









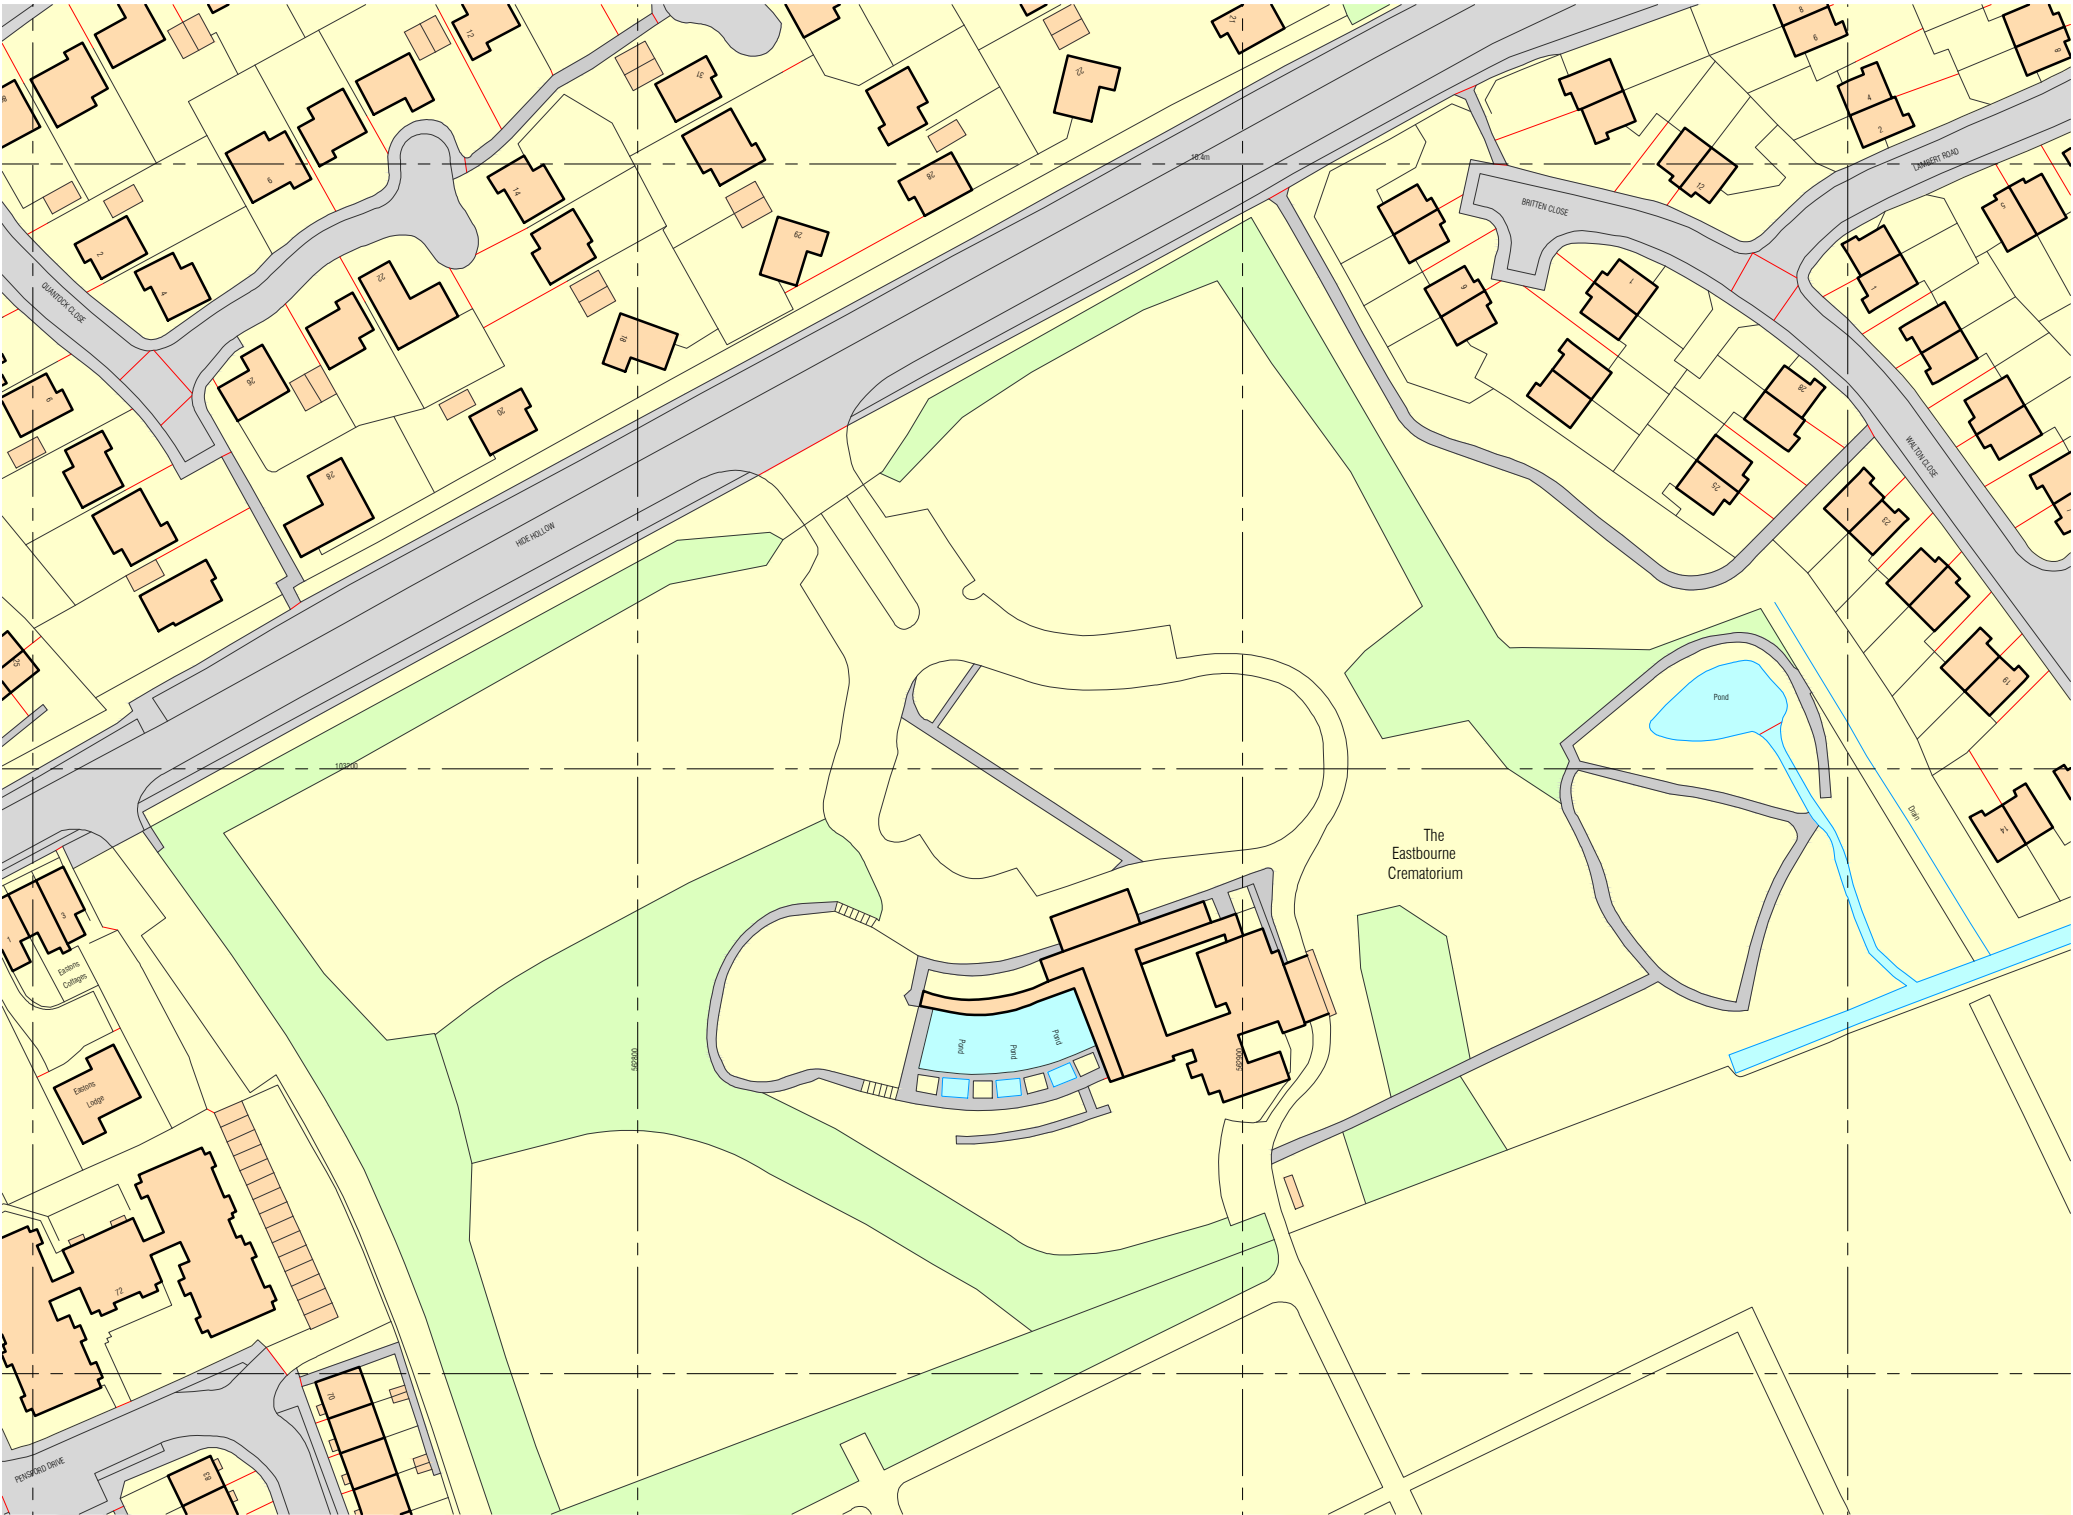

Ordnance Survey, (c) Crown Copyright 2012. All rights reserved. Licence number 100020449


01 Location Plan
Scale: 1:1250

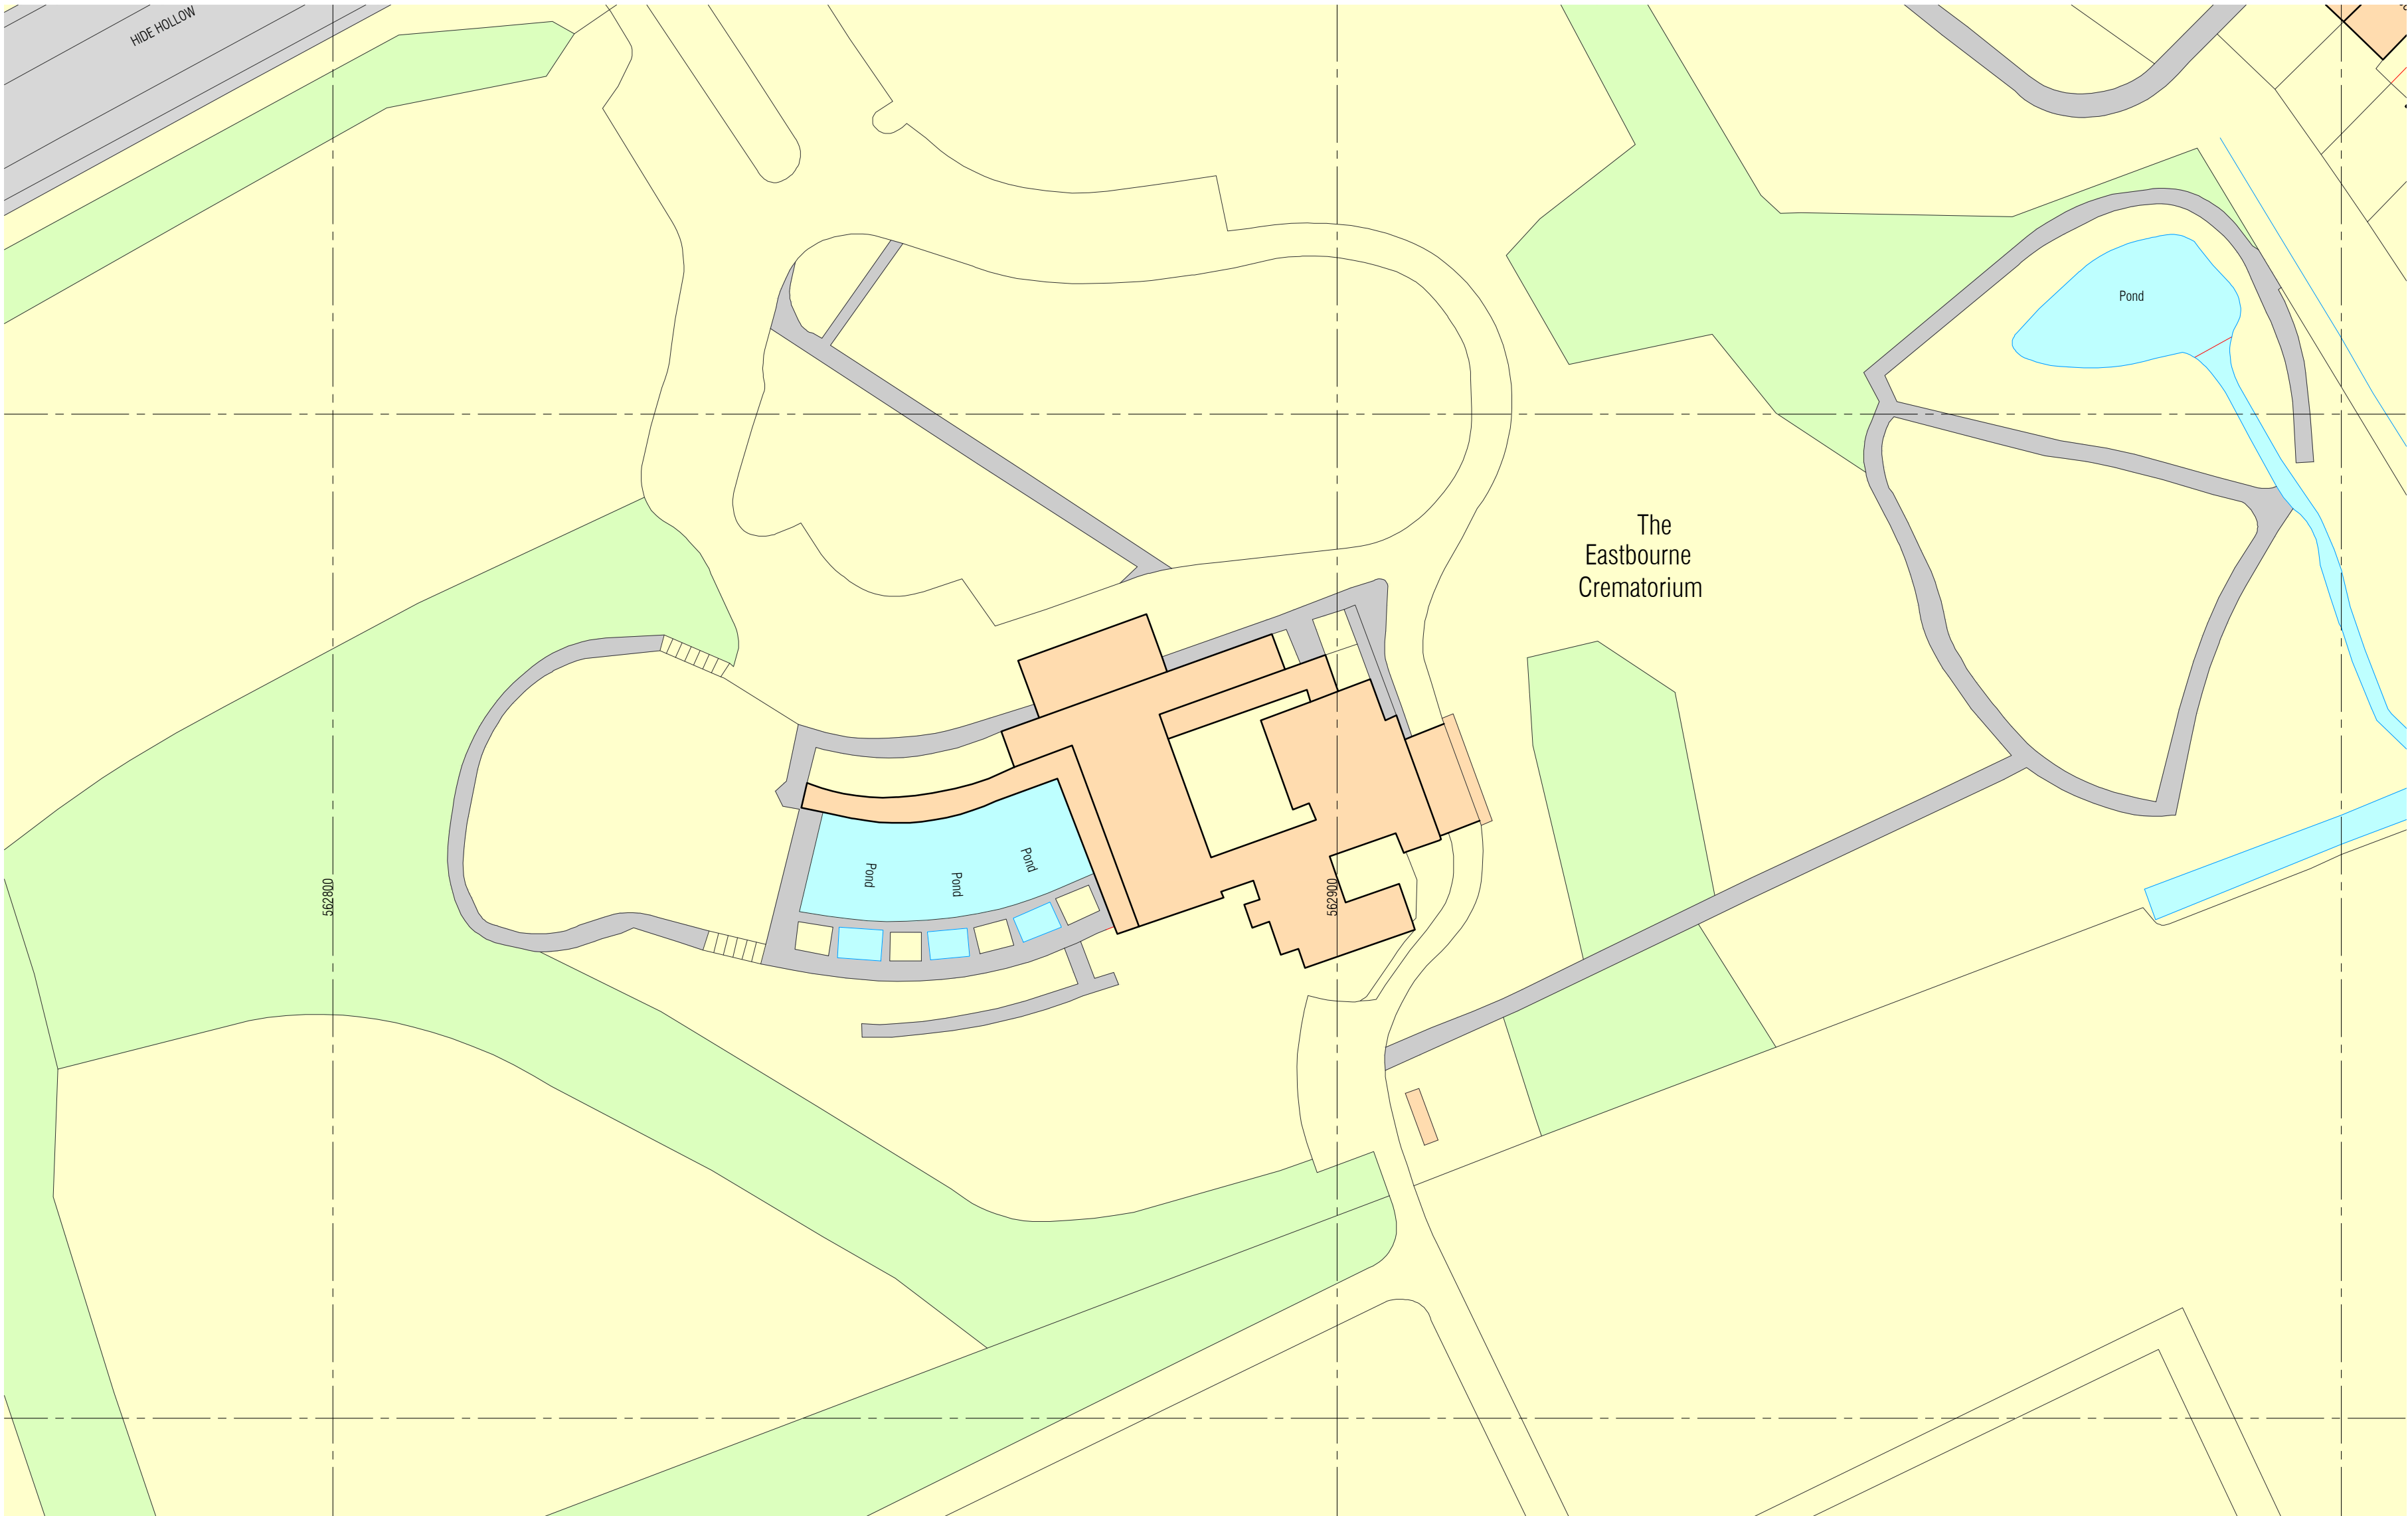

02 Block Plan
Scale: 1:1250

NB: All information based on supplied third party survey information.
All discrepancies to be reported to FCG immediately upon discovery.

NOTES: Do not scale this drawing. All dimensions to be checked on site prior to commencement or manufacture.
Key Plan (nts)

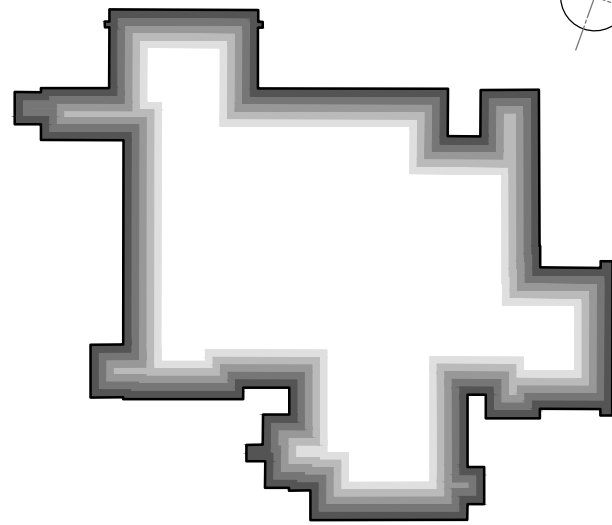

AS BUILT DRAWING

All details referenced in call outs supersede general arrangement or larger depictions.

Rev	Date	By	Chk	Comment
AB1	07.01.13	RKC	JAS	DRAWING ISSUED - AS BUILT

BRINGING IDEAS TO LIFE



FRANKHAM

Frankham Consultancy Group Limited
21 Perryman Road
Haywards Heath RH16 3TP
t 01444 444900 f 01444 455642
enquiries@frankham.com
www.frankham.com

Client	 Contract N°: MC0269
--------	-------------------------


Project Title	Eastbourne & Worthing Crematoria Refurbishments and Alterations
---------------	---

Drawing Title	 Eastbourne Crematorium Site Location & Block Plans
---------------	---

Drawn by: RKC	Scale: 1:100@A1	Date: 27.01.12
Designed by: FCG	Checked by: JAS	Approved by: AC


File Ref.: X:\FRANKHAM\2_080512\01 CREMATORIA\WORKING\000-BLOCK AND SITE PLANS\ 20.06.11\12.09.21

Drawing No. 521260-A-001-E	Rev. AB1
-------------------------------	-------------

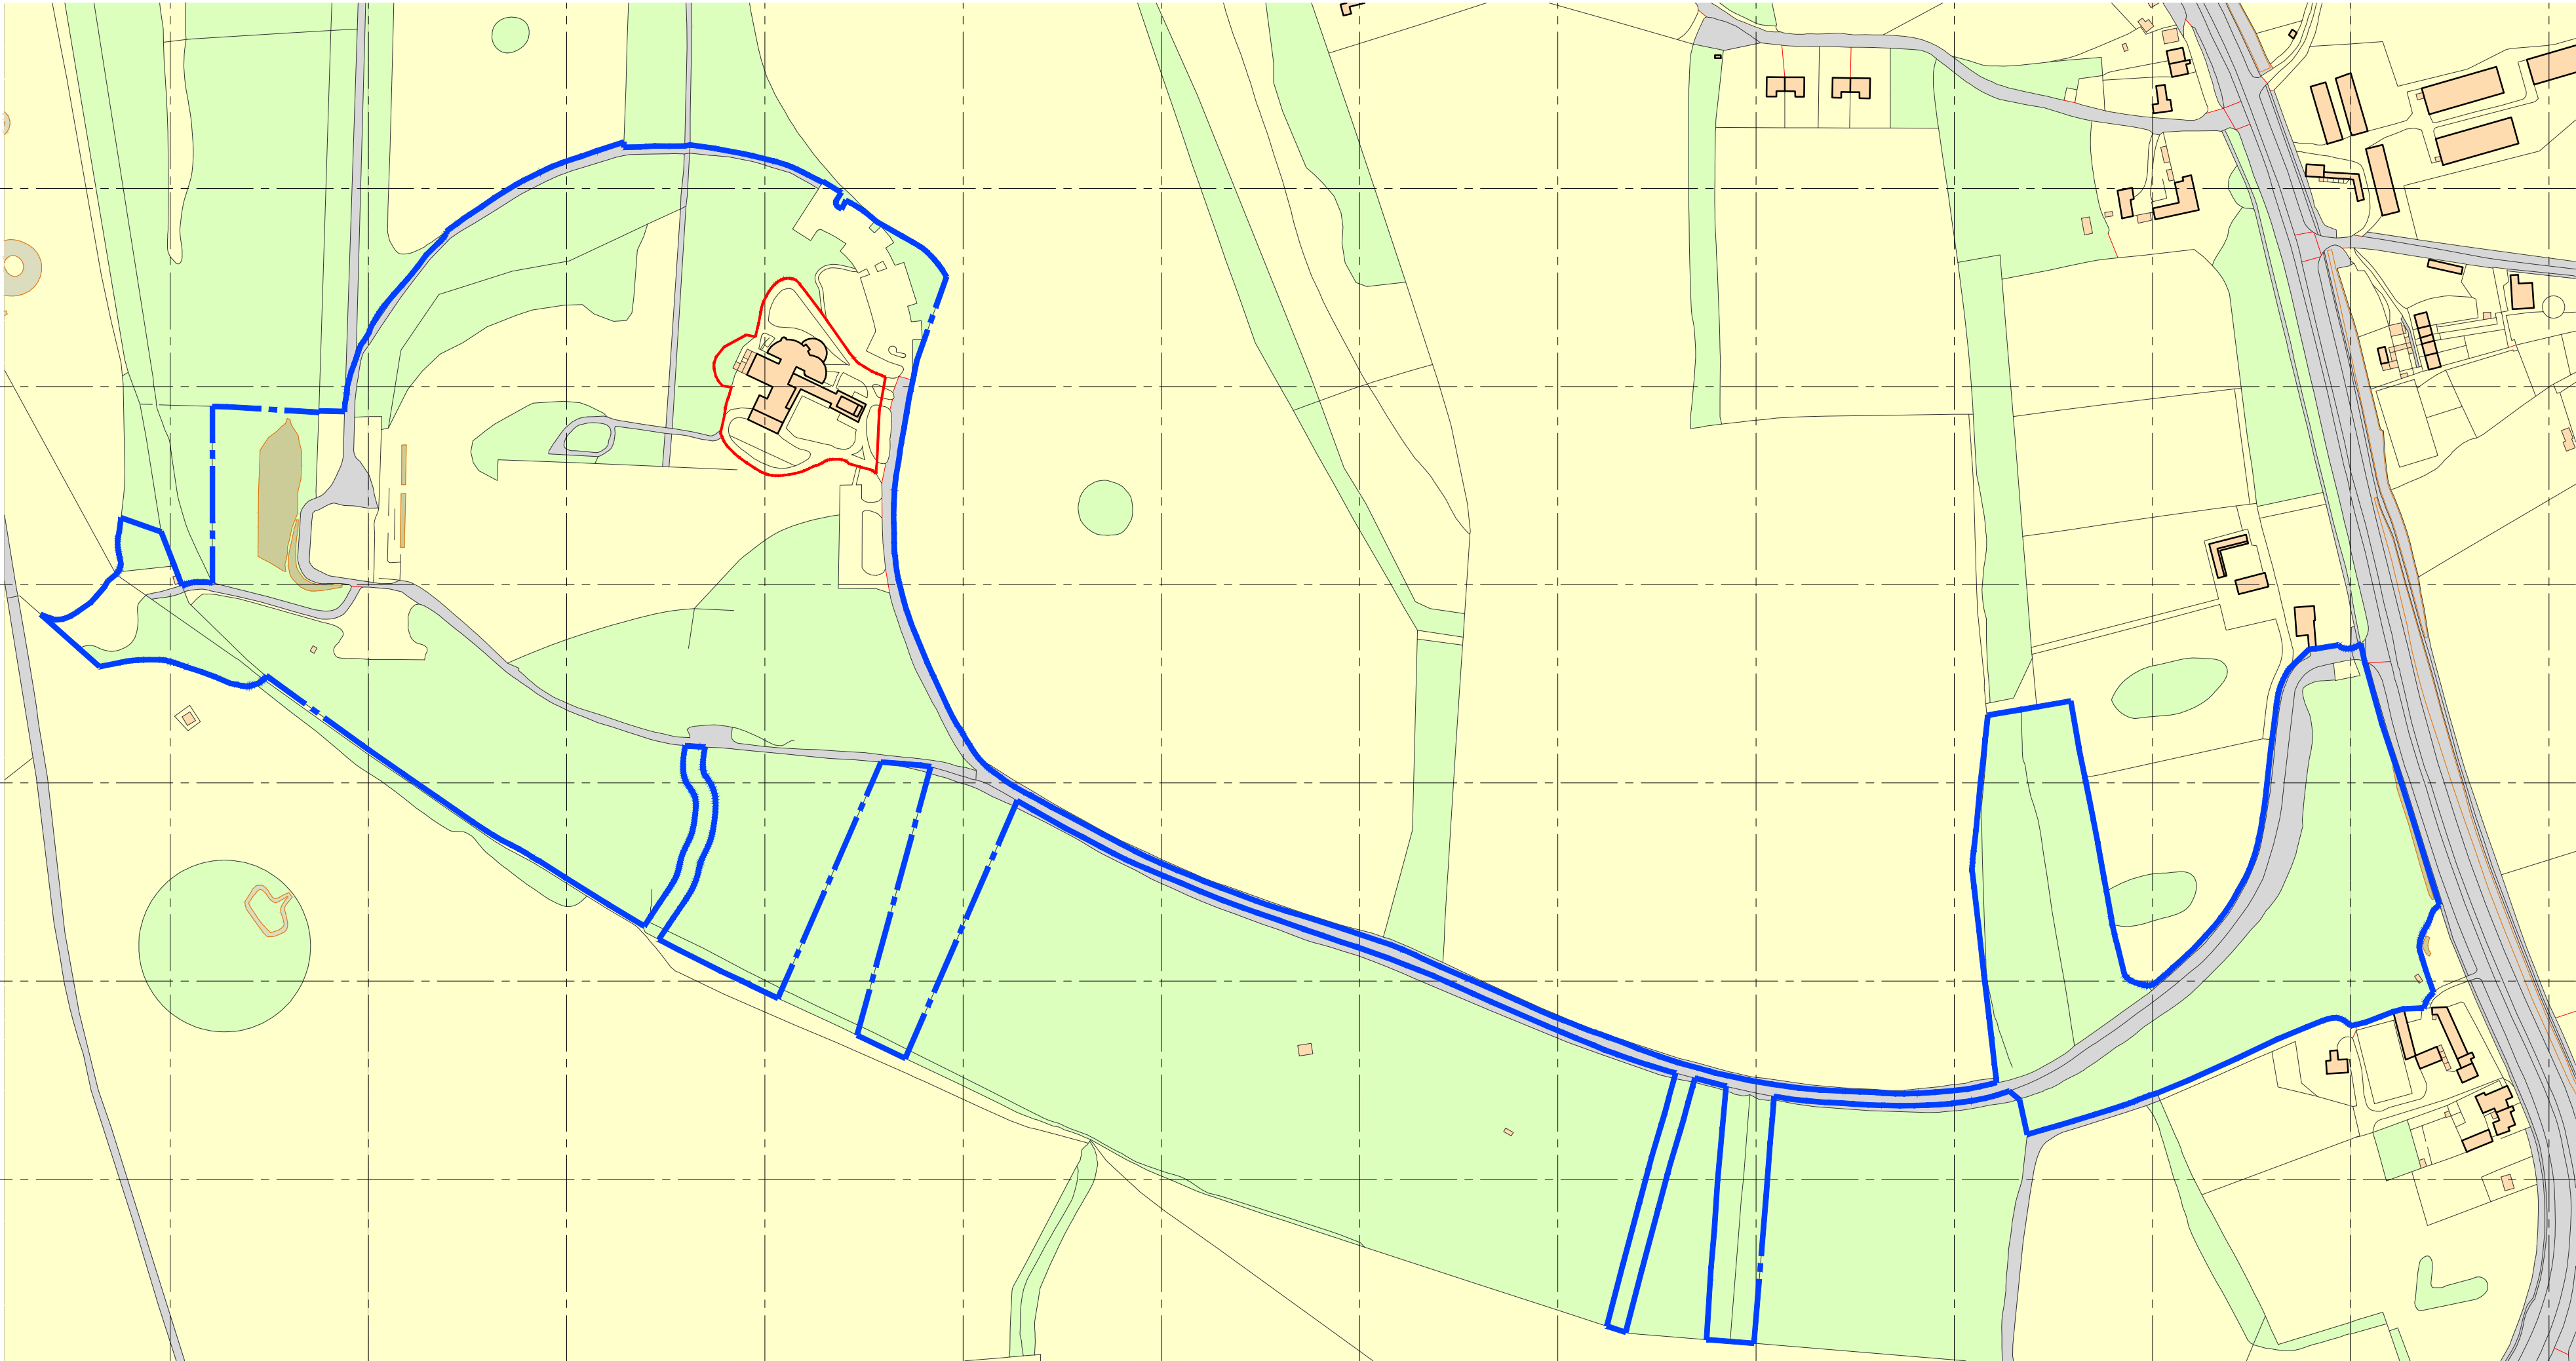

Ordnance Survey, (c) Crown Copyright 2012. All rights reserved. Licence number 100020449

01 Location Plan
Scale: 1:2500


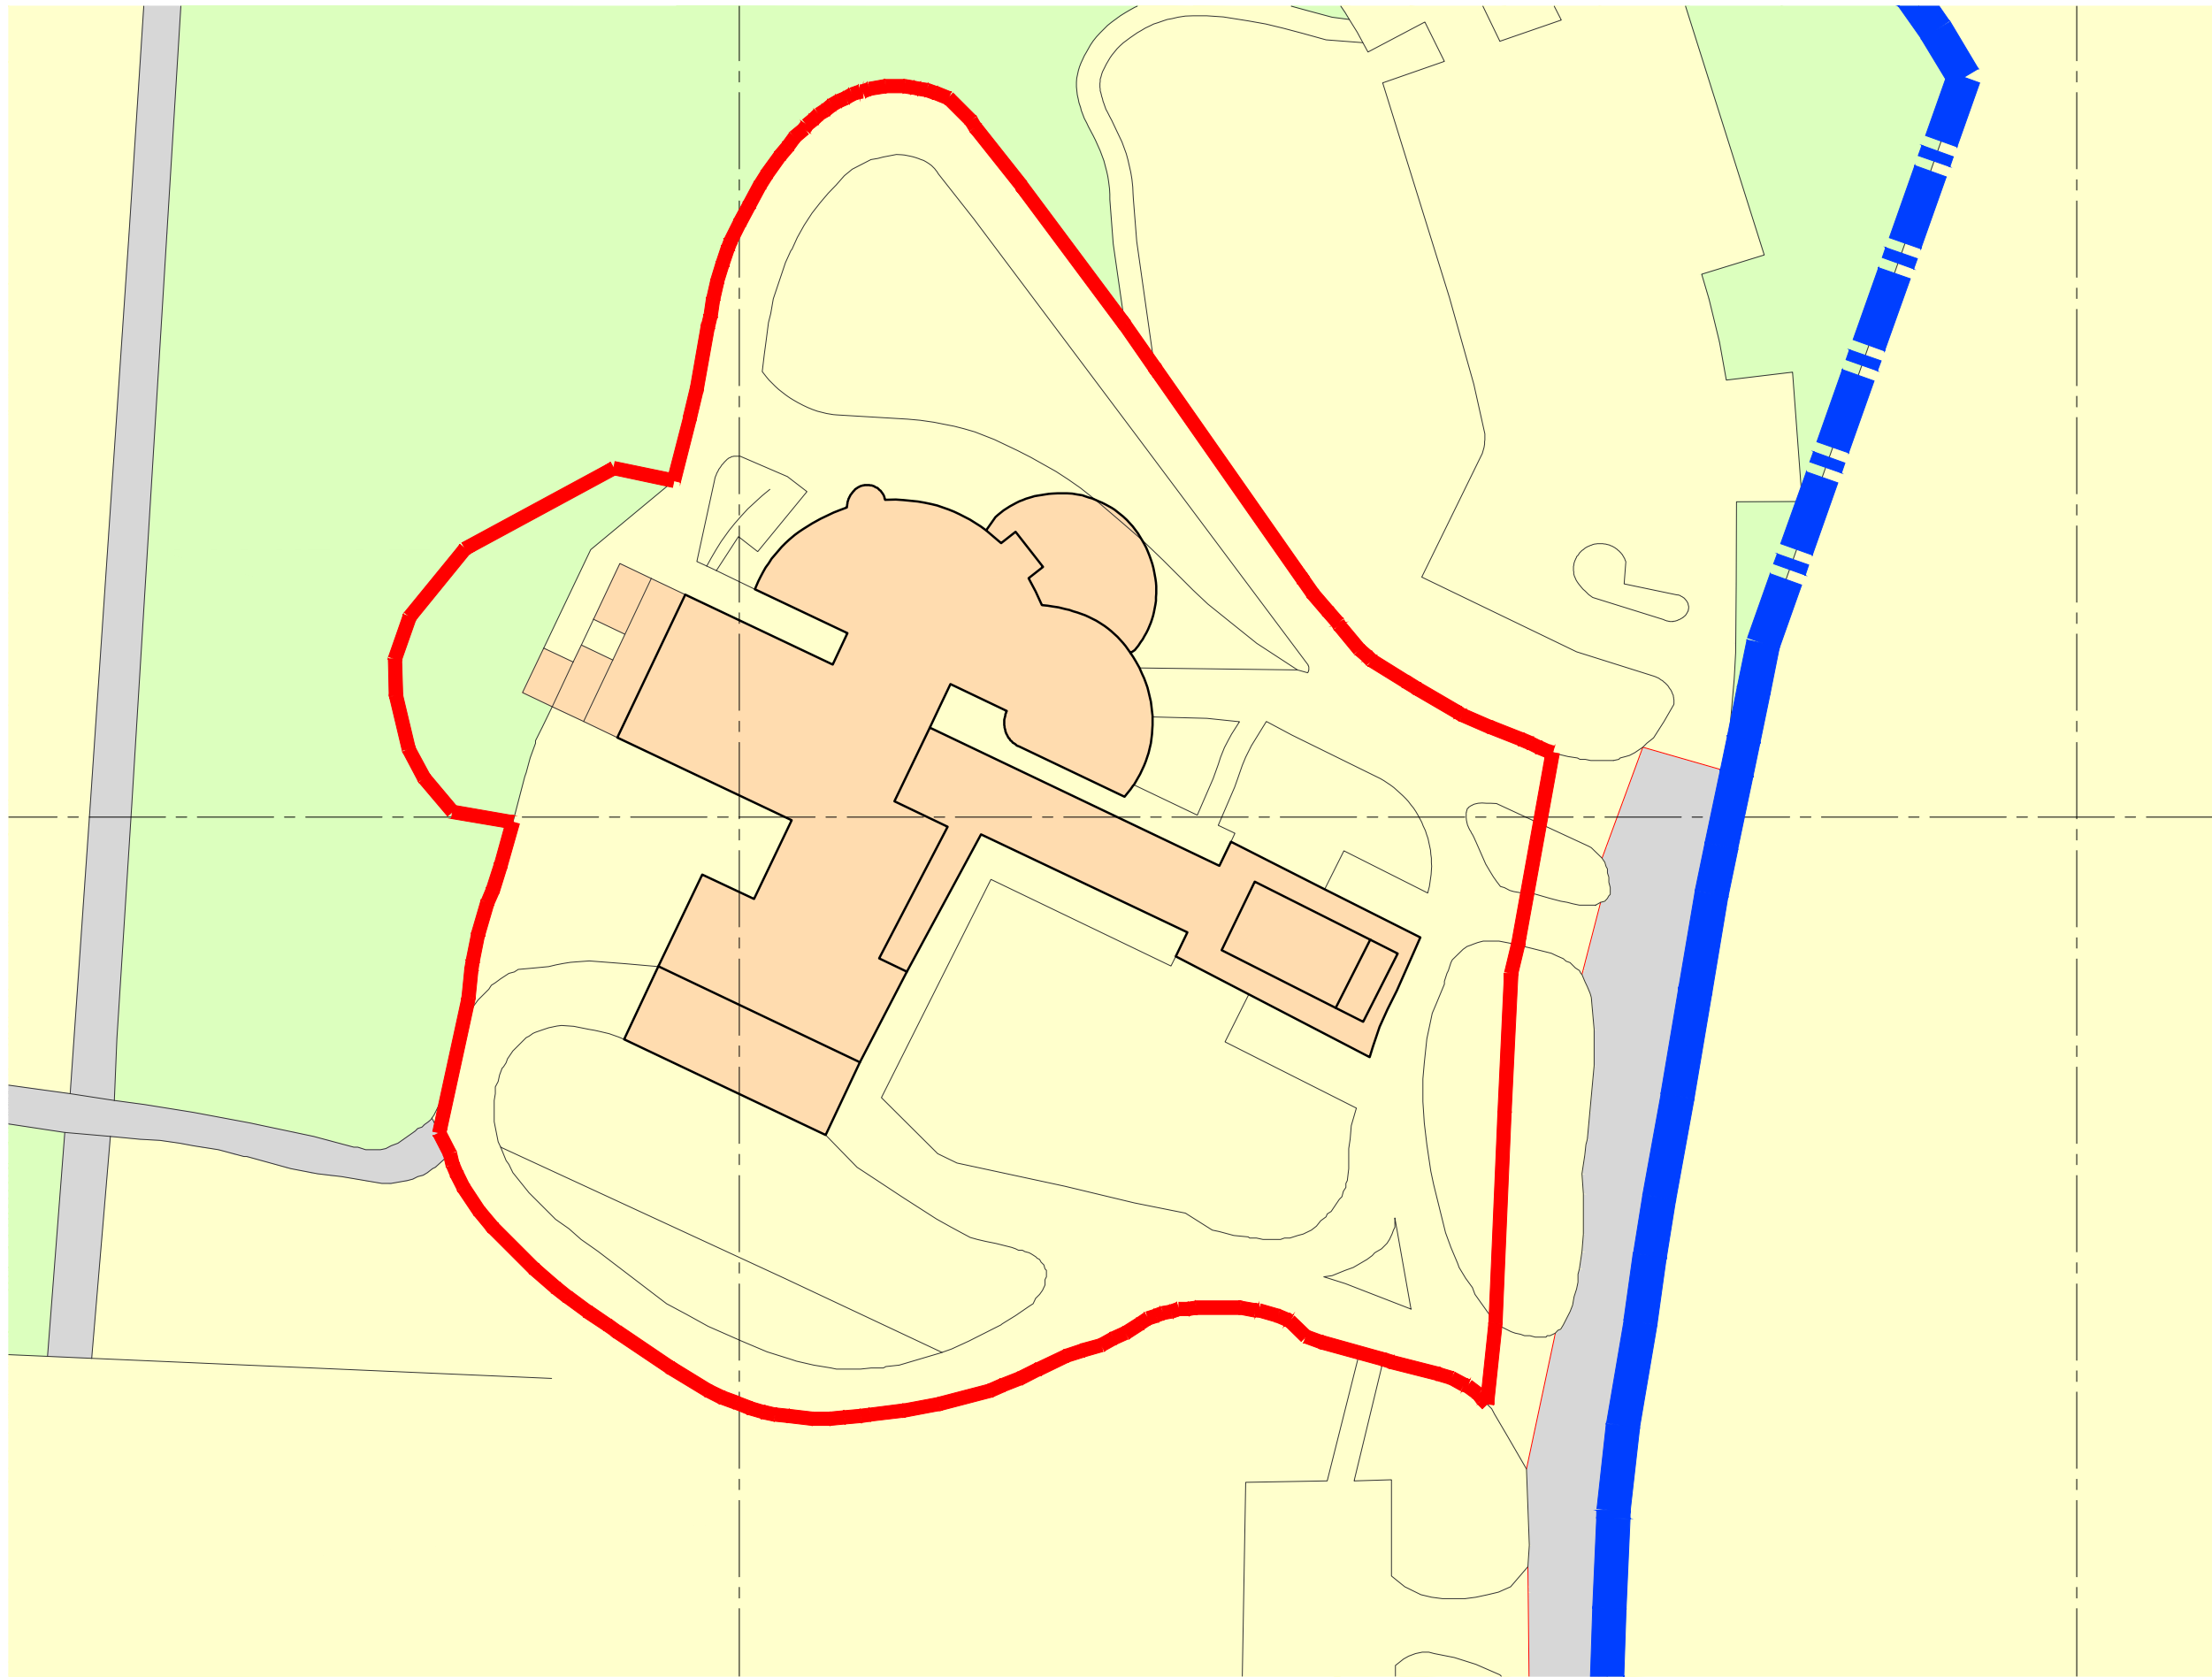


Ordnance Survey, (c) Crown Copyright 2012. All rights reserved. Licence number 100020449

02 Block Plan
Scale: 1:500

NB: All information based on supplied third party survey information.
All discrepancies to be reported to FCG immediately upon discovery.

NOTES: Do not scale this drawing. All dimensions to be checked on site prior to commencement or manufacture.
Key Plan (nts)

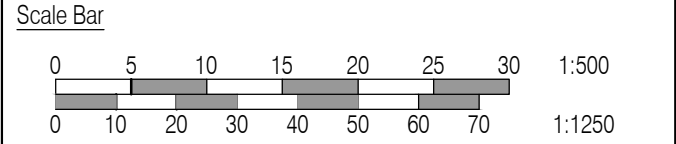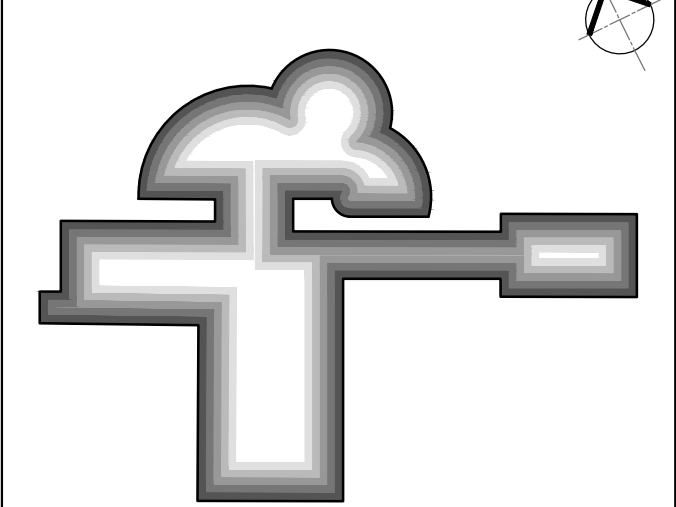

AS BUILT
DRAWING

All details referenced in call outs supersede general arrangement or larger depictions.

Rev	Date	By	Chk	Comment
AB1	07.01.13	RKC	JAS	DRAWING ISSUED - AS BUILT

BRINGING IDEAS TO LIFE



FRANKHAM

Frankham Consultancy Group Limited
21 Perryman Road
Haywards Heath RH16 3TP
t 01444 444900 f 01444 455642
enquiries@frankham.com
www.frankham.com

Client
Mansell
Contract N°: Worthing

Project Title
Eastbourne & Worthing
Crematoria
Refurbishments and Alterations


Drawing Title
Worthing
Worthing Crematorium
Site Location & Block Plans

Drawn by: RKC	Scale: 1:500 & 2500@A1	Date: 07.02.12
Designed by: FCG	Checked by: JAS	Approved by: AC

File Ref.: X:\FRANKHAM\2_080512180 CREMATORIA\WORTHING\005-BLOCK AND SITE PLANS\ 20.06.11\12.09.24

Drawing No.
521260-A-005-W



Rev.
AB1

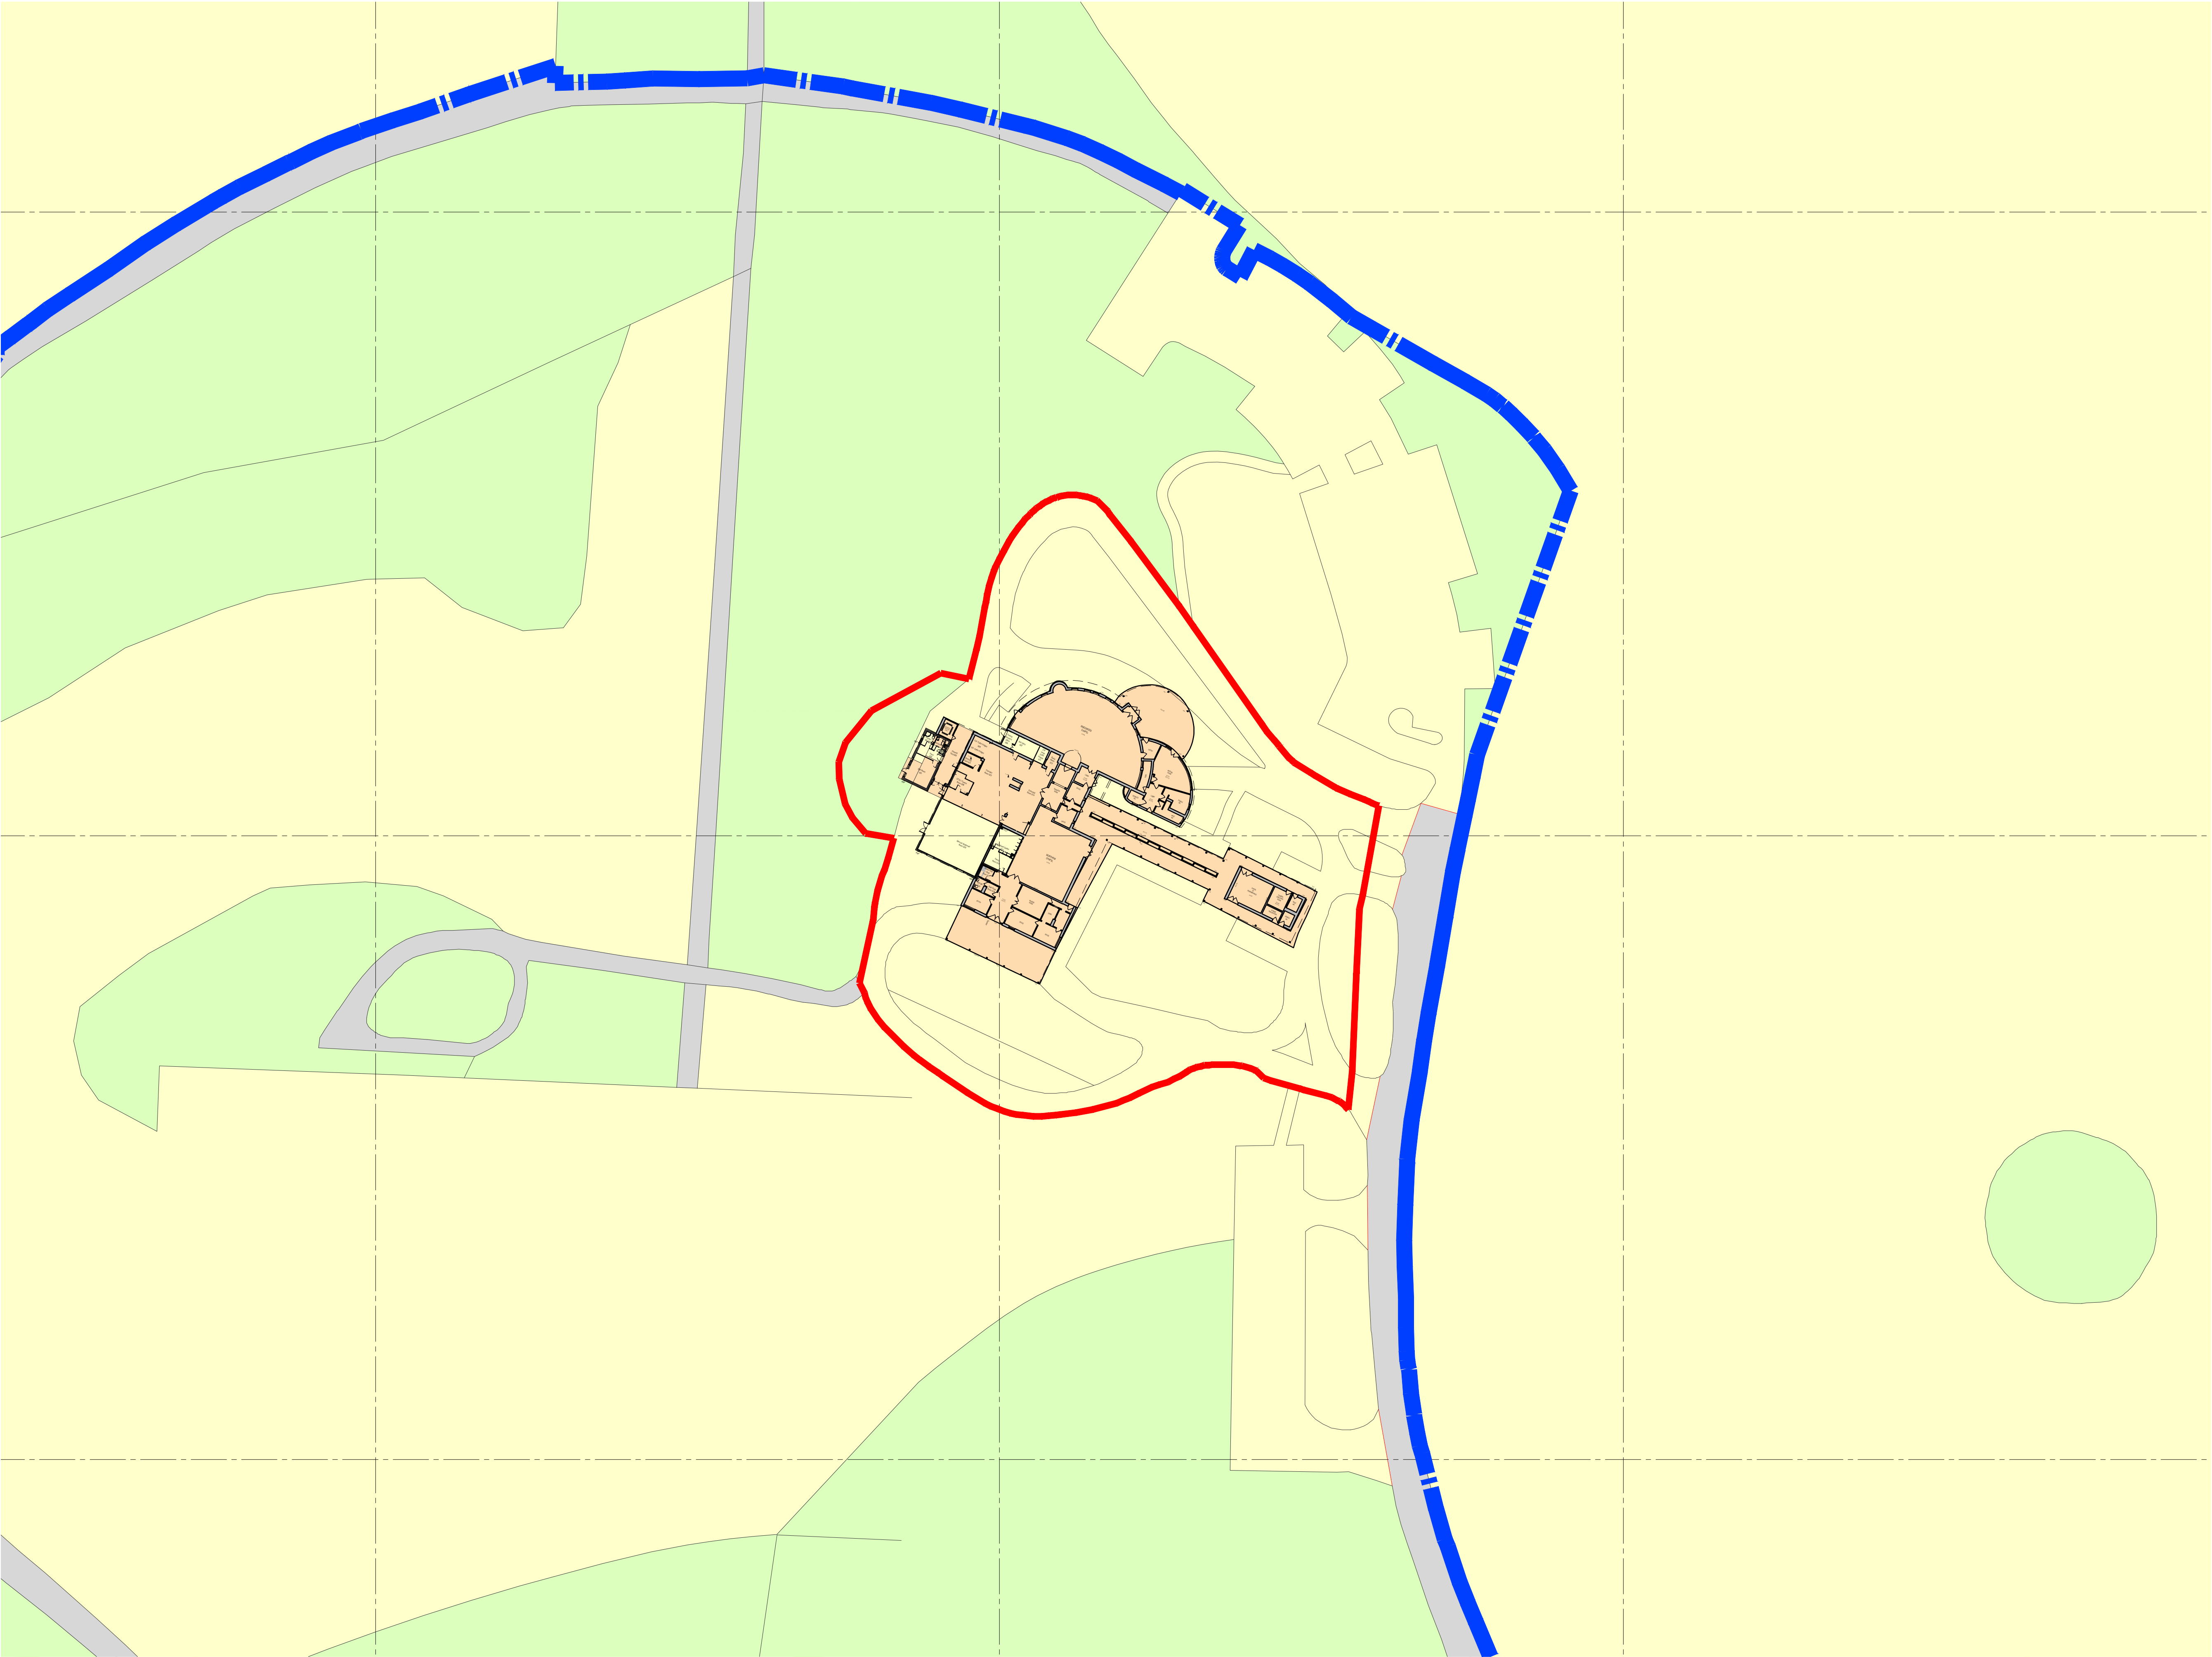

01 Site Arrangement Plan
Scale: 1:500

NB: All information based on supplied third party survey information.
All discrepancies to be reported to FCG immediately upon discovery.

NOTES: Do not scale this drawing. All dimensions to be checked on site prior to commencement or manufacture.
Key Plan (nts)

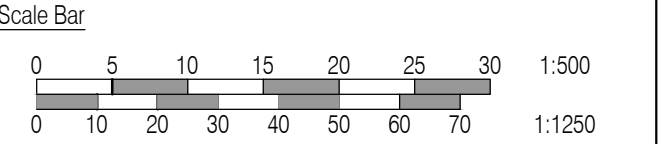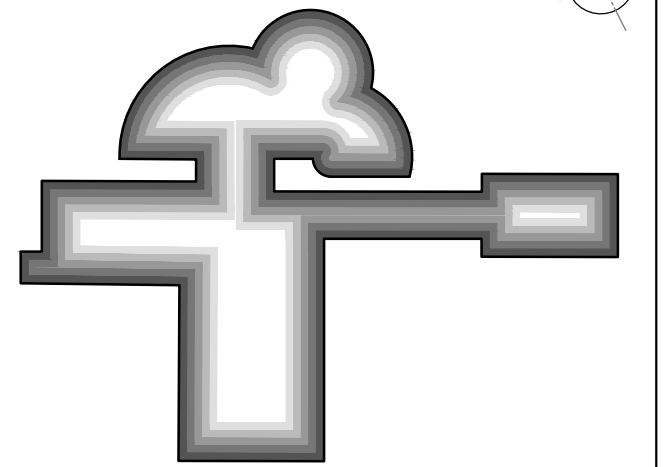

ISSUED FOR
INFORMATION

All details referenced in call outs supersede general arrangement or larger depictions.

Rev	Date	By	Chk	Comment
01	21.01.13	RKC	JAS	Issued for Client Alteration

BRINGING IDEAS TO LIFE



FRANKHAM

Frankham Consultancy Group Limited
21 Pymount Road
Haywards Heath RH16 3TP
t 01444 444900 f 01444 455642
enquiries@frankham.com
www.frankham.com

Client



Mansell
Contract N°: Worthing

Project Title

Eastbourne & Worthing
Crematoria
Refurbishments and Alterations

Drawing Title




Worthing
Crematorium
Site Arrangement Plans

Drawn by: RKC	Scale: 1:500@A1	Date: 07.02.12
Designed by: FCG	Checked by: JAS	Approved by: AC

File Ref.: X:\FRANKHAM\2_080512180 CREMATORIA\WORTHING\006-WOR-BLOCK AND SITE PLANS\ 20.06.11\12.09.29



Drawing No. 521260-A-006-W	Rev. 01
-------------------------------	------------

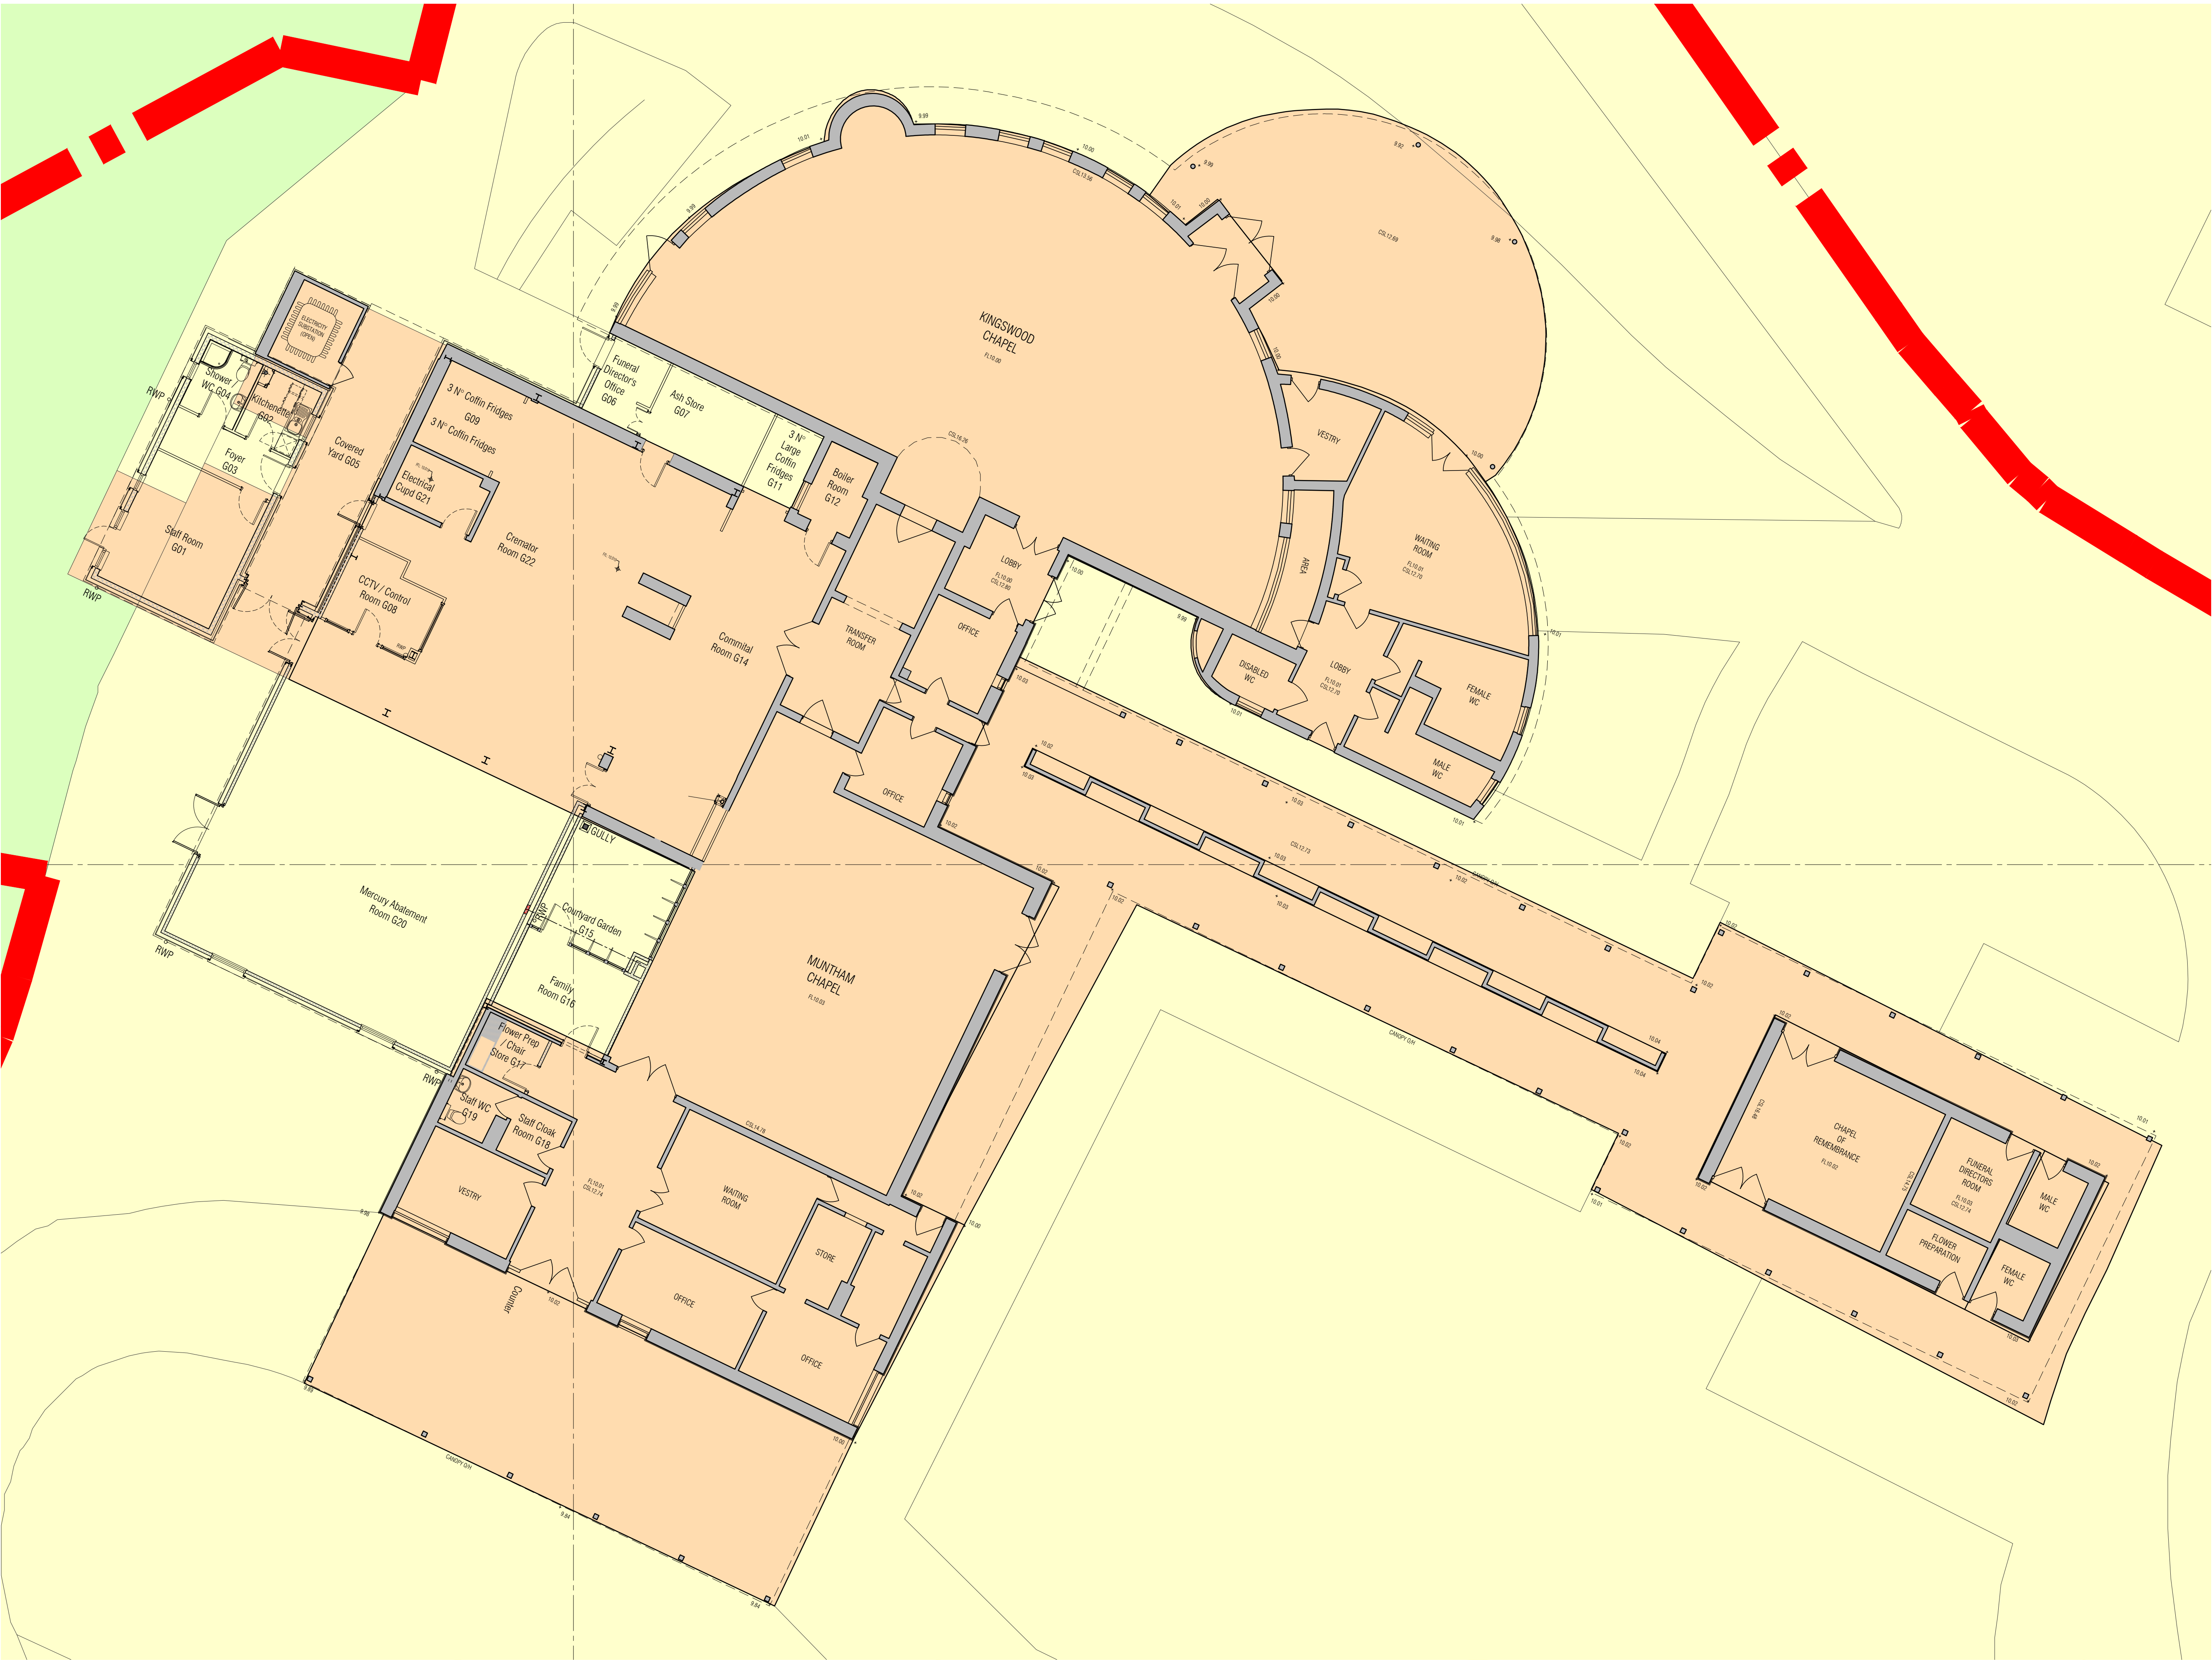

01 Site Arrangement Plan
Scale: 1:100

NB: All information based on supplied third party survey information.
All discrepancies to be reported to FCG immediately upon discovery.

NOTES: Do not scale this drawing. All dimensions to be checked on site prior to commencement or manufacture.
Key Plan (nts)

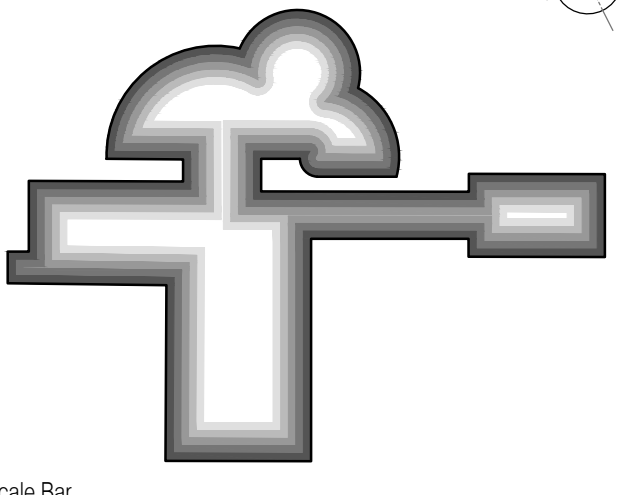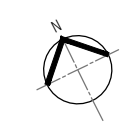

Scale Bar
0 5 10 15 20 25 30 1:500
0 10 20 30 40 50 60 70 1:1250

ISSUED FOR INFORMATION

All details referenced in call outs supercede general arrangement or larger depictions.

Rev	Date	By	Chk	Comment
01	21.01.13	RKC	JAS	Issued for Client Alteration

BRINGING IDEAS TO LIFE



FRANKHAM

Frankham Consultancy Group Limited
21 Perryman Road
Haywards Heath RH16 3TP
t 01444 444800 f 01444 455642
enquiries@frankham.com
www.frankham.com

Client



Contract N°: Worthing

Project Title

Eastbourne & Worthing
Crematoria
Refurbishments and Alterations

Drawing Title



Worthing Crematorium
Site Arrangement Plans

Drawn by: RKC	Scale: 1:100@A1	Date: 07.02.12
Designed by: FCG	Checked by: JAS	Approved by: AC

File Ref.: 521260-A-008-W-0001 - 200611120939


Drawing No. 521260-A-008-W	Rev. 01
-------------------------------	------------



01 Site Arrangement Plan
Scale: 1:100

NB: All information based on supplied third party survey information.
All discrepancies to be reported to FCG immediately upon discovery.

NOTES: Do not scale this drawing. All dimensions to be checked on site prior to commencement or manufacture.
Key Plan (nts)

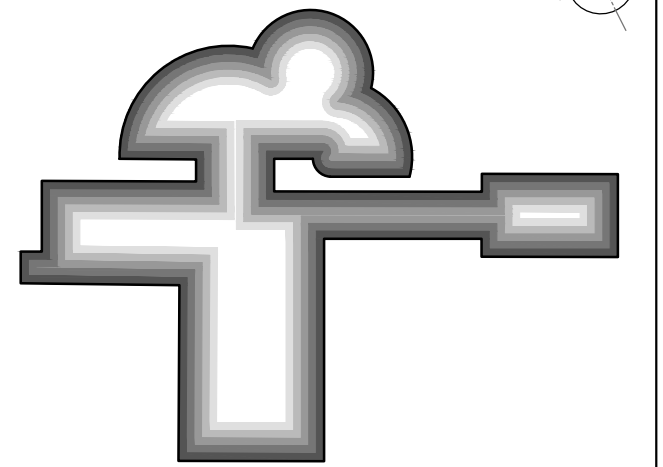

Scale Bar
0 5 10 15 20 25 30 1:500
0 10 20 30 40 50 60 70 1:1250

ISSUED FOR
INFORMATION

All details referenced in call outs supersede general arrangement or larger depictions.

Rev	Date	By	Chk	Comment
01	21.01.13	RKC	JAS	Issued for Client Alteration

BRINGING IDEAS TO LIFE



FRANKHAM

Frankham Consultancy Group Limited
21 Perryman Road
Haywards Heath RH16 3TP
t 01444 444800 f 01444 455642
enquiries@frankham.com
www.frankham.com

Client
Mansell
Contract N°: Worthing


Project Title
Eastbourne & Worthing
Crematoria
Refurbishments and Alterations

Drawing Title
Worthing
Worthing Crematorium
Site Arrangement Plans

Drawn by: RKC	Scale: 1:100@A1	Date: 07.02.12
Designed by: FCG	Checked by: JAS	Approved by: AC

File Ref.: 317380-A-009-W-0001 - 20061120044 20.06.11.12.09.44

Drawing No. 521260-A-009-W	Rev. 01
-------------------------------	------------

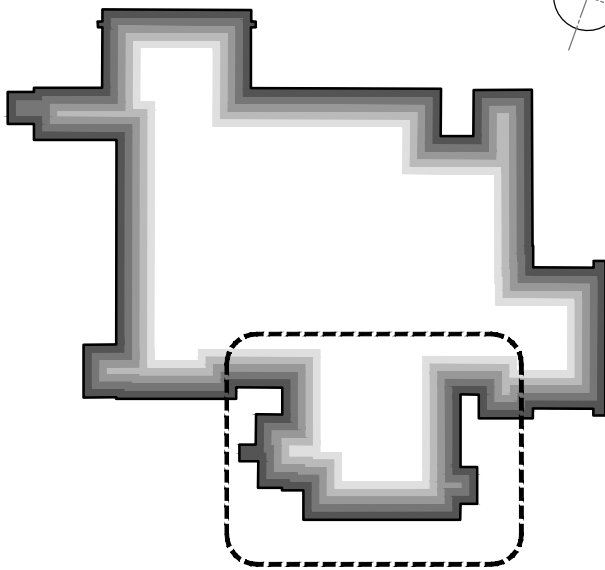

ISSUED FOR
CONSTRUCTION

[illegible]

C1	29.03.12	RKC	JAS	Issued for CONSTRUCTION
Rev	Date	By	Chk	Comment

BRINGING IDEAS TO LIFE



FRANKHAM

Frankham Consultancy Group Limited
21 Perrymount Road
Haywards Heath RH16 3TP
t 01444 444900 f 01444 455642
enquire@frankham.com
www.frankham.com

Client



Contract N°: MC0269

Project Title

Eastbourne & Worthing
Crematoria
Refurbishments and Alterations

Drawing Title




Eastbourne Crematorium
Existing Lower Ground Floor Plan

Drawn by: RKC	Scale: 1:100@A1	Date: 18.10.11
Designed by: FCG	Checked by: JAS	Approved by: AC


File Ref.: X:\FRANKHAMZ-JOBS\521260-CREMATORIA\ARCH100-199-LOCATION-PLANS-AND-GA.
521260-A-100-E.DWG - 200611120947 20:06:11:12:09:46

Drawing No. 521260-A-100-E	Rev. C1
-------------------------------	------------

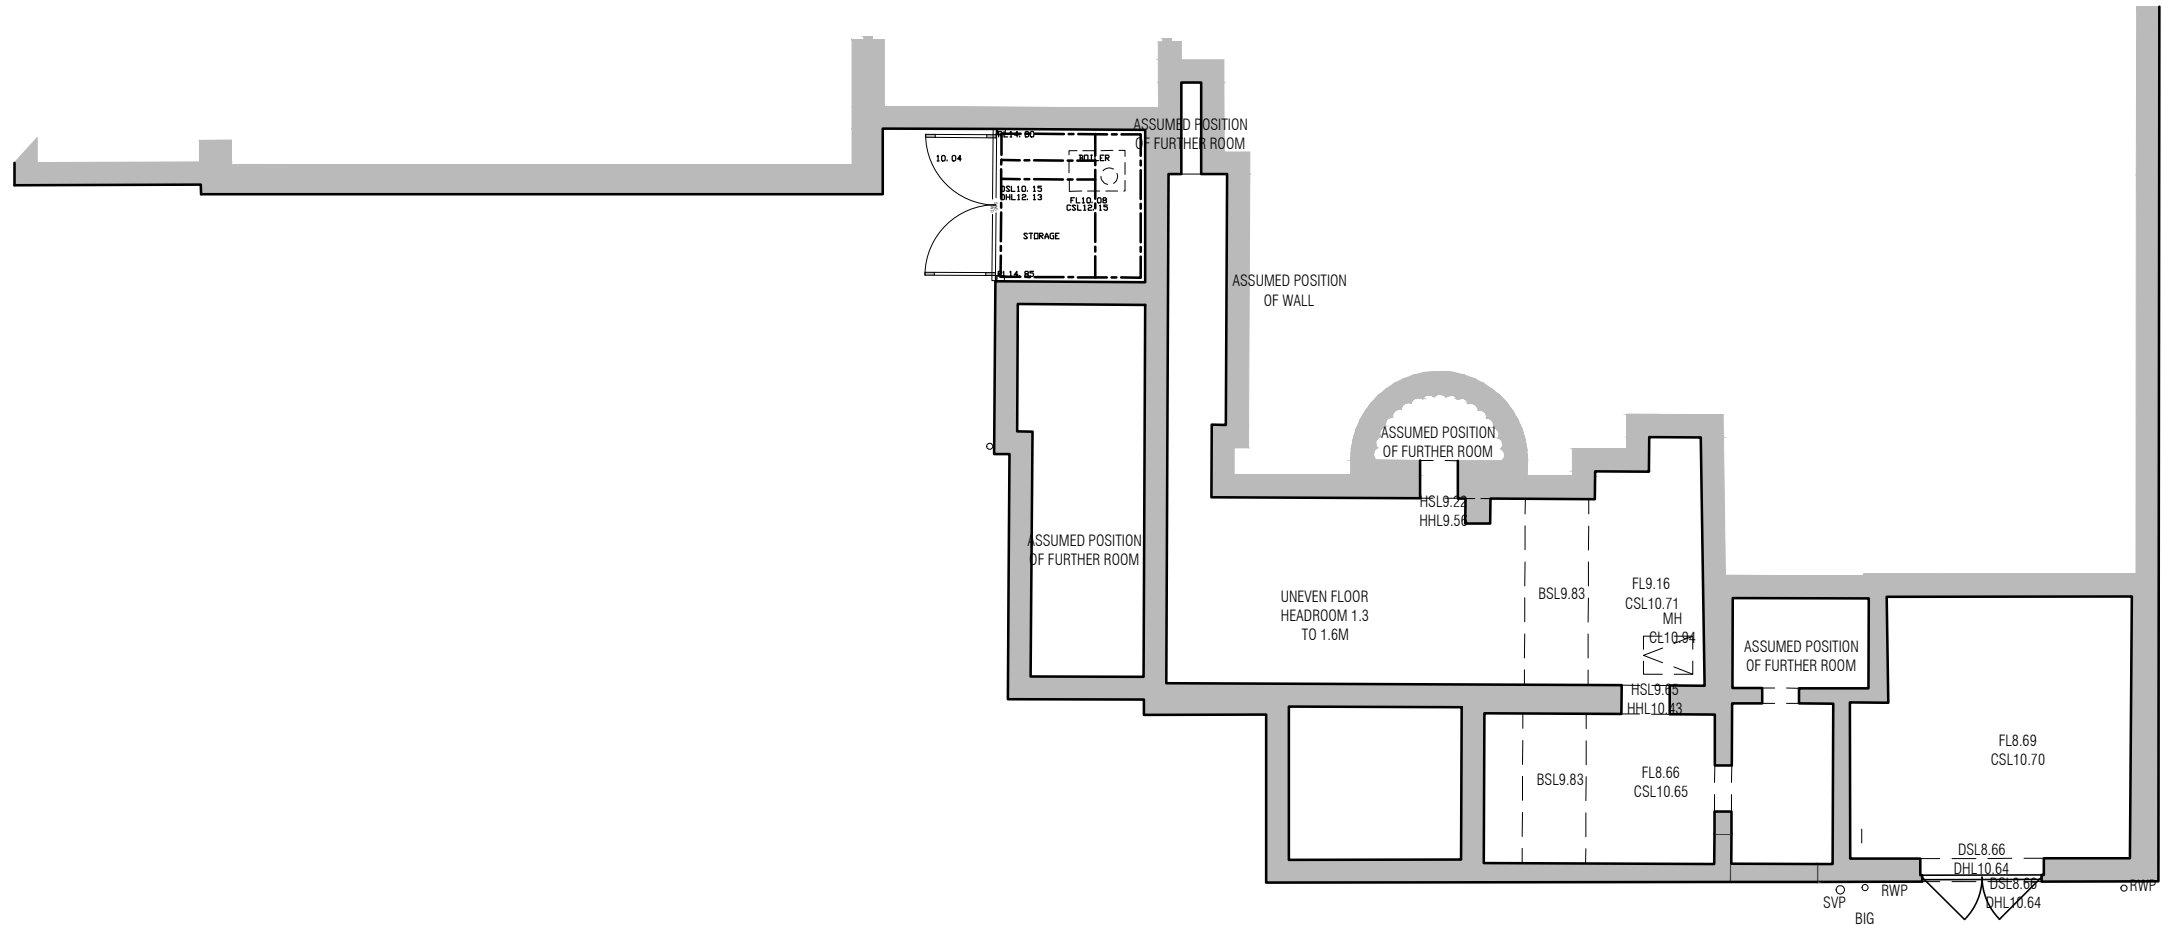


Refer to Dwg
521260-L-100-E
for Existing
Landscaping

NB: All information based on supplied third party survey information.
All discrepancies to be reported to FCG immediately upon discovery.

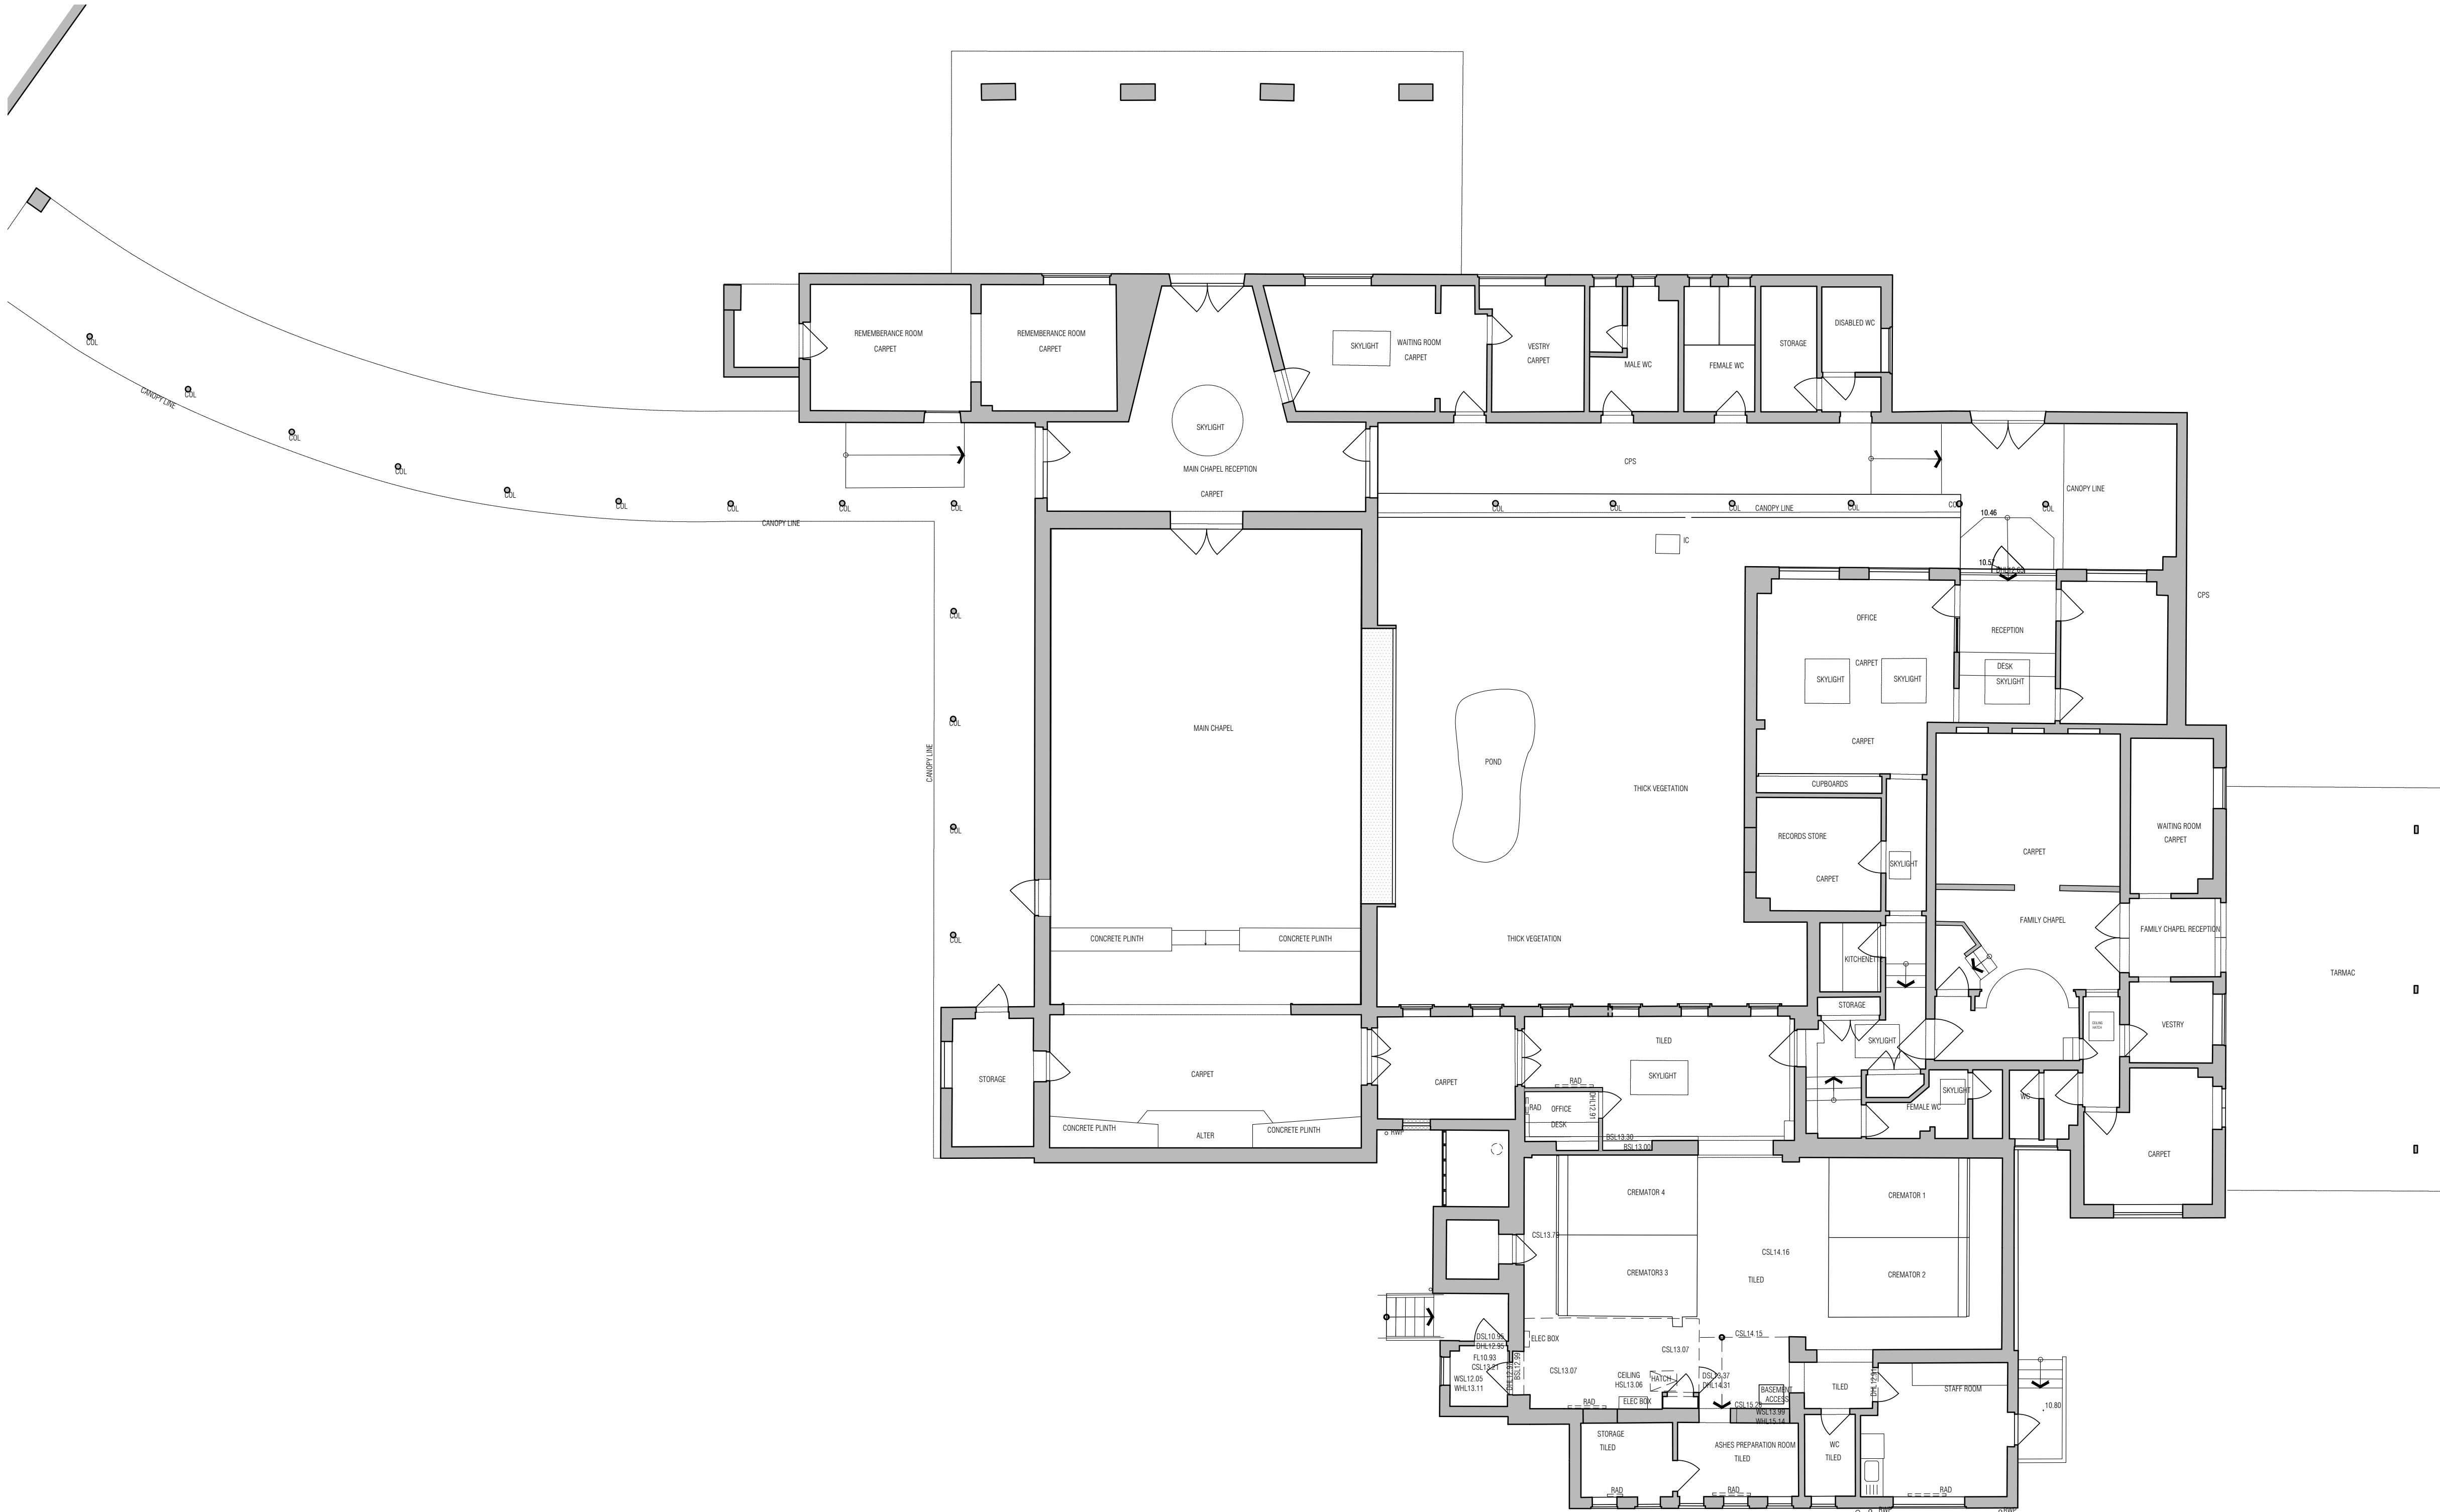

Refer to Dwg
521260-L-100-E
for Existing
Landscaping

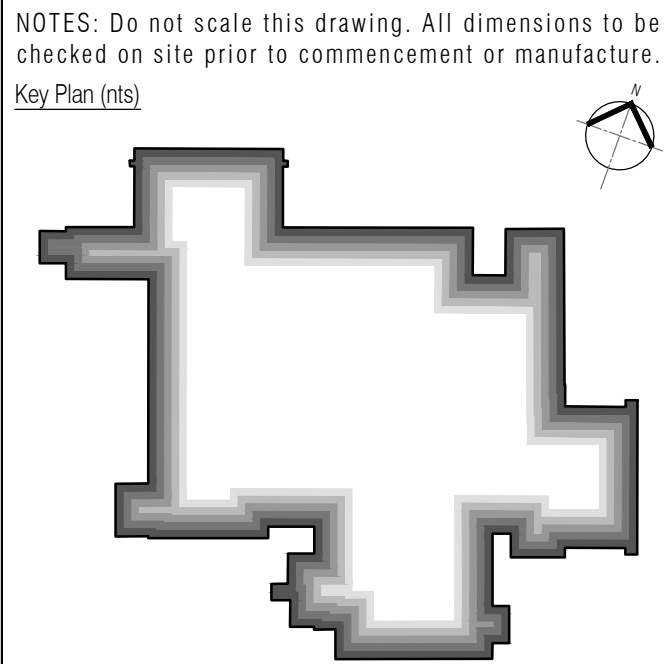

ISSUED FOR
CONSTRUCTION

All details referenced in call outs supersede general arrangement or larger depictions.

Rev	Date	By	Chk	Comment
C1	29.03.12	RKC	JAS	Issued for CONSTRUCTION

BRINGING IDEAS TO LIFE

FRANKHAM

Frankham Consultancy Group Limited
21 Perrymount Road
Haywards Heath RH16 3TP
t 01444 444900 f 01444 455642
enquiries@frankham.com
www.frankham.com

Client

Mansell
Contract N°: MC0269

Project Title


Eastbourne & Worthing
Crematoria
Refurbishments and Alterations

Drawing Title

EASTBOURNE
Eastbourne Crematorium
Existing Ground Floor Plan

Drawn by: RKC	Scale: 1:100@A1	Date: 18.10.11
Designed by: FCG	Checked by: JAS	Approved by: AC
File Ref.: X:\FRANKHAM\2_080512180 CREMATORIA\WORTHING\100-EXISTING FLOOR PLAN.dwg 307380-A-101-E.DWG - 290611120950		
Drawing No. 521260-A-101-E	Rev. C1	

NB: All information based on supplied third party survey information.
All discrepancies to be reported to FCG immediately upon discovery.

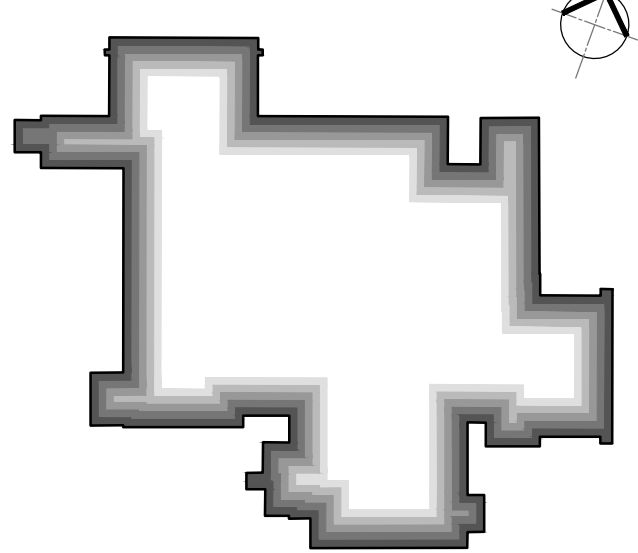

All details referenced in call outs supersede general arrangement or larger depictions.

BRINGING IDEAS TO LIFE



Client  **Mansell**
A Southern Bell Company
 Contract N°: MC0269

Project Title	Eastbourne & Worthing Crematoria Refurbishments and Alterations
---------------	---

Drawing Title


EASTBOURNE
Borough Council

Eastbourne Crematorium
Existing First Floor Plan

File Ref.: X:\FRANKHAMZ-JOBS\521260-CREMATORIA\ARCH100-199-LOCATION-PLANS-AND-GA,
521260-A-100-E.DWG - 200606132434 20-06-26-13:24:33


Drawing No. 521260-A-102-E	Rev. C1
-------------------------------	------------

NB: All information based on supplied third party survey information.
All discrepancies to be reported to FCG immediately upon discovery.

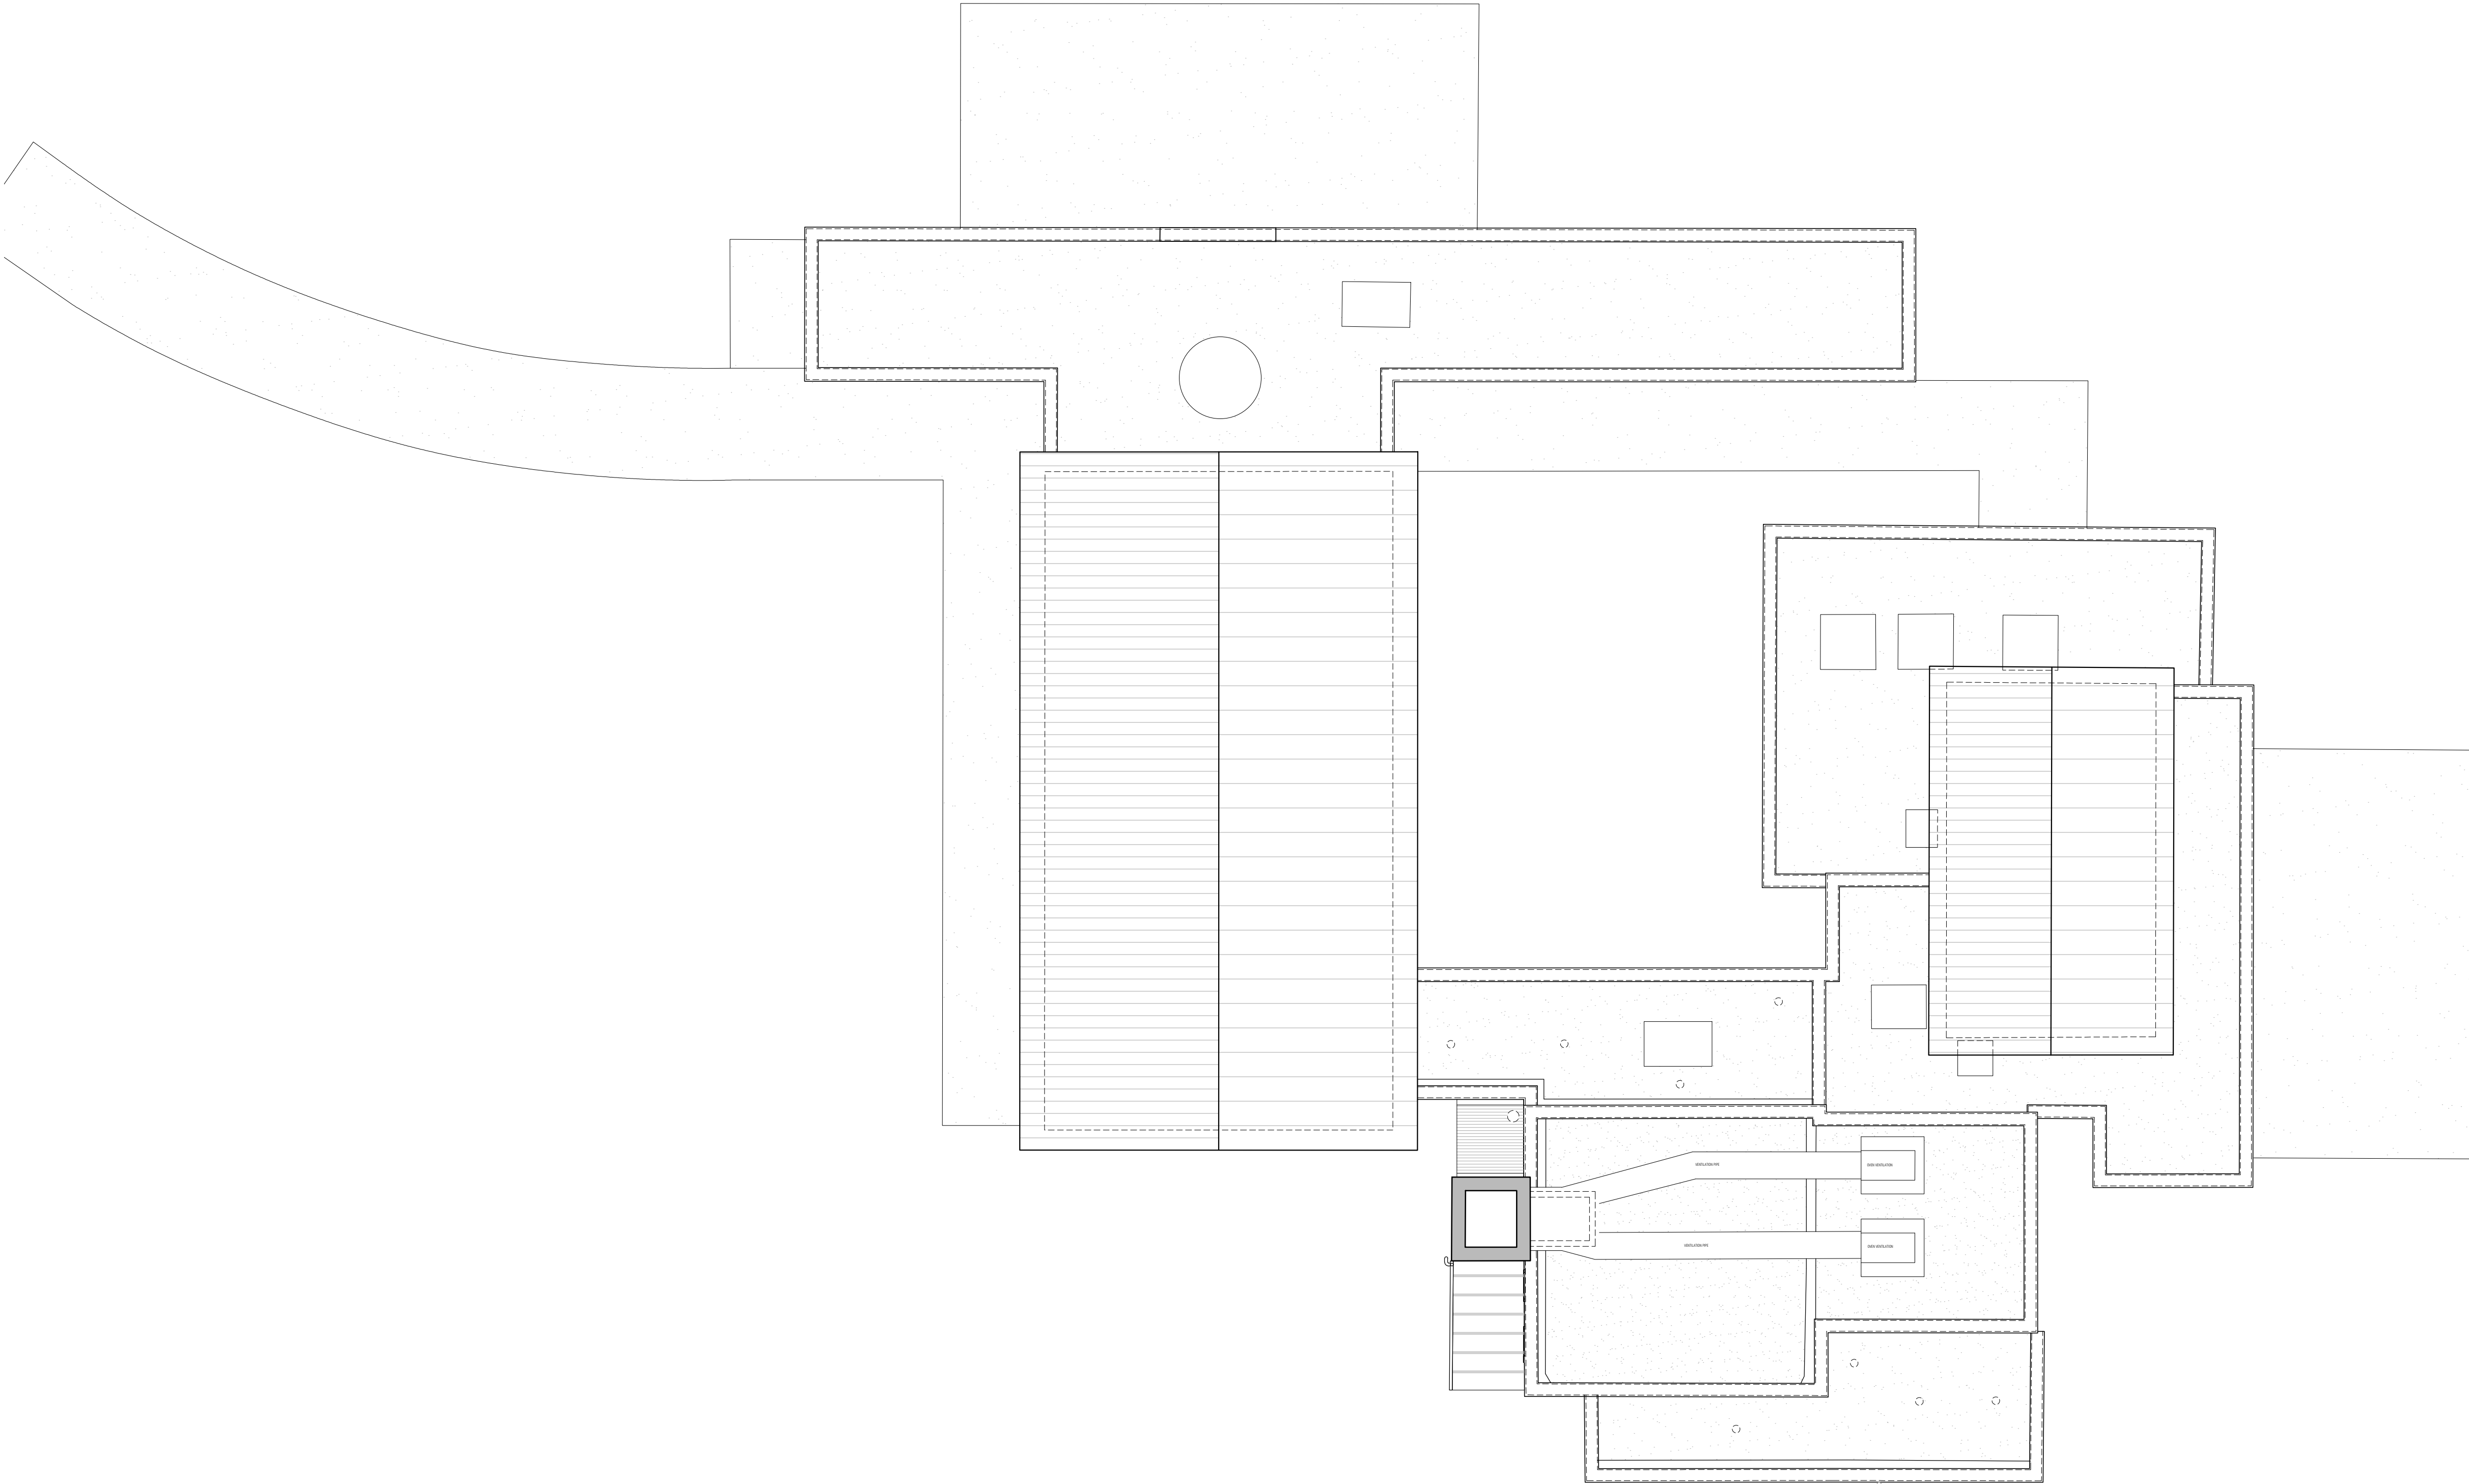

NB: All information based on supplied third party survey information.
All discrepancies to be reported to FCG immediately upon discovery.

NOTES: Do not scale this drawing. All dimensions to be checked on site prior to commencement or manufacture.
Key Plan (nts)

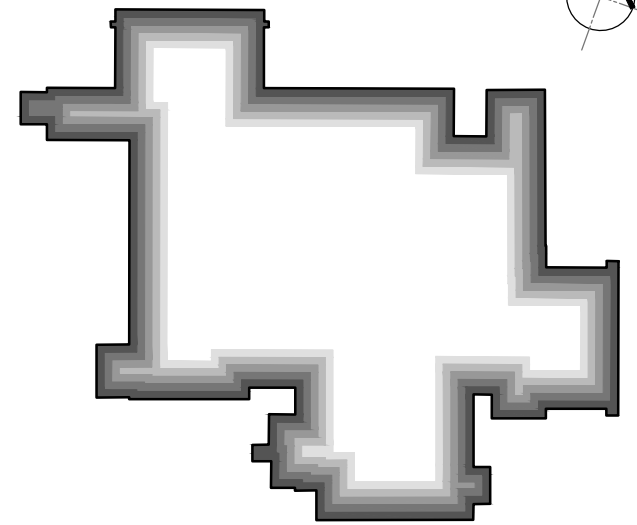

ISSUED FOR CONSTRUCTION

All details referenced in call outs supersede general arrangement or larger depictions.

C1	29.03.12	RKC	JAS	Issued for CONSTRUCTION
Rev	Date	By	Chk	Comment

BRINGING IDEAS TO LIFE



FRANKHAM

Frankham Consultancy Group Limited
21 Perrymount Road
Haywards Heath RH16 3TP
t 01444 444900 f 01444 455642
enquire@frankham.com
www.frankham.com

Client



Contract N°: MC0269

Project Title

Eastbourne & Worthing
Crematoria
Refurbishments and Alterations

Drawing Title




Eastbourne Crematorium
Existing Roof Plan

Drawn by: RKC	Scale: 1:100@A1	Date: 18.10.11
Designed by: FCG	Checked by: JAS	Approved by: AC



File Ref.: X:\FRANKHAM\2_080512181 CREMATORIA\WORK\100-100 LOCATION PLANS AND GA\ 20.06.26.12.24.11

Drawing No. 521260-A-103-E	Rev. C1
-------------------------------	------------

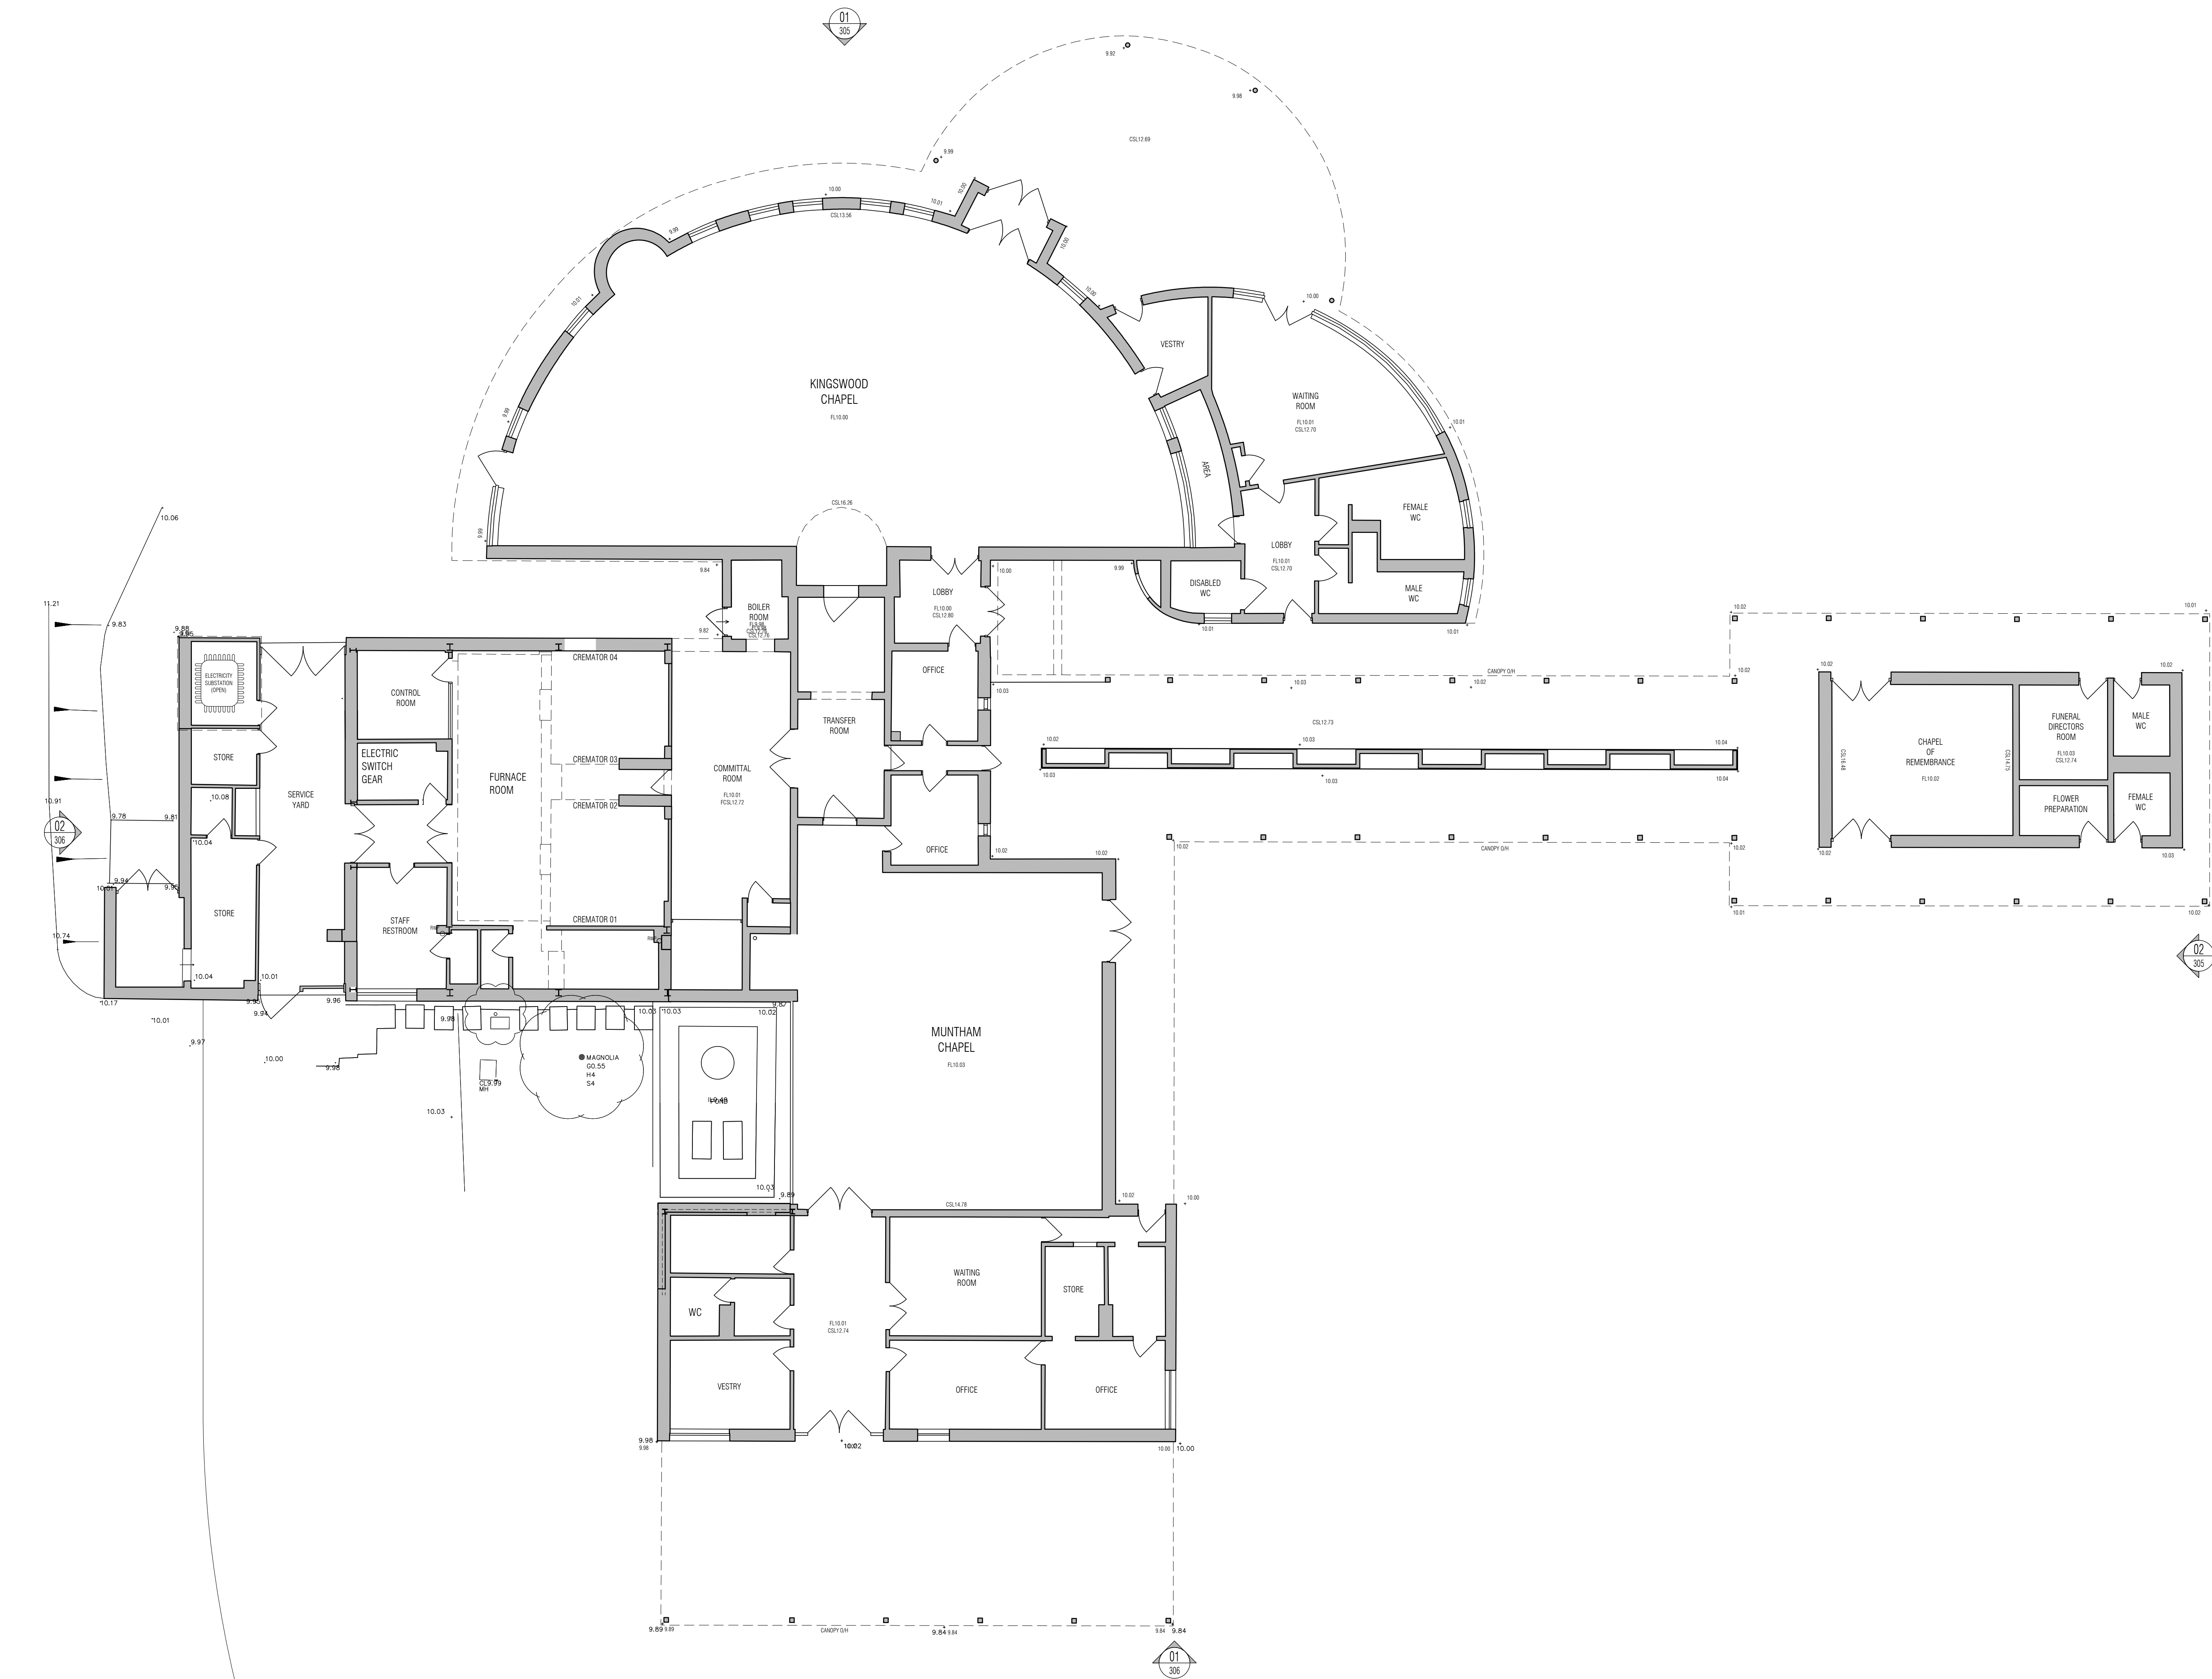

NB: All information based on supplied third party survey information.
All discrepancies to be reported to FCG immediately upon discovery.

NOTES: Do not scale this drawing. All dimensions to be checked on site prior to commencement or manufacture.
Key Plan (nts)

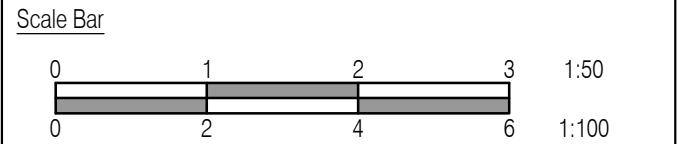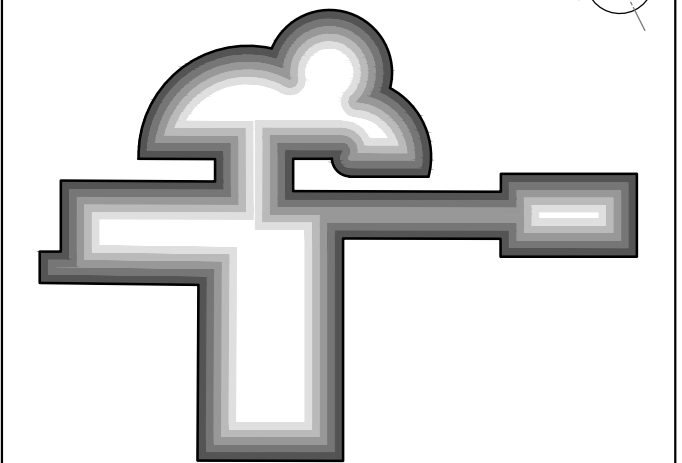

ISSUED FOR CONSTRUCTION

All details referenced in call outs supersede general arrangement or larger depictions.

Rev	Date	By	CHK	Comment
C2	09.07.12	RKC	JAS	Issued for Construction
P5	01.06.12	RKC	JAS	Issued for Stage F
P4	01.05.12	RKC	JAS	Issued for New Planning Approval
C1	23.04.12	RKC	JAS	Issued for CONSTRUCTION

BRINGING IDEAS TO LIFE

FRANKHAM






Frankham Consultancy Group Limited
21 Perryman Road
Haywards Heath RH16 3TP
t 01444 444900 f 01444 455642
enquire@frankham.com
www.frankham.com

Client: **Mansell**
Contract N°: Worthing

Project Title: Eastbourne & Worthing
Crematoria
Refurbishments and Alterations

Drawing Title: **Worthing**
Worthing Crematorium
Existing Ground Floor Plan

Drawn by: RKC	Scale: 1:100@A1	Date: 18.10.11
Designed by: FCG	Checked by: JAS	Approved by: AC
File Ref.: X:\FRANKHAM\2_08051210 CREMATORIA\WORTHING\LOCATIONS PLANS AND GFA 301260-A-105-W-000 - 200811271000		20.06.11 12.10.00
Drawing No: 521260-A-105-W		Rev: C2

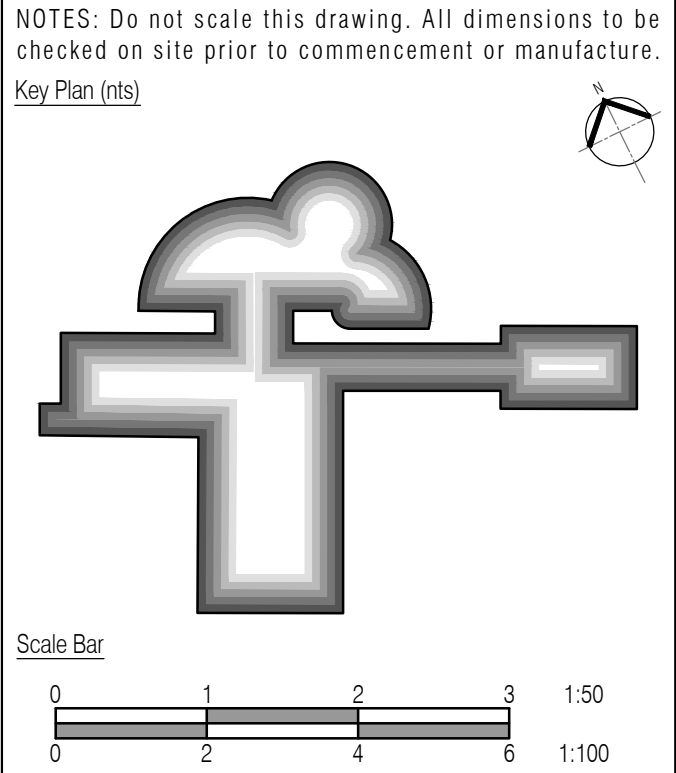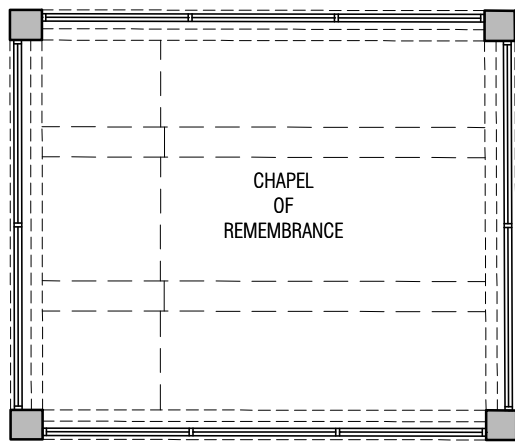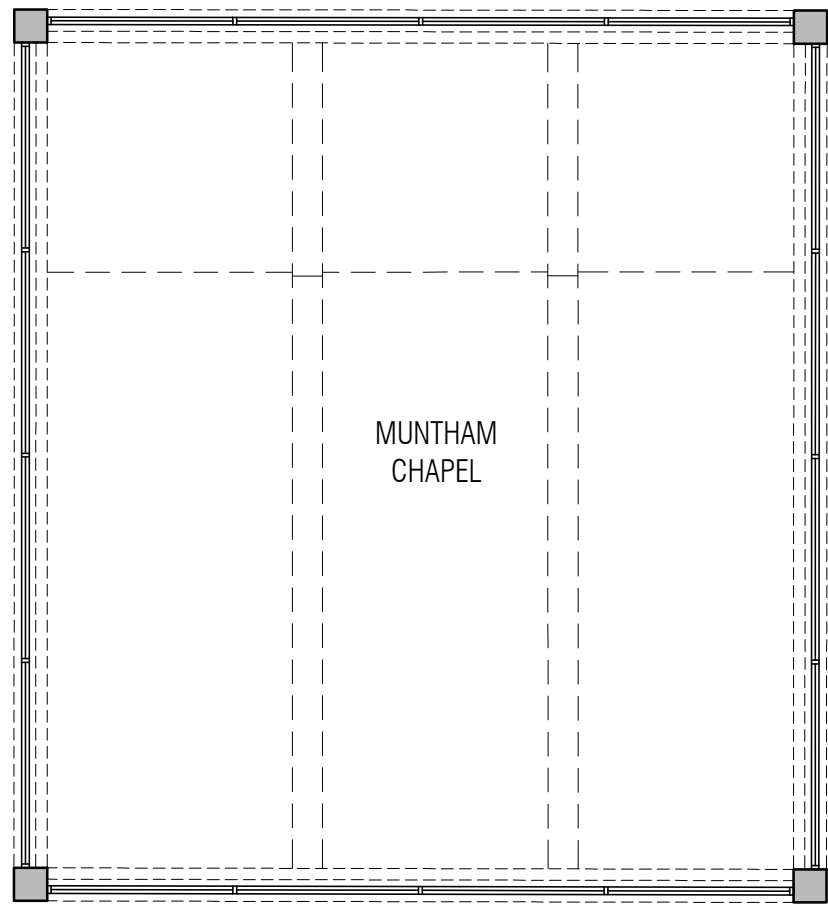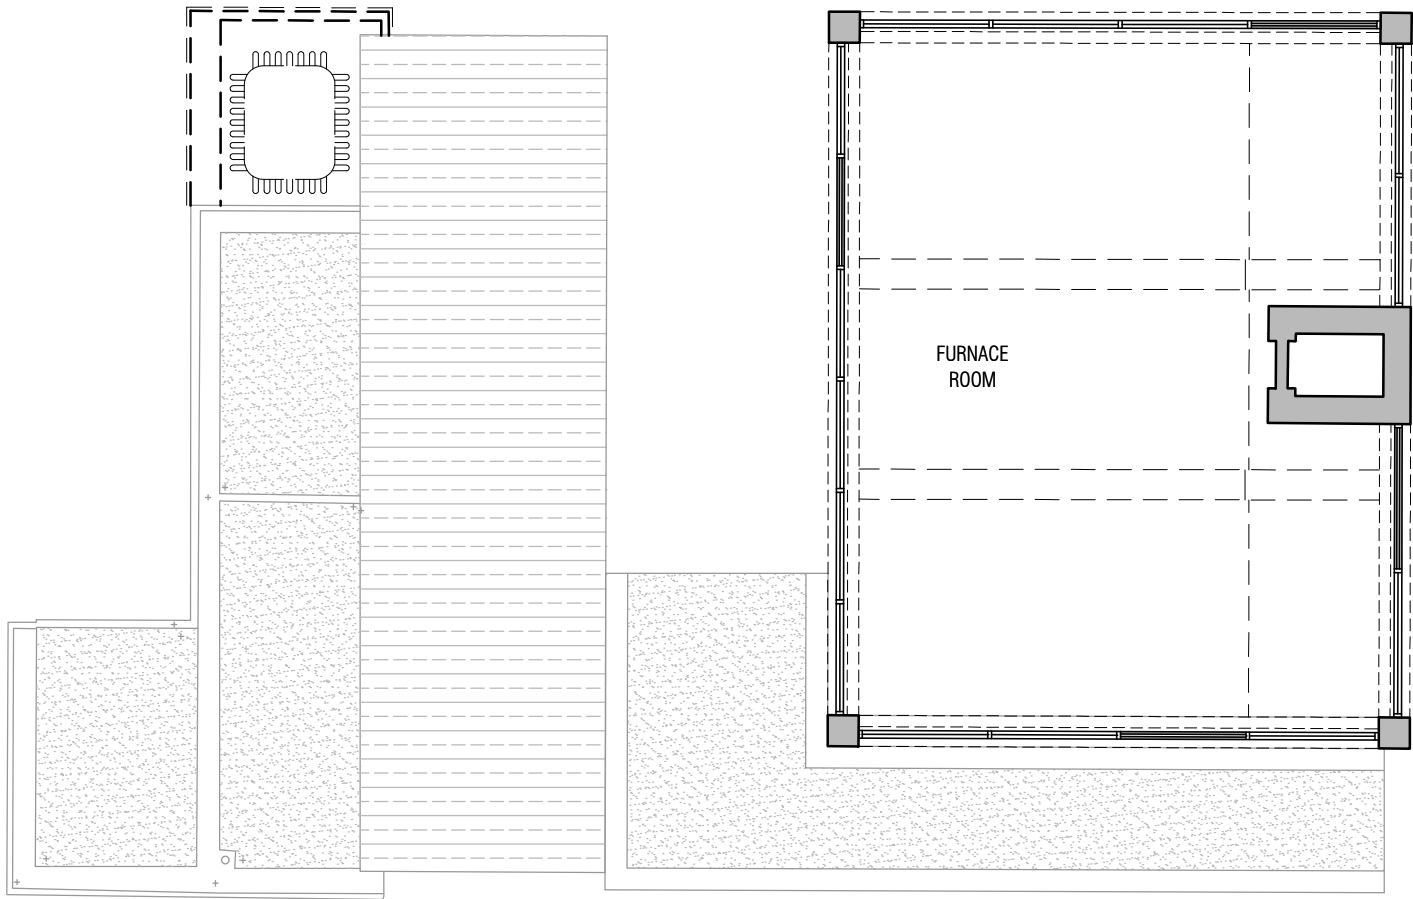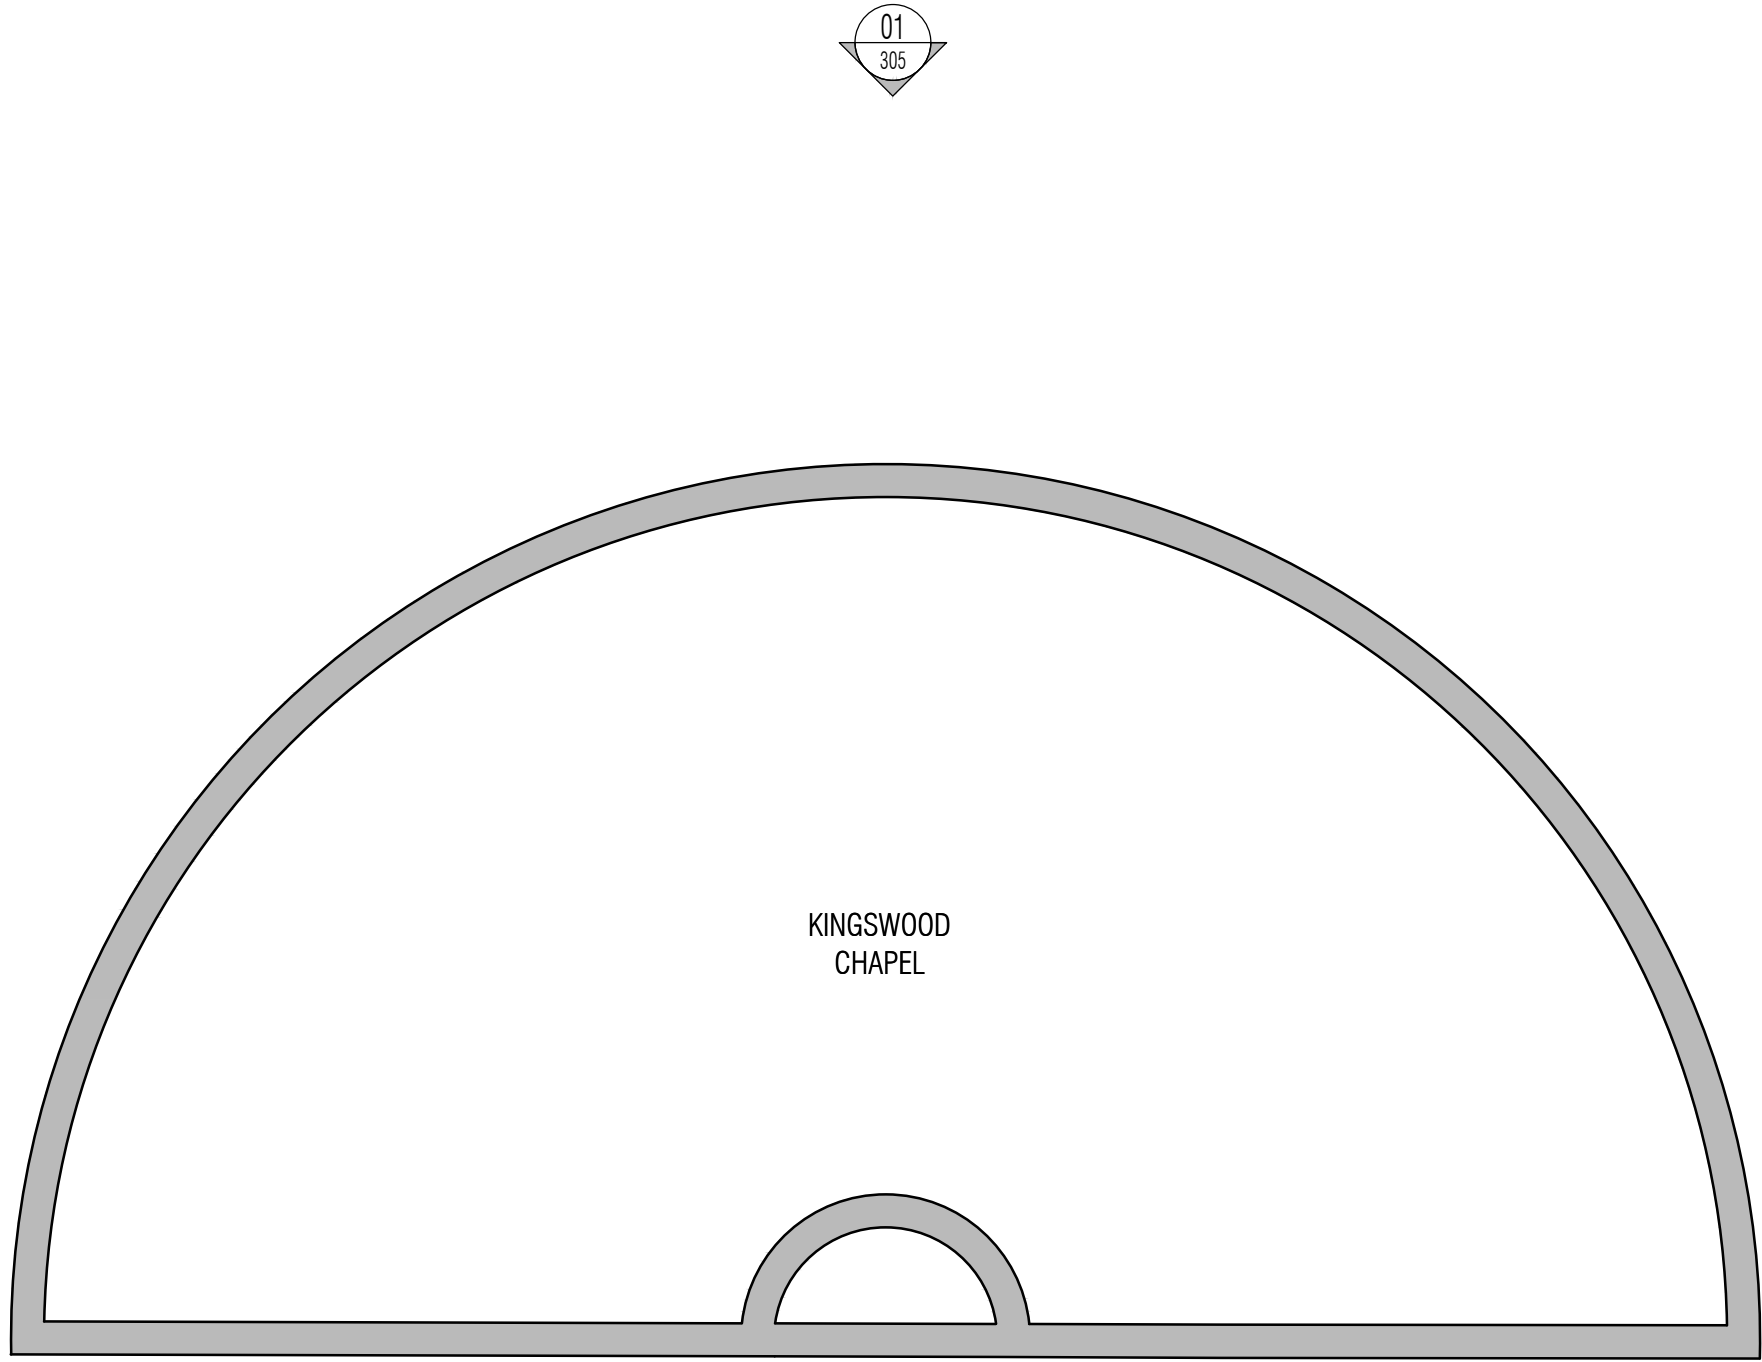

ISSUED FOR
CONSTRUCTION

All details referenced in call outs supercede general arrangement or larger depictions.

Rev	Date	By	Chk	Comment
C2	09.07.12	RKC	JAS	Issued for Construction
P4	01.06.12	RKC	JAS	Issued for Stage F
P3	01.05.12	RKC	JAS	Issued for New Planning Approval
C1	23.04.12	RKC	JAS	Issued for CONSTRUCTION

BRINGING IDEAS TO LIFE

FRANKHAM

Frankham Consultancy Group Limited
21 Perryman Road
Haywards Heath RH16 3TP
t 01444 444900 f 01444 455642
enquiries@frankham.com
www.frankham.com

Client

Mansell
Contract N°: Worthing

Project Title

Eastbourne & Worthing
Crematoria
Refurbishments and Alterations

Drawing Title

Worthing
Worthing Crematorium
Existing First Plan


Drawn by: RKC	Scale: 1:100@A1	Date: 19.01.12
Designed by: FCG	Checked by: JAS	Approved by: AC

File Ref.: X:\FRANKHAM\2_080512180 CREMATORIA\WORTHING\100 LOCATIONS PLANS AND GA\ 20.06.26.12.23.27

Drawing No. 521260-A-106-W	Rev. C2
-------------------------------	------------

NB: All information based on supplied third party survey information.
All discrepancies to be reported to FCG immediately upon discovery.



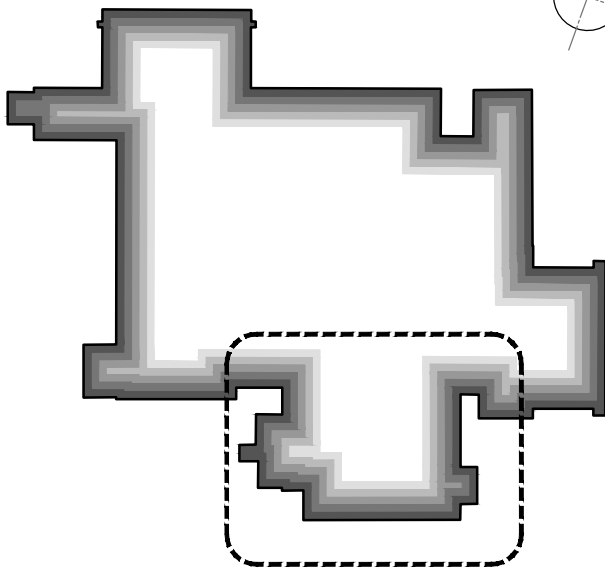

ISSUED FOR
CONSTRUCTION

BRINGING IDEAS TO LIFE

C1	29.03.12	RKC	JAS	Issued for CONSTRUCTION	
Rev	Date	By	Chk	Comment	



FRANKHAM

Frankham Consultancy Group Limited
21 Perrymount Road
Haywards Heath RH16 3TP
t 01444 444900 f 01444 455642
enquire@frankham.com
www.frankham.com

Client



Contract N°: MC0269

Project Title

Eastbourne & Worthing
Crematoria
Improvements and Alterations

Drawing Title



Eastbourne Crematorium
Ground Floor Demolition Plan

Drawn by:

RKC

Scale:

:100@A1

Date:

8.10.1

Designed by

checked by

proved

File Ref.: X:\FRANKHAM\Z-FILES\521260-CREMATORIA\ARCH100-199-LOCATION-PLANS-AND-GA,
521260-A-110-E.DWG - 200611121810 20-06-11-12:10:10

Drawing No.
521260-A-110-E

Rev
C-


NB: All information based on supplied third party survey information.
All discrepancies to be reported to FCG immediately upon discovery.

NB: Contractor to fully investigate and determine load bearing capacity of all building elements and materials and consult with Architect and Structural Engineer prior to commencement of demolition works. All discrepancies to be reported to FCG immediately upon discovery

NB: All waste to be recycled where possible and/or disposed of in accordance with the Contractor's Site Waste Management Plan and all in accordance with current legislation, particularly, but not excluding, all hazardous materials

- Existing boiler to be decommissioned and all supplies to be terminated and made safe in accordance with M&E Engineer's design and specification
- Existing structural steelwork to be determined — nonloadbearing and removed in accordance with Structural Engineer's design and specification
- Existing drainage channel to be decommissioned and sealed in accordance with Civil Engineer's design and specification
- Remove existing timber double doors and send for — recycling in accordance with SWMP

Refer to Dwg
521260-L-110-E
for External Works

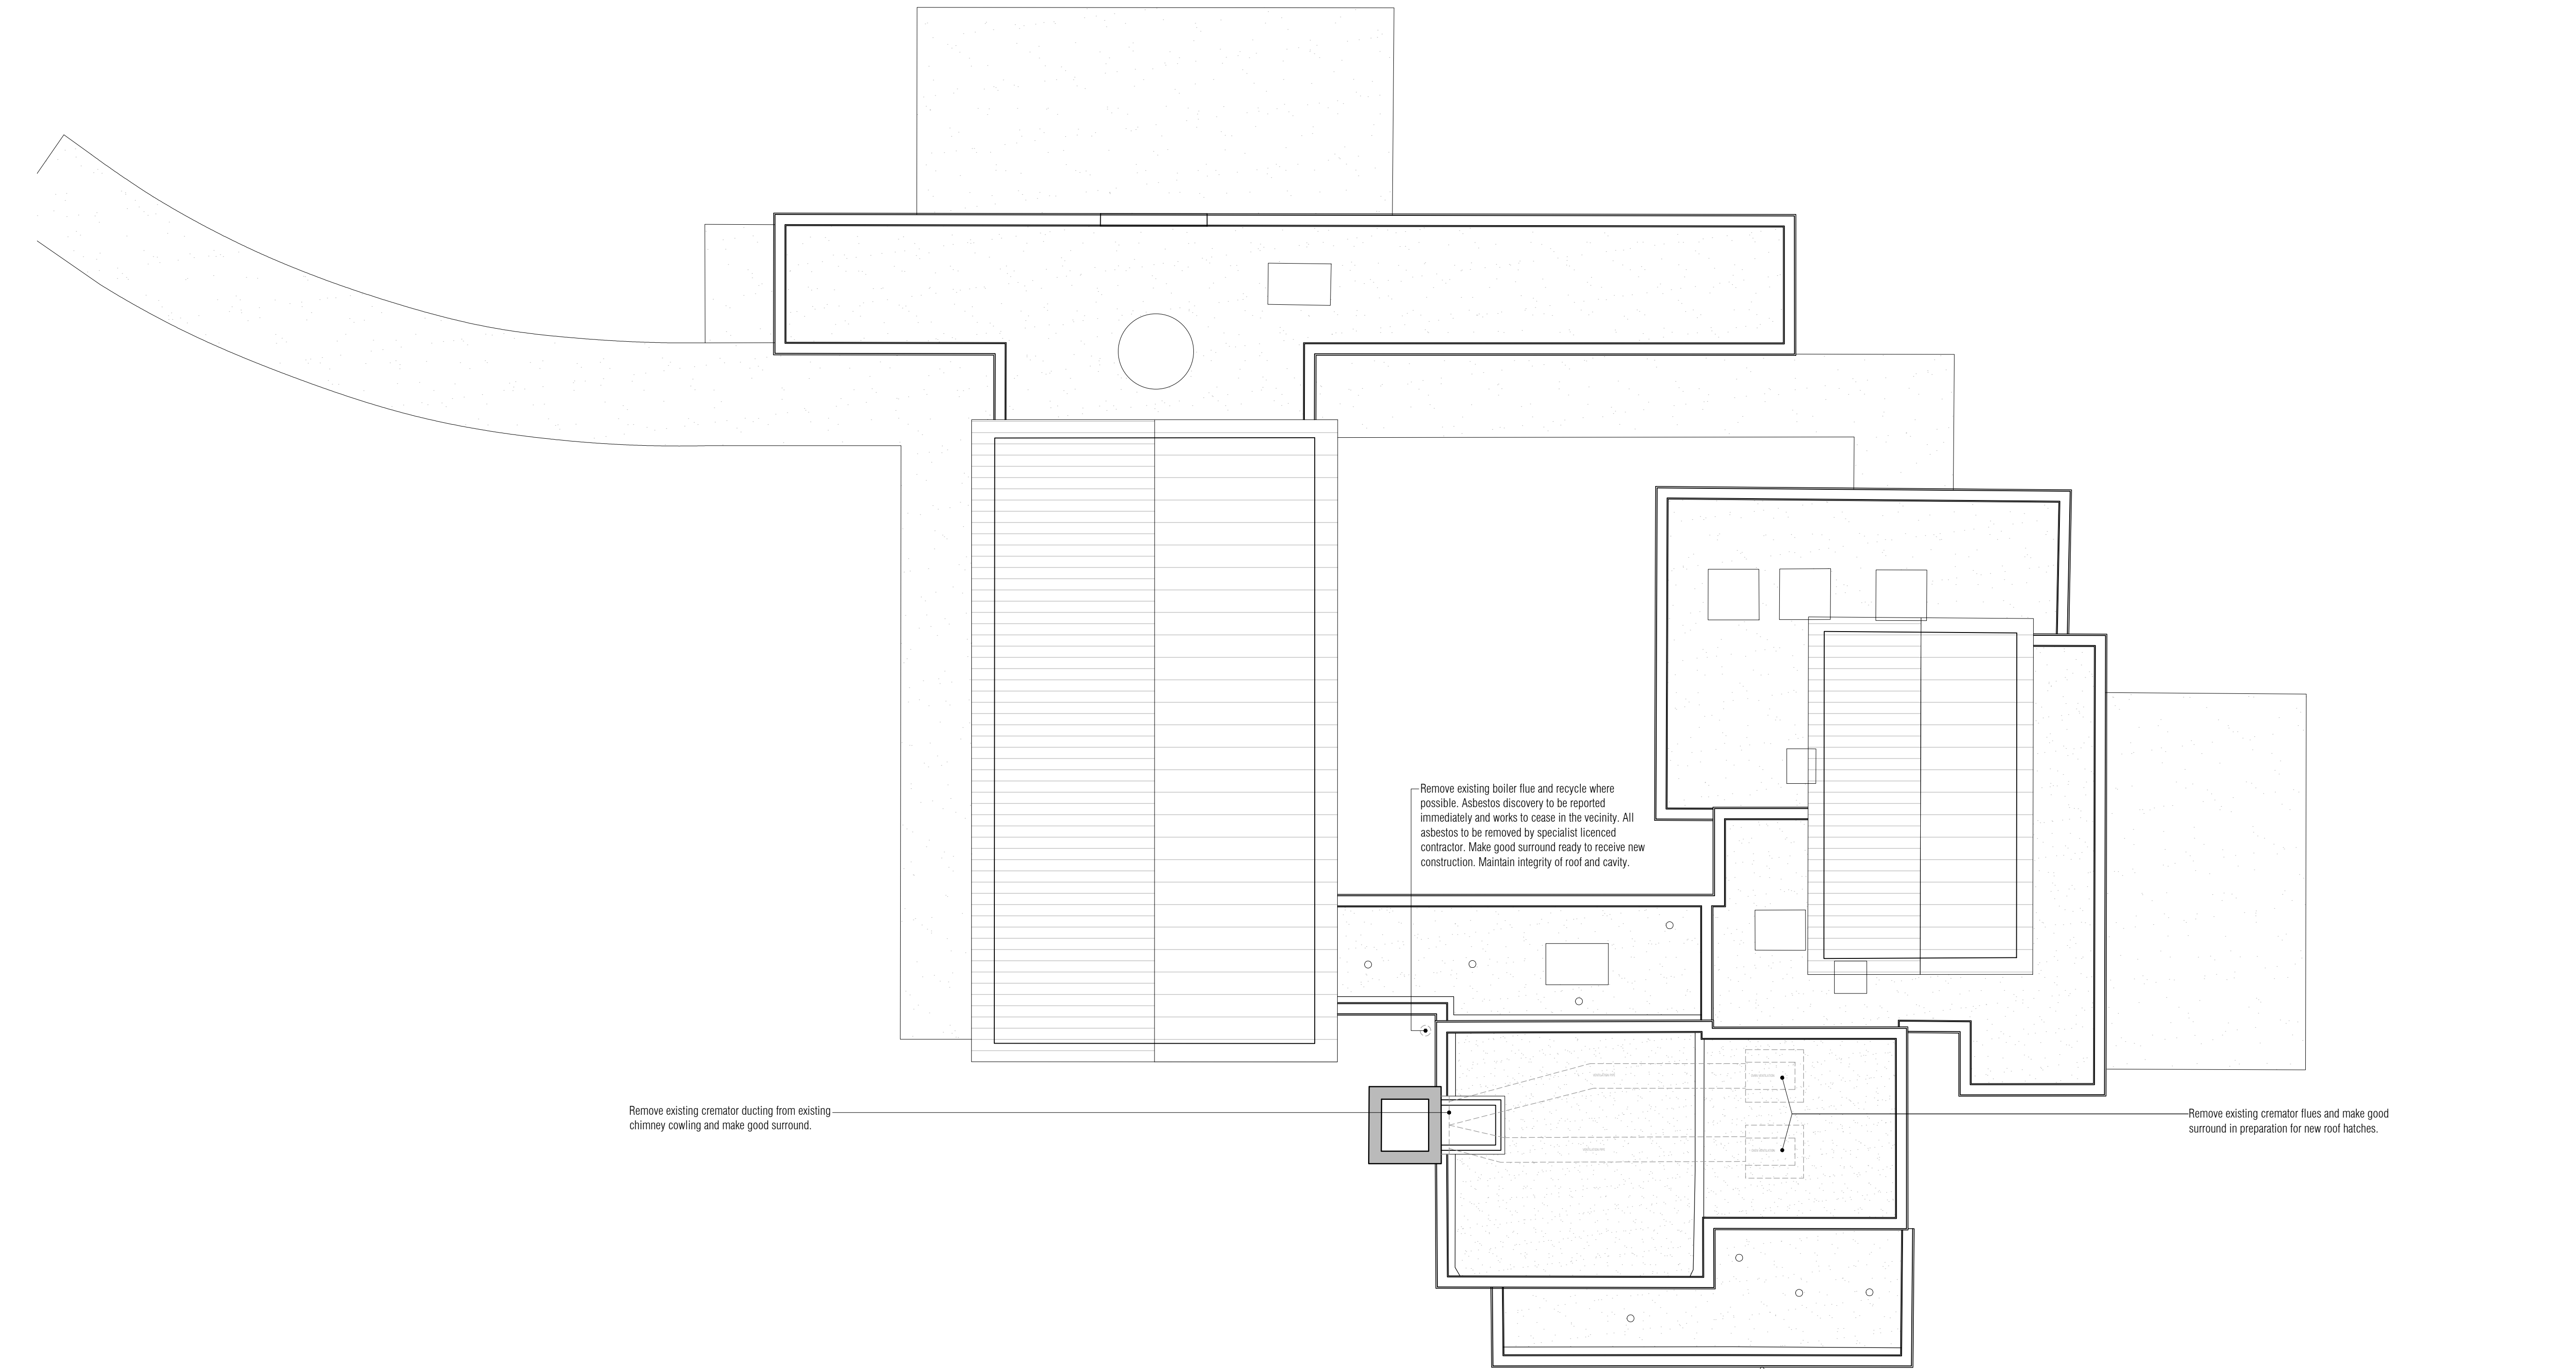

NB: All information based on supplied third party survey information. All discrepancies to be reported to FCG immediately upon discovery.

NB: Contractor to fully investigate and determine load bearing capacity of all building elements and materials and consult with Architect and Structural Engineer prior to commencement of demolition works. All discrepancies to be reported to FCG immediately upon discovery.

NB: All waste to be recycled where possible and/or disposed of in accordance with the Contractor's Site Waste Management Plan and all in accordance with current legislation, particularly, but not excluding, all hazardous materials

NOTES: Do not scale this drawing. All dimensions to be checked on site prior to commencement or manufacture.

Key Plan (nts)

ISSUED FOR CONSTRUCTION

All details referenced in call outs supersede general arrangement or larger depictions.

Rev	Date	By	Chk	Comment
C1	29.03.12	RKC	JAS	Issued for CONSTRUCTION

BRINGING IDEAS TO LIFE



FRANKHAM

Frankham Consultancy Group Limited
21 Pymme Road
Haywards Heath RH16 3TP
t 01444 444900 f 01444 455642
enquire@frankham.com
www.frankham.com

Client



Mansell

Contract N°: MC0269

Project Title

Eastbourne & Worthing
Crematoria
Refurbishments and Alterations

Drawing Title



Eastbourne Crematorium
Roof Demolition Plan

Drawn by: RKC	Scale: 1:100@A1	Date: 18.10.11
Designed by: FCG	Checked by: JAS	Approved by: AC

File Ref.: X:\FRANKHAM\2_080512180 CREMATORIA\WORK\100-100 LOCATION PLANS AND GA\ 307380-A-113-E.DWG - 290611121020


20.06.11 12:10:21

Drawing No. 521260-A-113-E	Rev. C1
-------------------------------	------------



NB: All information based on supplied third party survey information.
All discrepancies to be reported to FCG immediately upon discovery.

NB: Contractor to fully investigate and determine load bearing capacity of all building elements and materials and consult with Architect
and Structural Engineer prior to commencement of demolition works. All discrepancies to be reported to FCG immediately upon discovery.

NB: All waste to be recycled where possible and/or disposed of in accordance with the Contractor's Site Waste
Management Plan and all in accordance with current legislation, particularly, but not excluding, all hazardous materials

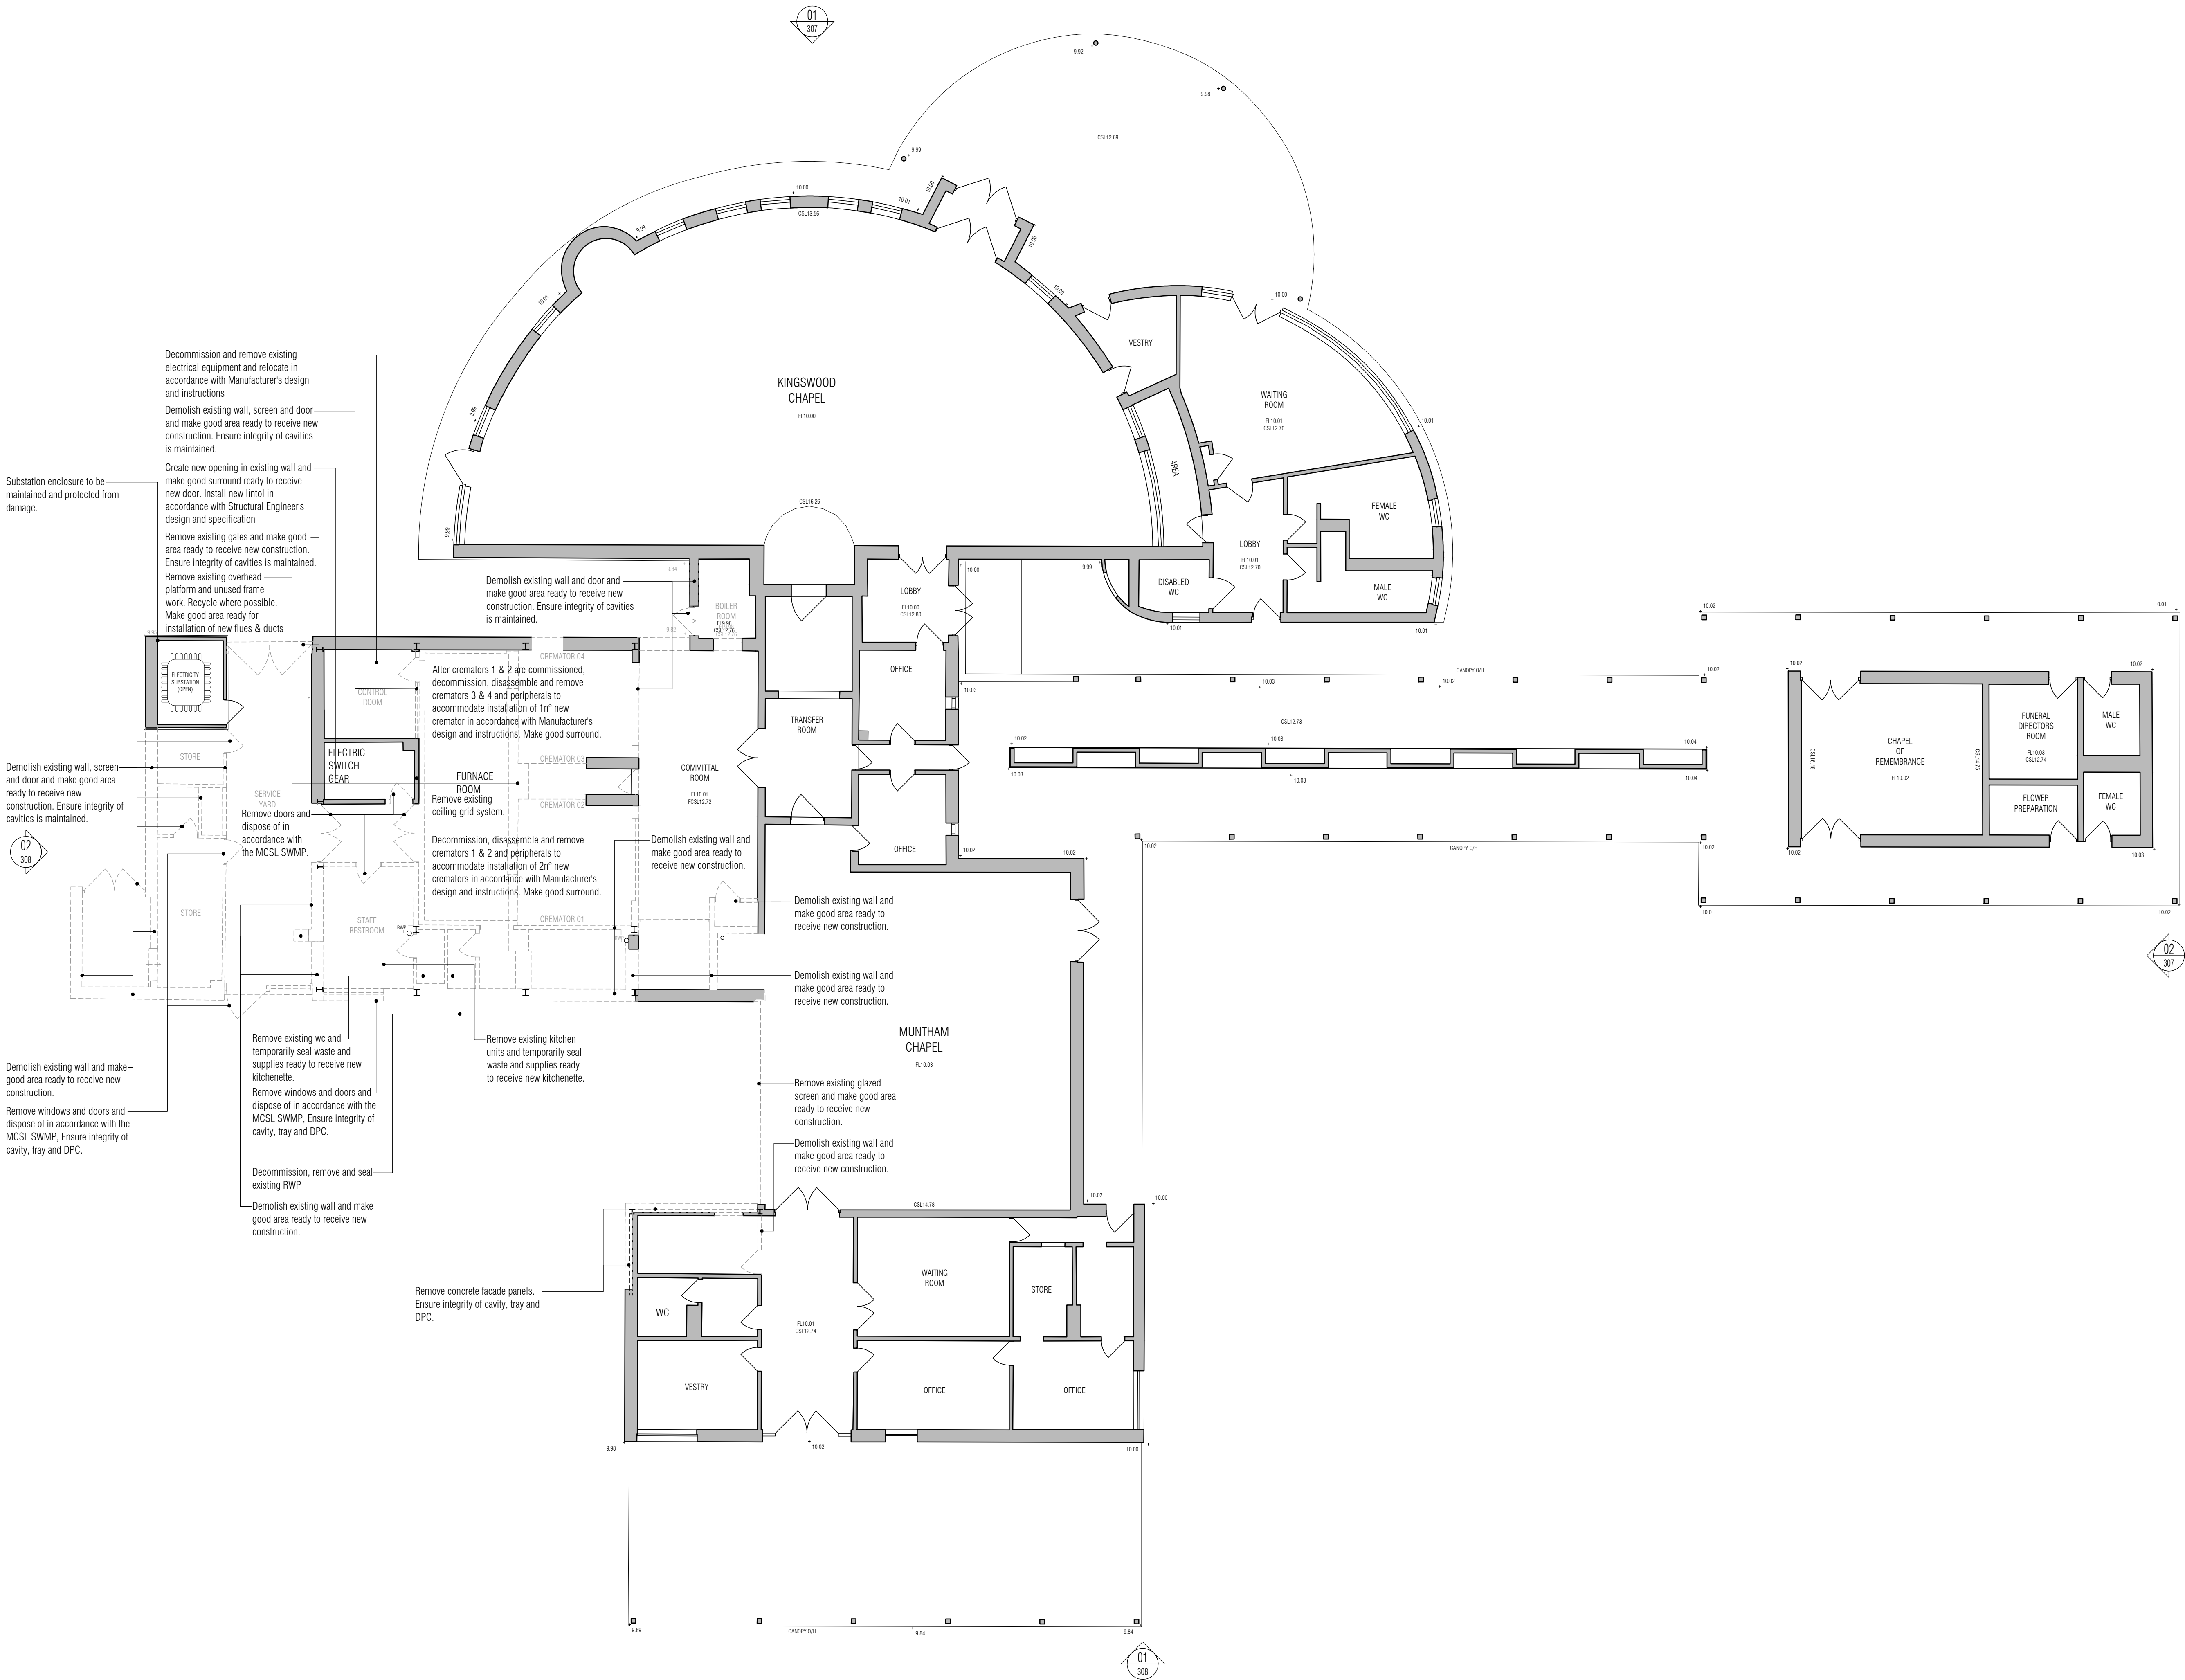

NOTES: Do not scale this drawing. All dimensions to be checked on site prior to commencement or manufacture.
Key Plan (nts)

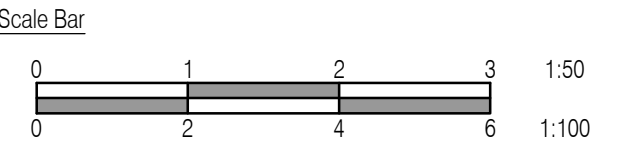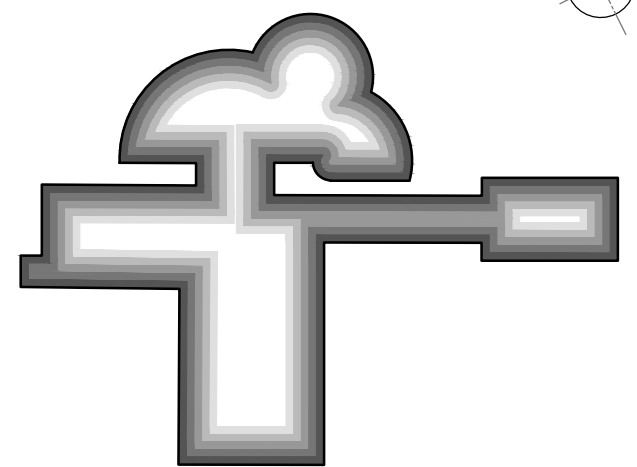

ISSUED FOR CONSTRUCTION

All details referenced in call outs supersede general arrangement or larger depictions.

Rev	Date	By	Chk	Comment
C3	20.09.12	RKC	JAS	Cleaners cup/Ash store revd
C2	09.07.12	RKC	JAS	Issued for Construction
P5	01.06.12	RKC	JAS	Issued for Stage F
P4	01.05.12	RKC	JAS	Issued for New Planning Application
C1	23.04.12	RKC	JAS	Issued for CONSTRUCTION

BRINGING IDEAS TO LIFE



FRANKHAM

Frankham Consultancy Group Limited
21 Perryman Road
Haywards Heath RH16 3TP
t 01444 444900 f 01444 455642
enquire@frankham.com
www.frankham.com

Client
Mansell
Contract N°: Worthing

Project Title
Eastbourne & Worthing
Crematoria
Refurbishments and Alterations


Drawing Title
Worthing
Worthing Crematorium
Ground Floor Demolition Plan

Drawn by: RKC	Scale: 1:100@A1	Date: 18.10.11
Designed by: FCG	Checked by: JAS	Approved by: AC

File Ref.: 521260-A-115-W-0000 - 200611121025

Drawing No. 521260-A-115-W	Rev. C3
-------------------------------	------------



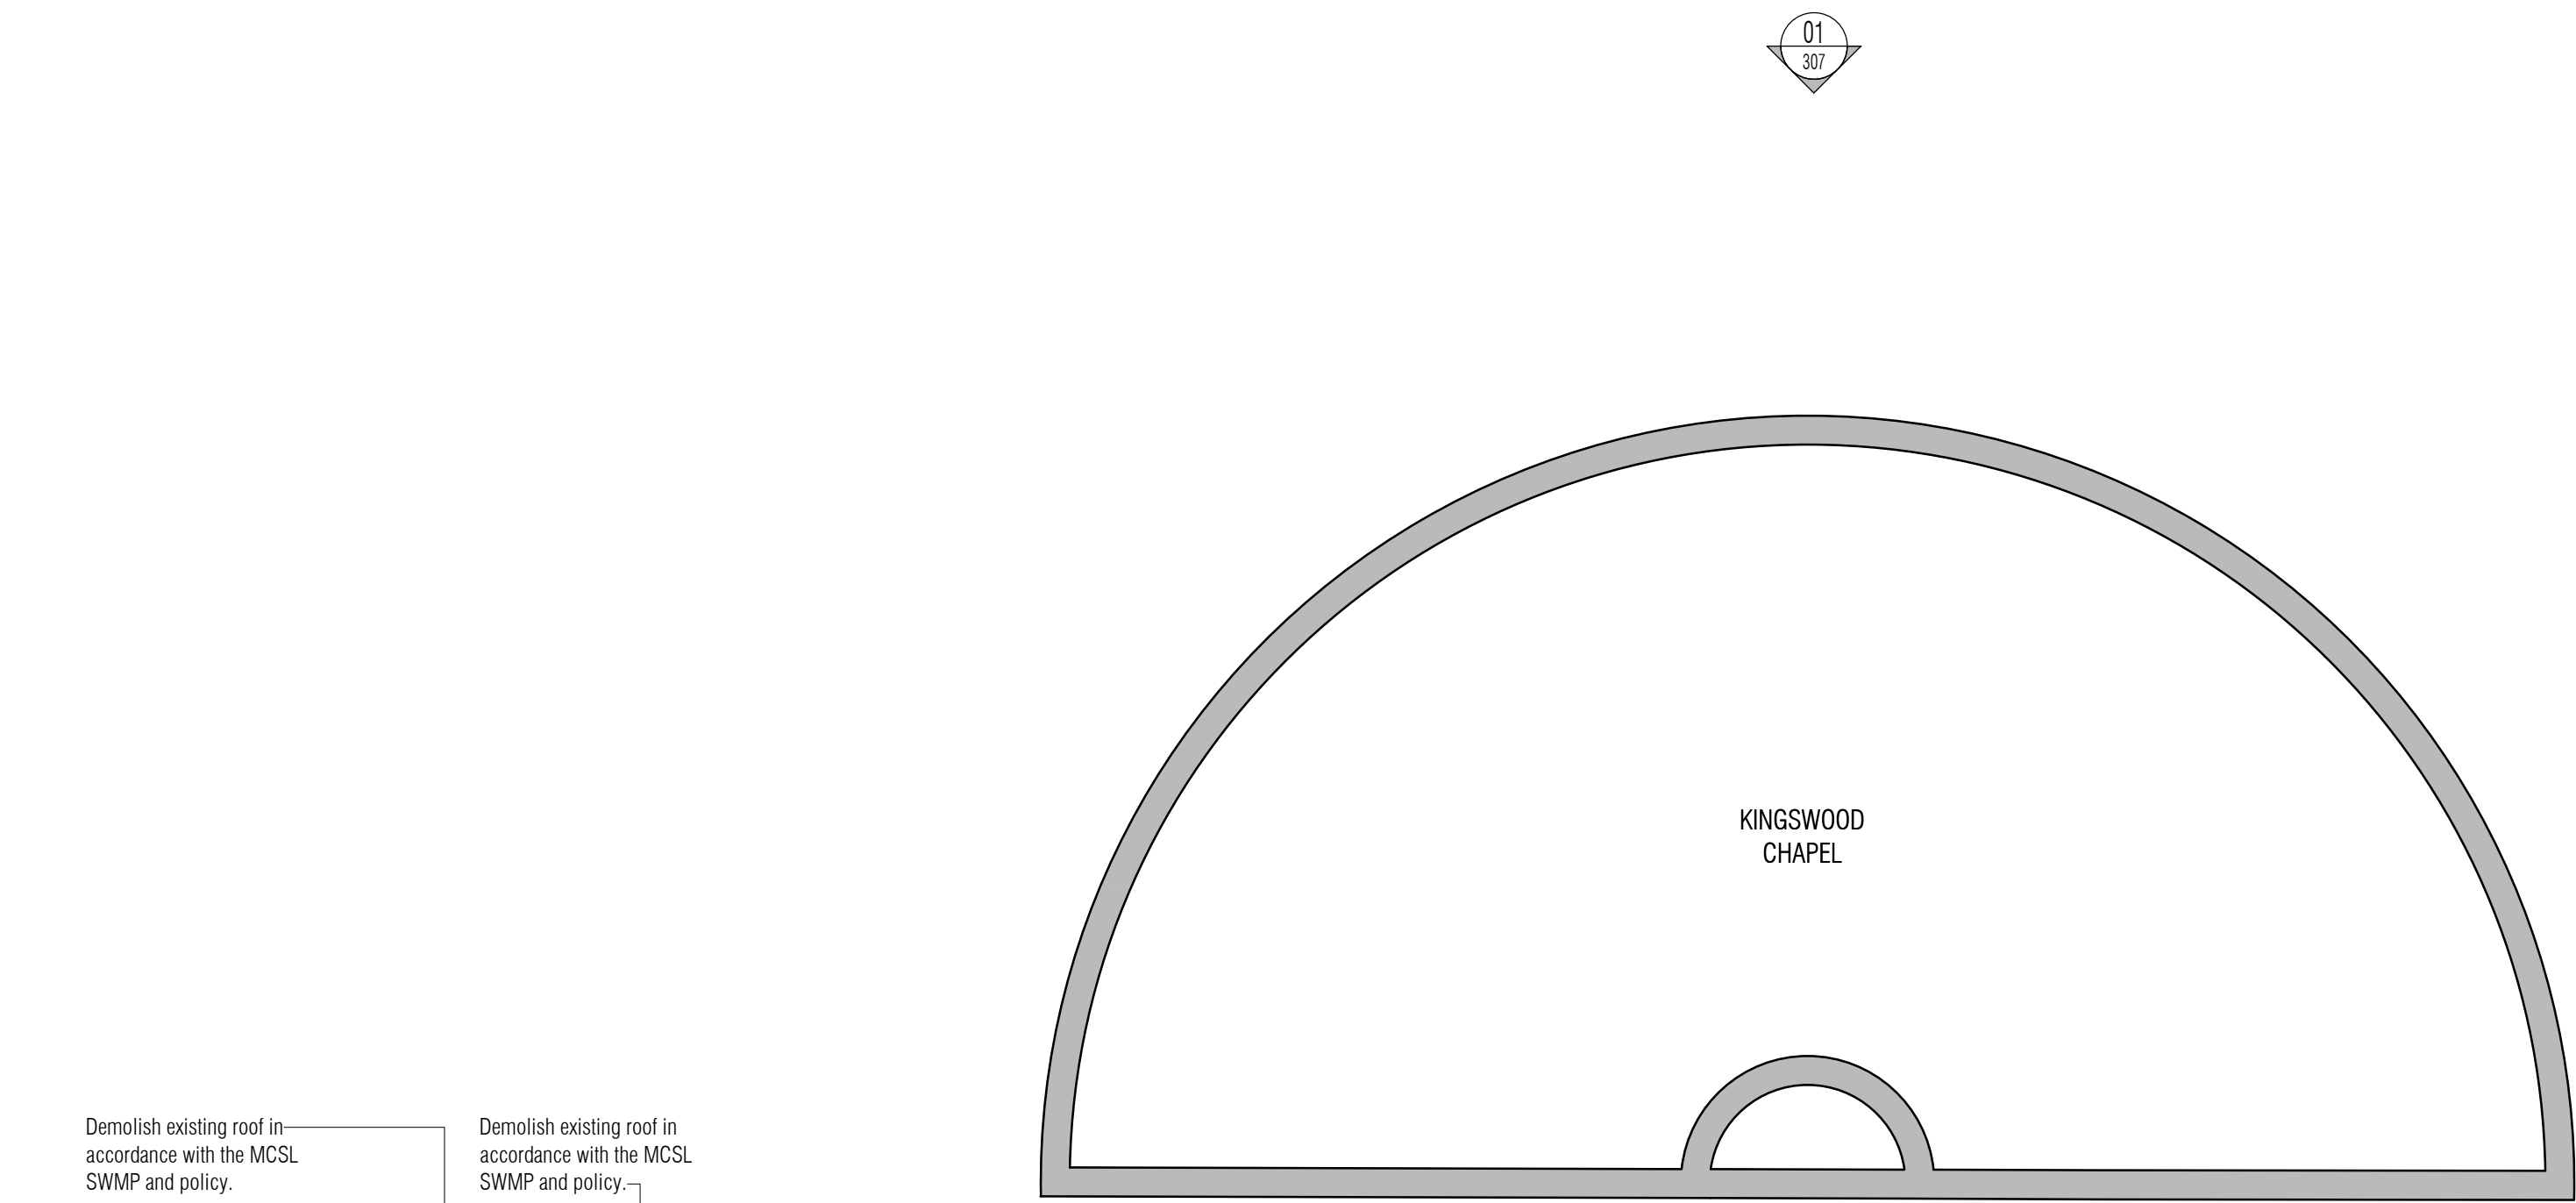


Demolish existing roof in accordance with the MCSL SWMP and policy.

Demolish existing roof in accordance with the MCSL SWMP and policy.

Demolish existing roof in accordance with the MCSL SWMP and policy.

02
308

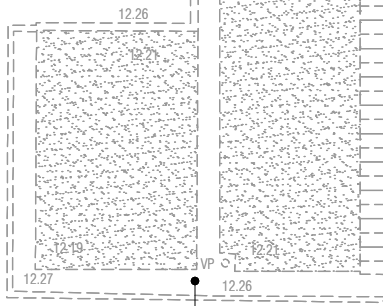



Demolish existing roof in accordance with the MCSL SWMP and policy.

Demolish existing roof in accordance with the MCSL SWMP and policy.


Demolish existing roof in accordance with the MCSL SWMP and policy.

Remove existing window in accordance with the MCSL SWMP and policy. Make good surround.


Demolish existing external skin of wall in accordance with the MCSL SWMP and policy. Make good, ready to receive new construction

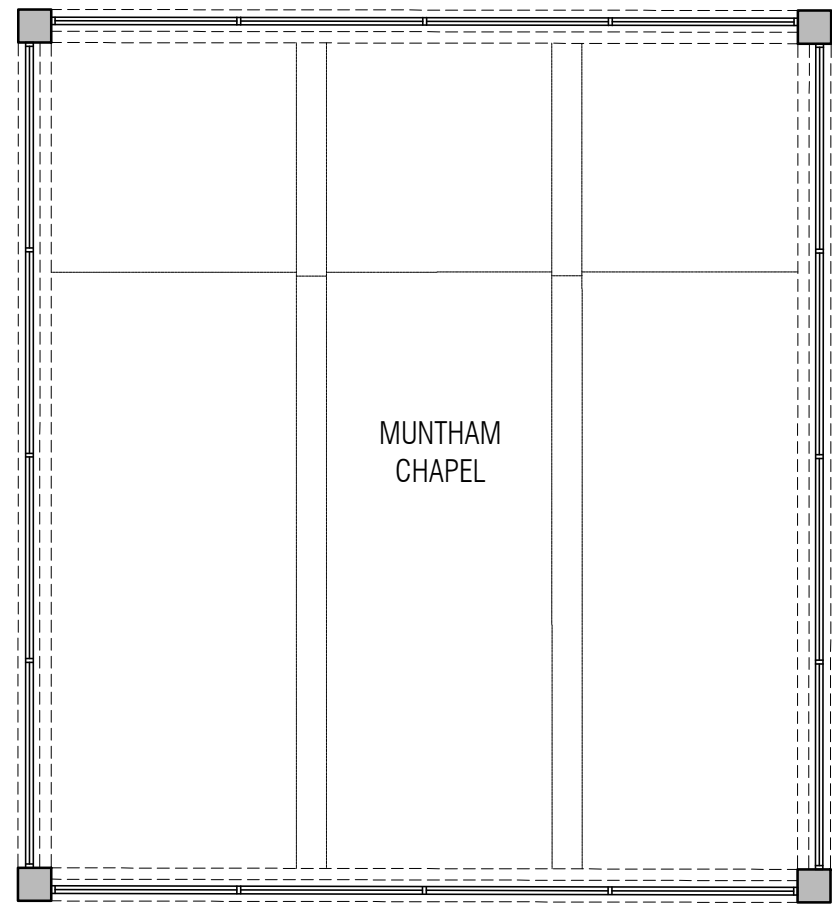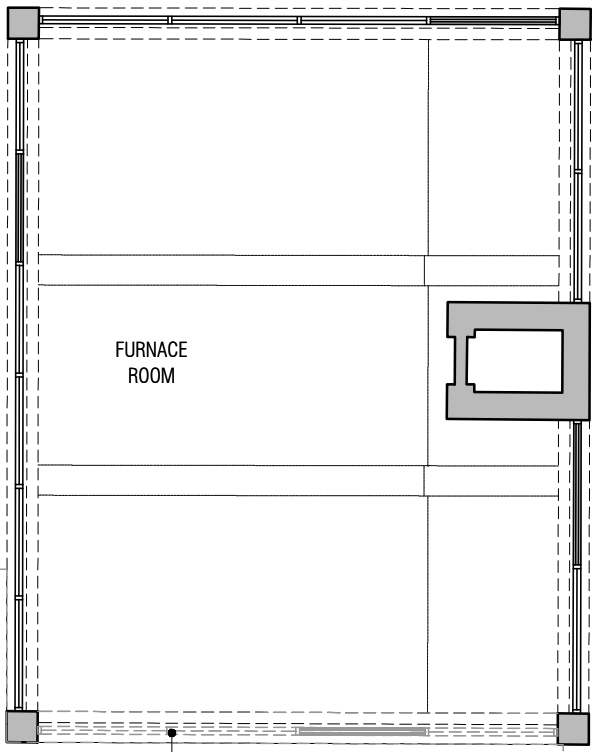

01
308

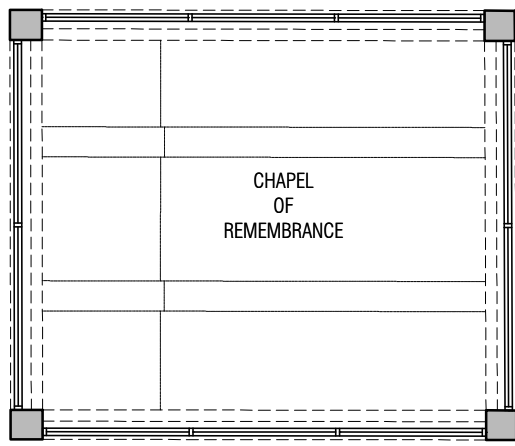

NOTES: Do not scale this drawing. All dimensions to be checked on site prior to commencement or manufacture.
Key Plan (nts)

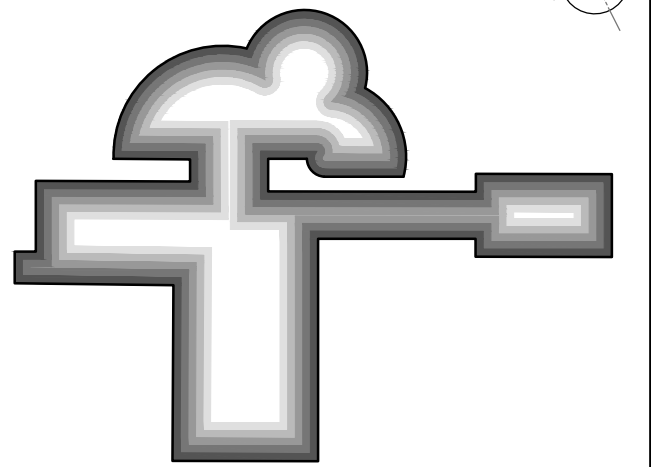

Scale Bar
0 1 2 3 1:50
0 2 4 6 1:100

ISSUED FOR CONSTRUCTION

All details referenced in call outs supercede general arrangement or larger depictions.

Rev	Date	By	Chk	Comment
C2	09.07.12	RKC	JAS	Issued for Construction
P5	01.06.12	RKC	JAS	Issued for Stage F
P4	01.05.12	RKC	JAS	Issued for New Planning Application
C1	23.04.12	RKC	JAS	Issued for CONSTRUCTION

BRINGING IDEAS TO LIFE

FRANKHAM

Frankham Consultancy Group Limited
21 Perryman Road
Haywards Heath RH16 3TP
t 01444 444900 f 01444 455642
enquiries@frankham.com
www.frankham.com

Client
Mansell
Contract N°: Worthing

Project Title
Eastbourne & Worthing
Crematoria
Refurbishments and Alterations


Drawing Title
Worthing
Worthing Crematorium
First Floor Demolition Plan



Drawn by: RKC	Scale: 1:100@A1	Date: 19.01.12
Designed by: FCG	Checked by: JAS	Approved by: AC
File Ref.: 521260-A-116-W-0000 - 200811271030		20.06.11.12.10.28
Drawing No. 521260-A-116-W		Rev. C2

NB: All information based on supplied third party survey information.
All discrepancies to be reported to FCG immediately upon discovery.

NB: Contractor to fully investigate and determine load bearing capacity of all building elements and materials and consult with Architect and Structural Engineer prior to commencement of demolition works. All discrepancies to be reported to FCG immediately upon discovery.

NB: All waste to be recycled where possible and/or disposed of in accordance with the Contractor's Site Waste Management Plan and all in accordance with current legislation, particularly, but not excluding, all hazardous materials

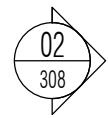

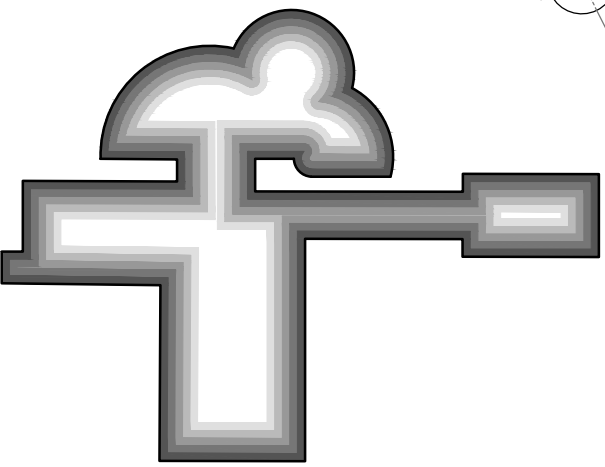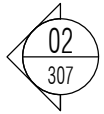

ISSUED FOR
CONSTRUCTION

3	10.07.12	RKC	JAS	Detail rets added
2	09.07.12	RKC	JAS	Issued for Construction
5	01.06.12	RKC	JAS	Issued for Stage F
4	01.05.12	RKC	JAS	Issued for New Planning Application
1	23.04.12	RKC	JAS	Issued for CONSTRUCTION
ev	Date	By	Chk	Comment



Frankham Consultancy Group Limited
21 Perrymount Road
Haywards Heath RH16 3TP
t 01444 444900 f 01444 455842
enquire@frankham.com
www.frankham.com



Eastbourne & Worthing
Crematoria
Imbursements and Alterations



Worthing
BOROUGH COUNCIL

9.01.1

proved


File Ref.: X:\FRANKHAMZ-JOBS\521260-CREMATORIUM\ARCH\100-199-LOCATION-PLANS-AND-GA,
521260-A-117-W.DWG - 200611121032 20:06:11:12:10:32

Rev
C3

NB: Contractor to fully investigate and determine load bearing capacity of all building elements and materials and consult with Architect and Structural Engineer prior to commencement of demolition works. All discrepancies to be reported to FCG immediately upon discovery.

NB: All waste to be recycled where possible and/or disposed of in accordance with the Contractor's Site Waste Management Plan and all in accordance with current legislation, particularly, but not excluding, all hazardous materials

NB: All levels are approximate and are subject to further site investigation prior to construction. All discrepancies to be reported to FCG immediately

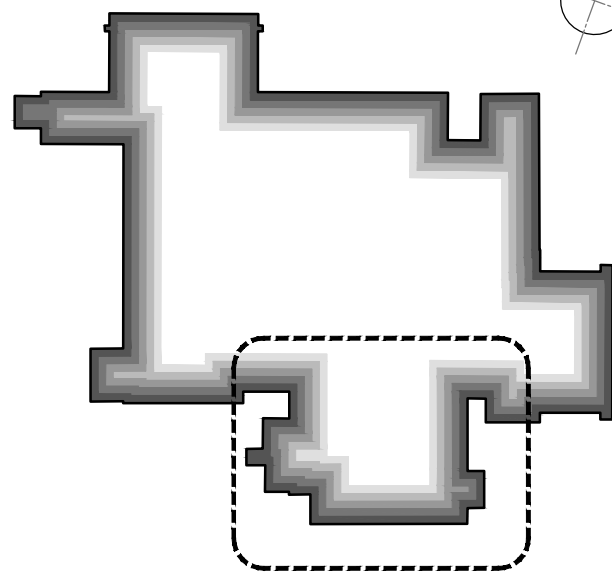

1. All square ductwork ventilation holes to be sized and set-out in accordance with the Structural Engineer's drawings - this shown on this drawing relate to these holes over-head.
2. All holes set-out on this drawing for drainage are dimensioned to the centre of the holes - all hole diameters to be as confirmed by the Mechanical Engineer's drawings, and to the satisfaction of the Structural Engineer.
3. Dashed lines indicate pipe-routes tracking from hole / outlet positions at floor above. For final exact routing requirements, refer to Mechanical and Electrical Engineer's design drawings.
4. All concrete / steelwork shown indicative sizes / locations only, and to be confirmed by Structural Engineer.
5. All structural information generally to be in accordance with the Structural Engineer's drawings and specifications.
6. Plant layouts shown here are taken directly from the Mechanical and Electrical Engineers, or Specialist Sub-contractor's design drawings; and are therefore included for reference only.
7. All mechanical, electrical, plumbing and ventilation information to be in accordance with Mechanical and Electrical Engineer's design, details and specification.
8. For references to soil + vent pipes / rain water pipes / sub-stacks / gullies / drains / downpipes / etc. refer to the Mechanical and Electrical Engineer's design drawings.
9. All screed butting existing masonry walls which have been removed, to be made good and level to match existing.

ISSUED FOR
CONSTRUCTION

[illegible]

Frankham Consultancy Group Limited
21 Perrymount Road
Haywards Heath RH16 3TP
t 01444 444900 f 01444 455642
enquire@frankham.com
www.frankham.com


Mansell
A Southern Company
Contract N°: MC02

Eastbourne & Worthing
Crematoria
Furnishments and Alterations

EASTBOURNE
Borough Council

Eastbourne Crematorium
Lower Ground Floor
Builder's Works Plan

11 11 11

proved b


AC

20:06:11:12:10:35

Rev.
C1


NB: Contractor to fully investigate and determine load bearing capacity of all building elements and materials and consult with Architect and Structural Engineer prior to commencement of demolition works. All discrepancies to be reported to FCG immediately upon discovery.

NB: All waste to be recycled where possible and/or disposed of in accordance with the Contractor's Site Waste Management Plan and all in accordance with current legislation, particularly, but not excluding, all hazardous materials

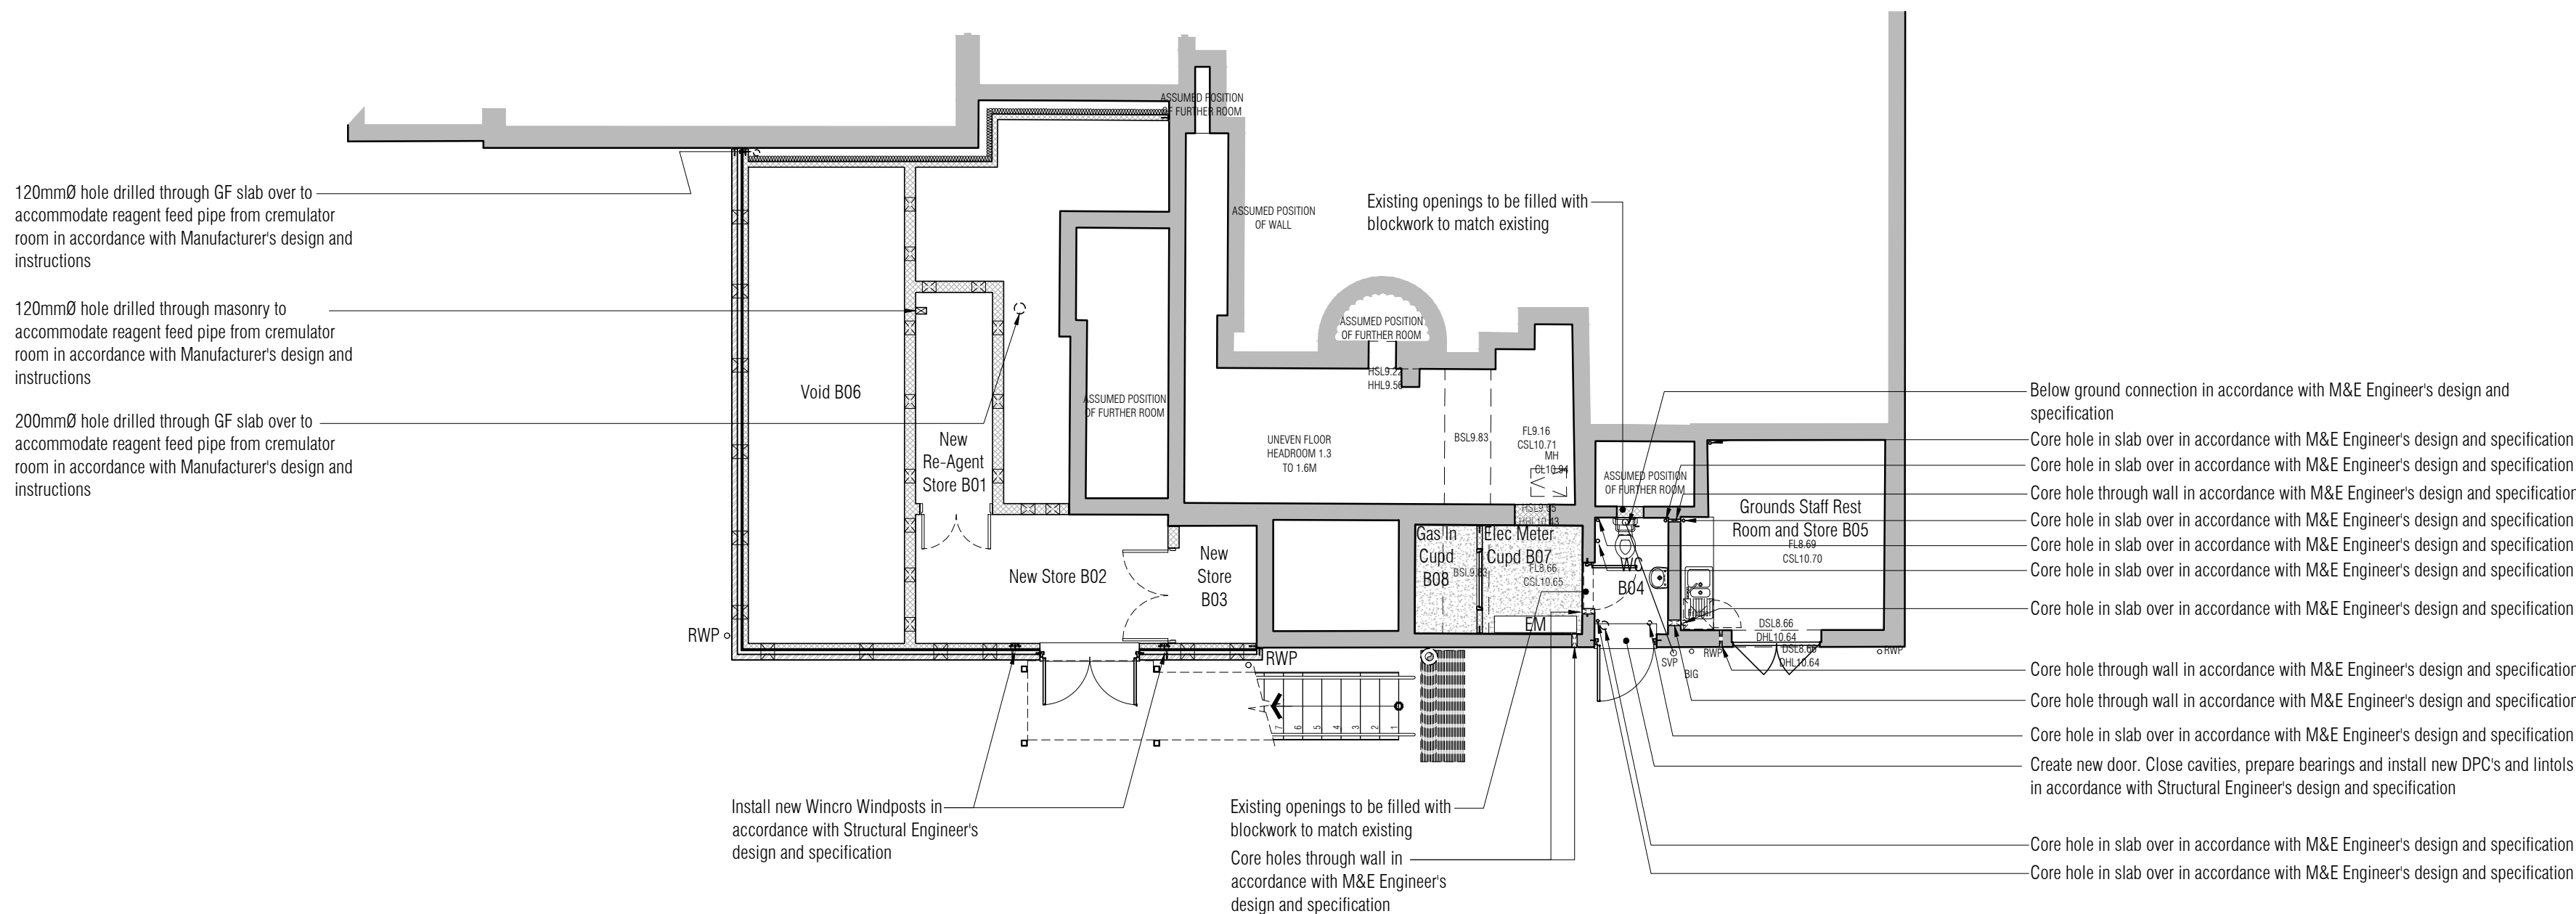

All builders works (cutting, coring, penetrating, etc.) to be in accordance with M&E Engineers dwgs. No builders works to proceed without confirmation by Structural Engineer to maintain integrity of structure. NB: All levels are approximate and are subject to further site investigation prior to construction. All discrepancies to be reported to FCG immediately

NOTES: Do not scale this drawing. All dimensions to be checked on site prior to commencement or manufacture.
Key Plan (nts)

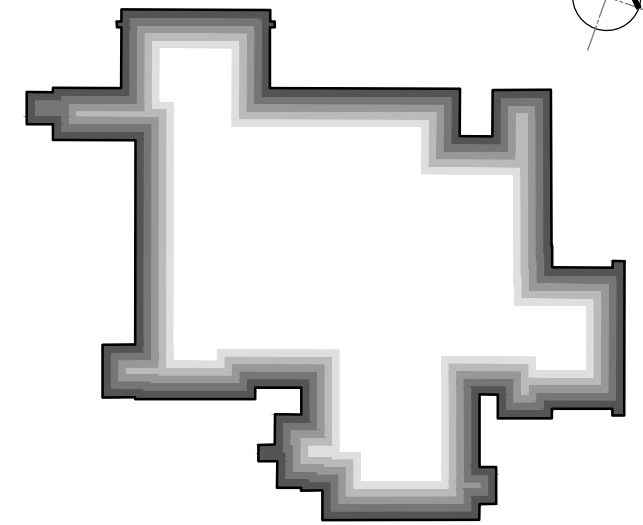

- General Builders Works Notes
1. All square ductwork ventilation holes to be sized and set-out in strict accordance with the Structural Engineer's drawings - those shown on this drawing relate to those holes over-head.
 2. All holes set-out on this drawing for drainage are dimensioned to the centre of the holes - all hole diameters to be as confirmed by the Mechanical Engineer's drawings, and to the satisfaction of the Structural Engineer.
 3. Dashed lines indicate pipe-routes tracking from hole / outlet positions at floor above. For final 'exact' routing requirements, refer to Mechanical and Electrical Engineer's design drawings.
 4. All concrete / steelwork shown indicative sizes / locations only, and to be confirmed by Structural Engineer.
 5. All structural information generally to be in accordance with Structural Engineer's design, details and specification.
 6. Plant layouts shown here are taken directly from the Mechanical and Electrical Engineer's, or Specialist Sub-contractor's design drawings; and are therefore included for reference only.
 7. All mechanical, electrical, plumbing and ventilation information to be in accordance with Mechanical and Electrical Engineer's design, details and specification.
 8. For references to soil + vent pipes / rain water pipes / stub-stacks / gulleys / drainage channels / etc; refer to the Mechanical and Electrical Engineer's design drawings.
 9. All screed butting existing masonry walls which have been removed, to be made good and level to match existing.

ISSUED FOR CONSTRUCTION

All details referenced in call outs supersede general arrangement or larger depictions.

Rev	Date	By	Chk	Comment
C1	29.03.12	RKC	JAS	Issued for CONSTRUCTION

BRINGING IDEAS TO LIFE



FRANKHAM

Frankham Consultancy Group Limited
21 Perryman Road
Haywards Heath RH16 3TP
t 01444 444900 f 01444 455642
enquire@frankham.com
www.frankham.com

Client
Mansell
Contract N°: MC0269


Project Title
Eastbourne & Worthing
Crematoria
Refurbishments and Alterations

Drawing Title
EASTBOURNE
Eastbourne Crematorium
Ground Floor
Builders Works Plan


Drawn by: RKC	Scale: 1:100@A1	Date: 01.11.11
Designed by: FCG	Checked by: JAS	Approved by: AC

File Ref.: X:\FRANKHAM\2_08512780 CREMATORIA\ARCH\100-100 LOCATIONS PLANS AND DWG
307380-A-121-0-00 - 290611121040

Drawing No. 521260-A-121-E	Rev. C1
-------------------------------	------------

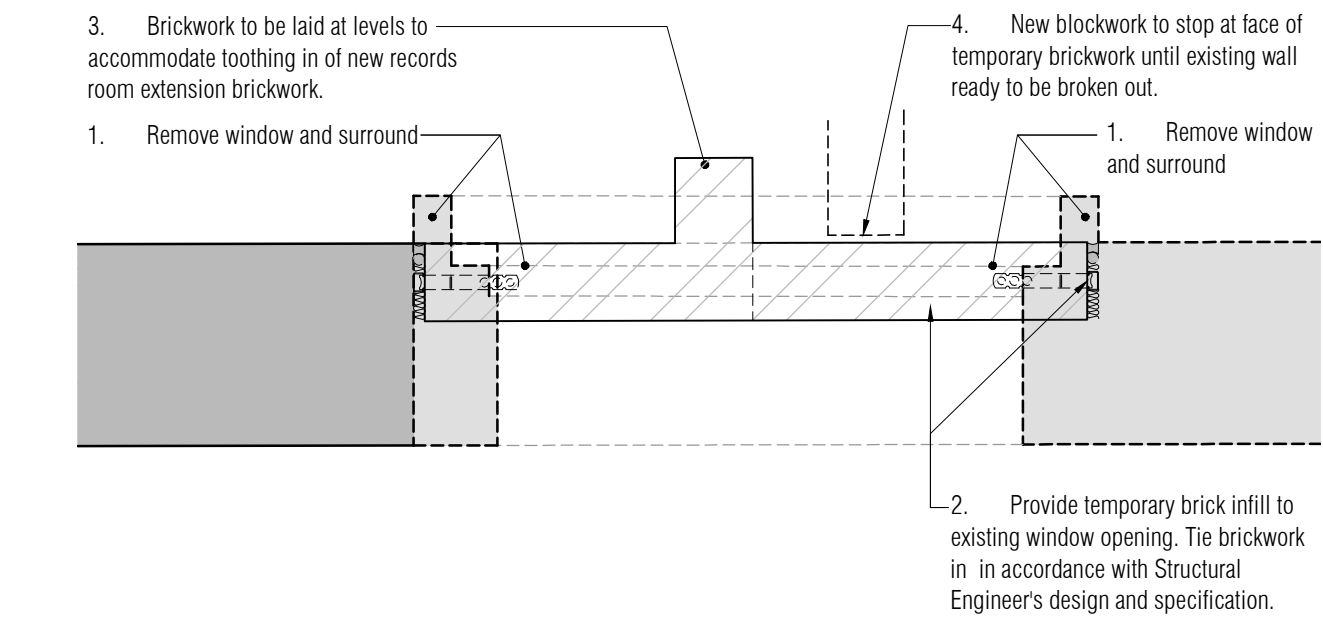

02 PRE-Demolition Wall Tie Phasing Detail 01
Scale: 1:10

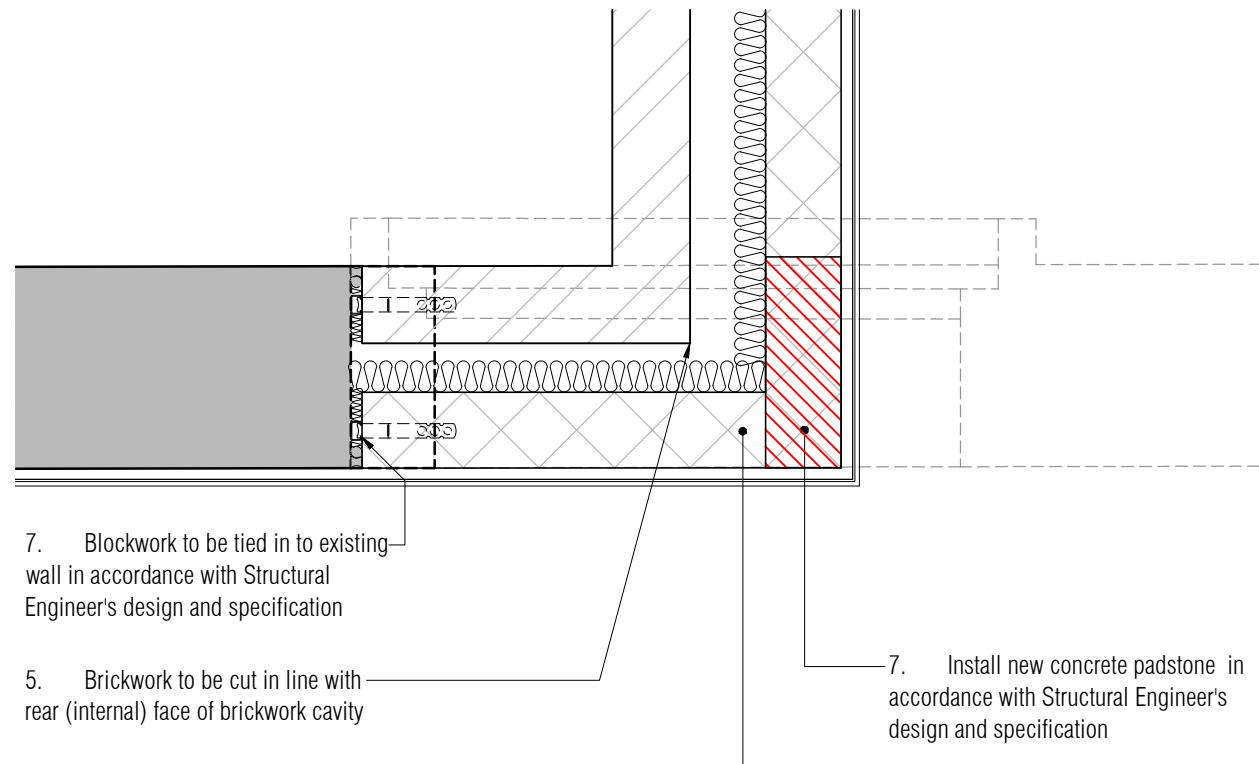

03 POST-Demolition Wall Tie Phasing Detail 02
Scale: 1:10


NB: All information based on supplied third party survey information. All discrepancies to be reported to FCG immediately upon discovery.

NB: Contractor to fully investigate and determine load bearing capacity of all building elements and materials and consult with Architect and Structural Engineer prior to commencement of demolition works. All discrepancies to be reported to FCG immediately upon discovery.

01 Ground Floor Builders Works Plan
Scale: 1:100


NB: All waste to be recycled where possible and/or disposed of in accordance with the Contractor's Site Waste Management Plan and all in accordance with current legislation, particularly, but not excluding, all hazardous materials

NB: All levels are approximate and are subject to further site investigation prior to construction. All discrepancies to be reported to FCG immediately

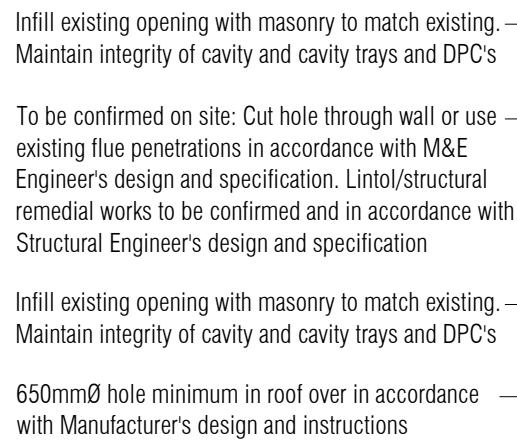

NB: Contractor to fully investigate and determine load bearing capacity of all building elements and materials and consult with Architect and Structural Engineer prior to commencement of demolition works. All discrepancies to be reported to FCG immediately upon discovery.

NOTES: Do not scale this drawing. All dimensions to be checked on site prior to commencement or manufacture.
Key Plan (nts)

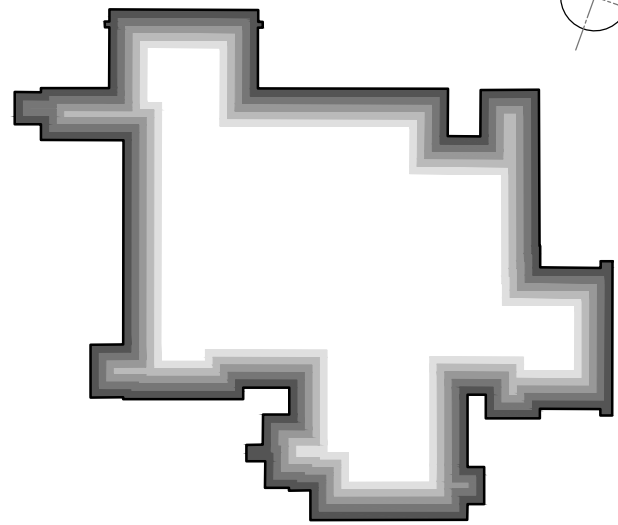

1. All square ductwork ventilation holes to be sized and set-out in strict accordance with the Structural Engineer's drawings - those shown on this drawing relate to those holes over-head.
2. All holes set-out on this drawing for grates are dimensioned to the centre of the holes - all hole diameters to be as confirmed by the Mechanical Engineer's drawings, and to the satisfaction of the Structural Engineer.
3. Dashed lines indicate pipe-routes tracking from hole / outlet positions at floor above. For final 'e-act' routing requirements, refer to Mechanical and Electrical Engineer's design drawings.
4. All concrete / steelwork shown indicate sizes / locations only, and to be confirmed by Structural Engineer.
5. All structural information shown is to be in accordance with Structural Engineer's design, details and specification.
6. Plant layouts shown here are taken directly from the Mechanical and Electrical Engineers, or Specialist Sub-contractor's design drawings; and are therefore included for reference only.
7. All mechanical, electrical, plumbing and ventilation information to be in accordance with Mechanical and Electrical Engineer's design, details and specification.
8. All structural details for vent pipes / rain water pipes / stub-stacks / gutters / drainage channels / etc. refer to the Mechanical and Electrical Engineer's design drawings.
9. All screed butting existing masonry walls which have been removed, to be made good and level to match existing.

ISSUED FOR
CONSTRUCTION



Frankham Consultancy Group Limited
21 Perrymount Road
Haywards Heath RH16 3TE
t 01444 444900 f 01444 45564
enquire@frankham.com
www.frankham.com

Ansell
Company
ct N°: MC02

EASTBOURNE
Borough Council

Date:
1.11.17


AC

06:11:12:10:45

Rev.
C1



NB: All levels are approximate and are subject to further site investigation prior to construction. All discrepancies to be reported to FCG immediately

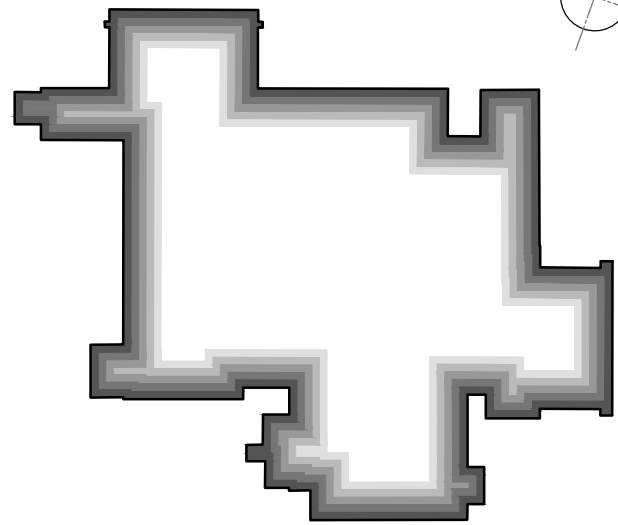

1. All square ductwork ventilation holes to be sized and set-out in accordance with the Structural Engineer's drawings - shown strictly on this drawing relate to those holes over-head.
2. All holes set-out on this drawing for drainage are dimensioned to the centre of the holes - all hole diameters to be as confirmed by the Mechanical Engineer's drawings, and to the satisfaction of the Structural Engineer.
3. Dashed lines indicate pipe-routes tracking from hole / outlet positions at floor above. For final 'exit' routing requirements, refer to Mechanical and Electrical Engineer's design drawings.
4. All concrete / steelwork shown indicative sizes / locations only, and to be confirmed by Structural Engineer.
5. All structural information shown to be in accordance with the Structural Engineer's design, details and specification.
6. Plant layouts shown here are taken directly from the Mechanical and Electrical Engineers, or Specialist Sub-contractors design drawings; and are therefore included for reference only.
7. All mechanical, electrical, plumbing and ventilation information to be in accordance with Mechanical and Electrical Engineer's design, details and specification.
8. For reference only: all vent pipes / rain water pipes / sub-stacks / gullies / drainage channels / etc. refer to the Mechanical and Electrical Engineer's design drawings.
9. All screed butting existing masonry walls which have been removed, to be made good and level to match existing.

ISSUED FOR
CONSTRUCTION



Frankham Consultancy Group Limited
21 Perrymount Road
Haywards Heath RH16 3TP
t 01444 444900 f 01444 455642
enquire@frankham.com
www.frankham.com


Mansell
A Southern Health Company
Contract N°: MC02

Eastbourne & Worthing
Crematoria
Refurbishments and Alterations



EASTBOURNE
Borough Council

Eastbourne Crematorium
Roof
Builder's Works Plan

Date:

01.11.1

Improved


File Ref.: X:\FRANKHAM2\JCS\521260-CREATOR\NAFCH\100-199-LOCATION-PLANS-AND-GA,
521260-A-123-E.DWG - 200611121050 20-06-11-12:10:50

Rev
C-

NB: Contractor to fully investigate and determine load bearing capacity of all building elements and materials and consult with Architect and Structural Engineer prior to commencement of demolition works. All discrepancies to be reported to FCG immediately upon discovery.

NB: All waste to be recycled where possible and/or disposed of in accordance with the Contractor's Site Waste Management Plan and all in accordance with current legislation, particularly, but not excluding, all hazardous materials

NOTES: Do not scale this drawing. All dimensions to be checked on site prior to commencement or manufacture.
Key Plan (nts)

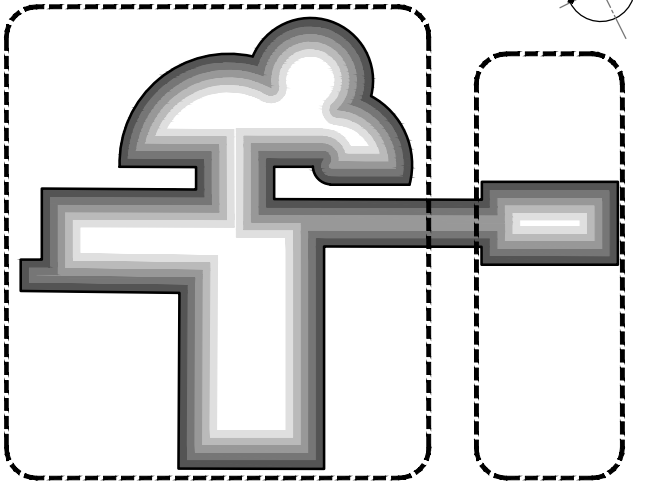

General Builders Works Notes

- 1.All square ductwork ventilation holes to be sized and set-out in strict accordance with the Structural Engineer's drawings - those shown on this drawing relate to those holes over-head.
- 2.All holes set-out on this drawing for drainage are dimensioned to the centre of the holes - all hole diameters to be as confirmed by the Mechanical Engineer's drawings, and to the satisfaction of the Structural Engineer.
- 3.Dashed lines indicate pipe-routes tracking from hole / outlet positions at floor above. For final 'exact' routing requirements, refer to Mechanical and Electrical Engineer's design drawings.
- 4.All concrete / steelwork shown indicative sizes / locations only, and to be confirmed by Structural Engineer.
- 5.All structural information generally to be in accordance with Structural Engineer's design, details and specification.
- 6.Plant layouts shown here are taken directly from the Mechanical and Electrical Engineer's, or Specialist Sub-contractor's design drawings; and are therefore included for reference only.
- 7.All mechanical, electrical, plumbing and ventilation information to be in accordance with Mechanical and Electrical Engineer's design, details and specification.
- 8.For references to soil + vent pipes / rain water pipes / stub-stacks / gulleys / drainage channels / etc; refer to the Mechanical and Electrical Engineer's design drawings.
- 9.All screed butting existing masonry walls which have been removed, to be made good and level to match existing.

ISSUED FOR CONSTRUCTION

All details referenced in call outs supercede general arrangement or larger depictions.

Rev	Date	By	Chk	Comment
C1	09.07.12	RKC	JAS	Issued for CONSTRUCTION

BRINGING IDEAS TO LIFE



FRANKHAM

Frankham Consultancy Group Limited
21 Perryman Road
Haywards Heath RH16 3TP
t 01444 444900 f 01444 455642
enquire@frankham.com
www.frankham.com

Client	 Mansell Contract N°: Worthing
--------	---

Project Title	Eastbourne & Worthing Crematoria Refurbishments and Alterations
---------------	---

Drawing Title	 Worthing Crematorium Ground Floor Builder's Works Plan
---------------	---

Drawn by: RKC	Scale: 1:100@A1	Date: 01.11.11
Designed by: FCG	Checked by: JAS	Approved by: AC

File Ref.: X:\FRANKHAM\2 - DRESDEN CREMATORIA\WORKING\100-100-LOCATIONS PLANS AND GA- 20.06.11 12:10:55

Drawing No. 521260-A-125-W	Rev. C1
-------------------------------	------------



NB: All information based on supplied third party survey information.
All discrepancies to be reported to FCG immediately upon discovery.

NB: Contractor to fully investigate and determine load bearing capacity of all building elements and materials and consult with Architect and Structural Engineer prior to commencement of demolition works. All discrepancies to be reported to FCG immediately upon discovery.

NB: All waste to be recycled where possible and/or disposed of in accordance with the Contractor's Site Waste Management Plan and all in accordance with current legislation, particularly, but not excluding, all hazardous materials



NB: All information based on supplied third party survey information.
All discrepancies to be reported to FCG immediately upon discovery.

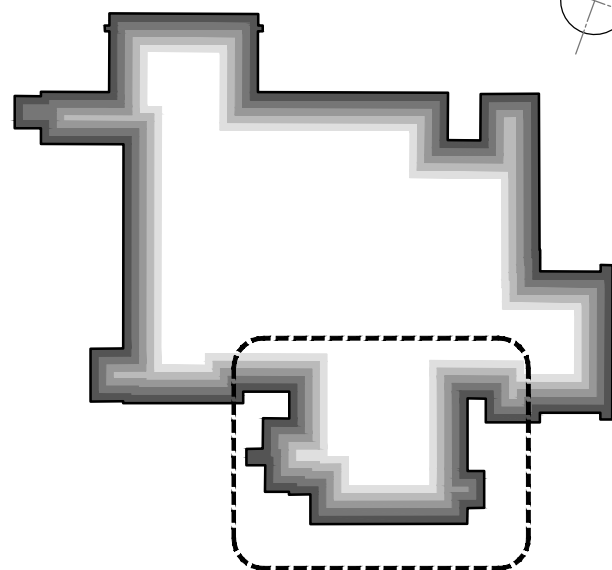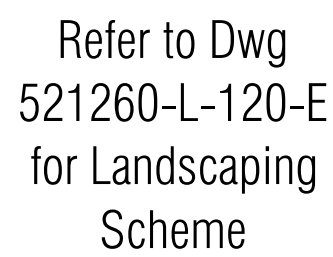

AS BUILT
DRAWING

01	07.01.13	RKC	JAS	DRAWING ISSUED - AS BUILT
Rev	Date	By	Chk	Comment

BRINGING IDEAS TO LIFE



FRANKHAM

Frankham Consultancy Group Limited
21 Perrymount Road
Haywards Heath RH16 3TP
t 01444 444900 f 01444 455642
enquire@frankham.com
www.frankham.com

Client



Contract N°: MC0269

Project Title

Eastbourne & Worthing
Crematoria
Furnishments and Alterations

Drawing Title




Eastbourne Crematorium
Lower Ground Floor
General Arrangement Plan

Drawn by: RKC	Scale: 1:100@A1	Date: 18.10.11
Designed by: FCG	Checked by: JAS	Approved by: AC


File Ref.: X:\FRANKHAMZ-JOBS\521260-CREMATORIA\ANDH\100-199-LOCATION-PLANS-AND-GA,
521260-A-130-EDWG - 200611121137 20:06:11:12:11:07

Drawing No. 521260-A-130-E	Rev. 01
-------------------------------	------------

All Disabled and Ambulant Disabled facilities to comply with Approved Document Part M - Access to and use of buildings*, Disability Discrimination Act 1995 and BS83000 as required

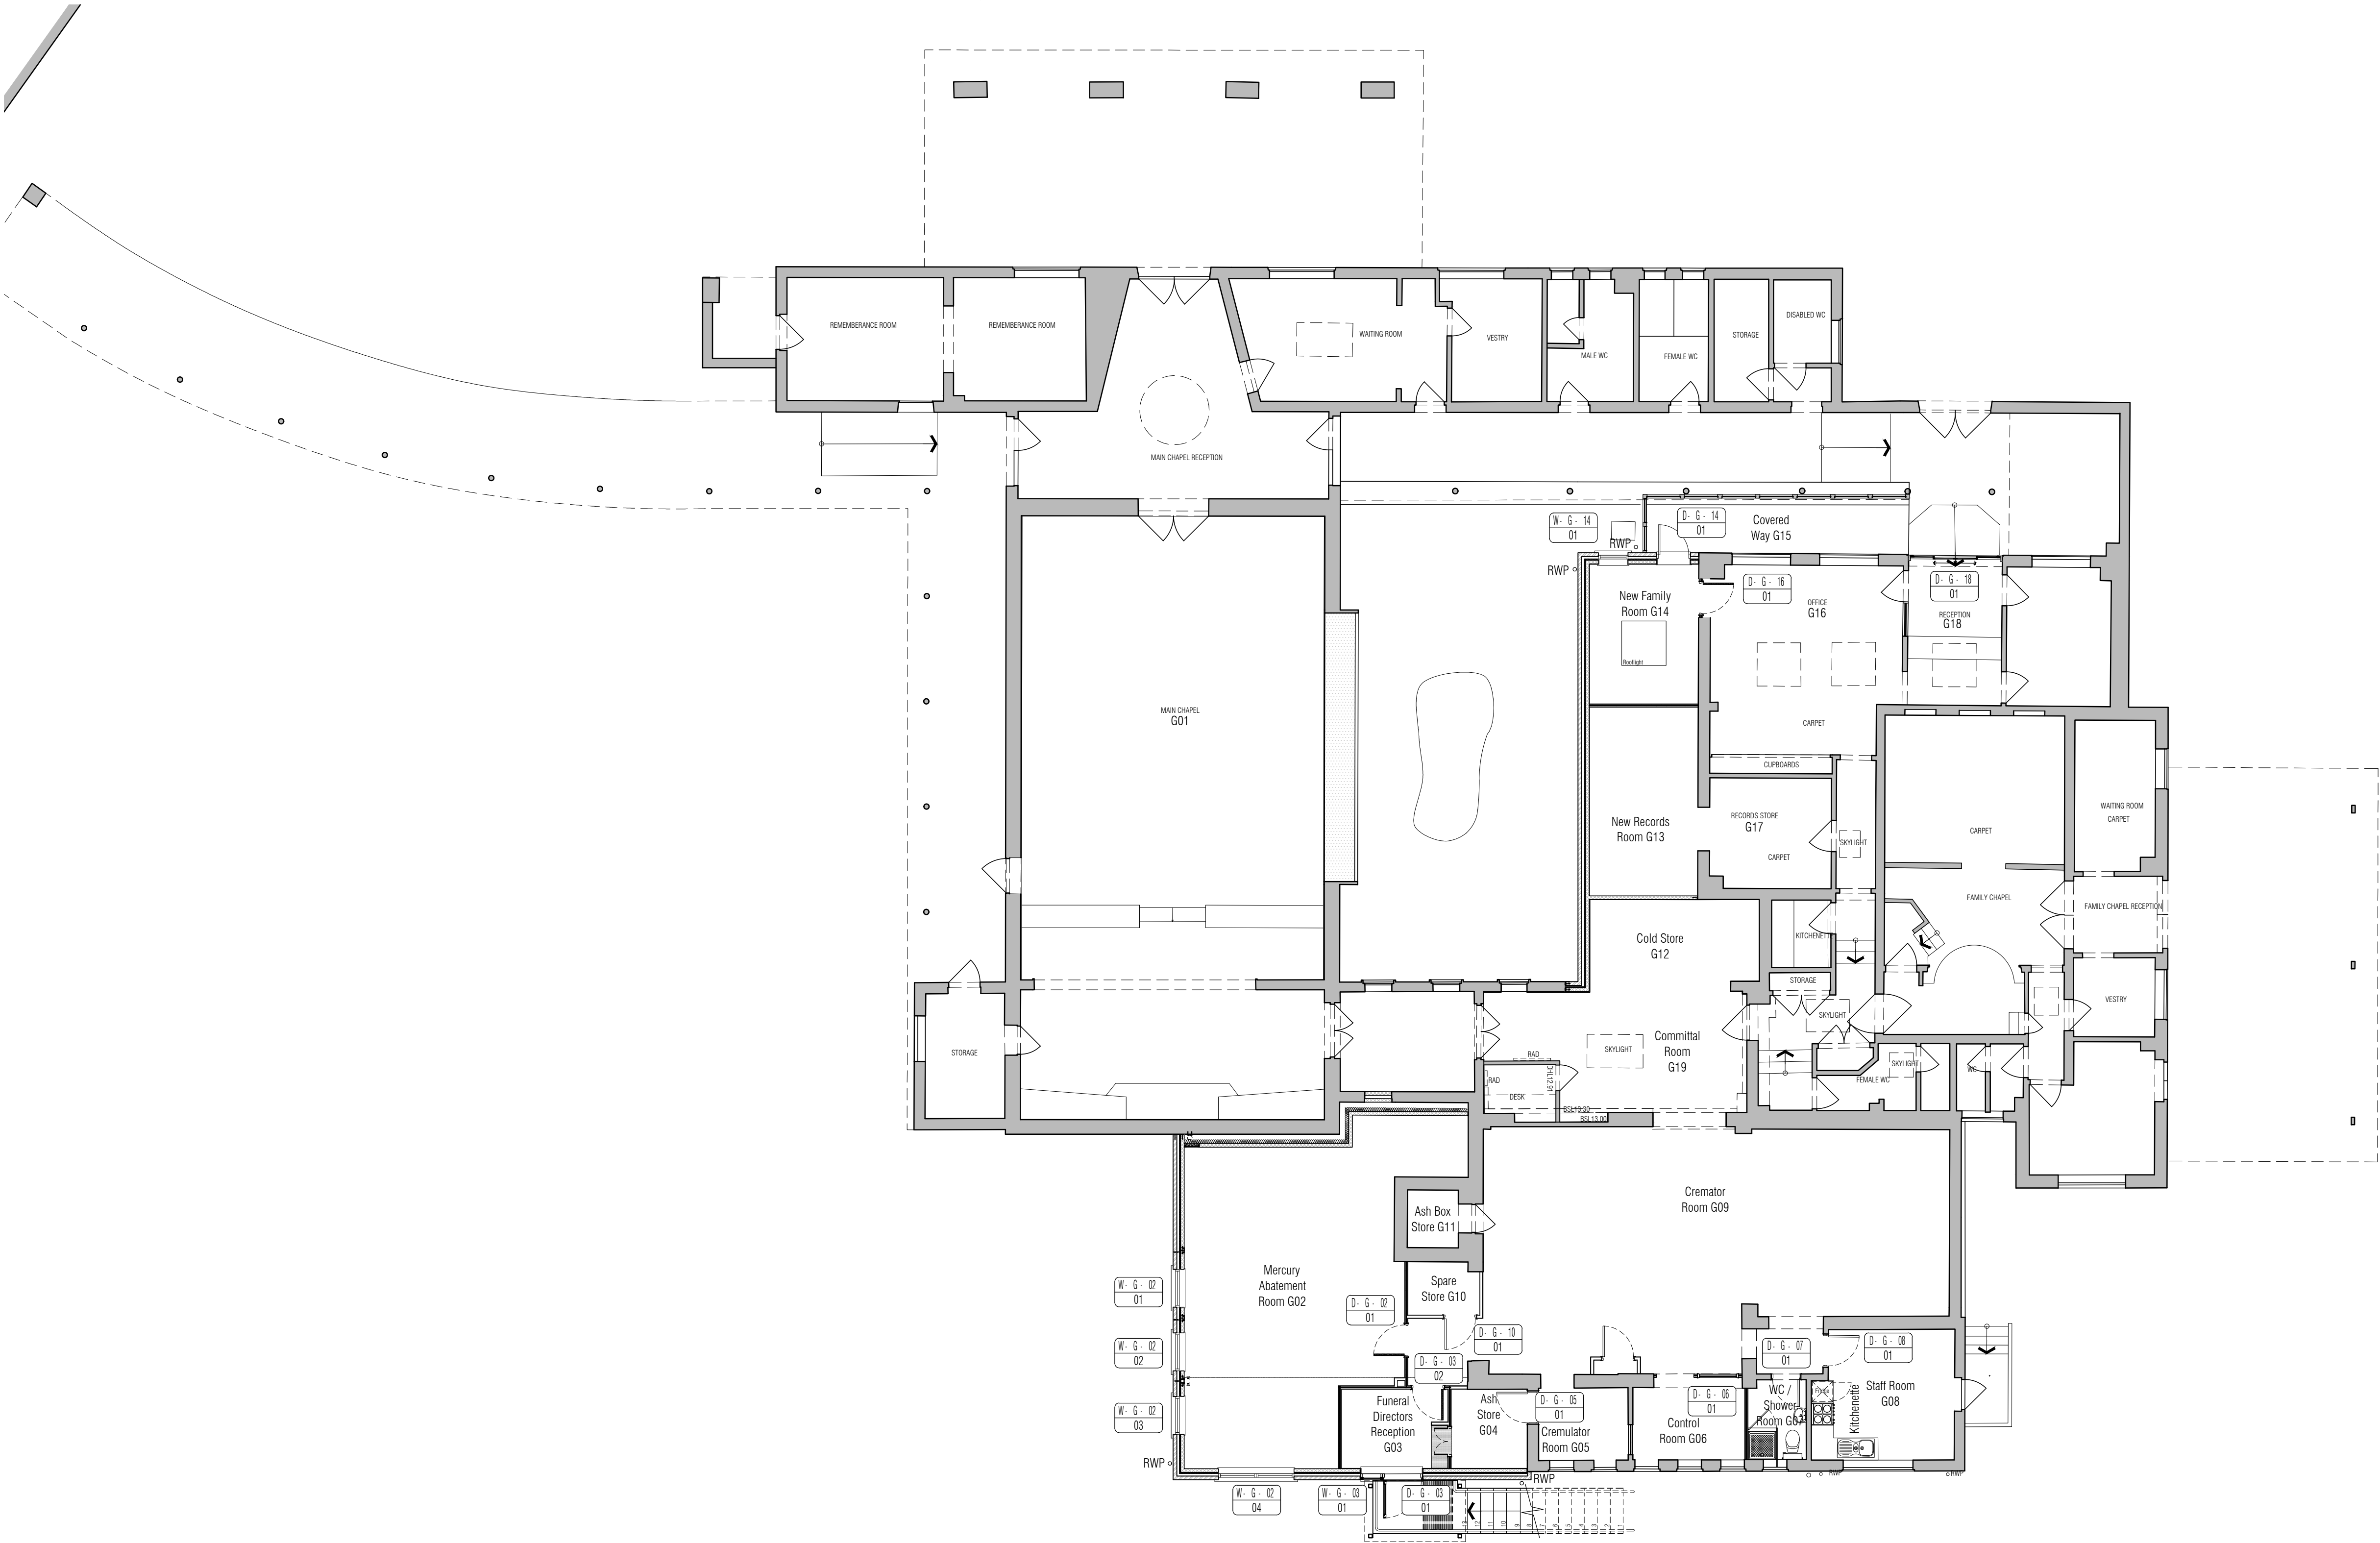

NOTES: Do not scale this drawing. All dimensions to be checked on site prior to commencement or manufacture.
Key Plan (nts)

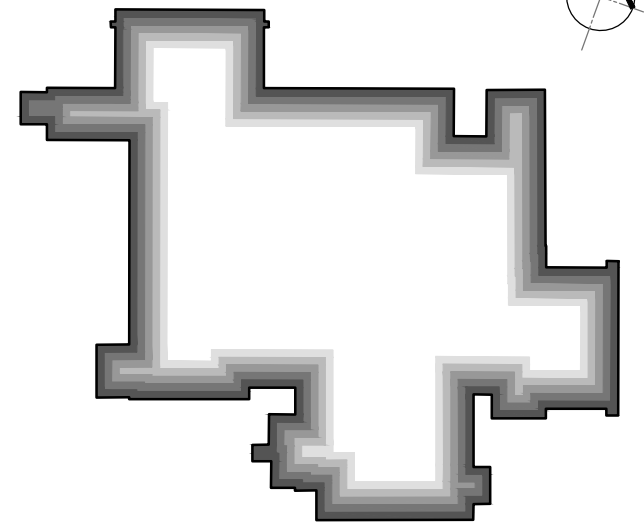

AS BUILT
DRAWING

All details referenced in call outs supersede general arrangement or larger depictions.

Rev	Date	By	Chk	Comment
01	07.01.13	RKC	JAS	DRAWING ISSUED - AS BUILT

BRINGING IDEAS TO LIFE



FRANKHAM

Frankham Consultancy Group Limited
21 Perryman Road
Haywards Heath RH16 3TP
t 01444 444900 f 01444 455642
enquiries@frankham.com
www.frankham.com

Client

Contract N°: MC0269

Project Title

Eastbourne & Worthing
Crematoria
Refurbishments and Alterations

Drawing Title

Eastbourne Crematorium
Ground Floor
General Arrangement Plan


Drawn by: RKC	Scale: 1:50@A1	Date: 19.10.11
Designed by: FCG	Checked by: JAS	Approved by: AC

File Ref.: X:\FRANKHAM\2_08051210 CREMATORIA\WORK\100-100-LOCATIONS PLANS AND GFA - 20.06.11\21.12.11

Drawing No. 521260-A-131-E	Rev. 01
-------------------------------	------------


NB: All information based on supplied third party survey information.
All discrepancies to be reported to FCG immediately upon discovery.

All Disabled and Ambulant Disabled facilities to comply with Approved Document Part M - Access to and use of buildings*, Disability Discrimination Act 1995 and BS83000 as required.

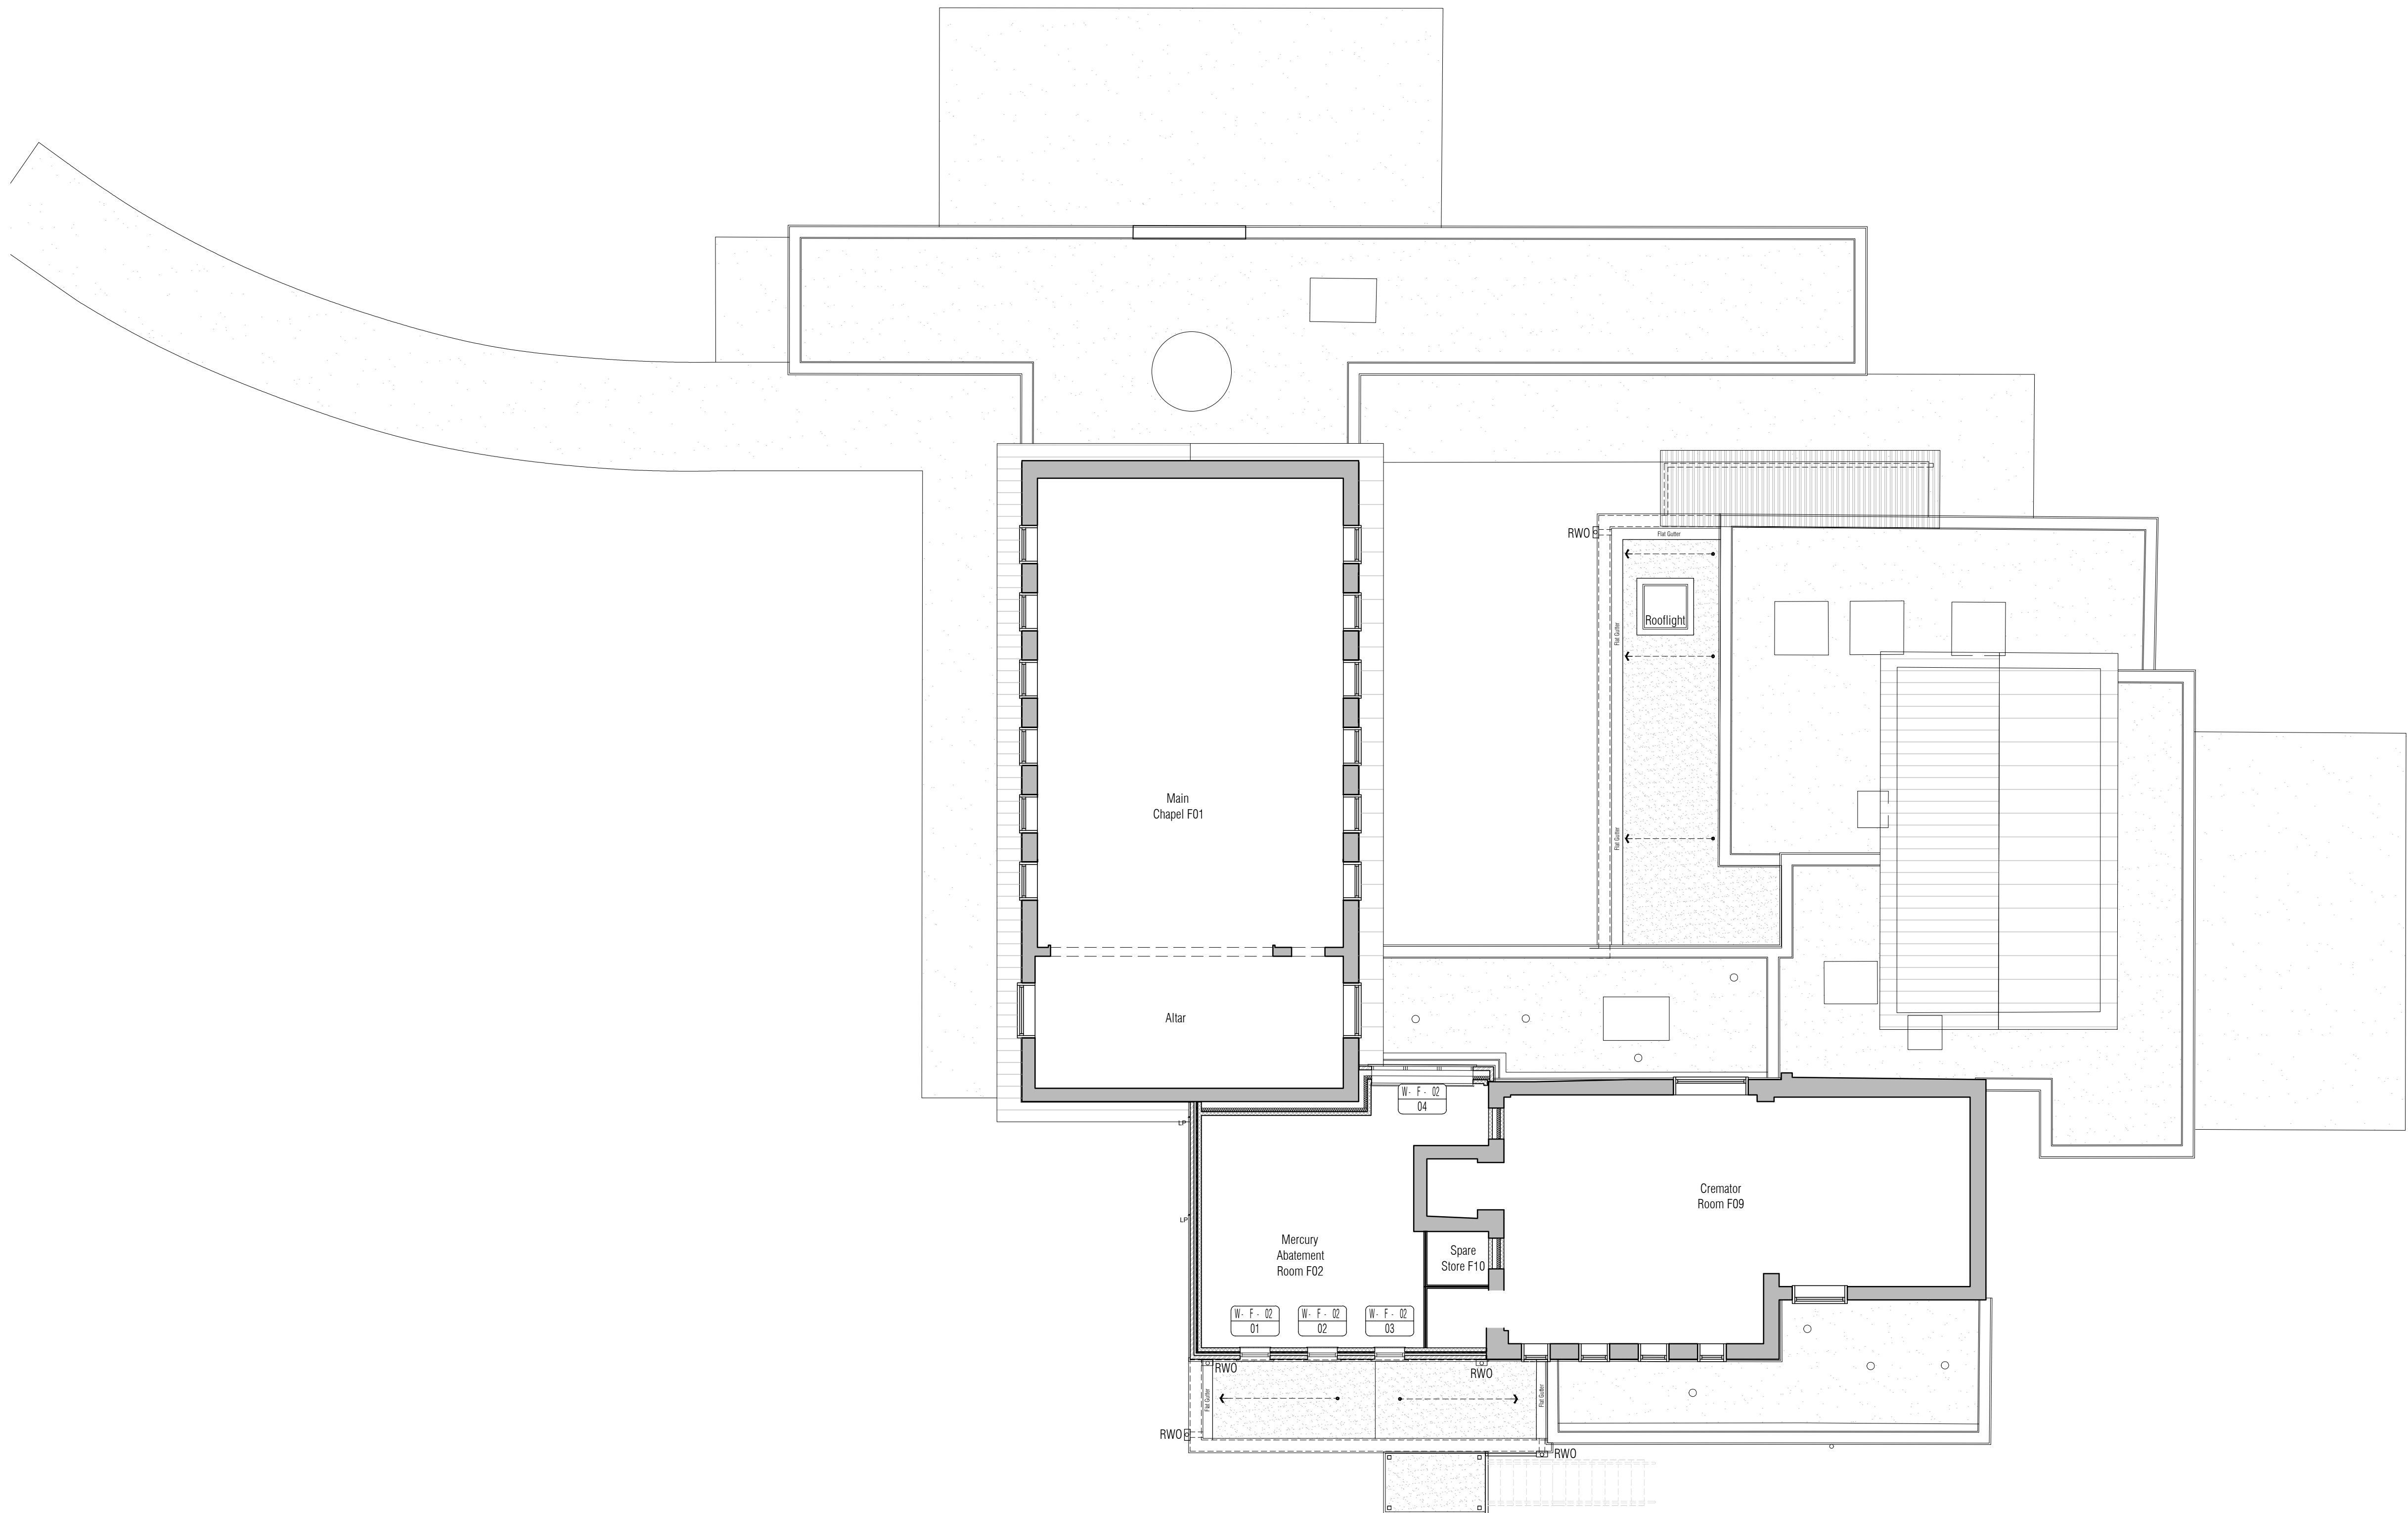

NB: All information based on supplied third party survey information.
All discrepancies to be reported to FCG immediately upon discovery.

NOTES: Do not scale this drawing. All dimensions to be checked on site prior to commencement or manufacture.
Key Plan (nts)

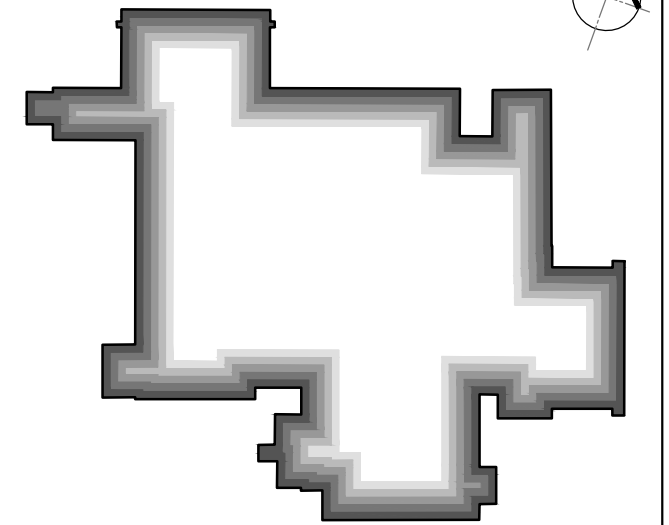

AS BUILT
DRAWING

All details referenced in call outs supersede general arrangement or larger depictions.

01	07.01.13	RKC	JAS	DRAWING ISSUED - AS BUILT	
Rev	Date	By	Chk	Comment	

BRINGING IDEAS TO LIFE



FRANKHAM

Frankham Consultancy Group Limited
21 Perrymount Road
Haywards Heath RH16 3TP
t 01444 444900 f 01444 455642
enquire@frankham.com
www.frankham.com

Client



Contract N°: MC0269

Project Title

Eastbourne & Worthing
Crematoria
Rebuildings and Alterations

Drawing Title




Castbourne Crematorium
First Floor
General Arrangement Plan

Drawn by: RKC	Scale: 1:50@A1	Date: 11.01.12
Designed by: FCG	Checked by: JAS	Approved by: AC

File Ref.: X:\FRANKHAMZ-JC8521260-CREMATORIUM\ARCH100-199-LOCATION-PLANS-AND-GA,
521260-A-133-E.DWG - 200611121116 20:06:11-12:11:17

Drawing No. 521260-A-132-E	Rev. 01
-------------------------------	------------

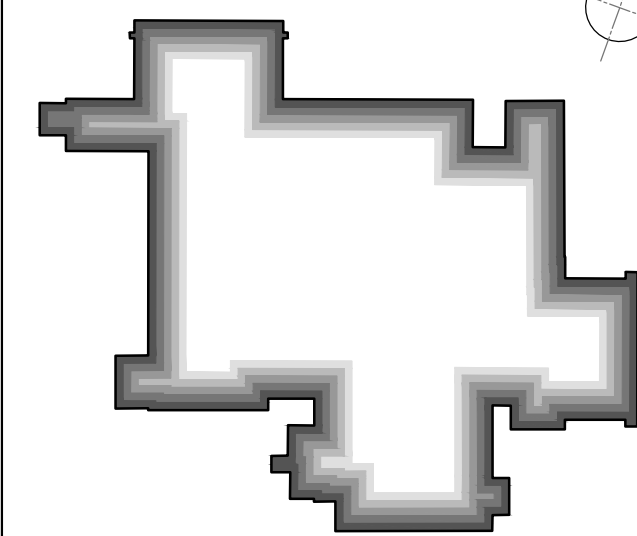

All details referenced in call outs supersede general arrangement or larger depictions.

01	07.01.13	RKC	JAS	DRAWING ISSUED - AS BUILT	
Rev	Date	By	Chk	Comment	



Frankham Consultancy Group Limited
21 Perrymount Road
Haywards Heath RH16 3TP
t 01444 444900 f 01444 455642
enquire@frankham.com
www.frankham.com


Contract N°: MC02

Eastbourne & Worthing
Crematoria
Refurbishments and Alterations



EASTBOURNE
Borough Council

Eastbourne Crematorium
Roof General Arrangement Plan

Drawn by: RKC	Scale: 1:100@A1	Date: 18.10.11
Designed by: FCG	Checked by: JAS	Approved by: AC




File Ref.: X:\FRANKHAM2\JOBS\521260-CREMATORIA\ARCH\100-199-LOCATION-PLANS-AND-GA,
521260-A-133-E.DWG - 200611121120 20:06:11-12:11:21

Drawing No. 521260-A-133-E	Rev. 01
-------------------------------	------------

NB: All information based on supplied third party survey information.
All discrepancies to be reported to FCG immediately upon discovery.

All Disabled and Ambulant Disabled facilities to comply with Approved Document Part M - Access to and use of buildings*, Disability Discrimination Act 1995 and BS83000 as required

NOTES: Do not scale this drawing. All dimensions to be checked on site prior to commencement or manufacture.
Key Plan (nts)

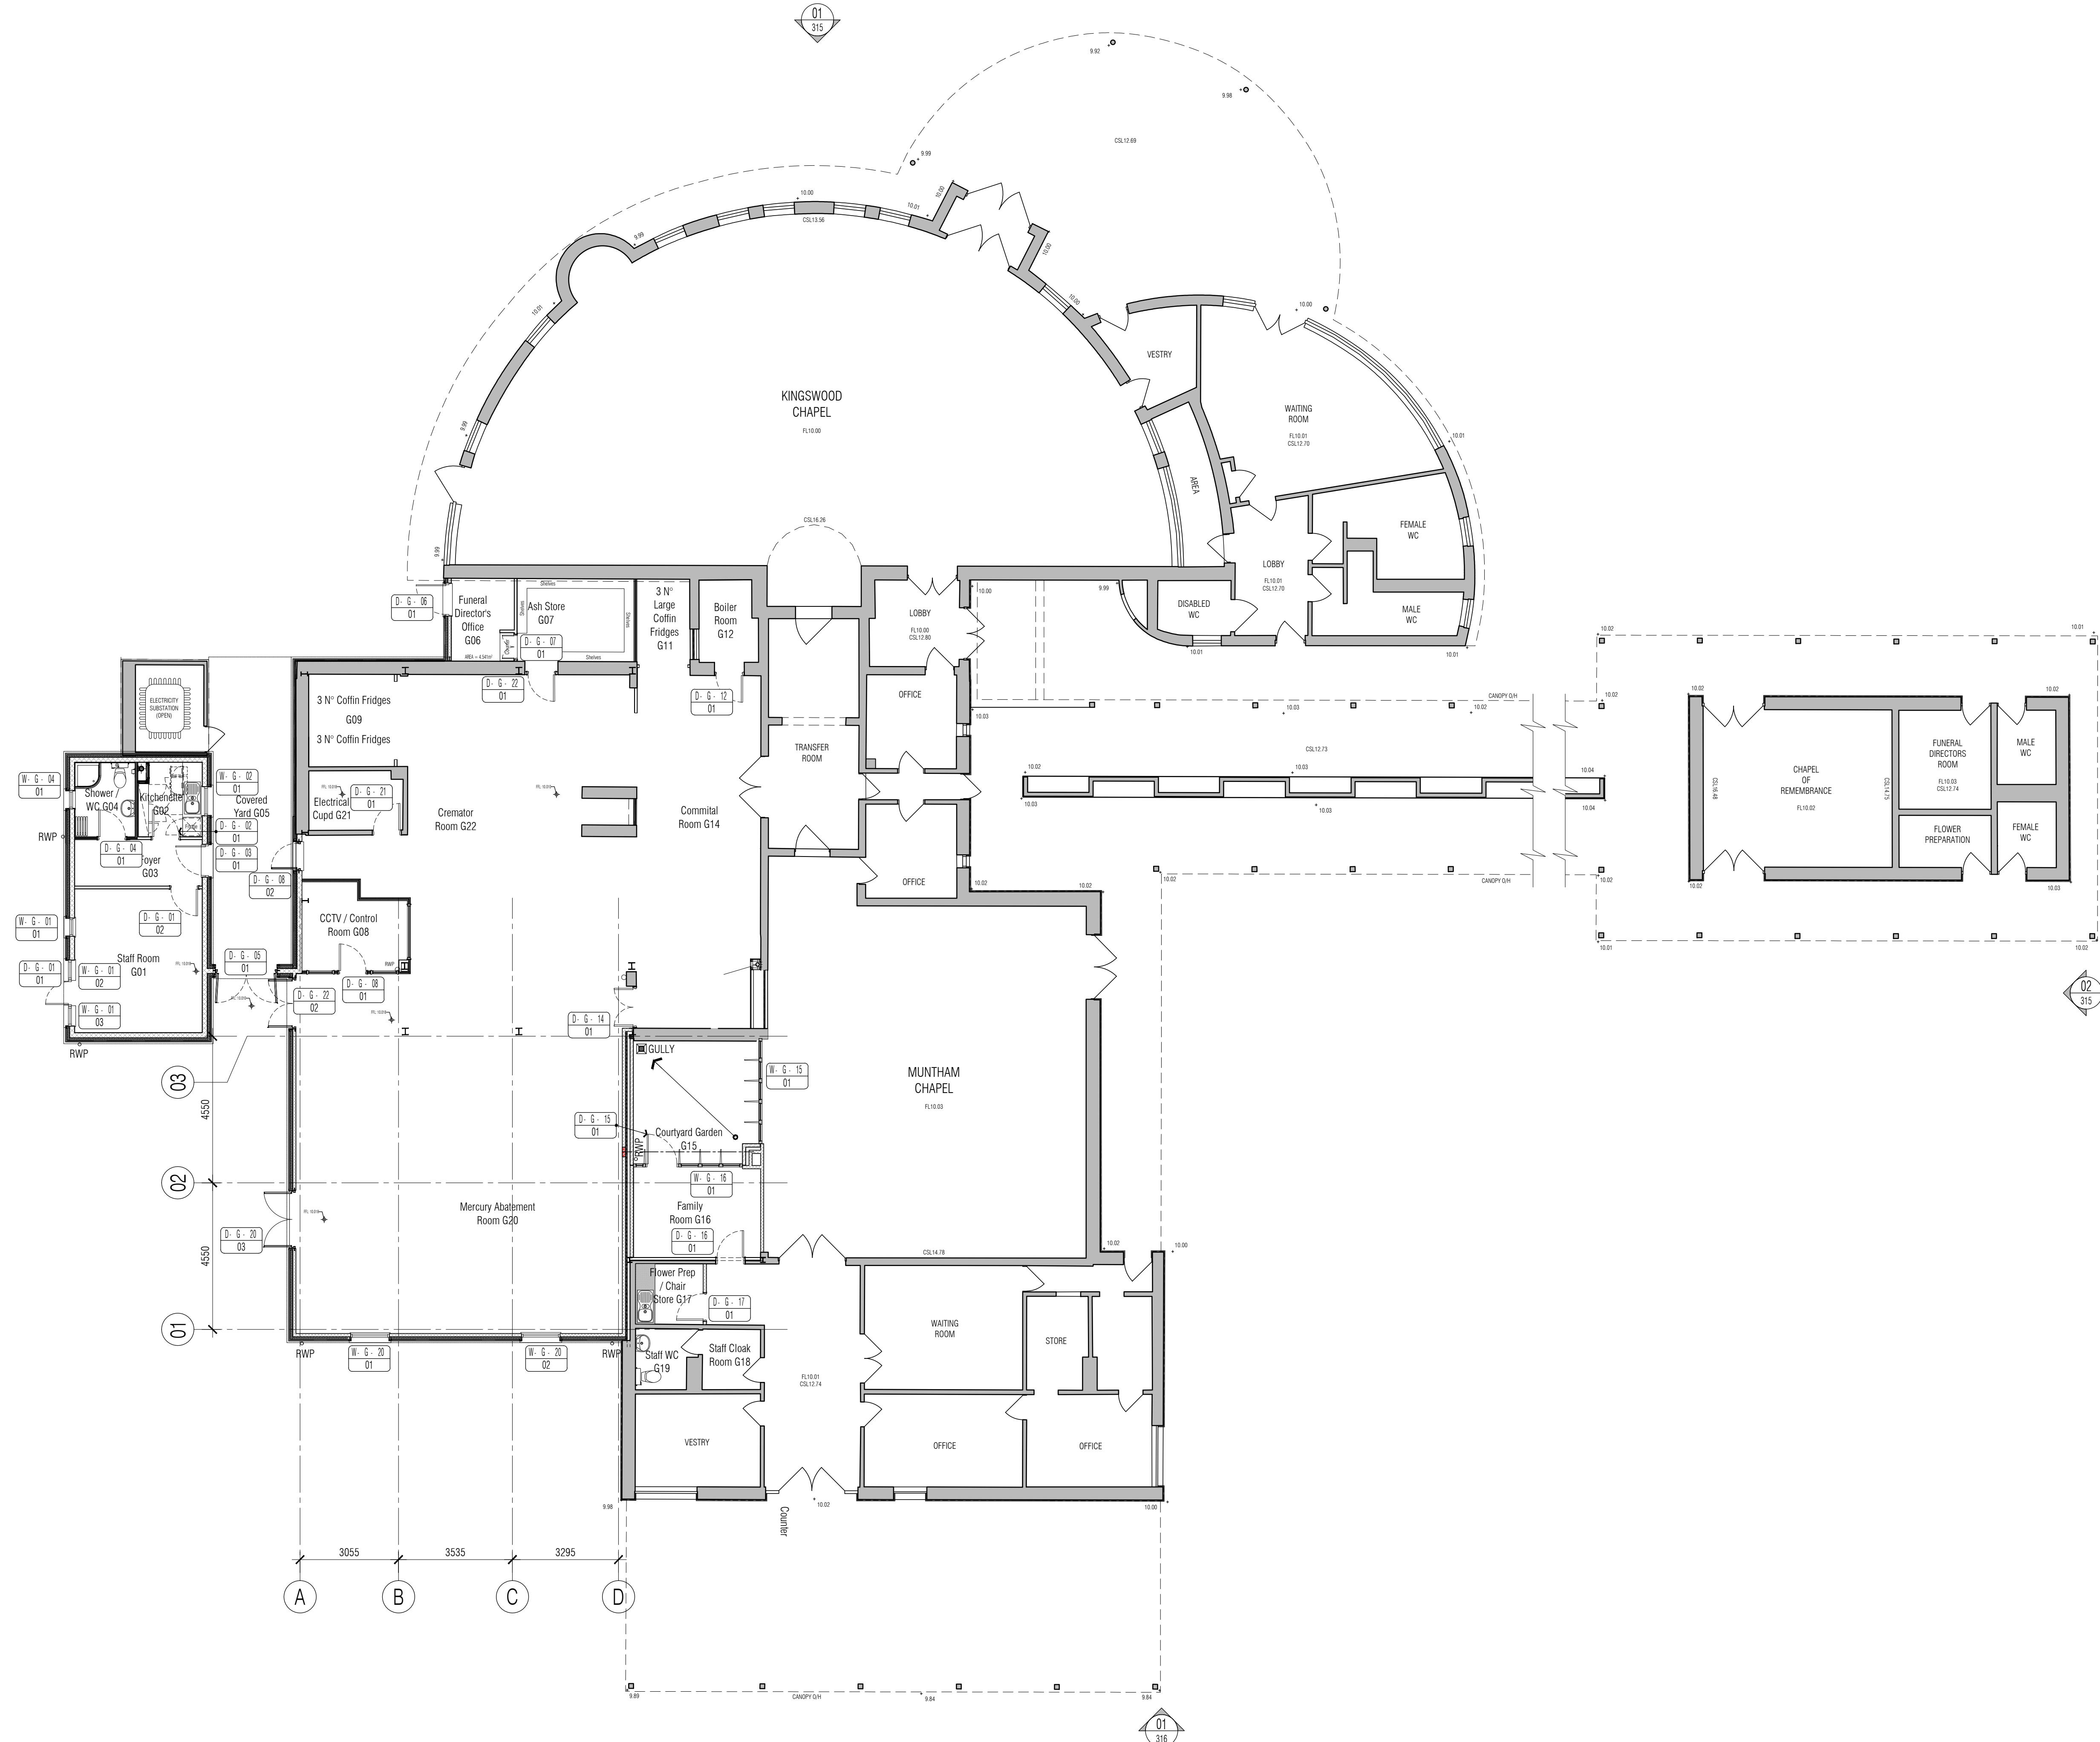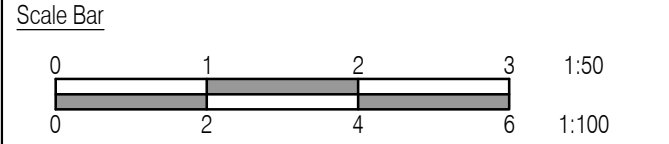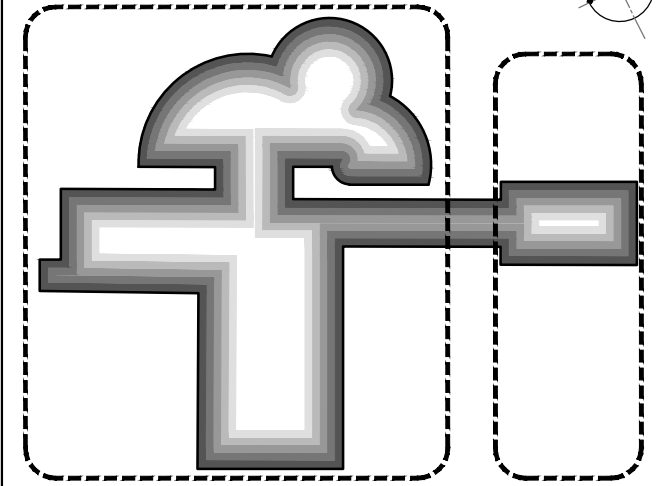

AS BUILT
DRAWING

All details referenced in call outs supersede general arrangement or larger depictions.

Rev	Date	By	Chk	Comment
AB1	07.01.13	RKC	JAS	DRAWING ISSUED - AS BUILT

BRINGING IDEAS TO LIFE



FRANKHAM

Frankham Consultancy Group Limited
21 Perryman Road
Haywards Heath RH16 3TP
t 01444 444900 f 01444 455642
enquiries@frankham.com
www.frankham.com

Client
Mansell
Contract N°: Worthing

Project Title
Eastbourne & Worthing
Crematoria
Refurbishments and Alterations

Drawing Title
Worthing
Worthing Crematorium
Ground Floor
General Arrangement Plan

Drawn by: RKC	Scale: 1:100@A1	Date: 18.10.11
Designed by: FCG	Checked by: JAS	Approved by: AC


File Ref.: X:\FRANKHAM\2_06551260 CREMATORIA\WORK\106-109 LOCATIONS PLANS AND GFA - 20.06.11\12.11.26

Drawing No. 521260-A-135-W	Rev. AB1
-------------------------------	-------------


NB: All information based on supplied third party survey information.
All discrepancies to be reported to FCG immediately upon discovery.




NB: All information based on supplied third party survey information.
All discrepancies to be reported to FCG immediately upon discovery.

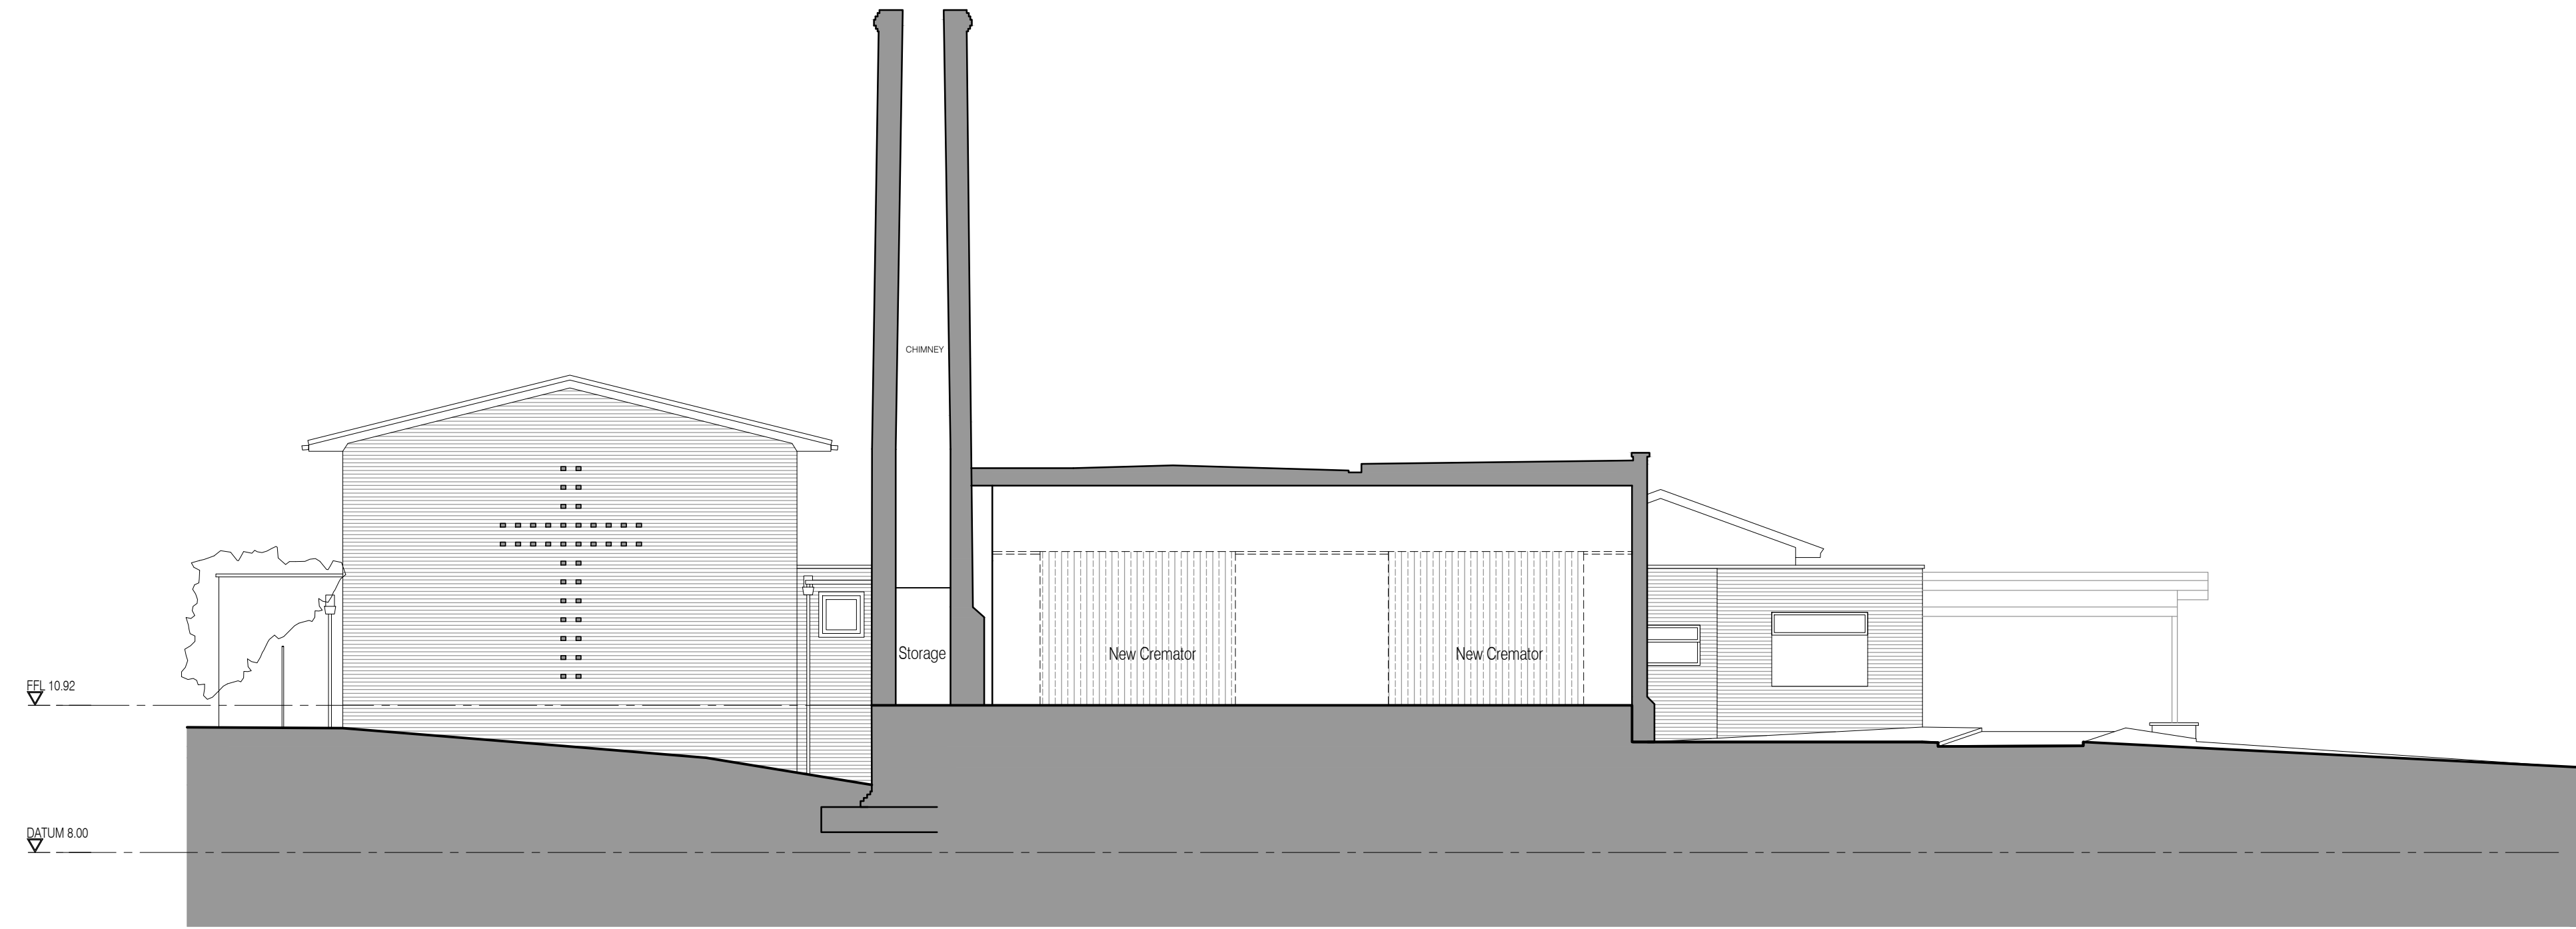


01 Section A
Scale: 1:100

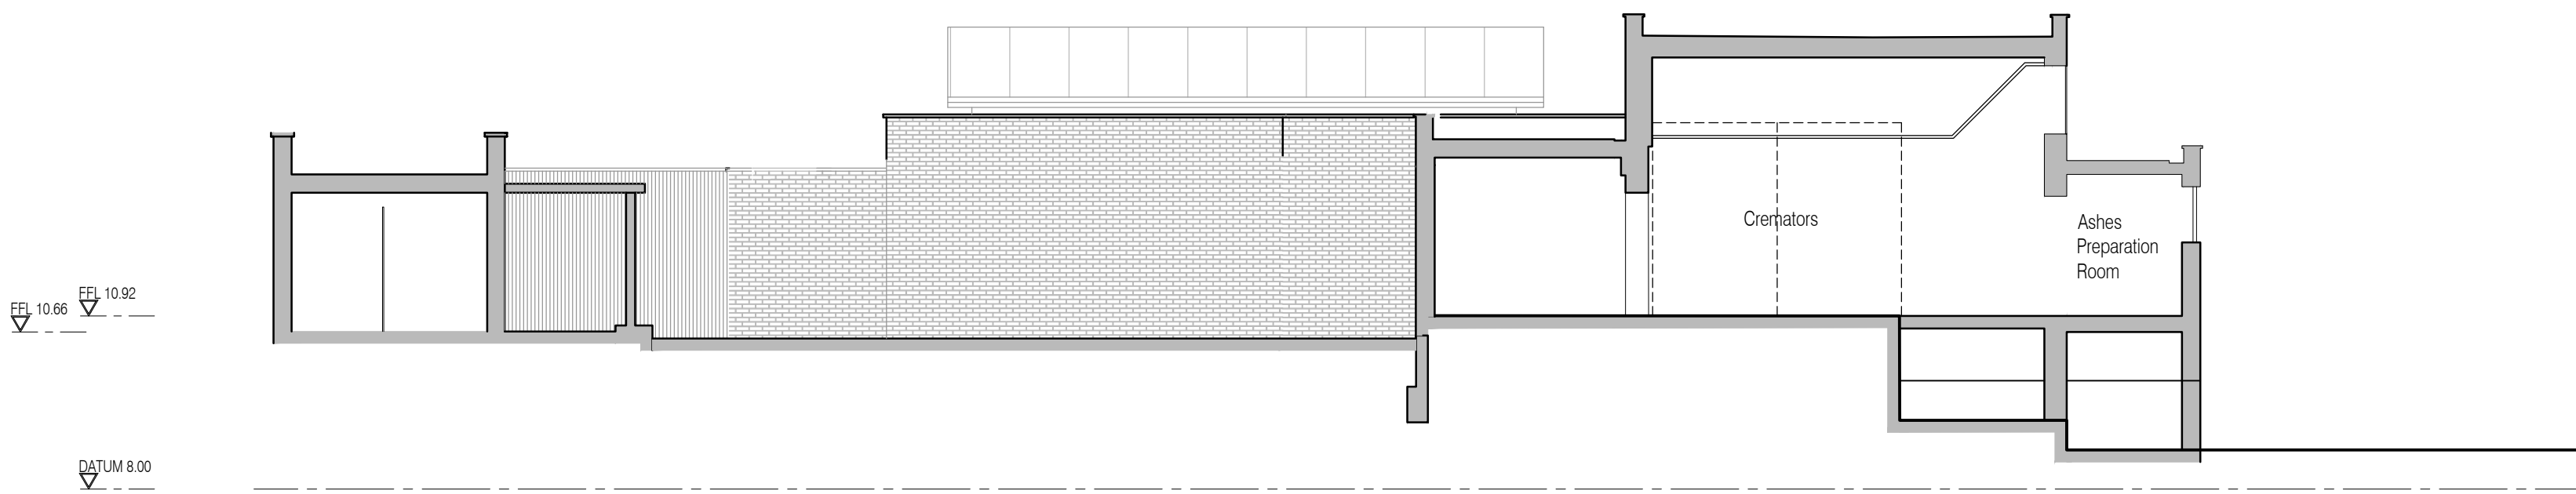

02 Section B
Scale: 1:100

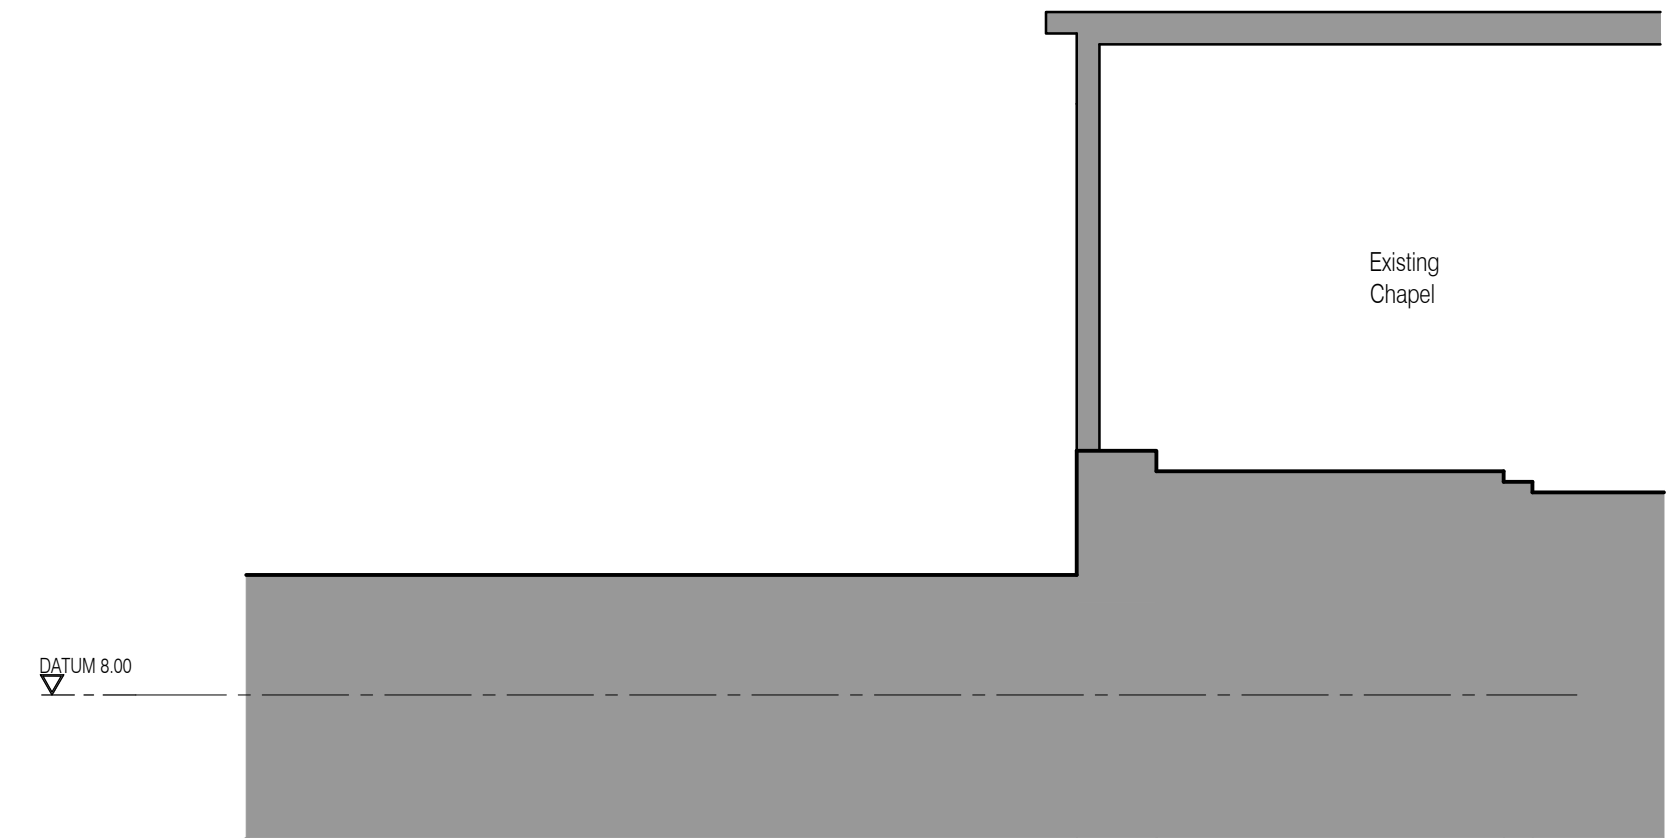

03 Section C
Scale: 1:100

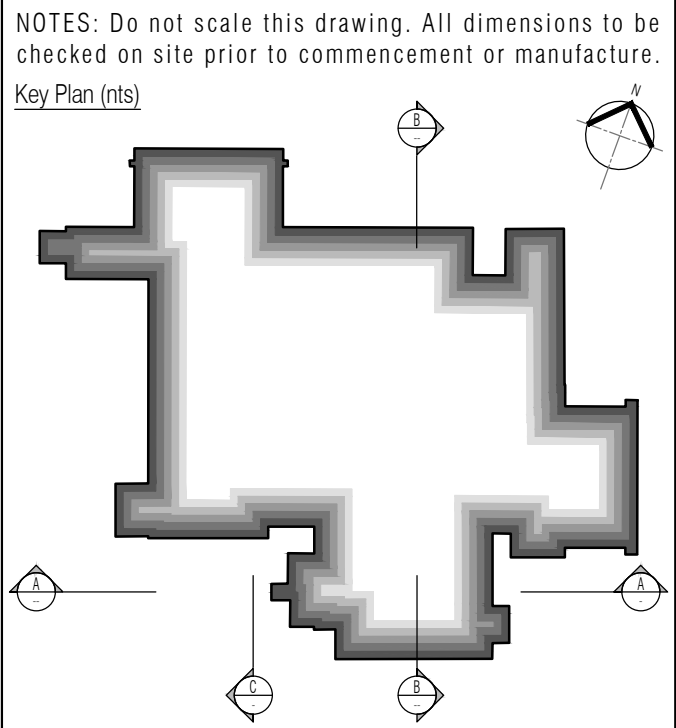

ISSUED FOR
CONSTRUCTION

All details referenced in call outs supercede general arrangement or larger depictions.

Rev	Date	By	Chk	Comment
C2	25.05.12	RKC	JAS	Parapet revd.
C1	29.03.12	RKC	JAS	Issued for CONSTRUCTION

BRINGING IDEAS TO LIFE

FRANKHAM

Frankham Consultancy Group Limited
21 Perrymount Road
Haywards Heath RH16 3TP
t 01444 444900 f 01444 455642
enquire@frankham.com
www.frankham.com

Client

Mansell
Contract N°: MC0269

Project Title

Eastbourne & Worthing
Crematoria
Refurbishments and Alterations


Drawing Title

EASTBOURNE
Eastbourne Crematorium
Existing Sections A, B & C


Drawn by: RKC	Scale: 1:100@A1	Date: 28.10.11
Designed by: FCG	Checked by: JAS	Approved by: AC

File Ref.: X:\FRANKHAM\2_080512180 CREMATORIA\ARCH\026-099-0211001 20.06.11 12:15:08


Drawing No. 521260-A-200-E	Rev. C2
-------------------------------	------------

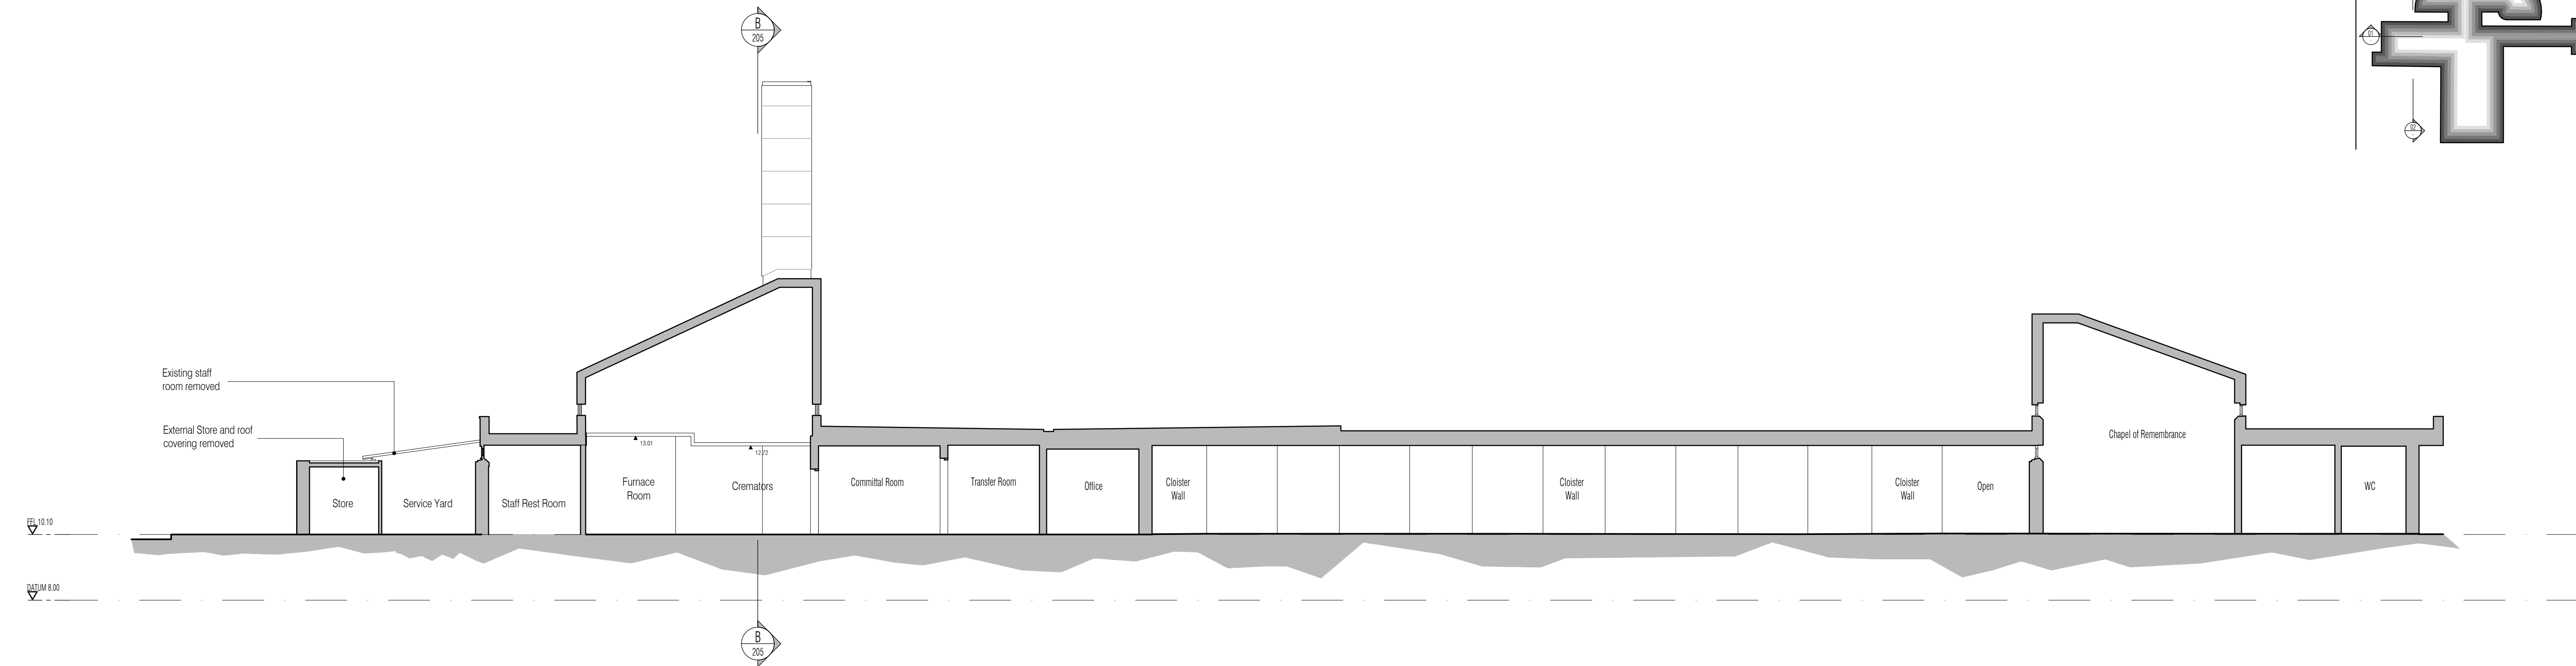

01 Section A
Scale: 1:100

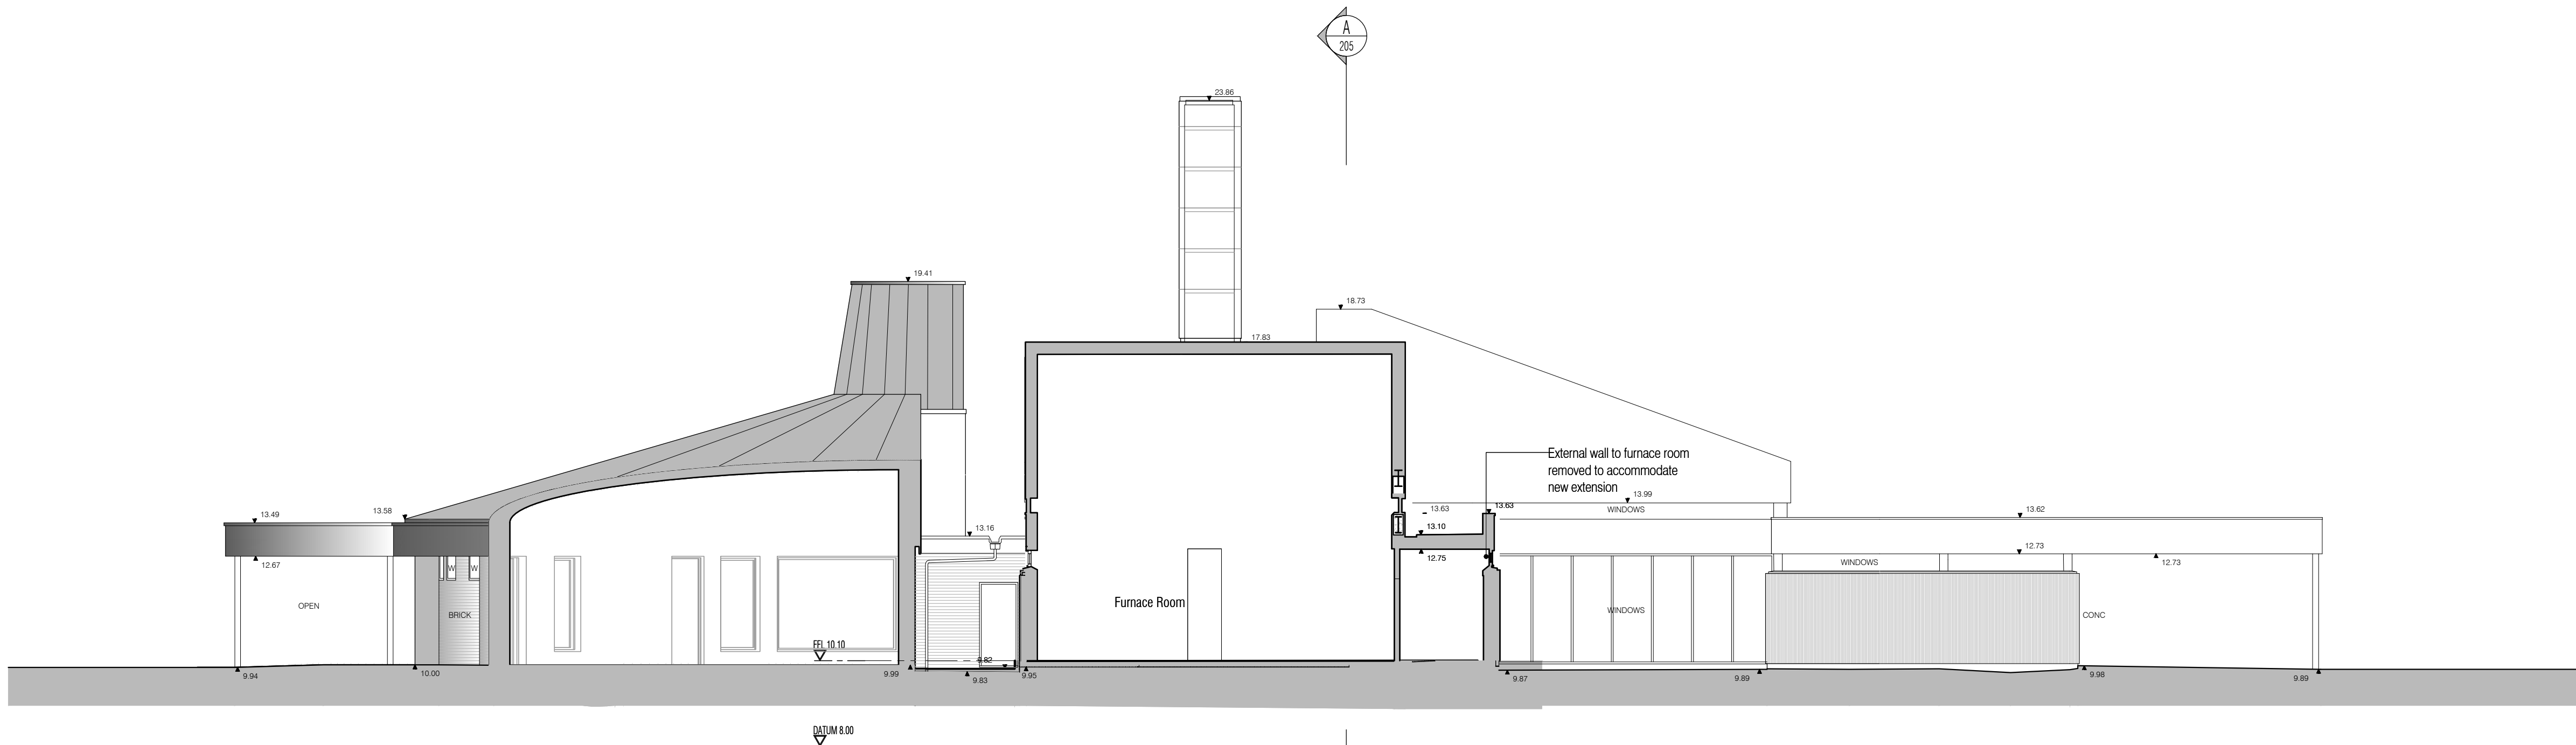

02 Section B
Scale: 1:100

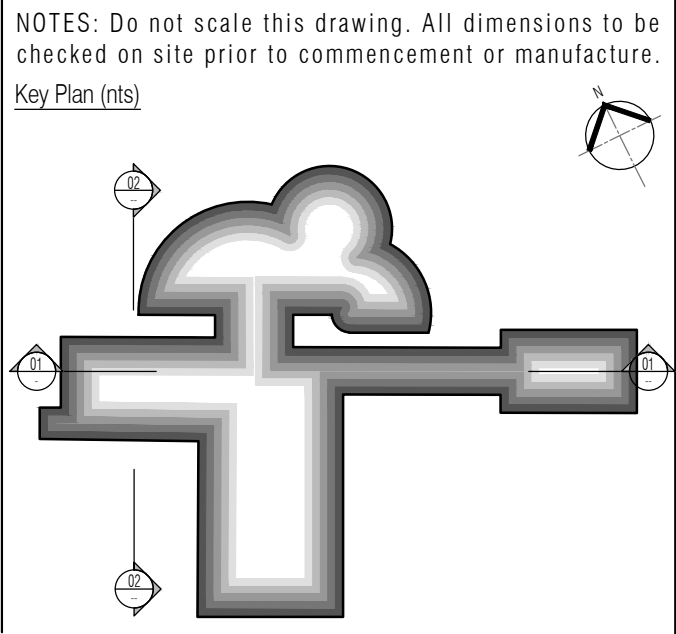

ISSUED FOR
CONSTRUCTION

All details referenced in call outs supersede general arrangement or larger depictions.

Rev	Date	By	Chk	Comment
C2	09.07.12	RKC	JAS	Issued for Construction
P5	01.06.12	RKC	JAS	Issued for Stage F
P4	16.05.12	RKC	JAS	Updated to reflect redesign
C1	23.04.12	RKC	JAS	Issued for CONSTRUCTION

BRINGING IDEAS TO LIFE

FRANKHAM

Frankham Consultancy Group Limited
21 Perrymount Road
Haywards Heath RH16 3TP
t 01444 444900 f 01444 455642
enquiries@frankham.com
www.frankham.com


Client
Mansell
Contract N°: Worthing

Project Title
Eastbourne & Worthing
Crematoria
Refurbishments and Alterations


Drawing Title
Worthing
Worthing Crematorium
Existing Sections A & B

Drawn by: RKC	Scale: 1:100@A1	Date: 28.10.11
Designed by: FCG	Checked by: JAS	Approved by: AC
File Ref.: X:\FRANKHAM\2_080512180 CREMATORIA\ARCH\026-099-SECTIONA.dwg 307380-A-205-W-0060 - 200811271512		20.06.11 12:15:12
Drawing No. 521260-A-205-W		Rev. C2


NB: All information based on supplied third party survey information.
All discrepancies to be reported to FCG immediately upon discovery.

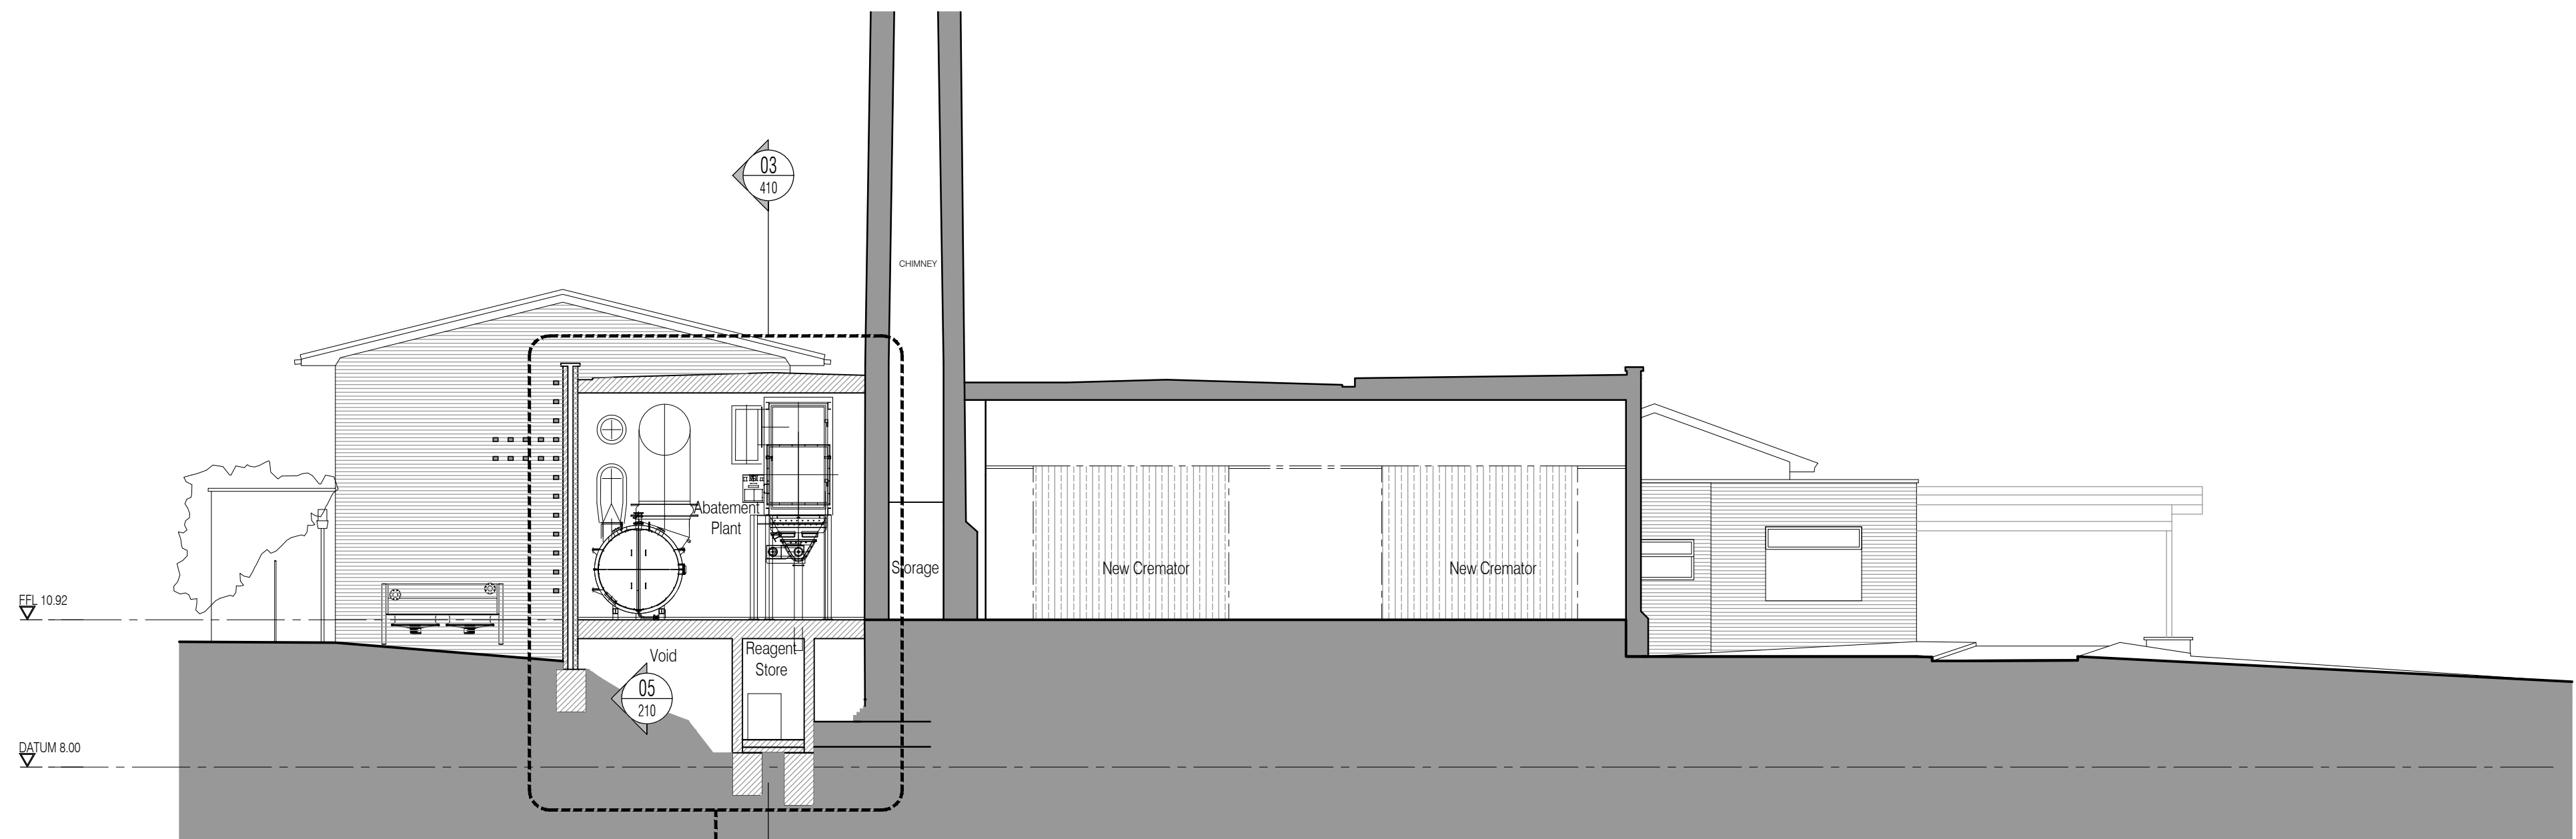

01 Section A
Scale: 1:100

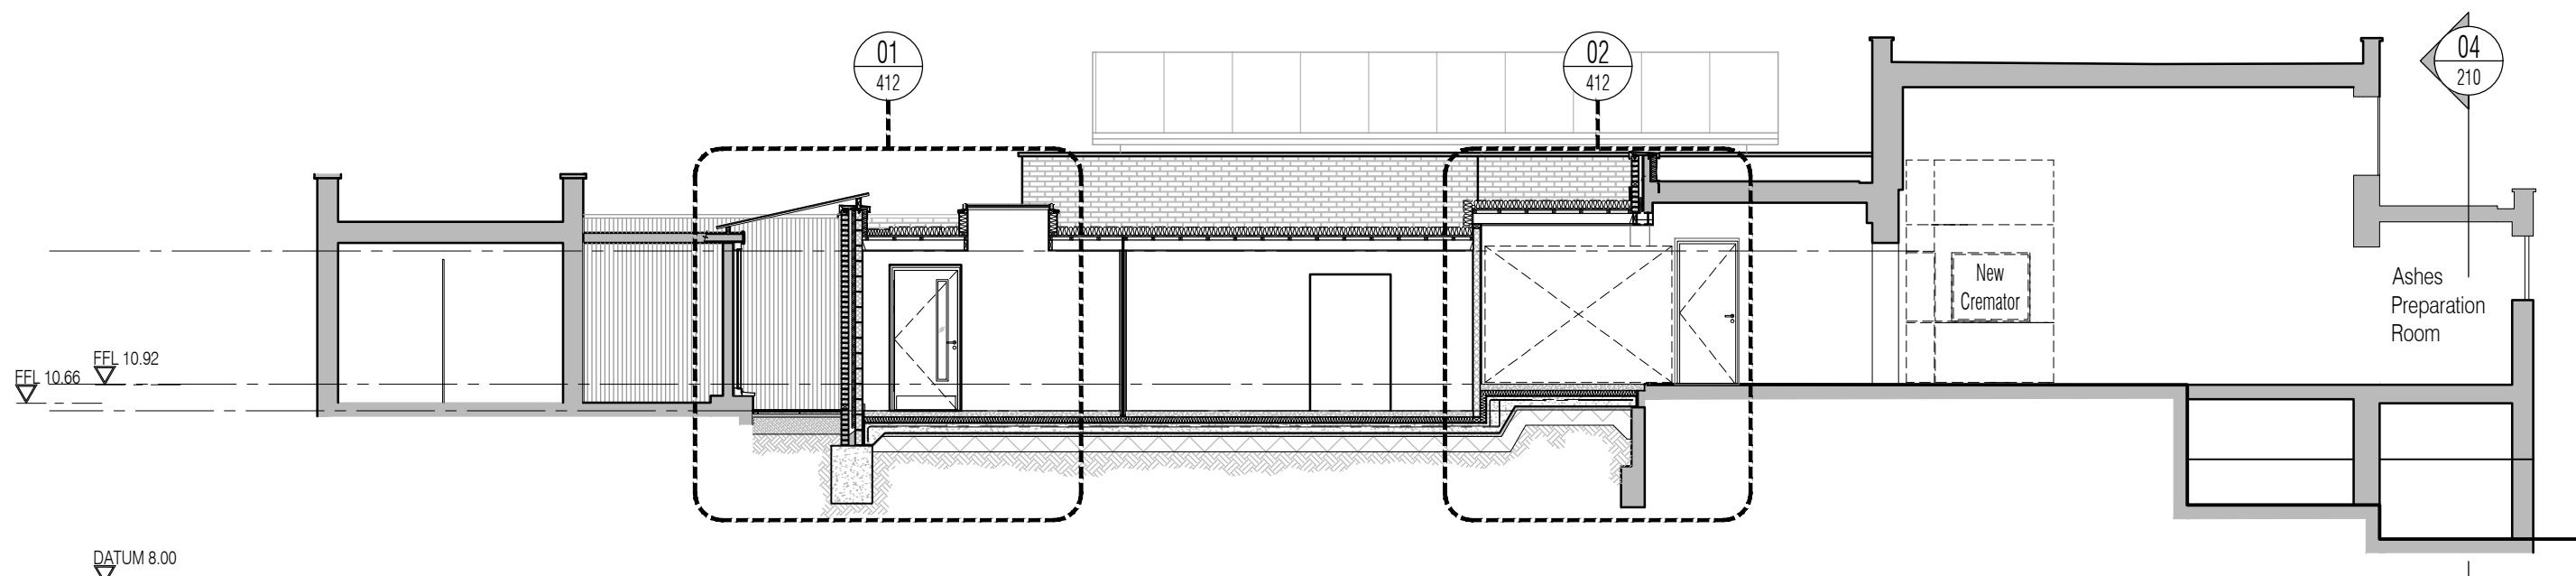


02 Section B
Scale: 1:100

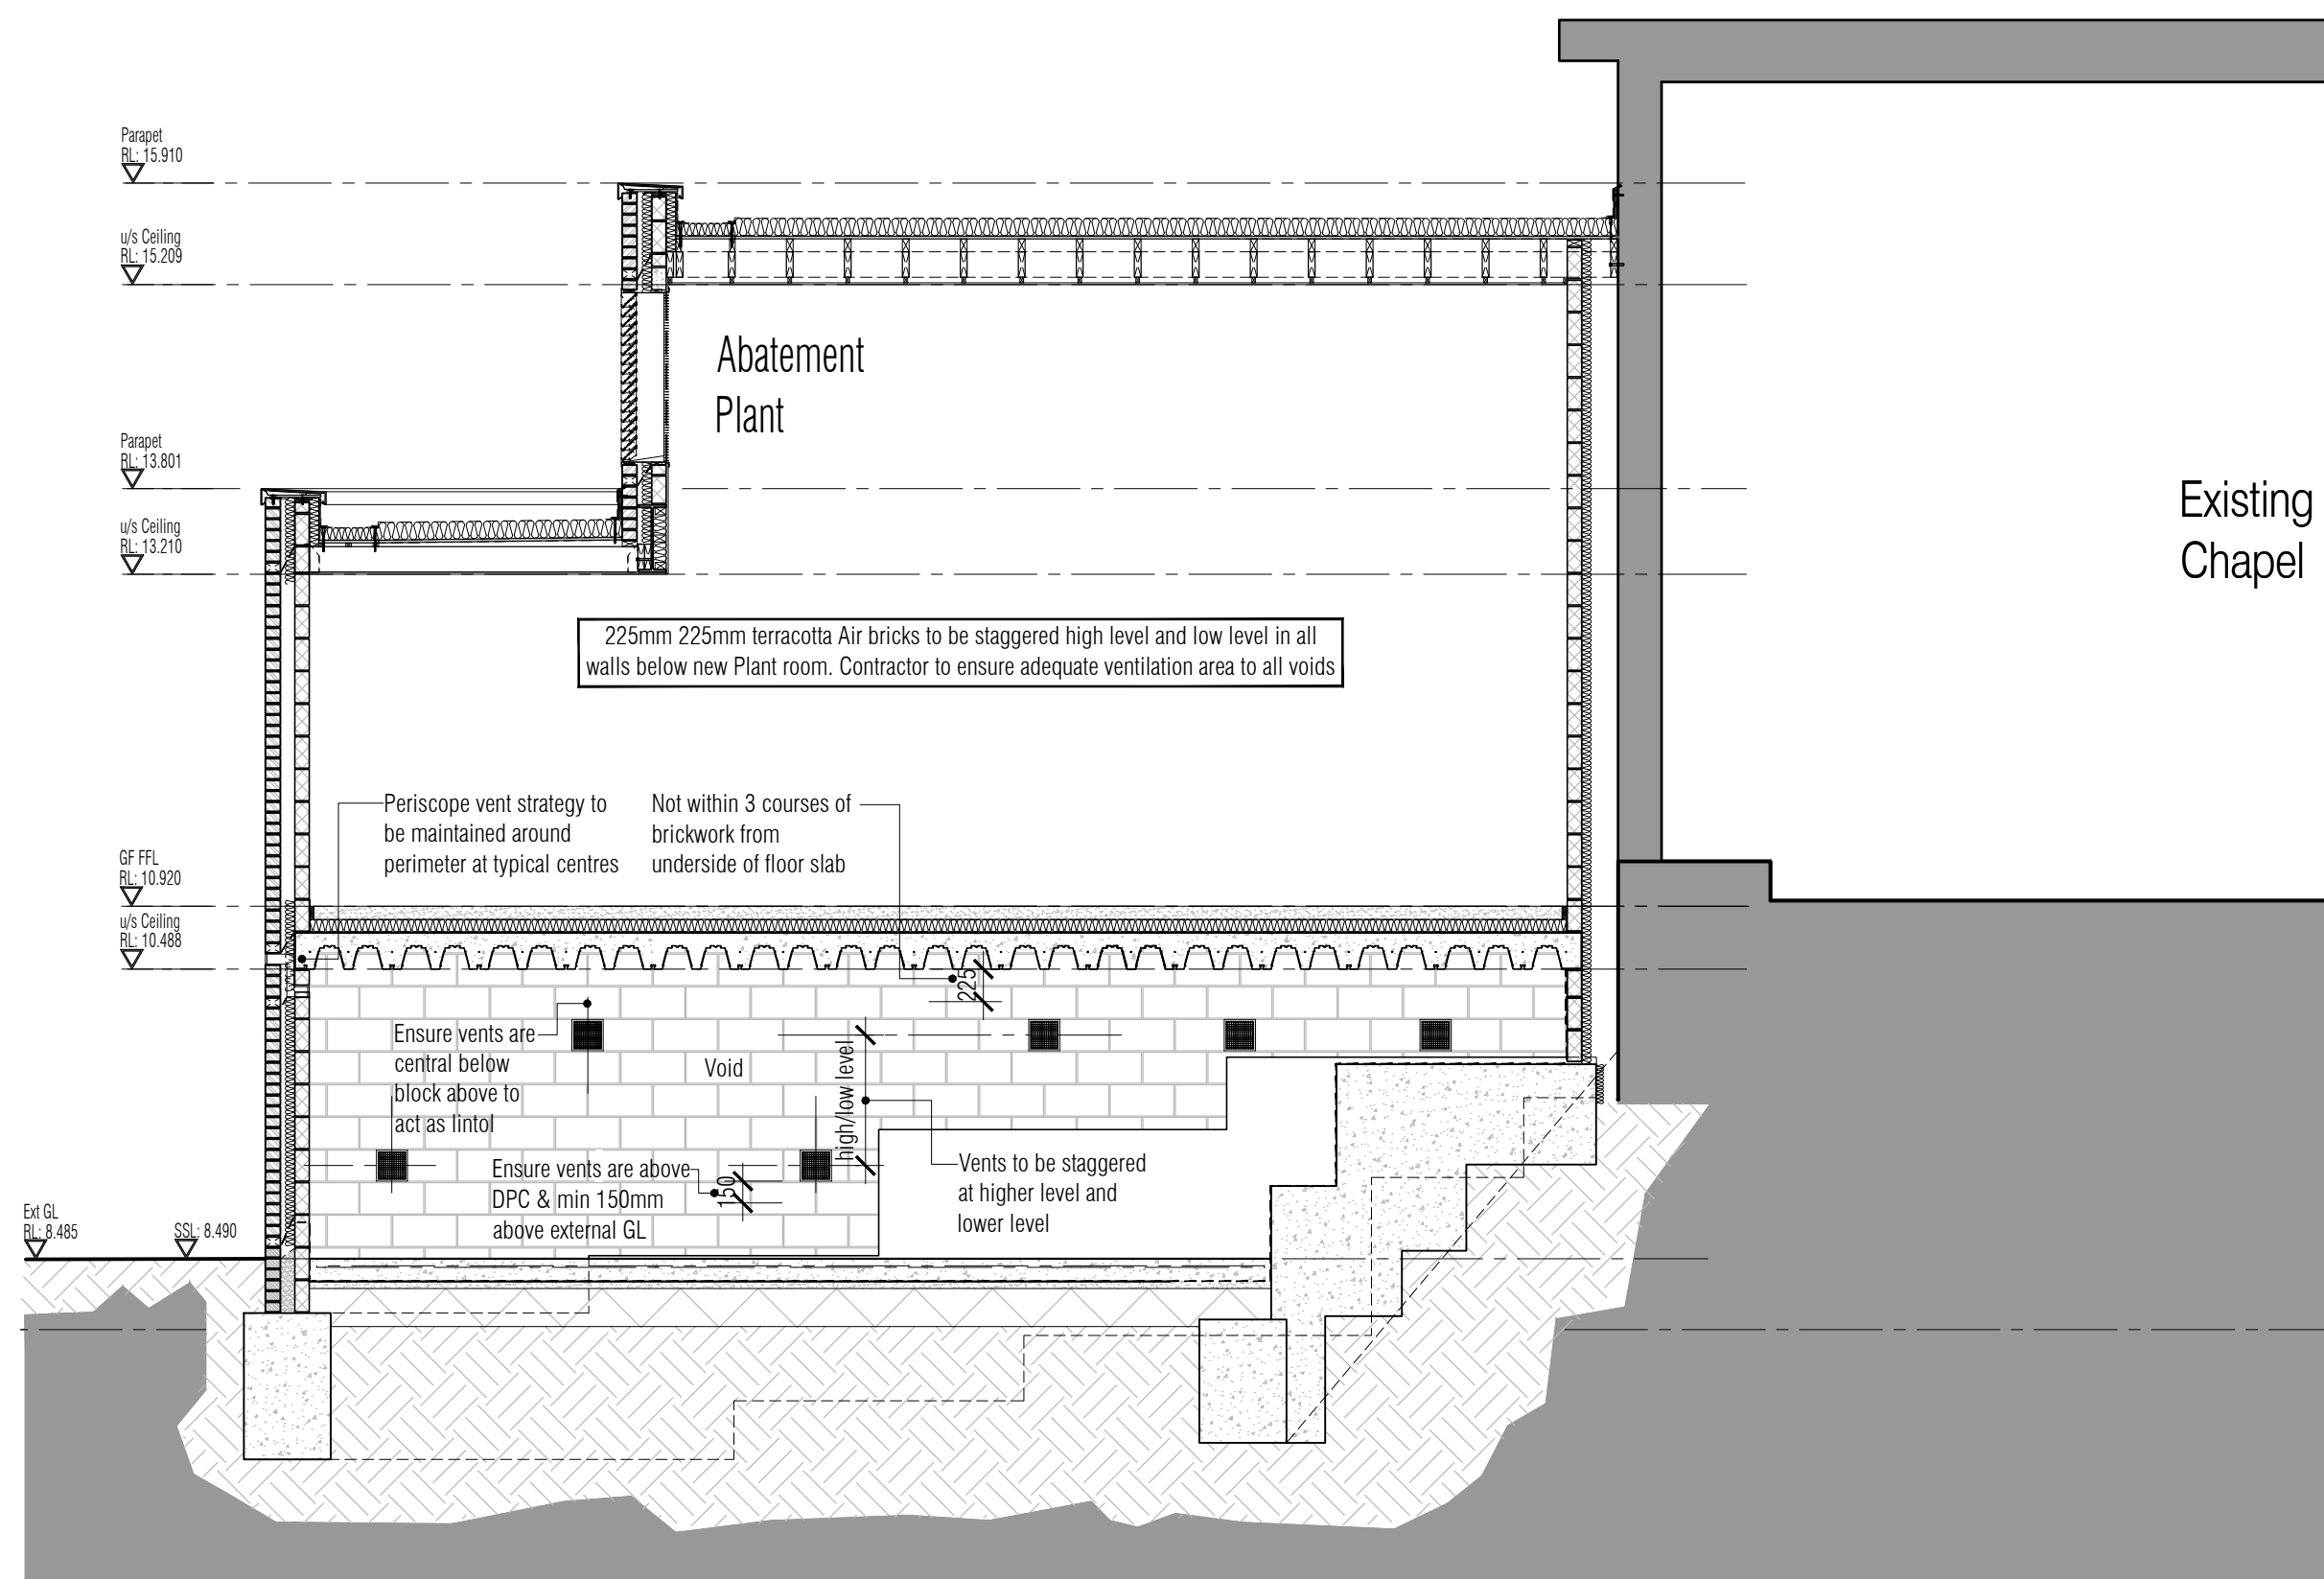

05 Section F
Scale: 1:50

NB: All information based on supplied third party survey information.
All discrepancies to be reported to FCG immediately upon discovery.

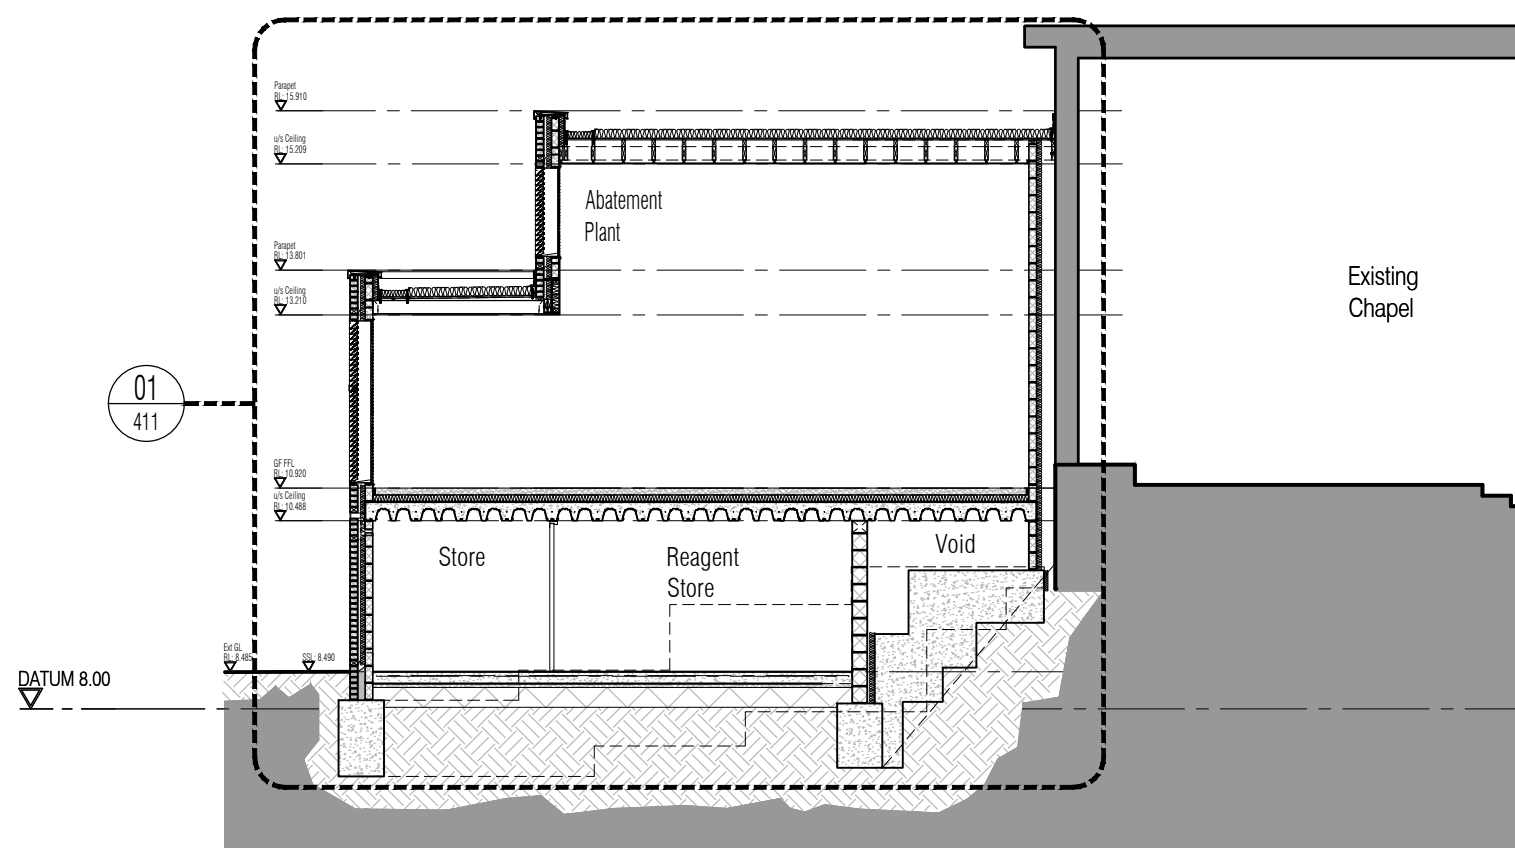


03 Section C
Scale: 1:100

Install new security door to new electrical cupboard. Install new lintol over in accordance with Structural Engineer's design and specification

Erect new blockwork wall from slab to u/s beam in accordance with Structural Engineer's design and specification and create 1125mm x 1125mm 1hr fire rated hatch to create gas enclosure.


Install new slab within small basement room to accommodate new electrical meter in accordance with Structural Engineer's design and specification

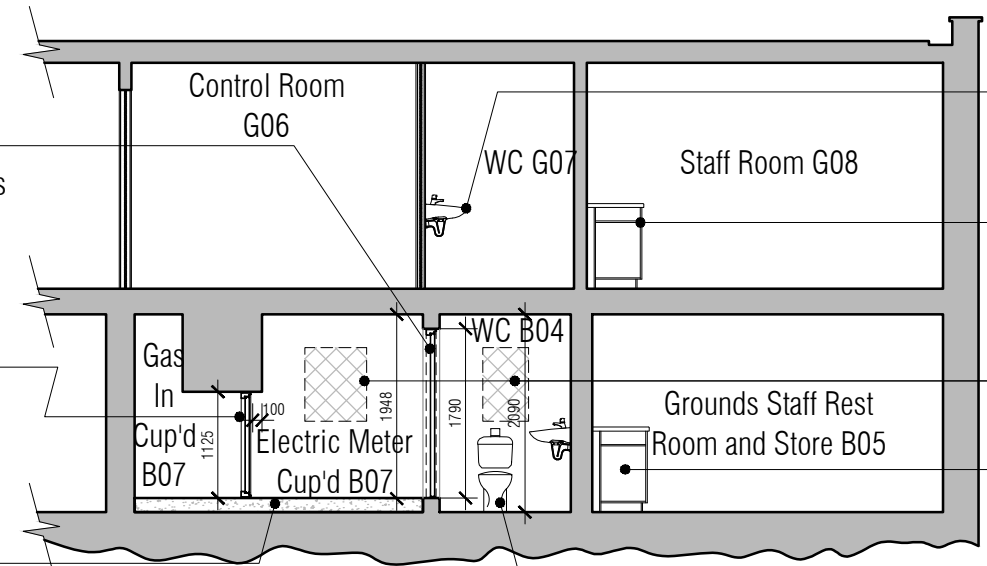

04 Partial Section E
Scale: 1:50

- Fit new toilet and sink units by Twyford's with new supply. New waste outlet connected to existing below ground drainage
- Fit new kitchenette and sink unit with new supply. New waste outlet connected to existing below ground drainage
- In fill existing openings with blockwork
- Fit new kitchenette and sink unit with new supply. New waste outlet connected to existing below ground drainage
- Fit new toilet and sink units by Twyford's with new supply. New waste outlet connected to existing below ground drainage

NOTES: Do not scale this drawing. All dimensions to be checked on site prior to commencement or manufacture.
Key Plan (nts)

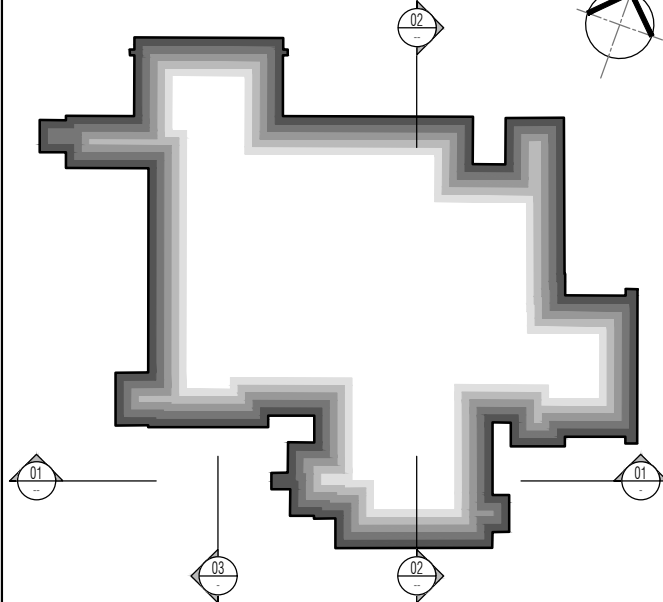

ISSUED FOR
CONSTRUCTION

All details referenced in call outs supersede general arrangement or larger depictions.				
C8	08.08.12	RKC	JAS	Vents elev added for clarity
C7	05.07.12	RKC	JAS	Reagent room & Exp Chimney founds revd
C6	19.06.12	RKC	JAS	Rooflight reduced
C5	12.06.12	RKC	JAS	Parapet revd.
C4	28.05.12	RKC	JAS	Section updated. Reels added
C3	24.04.12	RKC	JAS	Gas cupboard created. Notes added.
C2	23.04.12	RKC	JAS	Section E added
C1	29.03.12	RKC	JAS	Issued for CONSTRUCTION
Rev	Date	By	CHK	Comment

BRINGING IDEAS TO LIFE



FRANKHAM

Frankham Consultancy Group Limited
21 Perryman Road
Haywards Heath RH16 3TP
t 01444 444900 f 01444 455642
enquiries@frankham.com
www.frankham.com

Client	 Mansell Contract N°: MC0269
--------	---

Project Title	Eastbourne & Worthing Crematoria Refurbishments and Alterations
---------------	---


Drawing Title	 Eastbourne Crematorium Proposed Sections A, B & C
---------------	---

Drawn by: RKC	Scale: 1:100@A1	Date: 28.10.11
Designed by: FCG	Checked by: JAS	Approved by: AC


File Ref.: K:\FRANKHAM\2 - CREMATORIA\ARCH\026-099-SECTIONA
307380-A-210-0300 - 290611121518

20.06.11 12:15:20

Drawing No. 521260-A-210-E	Rev. C8
-------------------------------	------------

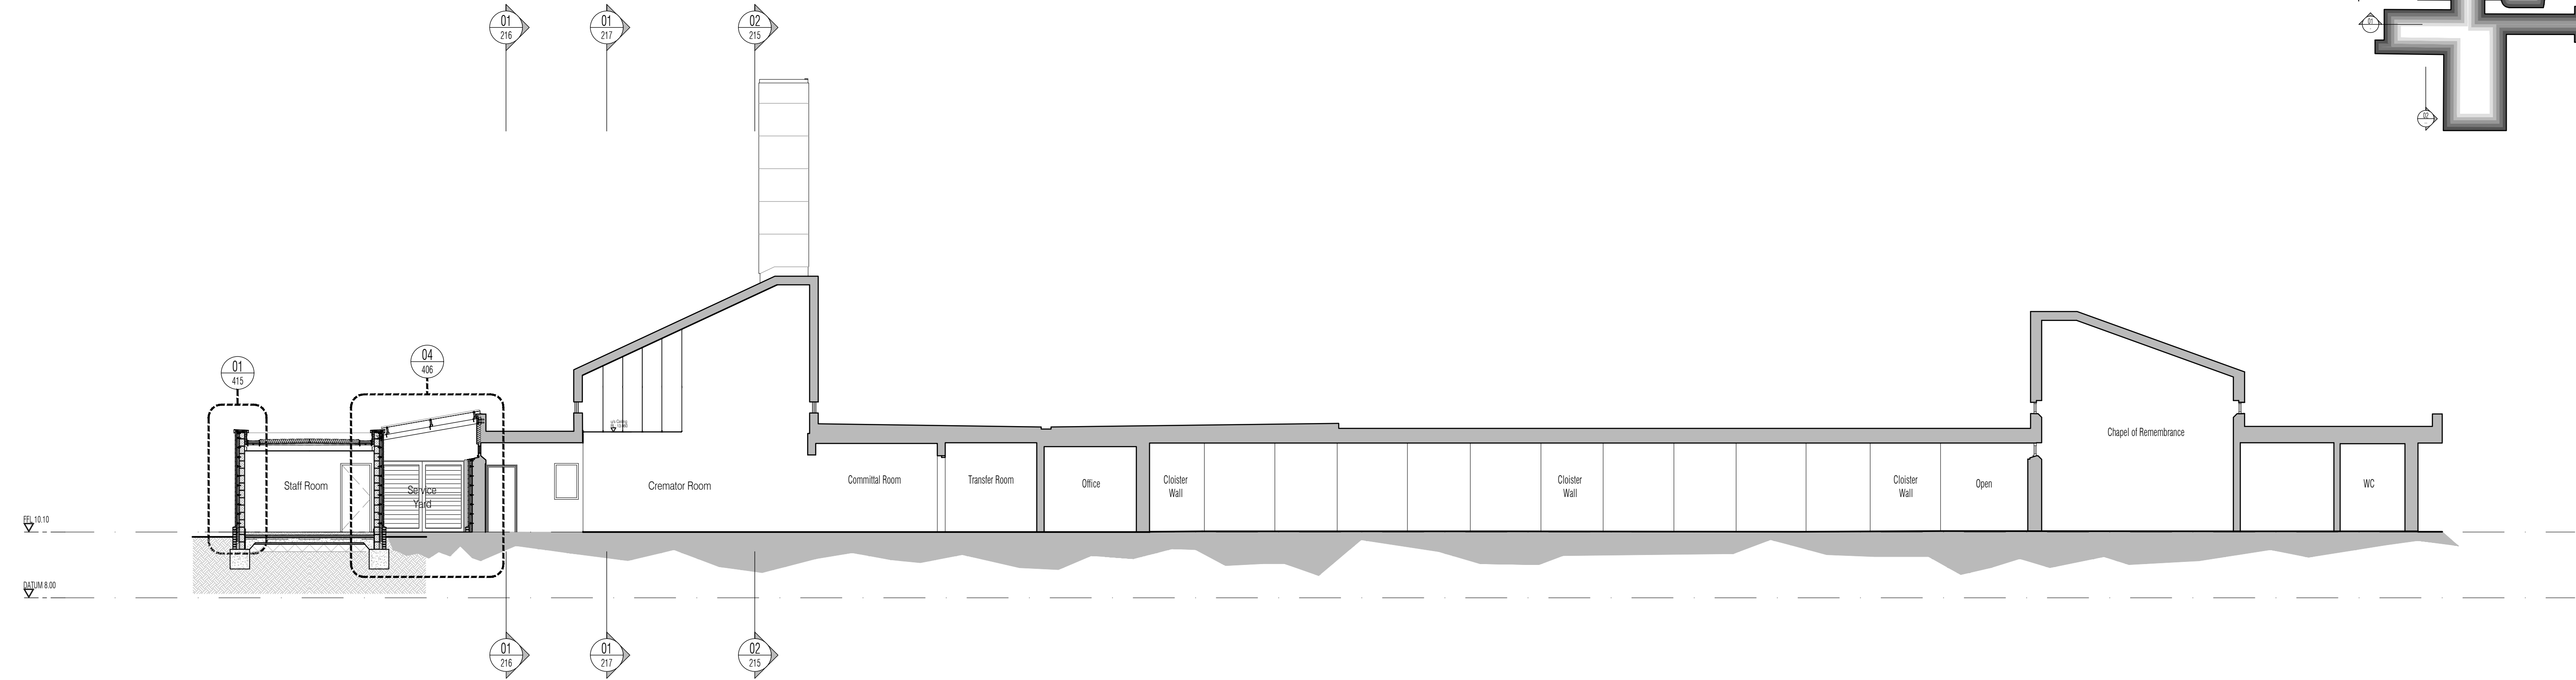


01 Section A
Scale: 1:100

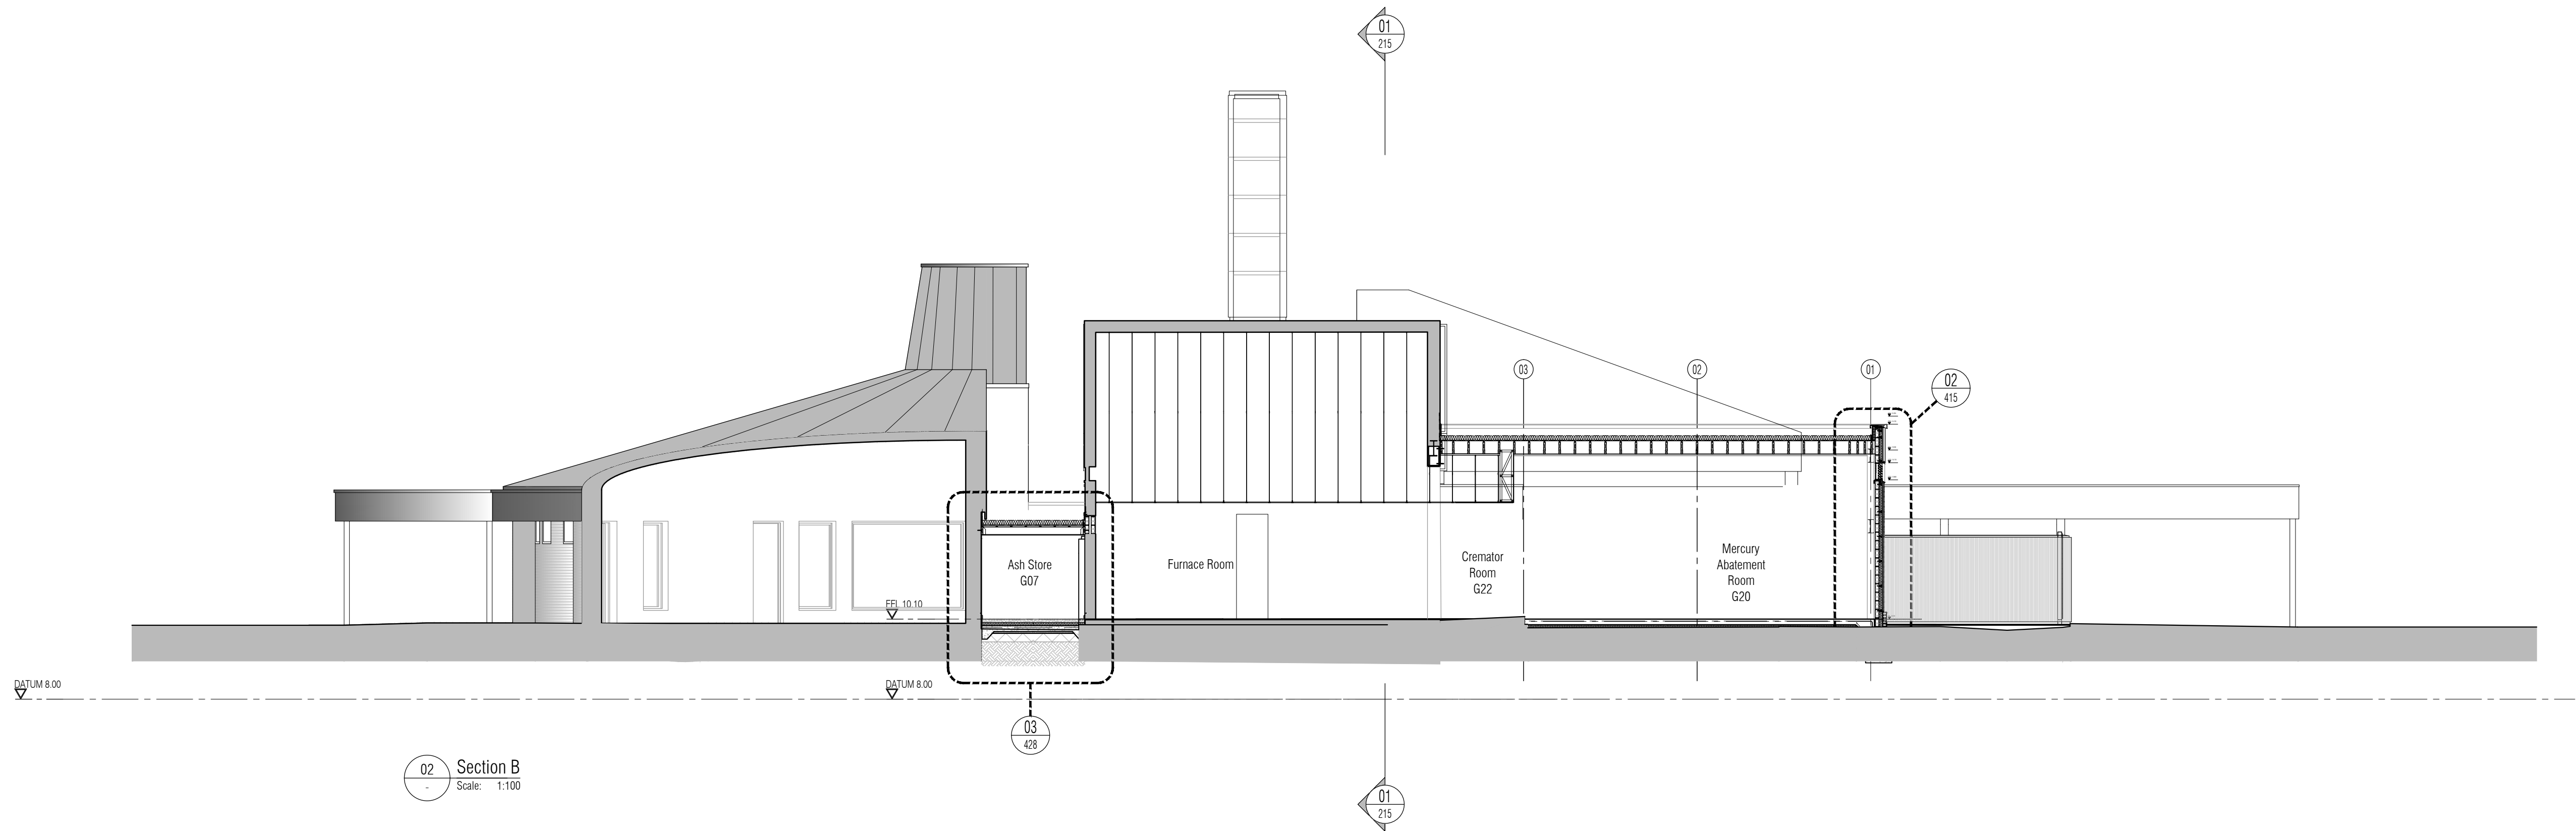

02 Section B
Scale: 1:100

NOTES: Do not scale this drawing. All dimensions to be checked on site prior to commencement or manufacture.
Key Plan (nts)

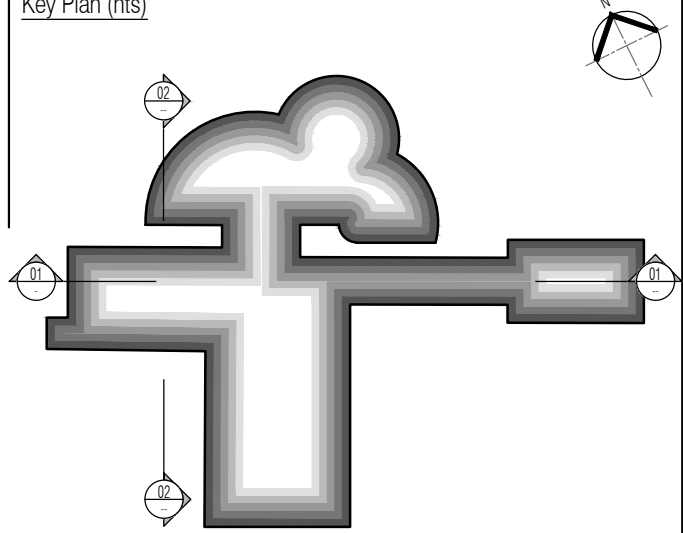

ISSUED FOR
CONSTRUCTION

All details referenced in call outs supercede general arrangement or larger depictions.

Rev	Date	By	Chk	Comment
C2	09.07.12	RKC	JAS	Issued for Construction
P6	01.06.12	RKC	JAS	Refs added
P5	16.05.12	RKC	JAS	Redesign revs
C1	23.04.12	RKC	JAS	Issued for CONSTRUCTION

BRINGING IDEAS TO LIFE



FRANKHAM

Frankham Consultancy Group Limited
21 Perryman Road
Haywards Heath RH16 3TP
t 01444 444900 f 01444 455642
enquire@frankham.com
www.frankham.com

Client
Mansell
Contract N°: Worthing

Project Title
Eastbourne & Worthing
Crematoria
Refurbishments and Alterations


Drawing Title
Worthing
Worthing Crematorium
Proposed Sections A & B

Drawn by: RKC	Scale: 1:100@A1	Date: 28.10.11
Designed by: FCG	Checked by: JAS	Approved by: AC

File Ref.: X:\FRANKHAM\2_080512\180 CREMATORIA\ARCH\026-009-021000A
301360-A-215-W-0060 - 200811171535 20.06.11.12.15.27

Drawing No. 521260-A-215-W	Rev. C2
-------------------------------	------------


NB: All information based on supplied third party survey information.
All discrepancies to be reported to FCG immediately upon discovery.

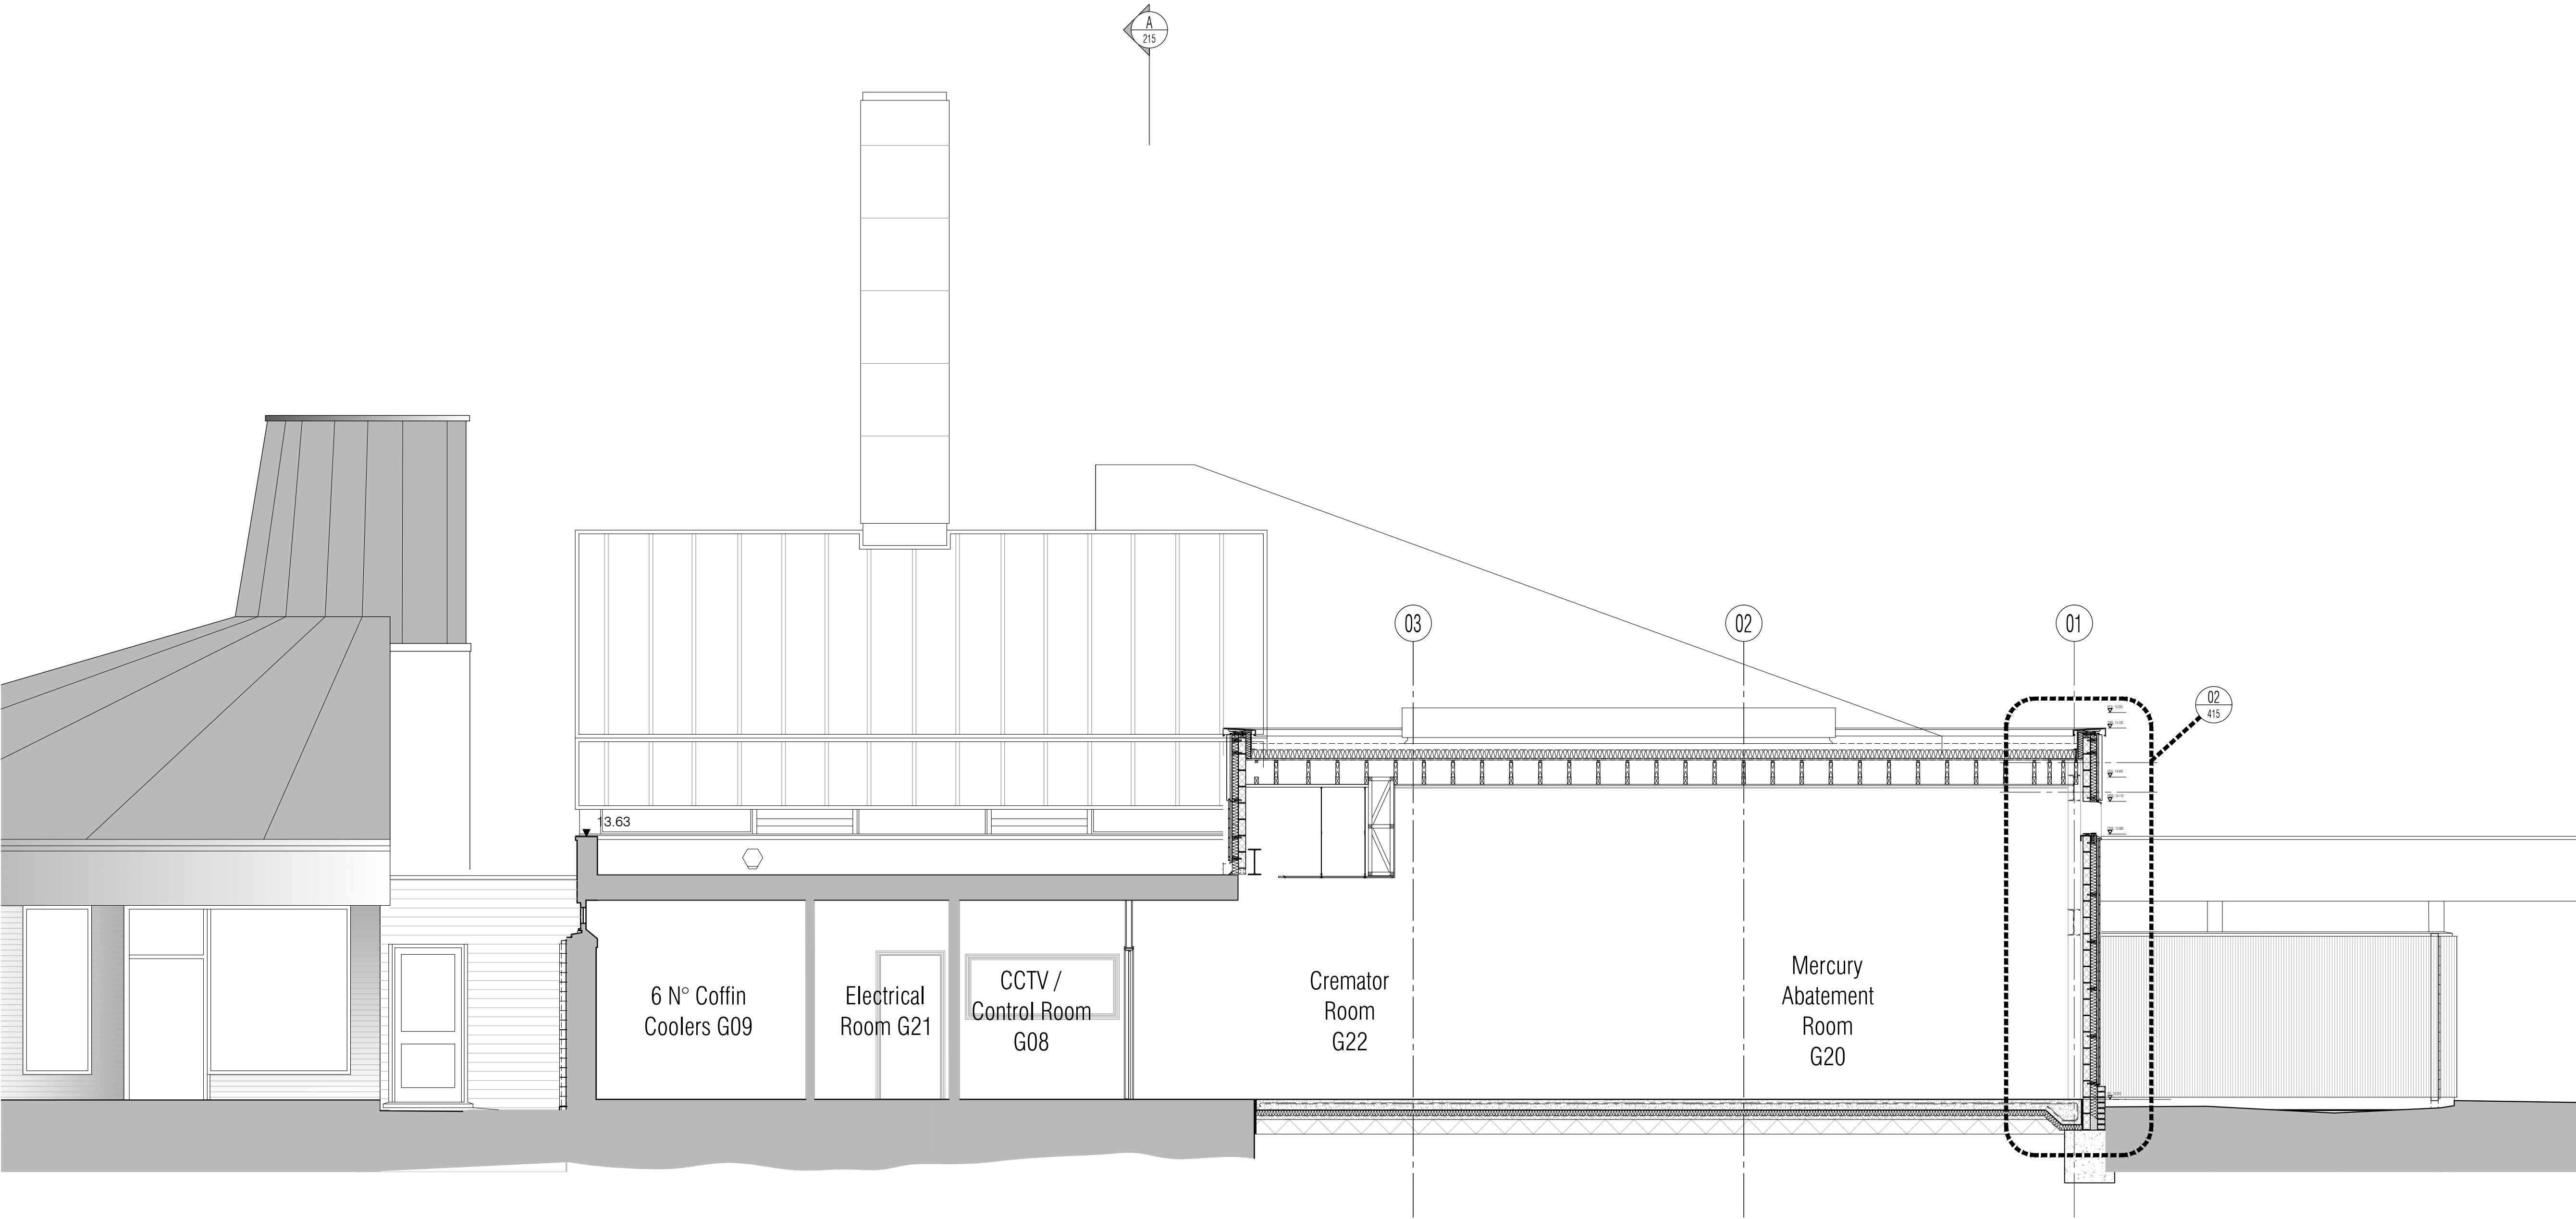

01 Section E
Scale: 1:50

NB: All information based on supplied third party survey information.
All discrepancies to be reported to FCG immediately upon discovery.

NOTES: Do not scale this drawing. All dimensions to be checked on site prior to commencement or manufacture.
Key Plan (nts)

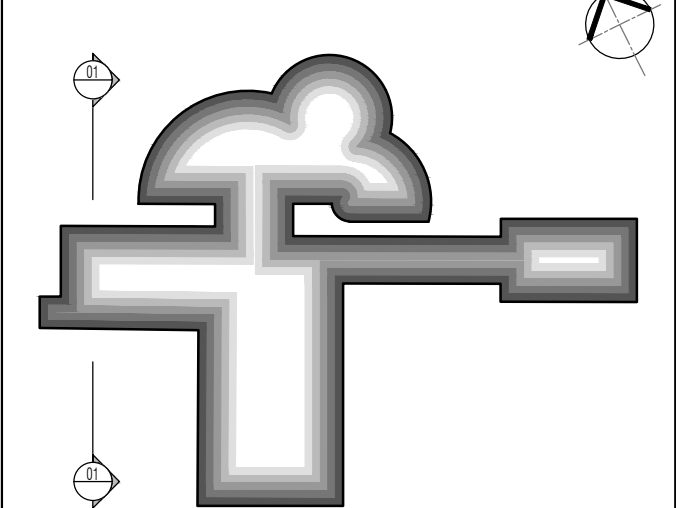

ISSUED FOR
CONSTRUCTION

All details referenced in call outs supersede general arrangement or larger depictions.

Rev	Date	By	Chk	Comment
C2	09.07.12	RKC	JAS	Issued for Construction
P3	01.06.12	RKC	JAS	Issued for Stage F
P2	16.05.12	RKC	JAS	Redesign revs
C1	23.04.12	RKC	JAS	Issued for CONSTRUCTION

BRINGING IDEAS TO LIFE

FRANKHAM

Frankham Consultancy Group Limited
21 Perryman Road
Haywards Heath RH16 3TP
t 01444 444900 f 01444 455642
enquiries@frankham.com
www.frankham.com

Client
Mansell
Contract N°: Worthing


Project Title
Eastbourne & Worthing
Crematoria
Refurbishments and Alterations

Drawing Title
Worthing
Worthing Crematorium
Proposed Section E

Drawn by: RKC	Scale: 1:50@A1	Date: 28.10.11
Designed by: FCG	Checked by: JAS	Approved by: AC


File Ref.: X:\FRANKHAM\2_080512180 CREMATORIA\WORKING\289-SECTION E.dwg 20.06.11 12:15:32

Drawing No. 521260-A-216-W	Rev. C2
-------------------------------	------------

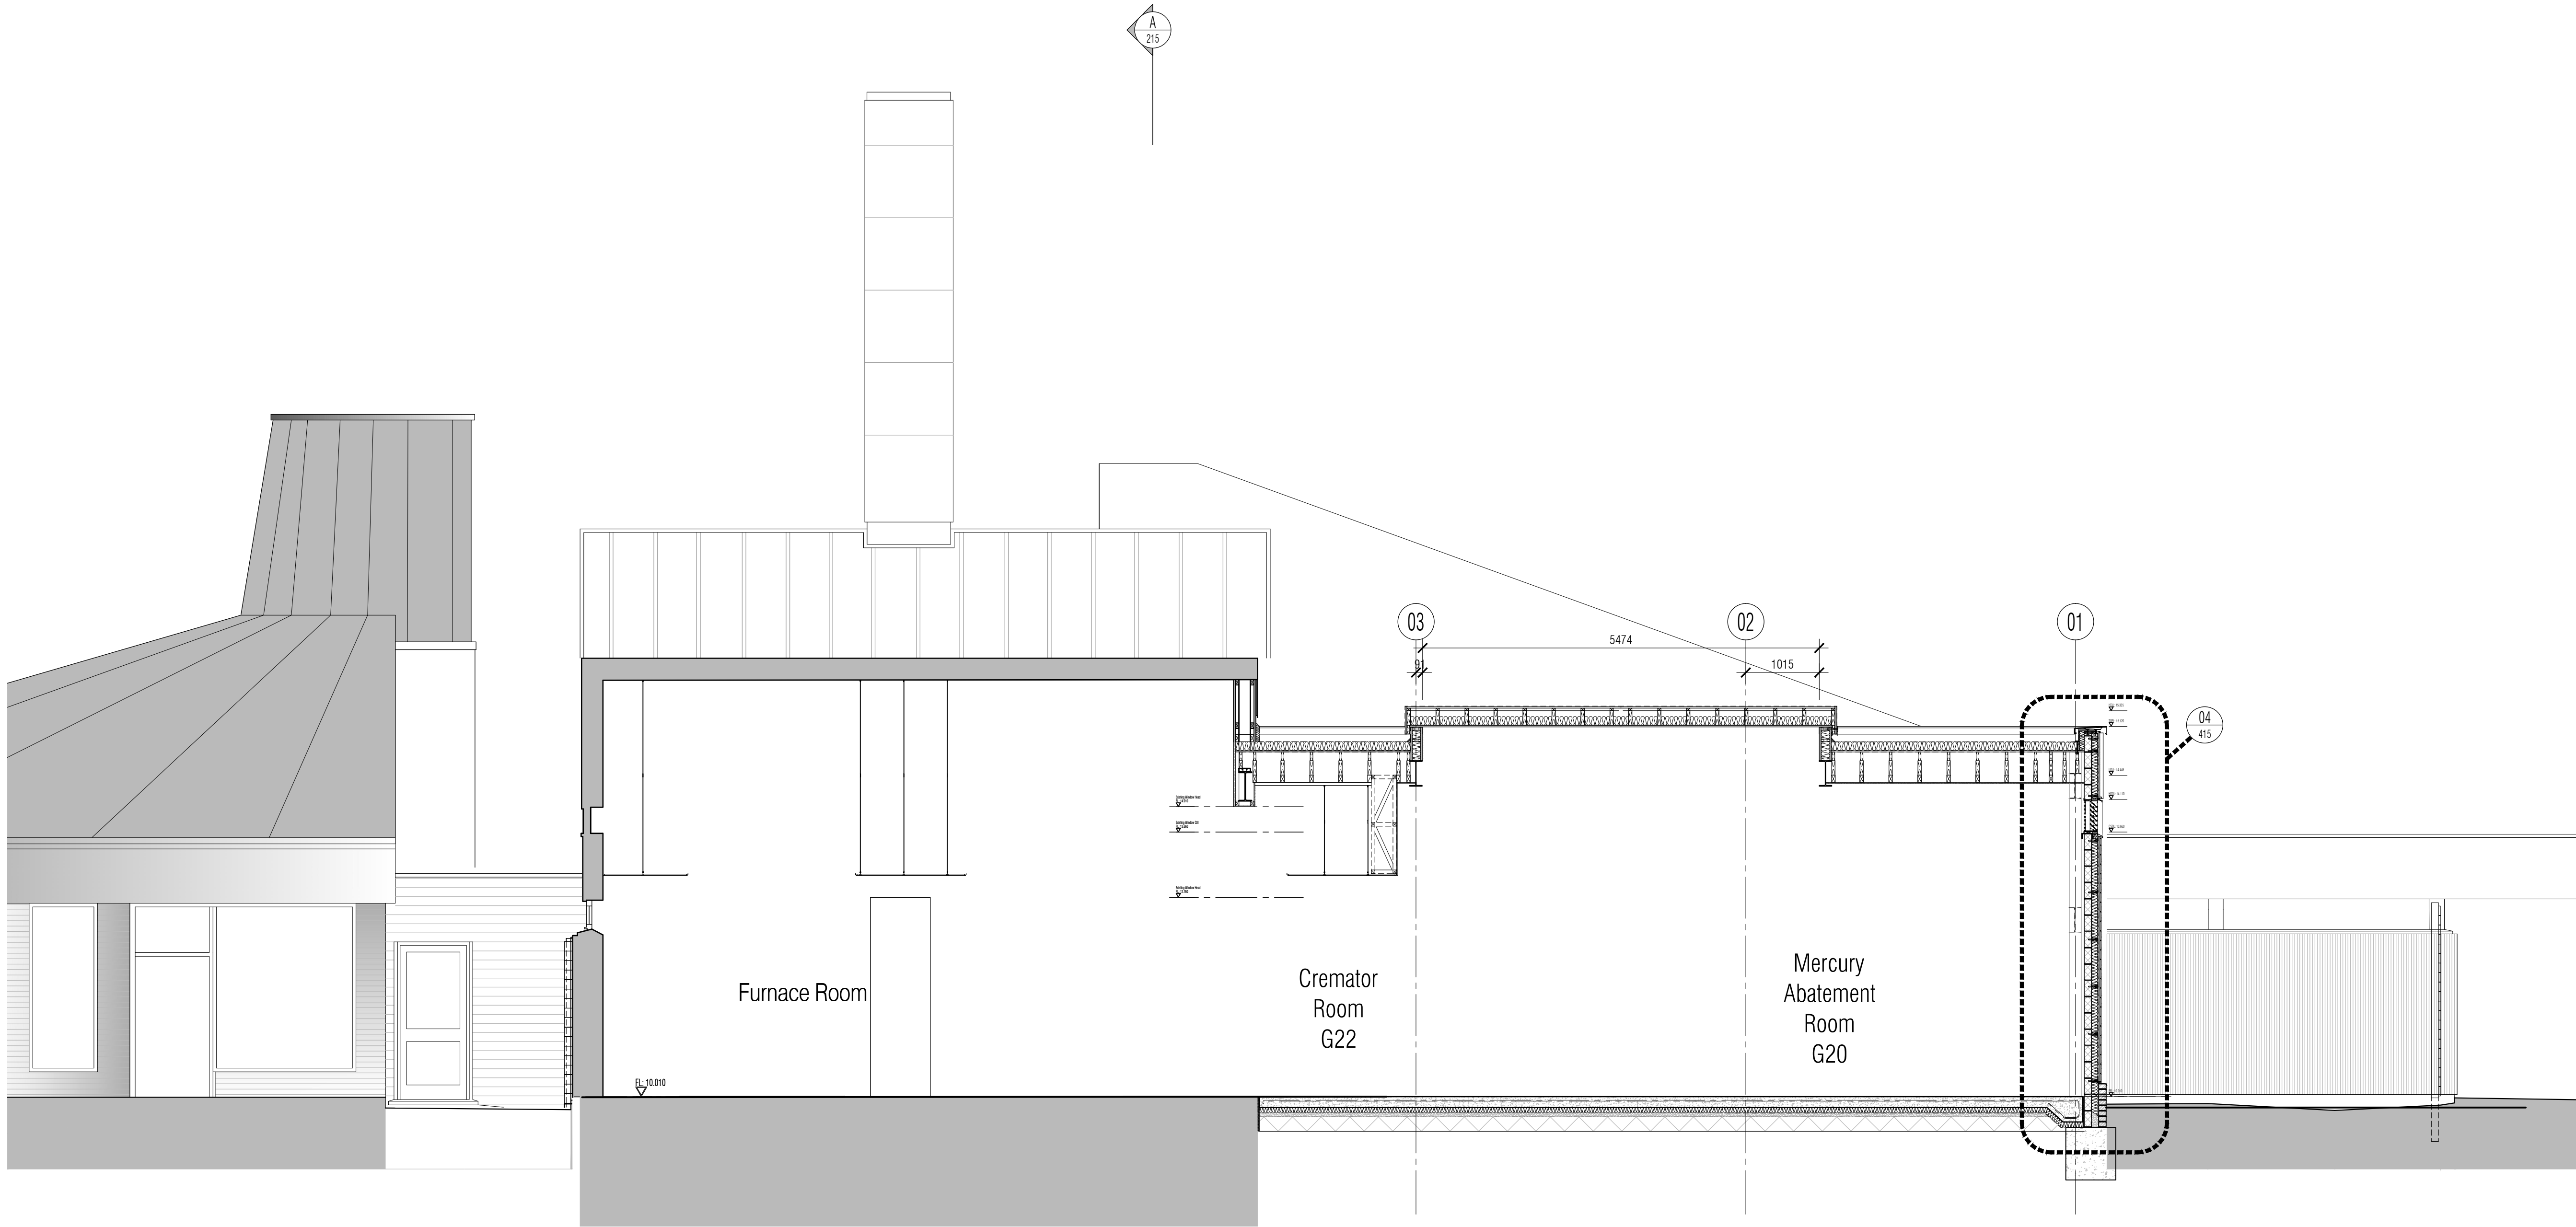

01 Section F
Scale: 1:50

NOTES: Do not scale this drawing. All dimensions to be checked on site prior to commencement or manufacture.
Key Plan (nts)

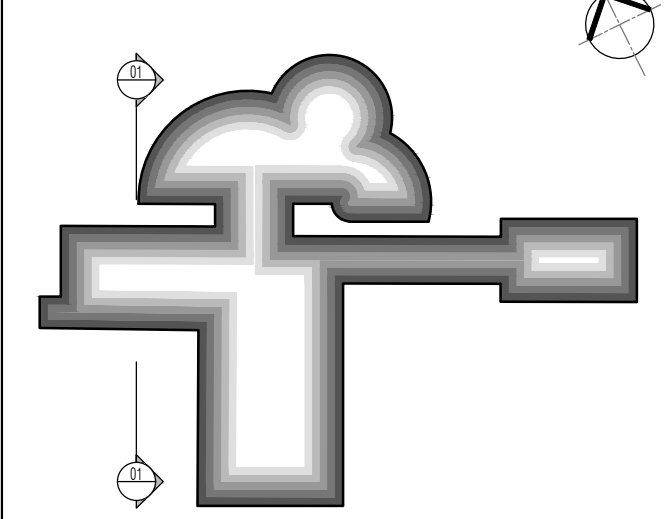

ISSUED FOR CONSTRUCTION

All details referenced in call outs supersede general arrangement or larger depictions.

Rev	Date	By	Chk	Comment
C2	09.07.12	RKC	JAS	Issued for Construction
P4	01.06.12	RKC	JAS	Issued for Stage F
P3	16.05.12	RKC	JAS	Redesign revs
C1	23.04.12	RKC	JAS	Issued for CONSTRUCTION

BRINGING IDEAS TO LIFE

FRANKHAM

Frankham Consultancy Group Limited
21 Perryman Road
Haywards Heath RH16 3TP
t 01444 444900 f 01444 455642
enquiries@frankham.com
www.frankham.com

Client

Mansell
Contract N°: Worthing

Project Title

Eastbourne & Worthing
Crematoria
Refurbishments and Alterations

Drawing Title


Worthing
Worthing Crematorium
Proposed Section F

Drawn by: RKC	Scale: 1:50@A1	Date: 28.10.11
Designed by: FCG	Checked by: JAS	Approved by: AC


File Ref.: X:\FRANKHAM\2_080512180 CREMATORIA\WORTHING\026-099-0212000 20.06.11 12:15:37

Drawing No: 521260-A-217-W	Rev: C2
-------------------------------	------------

NB: All information based on supplied third party survey information.
All discrepancies to be reported to FCG immediately upon discovery.

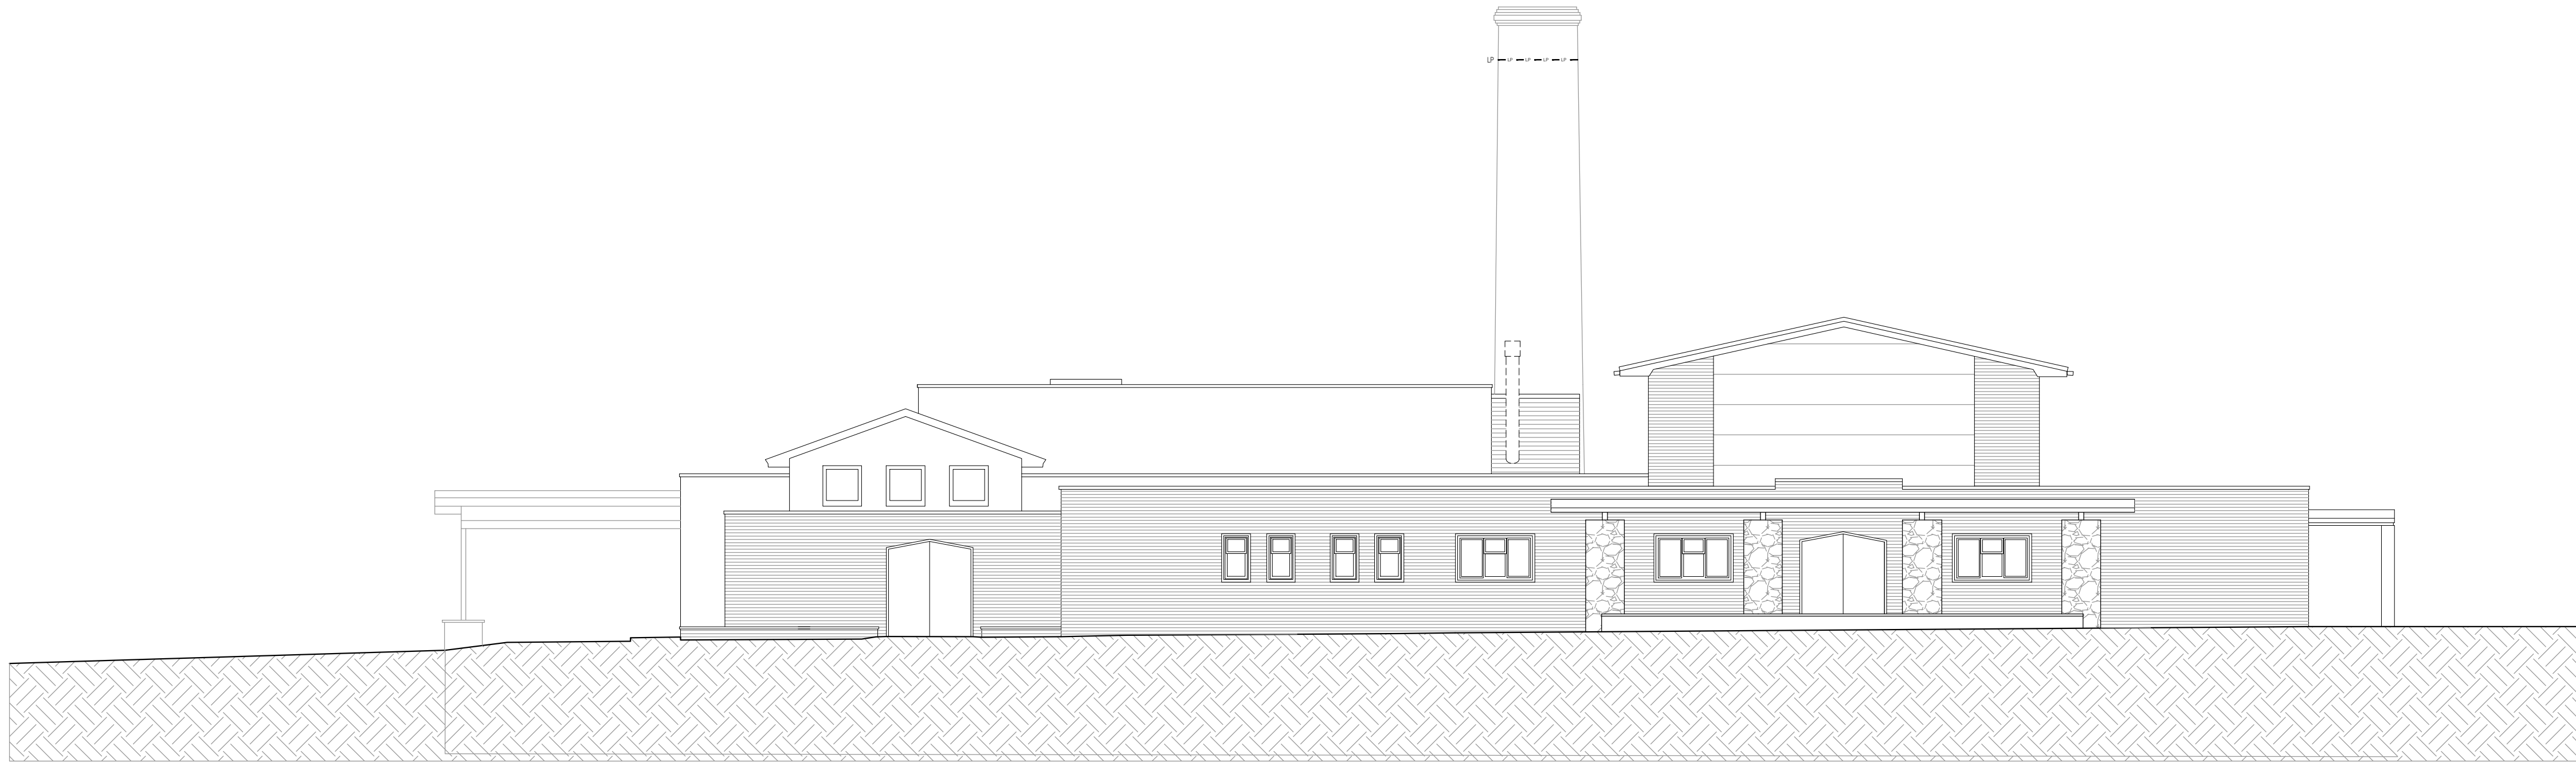


01 North Elevation
Scale: 1:100

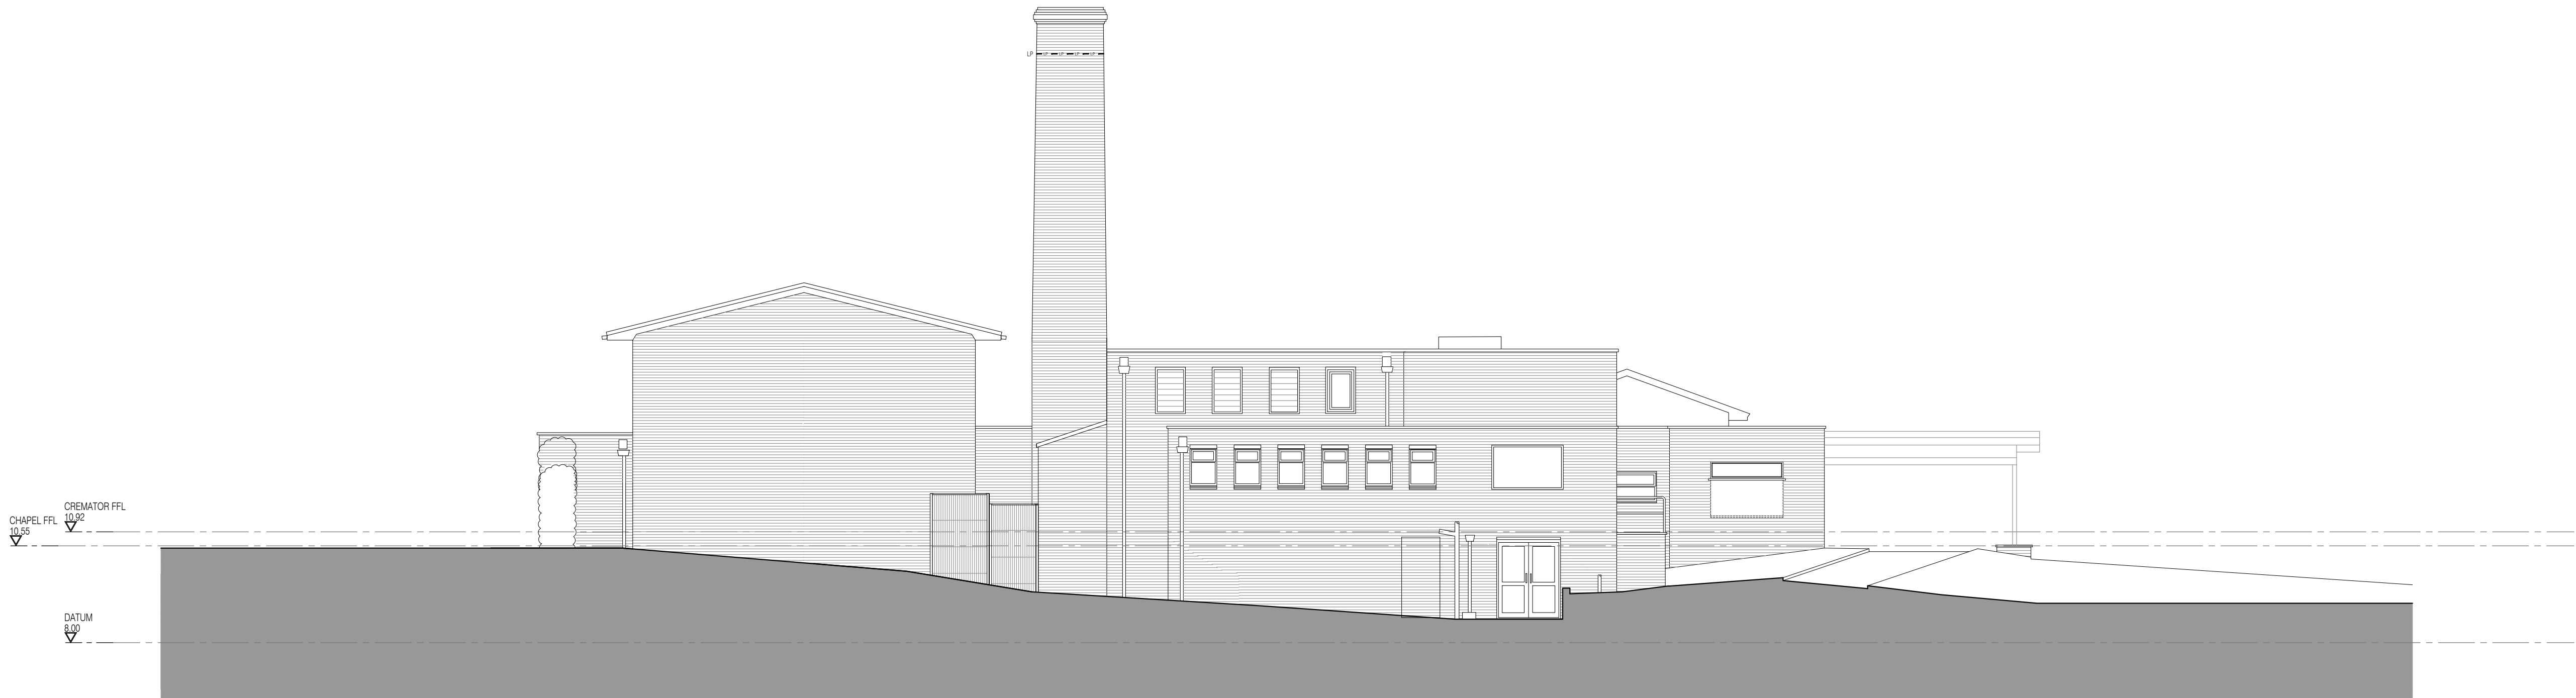

02 South Elevation
Scale: 1:100

NB: All information based on supplied third party survey information.
All discrepancies to be reported to FCG immediately upon discovery.

NOTES: Do not scale this drawing. All dimensions to be checked on site prior to commencement or manufacture.
Key Plan (nts)

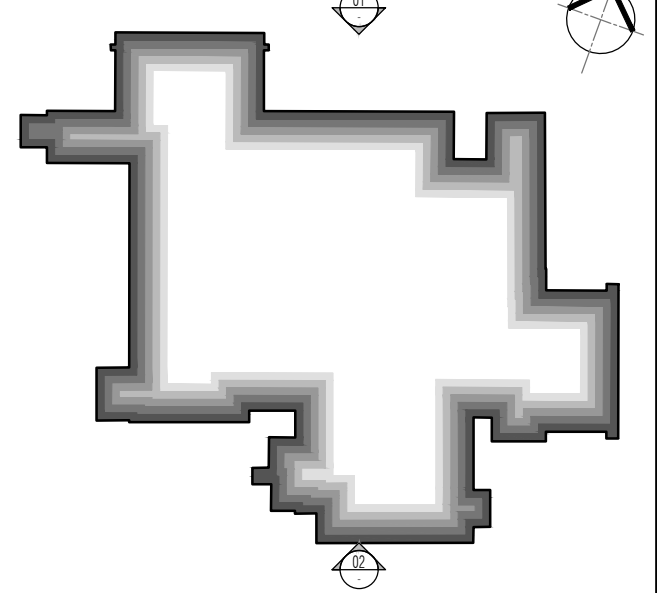

ISSUED FOR
CONSTRUCTION

All details referenced in call outs supercede general arrangement or larger depictions.

Rev	Date	By	Chk	Comment
C2	16.05.12	RKC	JAS	Existing Lightning Protection indicated
C1	29.03.12	RKC	JAS	Issued for CONSTRUCTION

BRINGING IDEAS TO LIFE



FRANKHAM

Frankham Consultancy Group Limited
21 Perryman Road
Haywards Heath RH16 3TP
t 01444 444900 f 01444 455642
enquire@frankham.com
www.frankham.com

Client


Contract N°: MC0269

Project Title

Eastbourne & Worthing
Crematoria
Refurbishments and Alterations


Drawing Title


Eastbourne Crematorium
Existing North & South Elevations


Drawn by: RKC	Scale: 1:100@A1	Date: 28.10.11
Designed by: FCG	Checked by: JAS	Approved by: AC

File Ref.: X:\FRANKHAM\2_080512180 CREMATORIA\ARCH\006-000 ELEVATIONS
20.06.11 12:15:42

Drawing No. 521260-A-300-E	Rev. C2
-------------------------------	------------

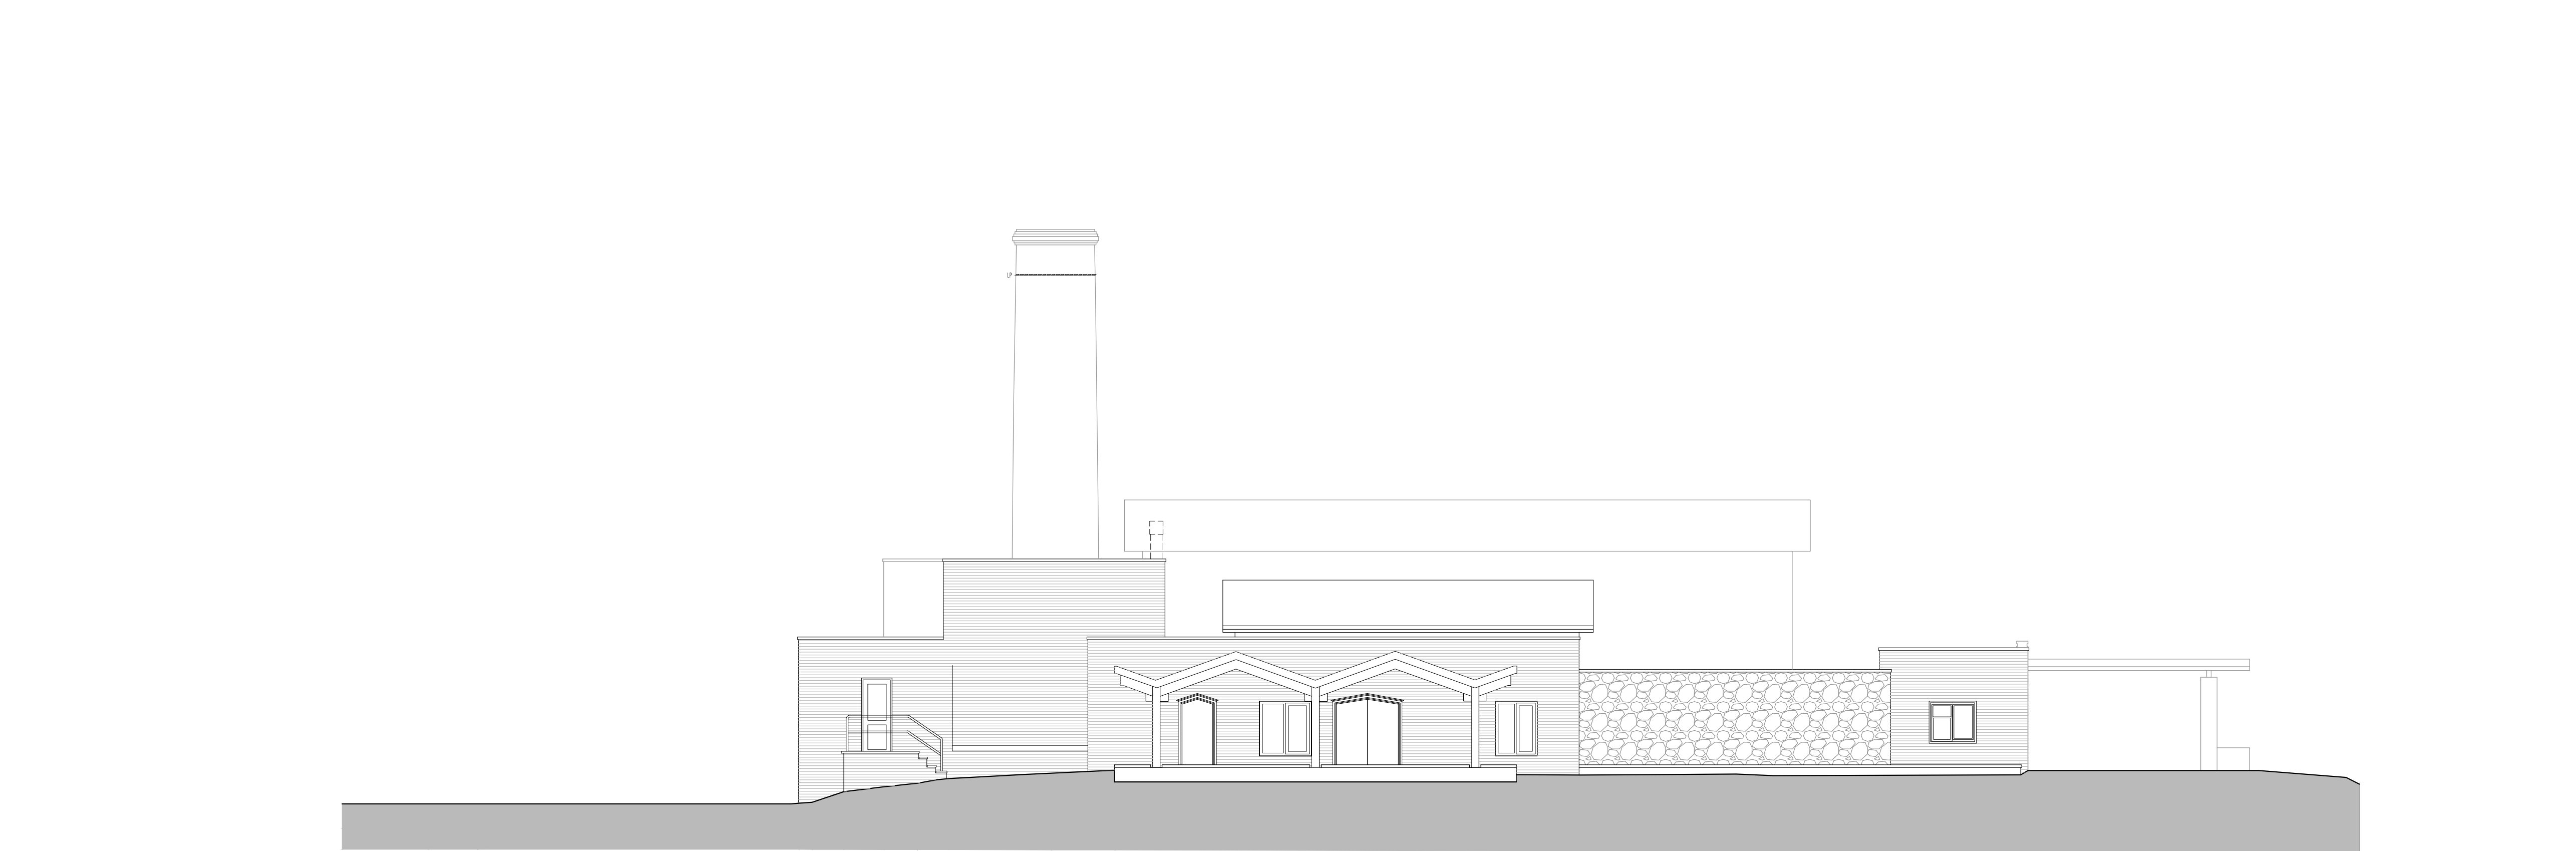

01 East Elevation
Scale: 1:100

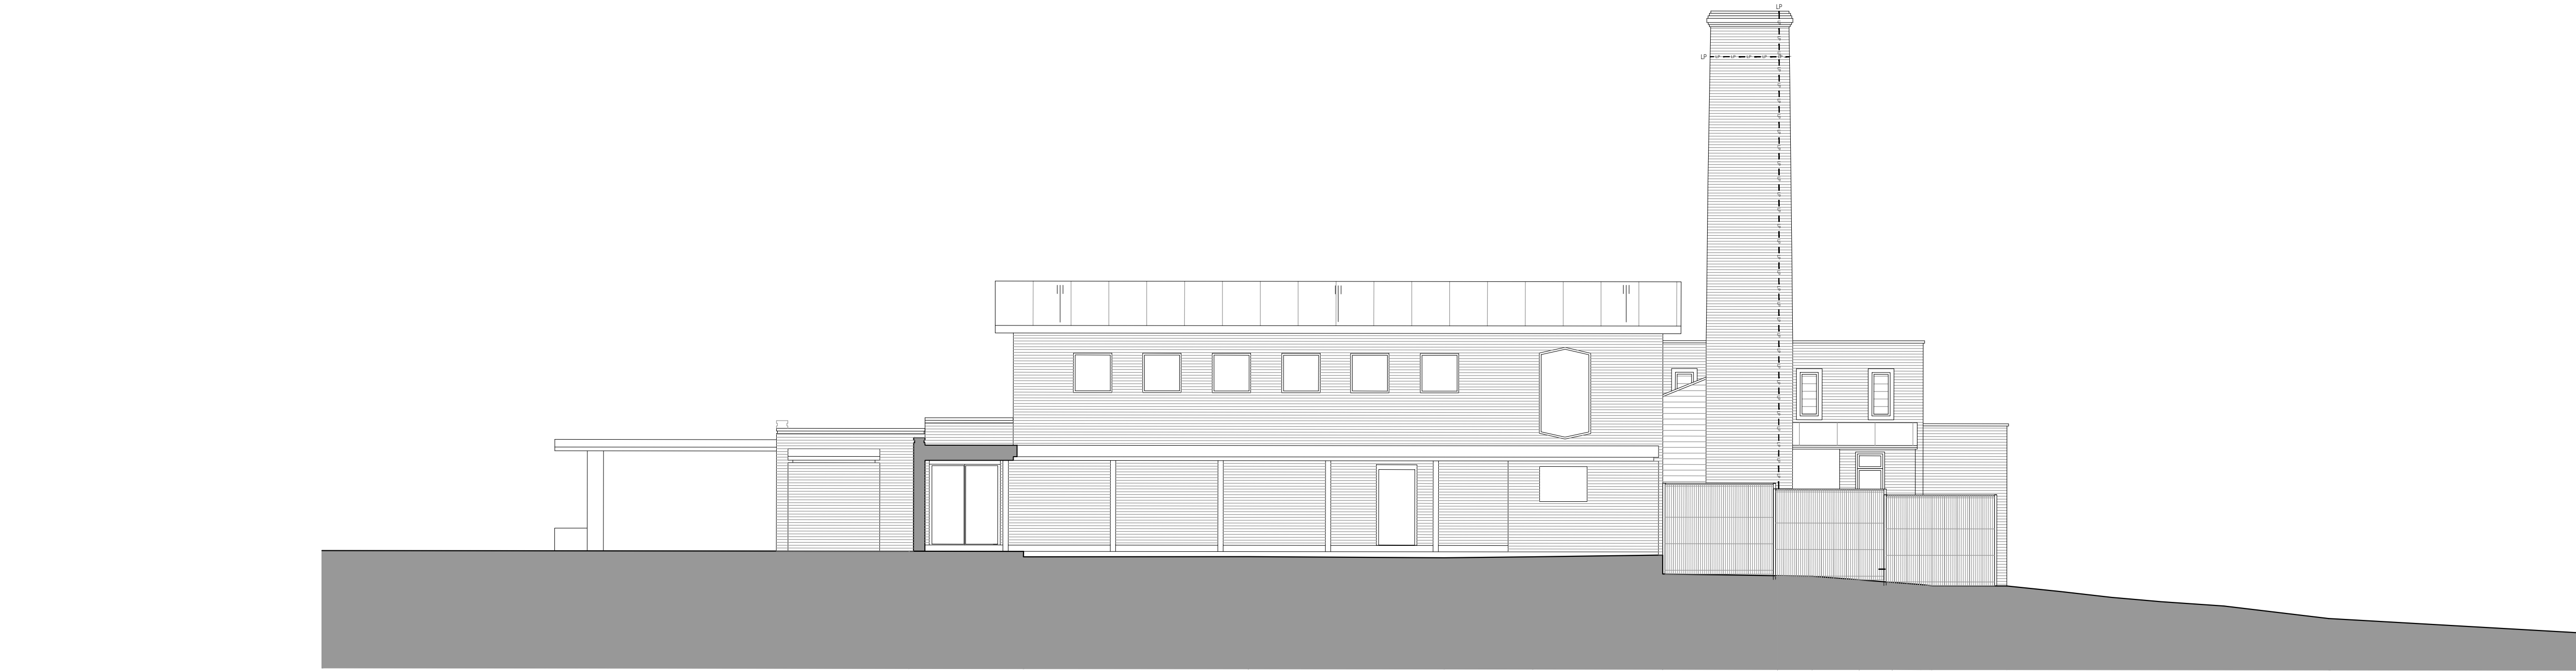

02 West Elevation
Scale: 1:100

NB: All information based on supplied third party survey information.
All discrepancies to be reported to FCG immediately upon discovery.

NOTES: Do not scale this drawing. All dimensions to be checked on site prior to commencement or manufacture.
Key Plan (nts)

ISSUED FOR CONSTRUCTION

All details referenced in call outs supersede general arrangement or larger depictions.

Rev	Date	By	Chk	Comment
C2	16.05.12	RKC	JAS	Existing Lightning protection indicated
C1	29.03.12	RKC	JAS	Issued for CONSTRUCTION

BRINGING IDEAS TO LIFE

FRANKHAM

Frankham Consultancy Group Limited
21 Perrymount Road
Haywards Heath RH16 3TP
t 01444 444900 f 01444 455642
enquire@frankham.com
www.frankham.com

Client

Contract N°: MC0269

Project Title


Eastbourne & Worthing
Crematoria
Refurbishments and Alterations

Drawing Title


Eastbourne Crematorium
Existing East & West Elevations

Drawn by: RKC	Scale: 1:100@A1	Date: 28.10.11
Designed by: FCG	Checked by: JAS	Approved by: AC

File Ref.: X:\FRANKHAM\2_080512180 CREMATORIA\ARCH\006-000 ELEVATIONS	20.06.11 12:15:44
Drawing No. 521260-A-301-E	Rev. C2

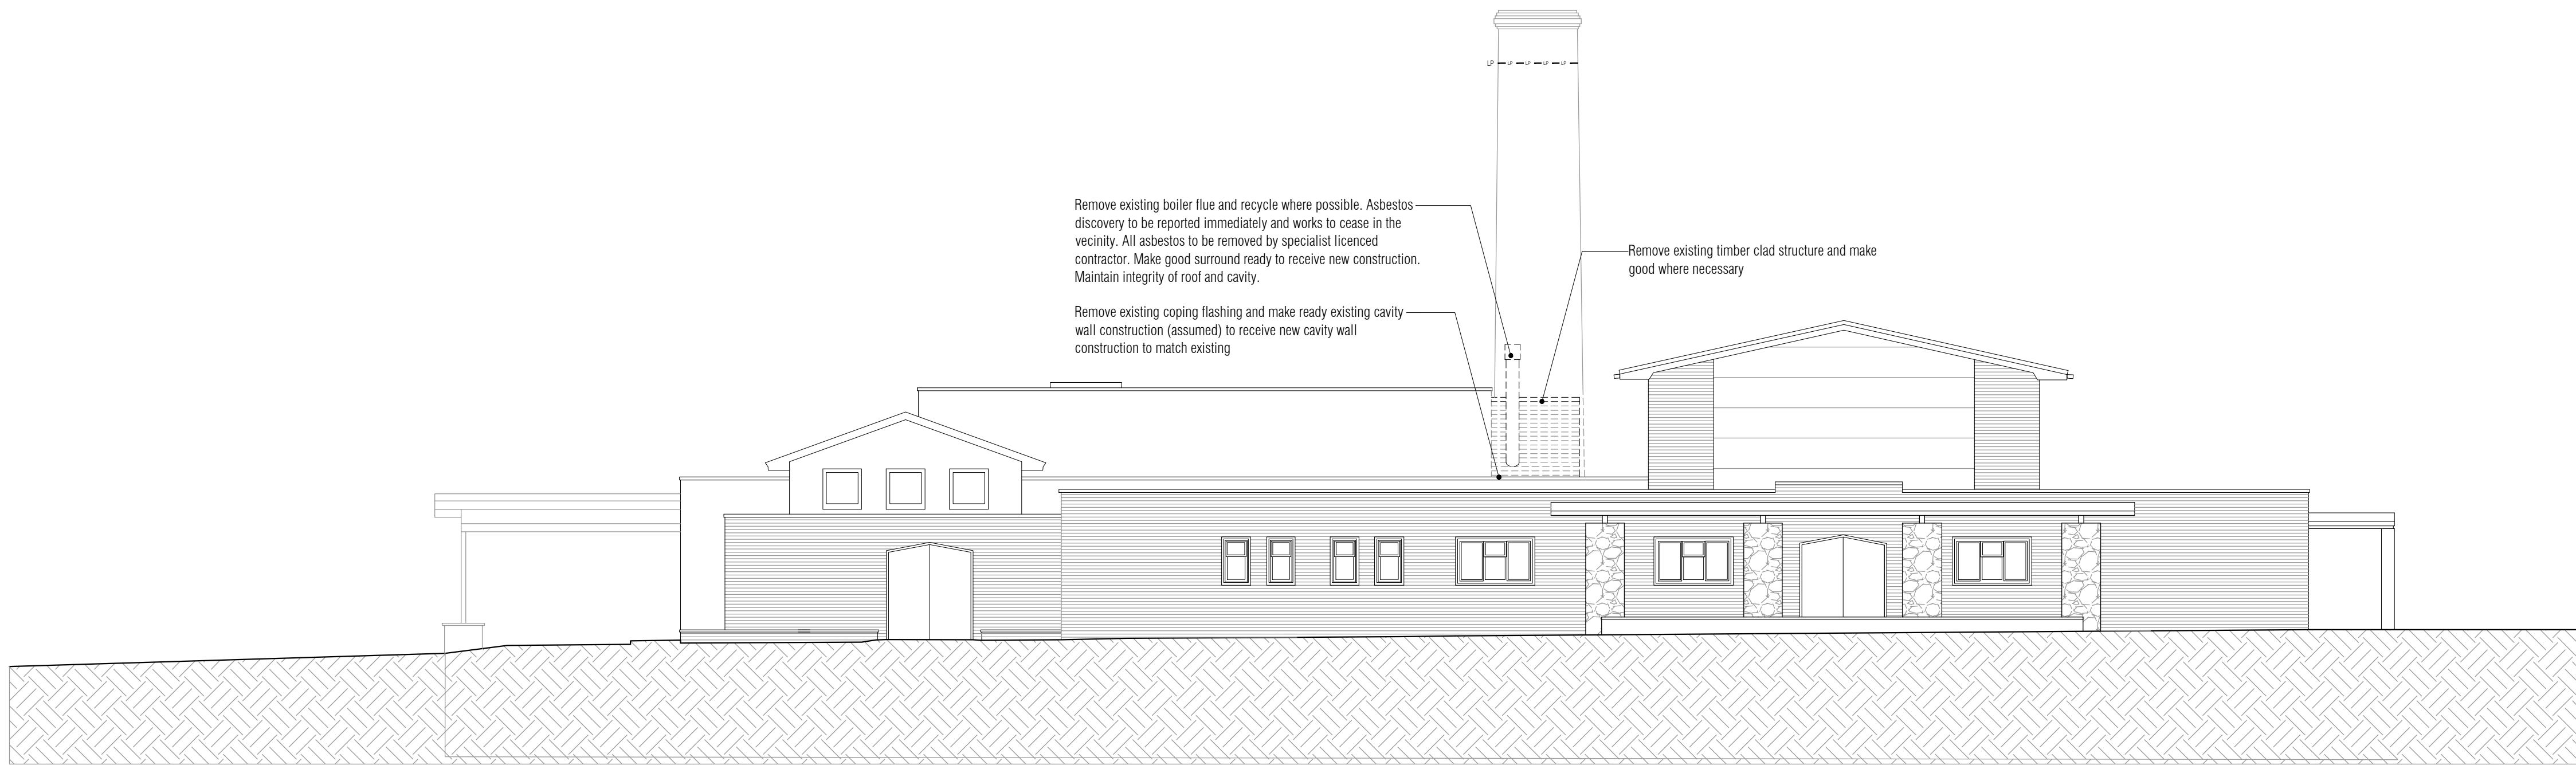


01 North Elevation
Scale: 1:100

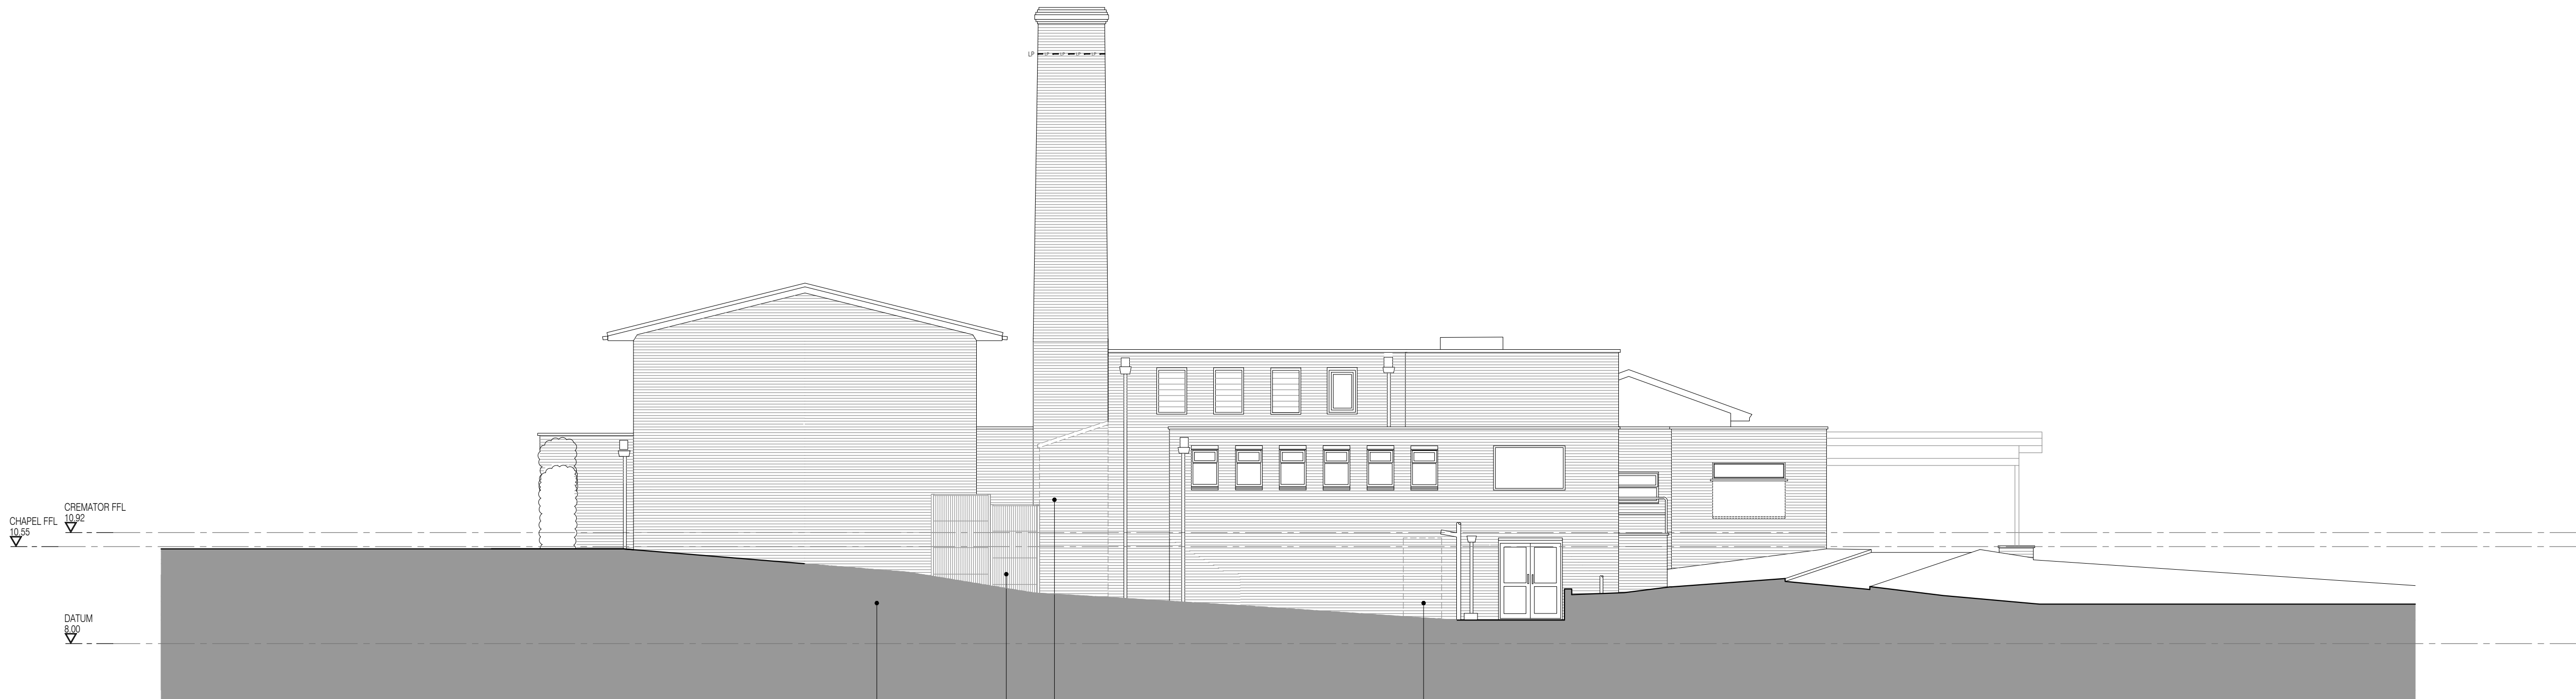

02 South Elevation
Scale: 1:100

NB: All information based on supplied third party survey information.
All discrepancies to be reported to FCG immediately upon discovery.

NOTES: Do not scale this drawing. All dimensions to be checked on site prior to commencement or manufacture.
Key Plan (nts)

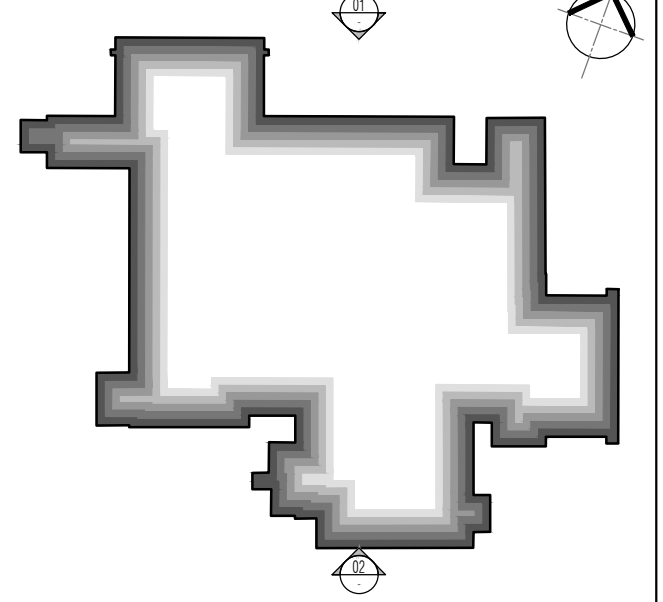

ISSUED FOR CONSTRUCTION

All details referenced in call outs supercede general arrangement or larger depictions.

Rev	Date	By	Chk	Comment
C1	29.03.12	RKC	JAS	Issued for CONSTRUCTION

BRINGING IDEAS TO LIFE

FRANKHAM

Frankham Consultancy Group Limited
21 Perrymount Road
Haywards Heath RH16 3TP
t 01444 444900 f 01444 455642
enquire@frankham.com
www.frankham.com

Client

Mansell
Contract N°: MC0269

Project Title

Eastbourne & Worthing
Crematoria
Refurbishments and Alterations


Drawing Title

EASTBOURNE
Eastbourne Crematorium
Demolition North & South Elevations


Drawn by: RKC	Scale: 1:100@A1	Date: 20.01.12
Designed by: FCG	Checked by: JAS	Approved by: AC

File Ref.: 521260-A-302-E (Rev. 1) 20.06.11 12:15:49

Drawing No. 521260-A-302-E	Rev. C1
-------------------------------	------------

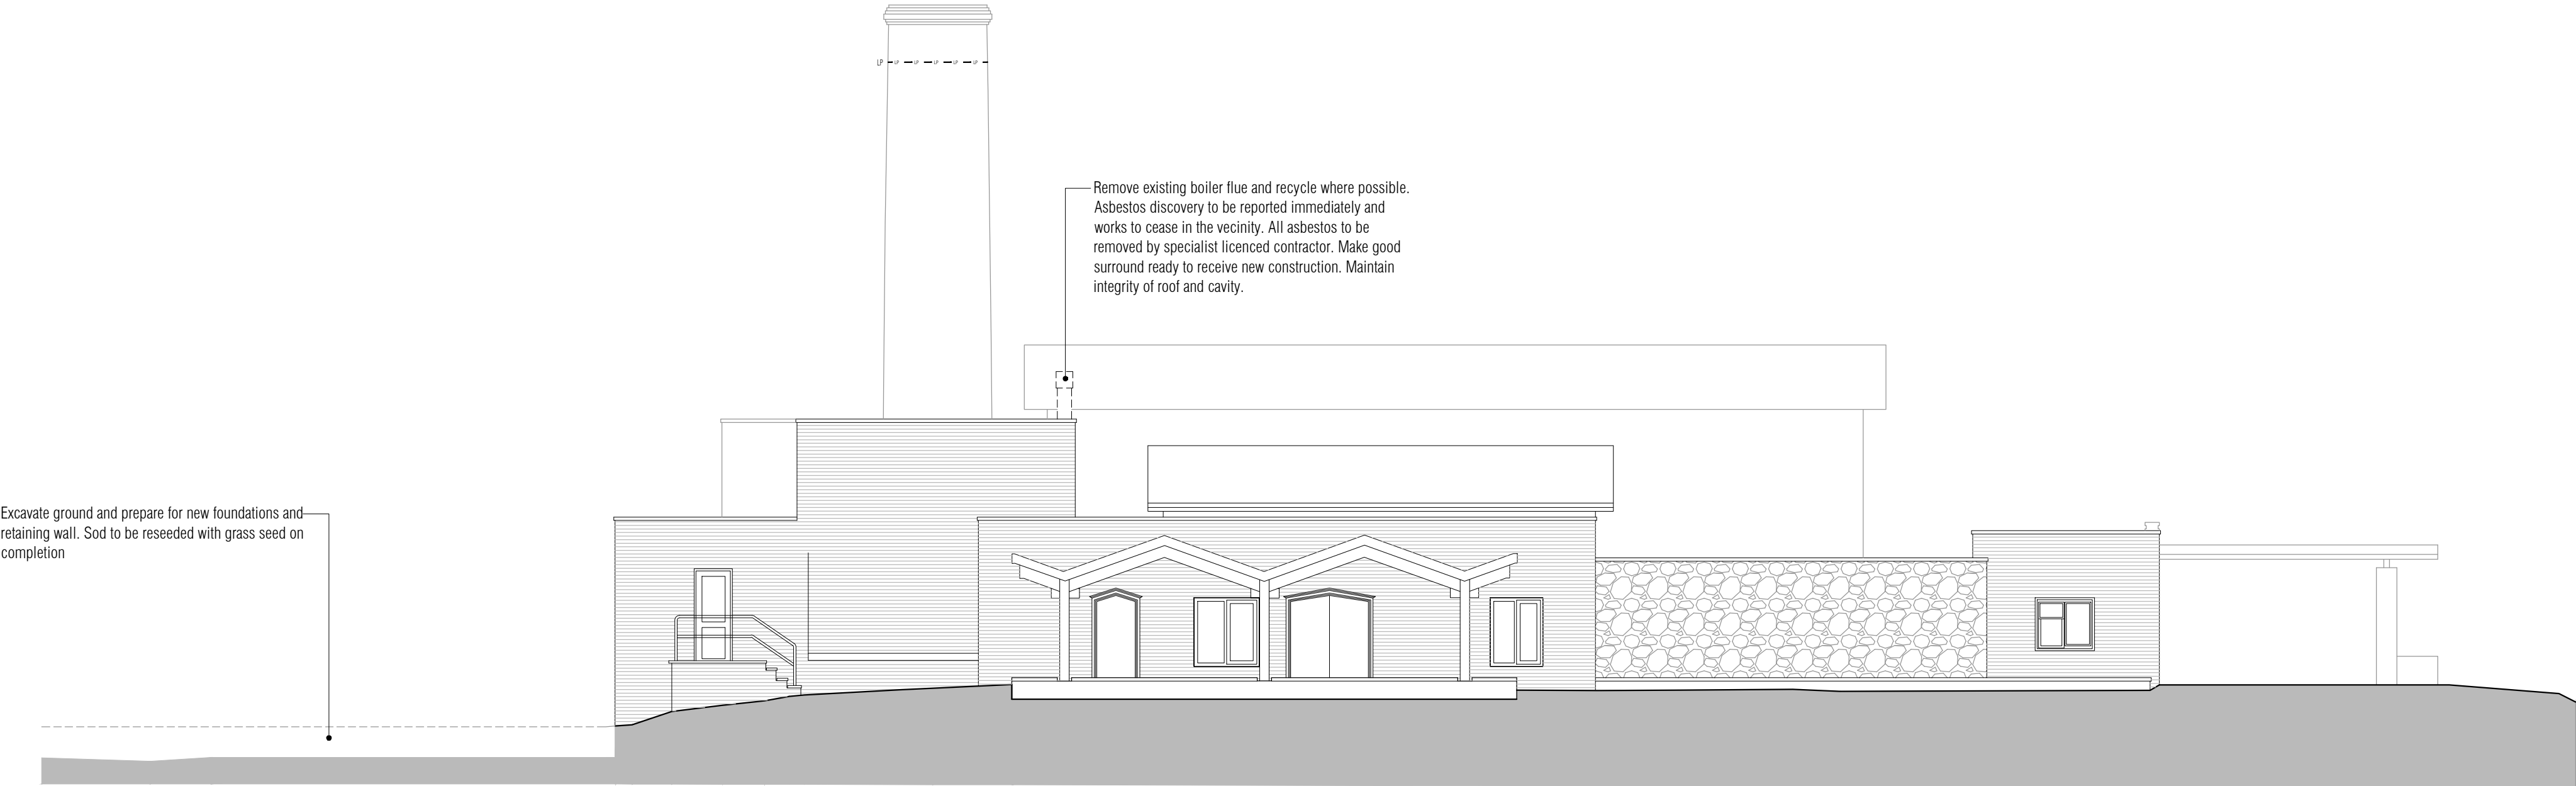

01 East Elevation
Scale: 1:100

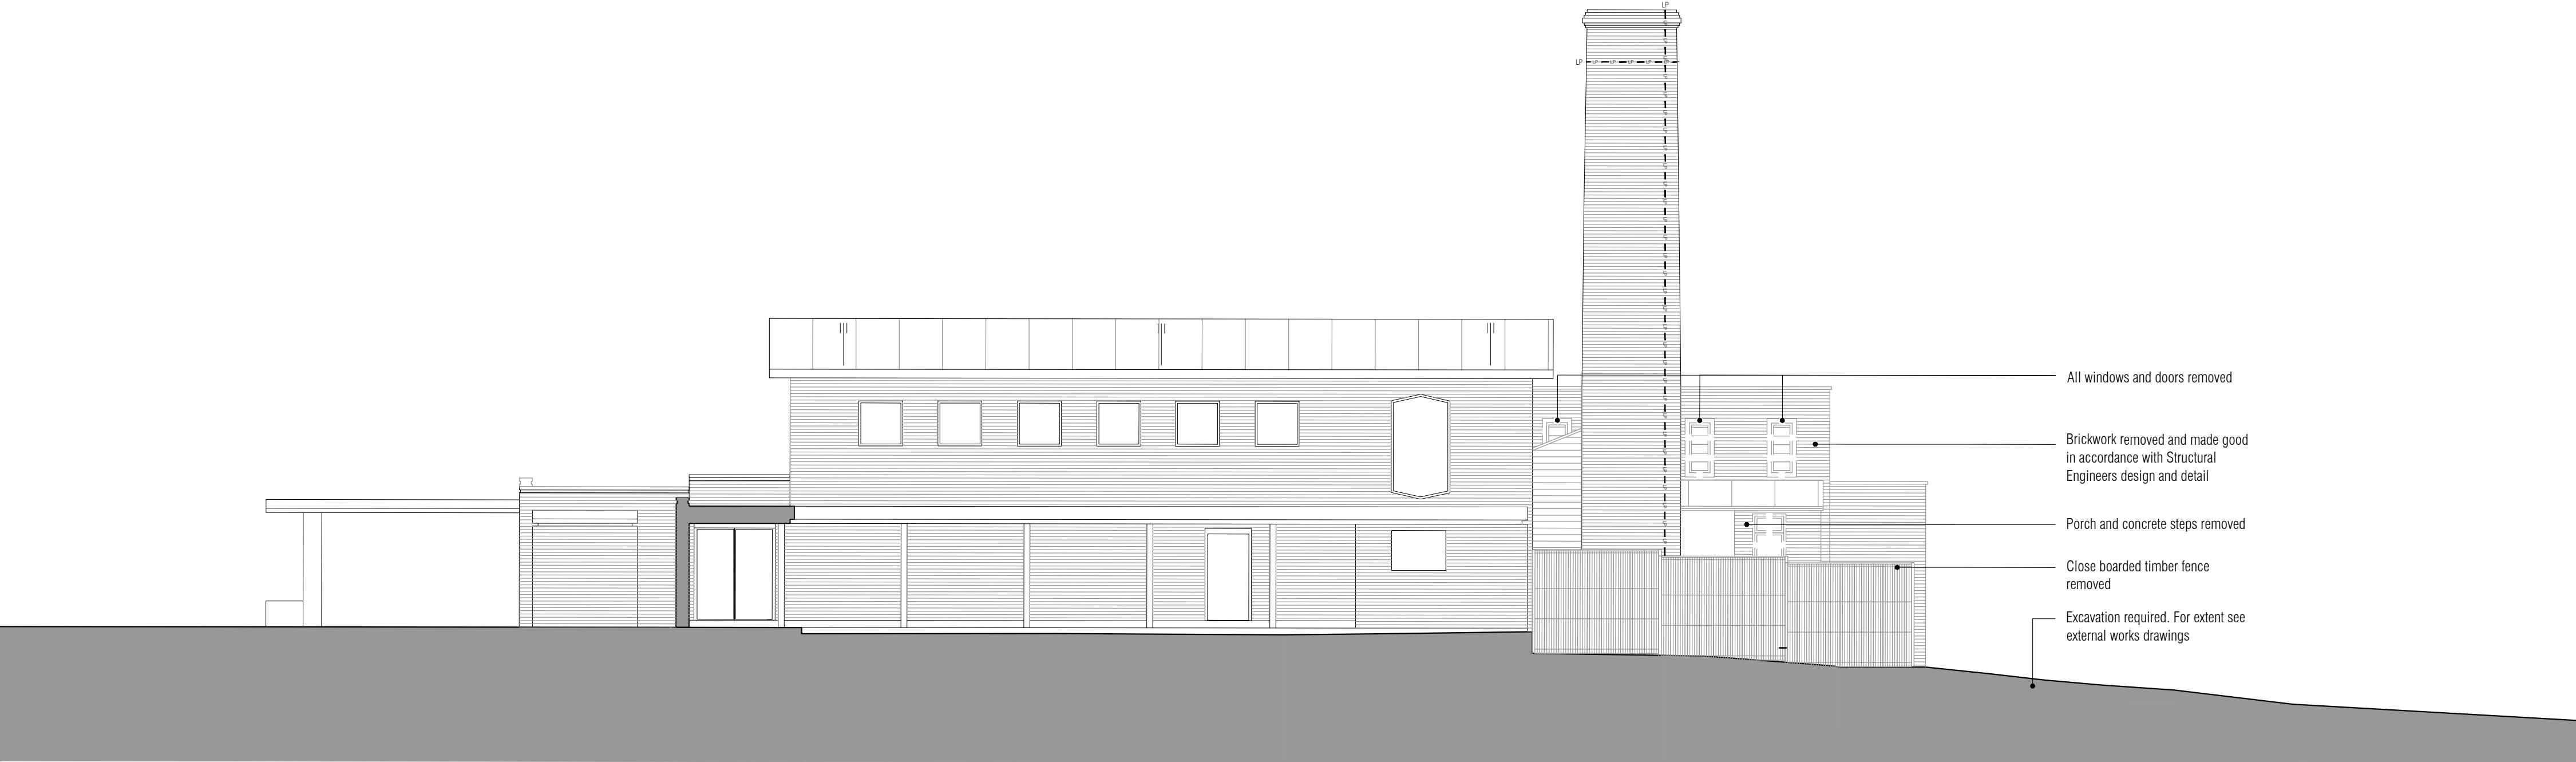

02 West Elevation
Scale: 1:100

NB: All information based on supplied third party survey information.
All discrepancies to be reported to FCG immediately upon discovery.

NOTES: Do not scale this drawing. All dimensions to be checked on site prior to commencement or manufacture.

Key Plan (nts)

ISSUED FOR CONSTRUCTION

All details referenced in call outs supercede general arrangement or larger depictions.

Rev	Date	By	Chk	Comment
C1	29.03.12	RKC	JAS	Issued for CONSTRUCTION

BRINGING IDEAS TO LIFE

FRANKHAM

Frankham Consultancy Group Limited
21 Pymount Road
Haywards Heath RH16 3TP
t 01444 444900 f 01444 455642
enquire@frankham.com
www.frankham.com

Client

Mansell
Contract N°: MC0269

Project Title

Eastbourne & Worthing
Crematoria
Refurbishments and Alterations

Drawing Title

EASTBOURNE
Demolition East & West Elevations

Drawn by: RKC	Scale: 1:100@A1	Date: 20.01.12
Designed by: FCG	Checked by: JAS	Approved by: AC



File Ref.: X:\FRANKHAM\2_080512\280 CREMATORIA\ARCH\0269-000 ELEVATIONS
301260-A-303-E.DWG - 200611121552 20.06.11 12:15:52

Drawing No. 521260-A-303-E	Rev. C1
-------------------------------	------------


Existing Materials Legend

- 1 Feather edge spruce cladding (treated - retaining light brown natural colour)
- 2 Upstand seam Polyester powder coated aluminium cladding (Weathered copper)
- 3 Double glazed powder coated Aluminium windows (dark brown frames, clear glazing)
- 4 Powder coated aluminium doors (dark brown frames, brown door leaves)
- 5 Powder coated aluminium louvre (White)
- 6 Stained softwood fencing & posts (Brown)
- 7 Double skinned Polycarbonate roofing (Clear)
- 8 Spruce T&G gates
- 9 Powder coated aluminium fascia

NB: New concrete paving slabs and kerbs to match existing. New tarmac to match existing.

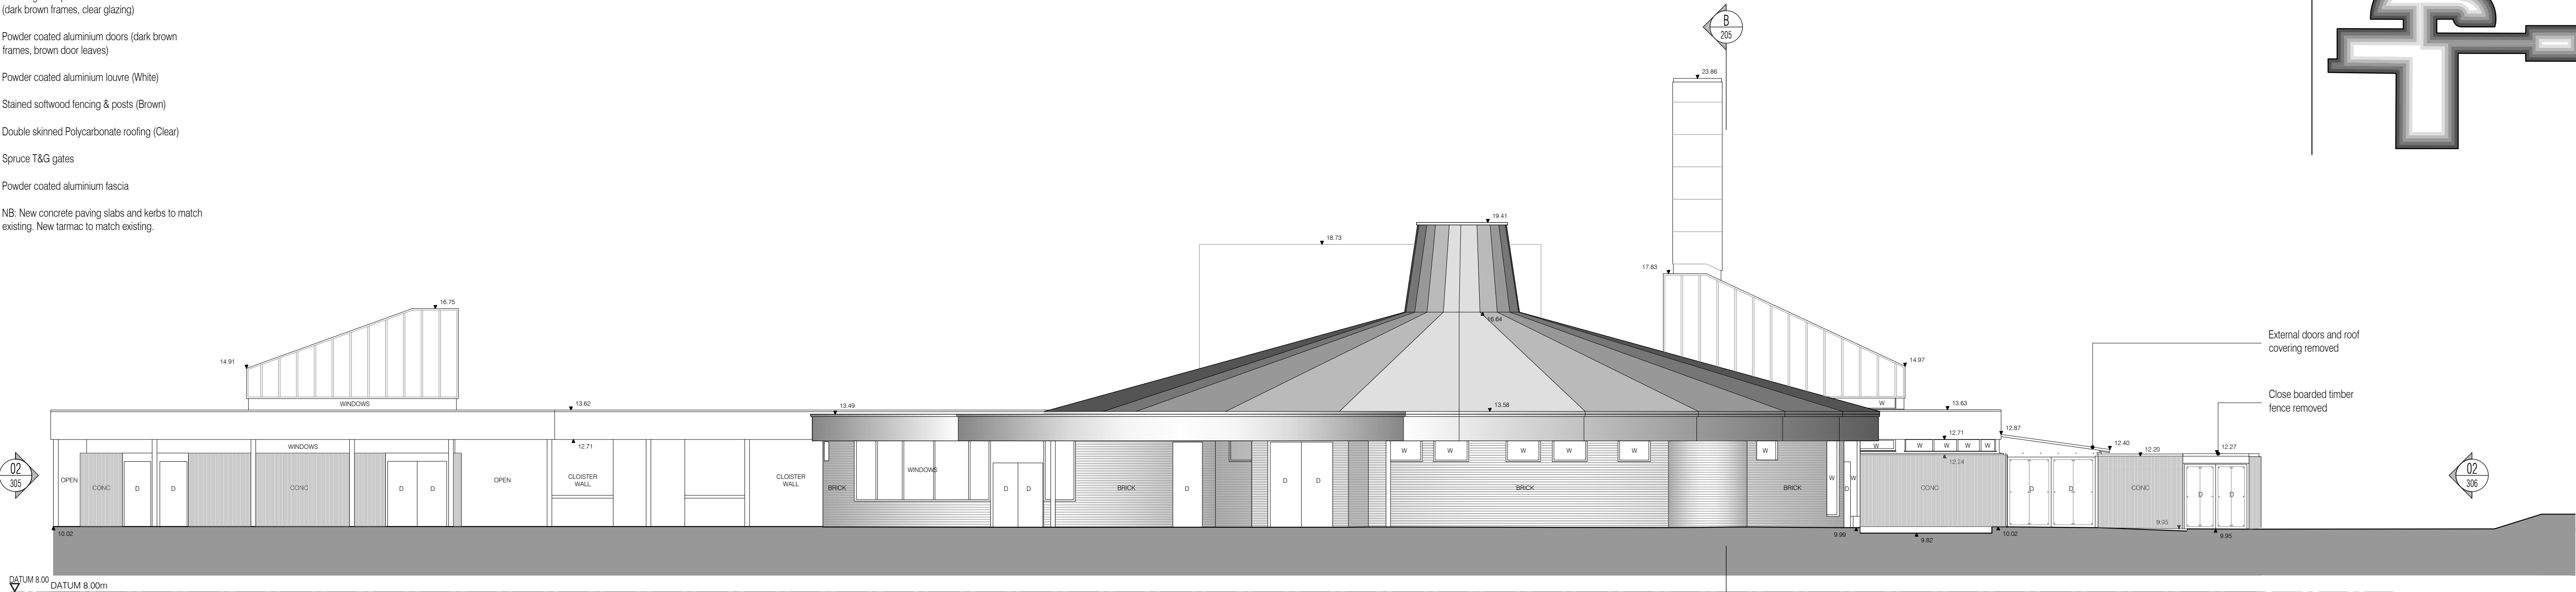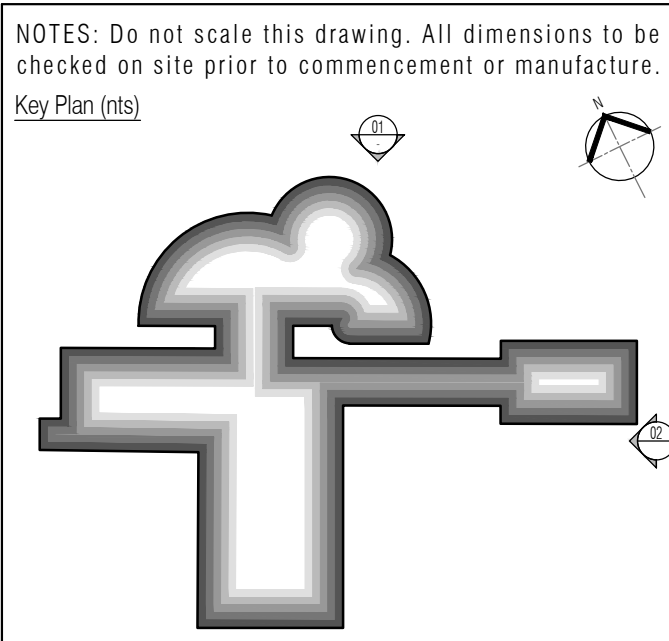

01 North Elevation
Scale: 1:100

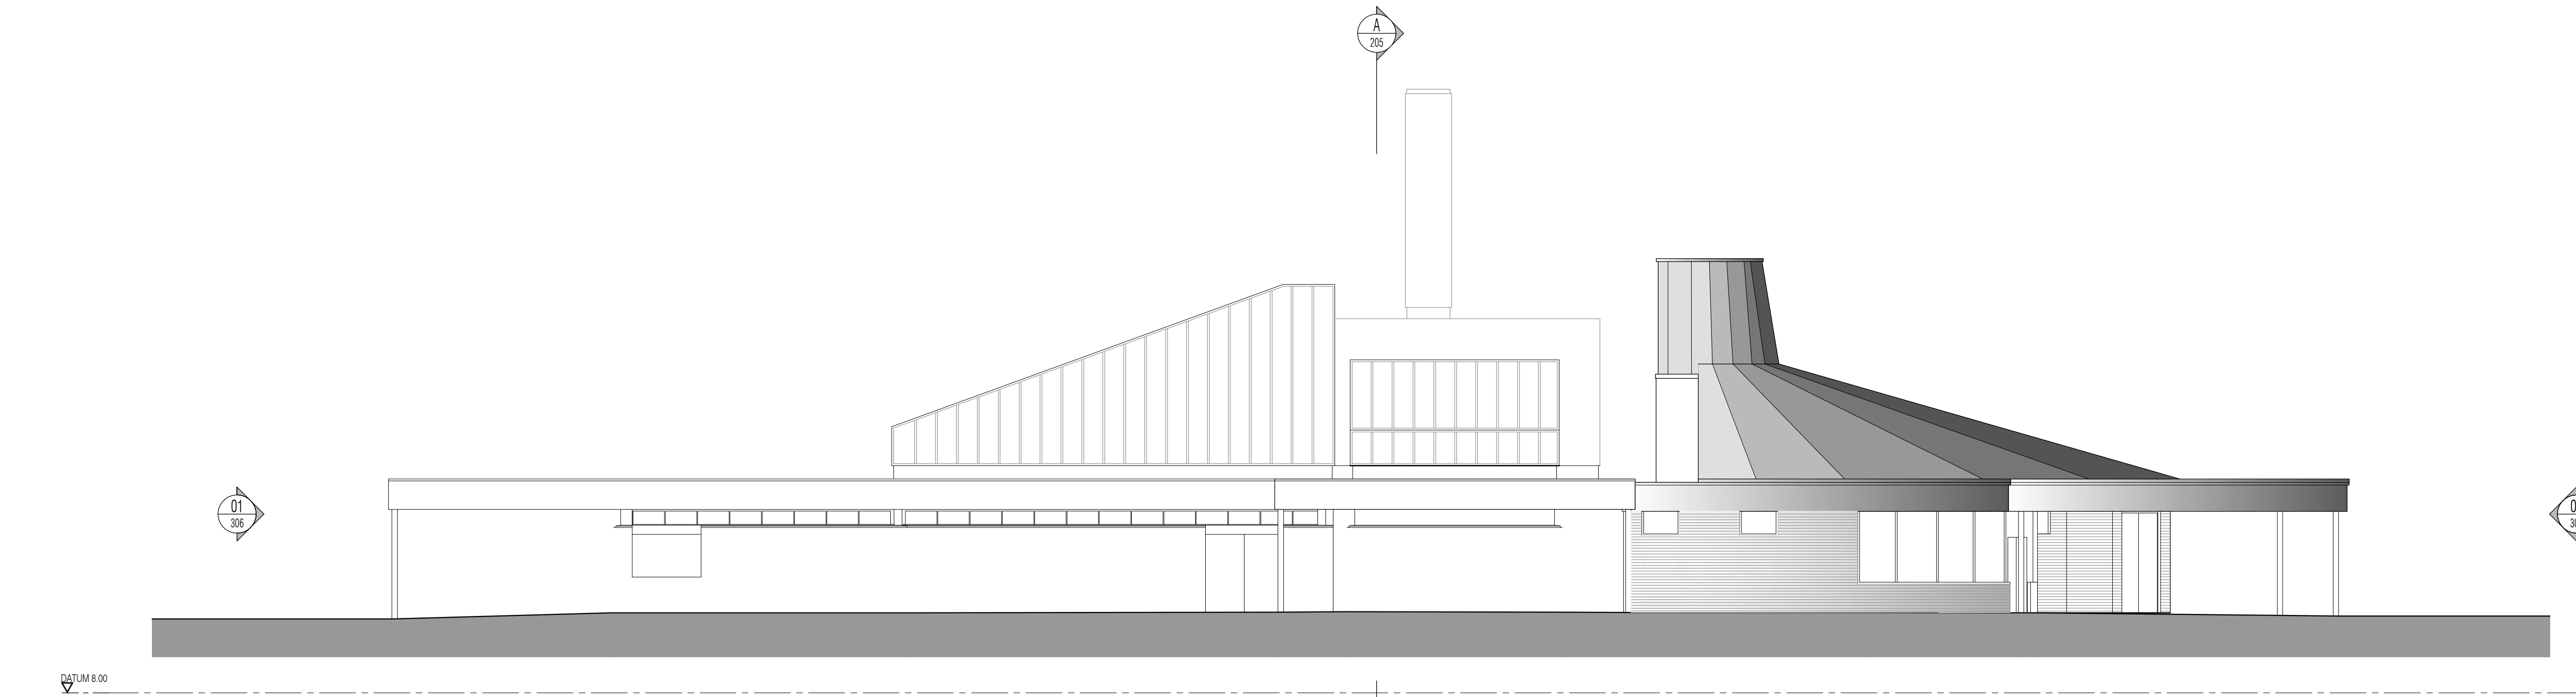

02 East Elevation
Scale: 1:100

NB: All information based on supplied third party survey information.
All discrepancies to be reported to FCG immediately upon discovery.

ISSUED FOR CONSTRUCTION

All details referenced in call outs supersede general arrangement or larger depictions.

Rev	Date	By	CHK	Comment
C2	09.07.12	RKC	JAS	Issued for Construction
P4	01.06.12	RKC	JAS	Issued for Stage F
P3	02.05.12	RKC	JAS	Issued for New Planning Application
C1	02.05.12	RKC	JAS	Issued for CONSTRUCTION

BRINGING IDEAS TO LIFE

FRANKHAM

Frankham Consultancy Group Limited
21 Perrymount Road
Haywards Heath RH16 3TP
t 01444 444900 f 01444 455642
enquire@frankham.com
www.frankham.com

Client

Contract N°: Worthing

Project Title

Eastbourne & Worthing
Crematoria
Refurbishments and Alterations

Drawing Title

Worthing Crematorium
Existing North & East Elevations

Drawn by: RKC	Scale: 1:100@A1	Date: 28.10.11
Designed by: FCG	Checked by: JAS	Approved by: AC

File Ref.: X:\FRANKHAM\2 - 080512180 CREMATORIA\ARCH\020-000 ELEVATIONS
301360-A-305-W-0000 - 200811121555 20.06.11 12:15:56

Drawing No. 521260-A-305-W	Rev. C2
-------------------------------	------------


Existing Materials Legend

- 1 Feather edge spruce cladding (treated - retaining light brown natural colour)
- 2 Upstand seam Polyester powder coated aluminium cladding (Weathered copper)
- 3 Double glazed powder coated Aluminium windows (dark brown frames, clear glazing)
- 4 Powder coated aluminium doors (dark brown frames, brown door leaves)
- 5 Powder coated aluminium louvre (White)
- 6 Stained softwood fencing & posts (Brown)
- 7 Double skinned Polycarbonate roofing (Clear)
- 8 Spruce T&G gates
- 9 Powder coated aluminium fascia

NB: New concrete paving slabs and kerbs to match existing. New tarmac to match existing.



01 South Elevation
Scale: 1:100

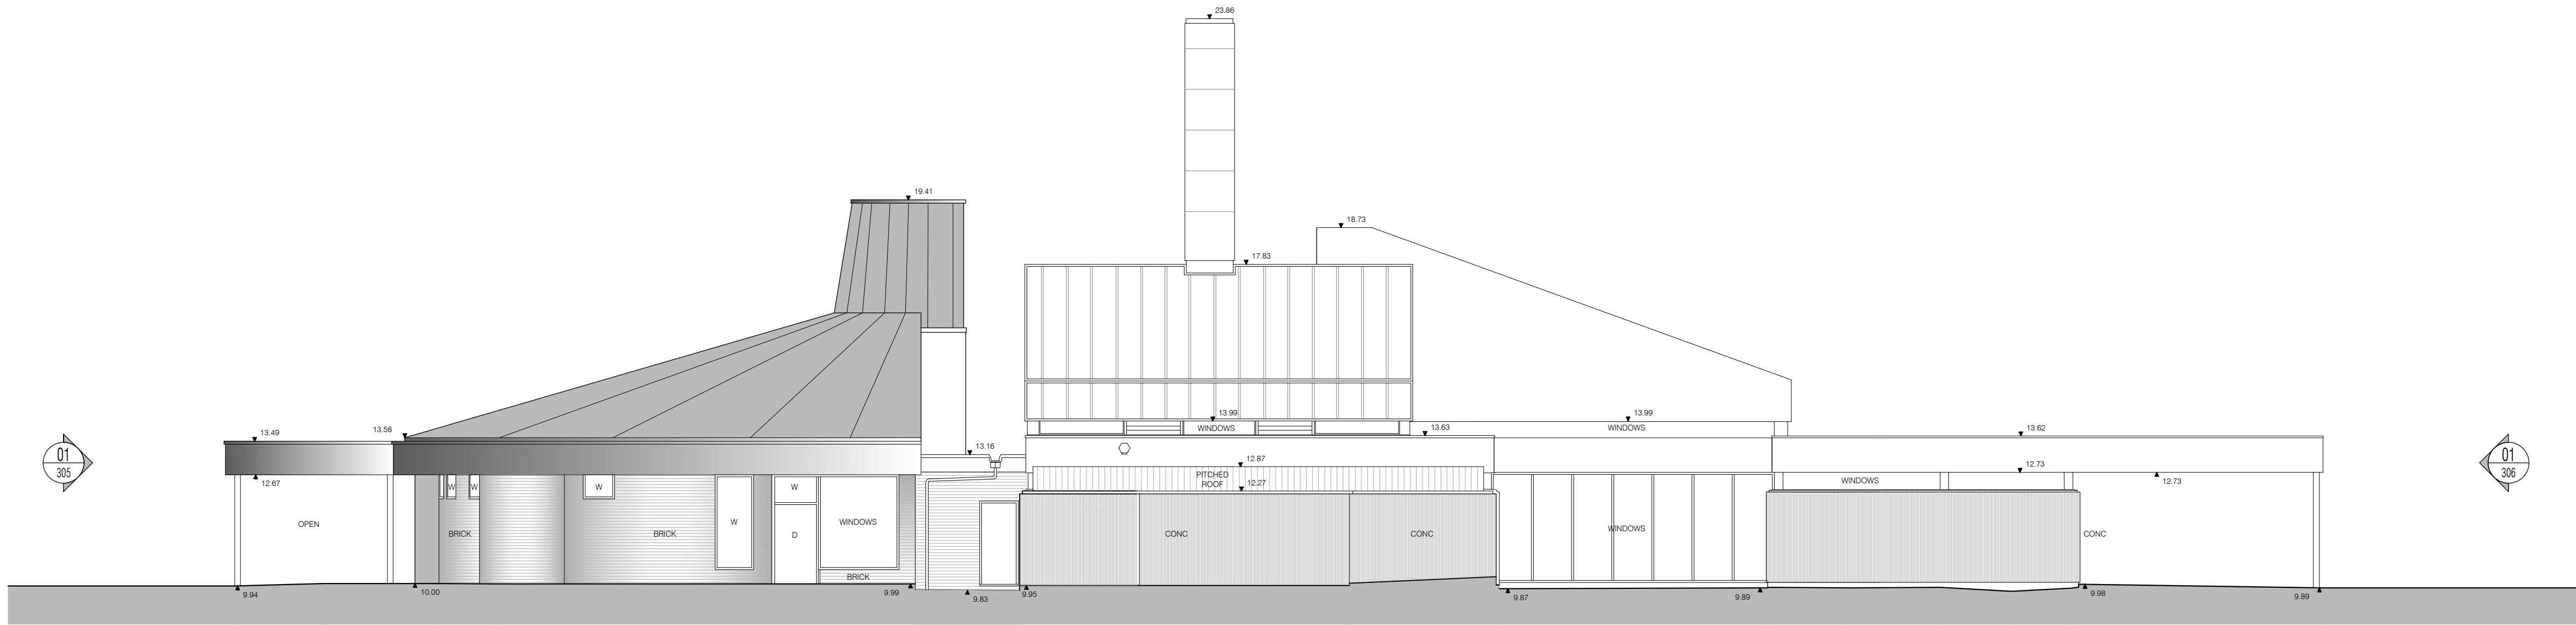

02 West Elevation
Scale: 1:100

NOTES: Do not scale this drawing. All dimensions to be checked on site prior to commencement or manufacture.
Key Plan (nts)

Scale Bar

0 1 2 3 4 5 6

1:50
1:100

ISSUED FOR
CONSTRUCTION

All details referenced in call outs supercede general arrangement or larger depictions.

Rev	Date	By	Chk	Comment
C2	09.07.12	RKC	JAS	Issued for Construction
P4	01.06.12	RKC	JAS	Issued for Stage F
P3	01.05.12	RKC	JAS	Issued for New Planning Application
C1	23.04.12	RKC	JAS	Issued for CONSTRUCTION

BRINGING IDEAS TO LIFE

FRANKHAM

Frankham Consultancy Group Limited
21 Pymme Road
Haywards Heath RH16 3TP
t 01444 444900 f 01444 455642
enquire@frankham.com
www.frankham.com

Client

Mansell
Contract N°: Worthing

Project Title

Eastbourne & Worthing
Crematoria
Refurbishments and Alterations

Drawing Title

Worthing
Worthing Crematorium
Existing South & West Elevations

Drawn by: RKC	Scale: 1:100@A1	Date: 28.10.11
Designed by: FCG	Checked by: JAS	Approved by: AC
File Ref.: X:\FRANKHAM\2_080512180 CREMATORIA\ARCH\02B-000-01\02B-000-01.dwg 307380-A-306-W-0000 - 200811271550		
Drawing No. 521260-A-306-W		Rev. C2

NB: All information based on supplied third party survey information.
All discrepancies to be reported to FCG immediately upon discovery.

Existing Materials Legend

- 1 Feather edge spruce cladding (treated - retaining light brown natural colour)
- 2 Upstand seam Polyester powder coated aluminium cladding (Weathered copper)
- 3 Double glazed powder coated Aluminium windows (dark brown frames, clear glazing)
- 4 Powder coated aluminium doors (dark brown frames, brown door leaves)
- 5 Powder coated aluminium louvre (White)
- 6 Stained softwood fencing & posts (Brown)
- 7 Double skinned Polycarbonate roofing (Clear)
- 8 Spruce T&G gates
- 9 Powder coated aluminium fascia

NB: New concrete paving slabs and kerbs to match existing. New tarmac to match existing.

NOTES: Do not scale this drawing. All dimensions to be checked on site prior to commencement or manufacture.
Key Plan (nts)

Scale Bar

0 1 2 3 1:50
0 2 4 6 1:100



01 North Elevation
Scale: 1:100

ISSUED FOR CONSTRUCTION

All details referenced in call outs supercede general arrangement or larger depictions.

Rev	Date	By	Chk	Comment
C2	09.07.12	RKC	JAS	Issued for Construction
P4	01.06.12	RKC	JAS	Issued for Stage F
P3	01.05.12	RKC	JAS	Issued for New Planning Application
C1	23.04.12	RKC	JAS	Issued for CONSTRUCTION

BRINGING IDEAS TO LIFE

FRANKHAM

Frankham Consultancy Group Limited
21 Perrymount Road
Haywards Heath RH16 3TP
t 01444 444900 f 01444 455642
enquire@frankham.com
www.frankham.com

Client

Mansell

Contract N°: Worthing

Project Title

Eastbourne & Worthing
Crematoria
Refurbishments and Alterations

Drawing Title

Worthing Crematorium
Demolition North & East Elevations

Drawn by: RKC	Scale: 1:100@A1	Date: 28.10.11
Designed by: FCG	Checked by: JAS	Approved by: AC
File Ref.: X:\FRANKHAM\2_080512180 CREMATORIA\ARCH\006-300-01 ELEVATIONS 301360-A-307-W-0060 - 200811271955		
Drawing No. 521260-A-307-W		Rev. C2

NB: All information based on supplied third party survey information.
All discrepancies to be reported to FCG immediately upon discovery.


Existing Materials Legend

- 1 Feather edge spruce cladding (treated - retaining light brown natural colour)
- 2 Upstand seam Polyester powder coated aluminium cladding (Weathered copper)
- 3 Double glazed powder coated Aluminium windows (dark brown frames, clear glazing)
- 4 Powder coated aluminium doors (dark brown frames, brown door leaves)
- 5 Powder coated aluminium louvre (White)
- 6 Stained softwood fencing & posts (Brown)
- 7 Double skinned Polycarbonate roofing (Clear)
- 8 Spruce T&G gates
- 9 Powder coated aluminium fascia

NB: New concrete paving slabs and kerbs to match existing. New tarmac to match existing.



01 South Elevation
Scale: 1:100

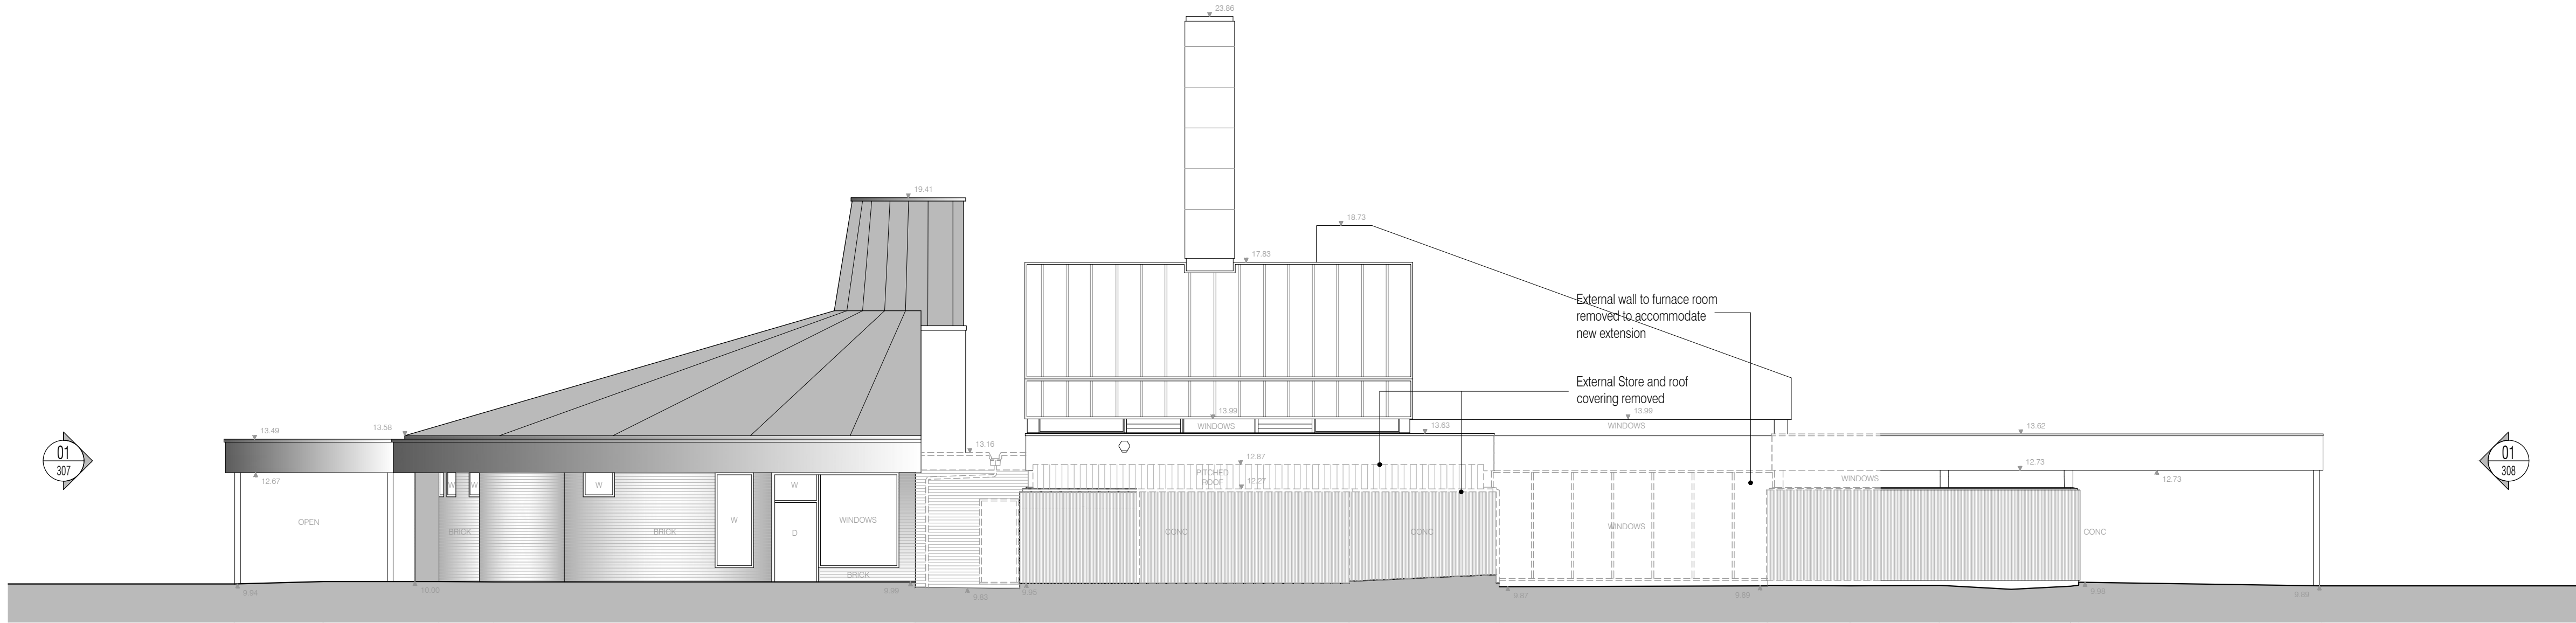

02 West Elevation
Scale: 1:100

NB: All information based on supplied third party survey information.
All discrepancies to be reported to FCG immediately upon discovery.

NOTES: Do not scale this drawing. All dimensions to be checked on site prior to commencement or manufacture.
Key Plan (nts)

Scale Bar
0 1 2 3 4 5 6
1:50
1:100

ISSUED FOR CONSTRUCTION

All details referenced in call outs supercede general arrangement or larger depictions.

Rev	Date	By	Chk	Comment
C2	09.07.12	RKC	JAS	Issued for Construction
P4	01.06.12	RKC	JAS	Issued for Stage F
P3	01.05.12	RKC	JAS	Issued for New Planning Application
C1	23.04.12	RKC	JAS	Issued for CONSTRUCTION

BRINGING IDEAS TO LIFE

FRANKHAM

Frankham Consultancy Group Limited
21 Perryman Road
Haywards Heath RH16 3TP
t 01444 444900 f 01444 455642
enquire@frankham.com
www.frankham.com

Client

Contract N°: Worthing

Project Title
Eastbourne & Worthing
Crematoria
Refurbishments and Alterations


Drawing Title

Worthing Crematorium
Demolition South & West Elevations


Drawn by: RKC	Scale: 1:100@A1	Date: 07.02.11
Designed by: FCG	Checked by: JAS	Approved by: AC

File Ref.: X:\FRANKHAM\2_080512180 CREMATORIA\ARCH\02B-308-ELEVATIONS
307380-A-308-W-0000 - 200811271930
20.06.11 12:16:08

Drawing No. 521260-A-308-W	Rev. C2
-------------------------------	------------

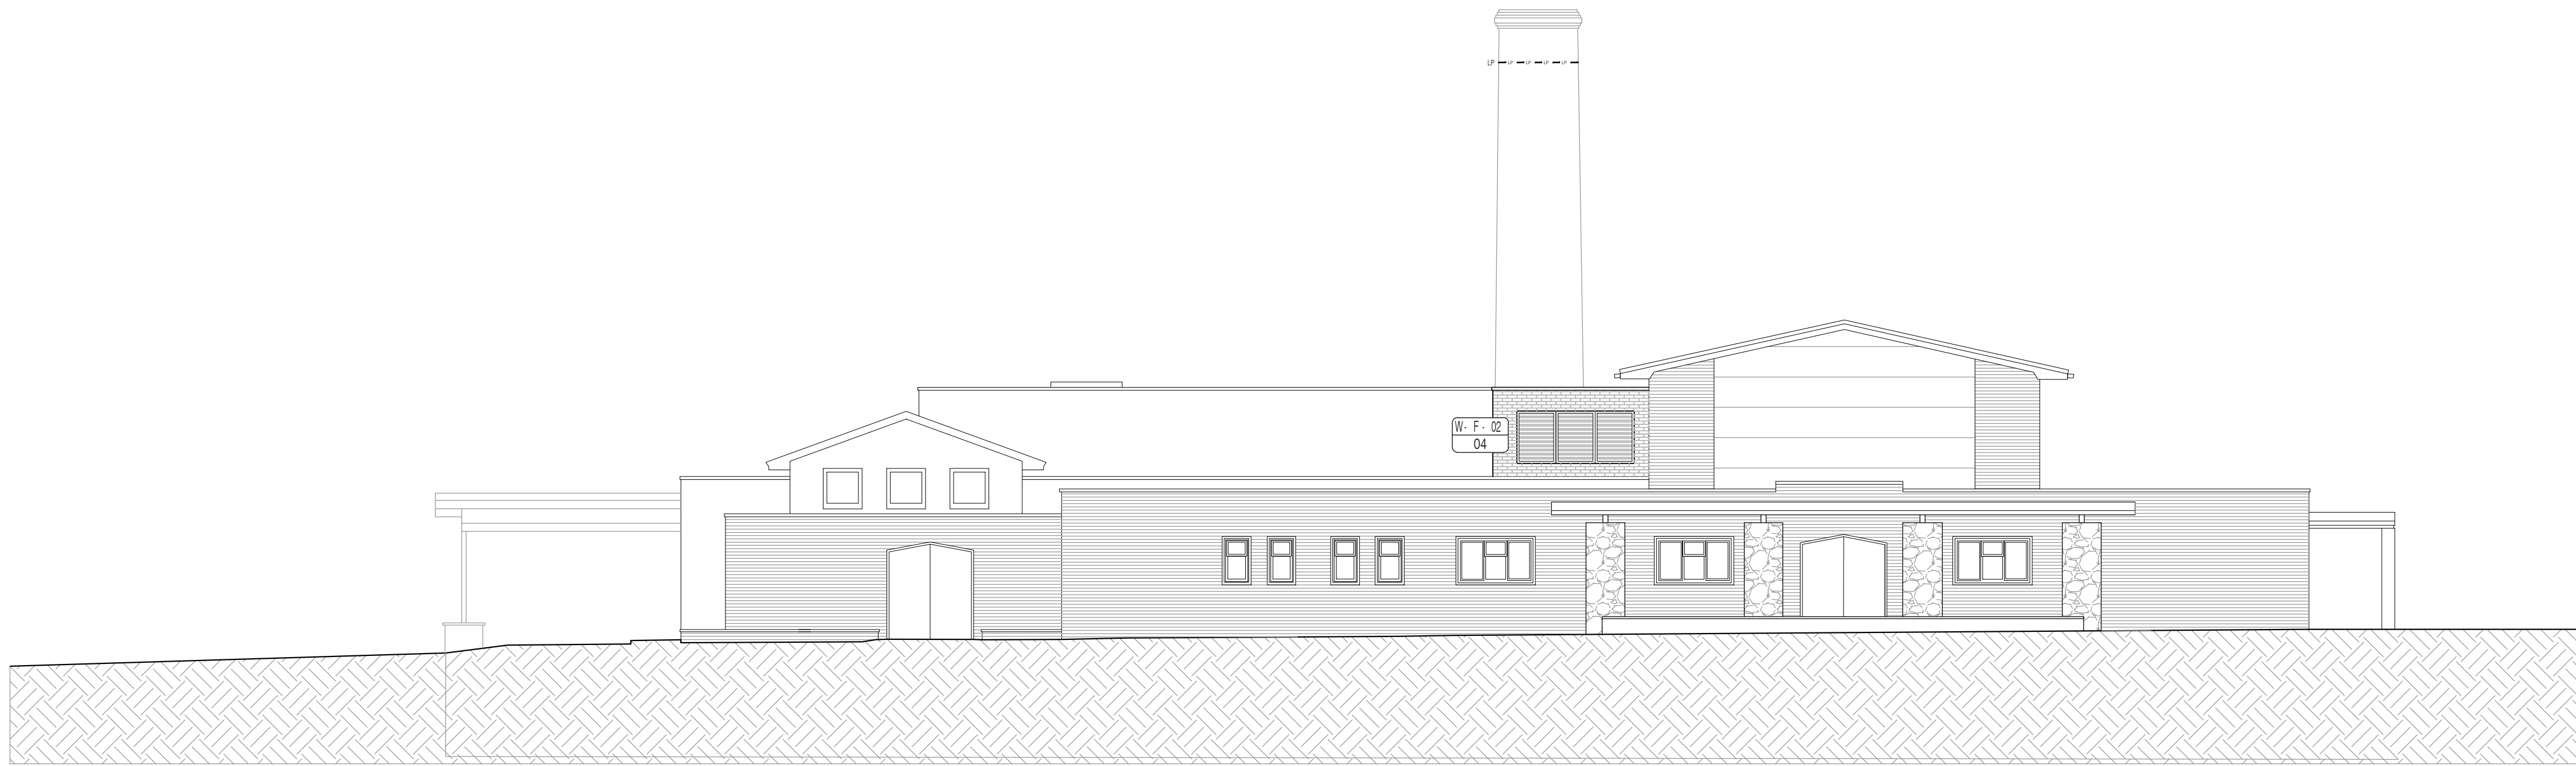

01 North Elevation
Scale: 1:100

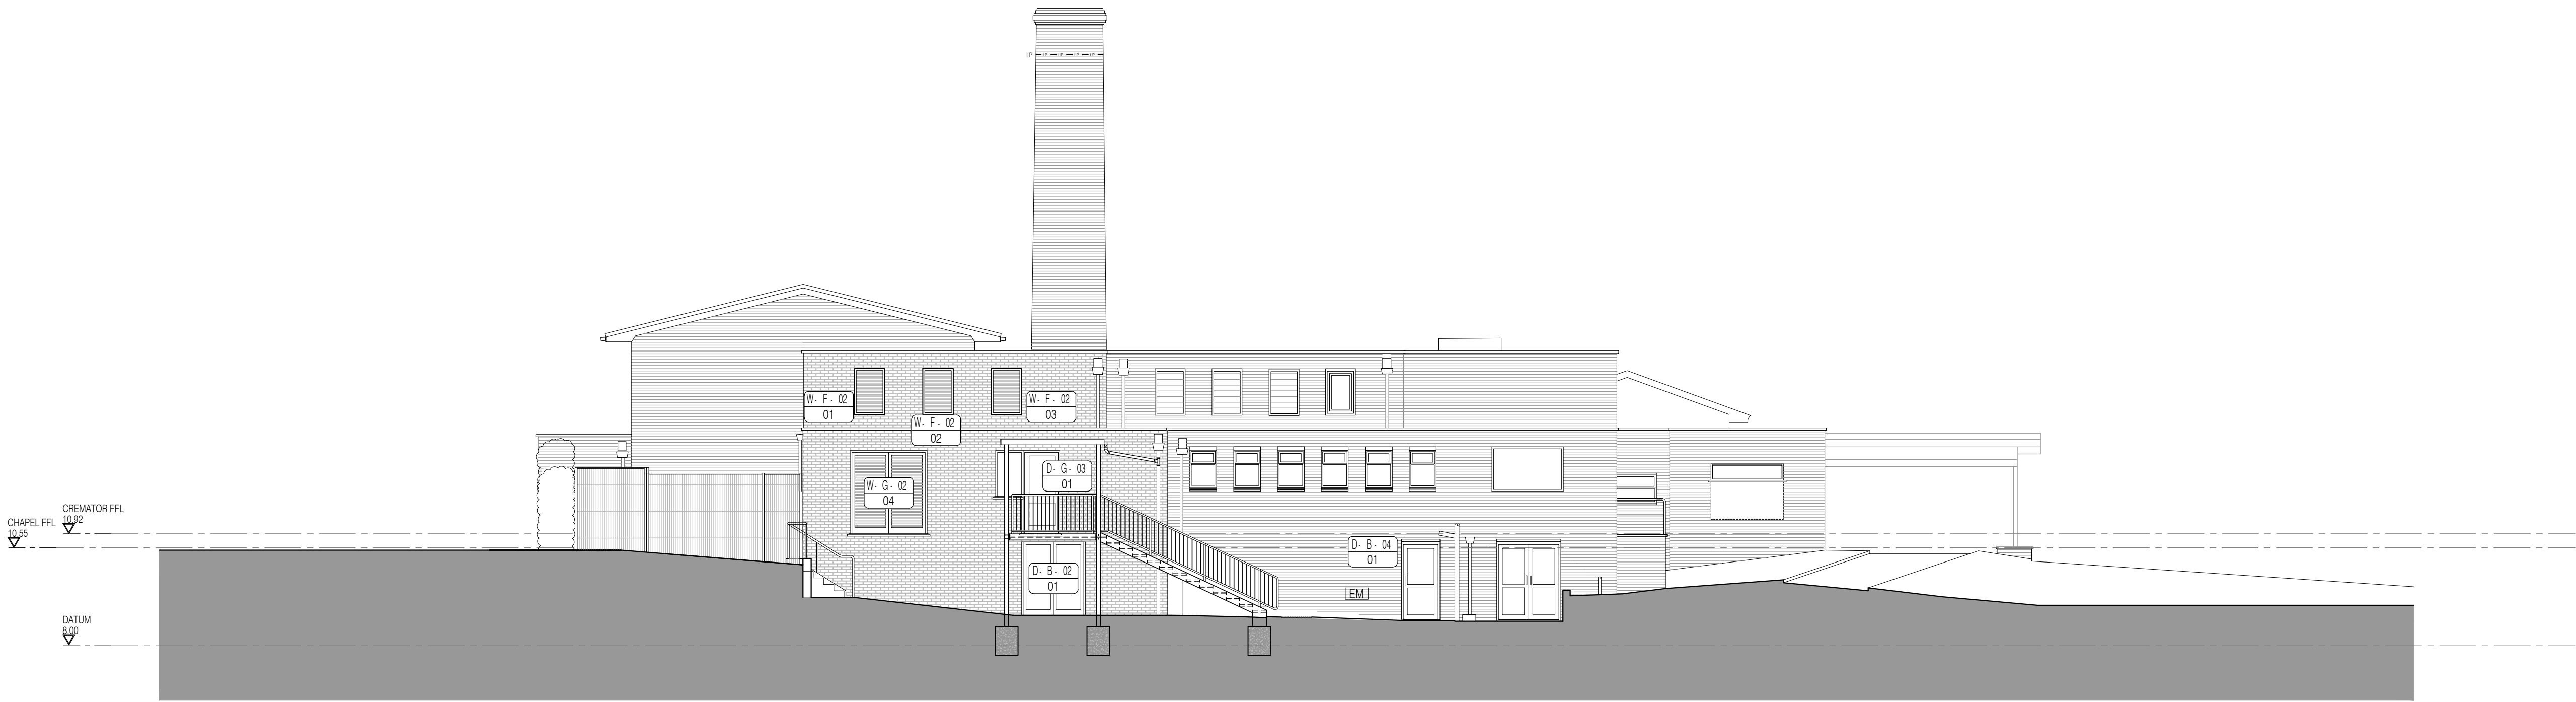

02 South Elevation
Scale: 1:100

NB: All information based on supplied third party survey information.
All discrepancies to be reported to FCG immediately upon discovery.

NOTES: Do not scale this drawing. All dimensions to be checked on site prior to commencement or manufacture.
Key Plan (nts)

AS BUILT
DRAWING

All details referenced in call outs supercede general arrangement or larger depictions.

AB1	07.01.13	RKC	JAS	DRAWING ISSUED - AS BUILT
Rev	Date	By	Chk	Comment

BRINGING IDEAS TO LIFE

FRANKHAM

Frankham Consultancy Group Limited
21 Perrymount Road
Haywards Heath RH16 3TP
t 01444 444900 f 01444 455642
enquiries@frankham.com
www.frankham.com

Client

Contract N°: MC0269

Project Title

Eastbourne & Worthing
Crematoria
Refurbishments and Alterations


Drawing Title

Eastbourne Crematorium
Proposed North & South Elevations


Drawn by: RKC	Scale: 1:100@A1	Date: 28.10.11
Designed by: FCG	Checked by: JAS	Approved by: AC

File Ref.: X:\FRANKHAM\2_080512\01 CREMATORIA\ARCH\006-000 ELEVATIONS	20.06.11 12:16:11
Drawing No. 521260-A-310-E	Rev. AB1



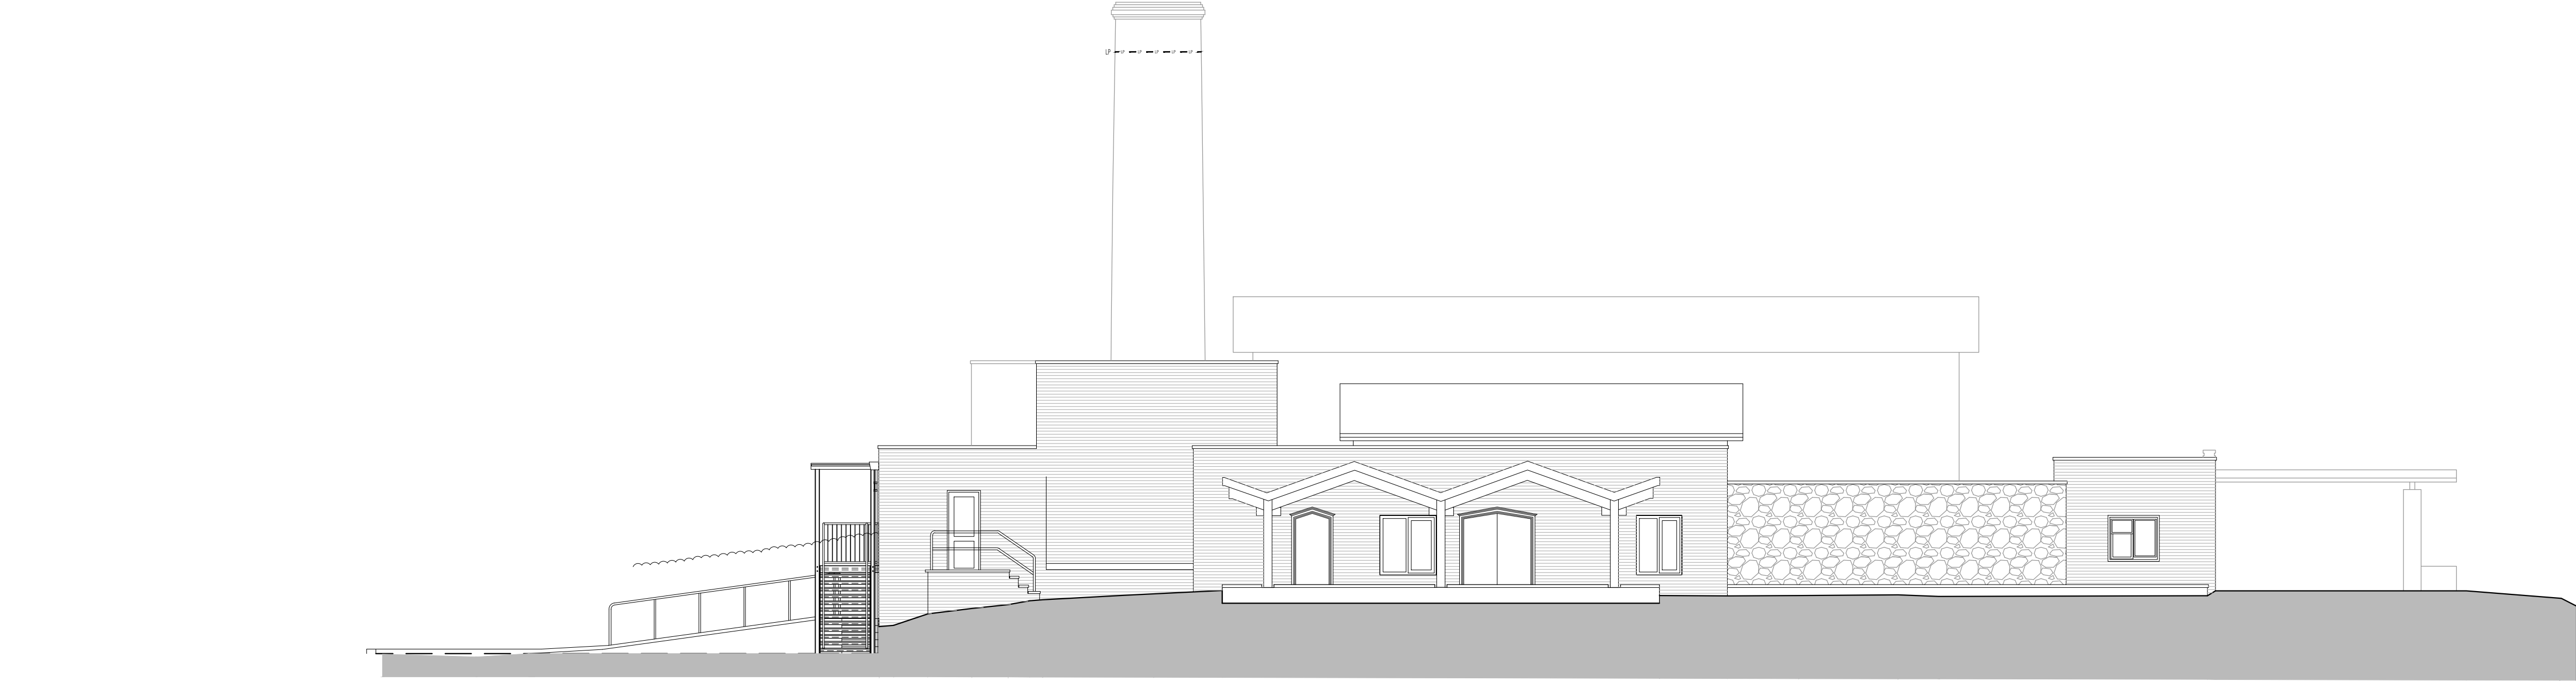


01 East Elevation
Scale: 1:100

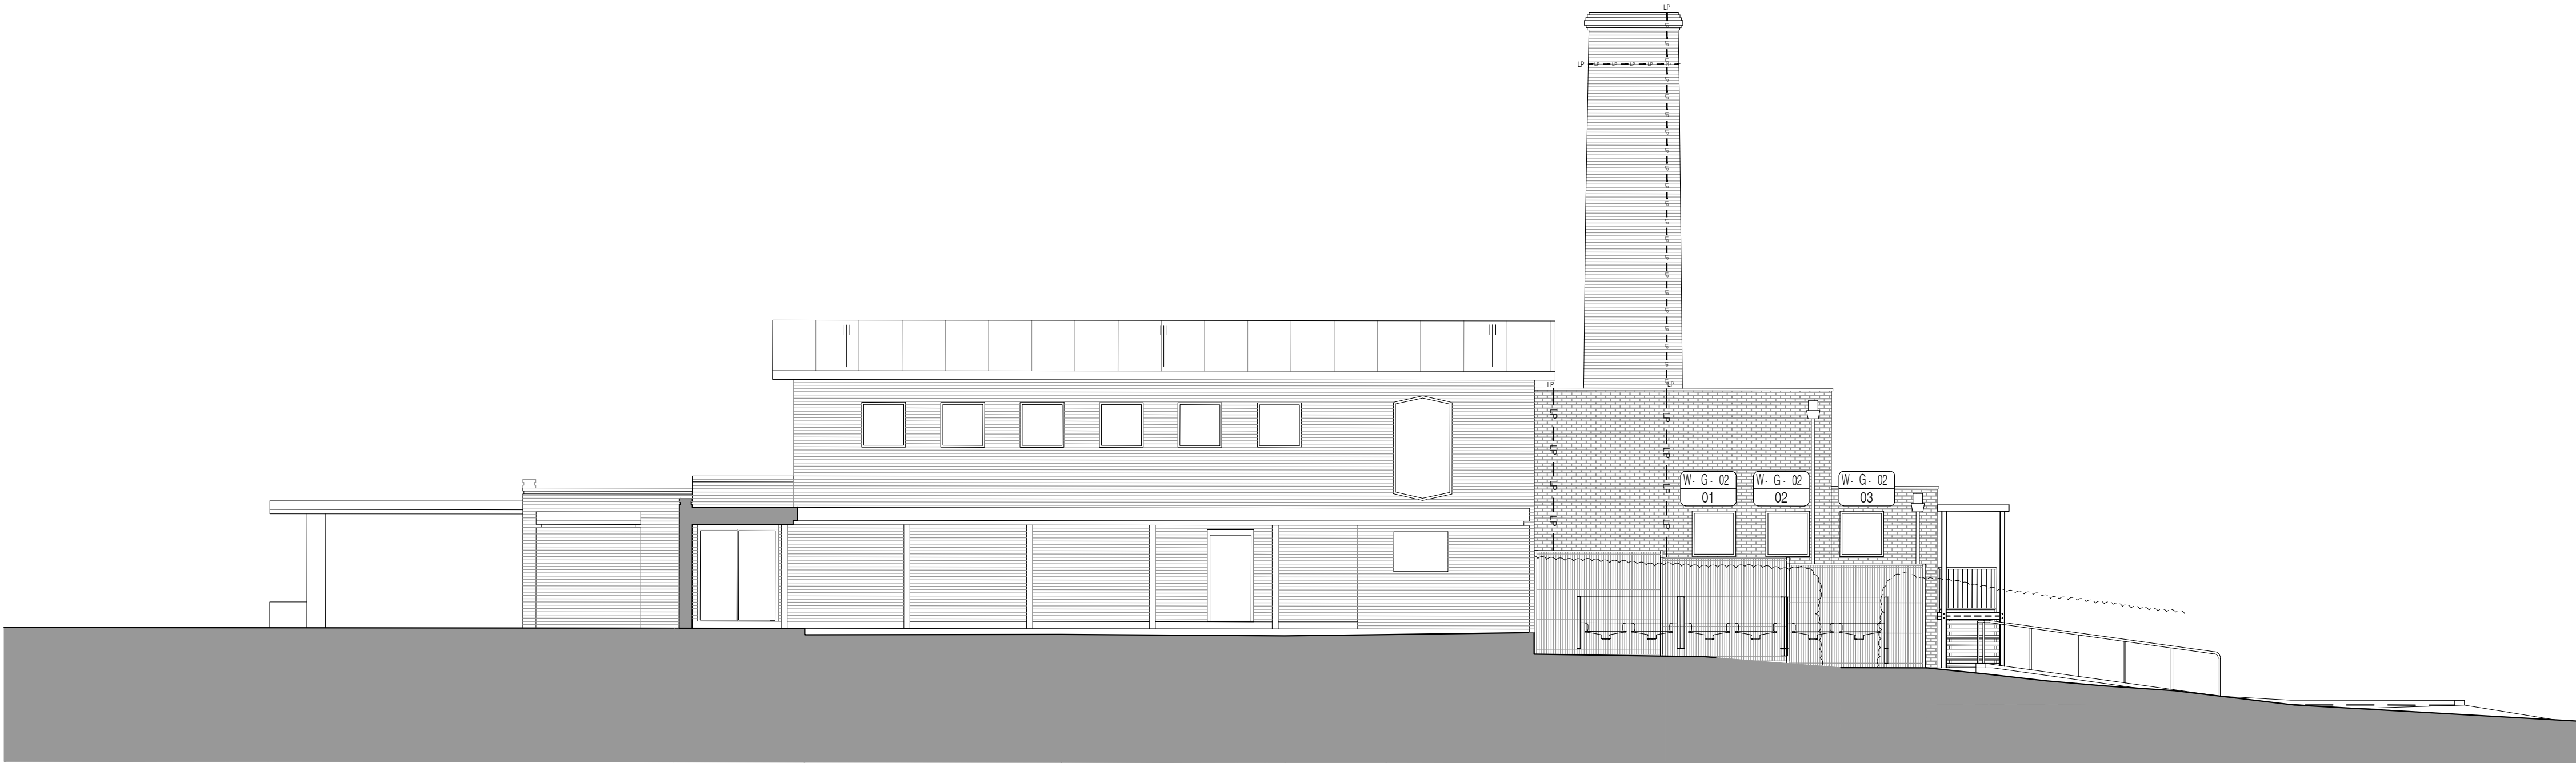

02 West Elevation
Scale: 1:100

NB: All information based on supplied third party survey information.
All discrepancies to be reported to FCG immediately upon discovery.

NOTES: Do not scale this drawing. All dimensions to be checked on site prior to commencement or manufacture.
Key Plan (nts)

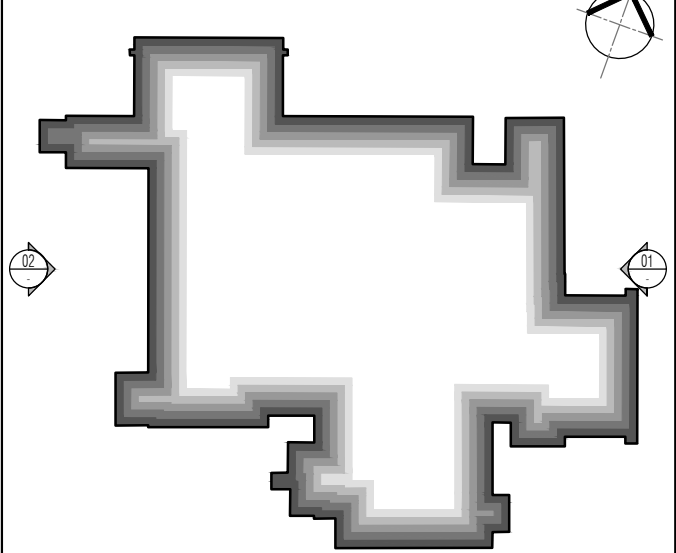

AS BUILT
DRAWING

All details referenced in call outs supercede general arrangement or larger depictions.

Rev	Date	By	Chk	Comment
AB1	07.01.13	RKC	JAS	DRAWING ISSUED - AS BUILT

BRINGING IDEAS TO LIFE



FRANKHAM

Frankham Consultancy Group Limited
21 Perrymount Road
Haywards Heath RH16 3TP
t 01444 444900 f 01444 455642
enquire@frankham.com
www.frankham.com

Client
Mansell
Contract N°: MC0269

Project Title
Eastbourne & Worthing
Crematoria
Refurbishments and Alterations


Drawing Title
EASTBOURNE
Eastbourne Crematorium
Proposed East & West Elevations

Drawn by: RKC	Scale: 1:100@A1	Date: 28.10.11
Designed by: FCG	Checked by: JAS	Approved by: AC

File Ref.: X:\FRANKHAM\2_080512\01 CREMATORIA\ARCH\0269-000 ELEVATIONS
307380-A-311-E.DWG - 200611121614 20.06.11 12:16:14


Drawing No. 521260-A-311-E	Rev. AB1
-------------------------------	-------------

NOTES: Do not scale this drawing. All dimensions to be checked on site prior to commencement or manufacture.
Key Plan (nts)

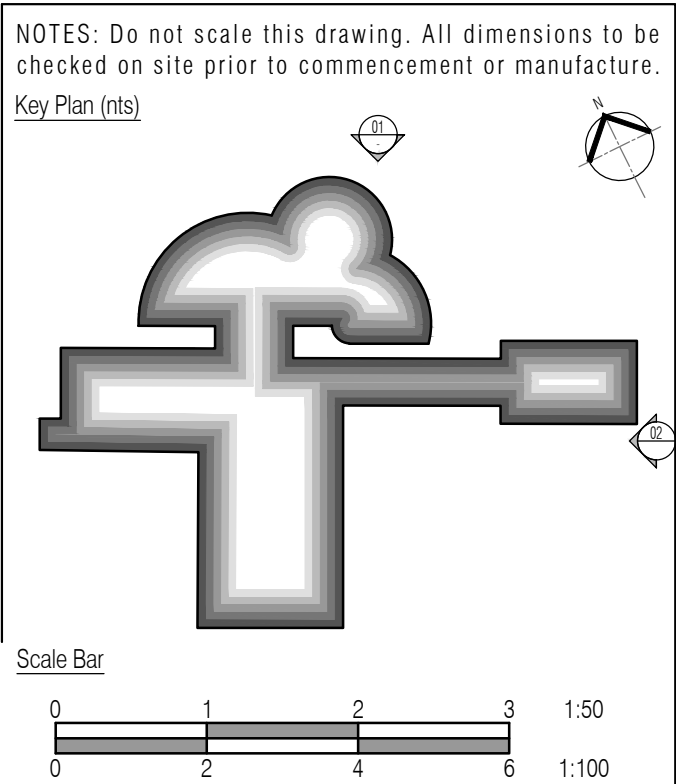


Scale Bar

0 1 2 3 1:50
0 2 4 6 1:100

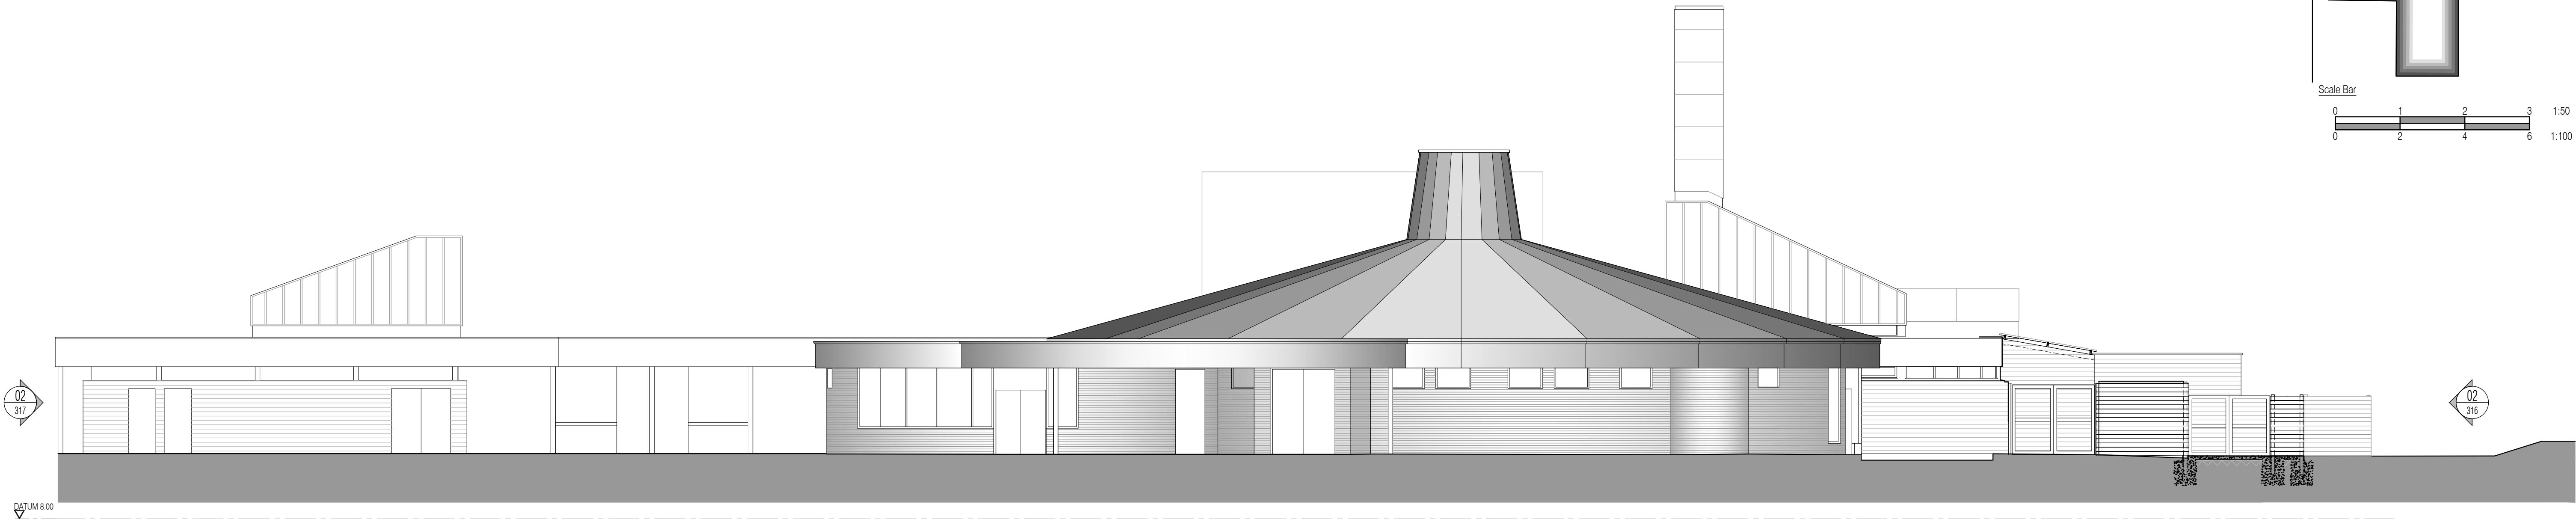

01 North Elevation
Scale: 1:100

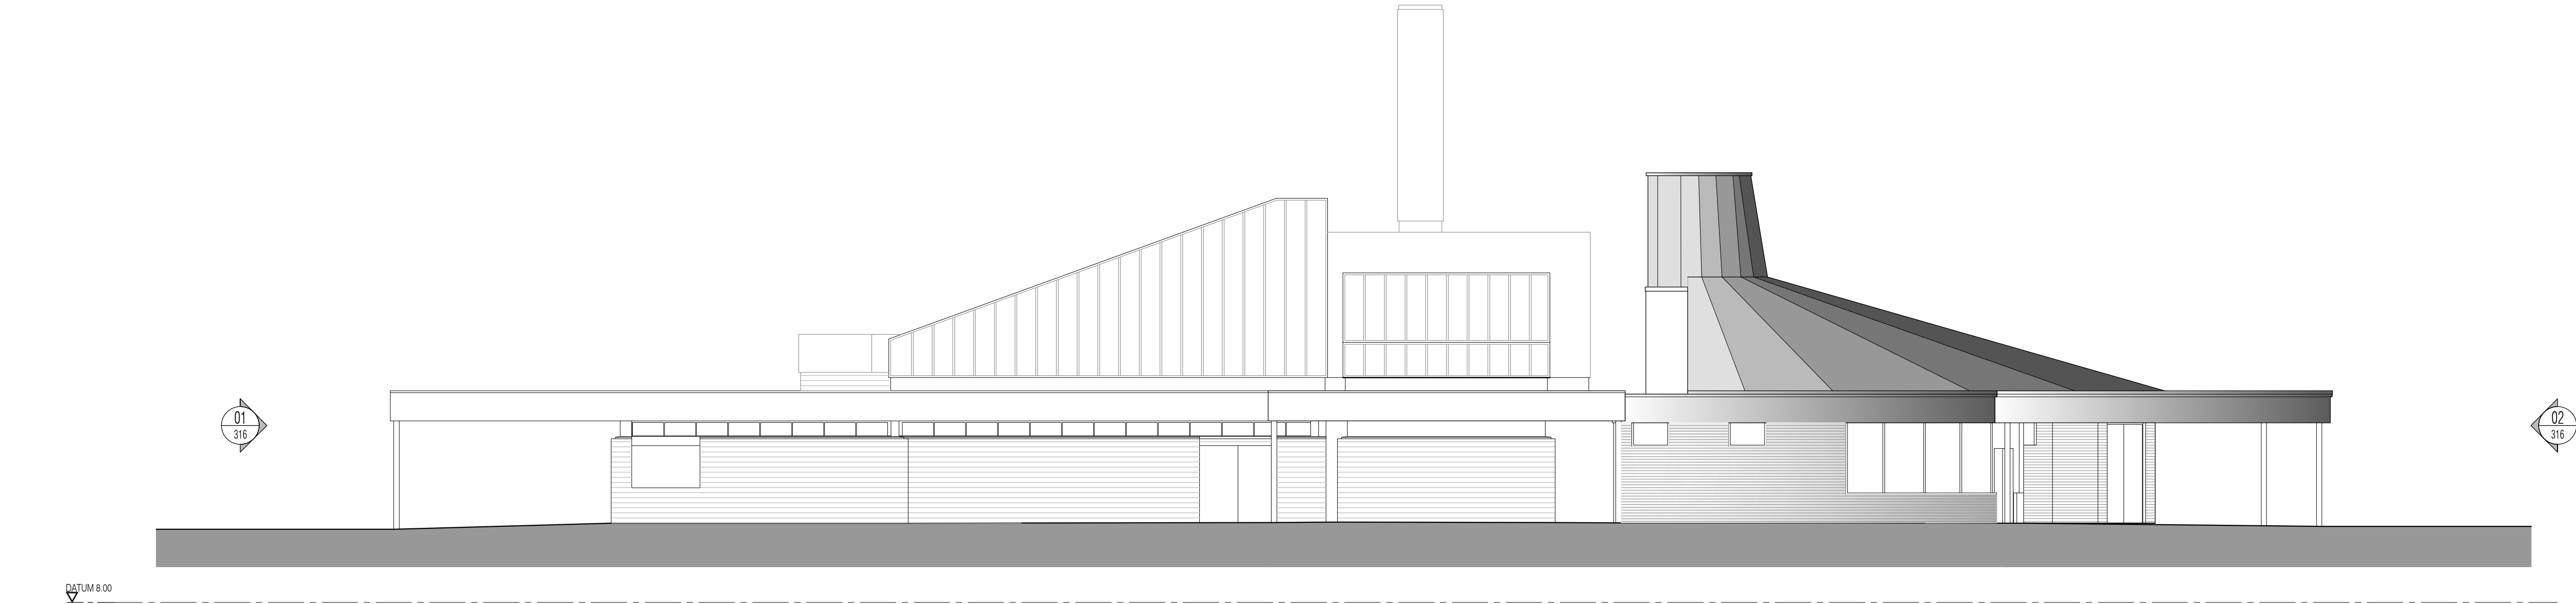

02 East Elevation
Scale: 1:100

NB: All information based on supplied third party survey information.
All discrepancies to be reported to FCG immediately upon discovery.

AS BUILT
DRAWING

All details referenced in call outs supersede general arrangement or larger depictions.

Rev	Date	By	Chk	Comment
AB1	07.01.13	RKC	JAS	DRAWING ISSUED - AS BUILT

BRINGING IDEAS TO LIFE

FRANKHAM

Frankham Consultancy Group Limited
21 Pymmount Road
Haywards Heath RH16 3TP
t 01444 444900 f 01444 455642
enquire@frankham.com
www.frankham.com

Client

Mansell

Contract N°: Worthing

Project Title

Eastbourne & Worthing
Crematoria
Refurbishments and Alterations

Drawing Title

Worthing

Worthing Crematorium
Proposed North & East Elevations

Drawn by: RKC	Scale: 1:100@A1	Date: 28.10.11
Designed by: FCG	Checked by: JAS	Approved by: AC


File Ref.: X:\FRANKHAM\2_080512180 CREMATORIA\WORKBOOK 300 ELEVATIONS
521260-A-315-W-0000 - 200811271516

20.06.11 12:16:19

Drawing No. 521260-A-315-W	Rev. AB1
-------------------------------	-------------



01 South Elevation
Scale: 1:100

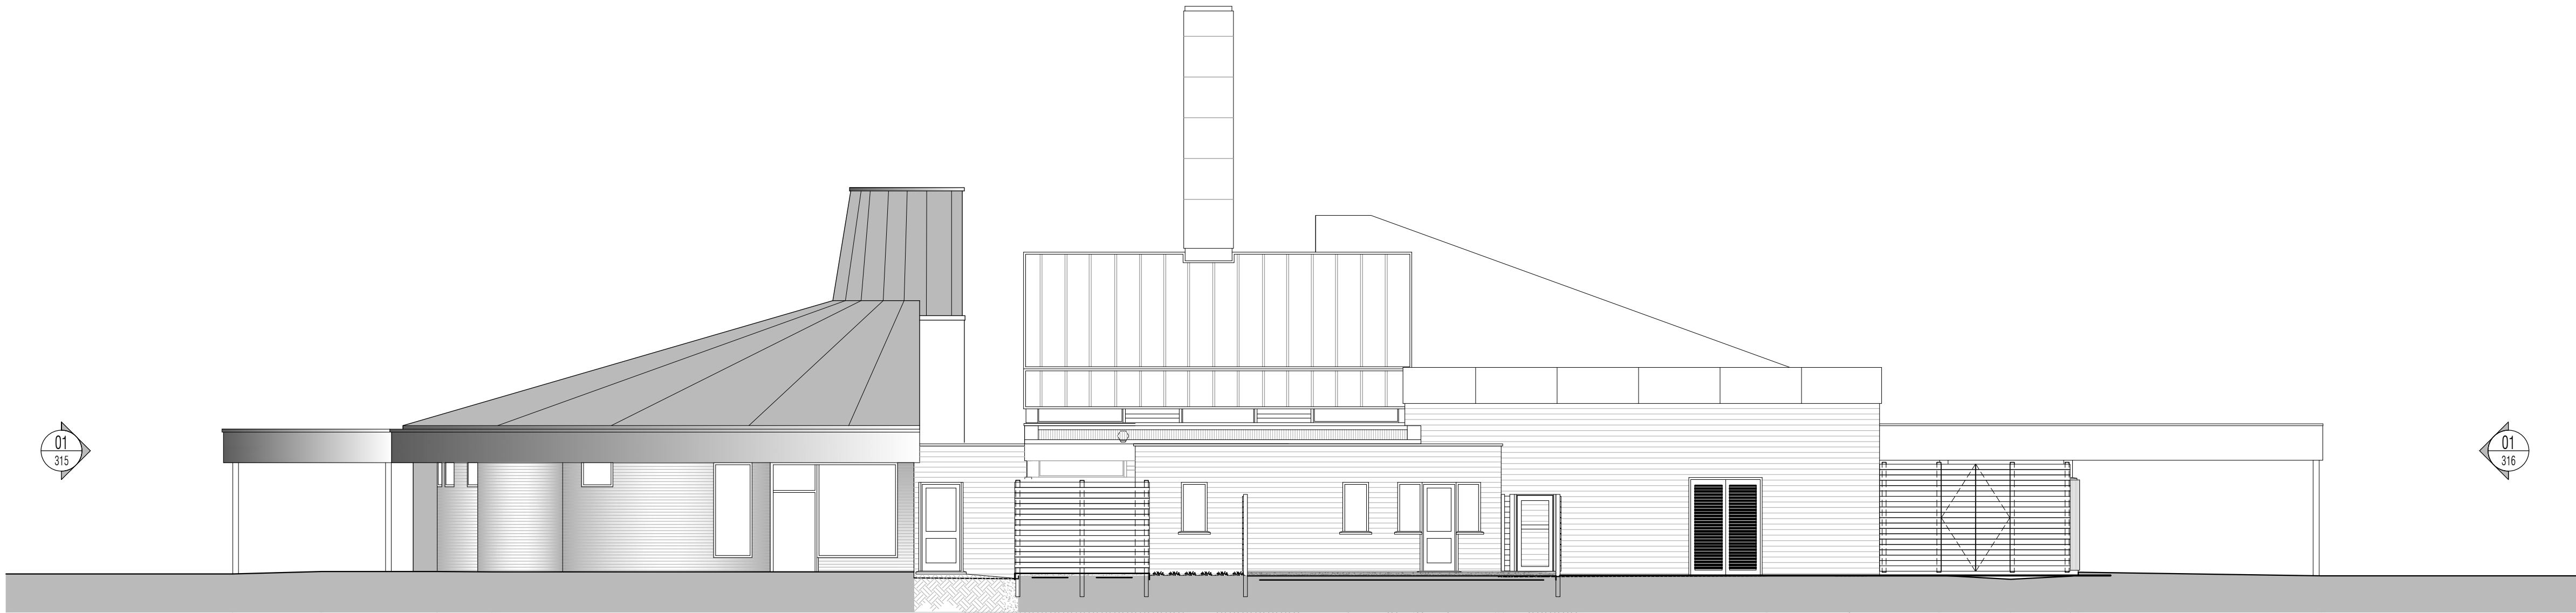

02 West Elevation
Scale: 1:100

NOTES: Do not scale this drawing. All dimensions to be checked on site prior to commencement or manufacture.
Key Plan (nts)

Scale Bar

0 1 2 3 4 5 6

1:50
1:100

NB: All information based on supplied third party survey information.
All discrepancies to be reported to FCG immediately upon discovery.

AS BUILT
DRAWING

All details referenced in call outs supercede general arrangement or larger depictions.

Rev	Date	By	Chk	Comment
AB1	07.01.13	RKC	JAS	DRAWING ISSUED - AS BUILT

BRINGING IDEAS TO LIFE

FRANKHAM

Frankham Consultancy Group Limited
21 Perryman Road
Haywards Heath RH16 3TP
t 01444 444900 f 01444 455642
enquiries@frankham.com
www.frankham.com

Client

Mansell

Contract N°: Worthing

Project Title

Eastbourne & Worthing
Crematoria
Refurbishments and Alterations

Drawing Title

Worthing

Worthing Crematorium
Proposed South & West Elevations

Drawn by: RKC	Scale: 1:100@A1	Date: 28.10.11
Designed by: FCG	Checked by: JAS	Approved by: AC

File Ref.: X:\FRANKHAM\2_080513180 CREMATORIA\ARCH\006 300 ELEVATIONS 521260-A-316-W-0000 - 200811271623	20.06.11 12:16:23
Drawing No. 521260-A-316-W	Rev. AB1



NOTES: Do not scale this drawing. All dimensions to be checked on site prior to commencement or manufacture.

Key Plan (nts)

0 1 2 3 1:50
0 2 4 6 1:100

ISSUED FOR
CONSTRUCTION

All details referenced in call outs supersede general arrangement or larger depiction

C2	09.07.12	RKC	JAS	Issued for Construction
P8	01.06.12	RKC	JAS	Issued for Stage F
P7	01.05.12	RKC	JAS	Issued for New Planning Application
C1	23.04.12	RKC	JAS	Issued for CONSTRUCTION
Rev	Date	By	Chk	Comment

BRINGING IDEAS TO LIFE



FRANKHAM

Frankham Consultancy Group Limited
21 Perry Mount Road
Haywards Heath RH16 3TP
t 01444 444900 f 01444 455642
enquire@frankham.com
www.frankham.com

Client



Contract N°: Worthing

Project Title

Eastbourne & Worthing
Crematoria
Refurbishments and Alterations

Drawing Title



Worthing Crematorium
Proposed South & West Elevations
Enlargements

Drawn by

Scale:

Date:

Designed by

Checked by _____









Approved I

File Ref.: X:\FRANKHAMZ-JOBS\521260-CREMATORY\APIC\300-399-ELEVATION\521260-A-317-W.DWG - 200611121630


20:06:11-12:16:28

Drawing No.
521260-A-317-W

Rev.
C2

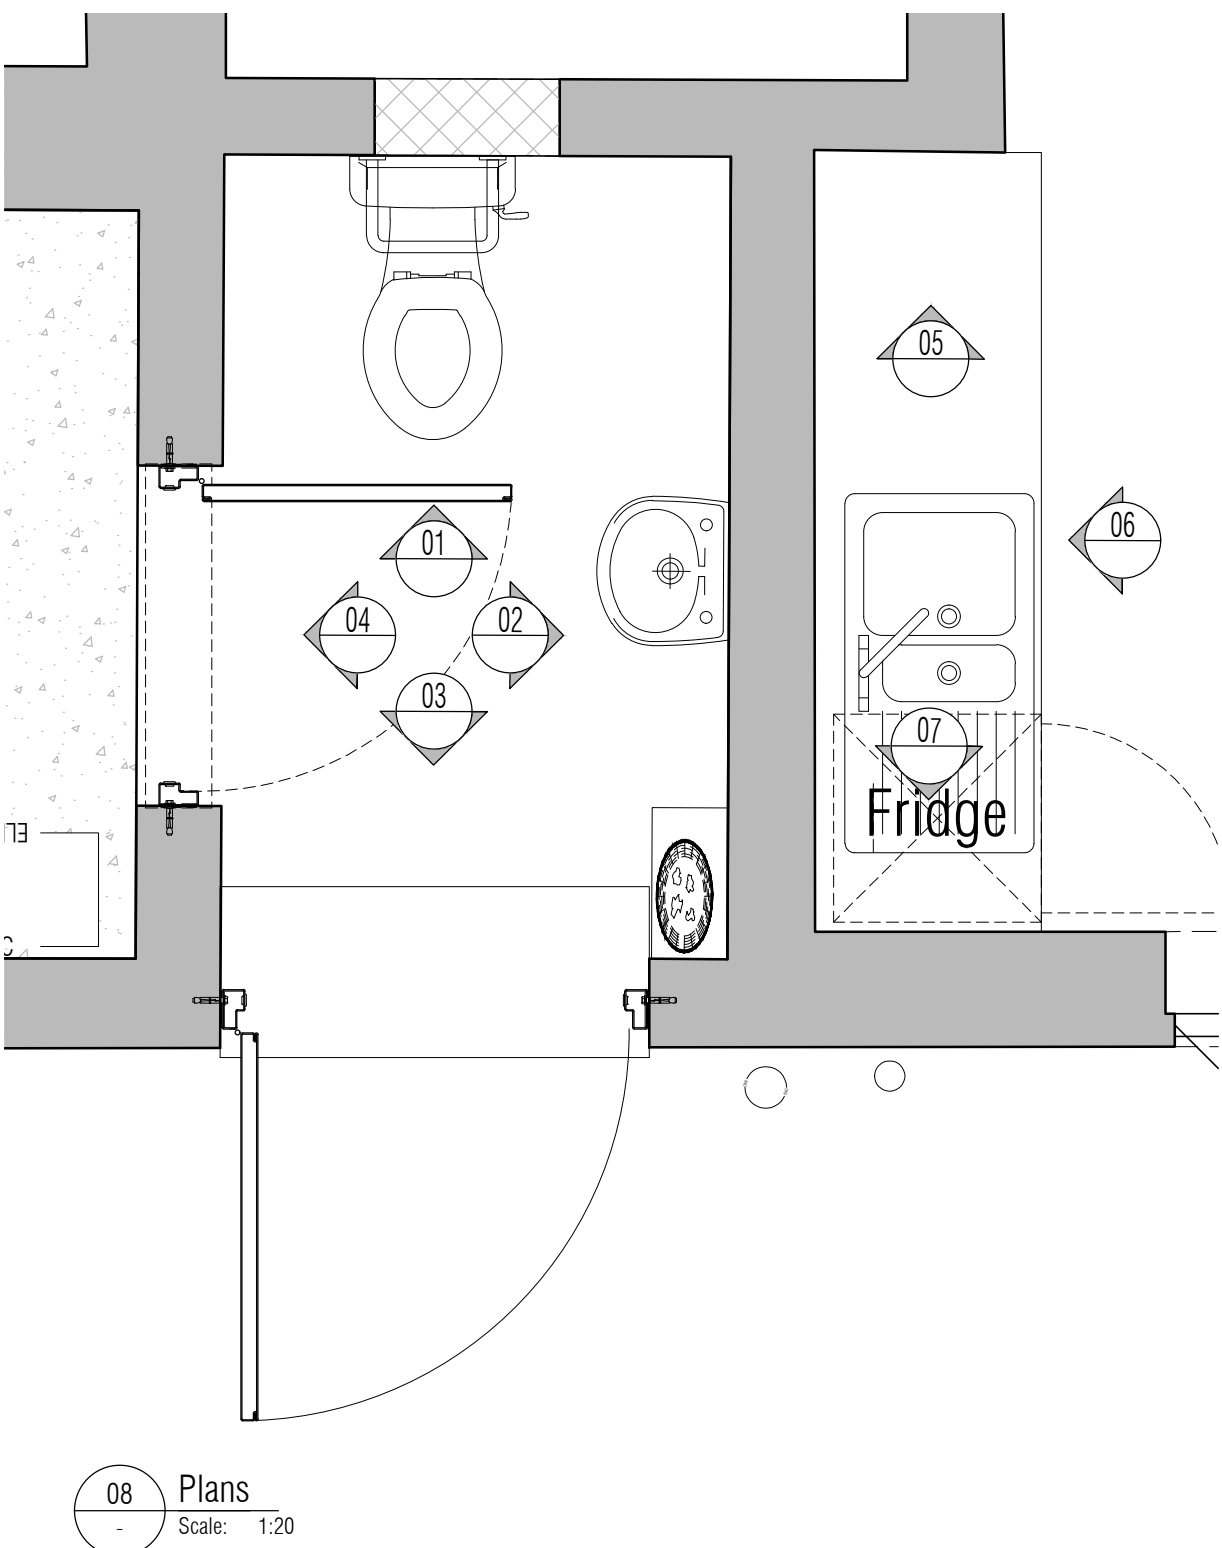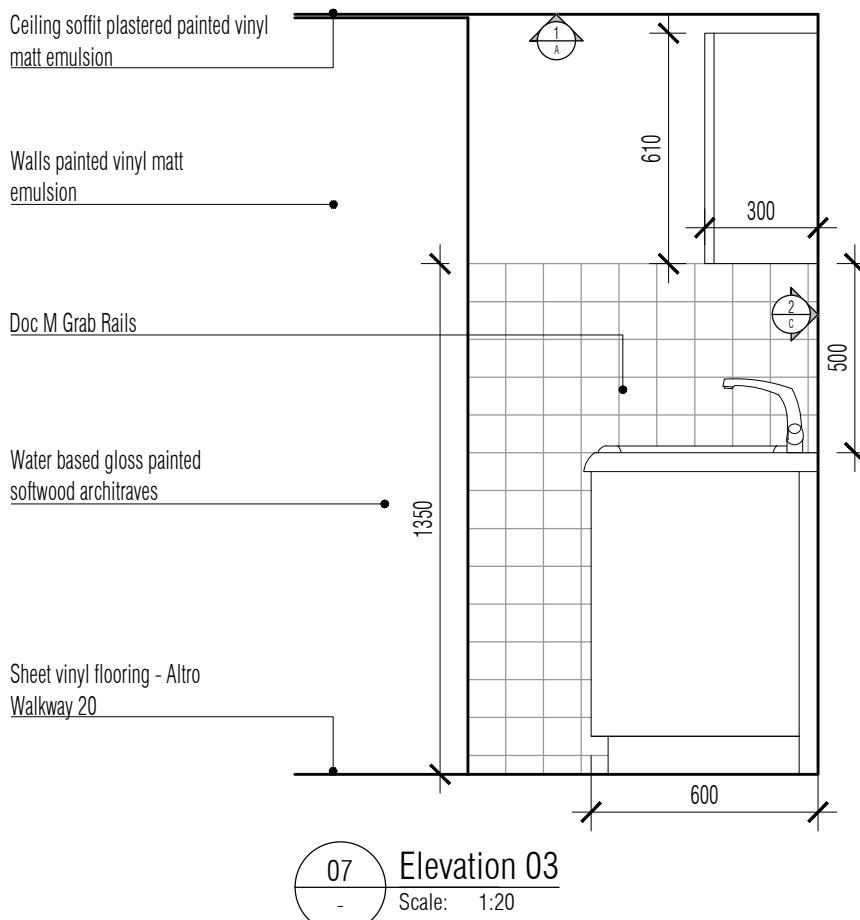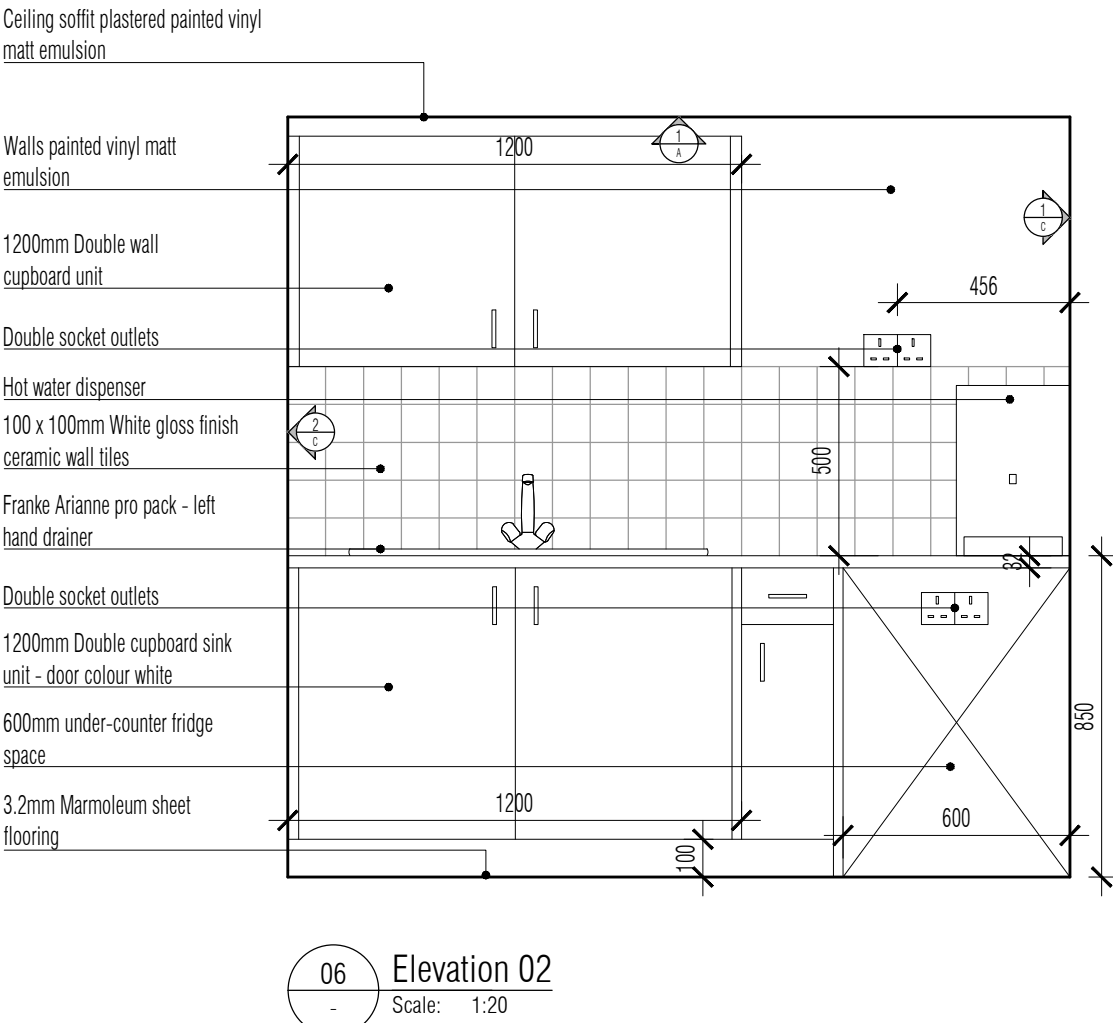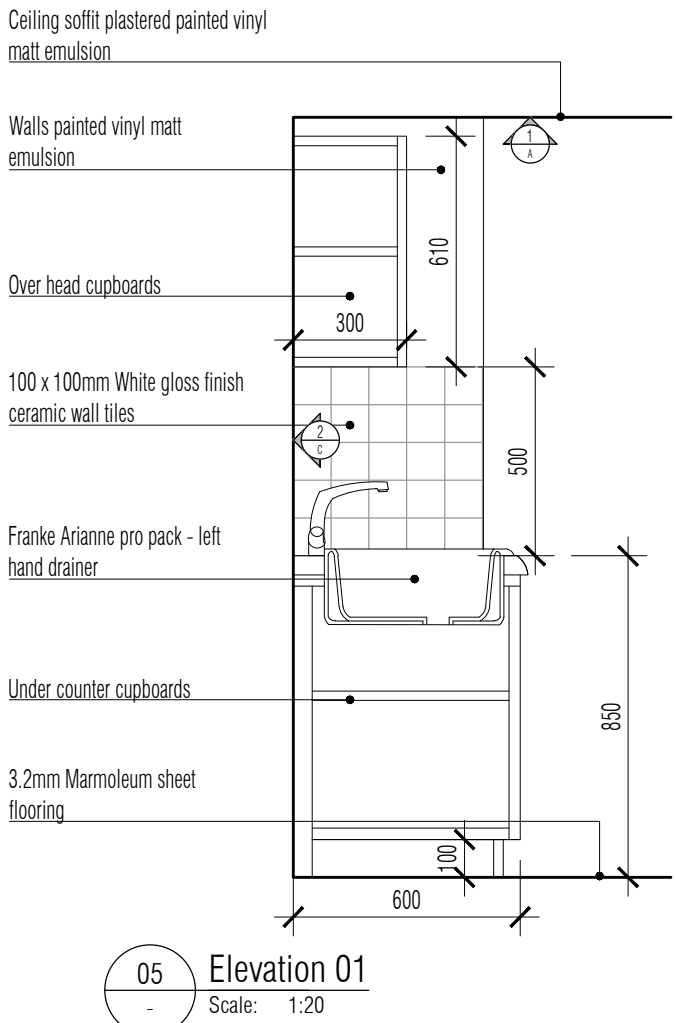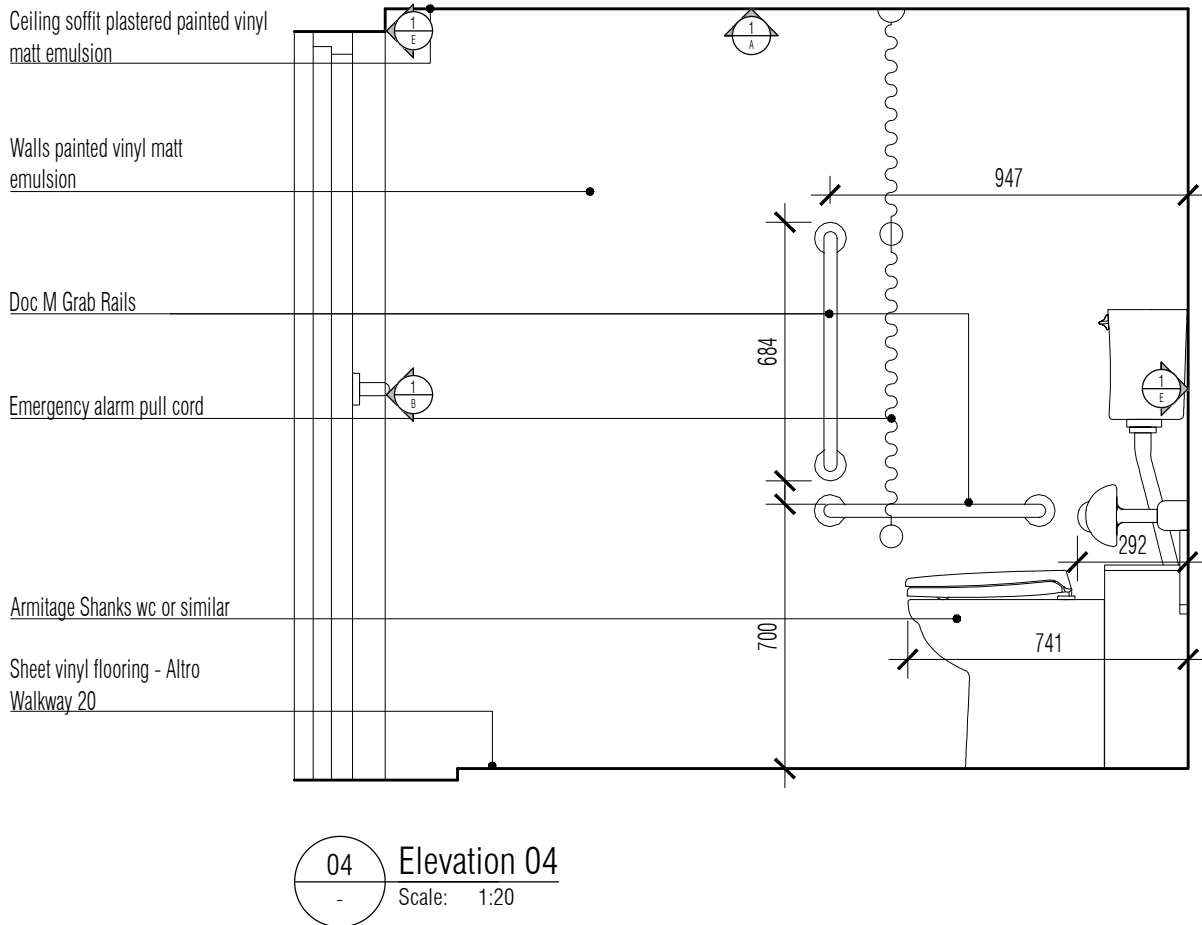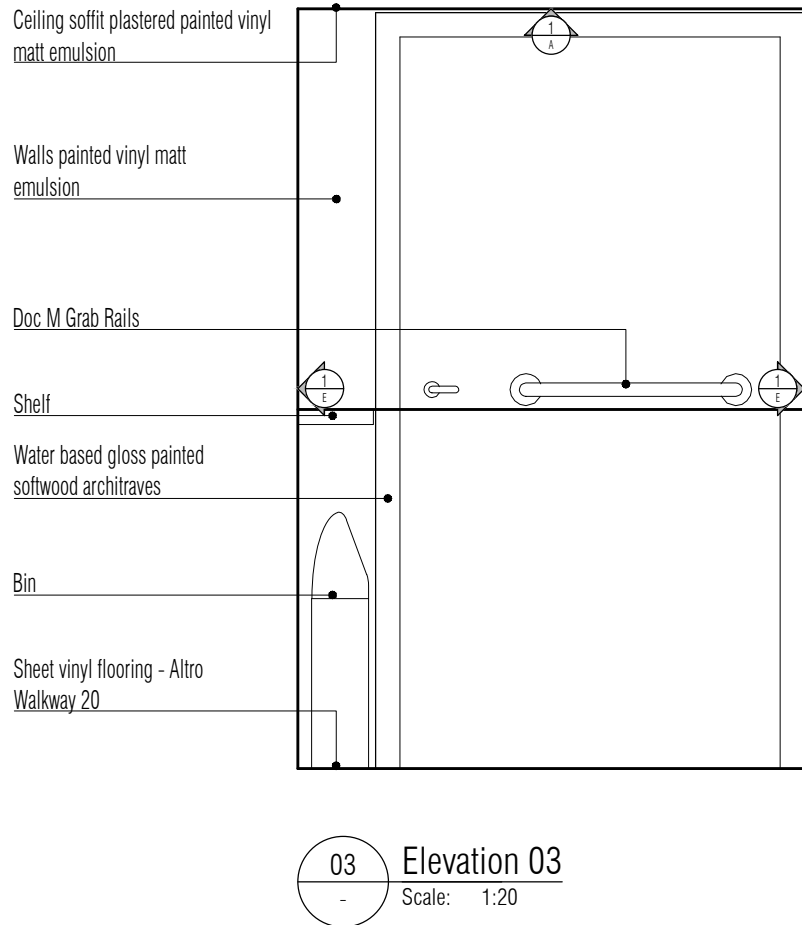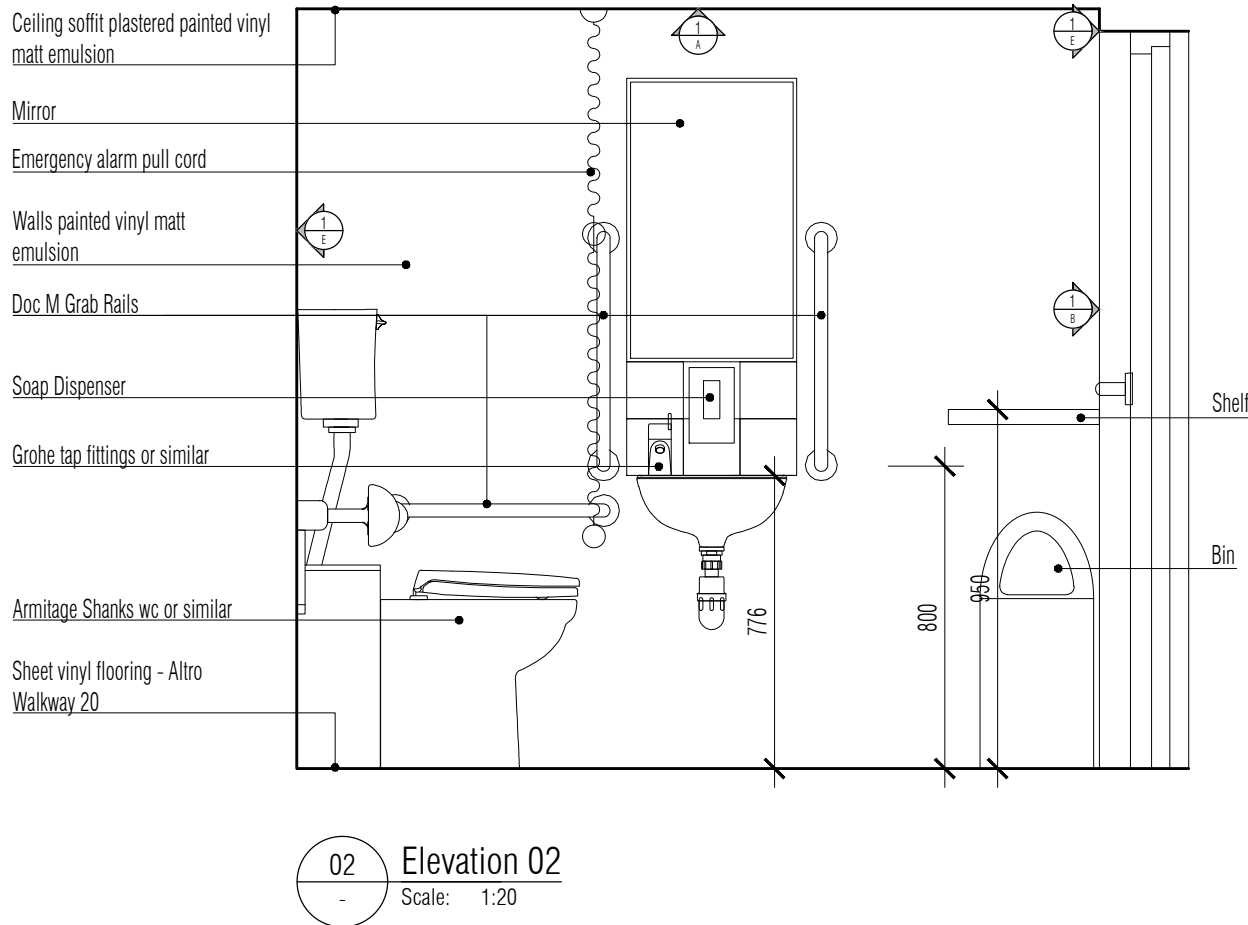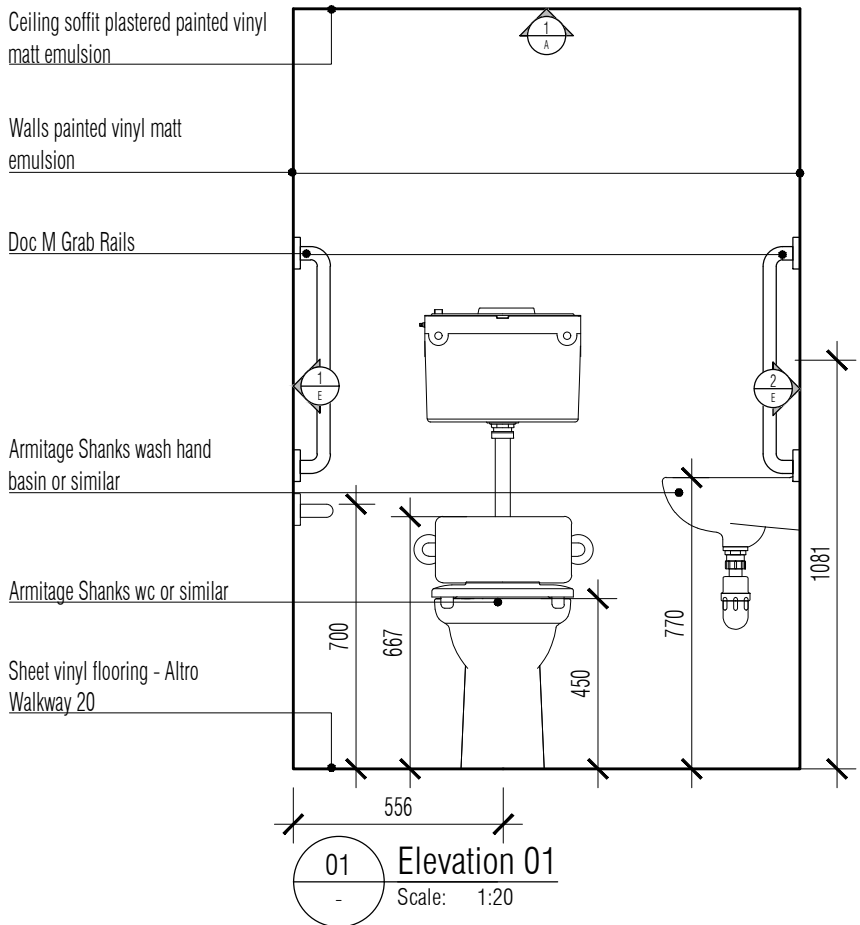

NOTES: Do not scale this drawing. All dimensions to be checked on site prior to commencement or manufacture.
Key Plan (nts)

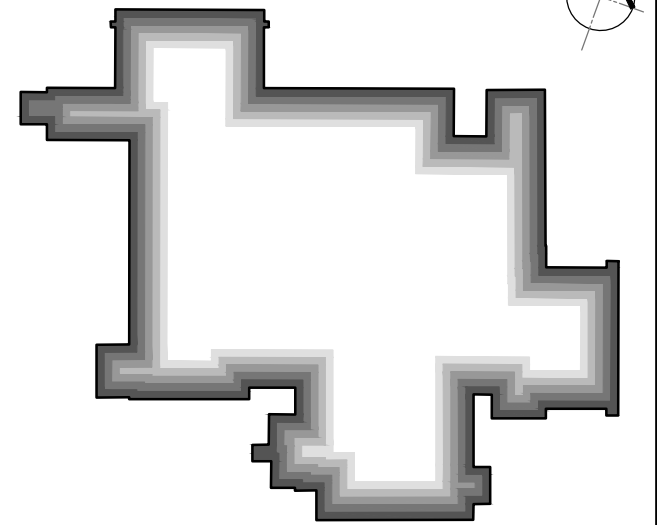

- Wall Finishes Legend
All colours to be confirmed.
- Denotes painted finish
 - Denotes painted emulsion finish with ceramic tiled splash-back.
 - Denotes ceramic tiles.
 - Denotes water based epoxy floor paint finish min 150mm from FFL. Colour: TBC.
 - Denotes make good existing finishes and re-decorate. Colour to match existing
 - Denotes timber trellace fitted between posts. Finish: TBC.
 - Denotes external wall, no works required.
 - Denotes new insulation, rails and larch T&G cladding.
 - Denotes polyester powder coated metal facings.
 - Denotes no internal finish is required.
 - Denotes white gloss finish ceramic tiles.
- A. Denotes Dulux Brilliant White Matt vinyl
B. Denotes Dulux Brilliant White gloss
C. Denotes Dulux Pale Citris Matt vinyl
D. Denotes Dulux Mellow Mocha Matt vinyl
E. Denotes Dulux Willow Tree Matt vinyl
- X denotes finish type, Z denotes colour, Arrow denotes which wall elevation finish to be applied to.

ISSUED FOR CONSTRUCTION

All details referenced in call outs supercede general arrangement or larger depictions.

Rev	Date	By	Chk	Comment
C2	16.05.12	RKC	JAS	Fins added. Revd per Client comments
C1	29.03.12	RKC	JAS	Issued for CONSTRUCTION


BRINGING IDEAS TO LIFE

FRANKHAM


Frankham Consultancy Group Limited
21 Perryman Road
Haywards Heath RH16 3TP
t 01444 444900 f 01444 455642
enquiries@frankham.com
www.frankham.com

Client	 Mansell Building Services Contract N°: MC0269		
Project Title	Eastbourne & Worthing Crematoria Refurbishments and Alterations		
Drawing Title	 Eastbourne Crematorium Lower Ground Floor Room Elevations Ambulant Disabled & Kitchenette		
Drawn by: RKC	Scale: 1:20@A1	Date: 07.02.12	
Designed by: FCG	Checked by: JAS	Approved by: AC	
File Ref.: X:\FRANKHAM\2 - 080512\210 CREMATORIA\WORK\006-300-000\000000 507380-A-320-E-0001 - 0001\11111210			
Drawing No. 521260-A-320-E			Rev. C2


NB: All information based on supplied third party survey information.
All discrepancies to be reported to FCG immediately upon discovery.

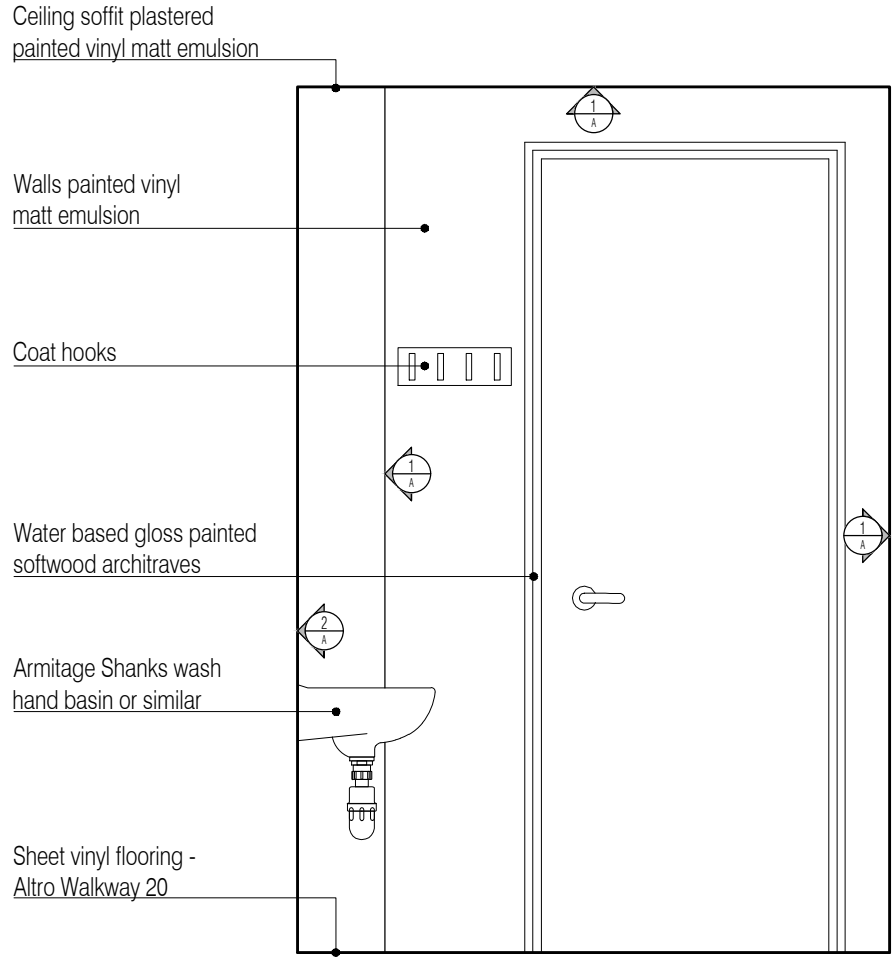


01 Elevation 01
Scale: 1:20

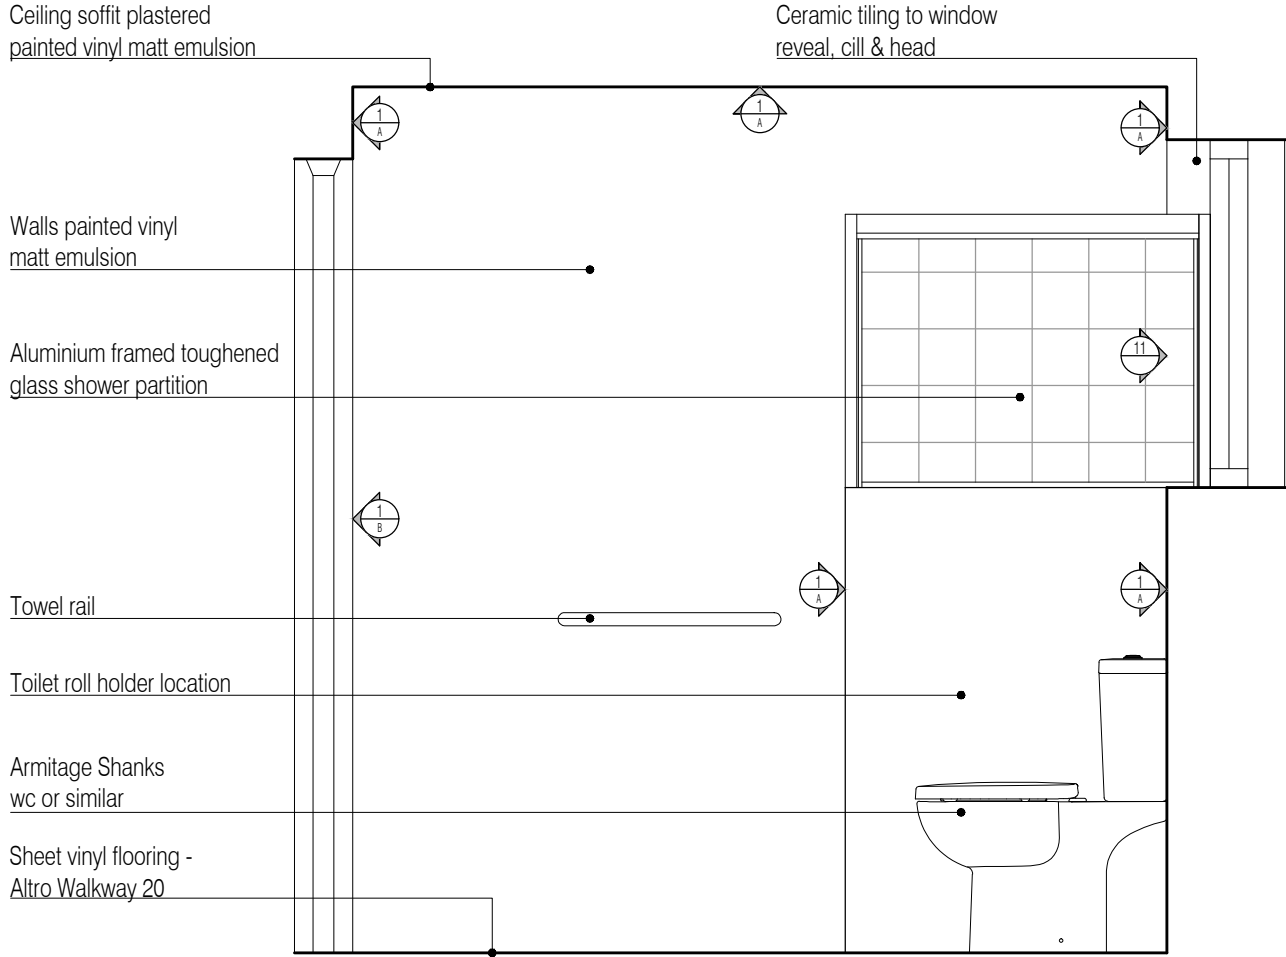


02 Elevation 02
Scale: 1:20

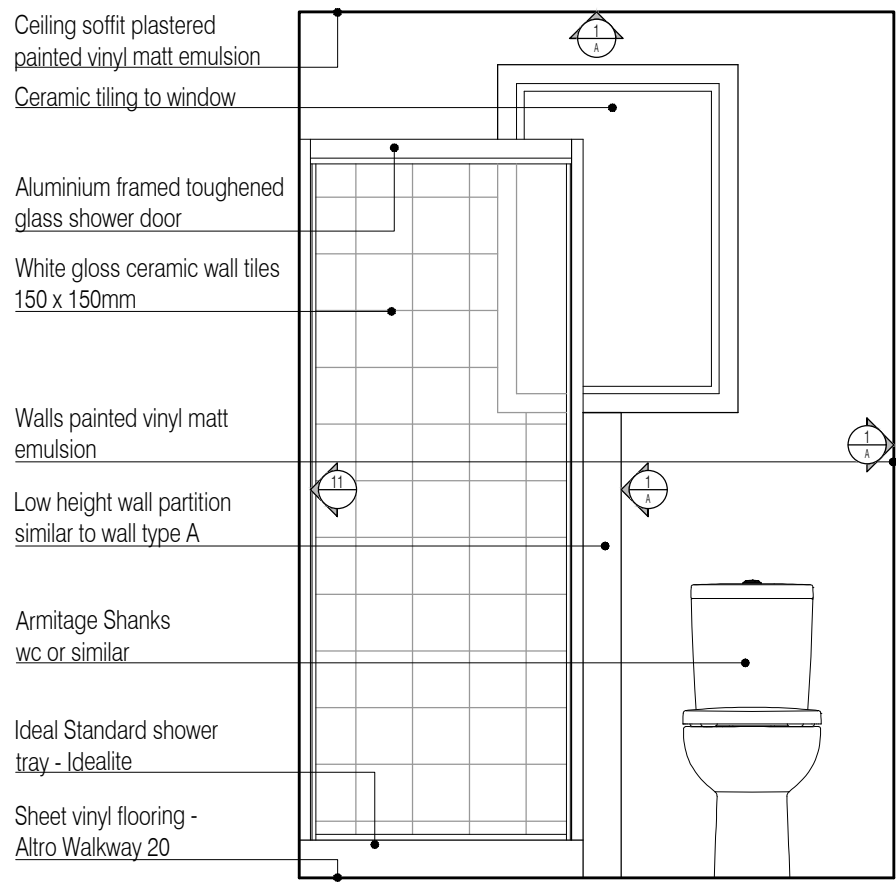

03 Elevation 03
Scale: 1:20

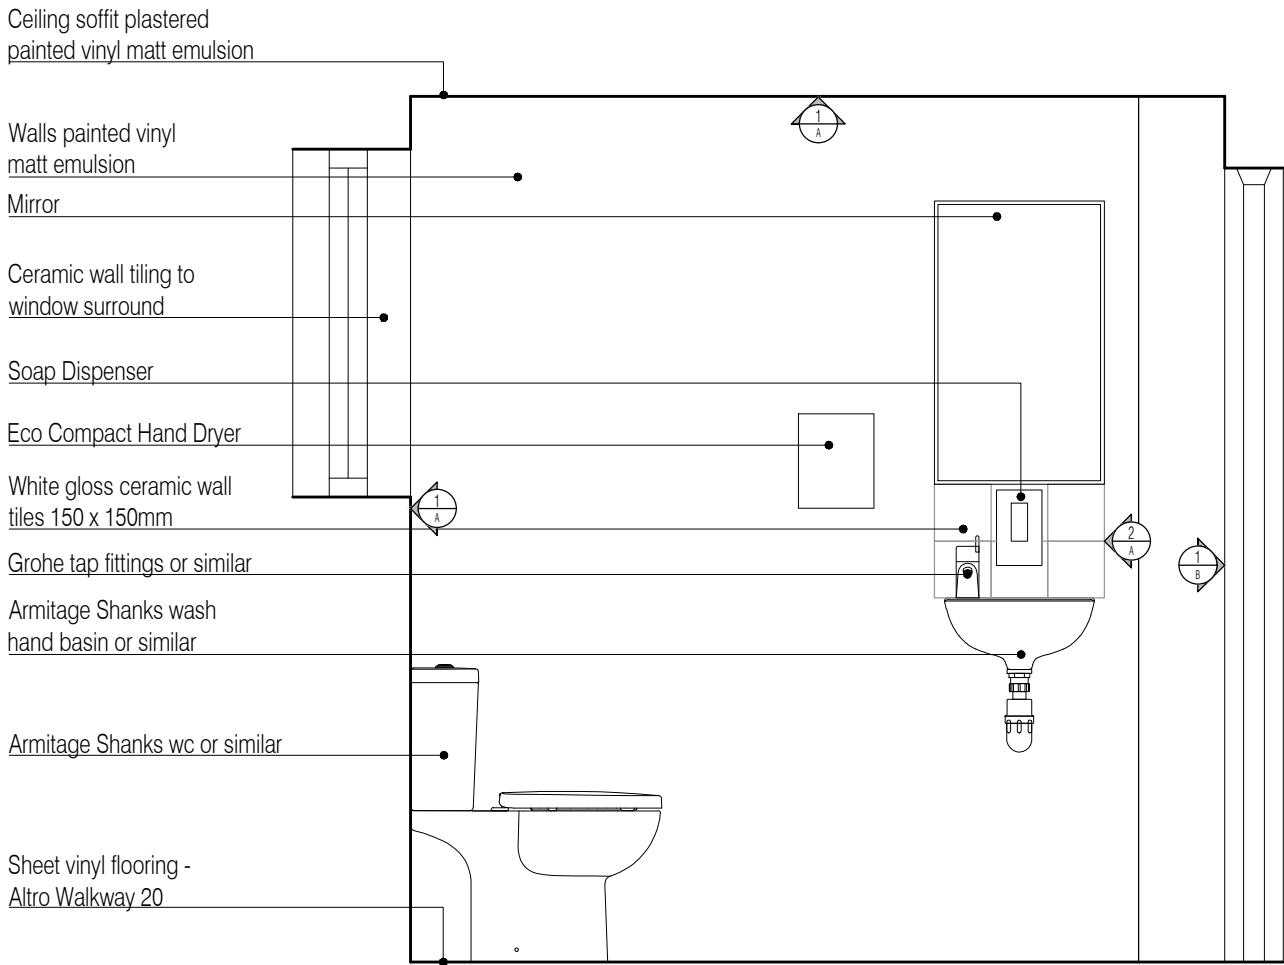


04 Elevation 04
Scale: 1:20

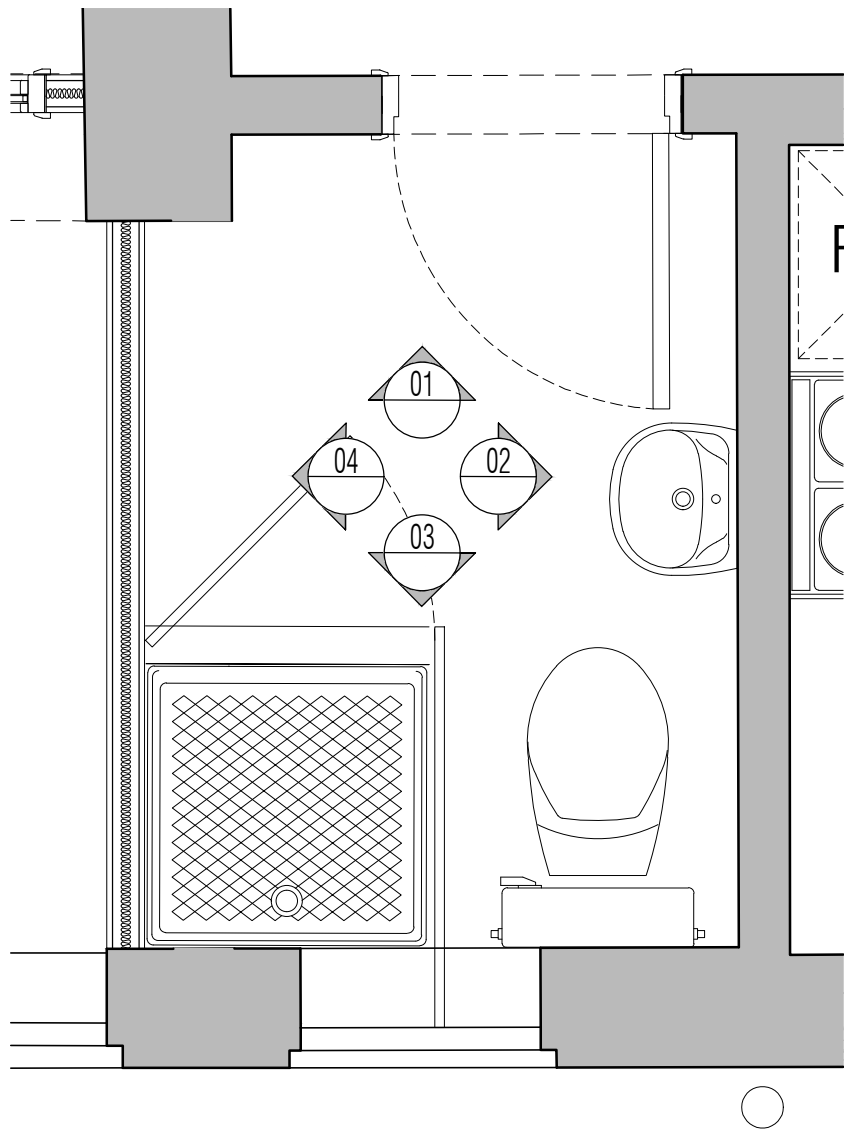

05 Plan
Scale: 1:20

NOTES: Do not scale this drawing. All dimensions to be checked on site prior to commencement or manufacture.
Key Plan (nts)

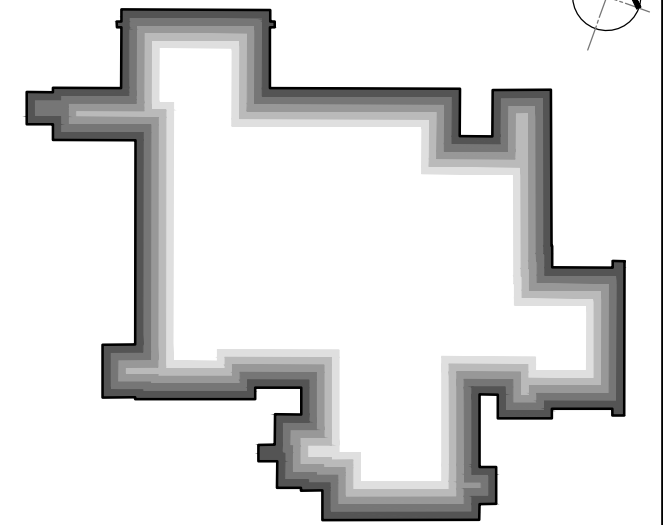

- Wall Finishes Legend
All colours to be confirmed.
- Denotes painted finish
 - Denotes painted emulsion finish with ceramic tiled splash-back.
 - Denotes ceramic tiles.
 - Denotes water based epoxy floor paint finish min 150mm from FFL. Colour: TBC.
 - Denotes make good existing finishes and re-decorate. Colour to match existing
 - Denotes timber trellace fitted between posts. Finish: TBC.
 - Denotes external wall, no works required.
 - Denotes new insulation, rails and larch T&G cladding.
 - Denotes polyester powder coated metal facings.
 - Denotes no internal finish is required.
 - Denotes white gloss finish ceramic tiles.
- A. Denotes Dulux Brilliant White Matt vinyl
B. Denotes Dulux Brilliant White gloss
C. Denotes Dulux Pale Citris Matt vinyl
D. Denotes Dulux Mellow Mocha Matt vinyl
E. Denotes Dulux Willow Tree Matt vinyl
- X denotes finish type, Z denotes colour, Arrow denotes which wall elevation finish to be applied to.

ISSUED FOR
CONSTRUCTION

All details referenced in call outs supercede general arrangement or larger depictions.

Rev	Date	By	Chk	Comment
C2	16.05.12	RKC	JAS	Final added. Revs per Client comments
C1	29.03.12	RKC	JAS	Issued for CONSTRUCTION

BRINGING IDEAS TO LIFE


FRANKHAM

Frankham Consultancy Group Limited
21 Perymount Road
Haywards Heath RH16 3TP
t 01444 444900 f 01444 455642
enquiries@frankham.com
www.frankham.com


Client	Mansell Contract N°: MC0269
Project Title	Eastbourne & Worthing Crematoria Refurbishments and Alterations
Drawing Title	EASTBOURNE Eastbourne Crematorium Ground Floor Room Elevations WC & Shower Room / Changing Room

Drawn by: RKC	Scale: 1:20@A1	Date: 07.02.12
Designed by: FCG	Checked by: JAS	Approved by: AC
File Ref.: 301360-A-321-E-000 - 200611121641		
Drawing No. 521260-A-321-E		Rev. C2


NB: All information based on supplied third party survey information.
All discrepancies to be reported to FCG immediately upon discovery.

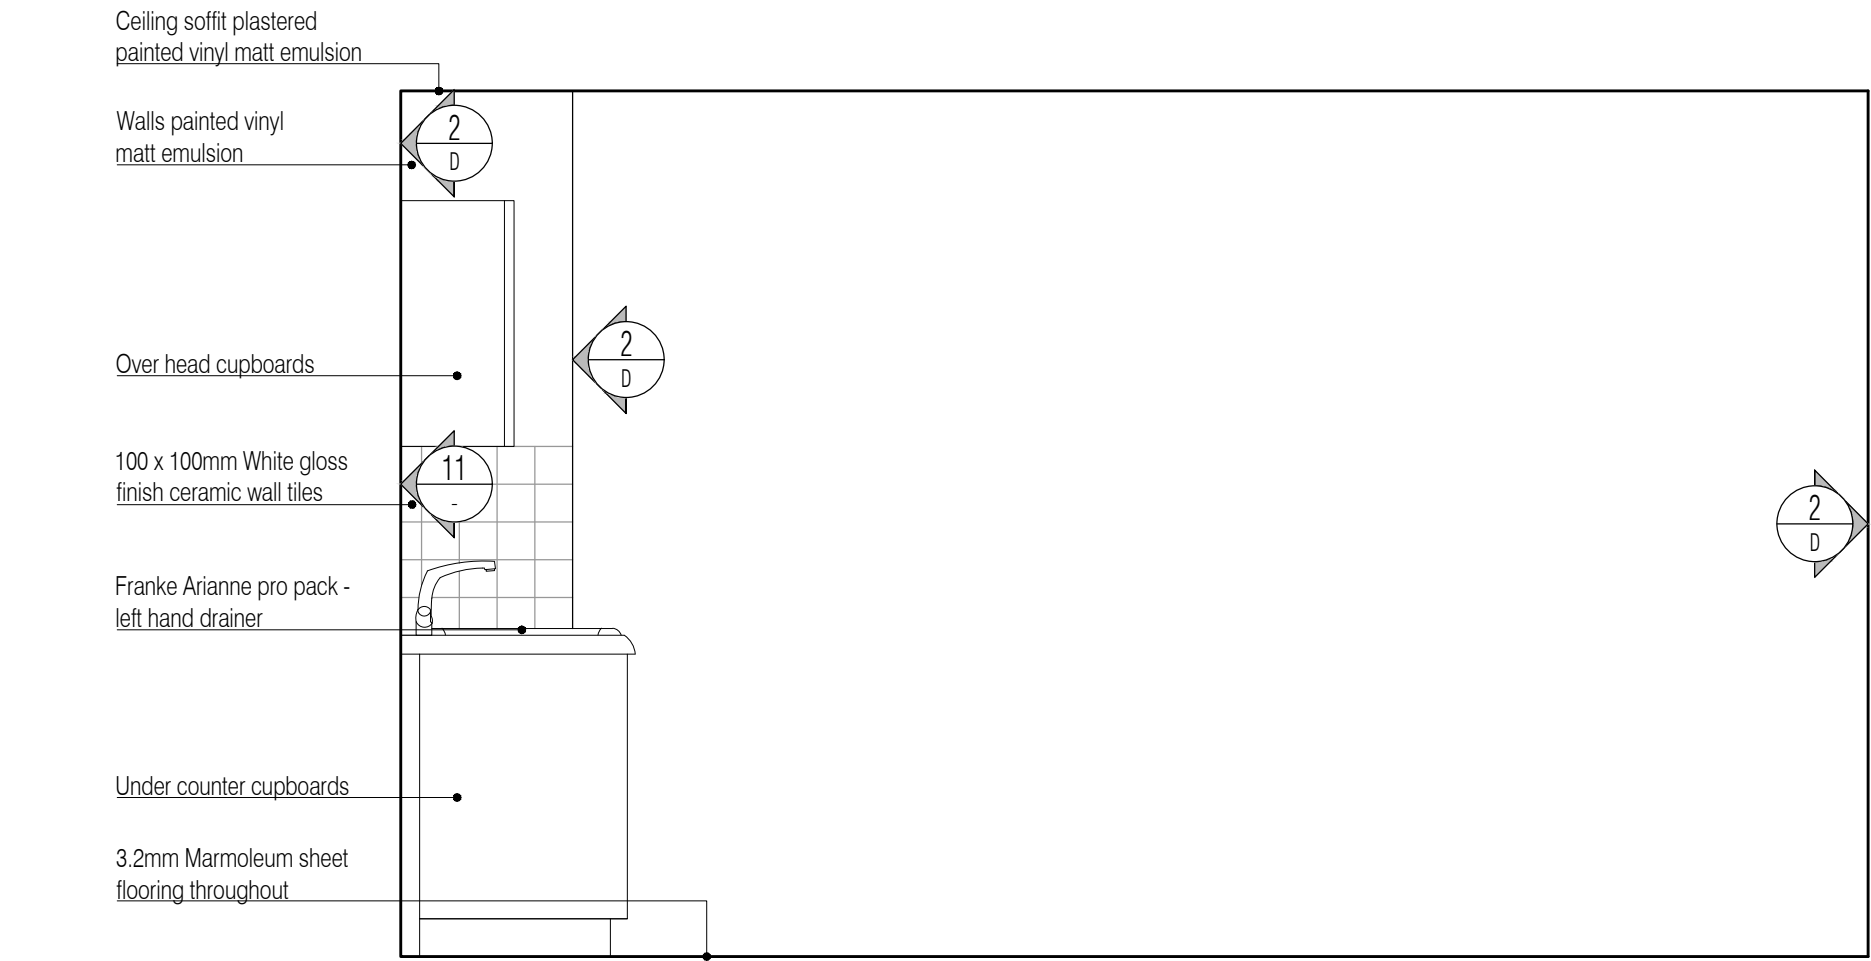


01 Elevation 01
Scale: 1:20

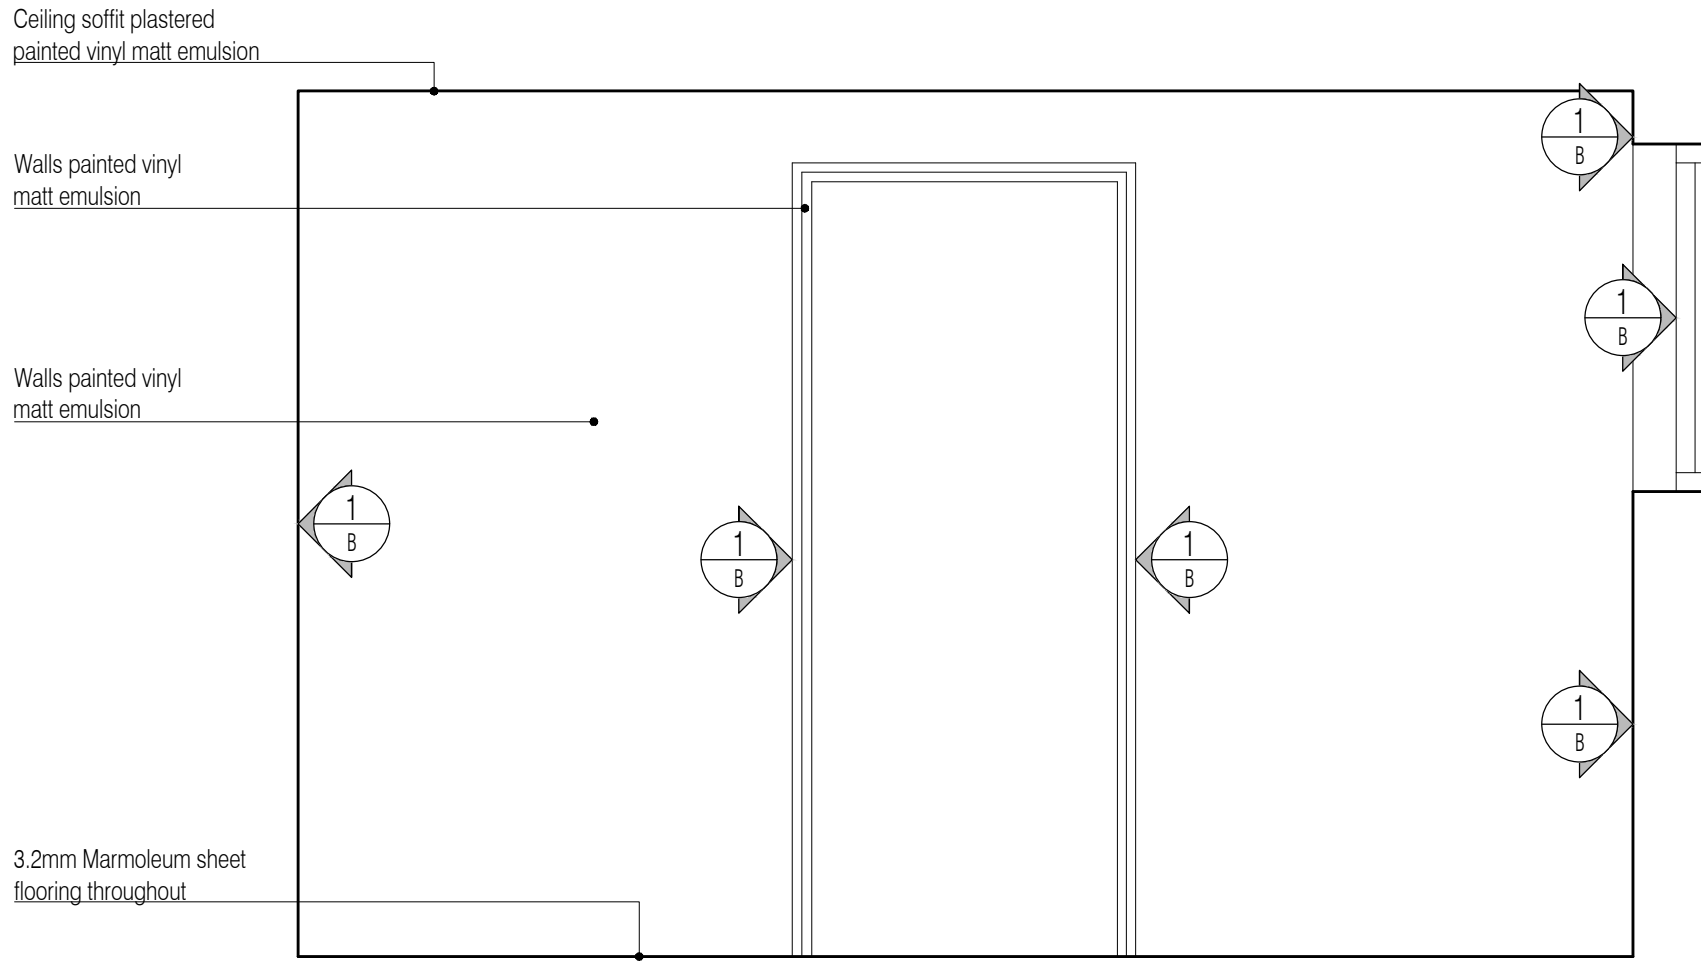


02 Elevation 02
Scale: 1:20

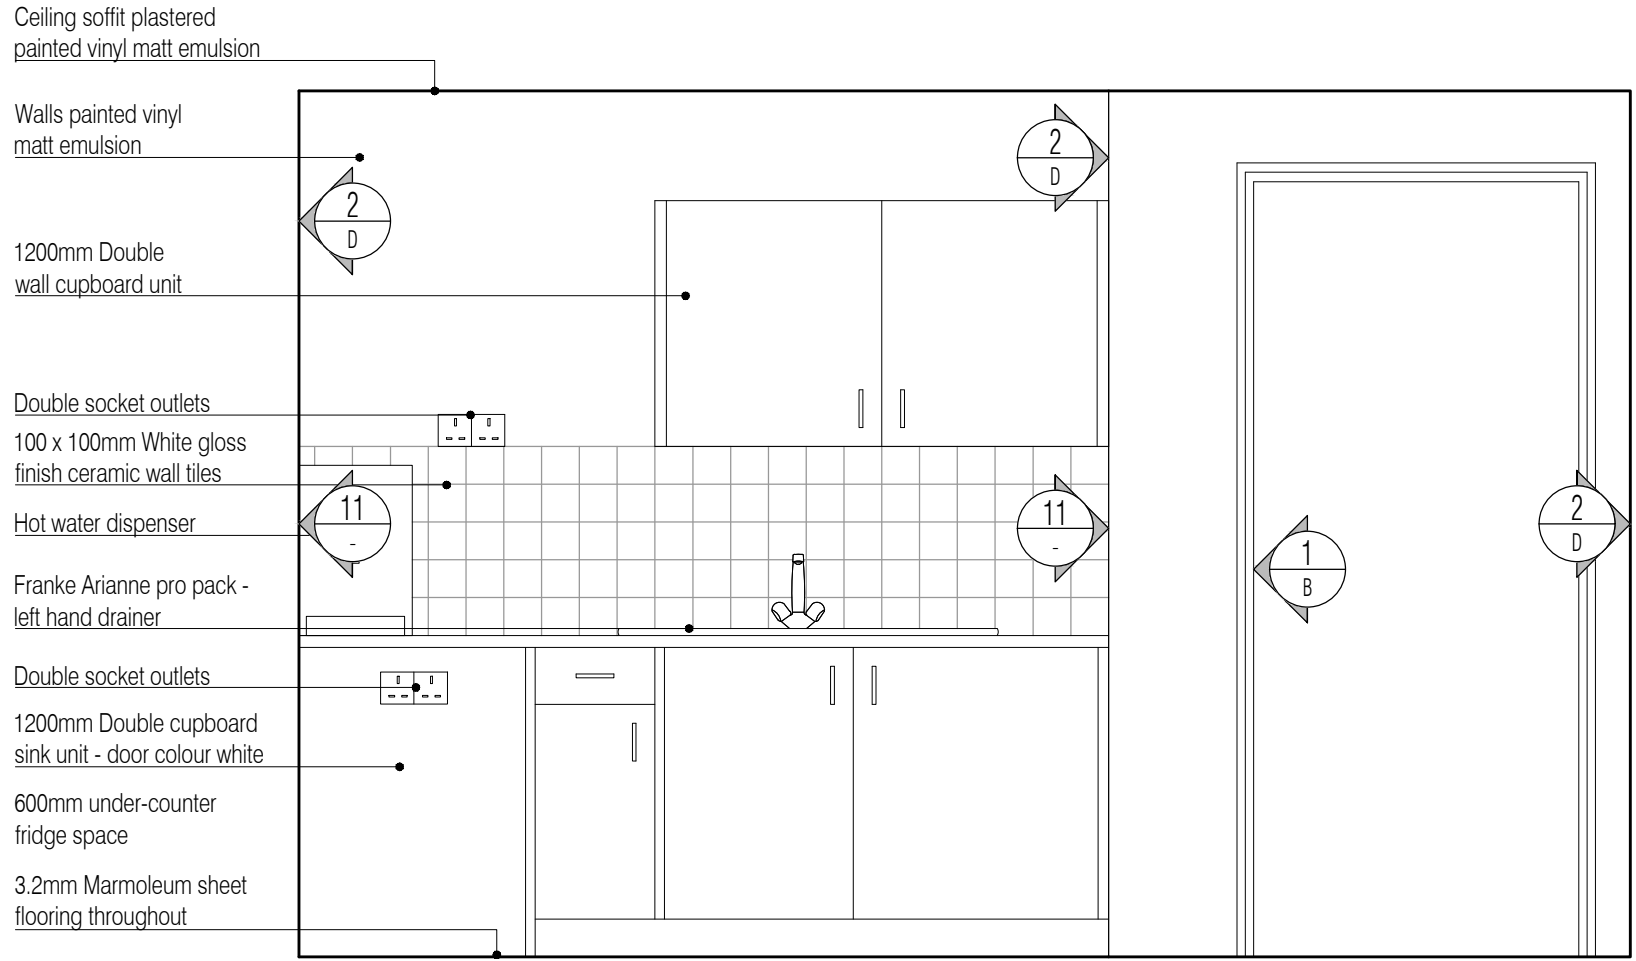

03 Elevation 04
Scale: 1:20

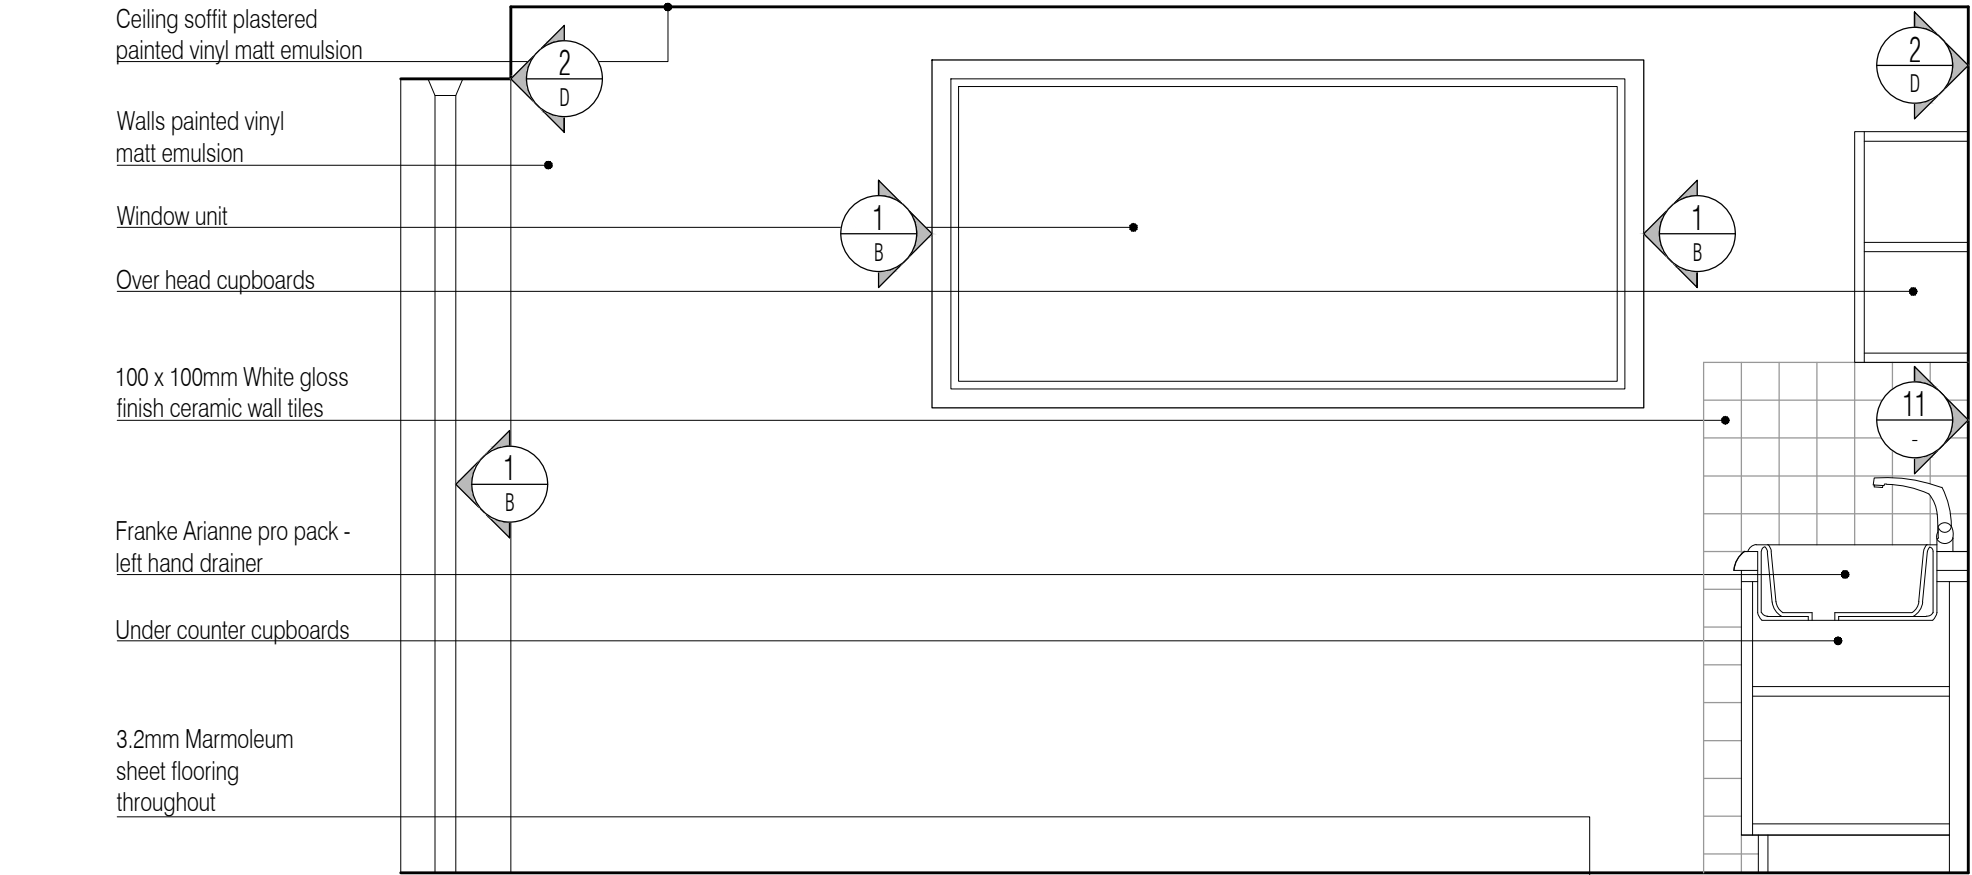


04 Elevation 03
Scale: 1:20

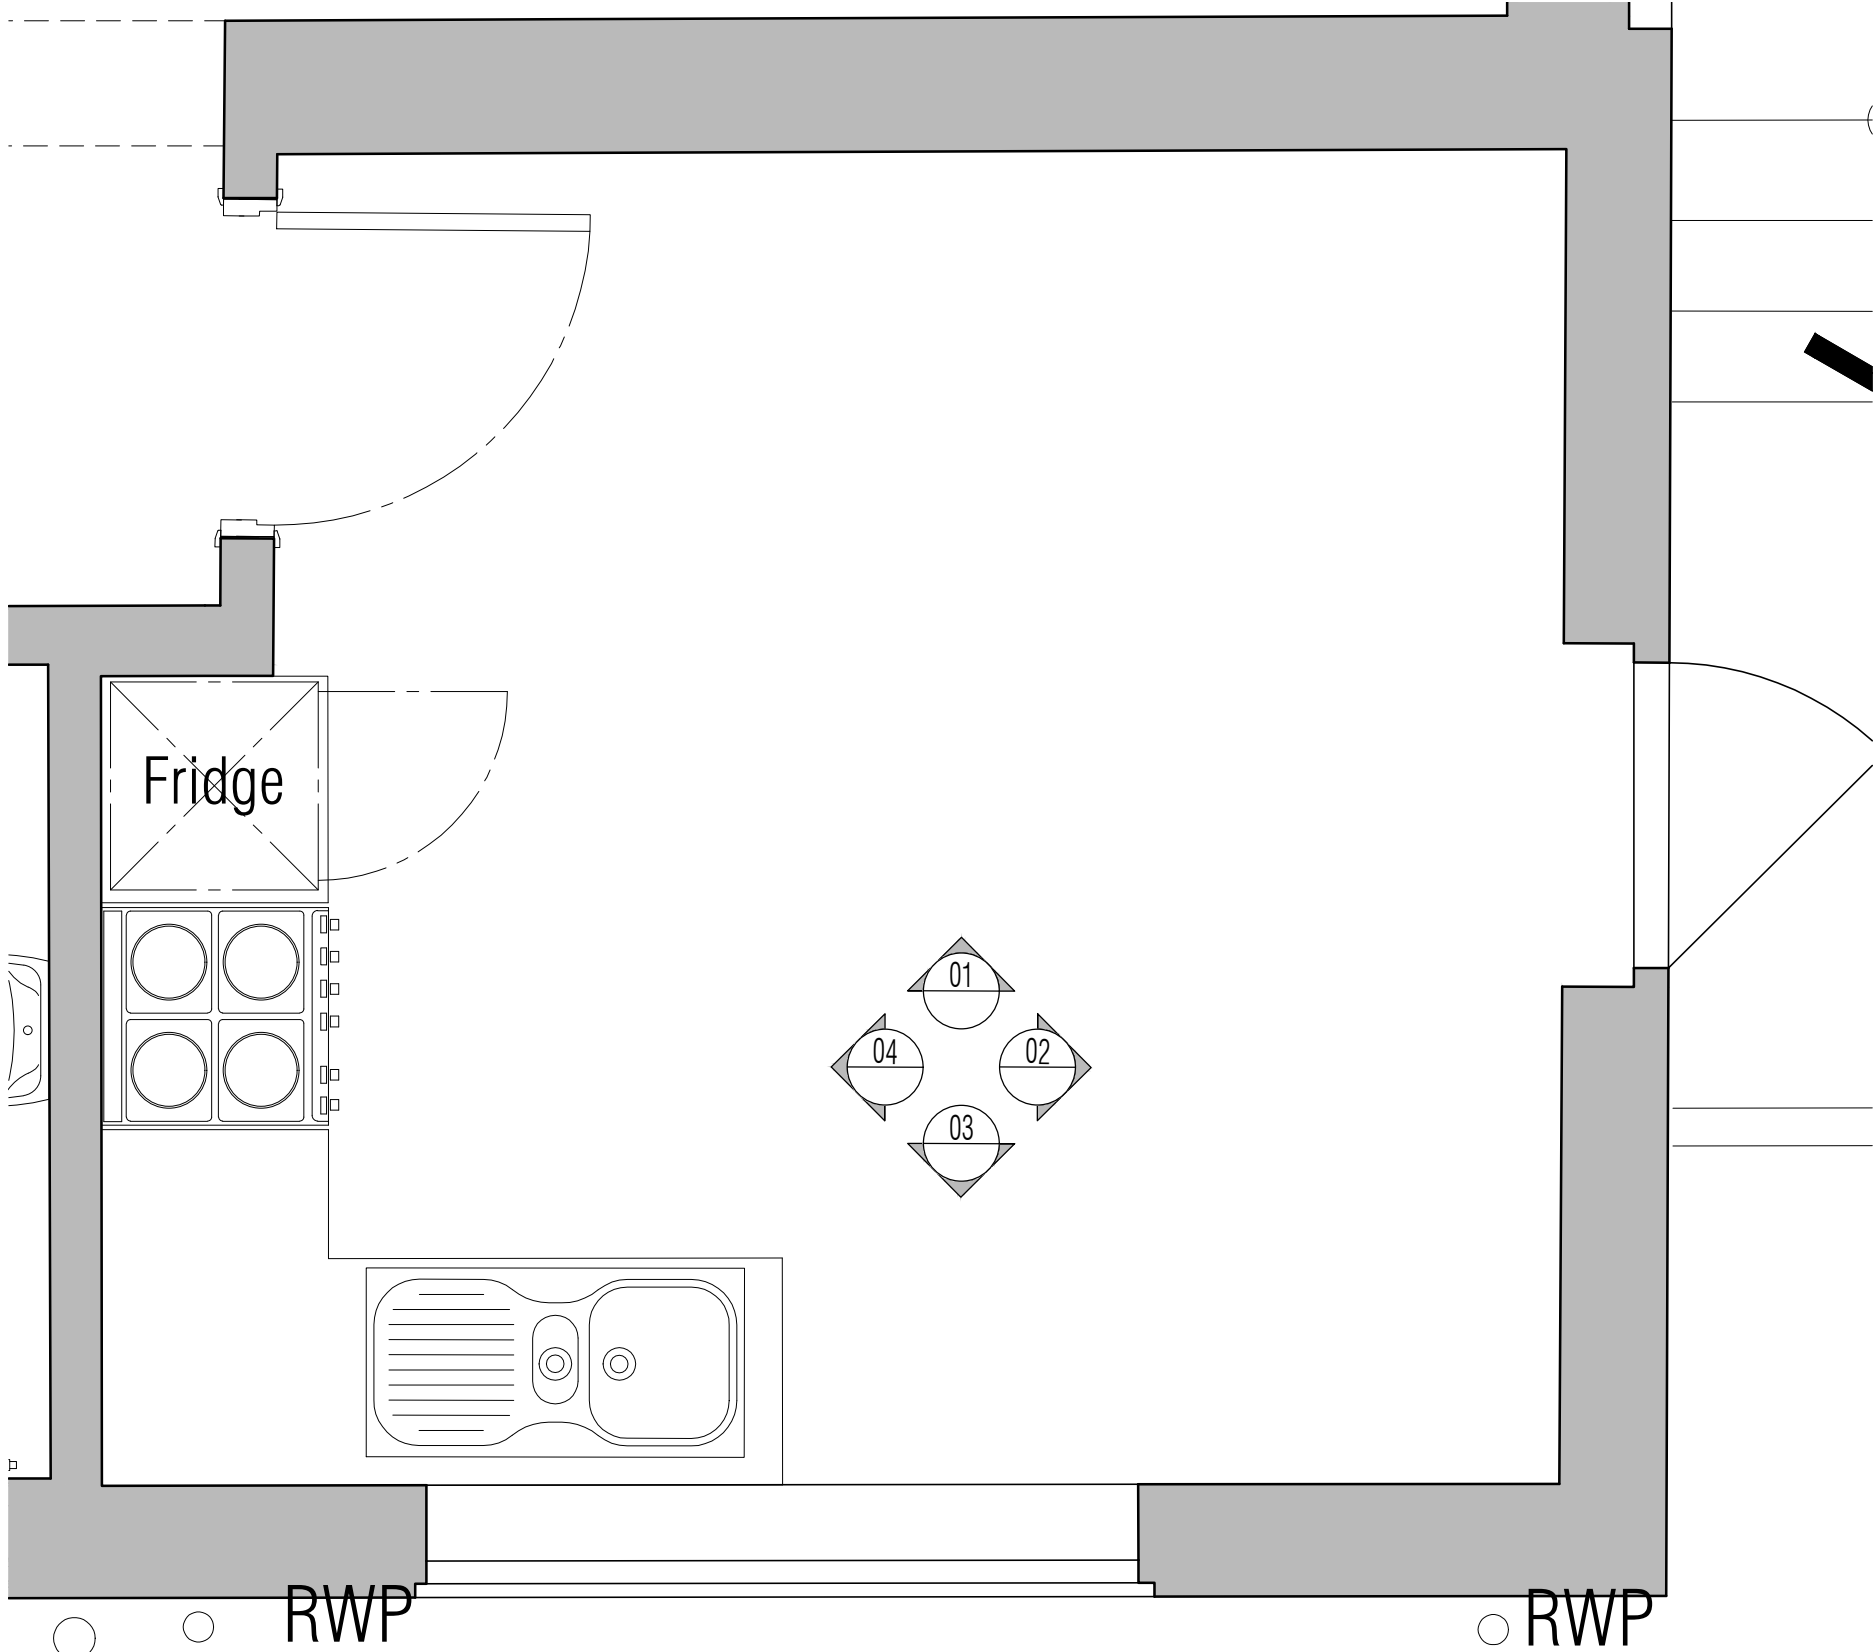

05 Plan
Scale: 1:20

NB: All information based on supplied third party survey information.
All discrepancies to be reported to FCG immediately upon discovery.

NOTES: Do not scale this drawing. All dimensions to be checked on site prior to commencement or manufacture.
Key Plan (nts)

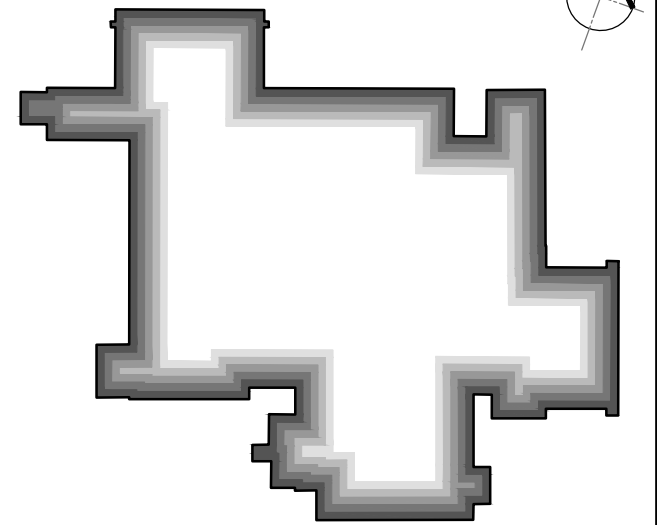

- Wall Finishes Legend
All colours to be confirmed.
- Denotes painted finish
 - Denotes painted emulsion finish with ceramic tiled splash-back.
 - Denotes ceramic tiles.
 - Denotes water based epoxy floor paint finish min 150mm from FFL. Colour: TBC.
 - Denotes make good existing finishes and re-decorate. Colour to match existing
 - Denotes timber trellace fitted between posts. Finish: TBC.
 - Denotes external wall, no works required.
 - Denotes new insulation, rails and larch T&G cladding.
 - Denotes polyester powder coated metal facings.
 - Denotes no internal finish is required.
 - Denotes white gloss finish ceramic tiles.
- A. Denotes Dulux Brilliant White Matt vinyl
B. Denotes Dulux Brilliant White gloss
C. Denotes Dulux Pale Citris Matt vinyl
D. Denotes Dulux Mellow Mocha Matt vinyl
E. Denotes Dulux Willow Tree Matt vinyl
- X denotes finish type, Z denotes colour, Arrow denotes which wall elevation finish to be applied to.

ISSUED FOR CONSTRUCTION

All details referenced in call outs supercede general arrangement or larger depictions.

Rev	Date	By	Chk	Comment
C2	16.05.12	RKC	JAS	Revs per Client comments
C1	29.03.12	RKC	JAS	Issued for CONSTRUCTION

BRINGING IDEAS TO LIFE

FRANKHAM

Frankham Consultancy Group Limited
21 Perrymount Road
Haywards Heath RH16 3TP
t 01444 444900 f 01444 455642
enquire@frankham.com
www.frankham.com

Client

Mansell
Contract N°: MC0269

Project Title

Eastbourne & Worthing
Crematoria
Refurbishments and Alterations

Drawing Title


EASTBOURNE
Eastbourne Crematorium
Ground Floor Room Elevations
Kitchenette & Staff Room

Drawn by: RKC	Scale: 1:20@A1	Date: 07.02.12
Designed by: FCG	Checked by: JAS	Approved by: AC


File Ref.: X:\FRANKHAM\2_080512\210 CREMATORIA\ARCH\006-300-01\000001.DWG - 200611121646 20.06.11 12:16:46

Drawing No. 521260-A-322-E	Rev. C2
-------------------------------	------------




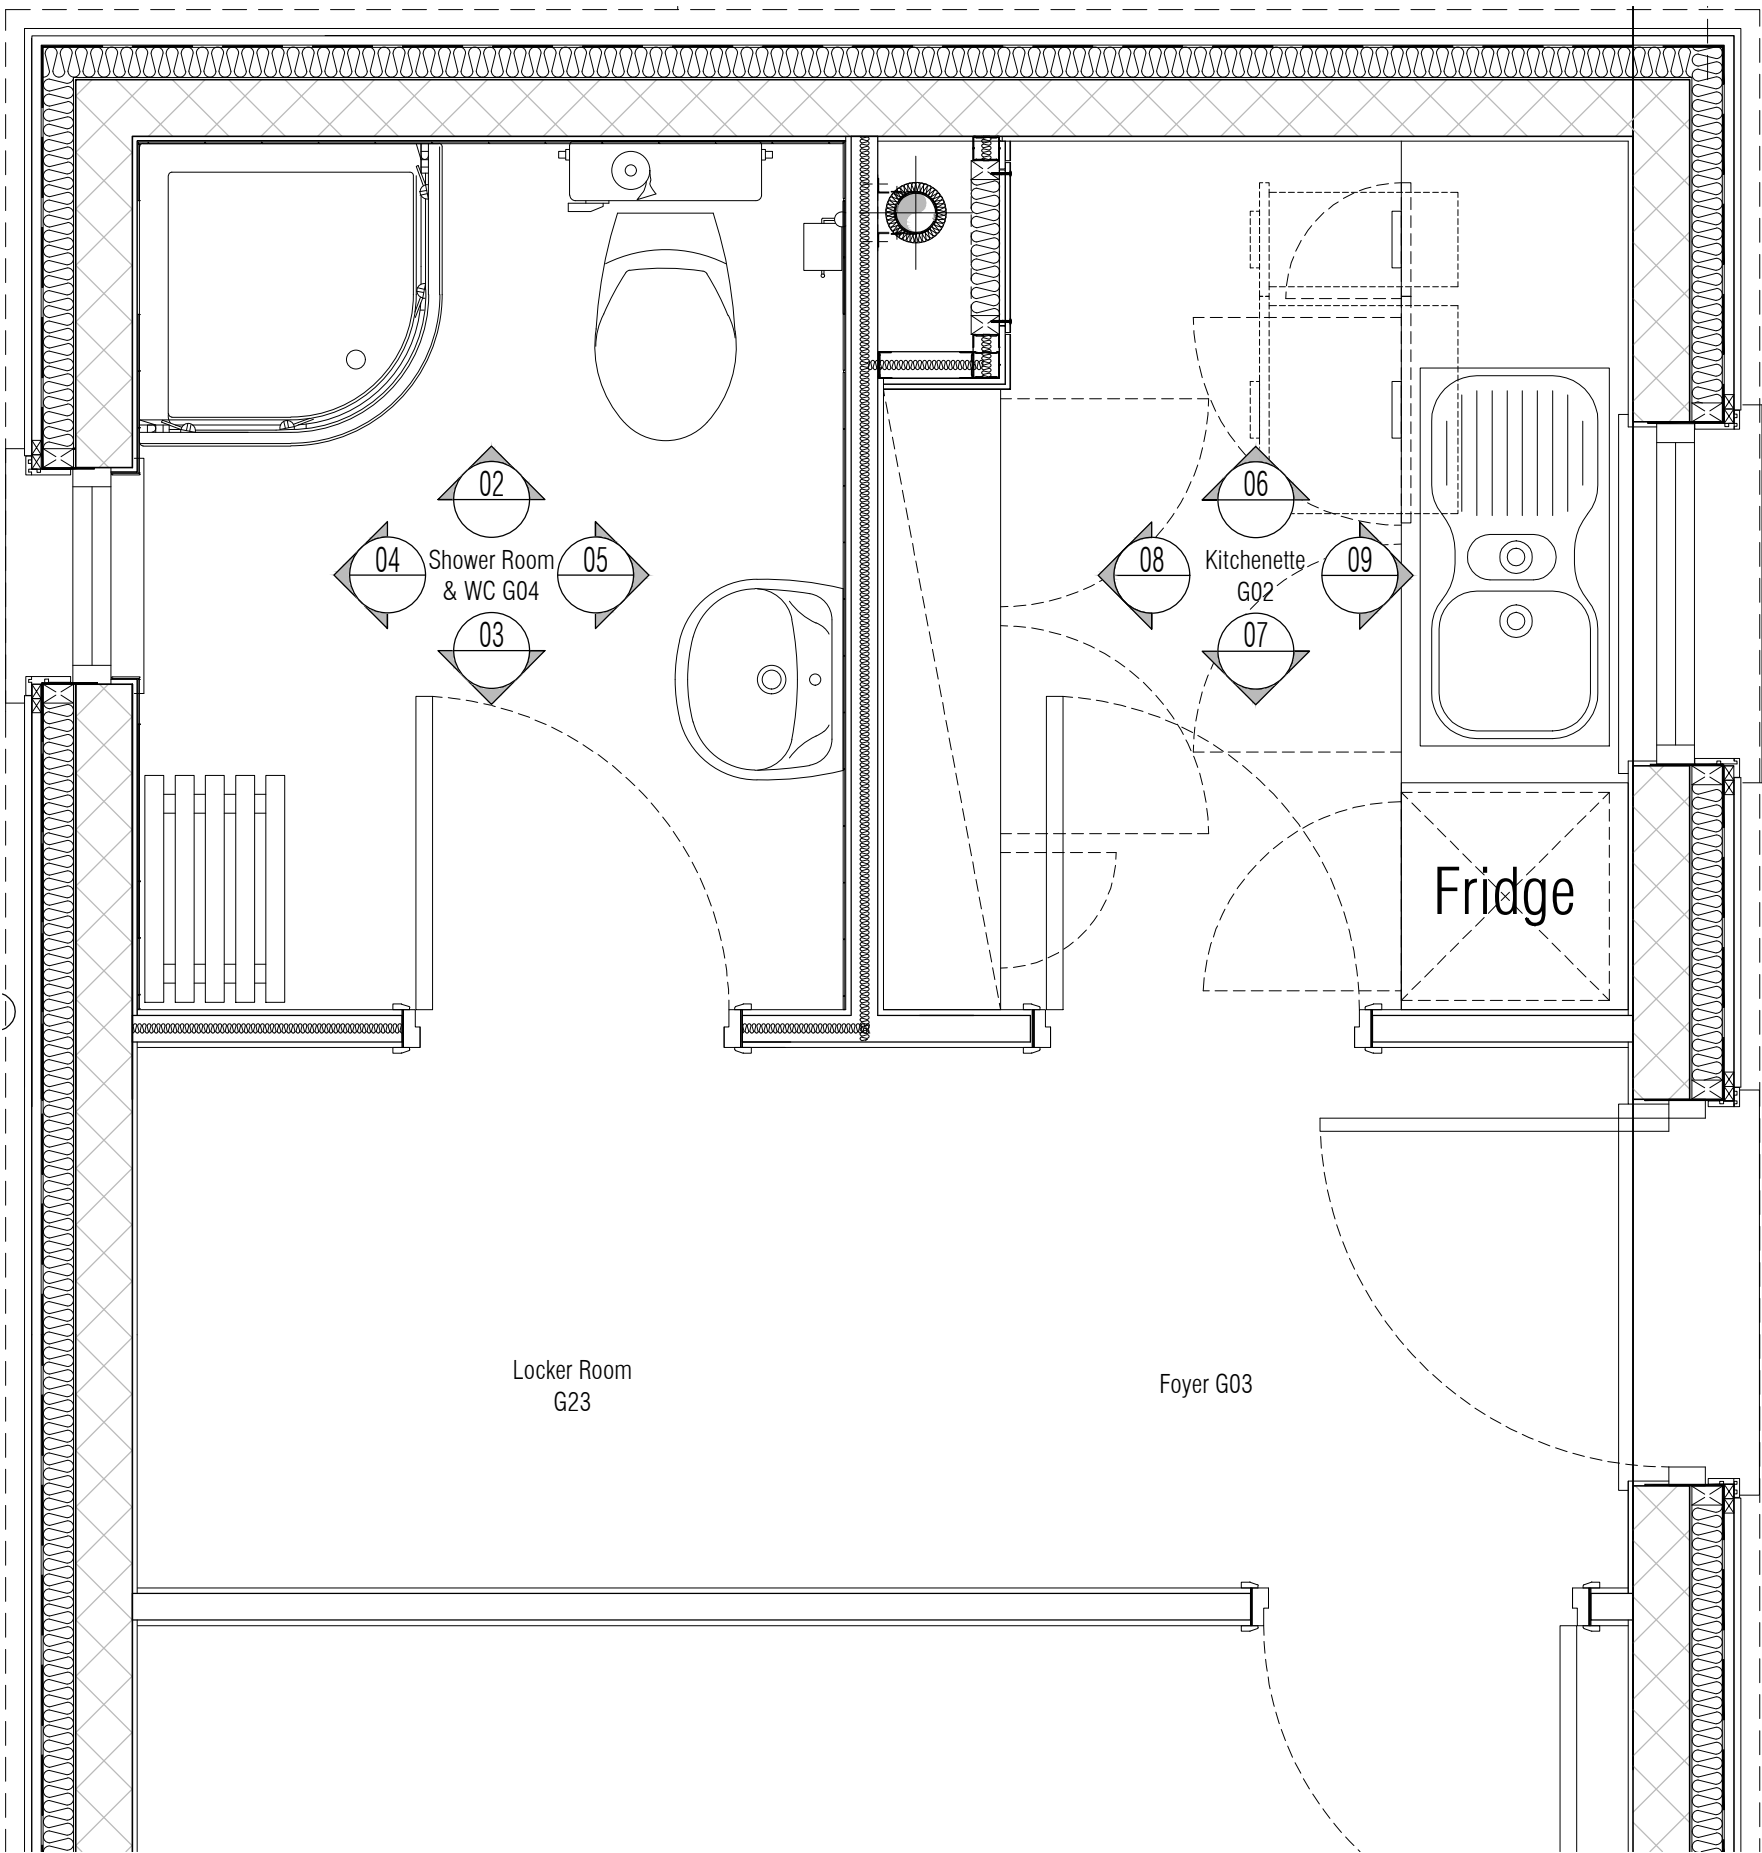

01 Ground Floor Staff Facilities Plan
Scale: 1:20

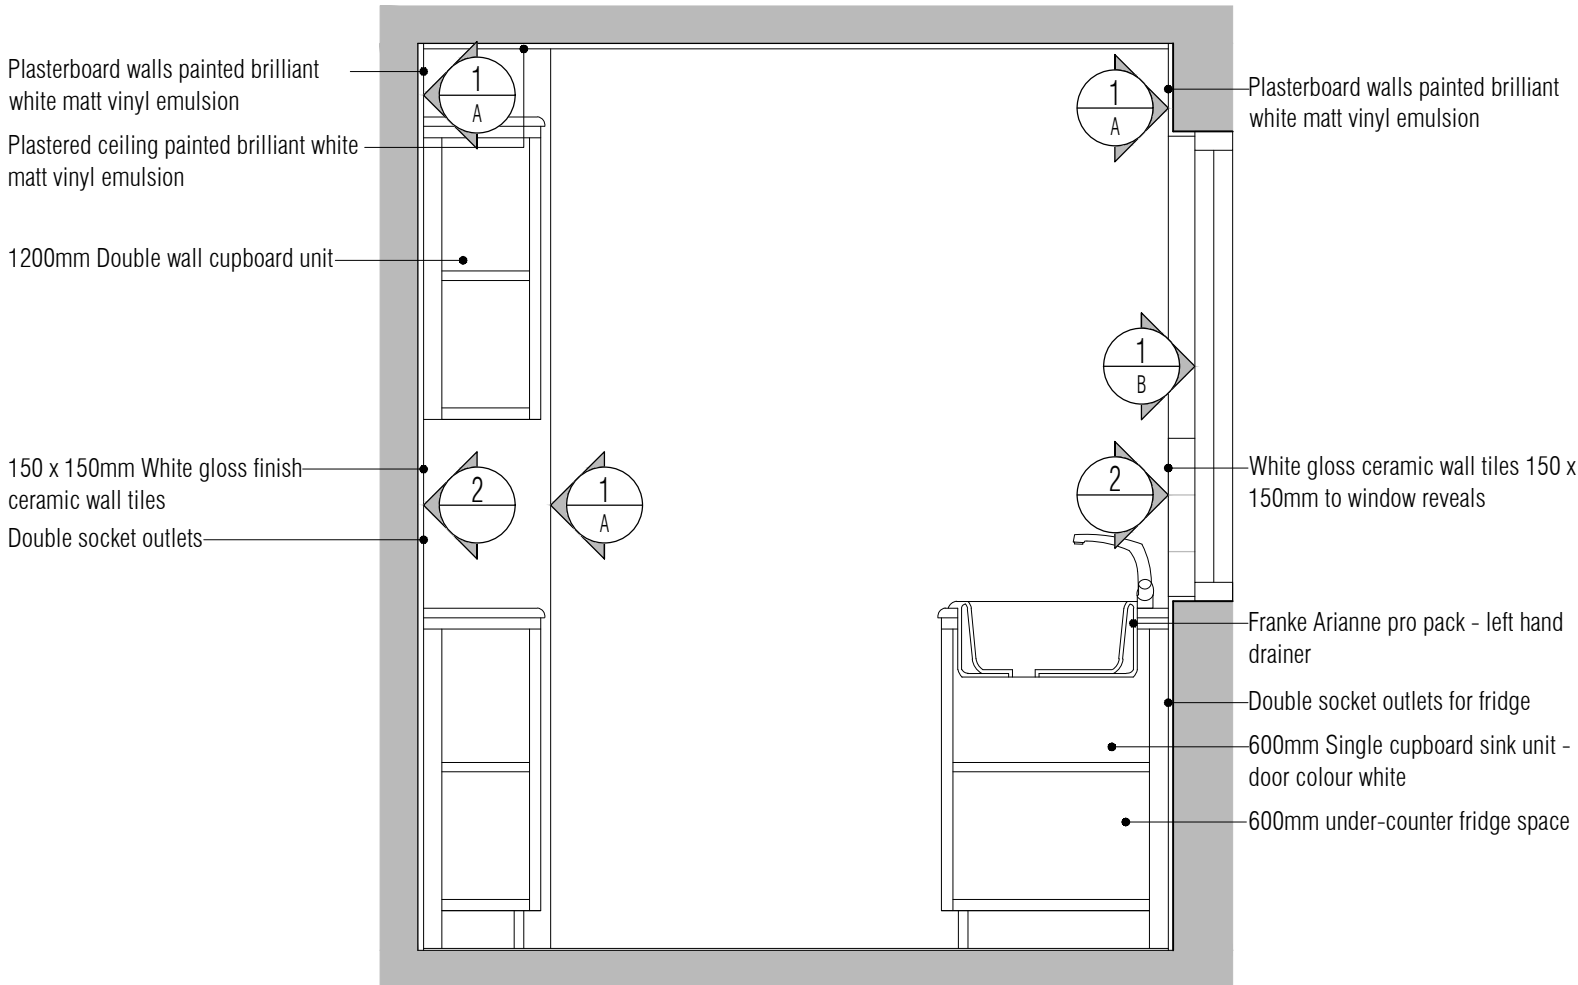


02 Elevation 02
Scale: 1:20

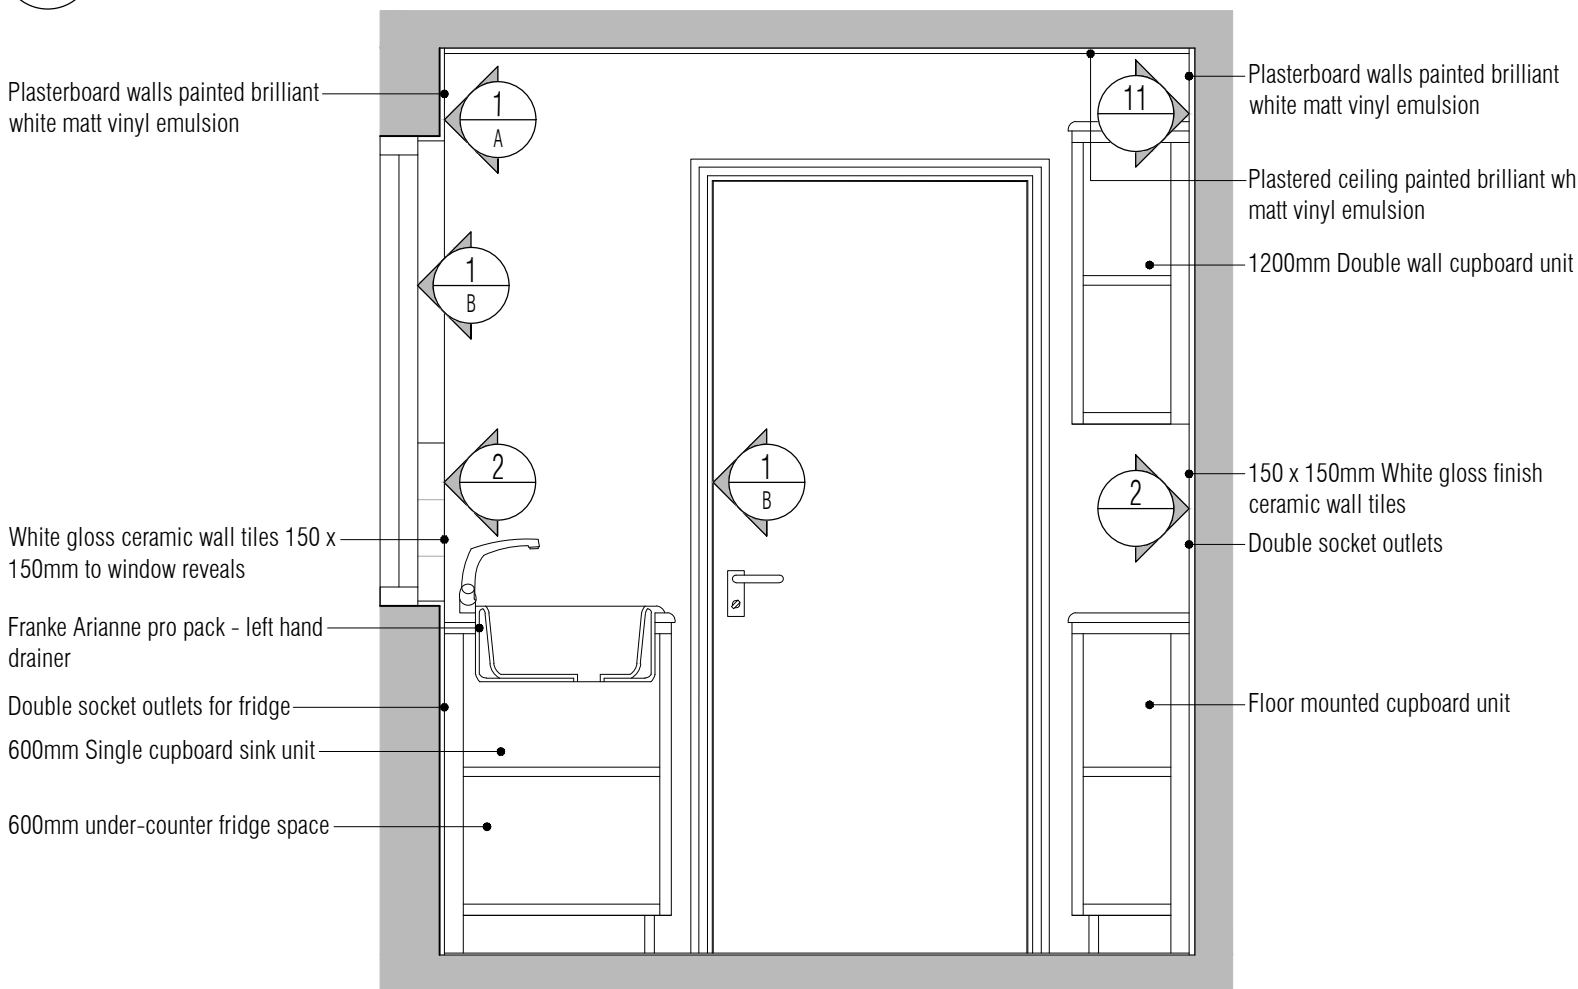


03 Elevation 03
Scale: 1:20


NB: All information based on supplied third party survey information.
All discrepancies to be reported to FCG immediately upon discovery.

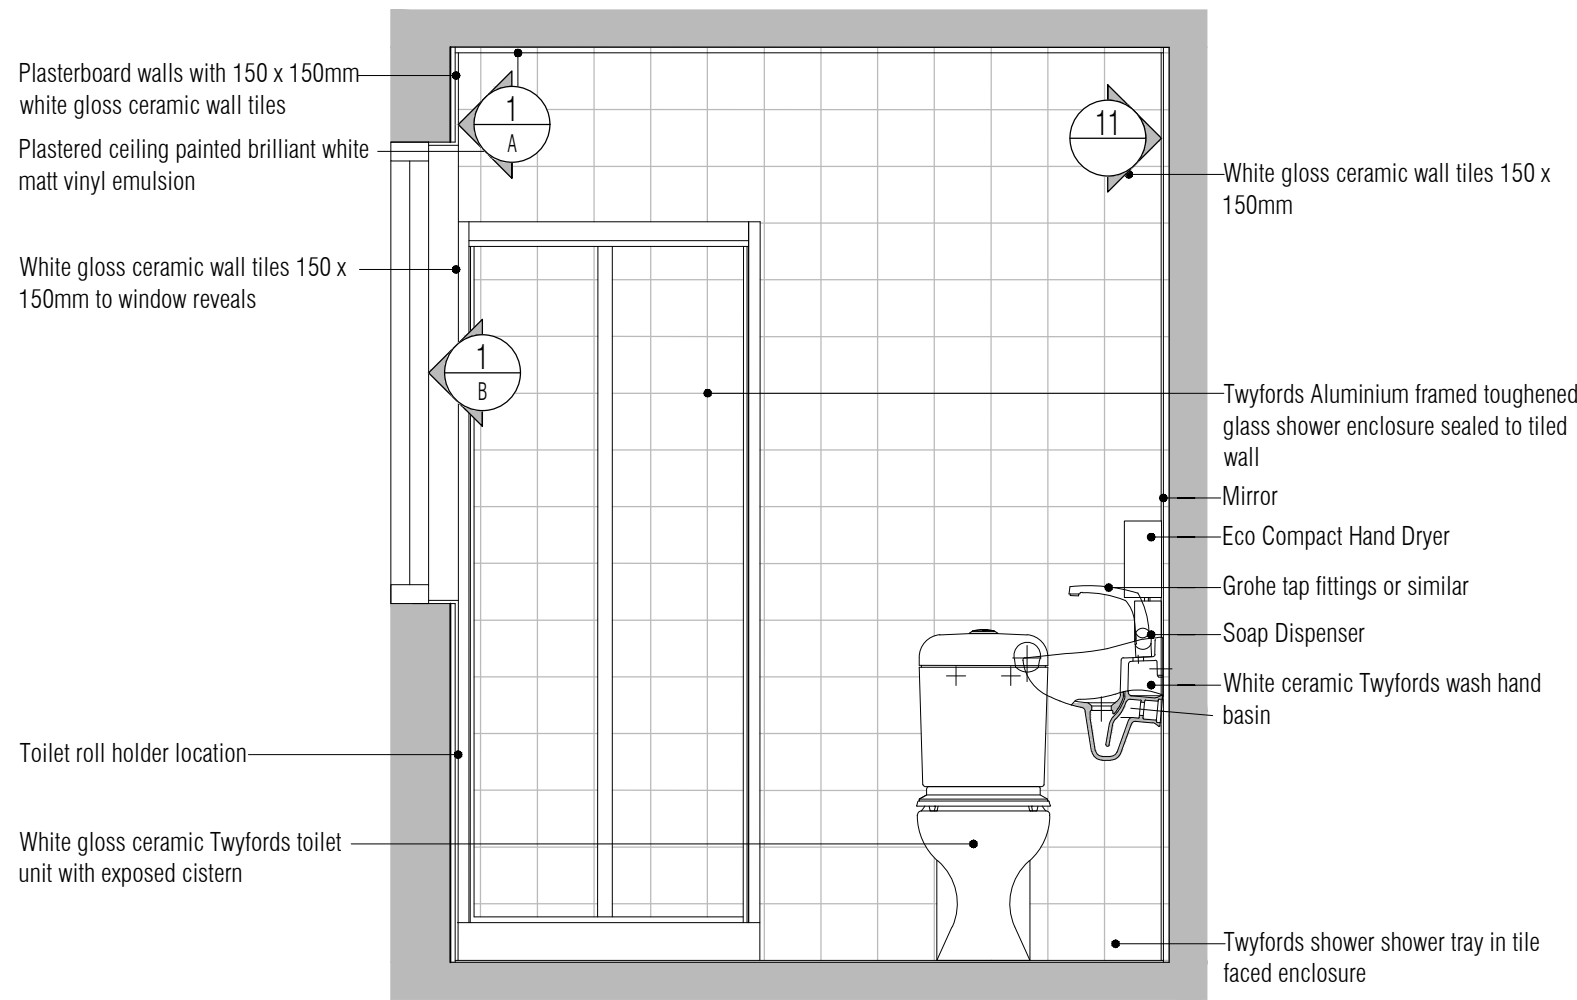


04 Elevation 04
Scale: 1:20

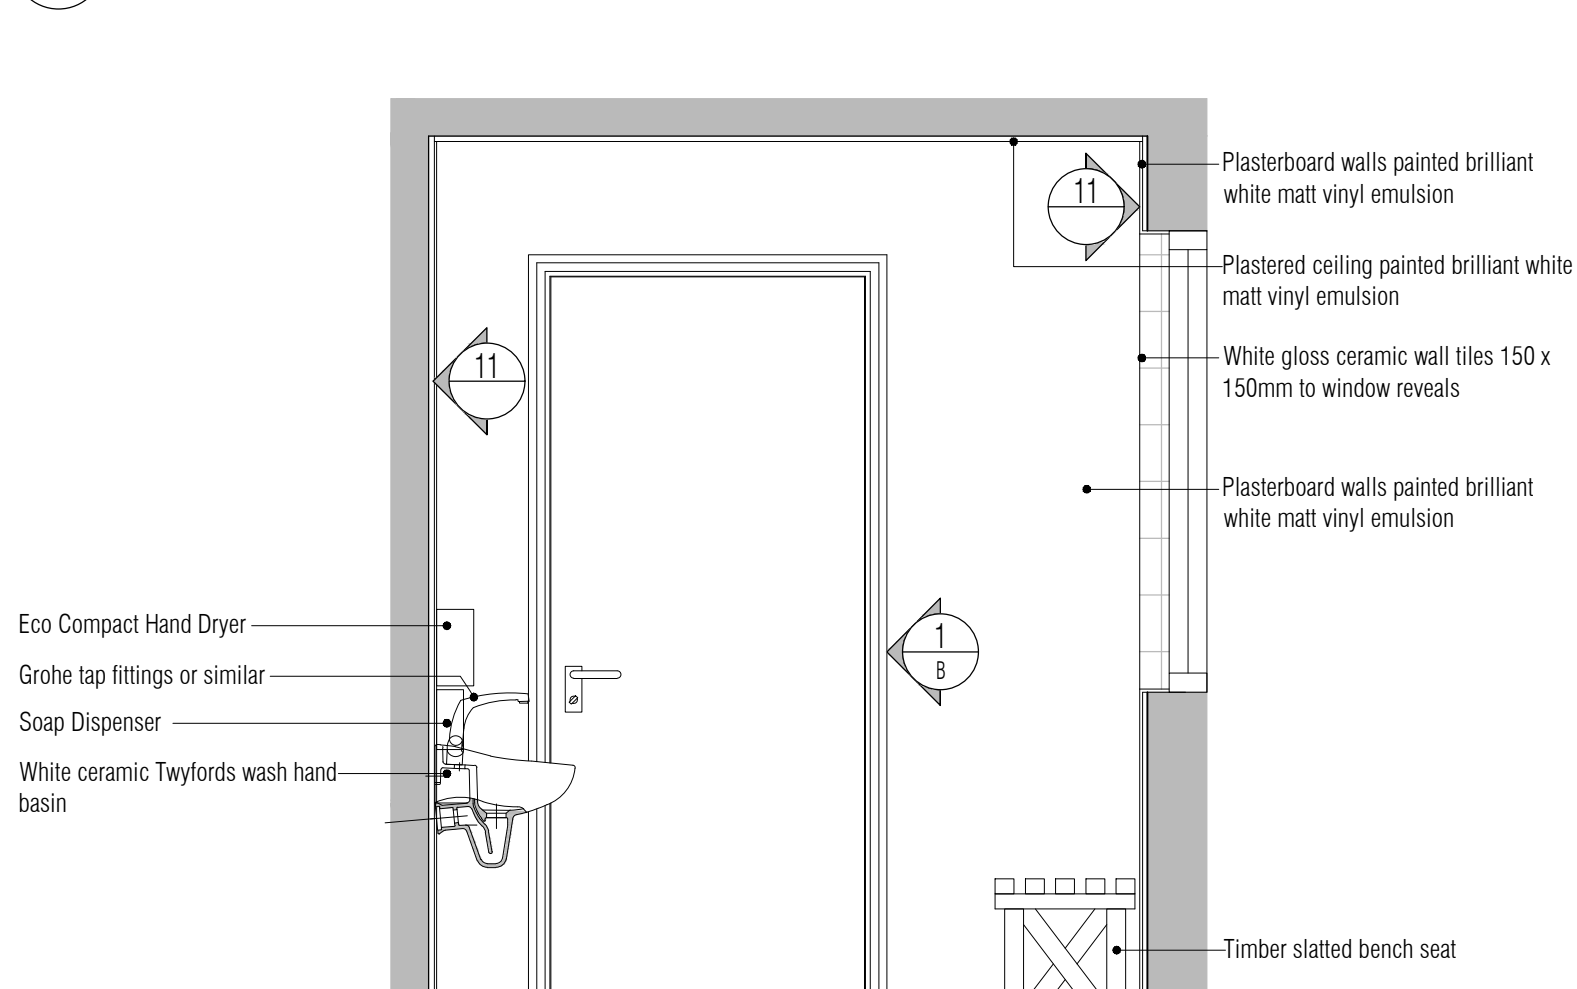


05 Elevation 05
Scale: 1:20

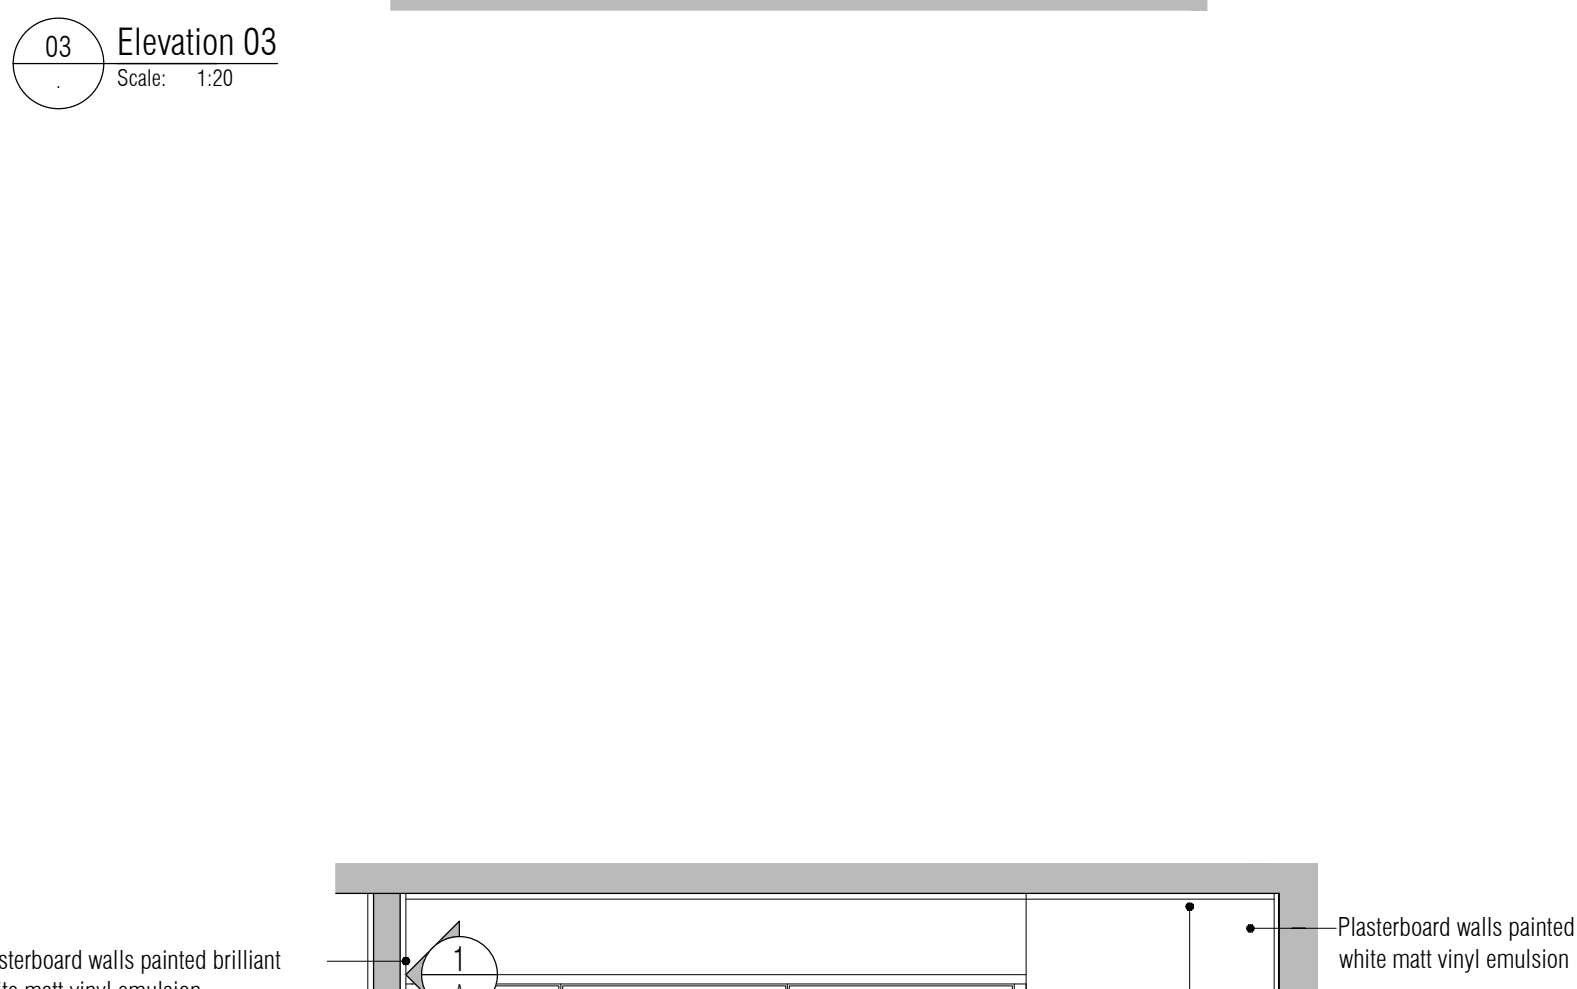


06 Elevation 06
Scale: 1:20

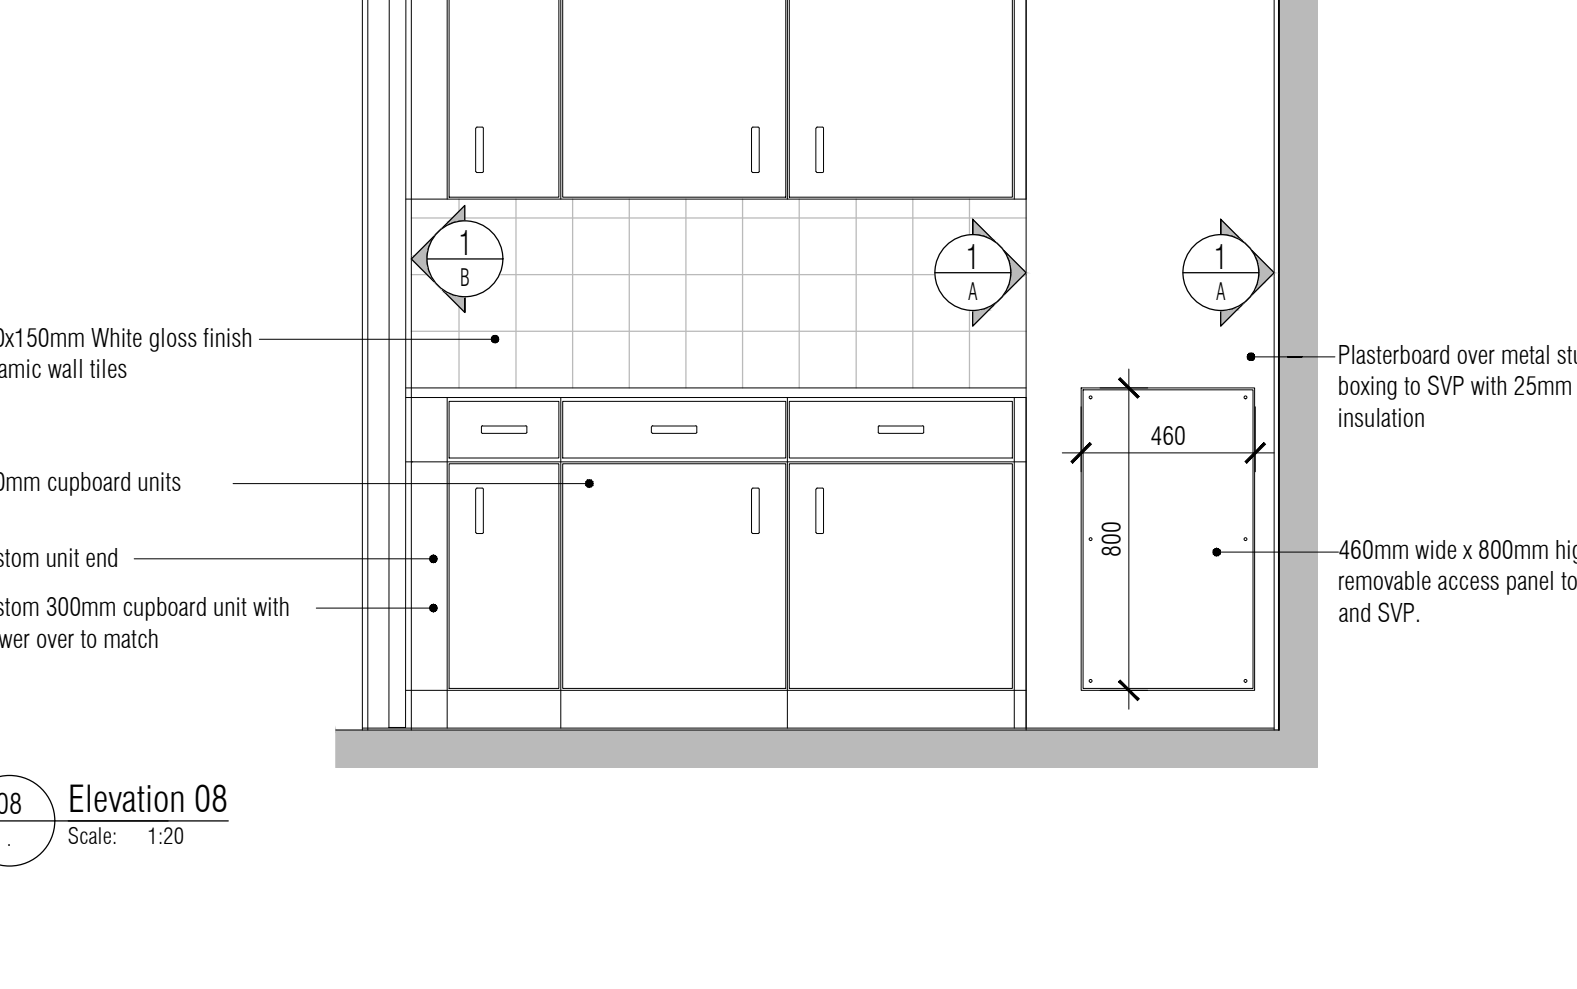


07 Elevation 07
Scale: 1:20

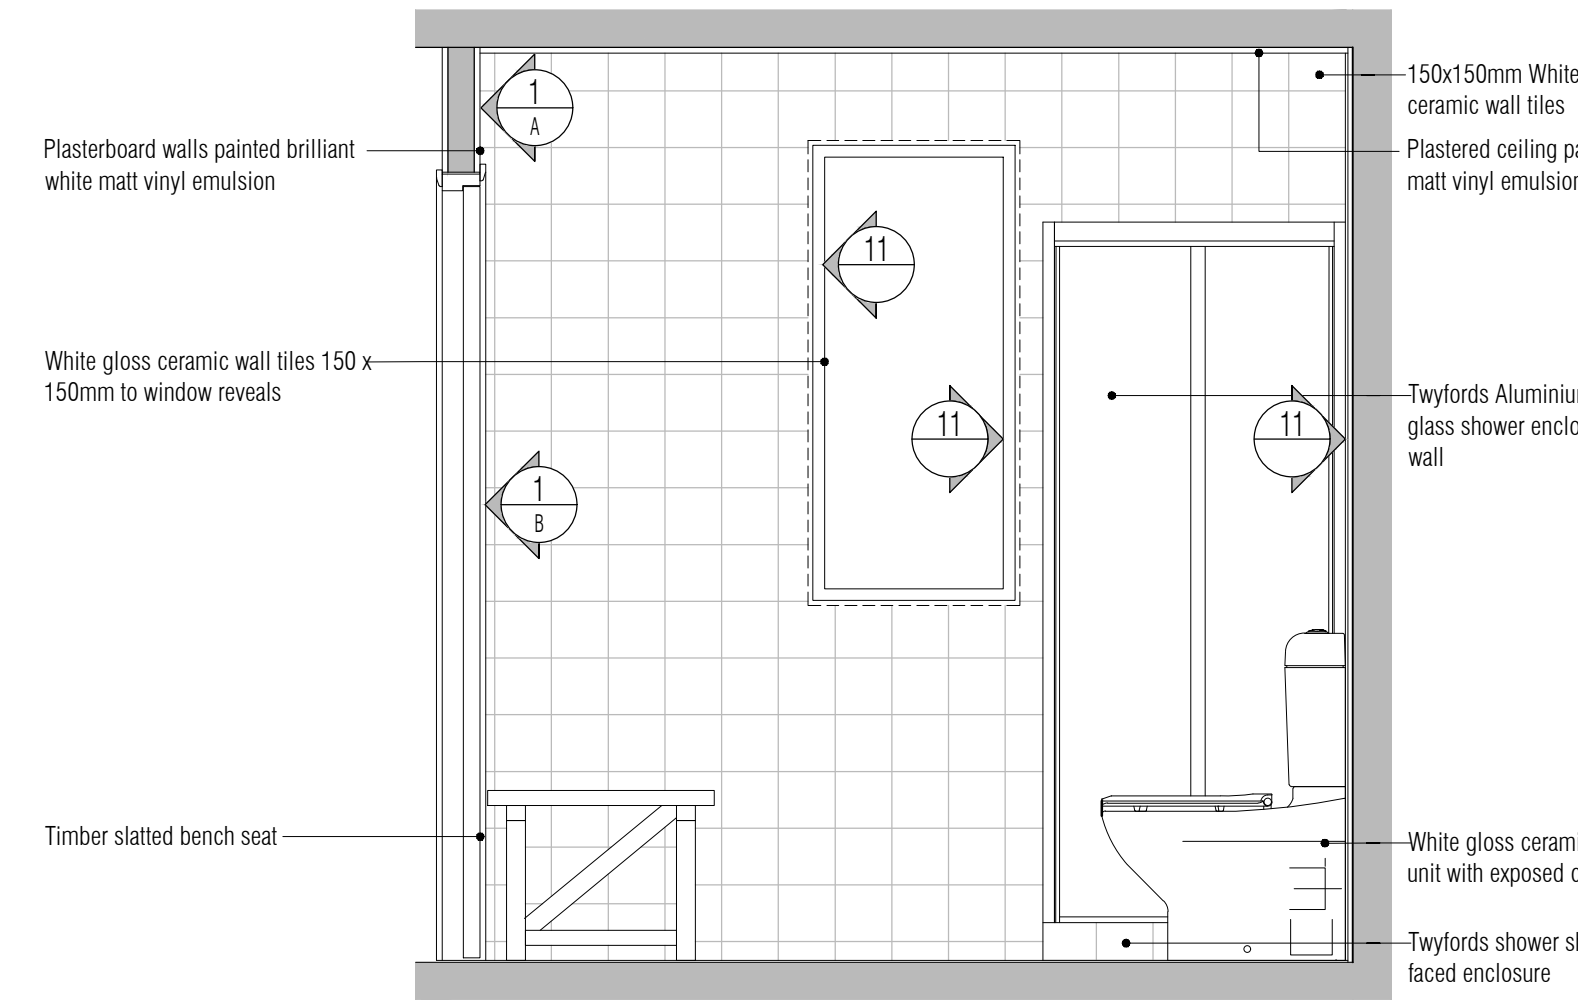


08 Elevation 08
Scale: 1:20

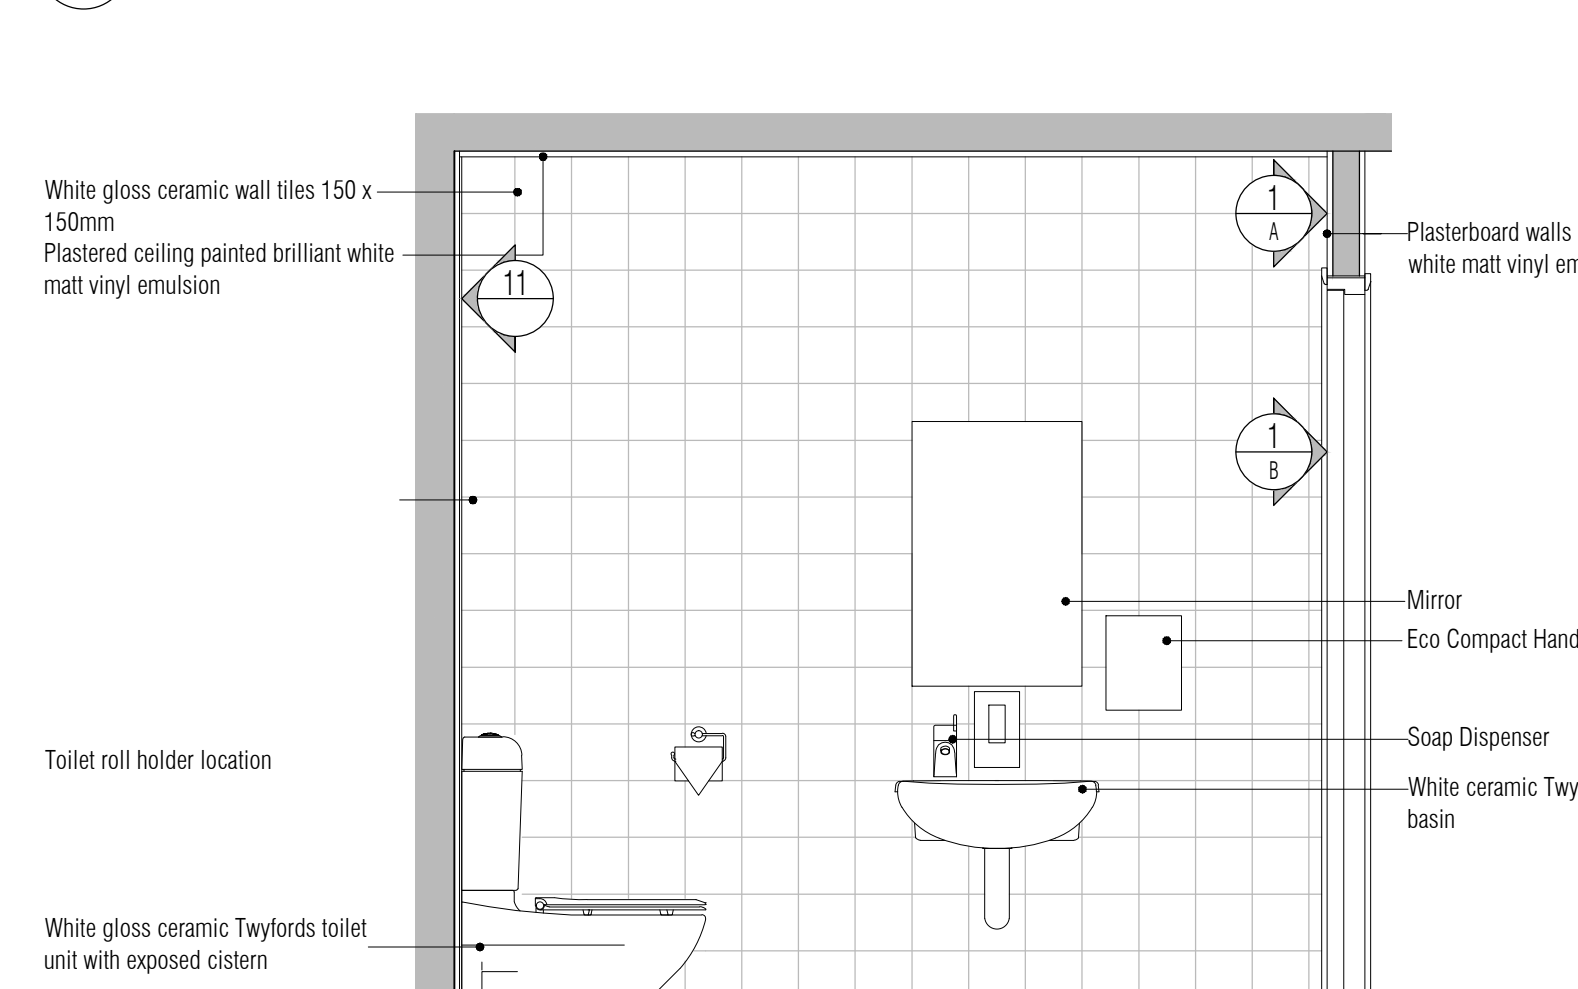

09 Elevation 09
Scale: 1:20

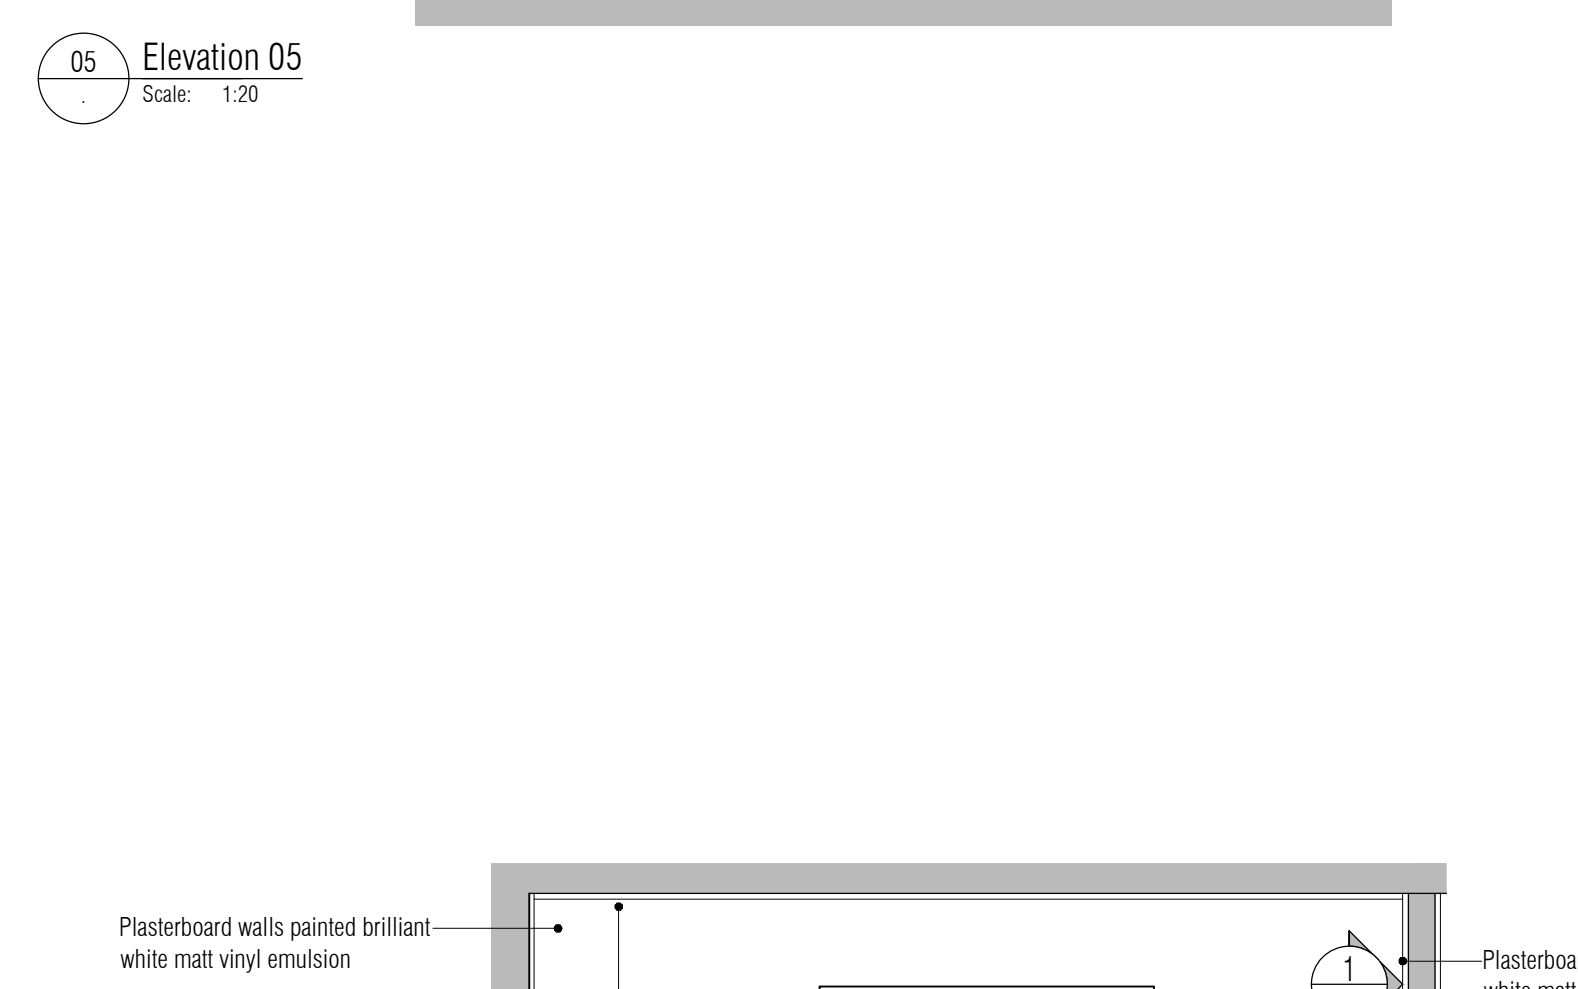


10 Elevation 10
Scale: 1:20

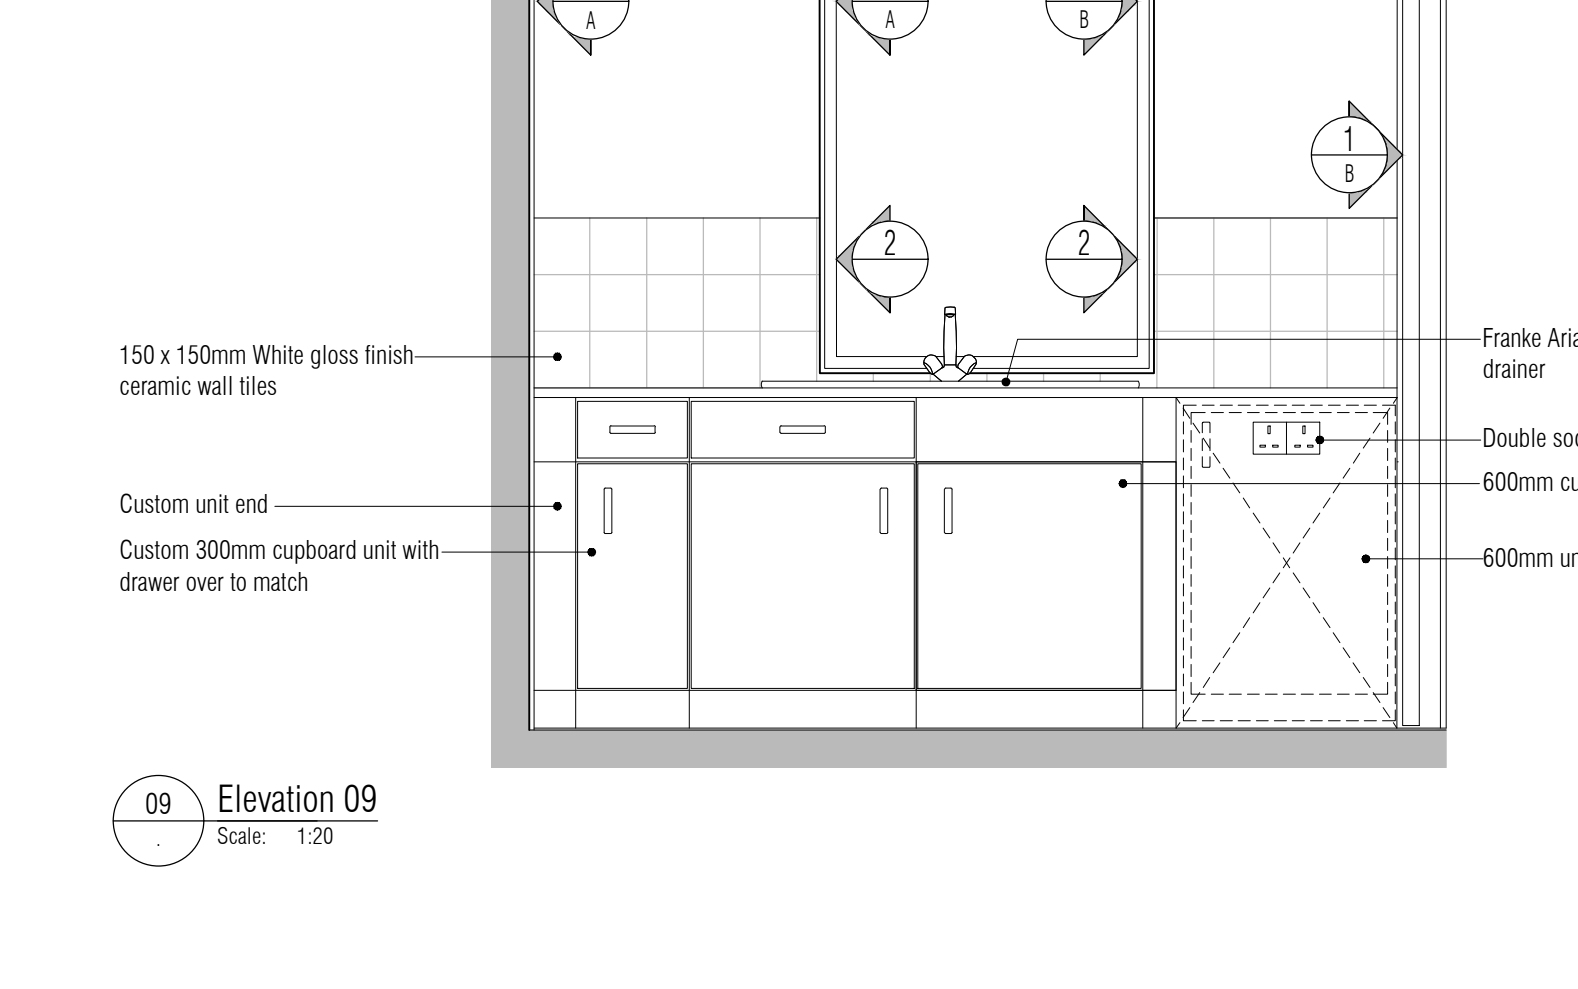

11 Elevation 11
Scale: 1:20

NOTES: Do not scale this drawing. All dimensions to be checked on site prior to commencement or manufacture.
Key Plan (nts)

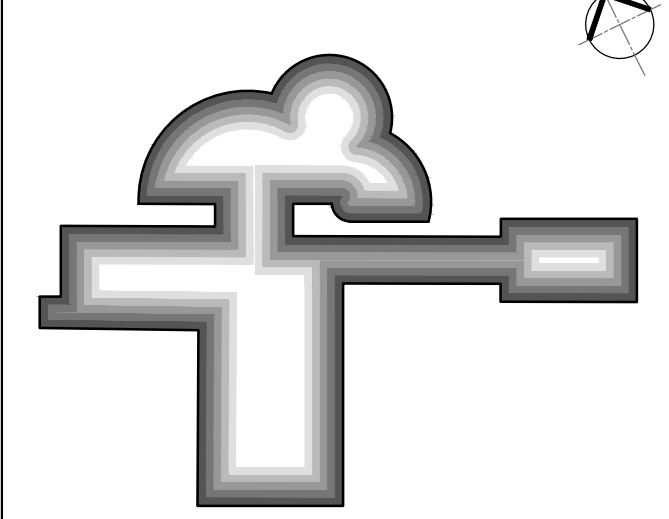

- Wall Finishes Legend
All colours to be confirmed.
- Denotes painted finish
 - Denotes painted emulsion finish with ceramic tiled splash-back.
 - Denotes ceramic tiles.
 - Denotes water based epoxy floor paint finish min 150mm from FFL. Colour: TBC.
 - Denotes make good existing finishes and re-decorate. Colour to match existing
 - Denotes timber trellace fitted between posts. Finish: TBC.
 - Denotes external wall, no works required.
 - Denotes new insulation, rails and larch T&G cladding.
 - Denotes polyester powder coated metal facings.
 - Denotes no internal finish is required.
 - Denotes white gloss finish ceramic tiles.
- A. Denotes Dulux Brilliant White Matt vinyl
B. Denotes Dulux Brilliant White gloss
C. Denotes Dulux Pale Citris Matt vinyl
D. Denotes Dulux Mellow Mocha Matt vinyl
E. Denotes Dulux Willow Tree Matt vinyl
- X denotes finish type, Z denotes colour, Arrow denotes which wall elevation finish to be applied to.

ISSUED FOR CONSTRUCTION

All details referenced in call outs supercode general arrangement or larger depictions.

Rev	Date	By	Chk	Comment
C1	09.07.12	RKC	JAS	Issued for CONSTRUCTION

BRINGING IDEAS TO LIFE

FRANKHAM

Frankham Consultancy Group Limited
21 Perryman Road
Haywards Heath RH16 3TP
t 01444 444900 f 01444 455642
enquiries@frankham.com
www.frankham.com

Client: Mansell
Contract N°: Worthing

Project Title: Eastbourne & Worthing Crematoria Refurbishments and Alterations

Drawing Title: Worthing Crematorium Ground Floor Internal Elevations Shower Room


Drawn by: RKC	Scale: 1:20@A1	Date: 09.02.12
Designed by: FCG	Checked by: JAS	Approved by: AC

File Ref.: 521260-A-330-W-0001-121653 20.06.11 12:16:53


Drawing No. 521260-A-330-W	Rev. C1
----------------------------	---------

NOTES: Do not scale this drawing. All dimensions to be checked on site prior to commencement or manufacture.


All Disabled and Ambulant Disabled facilities to comply with Approved Document Part M - Access to and use of buildings*, Disability Discrimination Act 1995 and BS83000 as required

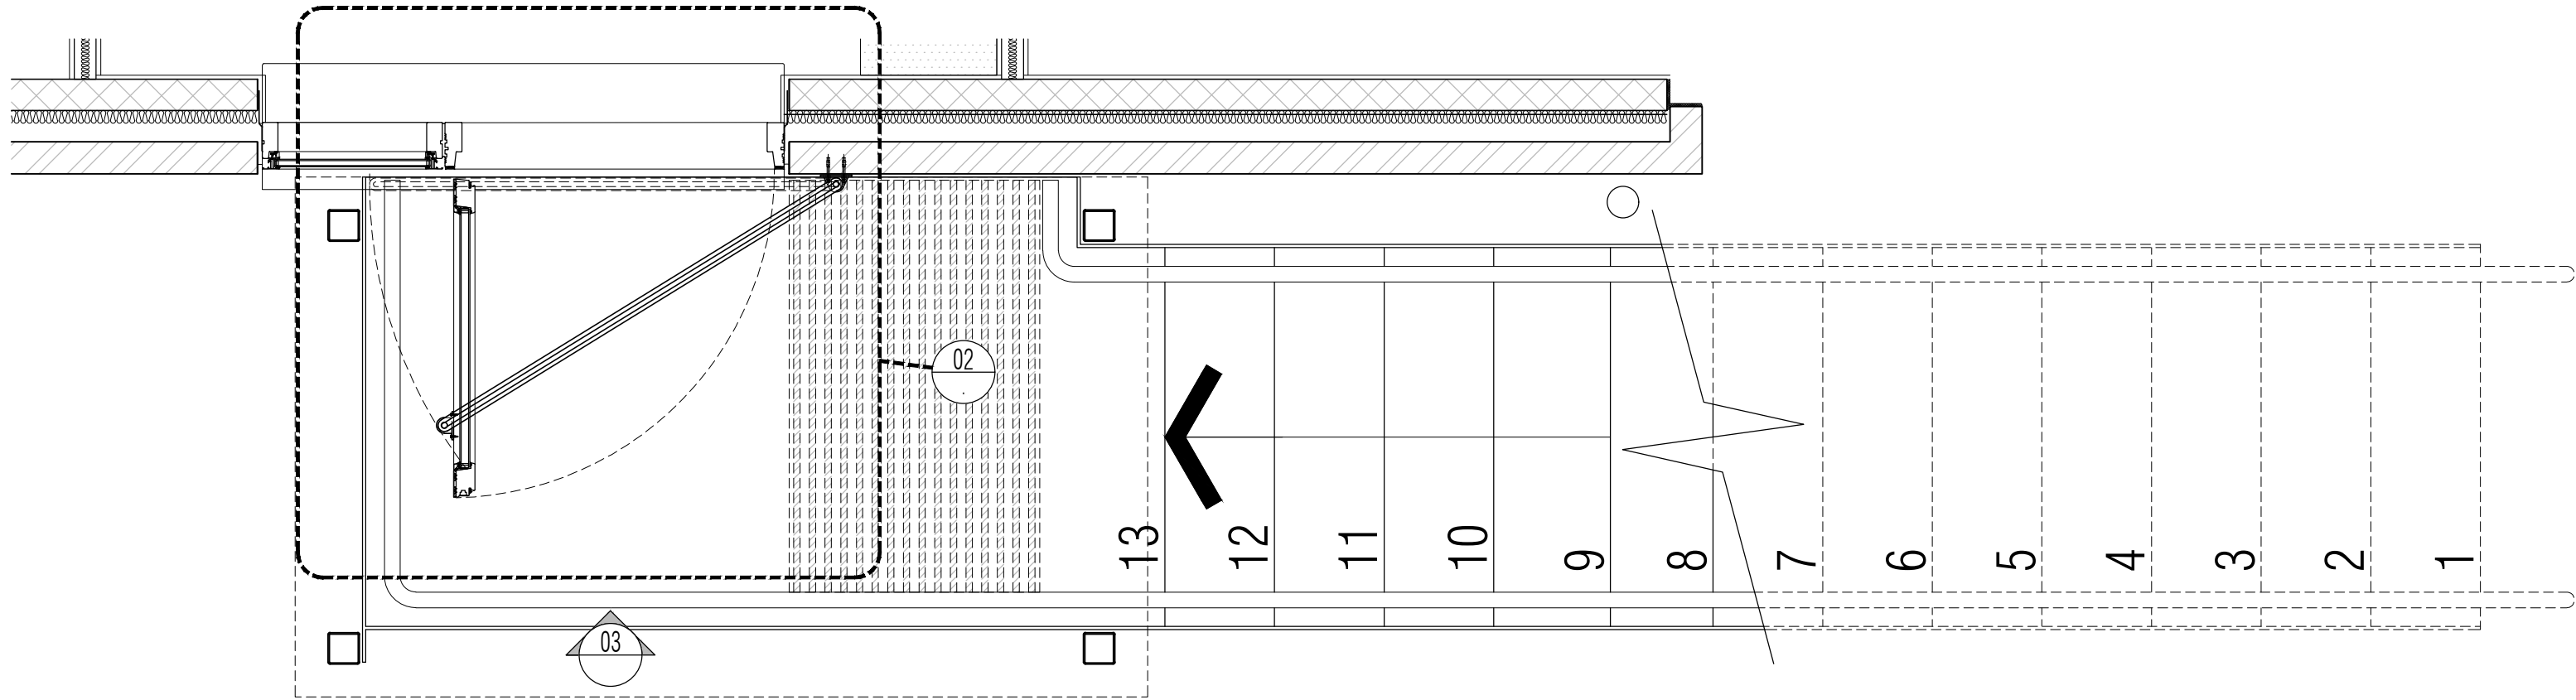


01 Ground Floor Metal Stair Arrangement Plan
Scale: 1:20

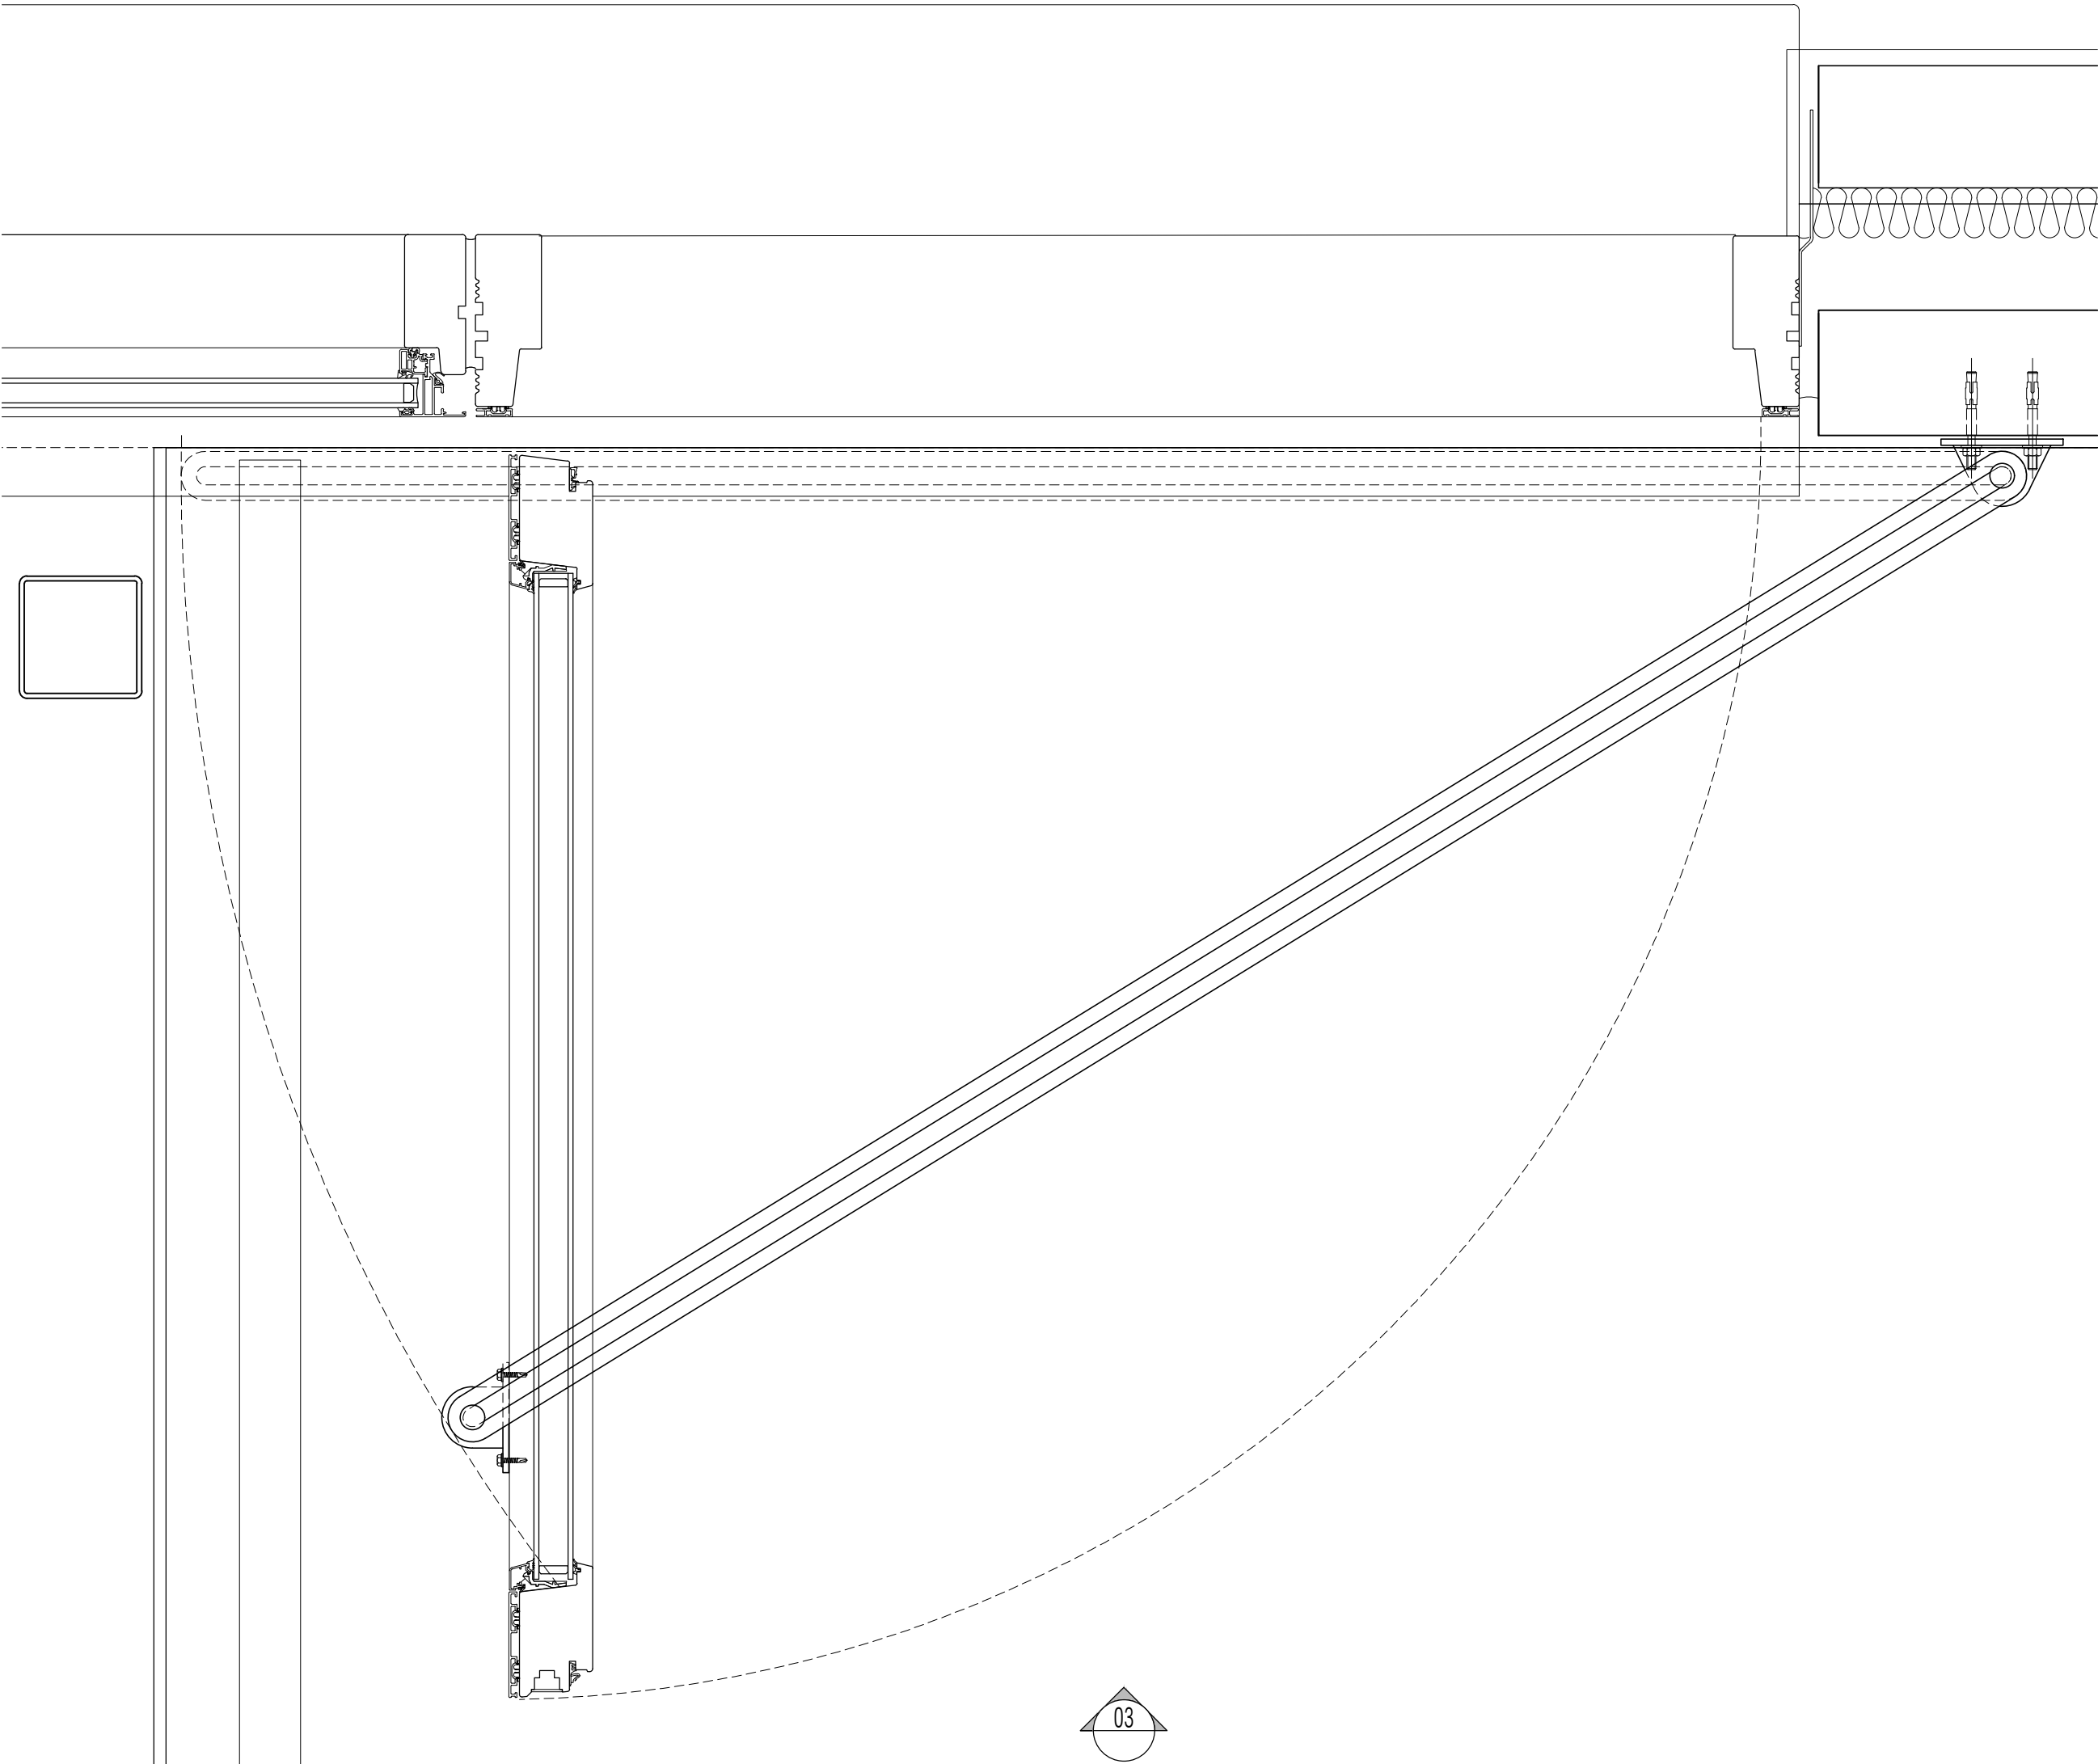

02 Door Head Stop Arm Plan
Scale: 1:5

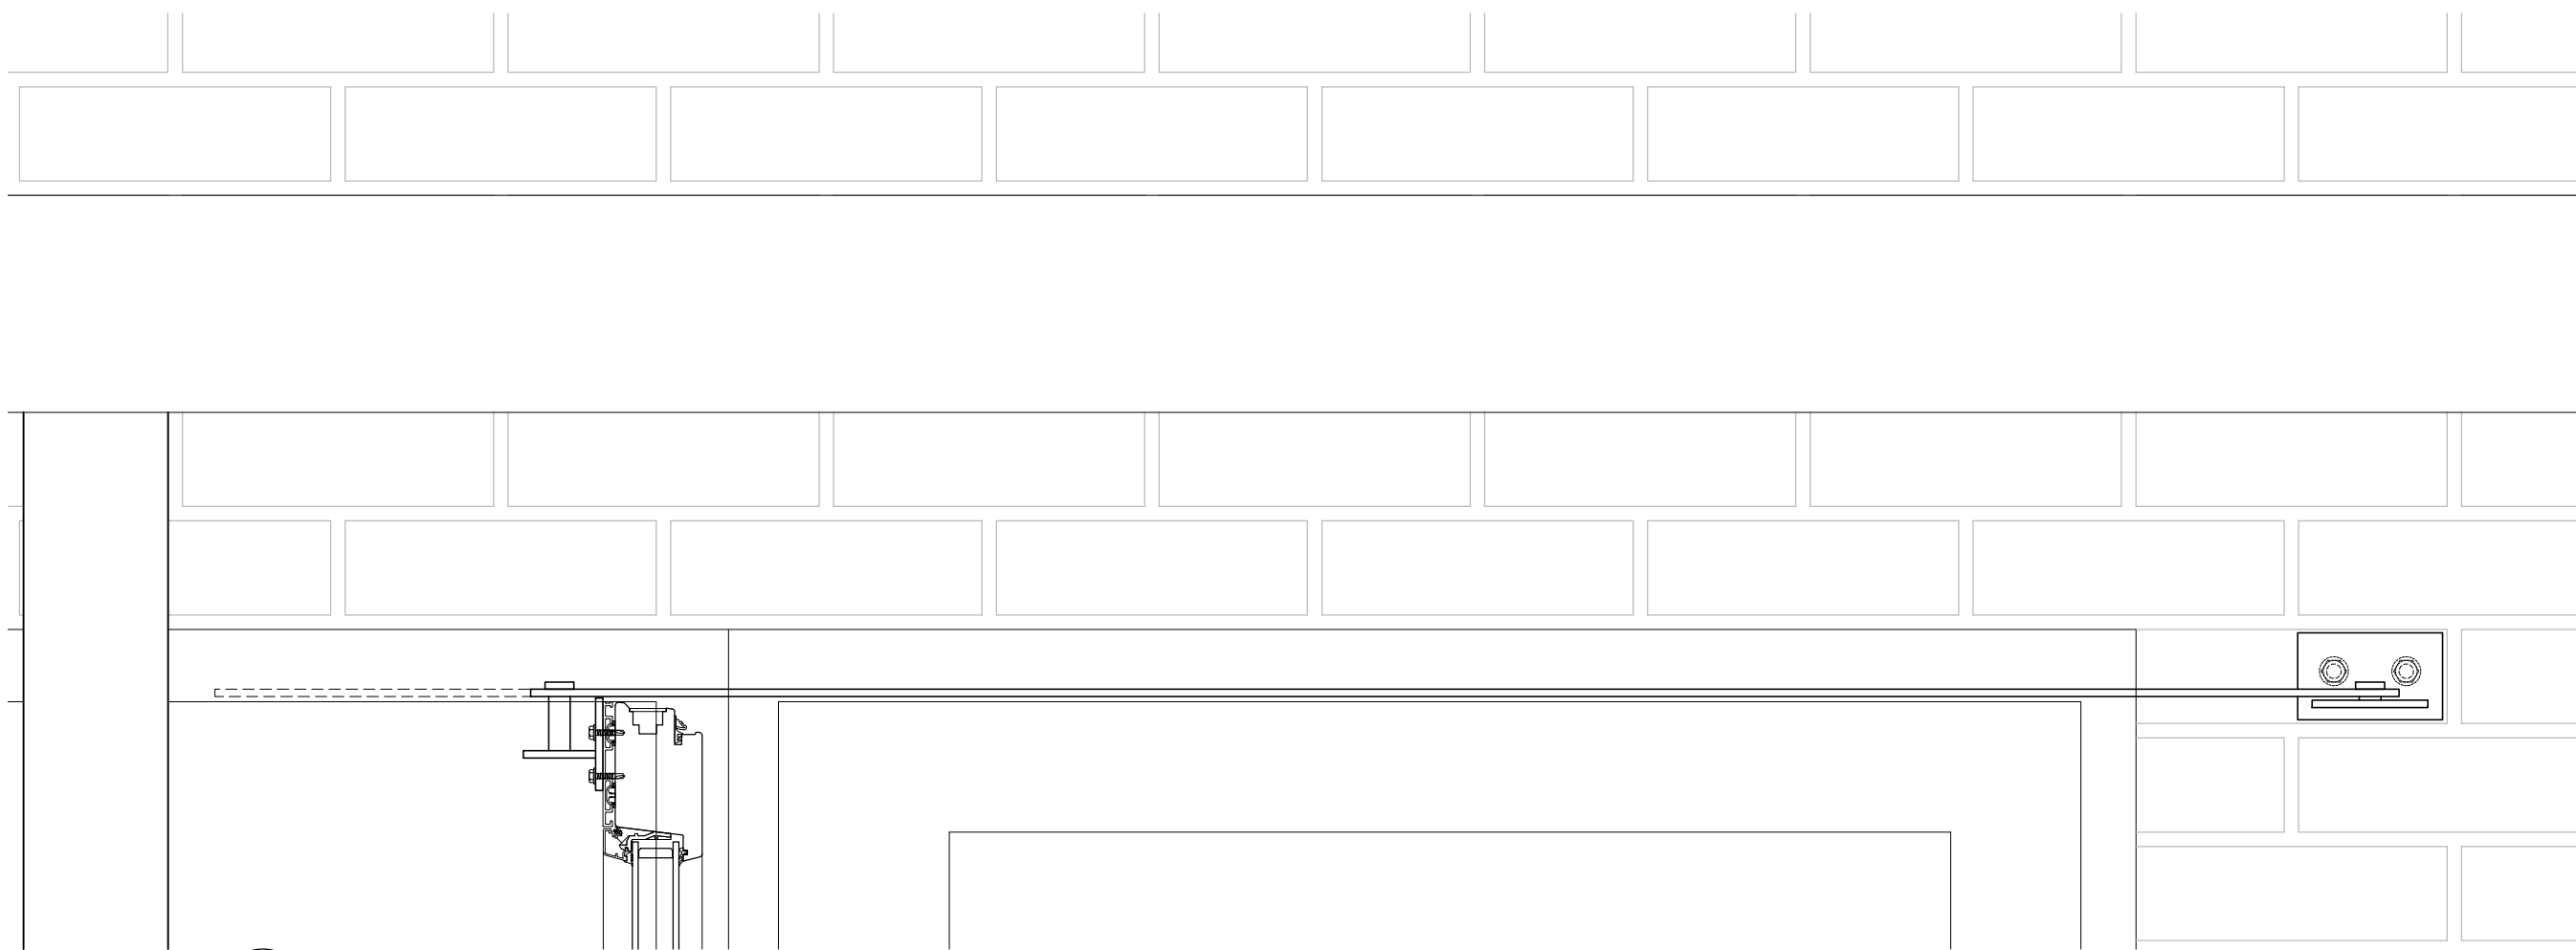


03 Door Head Stop Arm Elevation
Scale: 1:5

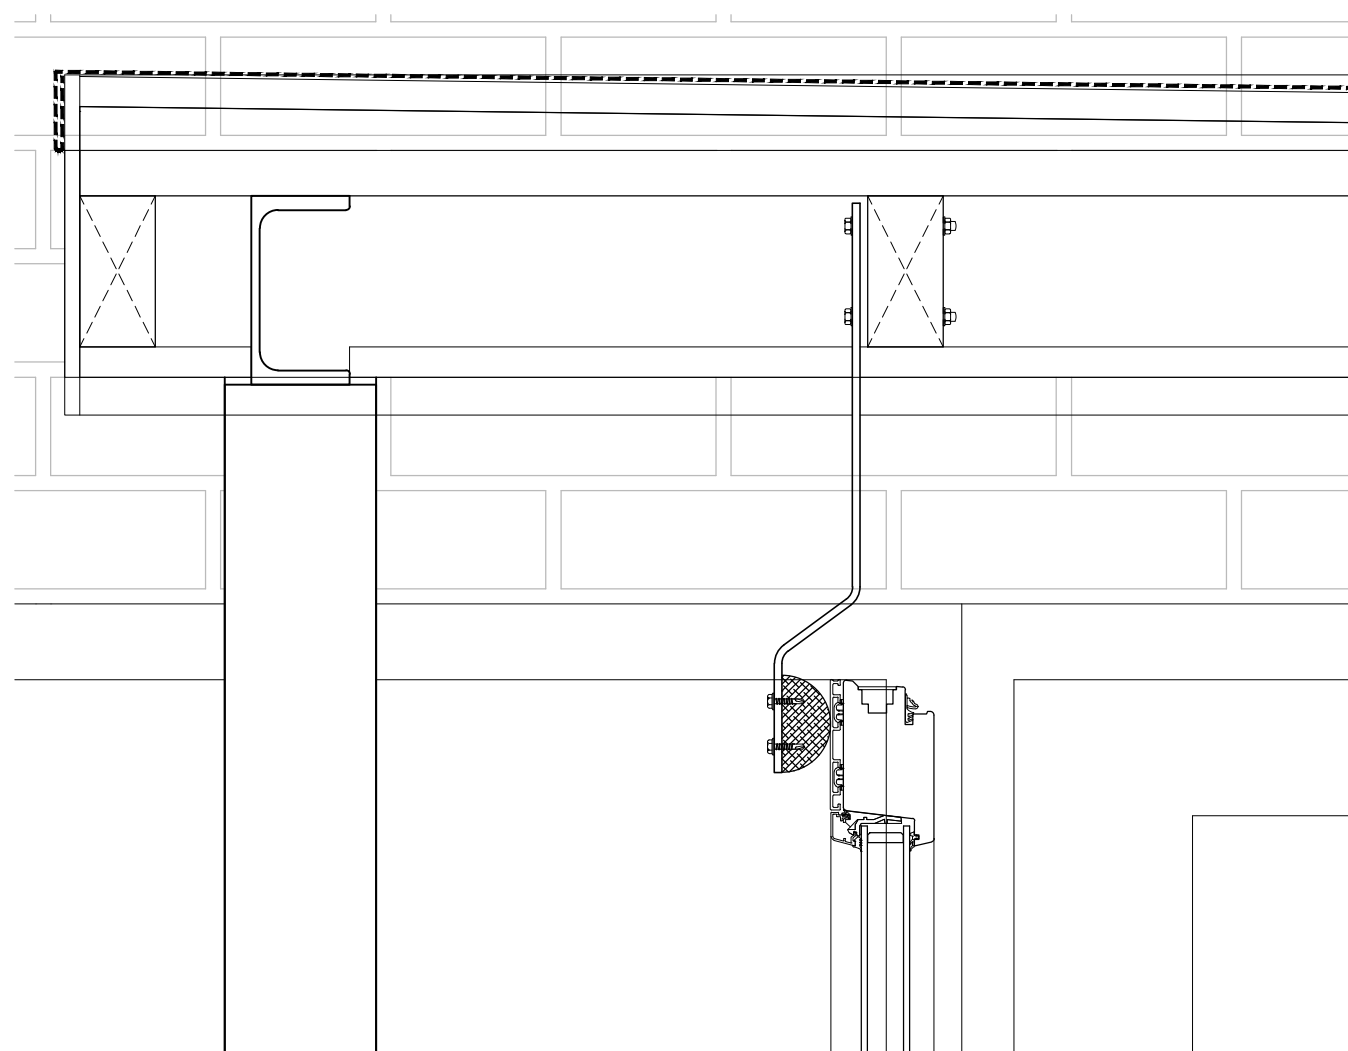

04 Door Head Stopper Arm Elevation
Scale: 1:5

NB: All information based on supplied third party survey information.
All discrepancies to be reported to FCG immediately upon discovery.

NOTES: Do not scale this drawing. All dimensions to be checked on site prior to commencement or manufacture.
Key Plan (nts)

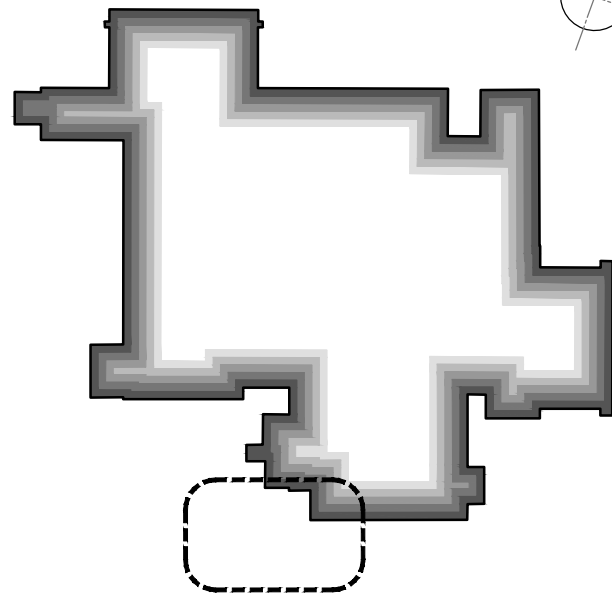

ISSUED FOR
INFORMATION ONLY

All details referenced in call outs supersede general arrangement or larger depictions.

Rev	Date	By	Chk	Comment
P1	09.09.13	RKC	AGC	Preliminary Issue for Information

BRINGING IDEAS TO LIFE



FRANKHAM

Frankham Consultancy Group Limited
21 Pymons Road
Haywards Heath RH16 3TP
t 01444 444900 f 01444 455642
enquiries@frankham.com
www.frankham.com

Client
Mansell
Contract N°: MC0269

Project Title
Eastbourne & Worthing
Crematoria
Refurbishments and Alterations

Drawing Title
EASTBOURNE
Eastbourne Crematorium
Office Door Stop Options

Drawn by: RKC	Scale: 1:20@A1	Date: 09.09.13
Designed by: FCG	Checked by: JAS	Approved by: AC

File Ref.: X:\FRANKHAM\2_080512180 CREMATORIA\ARCHIVE\400-02160-001\04-001.dwg
20.06.11 12:17:10

Drawing No. 521260-A-401-E-X	Rev. P1
---------------------------------	------------

All Disabled and Ambulant Disabled facilities to comply with Approved Document Part M - 'Access to and use of buildings', Disability Discrimination Act 1995 and BS83000 as required

Install new canopy over landing. Construct frame and joist and firrings, with Polycarb sheet to drain to gutter to connect to RWP adjacent. Facia boards to be painted both sides prior to fixing.

Install new DDA compliant handrails in accordance with BS8300:2009 5.10.2. 45mmØ polyester powder coated, 1100mm above landings

Install new steel posts to support stairs in accordance with Structural Engineers design and specification

01 Metal Stair South Elevation

Scale: 1:20

Install new canopy over landing. Construct frame and joist and firrings, with Polycarb sheet to drain to gutter to connect to RWP adjacent. Facia boards to be painted both sides prior to fixing.

Install new DDA compliant handrails in accordance with BS8300:2009 5.10.2. 45mmØ polyester powder coated, 1100mm above landings

String plate to be reduced in height outside door threshold to prevent step over into office.

At head of stairs, install new DDA compliant "corduroy" tactile paving recessed into frame to ensure level in accordance with BS8300:2009 5.9.6. 800mm wide, 400mm from bottom nosing, spanning 400mm each side of stair if possible

Install new steel posts to support stairs in accordance with Structural Engineers design and specification

02 Metal Stair South Section

Scale: 1:20

NB: All information based on supplied third party survey information. All discrepancies to be reported to FCG immediately upon discovery.

Gutter to connect to RWP adjacent.

Install new DDA compliant handrails each side of stairs in accordance with BS8300:2009 5.10.2. 45mmØ polyester powder coated, 1000mm above stair pitch to provide a min clear width of 1m to extend 300mm past top and bottom steps

Install new DDA compliant stairs in accordance with BS8300:2009 5.9.

At base and head of stairs, install new DDA compliant "corduroy" tactile paving in accordance with BS8300:2009 5.9.6. 800mm wide, 400mm from bottom nosing, spanning 400mm each side of stair


Gutter to connect to RWP adjacent.

Install new DDA compliant handrails each side of stairs in accordance with BS8300:2009 5.10.2. 45mmØ polyester powder coated, 1000mm above stair pitch to provide a min clear width of 1m to extend 300mm past top and bottom steps

Install new DDA compliant stairs in accordance with BS8300:2009 5.9.

At base and head of stairs, install new DDA compliant "corduroy" tactile paving in accordance with BS8300:2009 5.9.6. 800mm wide, 400mm from bottom nosing, spanning 400mm each side of stair

NOTES: Do not scale this drawing. All dimensions to be checked on site prior to commencement or manufacture.
Key Plan (nts)

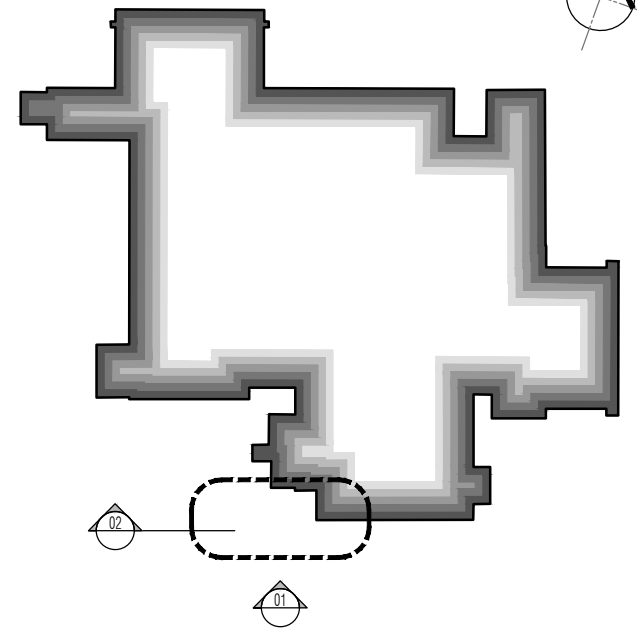

STAIRCASE CRITERIA

LOWER GF to GROUND	floor total rise	= 2125 mm
13 number RISERS	@	= 163.461 mm
12 number GOINGS	@	= 350 mm
PITCH of stair to be		= 25.0341 °
Overall STRING to be		= 1210 mm

Height to top of handrail to be min 900mm
Height to top of guarding to be min 1100mm
Balusters to be max 100mm clear spaced apart.
Min 2000mm clear headroom above stair pitch line.

ISSUED FOR CONSTRUCTION

All details referenced in call outs supercede general arrangement or larger depictions.

C2	28.05.12	RKC	JAS	Gen revs per Client comments
C1	29.03.12	RKC	JAS	Issued for CONSTRUCTION
Rev	Date	By	Chk	Comment

BRINGING IDEAS TO LIFE



FRANKHAM

Frankham Consultancy Group Limited
21 Perryman Road
Haywards Heath RH16 3TP
t 01444 444900 f 01444 455642
enquiries@frankham.com
www.frankham.com

Client
Mansell
Contract N°: MC0269

Project Title
Eastbourne & Worthing
Crematoria
Refurbishments and Alterations

Drawing Title
EASTBOURNE
Eastbourne Crematorium
External Stair Elevation and Section 02

Drawn by: RKC	Scale: 1:20@A1	Date: 02.03.12
Designed by: FCG	Checked by: JAS	Approved by: AC

File Ref.: X:\FRANKHAM\2_06051210 CREMATORIA\WORKBOOK 400 DETAIL COORDINATES
301360-A-402-E 096 - 2006111212123 20.06.11.12.17.23

Drawing No. 521260-A-402-E	Rev. C2
-------------------------------	------------

01 Metal Stair West Elevation
Scale: 1:20

02 402

Install new canopy over landing. Construct frame and joist and firings, with Polycarb sheet to drain to gutter to connect to RWP adjacent. Facia boards to be painted both sides prior to fixing.

Install new DDA compliant handrails in accordance with BS8300:2009 5.10.2. 45mmØ polyester powder coated, 1100mm above landings

String plate to be reduced in height outside door threshold to prevent step over into office.

Install new steel posts to support stairs in accordance with Structural Engineer's design and specification

01 402

02 402

Install new canopy over landing. Construct frame and joist and firings, with Polycarb sheet to drain to gutter to connect to RWP adjacent. Facia boards to be painted both sides prior to fixing.

Install new DDA compliant handrails in accordance with BS8300:2009 5.10.2. 45mmØ polyester powder coated, 1100mm above landings

String plate to be reduced in height outside door threshold to prevent step over into office.

Install new steel posts to support stairs in accordance with Structural Engineer's design and specification

At foot of stairs, install new DDA compliant "corduroy" tactile paving recessed into frame to ensure level in accordance with BS8300:2009 5.9.6. 800mm wide, 400mm from bottom nosing, spanning 400mm each side of stair if possible

Install new foundations to steel posts to support stairs in accordance with Structural Engineer's design and specification

02 402

01 Metal Stair West Elevation
Scale: 1:20

[illegible]

03 Metal Stair Section 01
Scale: 1:20

ISSUED FOR
CONSTRUCTION

All details referenced in call outs supercede general arrangement or larger depictions.

C2	16.05.12	RKC	JSA	Gen revs per Client comments
C1	29.03.12	RKC	JAS	Issued for CONSTRUCTION
Rev	Date	By	Chk	Comment

BRINGING IDEAS TO LIFE



FRANKHAM

Frankham Consultancy Group Limited
21 Perrymount Road
Haywards Heath RH16 3TP
t 01444 444900 f 01444 455642
enquire@frankham.com
www.frankham.com

Client	 Mansell Building Quality Connections Contract N°: MC0269
--------	---

Project Title	Eastbourne & Worthing Crematoria Refurbishments and Alterations
---------------	---

Drawing Title	
Eastbourne Crematorium	
External Stair Elevations and Sections	


Drawn by: RKC	Scale: 1:20@A1	Date: 02.03.12
Designed by: FCG	Checked by: JAS	Approved by: AC

File Ref.: X:\FRANKHAM Z-ICBS\521260-CREMATORIUM\ARCH\400-499-DETAIL-SHEMATICS,
521260-A-403-E.DWG - 200611121726 20:06:11:12:17:25


Drawing No. 521260-A-403-E	Rev. C2
-------------------------------	------------

NB: All information based on supplied third party survey information.
All discrepancies to be reported to FCG immediately upon discovery.

All Disabled and Ambulant Disabled facilities to comply with Approved Document Part M - Access to and use of buildings*, Disability Discrimination Act 1995 and BS83000 as required

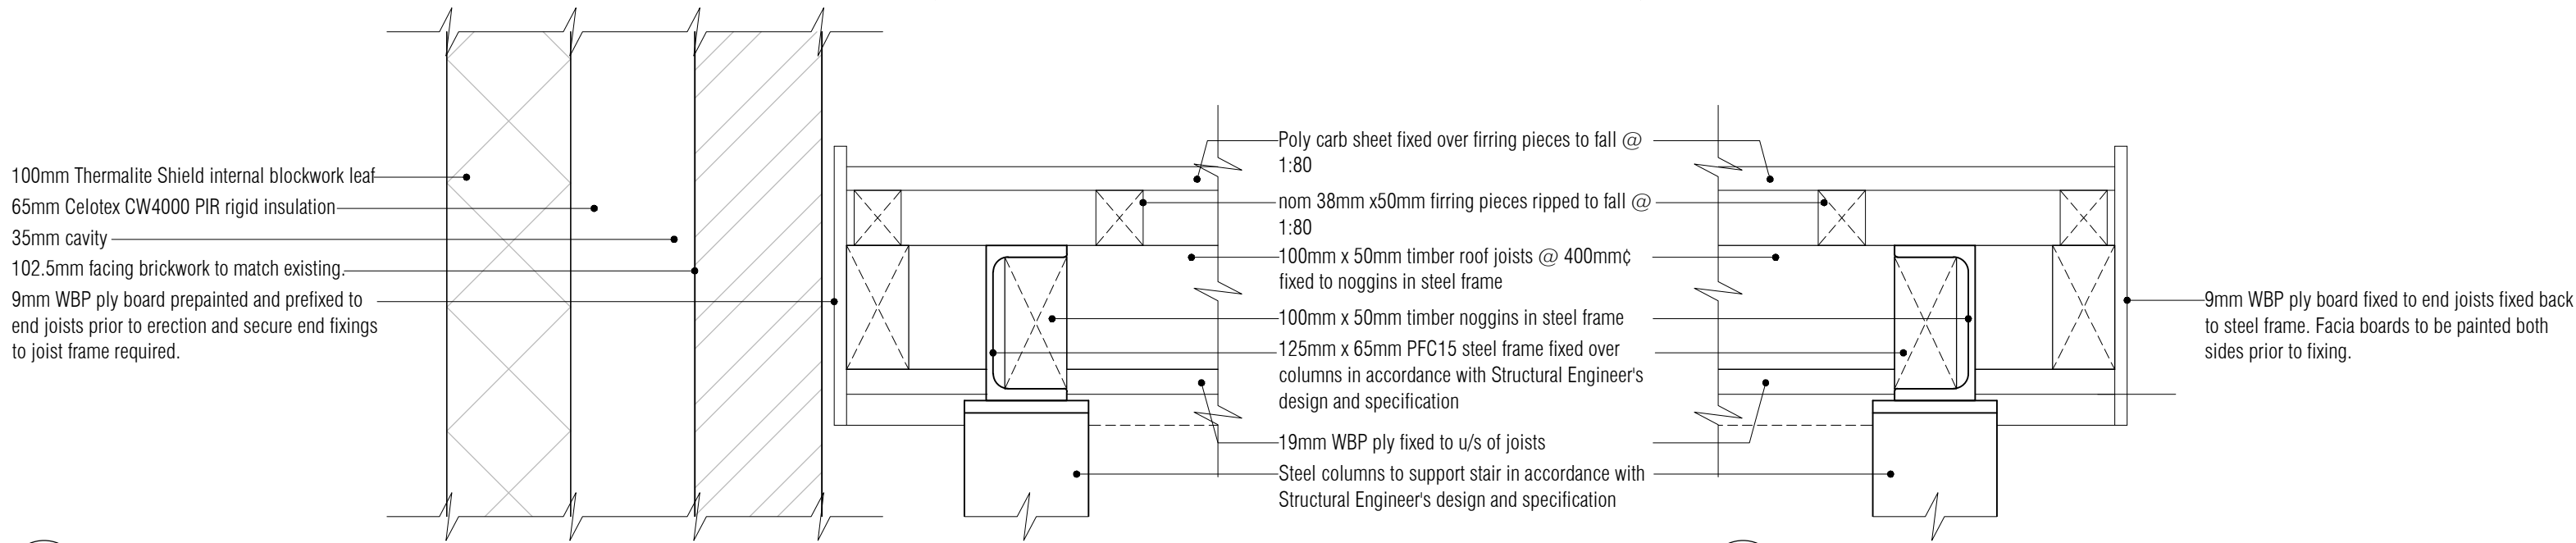


01 Metal Stair Canopy Facia Detail
Scale: 1:5

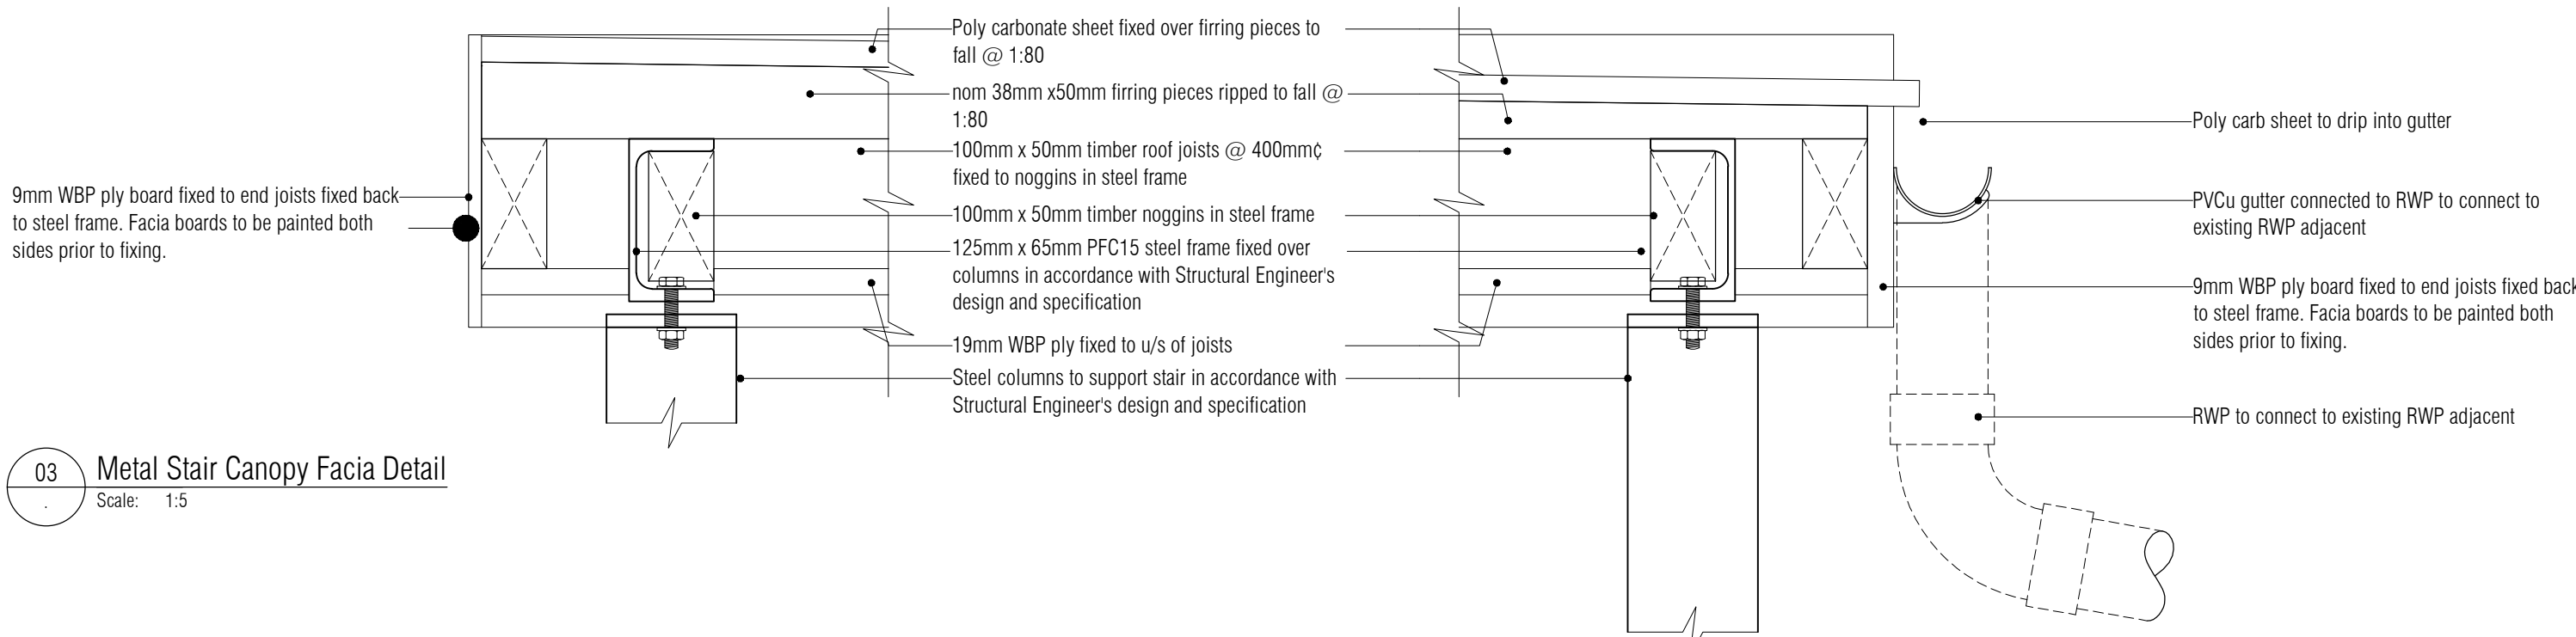


03 Metal Stair Canopy Facia Detail
Scale: 1:5

04 Metal Stair Canopy Facia Detail
Scale: 1:5

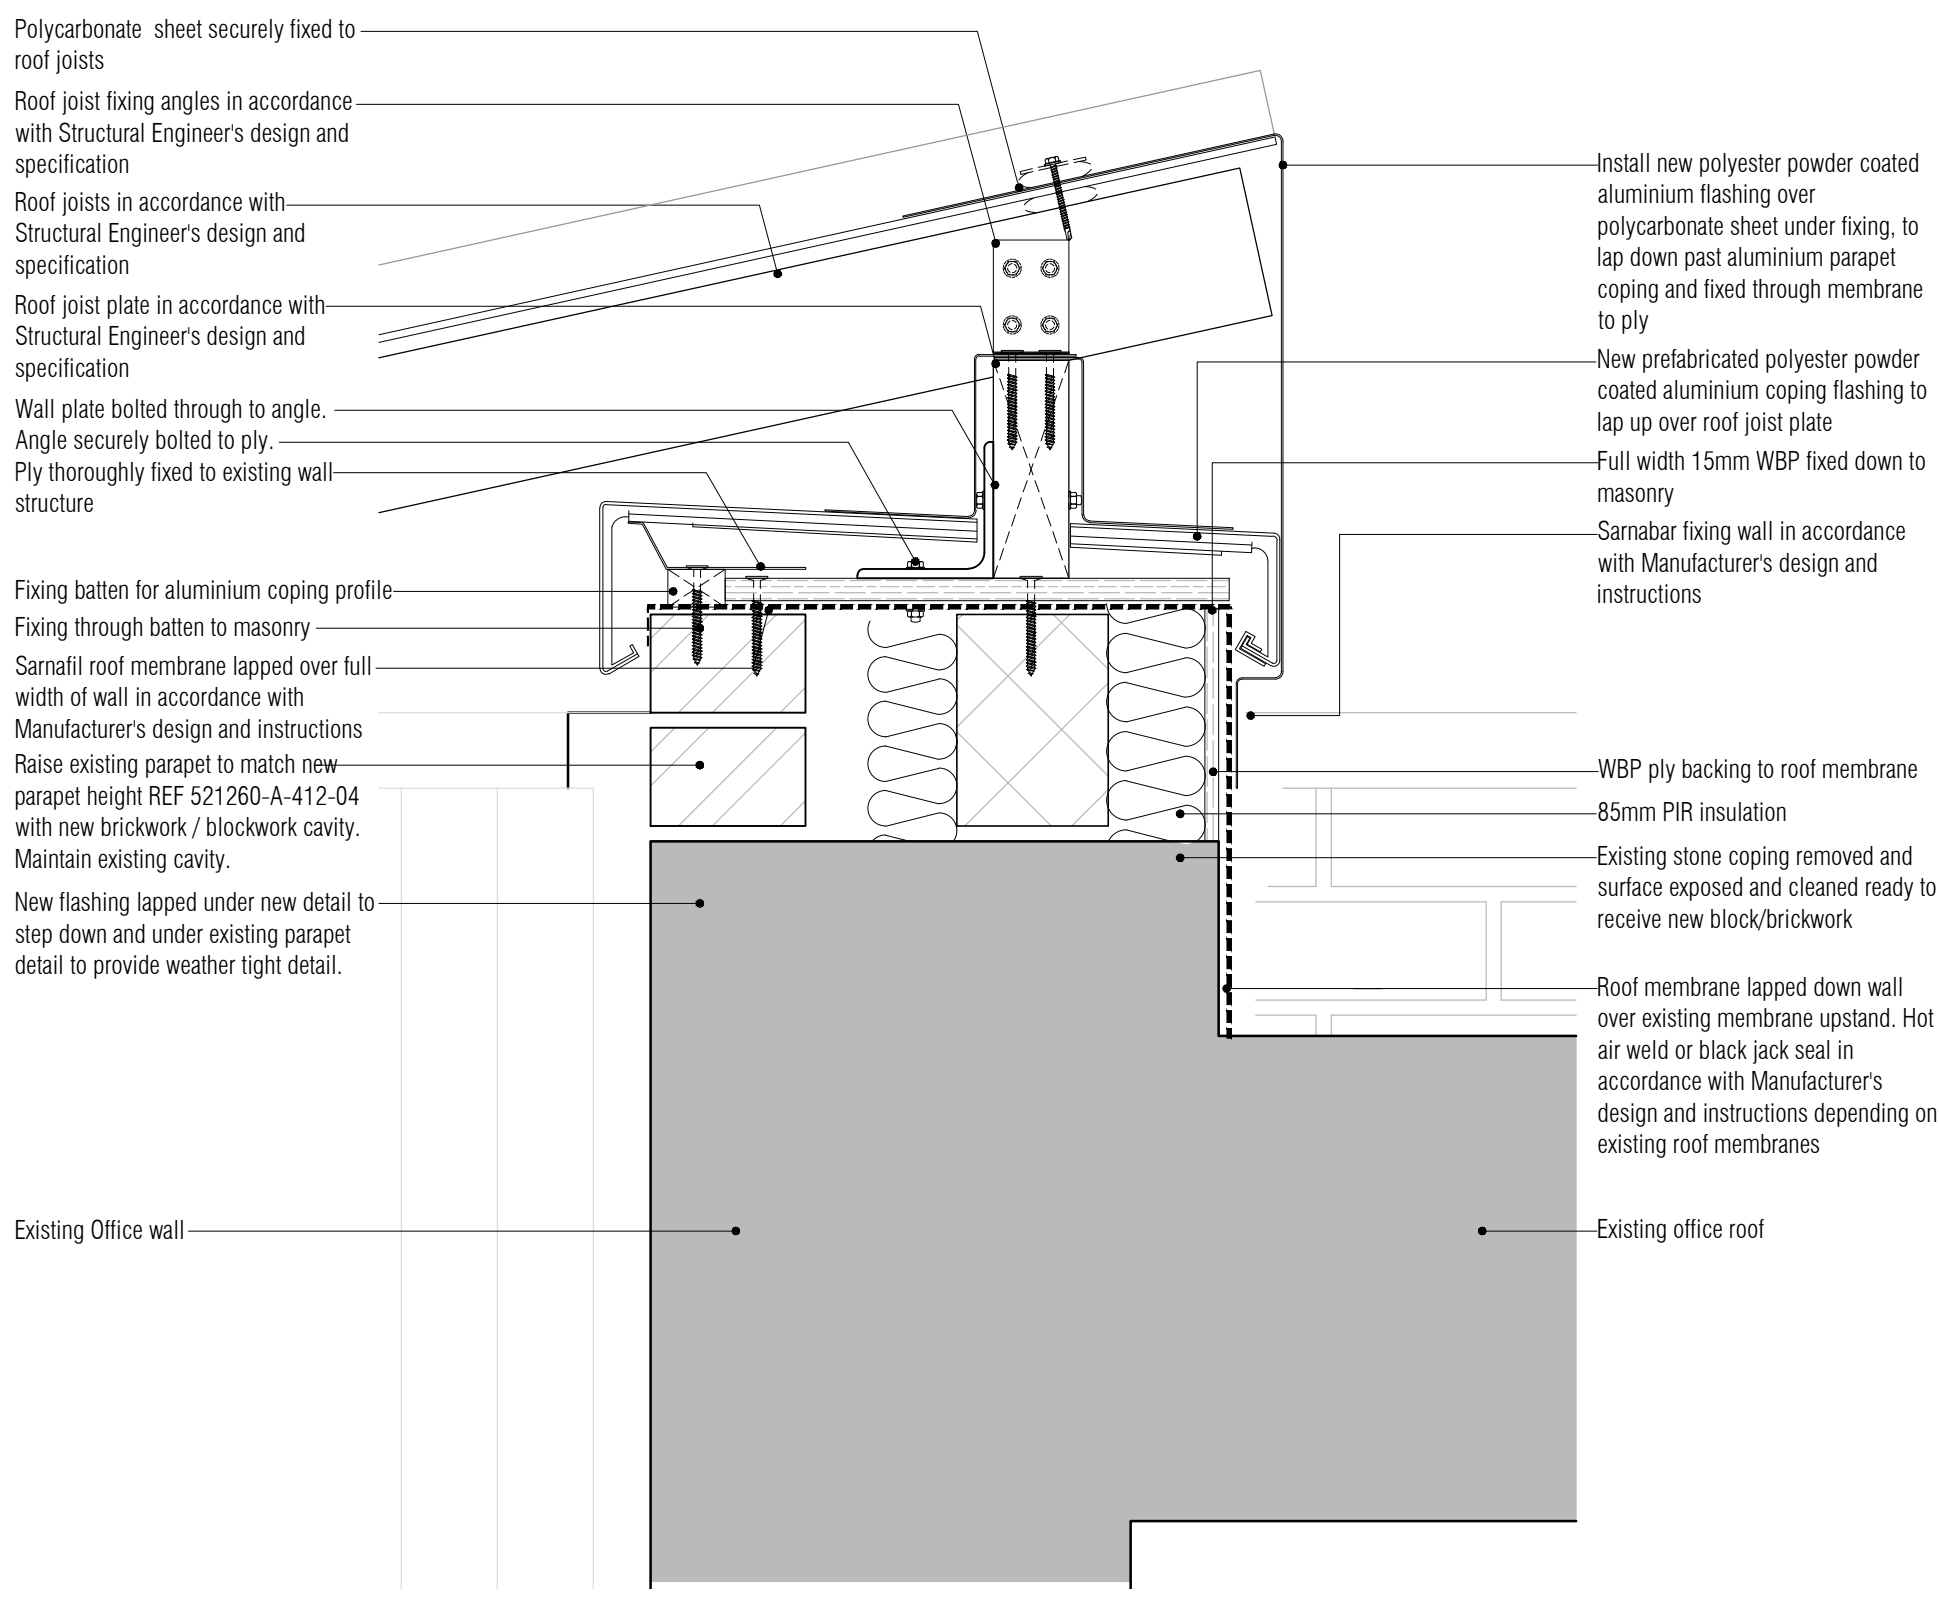

05 Covered Corridor Parapet Detail
Scale: 1:5

NOTES: Do not scale this drawing. All dimensions to be checked on site prior to commencement or manufacture.
Key Plan (nts)

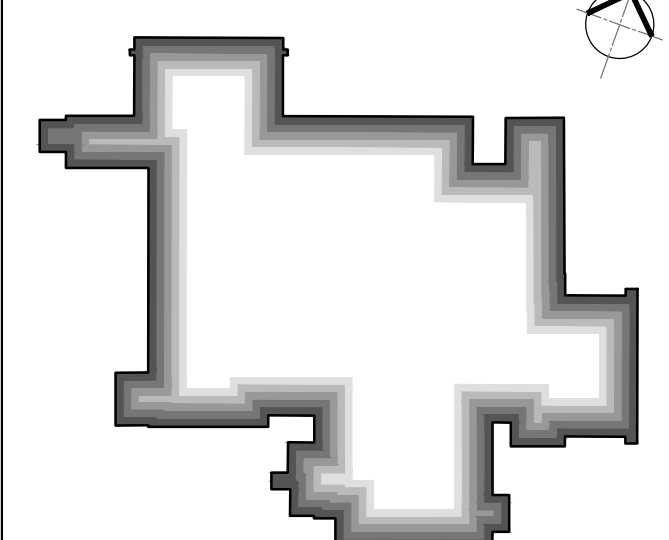

STAIRCASE CRITERIA			
LOWER GF to GROUND	floor total rise	= 2125	mm
13 number RISERS	@	= 163.461	mm
12 number GOINGS	@	= 330	mm
PITCH of stair to be		= 25.0341	°
Overall STRING to be		= 1210	mm
Height to top of handrail to be min 900mm Height to top of guarding to be min 1100mm (Balusters to be max 100mm clear spaced apart. Min 2000mm clear headroom above stair pitch line.			

STAGE - F DESIGN ISSUE

All details referenced in call outs supercede general arrangement or larger depictions.

Rev	Date	By	Chk	Comment
P3	01.06.12	RKC	JAS	Issued for Stage F
P2	28.05.12	RKC	JAS	Detail 05 added
C2	16.05.12	RKC	JAS	Gen revs per Client comments
C1	29.03.12	RKC	JAS	Issued for CONSTRUCTION

BRINGING IDEAS TO LIFE



FRANKHAM

Frankham Consultancy Group Limited
21 Perryman Road
Haywards Heath RH16 3TP
t 01444 444900 f 01444 455642
enquiries@frankham.com
www.frankham.com


Client  Contract N°: MC0269		
Project Title Eastbourne & Worthing Crematoria Refurbishments and Alterations		
Drawing Title  Eastbourne Crematorium External Stair Details		
Drawn by: RKC	Scale: 1:5@A1	Date: 08.03.12
Designed by: FCG	Checked by: JAS	Approved by: AC
File Ref.: X:\FRANKHAM\2_080312\01 CREMATORIA\WORK\404-404-E\01 DETAIL CO-ORDINATES 307350-A-404-E-000 - 290611121738 20.06.11 12:17:37		
Drawing No. 521260-A-404-E		Rev. P3

NB: All information based on supplied third party survey information.
All discrepancies to be reported to FCG immediately upon discovery.


All Disabled and Ambulant Disabled facilities to comply with Approved Document Part M - Access to and use of buildings', Disability Discrimination Act 1995 and BS83000 as required

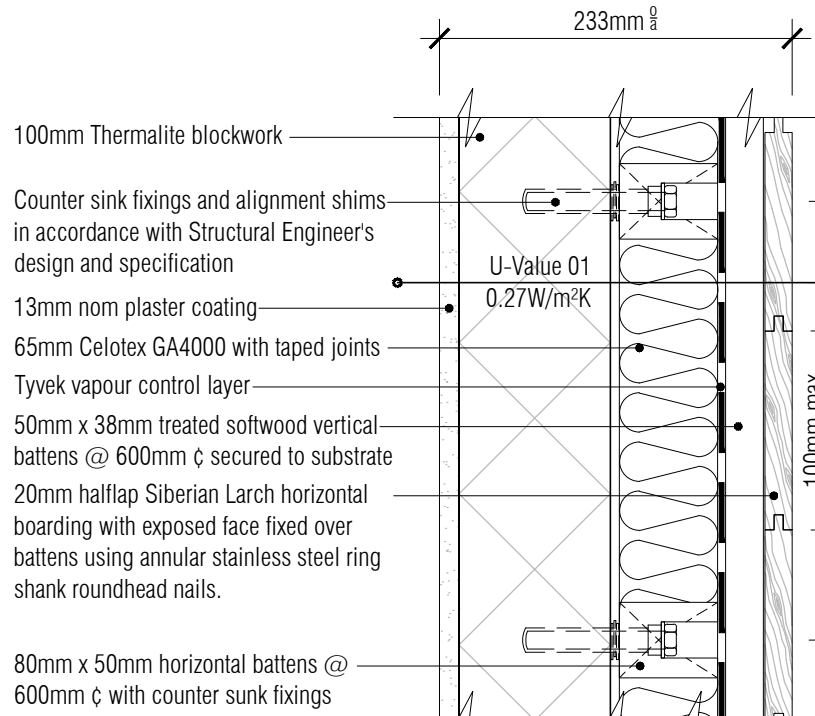


01 Typical Plant Room External Wall Detail - Wall Type J
Scale: 1:5

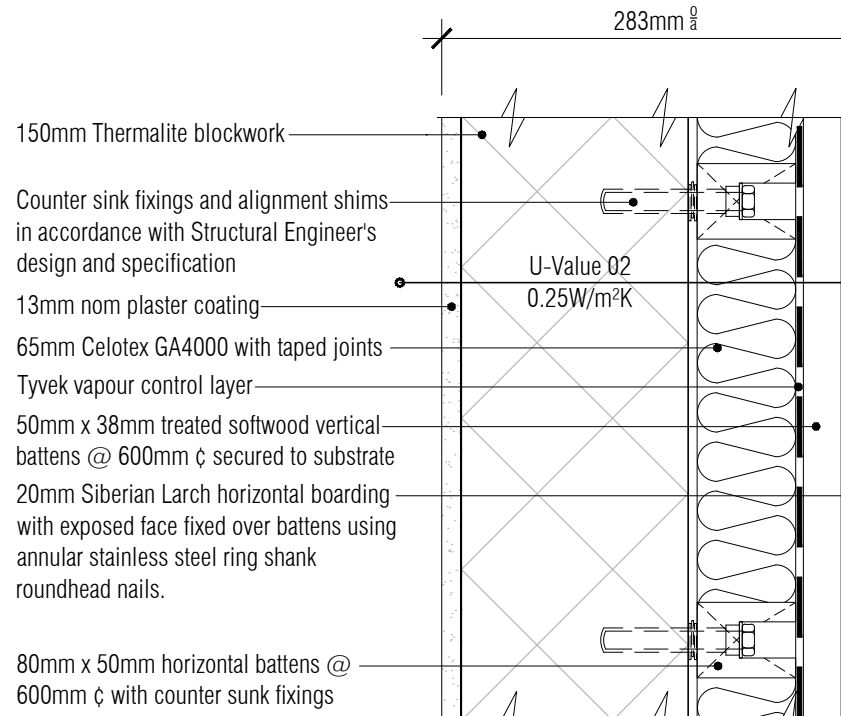


02 Typical Staff Quarters External Wall Detail - Wall Type K
Scale: 1:5

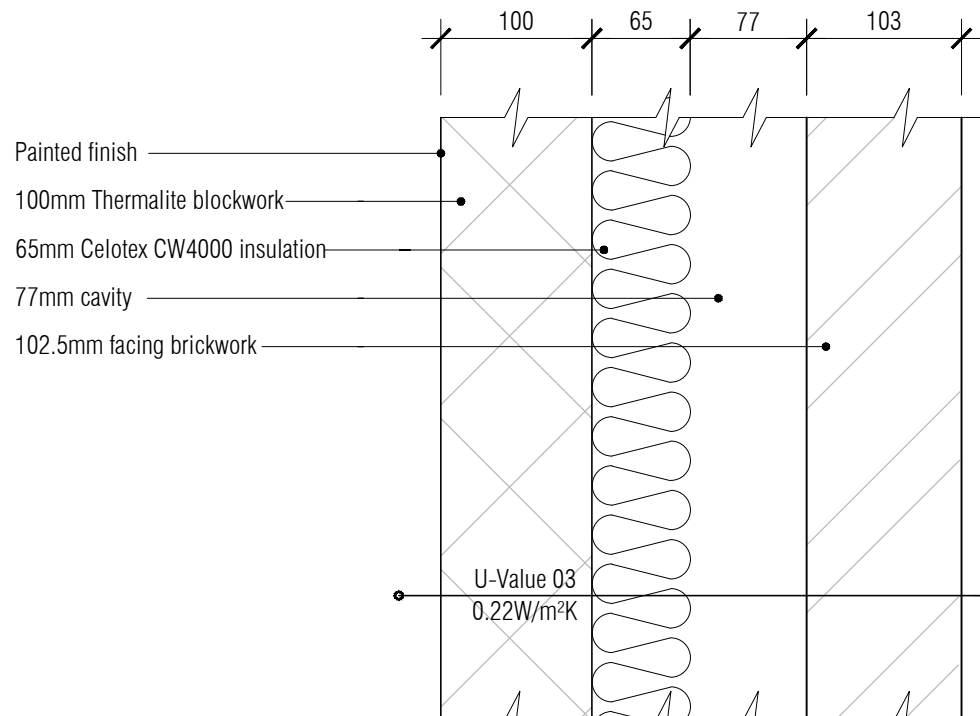


03 Typical Courtyard External Wall Detail - Wall Type G & H
Scale: 1:5

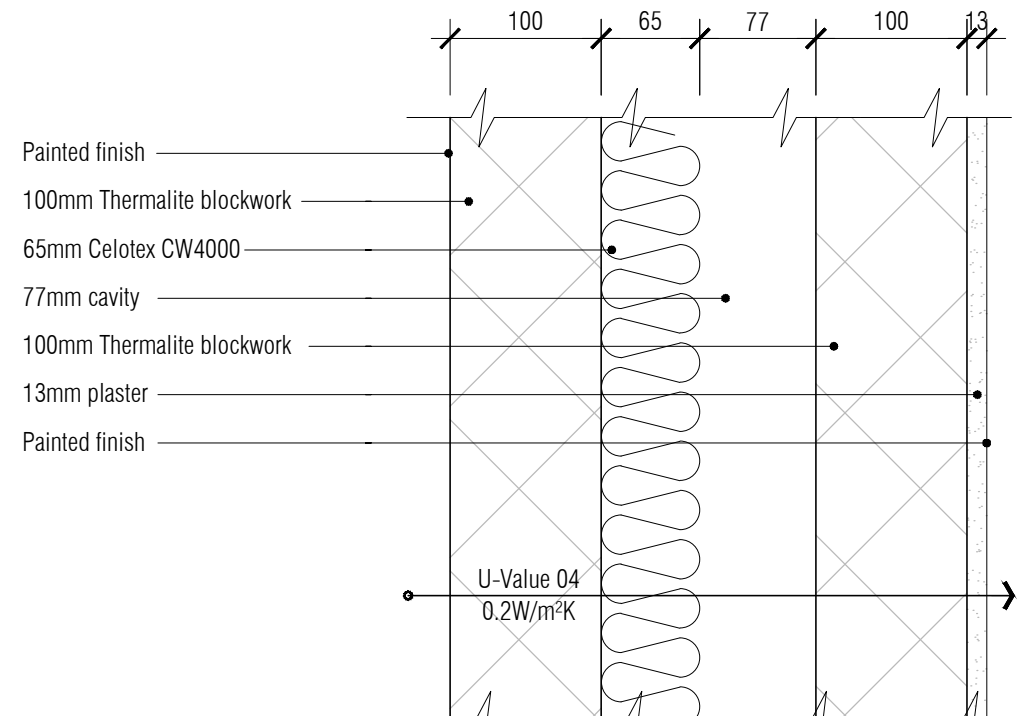

04 Typical Family Room Internal Wall Detail - Wall Type L
Scale: 1:5

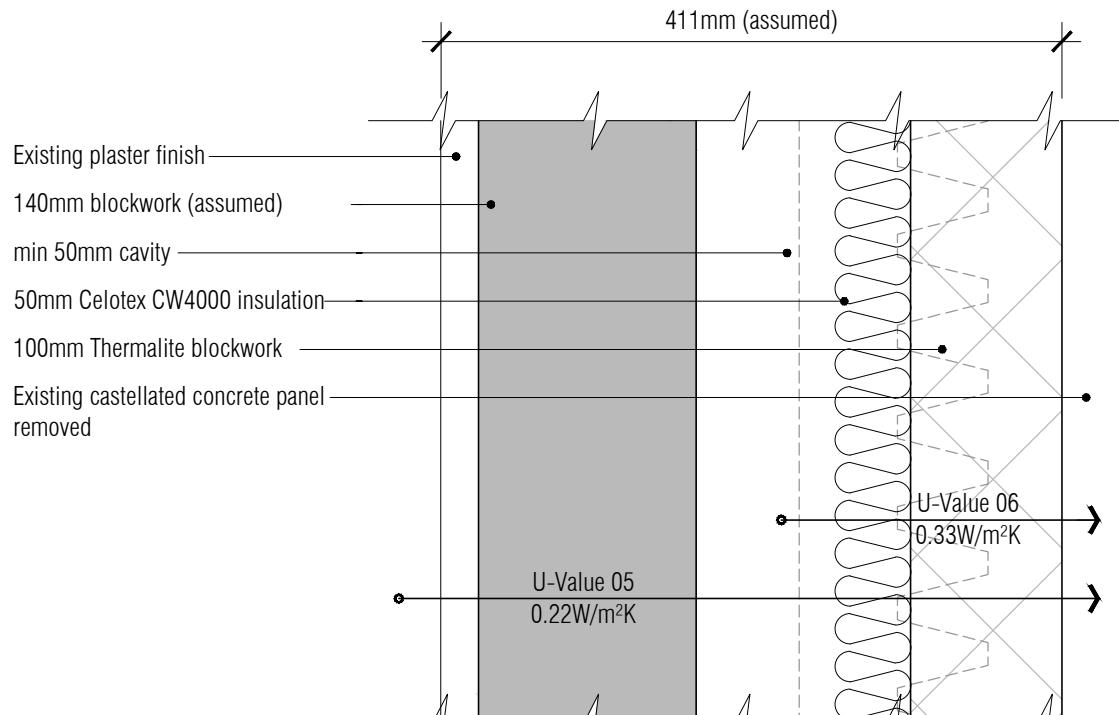


05 Typical Staff WC Internal Wall Detail - Wall Type M
Scale: 1:5

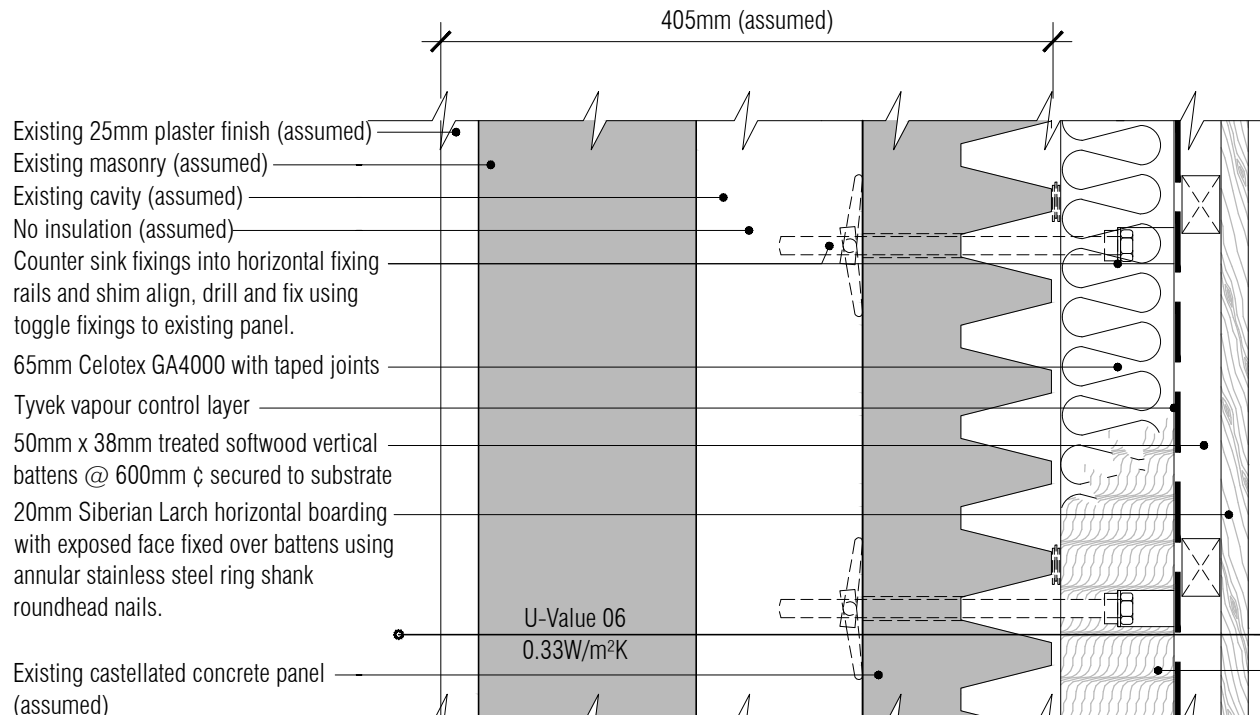


06 Typical Staff Quarters External Wall Detail - Wall Type O
Scale: 1:5

NB: All fixings in accordance with Structural Engineer's design and specification


Board fixings to be annular ring-shank nails for Larch. Nail length should normally be 2 times the thickness of the board being fixed. Nails should be driven marginally below the surface. Butt-joints should always occur over battens and nail fixings should be at least 15 mm from the end of the boards and this may require wider or additional fixing battens behind. For all boards to be left without a surface coating austenitic stainless steel nails.

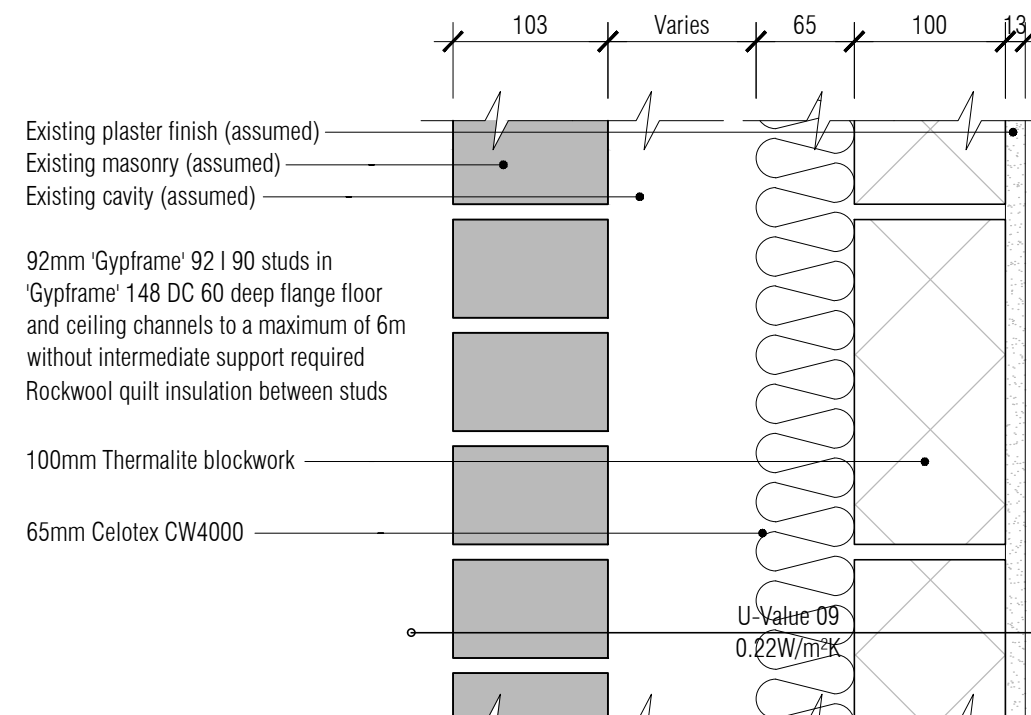


07 Typical Courtyard External Wall Detail - Wall Type D
Scale: 1:5

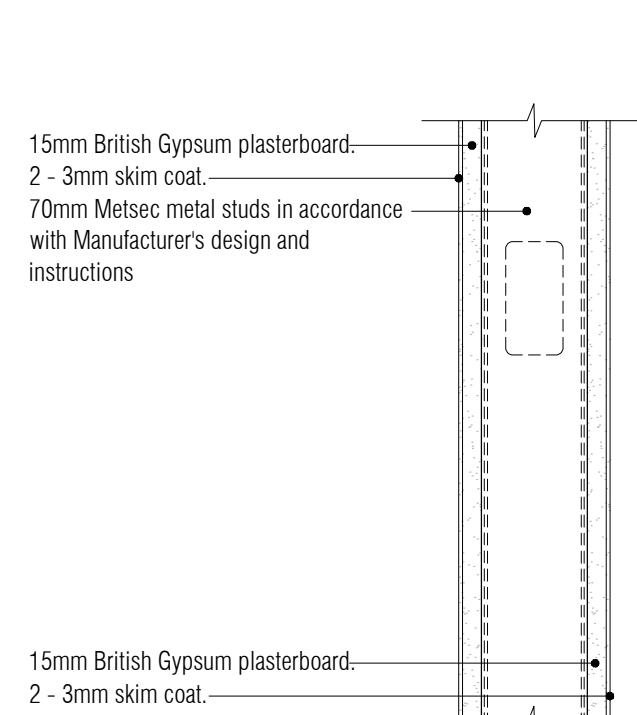


08 Typical Stud Wall Detail - Wall Type A
Scale: 1:5

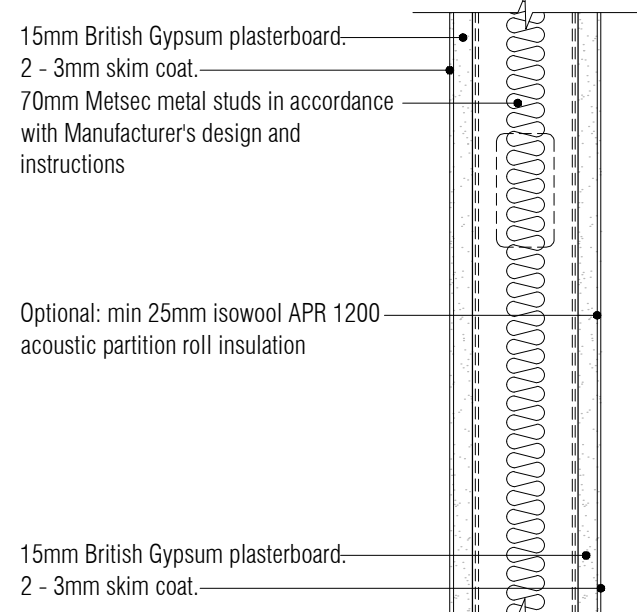


09 Typical Stud Wall Detail - Wall Type B
Scale: 1:5

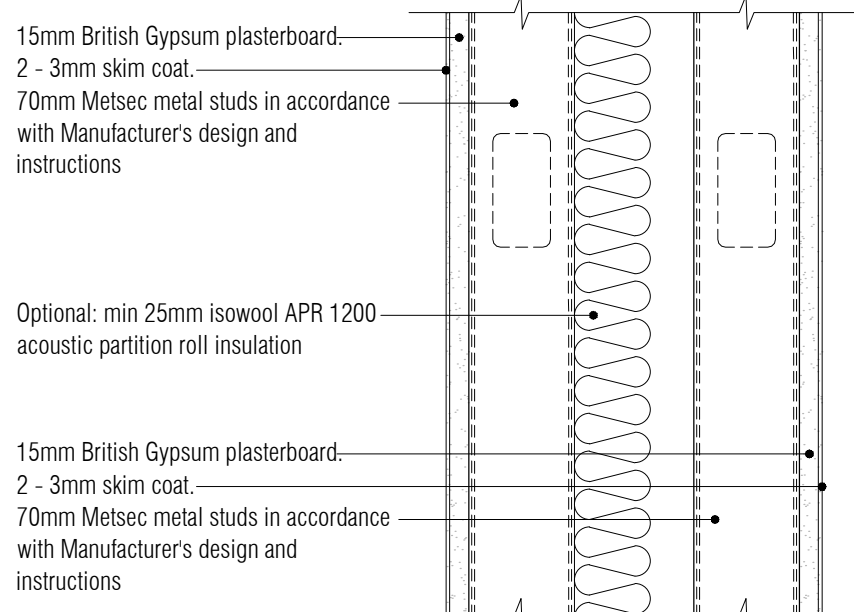


10 Typical Stud Infill Detail - Wall Type N (back to back)
Scale: 1:5

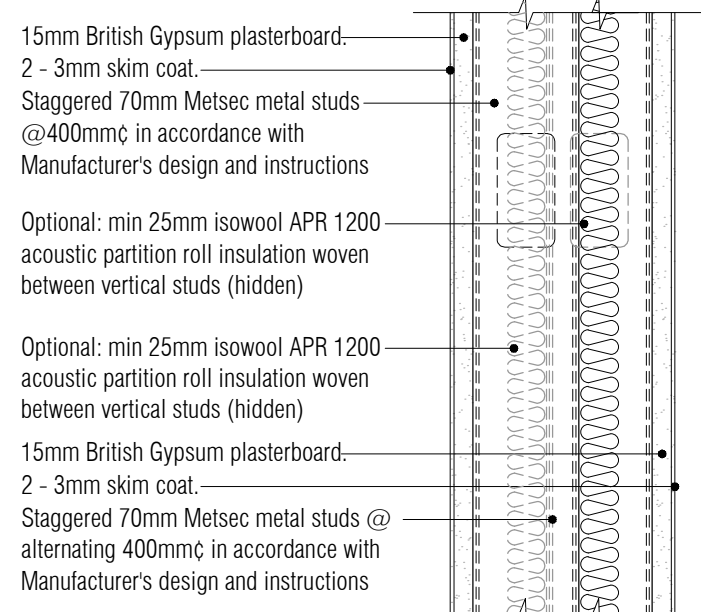


11 Typical Staggered Stud Wall Section Detail
Scale: 1:5

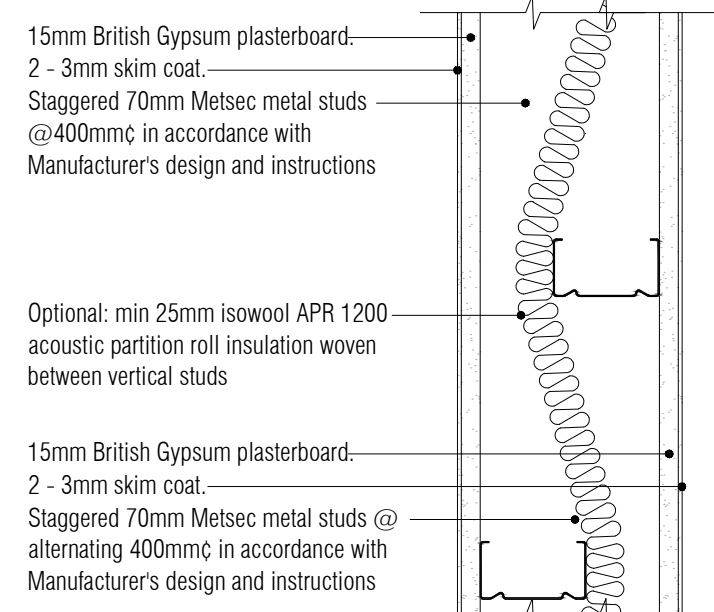


Staggered Wall Plan Detail - Wall Type N (back to back)

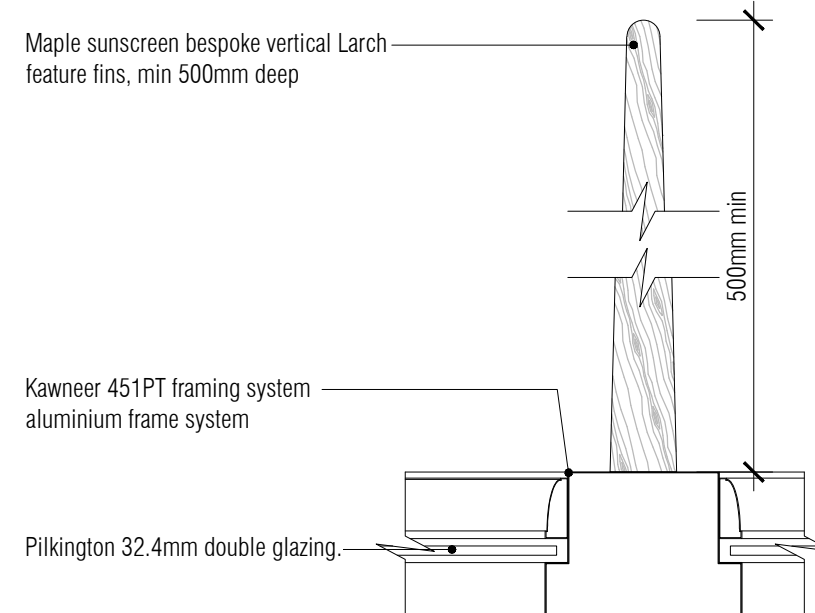


12 Bespoke Courtyard Glazing Panel Detail - Wall Type P
Scale: 1:5

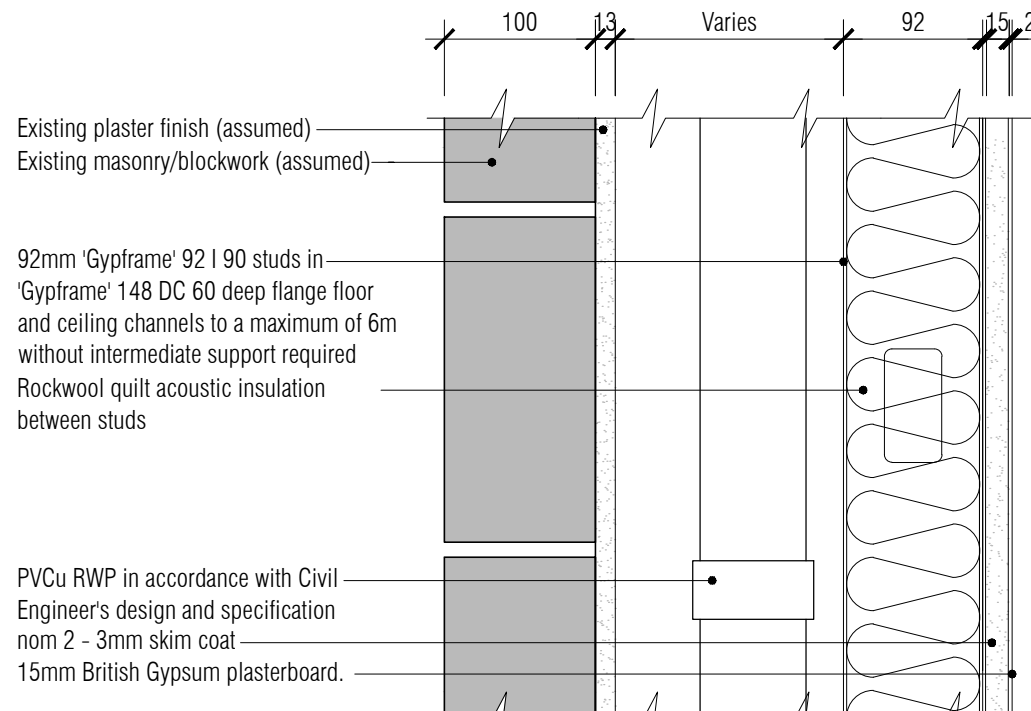

13 Typical Stud Panel Detail - Wall Type N
Scale: 1:5

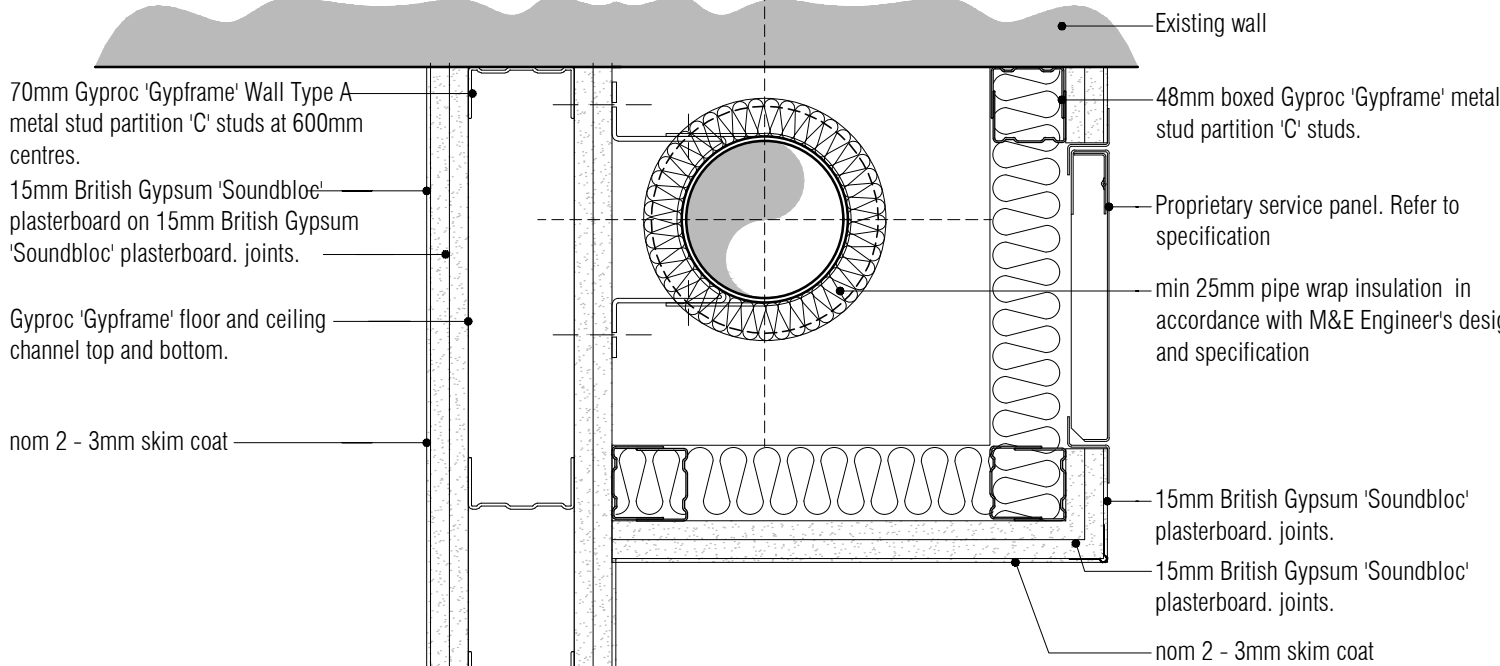


15 Typical Stud Boxing against Solid Wall with Access Panel Detail
Scale: 1:5

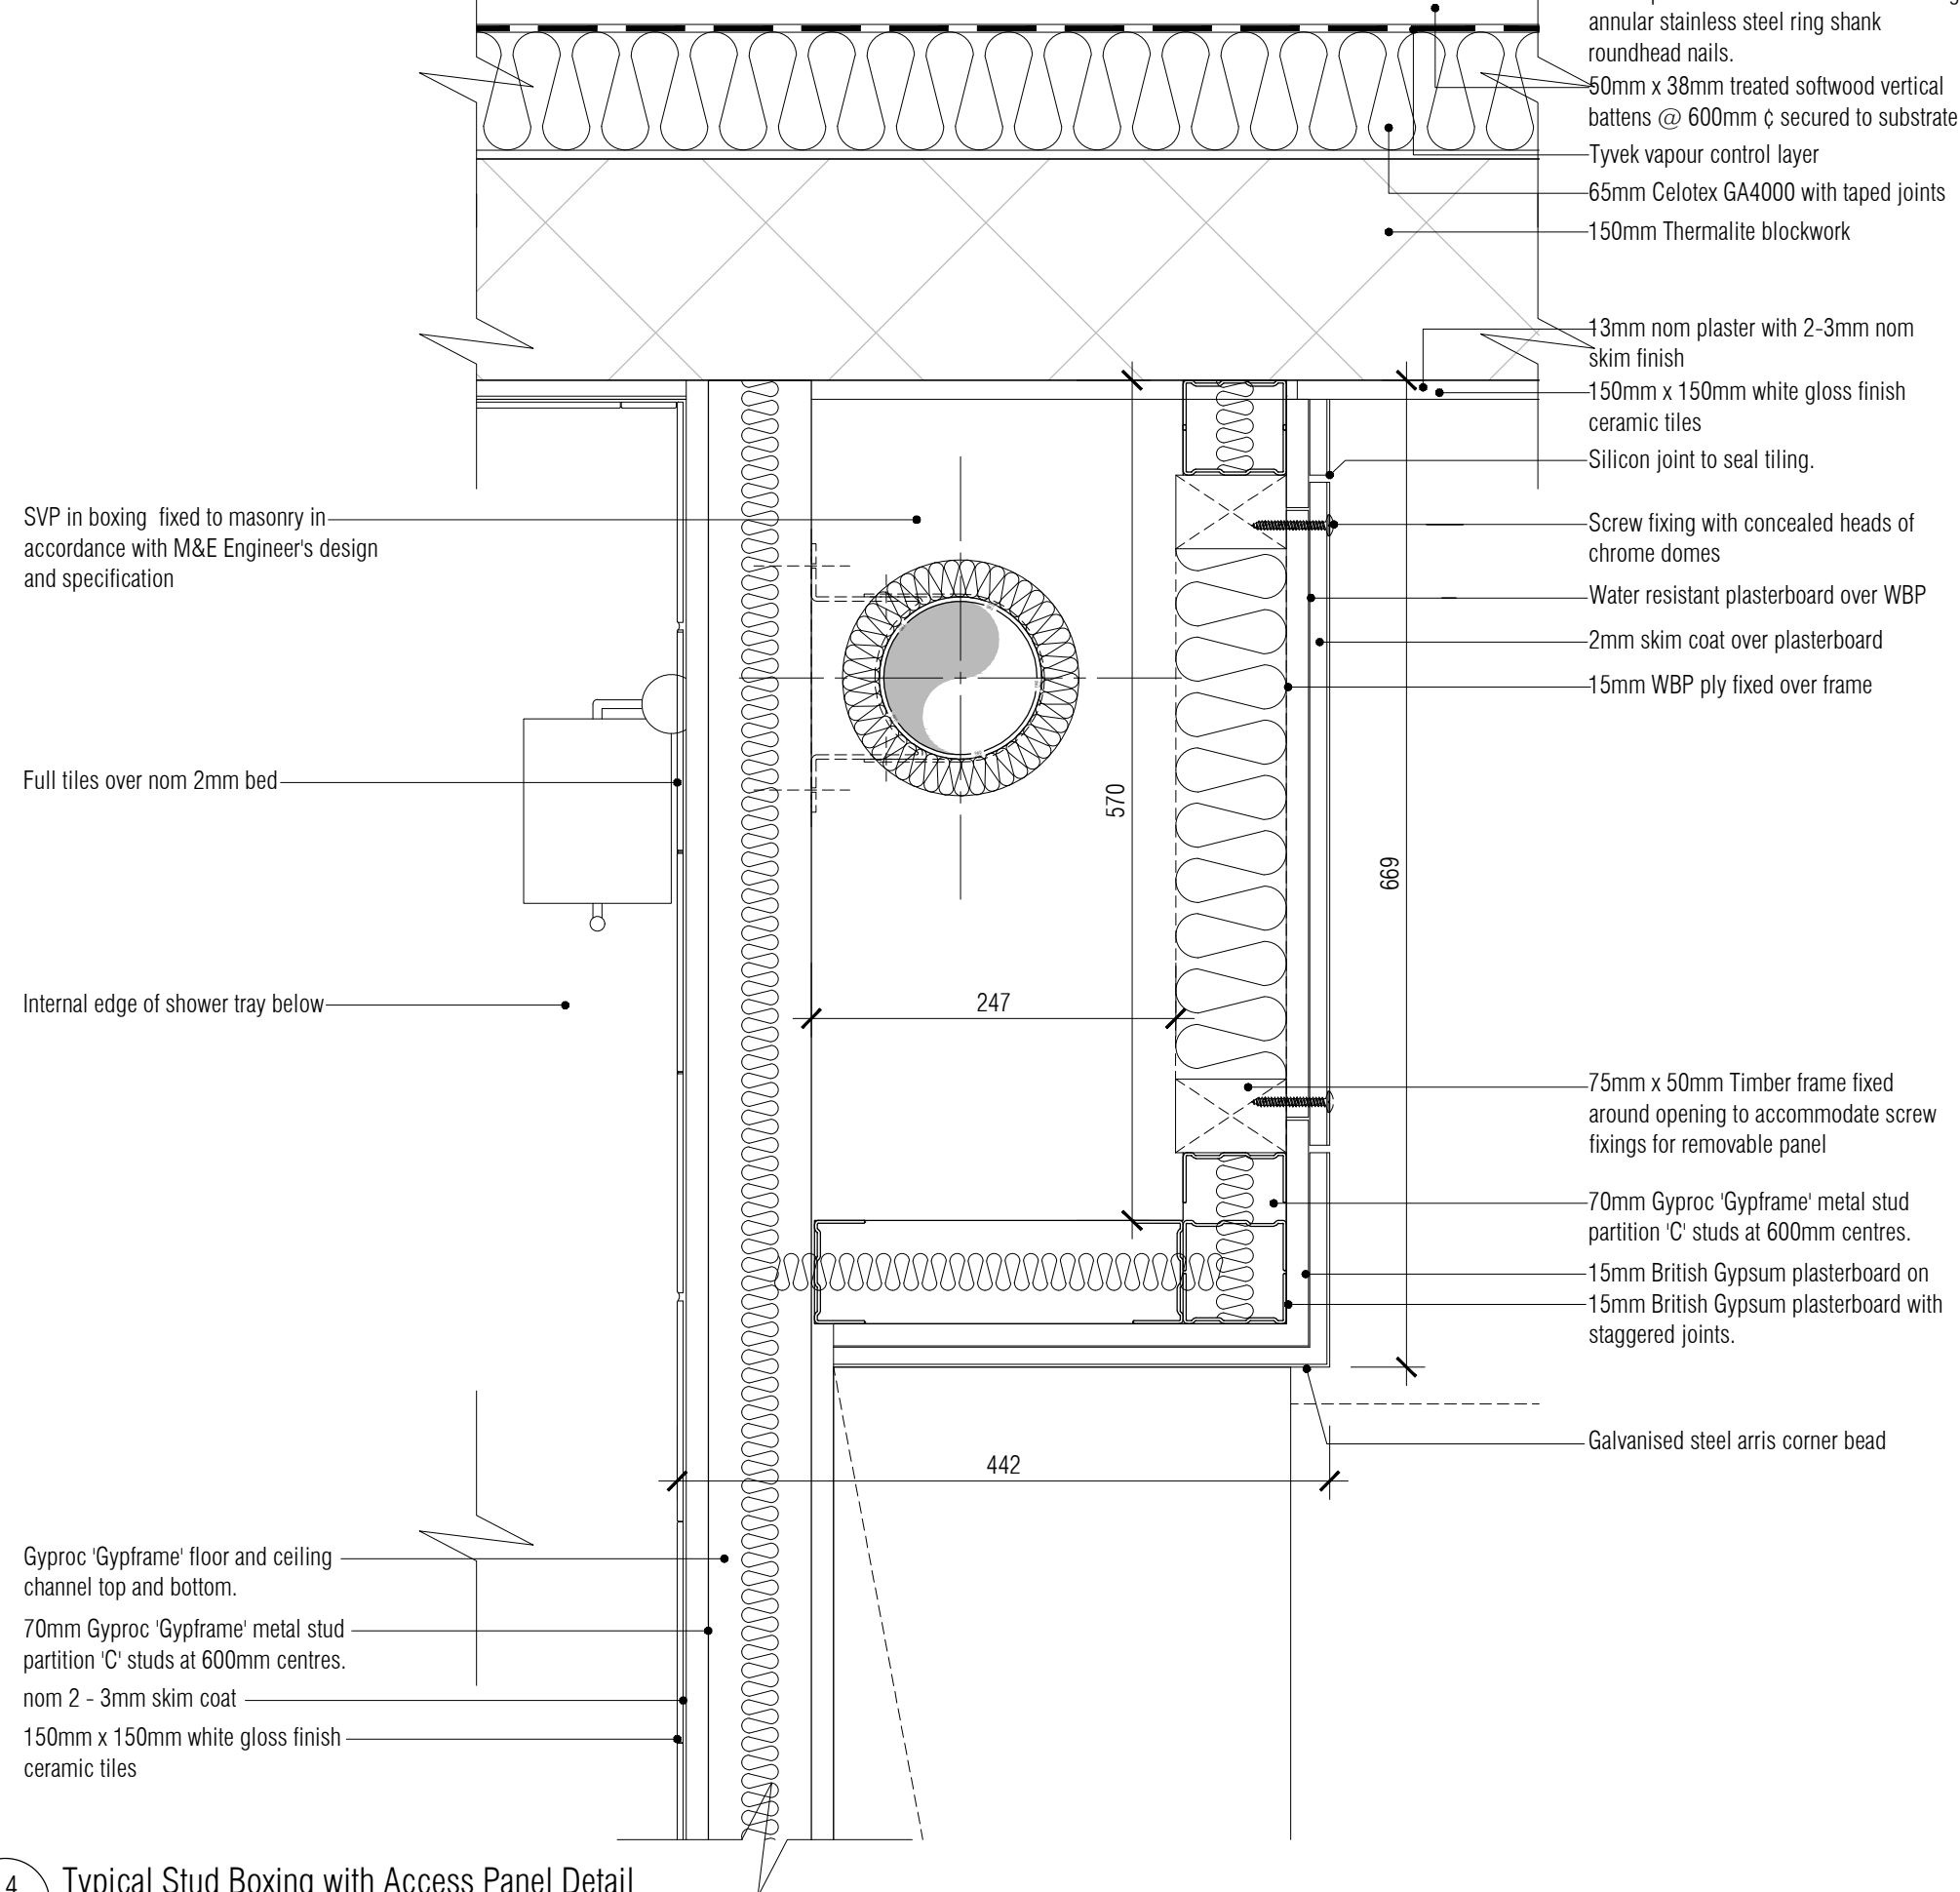

14 Typical Stud Boxing with Access Panel Detail
Scale: 1:5

NOTES: Do not scale this drawing. All dimensions to be checked on site prior to commencement or manufacture.
Key Plan (nts)

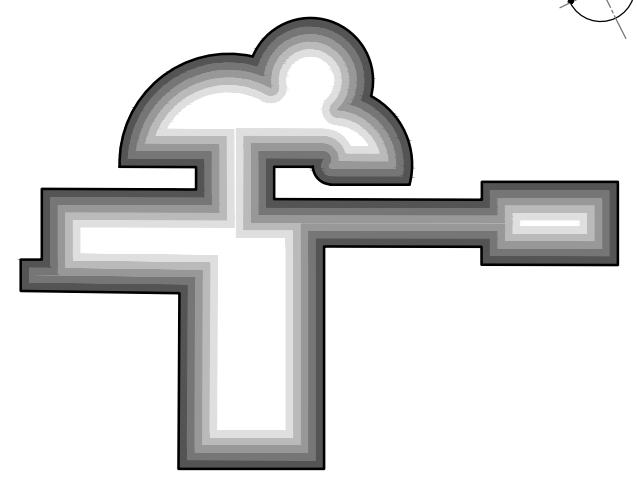

Partition Strategy Key			
WA	WB	WC	WD
WE	WF	WG	WH
WI	WJ	WK	WL
WM	WN	WO	WP
70mm C-Stud & 1 layer 15mm Duraline plasterboard each side - no quilt.			
100mm Thermalite HiStrength 7kN blockwork.			
150mm Thermalite Shield blockwork.			
200mm Thermalite HiStrength 7kN blockwork.			
102.5mm facing brickwork, 35mm cavity, 65mm insulation, 100mm Thermalite Shield blockwork.			
102.5mm facing brickwork, 35mm cavity, 65mm insulation, 100mm Thermalite HiStrength 7kN blockwork.			
100mm Thermalite HiStrength 7kN blockwork, 65mm insulation, 100mm Thermalite Shield blockwork.			
150mm Thermalite Shield blockwork, 65mm insulation, Larch horizontal boarding.			
100mm Thermalite HiStrength 7kN blockwork, 35mm cavity, 65mm insulation.			
70mm C-Stud & 1 layer 15mm Duraline plasterboard - Rockwool quilt.			
80mm insulation, Larch horizontal boarding over existing castellated concrete cladding panel.			
Aluminium double glazing curtain walling with bespoke Larch fins			

ISSUED FOR CONSTRUCTION

Rev	Date	By	Chk	Comment
C2	09.07.12	RKC	JAS	Issued for Construction
P7	19.06.12	RKC	JAS	Cavities rationalised
P6	12.06.12	RKC	JAS	Detail added
P5	01.06.12	RKC	JAS	Cavities widened to suite cladding system & sections
P4	18.05.12	RKC	JAS	Detail revd. Abeyance removed
C1	23.04.12	RKC	JAS	Issued for CONSTRUCTION

BRINGING IDEAS TO LIFE

FRANKHAM

Frankham Consultancy Group Limited
21 Perryman Road
Haywards Heath RH16 3TP
t 01444 444900 f 01444 455642
enquiries@frankham.com
www.frankham.com

Client: Mansell
Contract N°: Worthing

Project Title: Eastbourne & Worthing Crematoria
Refurbishments and Alterations

Drawing Title: Worthing Crematorium
Wall Typical Details

Drawn by: RKC	Scale: 1:5@A1	Date: 31.01.12
Designed by: FCG	Checked by: JAS	Approved by: AC
File Ref.: 521260-A-405-W-0001-121744		20.06.11 12:17:45
Drawing No: 521260-A-405-W		Rev: C2

NB: All information based on supplied third party survey information.
All discrepancies to be reported to FCG immediately upon discovery.

All Disabled and Ambulant Disabled facilities to comply with Approved Document Part M - Access to and use of buildings*, Disability Discrimination Act 1995 and BS83000 as required

20mm Siberian Larch horizontal boarding with exposed face fixed over battens using annular stainless steel ring shank roundhead nails.
50mm x 38mm treated softwood vertical battens @ 600mm c secured to substrate
Tyvek vapour control layer
100mm Thermalite Shield blockwork
65mm Celotex CW4000
15mm British Gypsum plasterboard with staggered joints nom 2 - 3mm skim coat

20mm Siberian Larch horizontal boarding with exposed face fixed over battens using annular stainless steel ring shank roundhead nails.
50mm x 38mm treated softwood vertical battens @ 600mm c secured to substrate
Tyvek vapour control layer
40mm Celotex GA4000 with taped joints
Existing castellated concrete panel (assumed)
Existing masonry (assumed)
Wincro WC36 wall tie starter kit fixed to existing masonry wall with ties at 225mmc vertically in accordance with Structural Engineer's design and specification
Mastic seal with backing bead, joint to have compressible board filler

01 Typical Overcladding & New Clad Wall Detail

Scale: 1:5

100mm Thermalite blockwork
Counter sink fixings and alignment shims in accordance with Structural Engineer's design and specification
13mm nom plaster coating
65mm Celotex GA4000 with taped joints
Tyvek vapour control layer
50mm x 38mm treated softwood vertical battens @ 600mm c secured to substrate
20mm halflap Siberian Larch horizontal boarding with exposed face fixed over battens using annular stainless steel ring shank roundhead nails.
80mm x 50mm horizontal battens @ 600mm c with counter sunk fixings
Existing plaster finish
140mm blockwork (assumed)
92mm cavity
50mm Celotex CW4000 insulation
100mm Thermalite blockwork
Existing castellated concrete panel removed
Existing 25mm plaster finish (assumed)
Existing masonry (assumed)
Existing cavity (assumed)
No insulation (assumed)
Existing 102.5mm facing brickwork, 35mm cavity, 65mm insulation, 100mm Thermalite HiStrength 7kN blockwork.
Existing 100mm Thermalite HiStrength 7kN blockwork, 65mm insulation, Larch horizontal boarding, 65mm insulation, Larch horizontal boarding.
Existing 100mm Thermalite HiStrength 7kN blockwork, 35mm cavity, 65mm insulation.
Existing 100mm Thermalite HiStrength 7kN blockwork, 65mm insulation, Larch horizontal boarding over existing castellated concrete cladding panel.
Existing 100mm Thermalite HiStrength 7kN blockwork, 65mm insulation, Larch horizontal boarding over existing castellated concrete cladding panel.

02 Overcladding/New Clad Wall/External-Internal Wall Conversion Abutment Detail

Scale: 1:5

Painted finish
100mm Thermalite blockwork
65mm Celotex CW4000
77mm cavity
100mm Thermalite blockwork
13mm plaster
Wincro WC36 wall tie starter kit fixed to existing column with ties at 225mmc vertically in accordance with Structural Engineer's design and specification
Existing column
Existing castellated concrete panel removed
Line of existing channel over
Existing plaster finish
140mm blockwork (assumed)
92mm cavity
50mm Celotex CW4000 insulation
100mm Thermalite blockwork
Existing castellated concrete panel removed
Line of existing channel over
Flush face of plasterboard over metal stud wall and channel over
70mm metal stud wall external face flush to channel over to allow flush face of plasterboard over
Line of existing channel over
140mm blockwork (assumed)
Existing plaster finish

03 New Cavity Wall/External-Internal Wall Conversion Abutment Detail

Scale: 1:5


NB: All information based on supplied third party survey information.
All discrepancies to be reported to FCG immediately upon discovery.

New polycarbonate roof fixed to new structure
85mm Celotex TA 5000 to gutter
Single ply roofing membrane dressed up wall 150mm minimum, with lead flashing over
120mm EL3000 Celotex insulation on 18mm WBP on timber firrings
200x64 C24 rafters on hangers. See structural engineers details.
150mm Thermalite Shield blockwork
Horizontal larch timber cladding. Counter sink fixings and alignment shims in accordance with Structural Engineer's design and specification
65mm Celotex GA4000 with taped joints
20mm wide compressible filler. See Structural Engineers drawings
RC slab bearing on foundation. See Structural Engineers drawings for details
102.5mm Engineering brick splash plinths. See Structural Engineers drawings for details
New polycarbonate roof fixed to existing structure
Existing flashing to be removed and replaced with prefabricated polyester powder coated flashing to lap over new cladding and lapped up to window cill
Horizontal larch timber cladding. Counter sink fixings and alignment shims in accordance with Structural Engineer's design and specification
65mm Celotex GA4000 with taped joints
Existing 102.5mm facing brickwork, 35mm cavity, 65mm insulation, 100mm Thermalite HiStrength 7kN blockwork.
Existing 100mm Thermalite HiStrength 7kN blockwork, 65mm insulation, Larch horizontal boarding, 65mm insulation, Larch horizontal boarding.
Existing 100mm Thermalite HiStrength 7kN blockwork, 35mm cavity, 65mm insulation.
Existing 100mm Thermalite HiStrength 7kN blockwork, 65mm insulation, Larch horizontal boarding over existing castellated concrete cladding panel.
Existing 100mm Thermalite HiStrength 7kN blockwork, 65mm insulation, Larch horizontal boarding over existing castellated concrete cladding panel.

04 Covered Courtyard Section

Scale: 1:20

NOTES: Do not scale this drawing. All dimensions to be checked on site prior to commencement or manufacture.
Key Plan (nts)

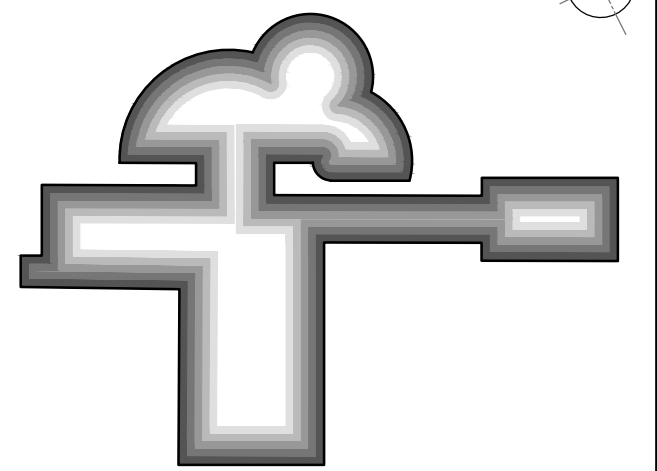

Partition Strategy Key

WA 70mm C-Stud & 1 layer 15mm Duraline plasterboard each side - no quilt.
WB 70mm C-Stud & 1 layer 15mm Duraline plasterboard each side - 25mm quilt.
WC 100mm Thermalite Shield blockwork.
WD 100mm Thermalite HiStrength 7kN blockwork.
WE 150mm Thermalite Shield blockwork.
WF 200mm Thermalite HiStrength 7kN blockwork.
WG 102.5mm facing brickwork, 35mm cavity, 65mm insulation, 100mm Thermalite Shield blockwork.
WH 102.5mm facing brickwork, 35mm cavity, 65mm insulation, 100mm Thermalite HiStrength 7kN blockwork.
WI 100mm Thermalite HiStrength 7kN blockwork, 65mm insulation, Larch horizontal boarding, 65mm insulation, Larch horizontal boarding.
WJ 100mm Thermalite HiStrength 7kN blockwork, 65mm insulation, Larch horizontal boarding, 65mm insulation, Larch horizontal boarding.
WK 150mm Thermalite Shield blockwork, 65mm insulation, Larch horizontal boarding.
WL 100mm Thermalite HiStrength 7kN blockwork, 35mm cavity, 65mm insulation.
WM 100mm Thermalite HiStrength 7kN blockwork, 65mm insulation, Larch horizontal boarding over existing castellated concrete cladding panel.
WN 100mm Thermalite HiStrength 7kN blockwork, 65mm insulation, Larch horizontal boarding over existing castellated concrete cladding panel.
WO 80mm insulation, Larch horizontal boarding over existing castellated concrete cladding panel.
WP Aluminium double glazing curtain walling with bespoke Larch fins

ISSUED FOR CONSTRUCTION

All details referenced in call outs supersede general arrangement or larger depictions.

Rev	Date	By	Chk	Comment
C3	09.07.12	RKC	JAS	Issued for Construction
P4	12.06.12	RKC	JAS	Existing frame added. Detail revd.
P3	01.06.12	RKC	JAS	Cavities widened to suit cladding system and sections
P2	25.05.12	RKC	JAS	Section added.
C2	18.05.12	RKC	JAS	Insulation revd.
C1	23.04.12	RKC	JAS	Issued for CONSTRUCTION

BRINGING IDEAS TO LIFE



FRANKHAM

Frankham Consultancy Group Limited
21 Perryman Road
Haywards Heath RH16 3TP
t 01444 444900 f 01444 455642
enquire@frankham.com
www.frankham.com

Client
Mansell
Contract N°: Worthing

Project Title
Eastbourne & Worthing
Crematoria
Refurbishments and Alterations


Drawing Title
Worthing Crematorium
Wall Typical Details

Drawn by: RKC	Scale: 1:5@A1	Date: 31.01.12
Designed by: FCG	Checked by: JAS	Approved by: AC


File Ref.: 317350-A-406-W-006 - 200611121752 20.06.11.12.17.52

Drawing No. 521260-A-406-W	Rev. C3
-------------------------------	------------


All partition information, details and specifications subject to confirmation by Drywall Contractor and are to be in accordance with Manufacturers design and instructions. Architect to be notified immediately upon discovery of variation to the details shown.

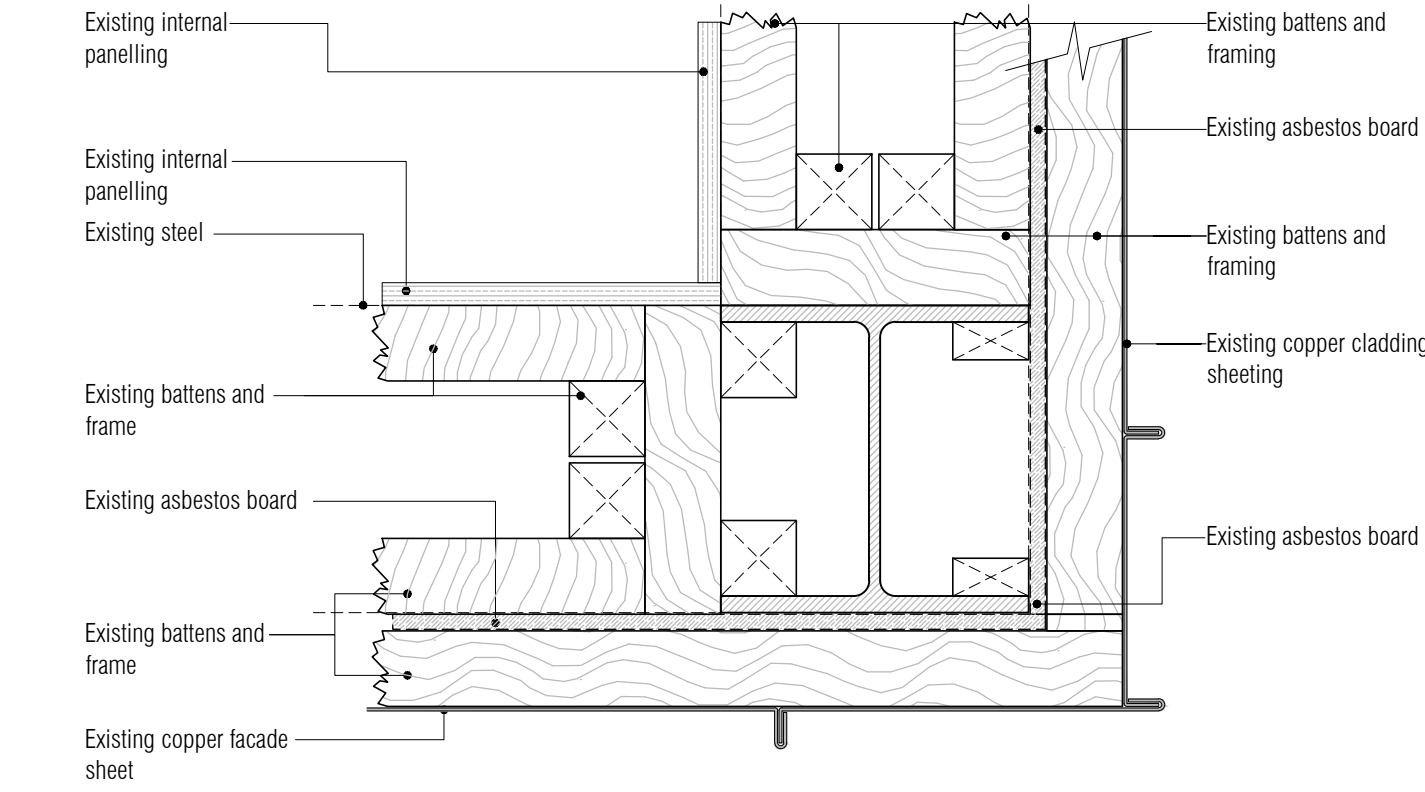

01 Existing Cladding Plan Detail
Scale: 1:5

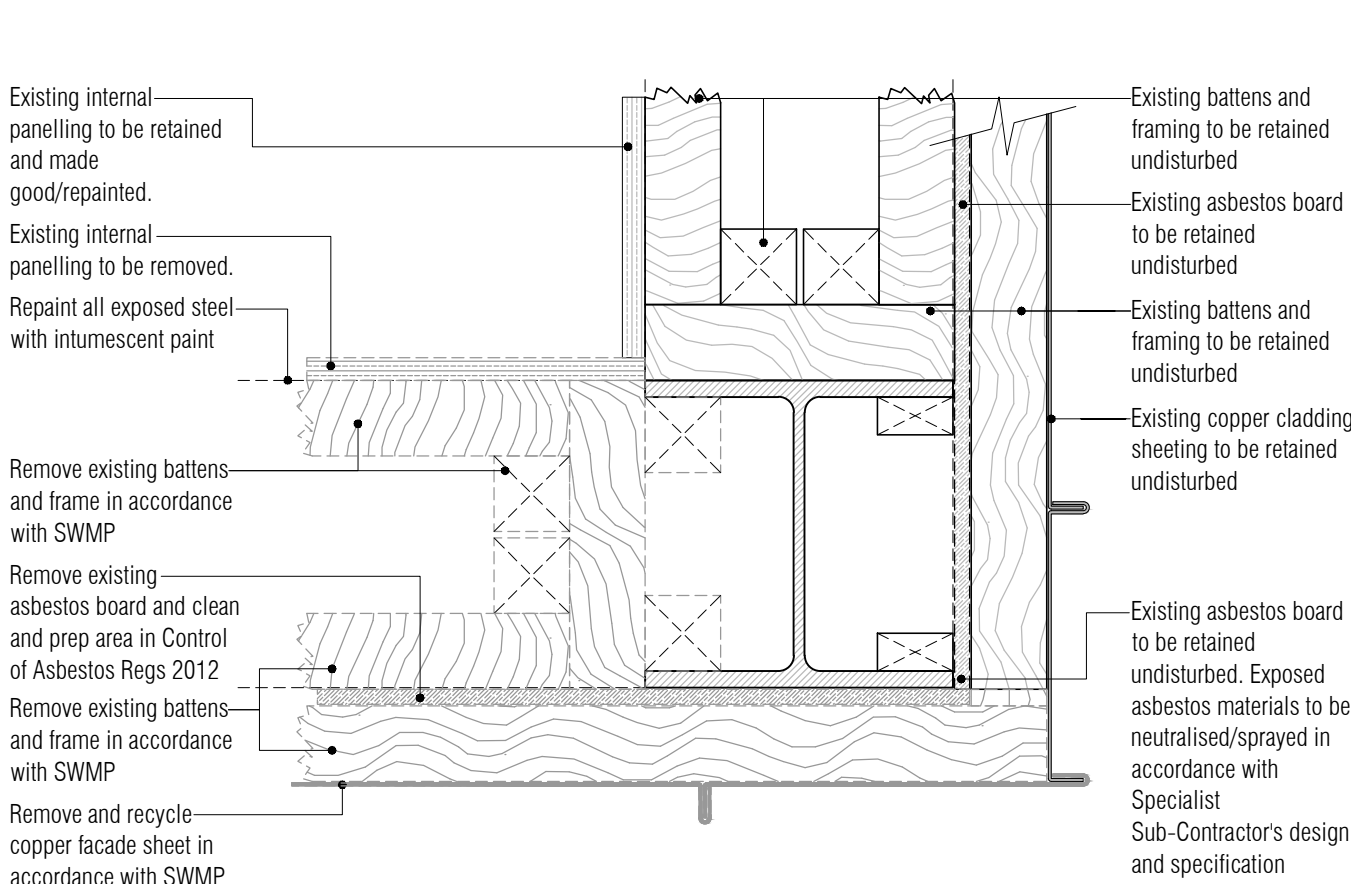

02 Cladding Demolition Plan Detail
Scale: 1:5

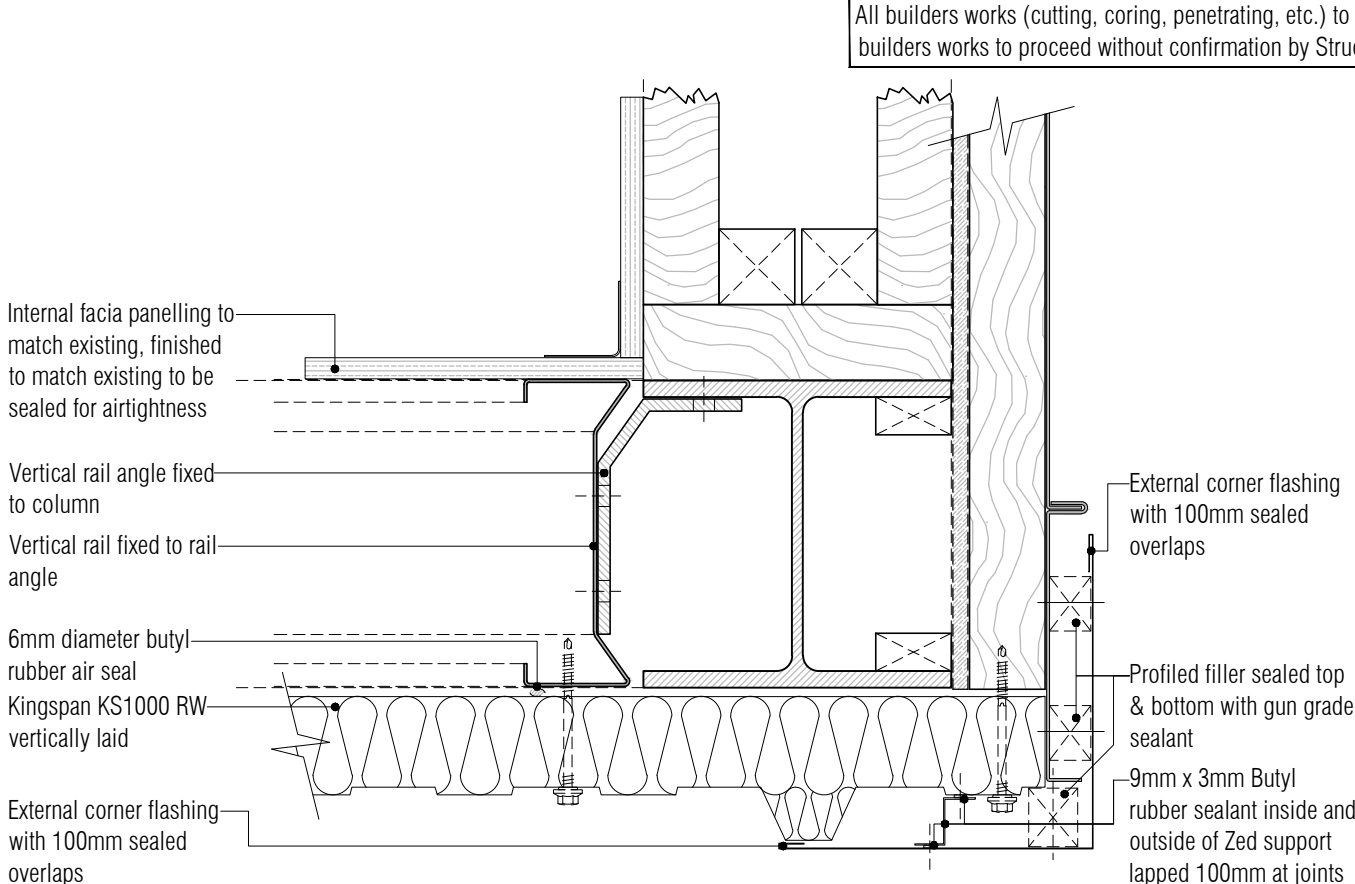


03 New Cladding Plan Detail
Scale: 1:5

All builders works (cutting, coring, penetrating, etc.) to be in accordance with M&E Engineers dwgs. No builders works to proceed without confirmation by Structural Engineer to maintain integrity of structure.

NB: All levels are approximate and are subject to further site investigation prior to construction. All discrepancies to be reported to FCG immediately

NOTES: Do not scale this drawing. All dimensions to be checked on site prior to commencement or manufacture.
Key Plan (nts)

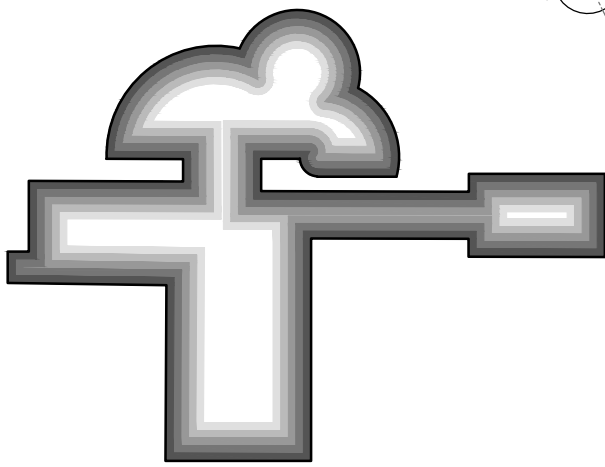

PRELIMINARY
ISSUE

All details referenced in call outs supercede general arrangement or larger depictions.

Rev	Date	By	Chk	Comment
P1	10.07.12	RKC	JAS	Issued for Information

BRINGING IDEAS TO LIFE



FRANKHAM

Frankham Consultancy Group Limited
21 Perrymount Road
Haywards Heath RH16 3TP
t 01444 444900 f 01444 455642
enquire@frankham.com
www.frankham.com

Client


Contract N°: Worthing

Project Title

Eastbourne & Worthing
Crematoria
Refurbishments and Alterations

Drawing Title


Worthing Crematorium
Special Wall Typical Details

Drawn by: RKC	Scale: 1:5@A1	Date: 10.07.12
Designed by: FCG	Checked by: JAS	Approved by: AC

File Ref.: X:\FRANKHAM\2_080512180 CREMATORIA\WORTHING 400 DETAIL COORDINATES 521260-A-407-W-0001 - 200811121753 20.06.11 12:17:57

Drawing No. 521260-A-407-W	Rev. P1
-------------------------------	------------

NB: All information based on supplied third party survey information.
All discrepancies to be reported to FCG immediately upon discovery.


NB: Contractor to fully investigate and determine load bearing capacity of all building elements and materials and consult with Architect and Structural Engineer prior to commencement of demolition works. All discrepancies to be reported to FCG immediately upon discovery.

All Mechanical & Electrical and Structural information shown indicative only.
Please refer to Mechanical & Electrical and Structural documentation.


NB: All waste to be recycled where possible and/or disposed of in accordance with the Contractor's Site Waste Management Plan and all in accordance with current legislation, particularly, but not excluding, all hazardous materials

All Disabled and Ambulant Disabled facilities to comply with Approved Document Part M - 'Access to and use of buildings', Disability Discrimination Act 1995 and BS83000 as required

NB: All levels are approximate and are subject to further site investigation prior to construction. All discrepancies to be reported to FCG immediately

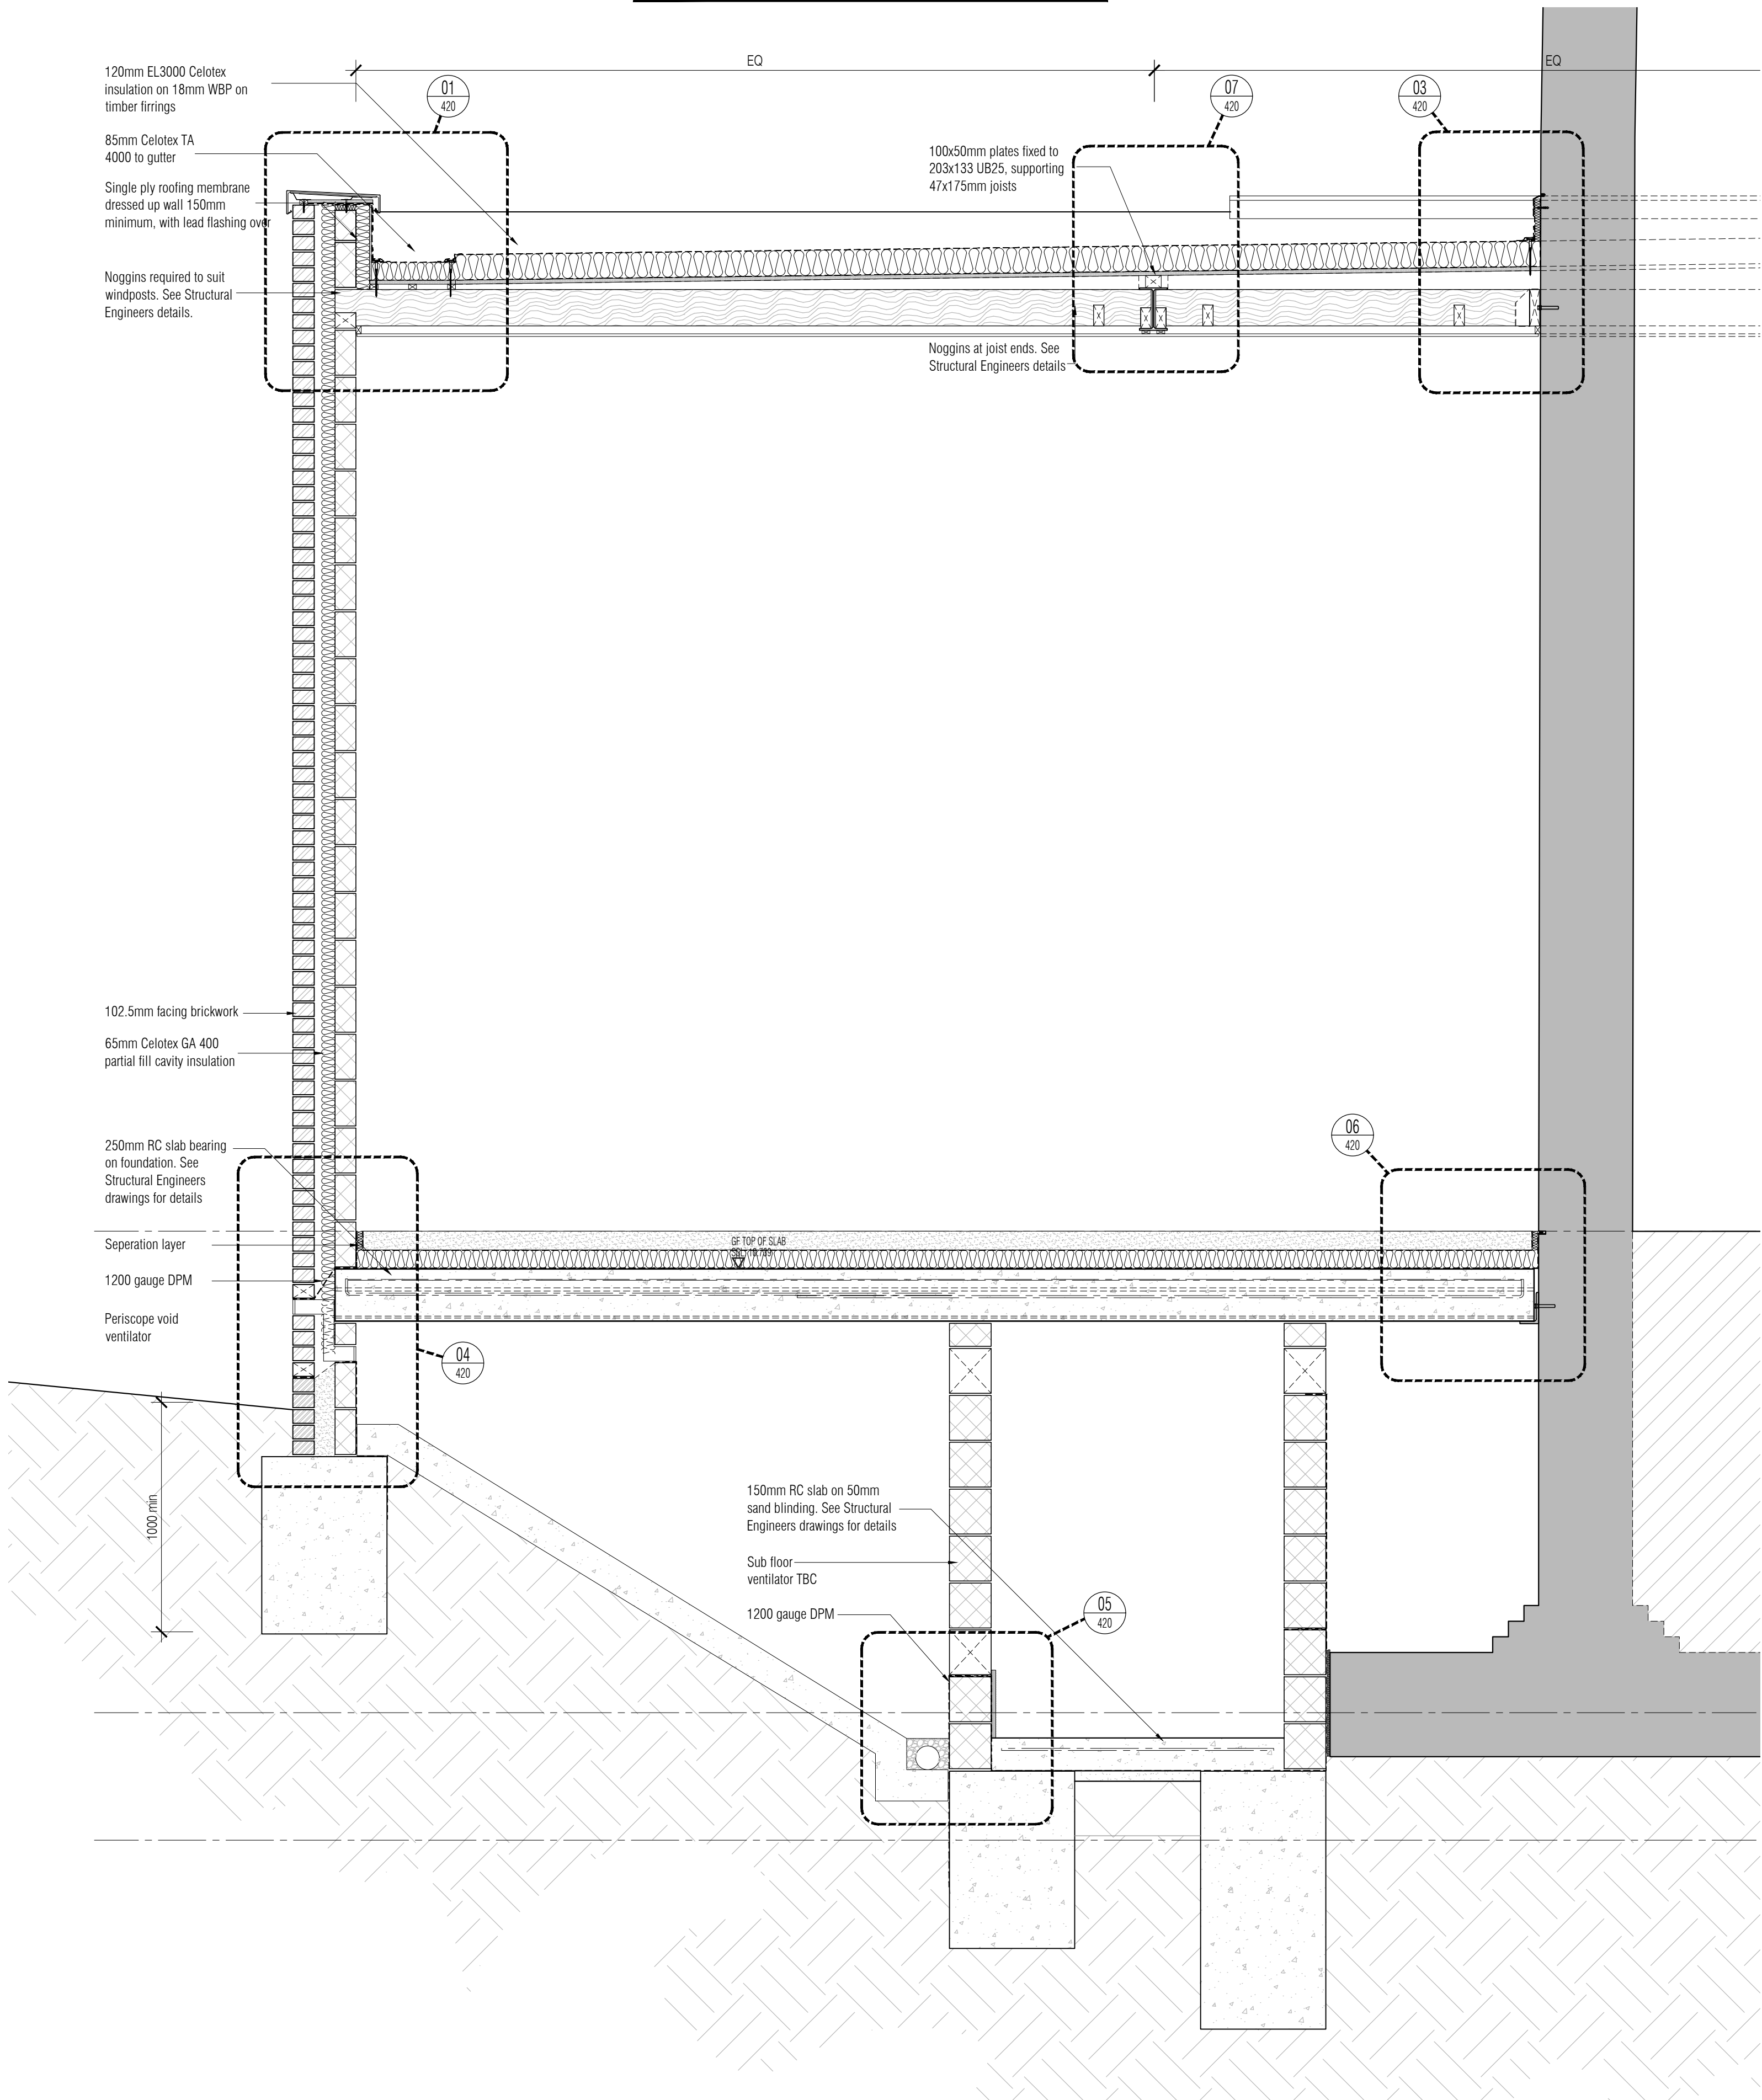


01 Detail Section A Through Cremator Extension
Scale: 1:20

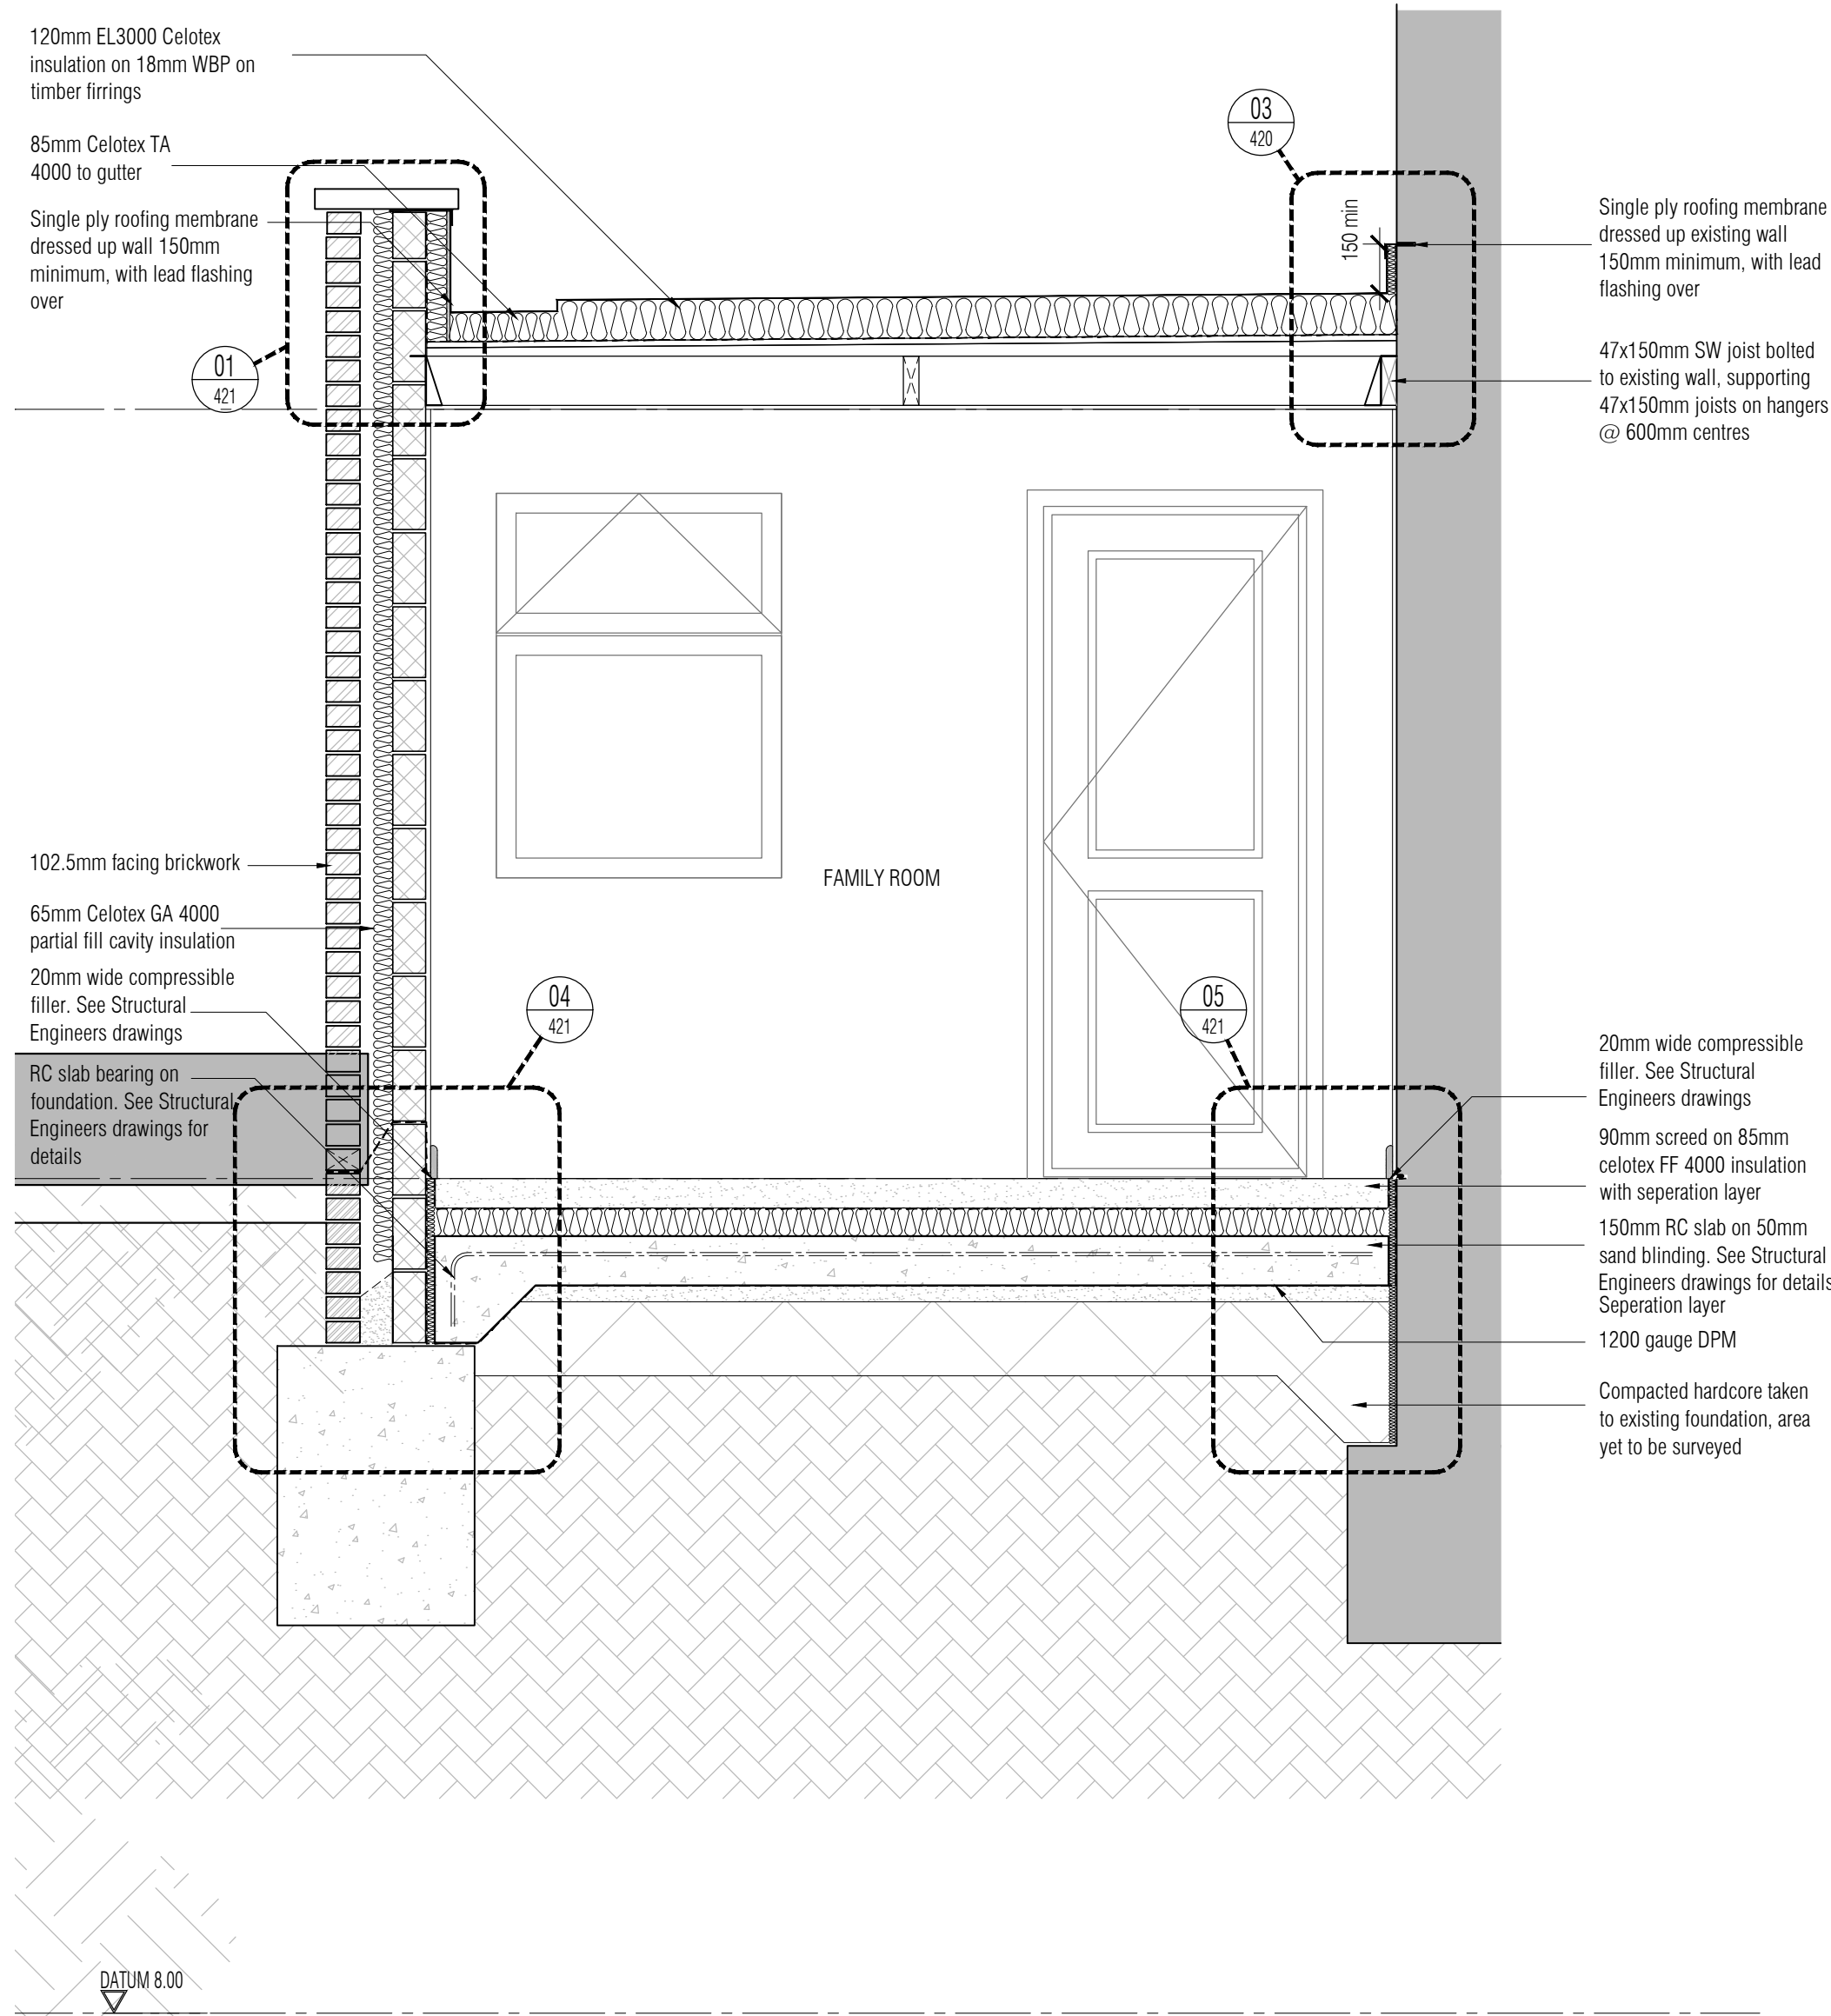

02 Detail Section D Through Family Room Extension
Scale: 1:20

NOTES: Do not scale this drawing. All dimensions to be checked on site prior to commencement or manufacture.
Key Plan (nts)

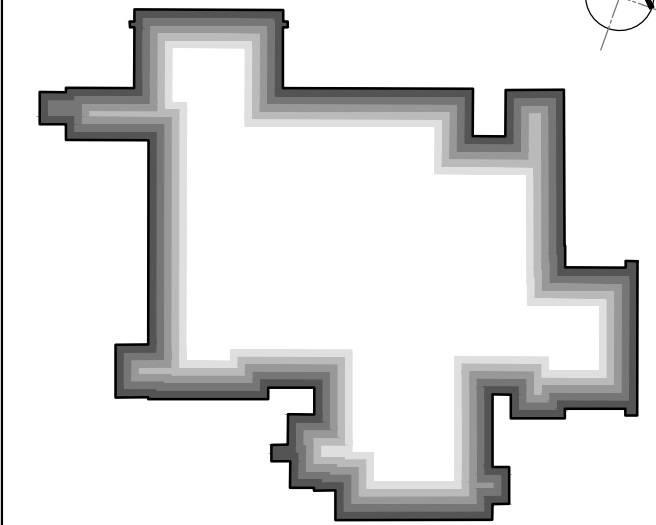

ISSUED FOR CONSTRUCTION

All details referenced in call outs supercede general arrangement or larger depictions.

Rev	Date	By	Chk	Comment
C2	05.07.12	RKC	JAS	Exp Chimney Foundns Revd. Resident Room Revd
C1	29.03.12	RKC	JAS	Issued for CONSTRUCTION

BRINGING IDEAS TO LIFE



FRANKHAM

Frankham Consultancy Group Limited
21 Perryman Road
Haywards Heath RH16 3TP
t 01444 444900 f 01444 455642
enquiries@frankham.com
www.frankham.com

Client	 Mansell Contract N°: MC0269
--------	------------------------------------

Project Title	Eastbourne & Worthing Crematoria Refurbishments and Alterations
---------------	---


Drawing Title	 Eastbourne Crematorium Detail Sections A & D
---------------	---

Drawn by:	Scale:	Date:
RKC	1:20@A1	27.01.12
Designed by:	Checked by:	Approved by:
FCG	JAS	AC

File Ref.: X:\FRANKHAM\2_080512180 CREMATORIA\WORKBOOK 400 DETAIL COORDINATES
307380-A-410-0300 - 200611171801 20.06.11.12.18.02

Drawing No.	Rev.
521260-A-410-E	C2


NB: All information based on supplied third party survey information.
All discrepancies to be reported to FCG immediately upon discovery.

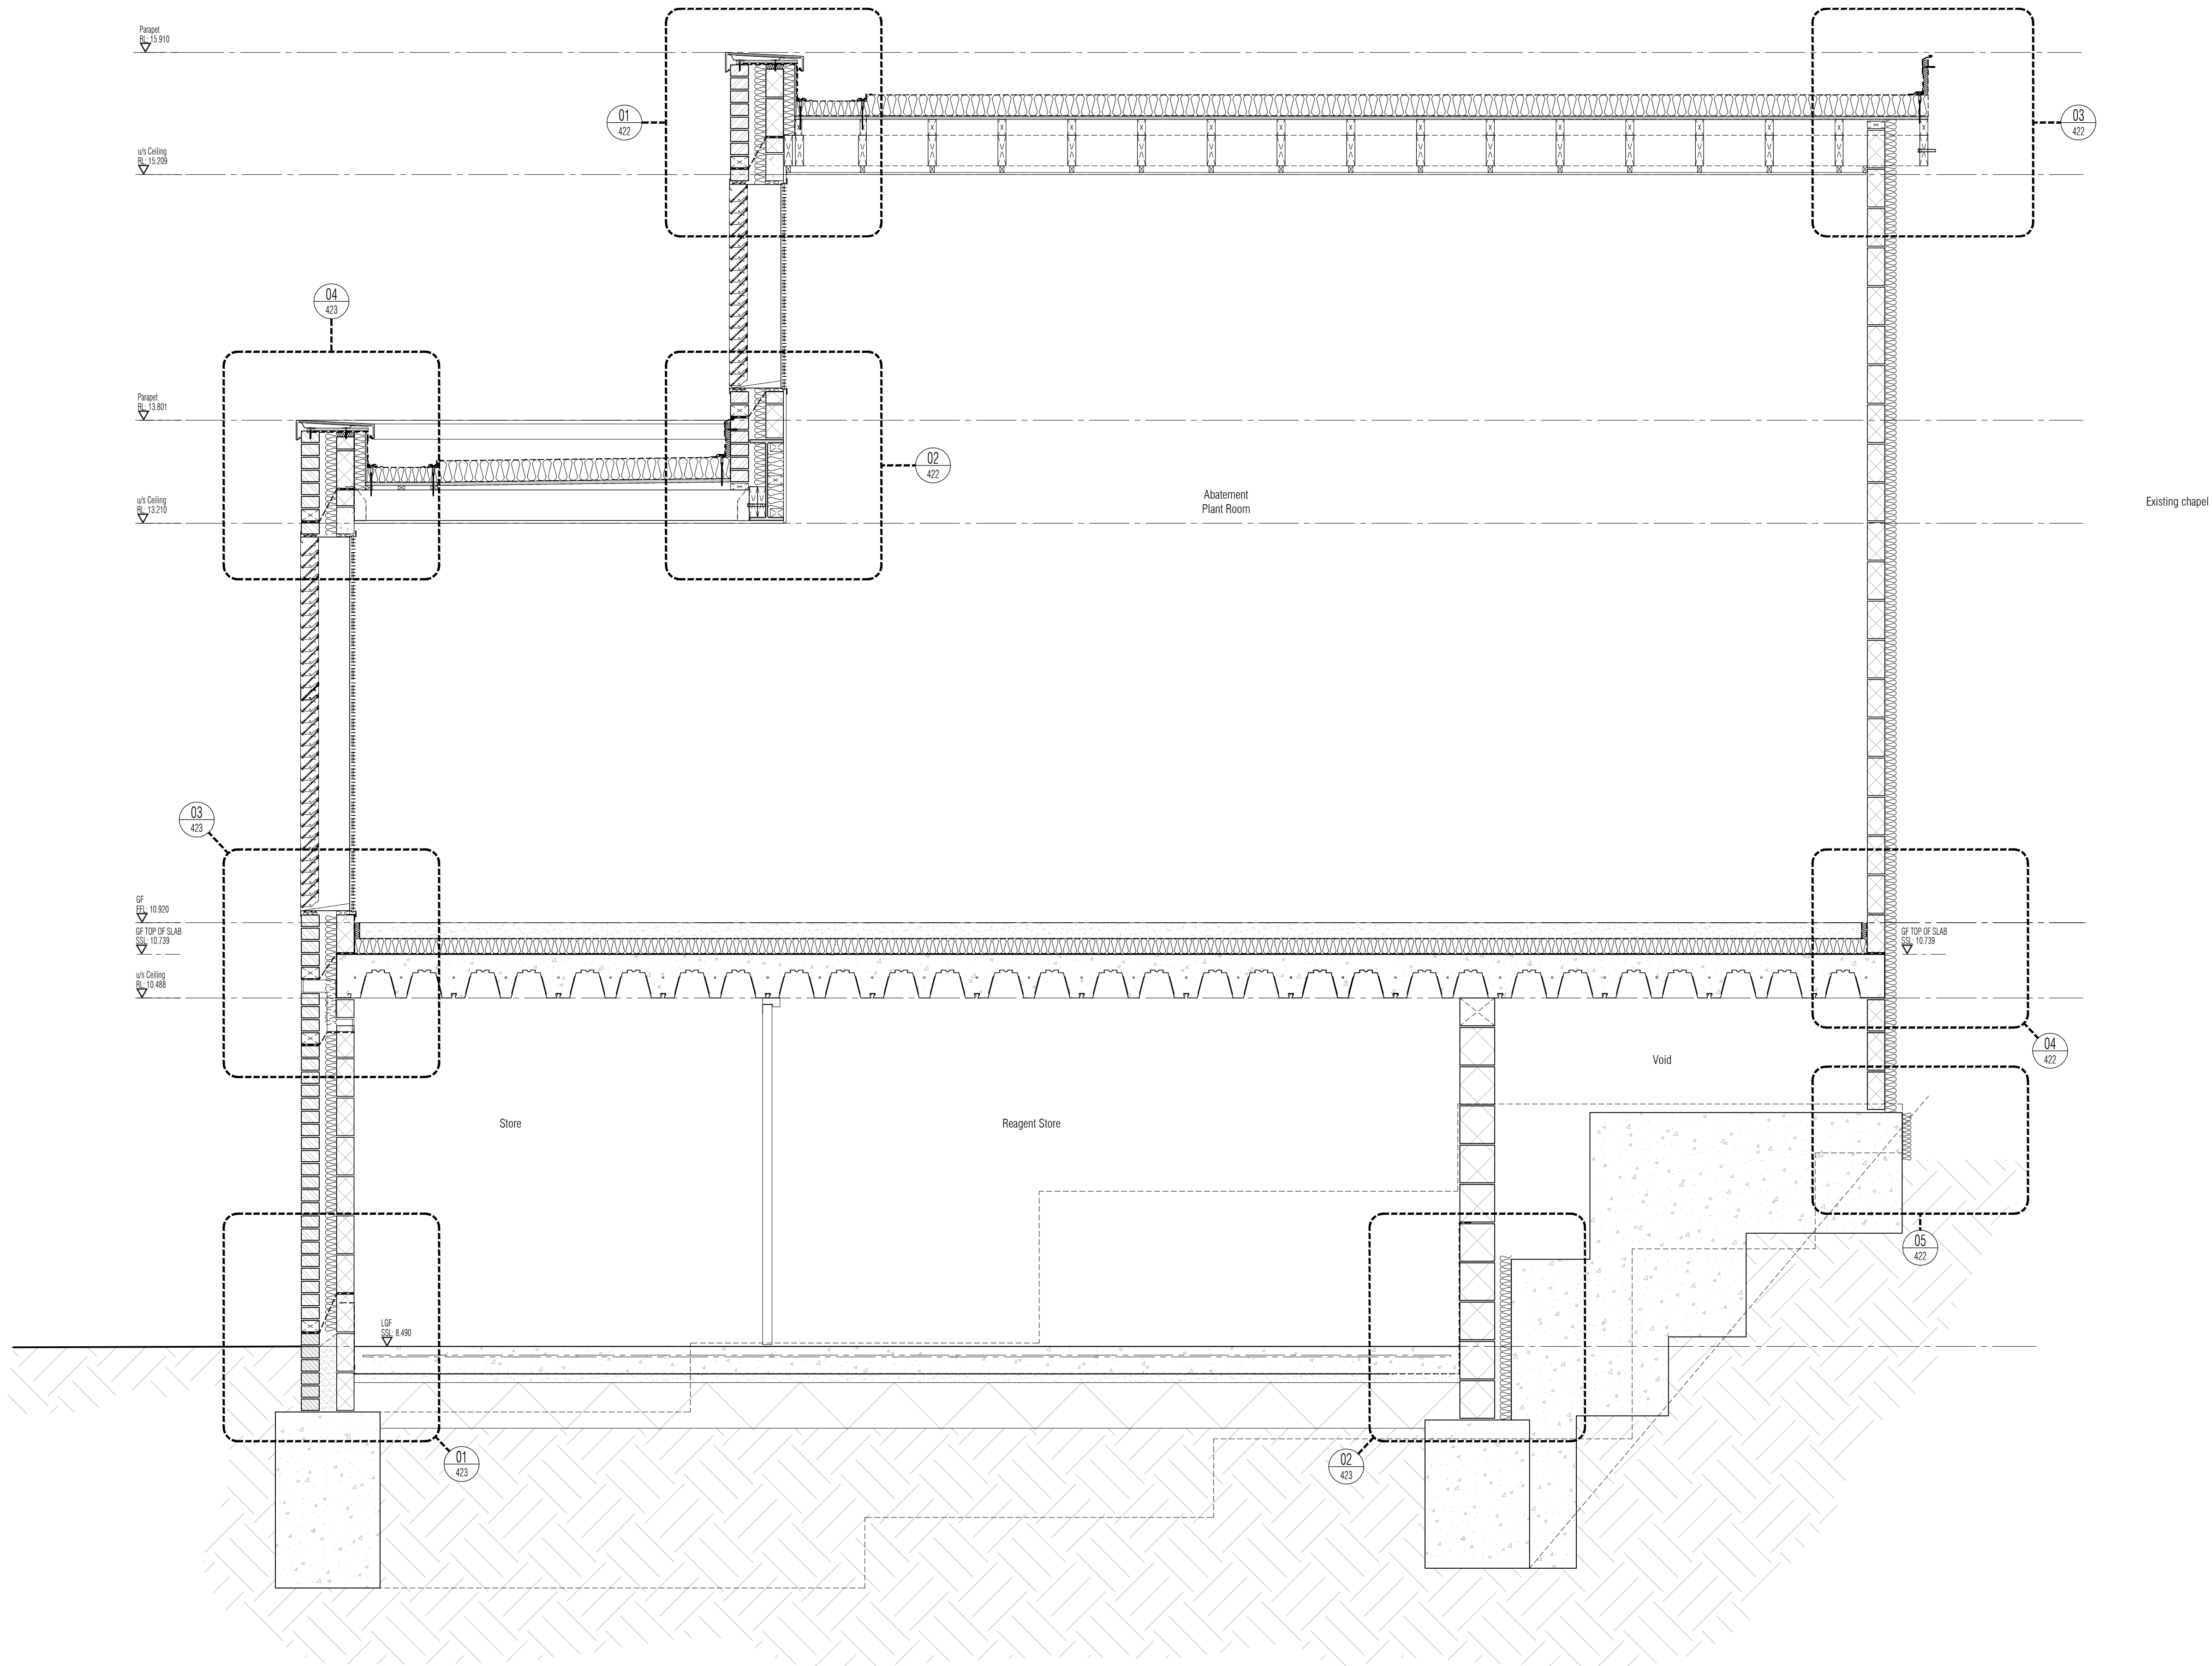

01 Section C
Scale: 1:20

NB: All information based on supplied third party survey information.
All discrepancies to be reported to FCG immediately upon discovery.

NOTES: Do not scale this drawing. All dimensions to be checked on site prior to commencement or manufacture.
Key Plan (nts)

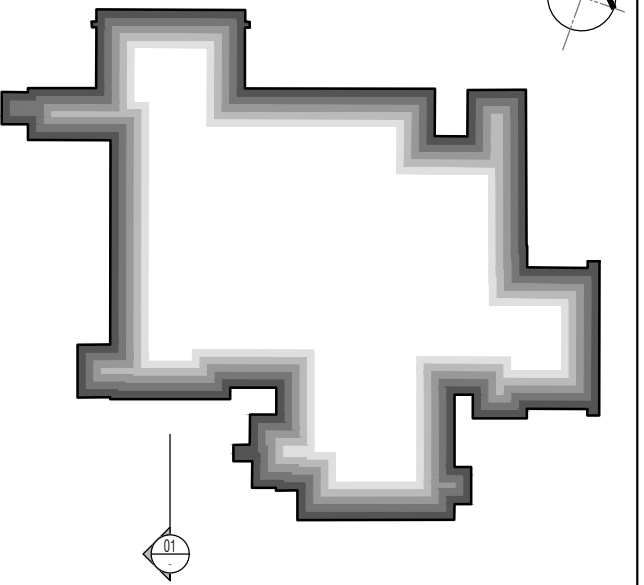

ISSUED FOR
CONSTRUCTION

All details referenced in call outs supersede general arrangement or larger depictions.

Rev	Date	By	CHK	Comment
C2	05.07.12	RKC	JAS	reagent room revd
C1	29.03.12	RKC	JAS	Issued for CONSTRUCTION

BRINGING IDEAS TO LIFE



FRANKHAM

Frankham Consultancy Group Limited
21 Perrymount Road
Haywards Heath RH16 3TP
t 01444 444900 f 01444 455642
enquiries@frankham.com
www.frankham.com

Client

Mansell
Contract N°: MC0269

Project Title

Eastbourne & Worthing
Crematoria
Refurbishments and Alterations


Drawing Title

EASTBOURNE
Eastbourne Crematorium
Proposed Sections C

Drawn by: RKC	Scale: 1:20 @ A1	Date: 15.03.12
Designed by: FCG	Checked by: JAS	Approved by: AC



File Ref.: X:\FRANKHAM\2_080512180 CREMATORIA\ARCHIVE\409-0216L-COMM-001
307380-A-411-E-000 - 200611171803 20.06.11.12.18.06

Drawing No. 521260-A-411-E	Rev. C2
-------------------------------	------------

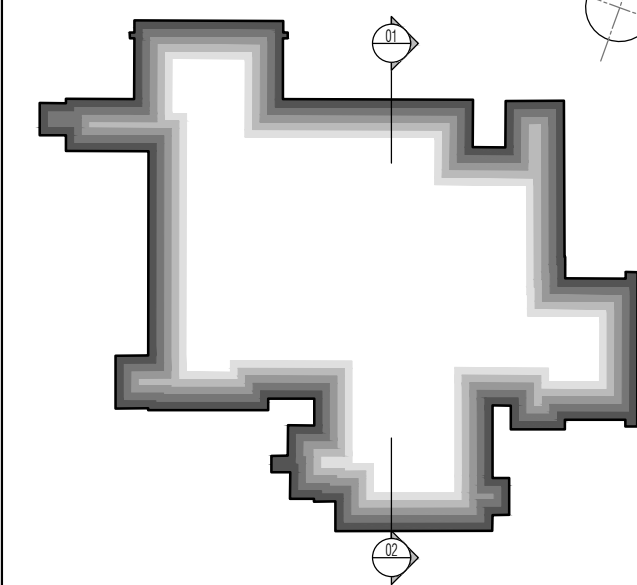


Drawing No. 521260-A-412-E	Rev. P4
-------------------------------	------------

NB: All information based on supplied third party survey information.
All discrepancies to be reported to FCG immediately upon discovery.

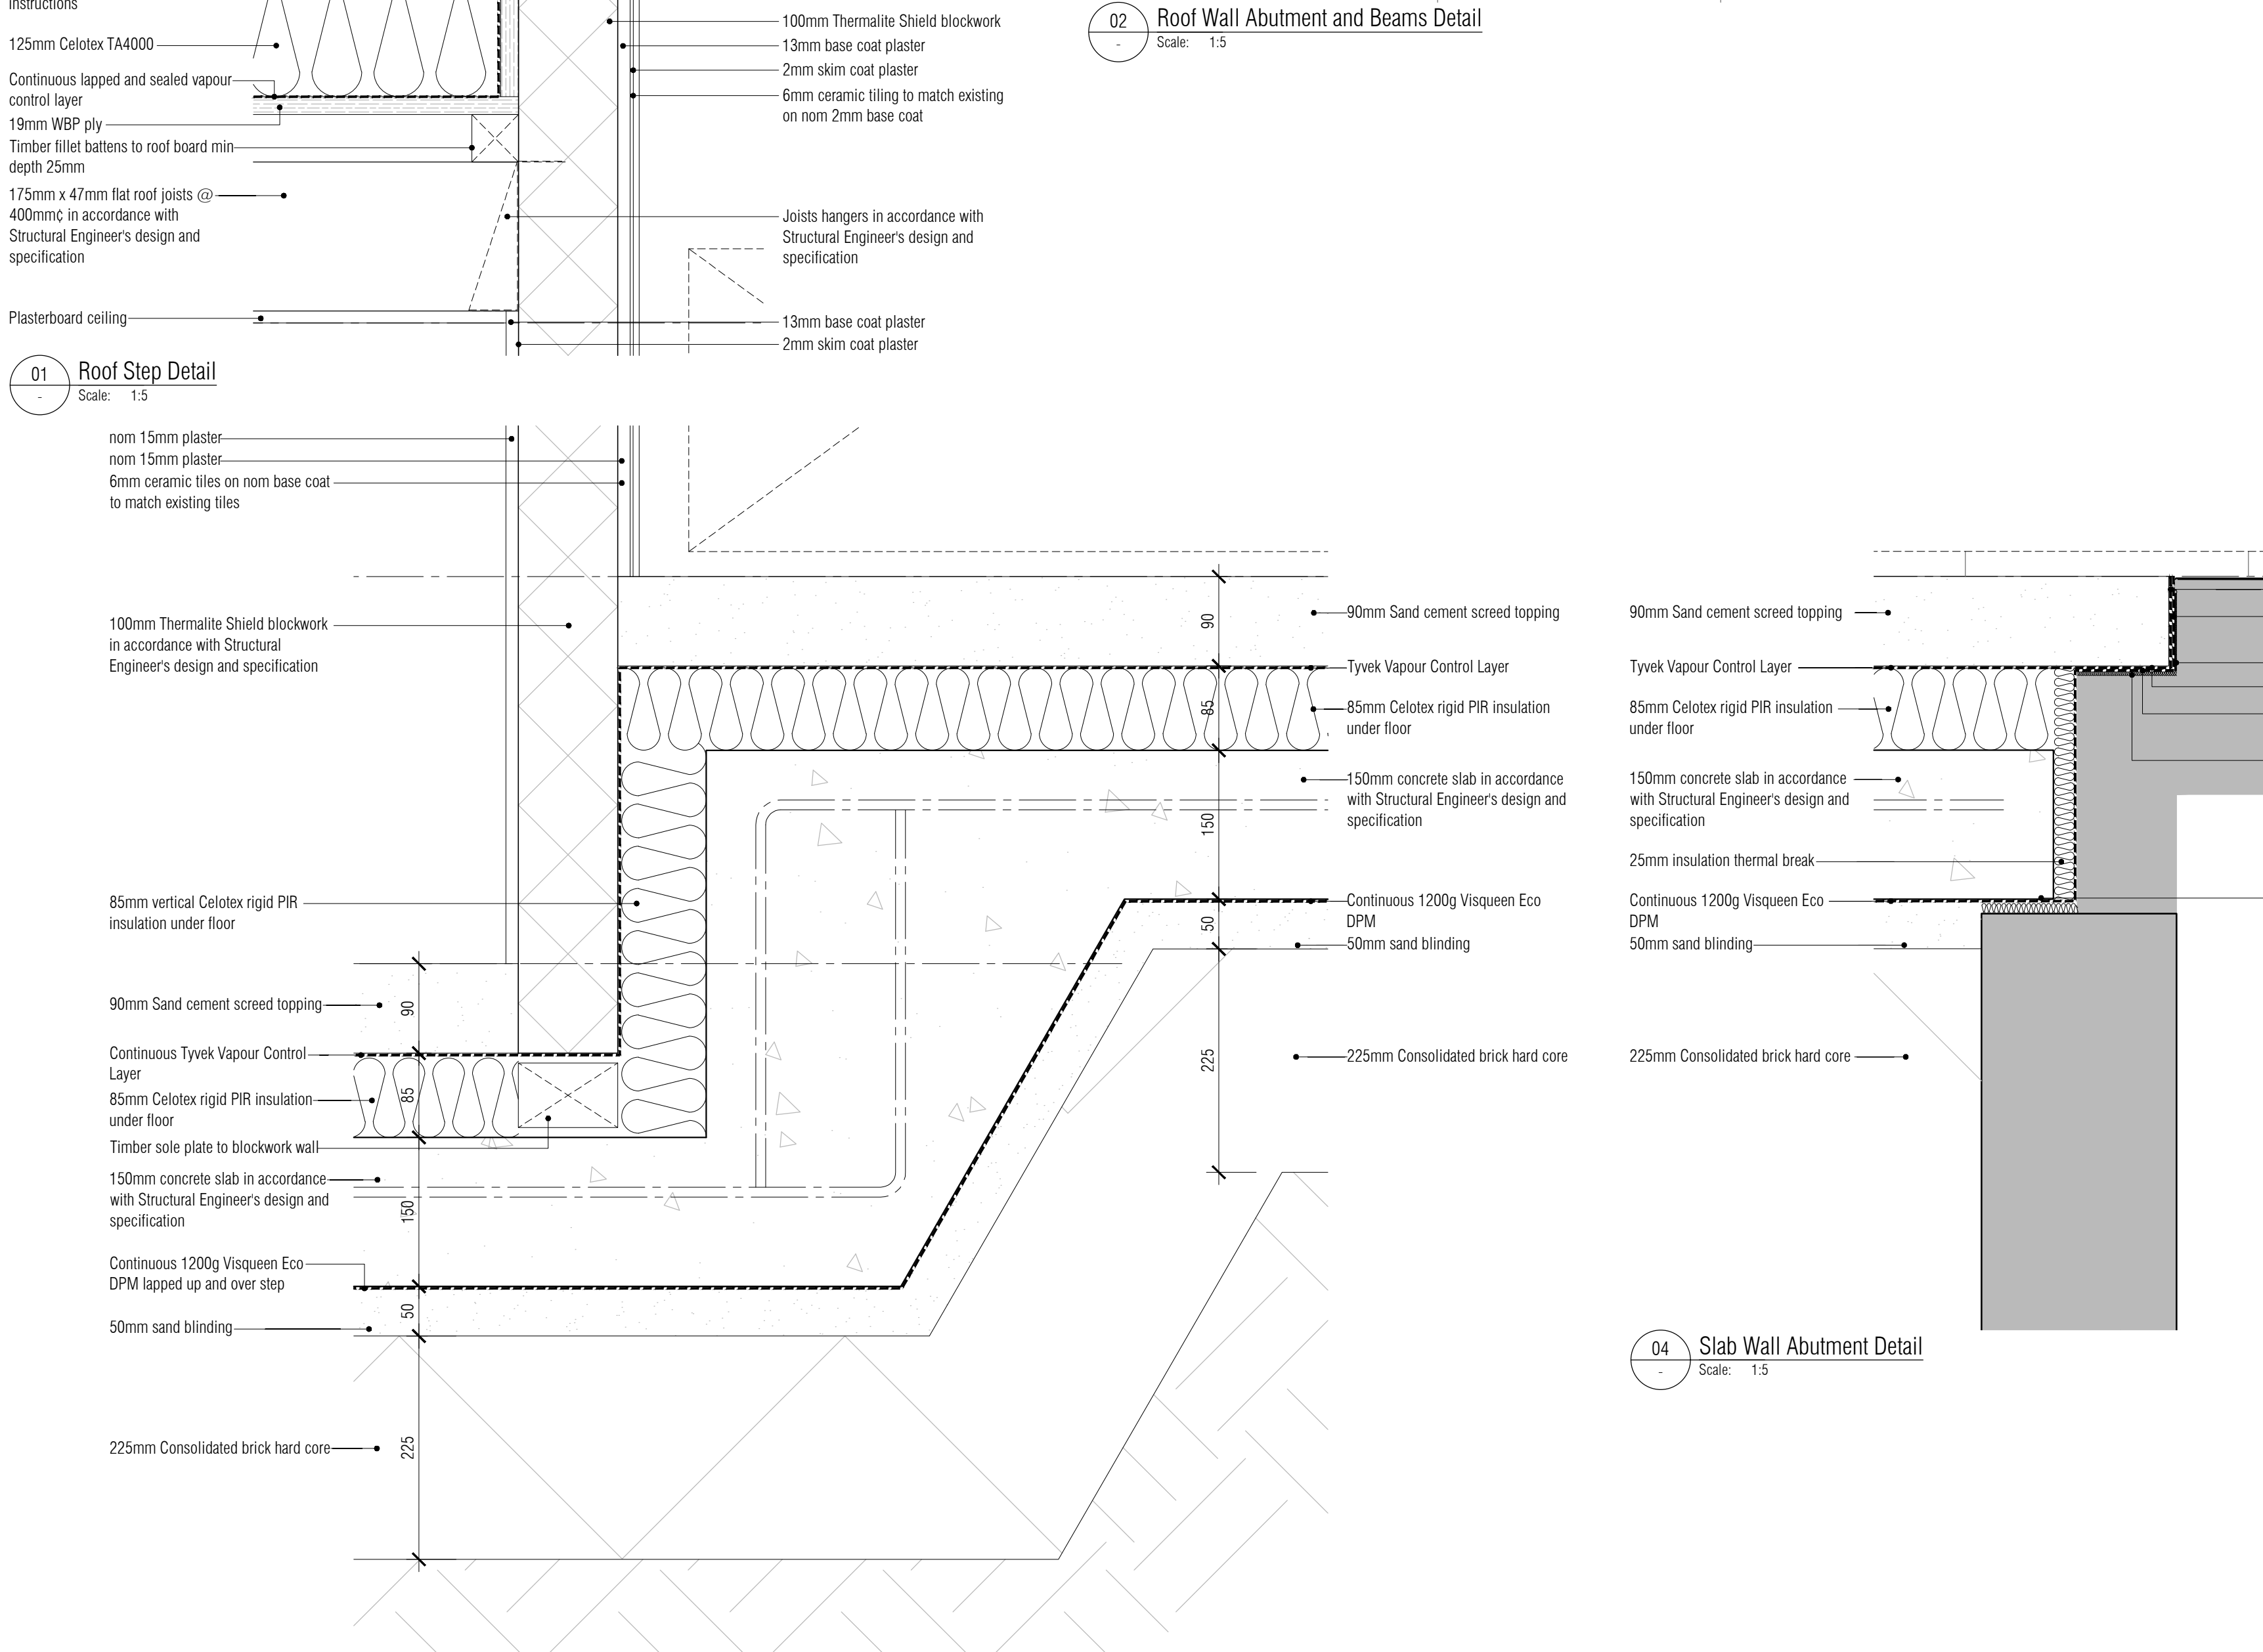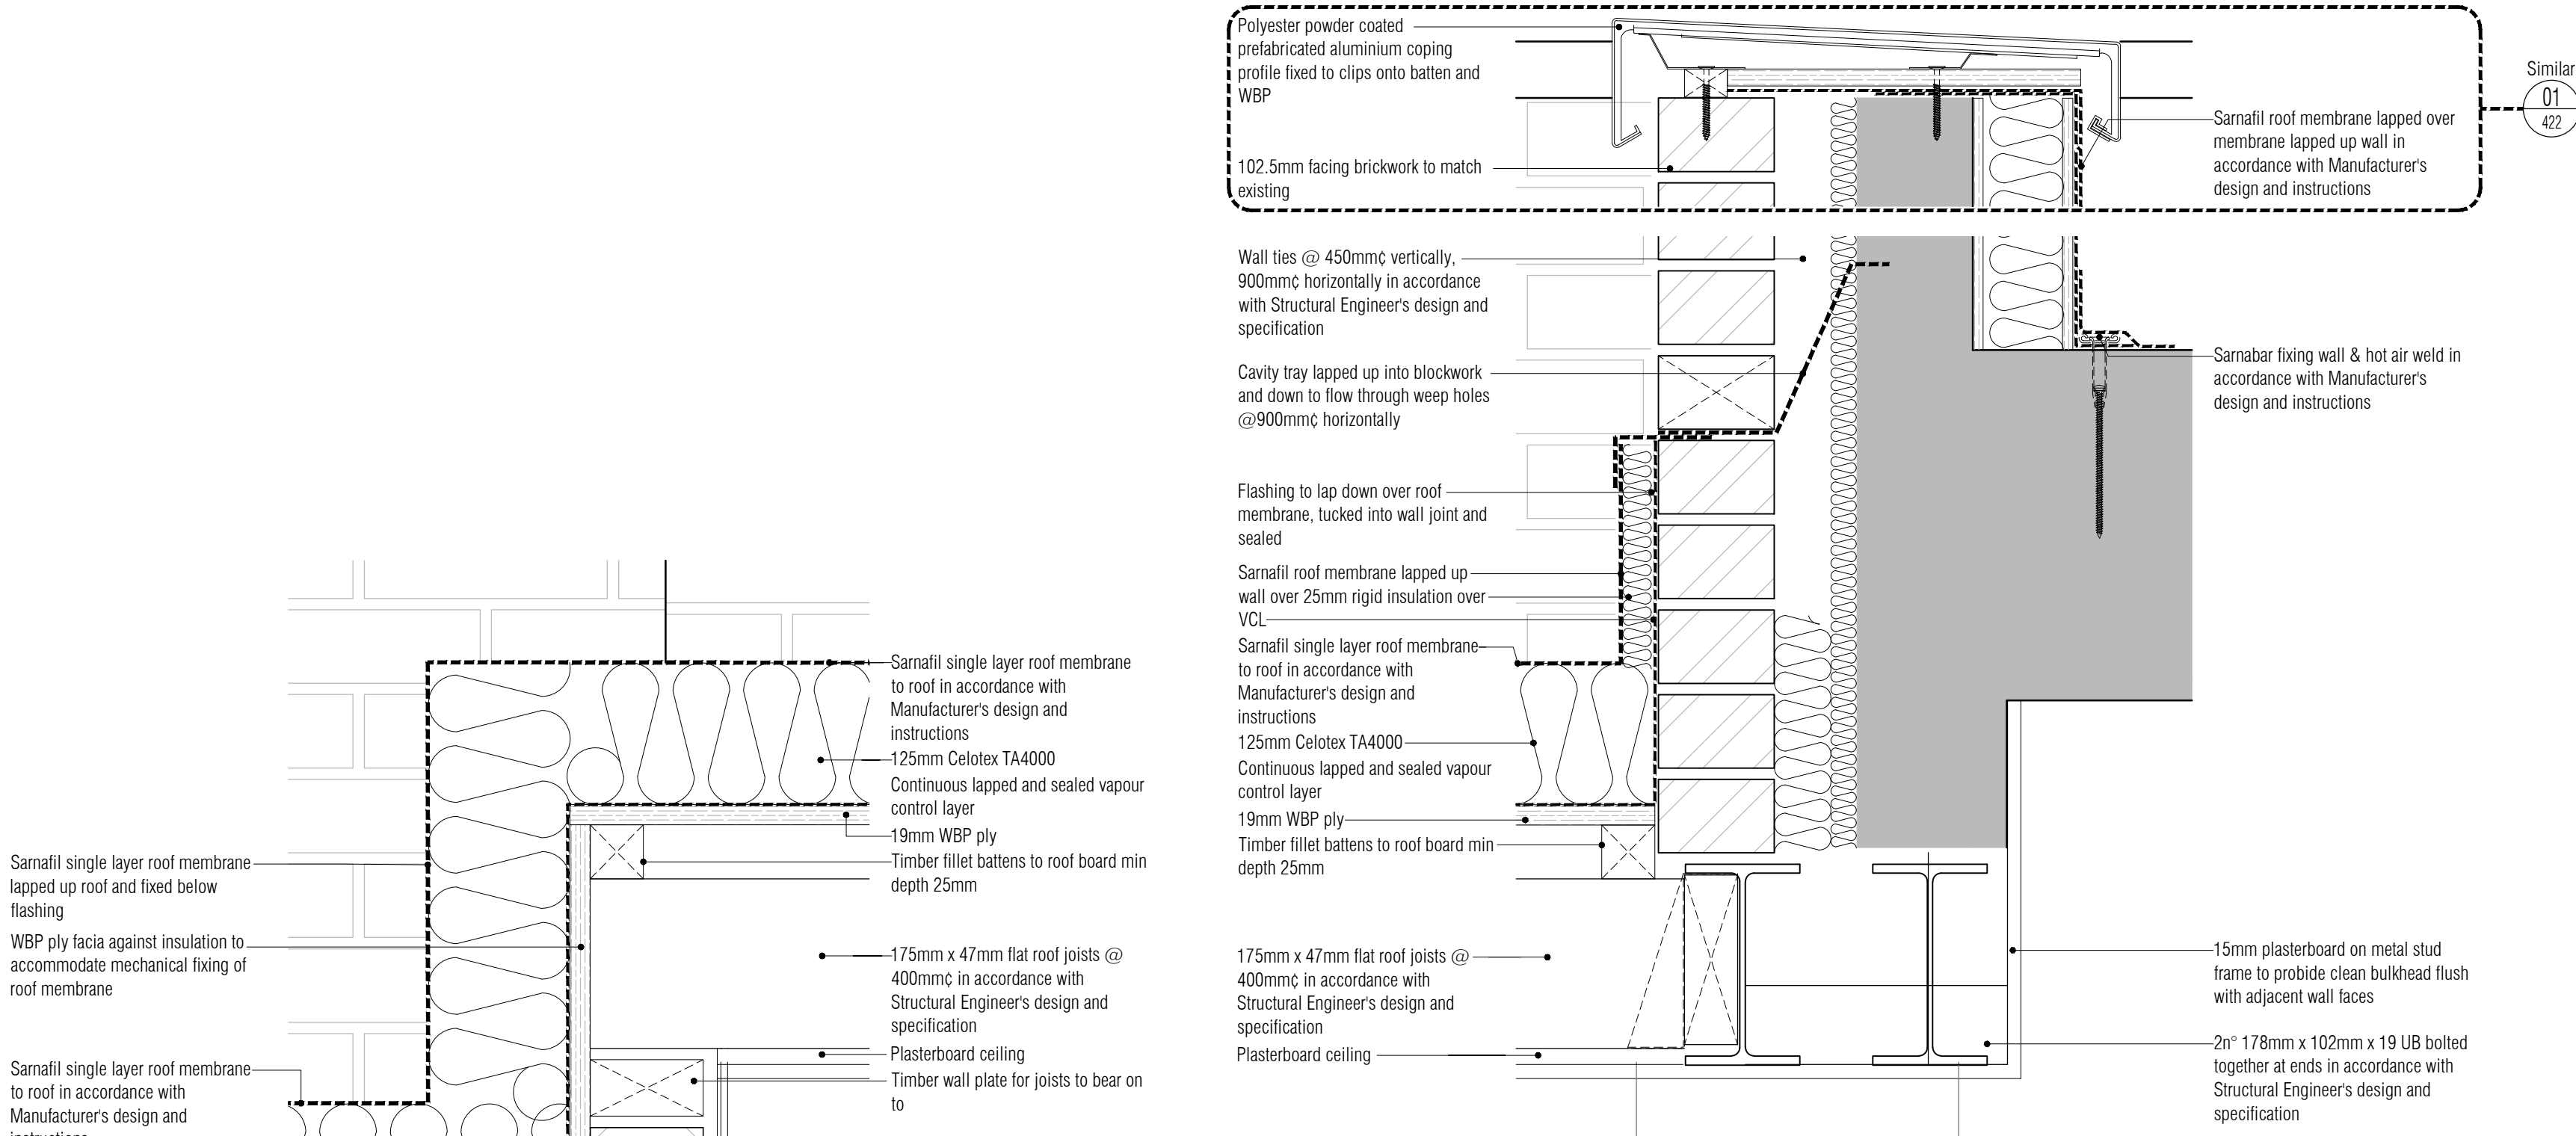

NB: All information based on supplied third party survey information.
All discrepancies to be reported to FCG immediately upon discovery.

NOTES: Do not scale this drawing. All dimensions to be checked on site prior to commencement or manufacture.
Key Plan (nts)

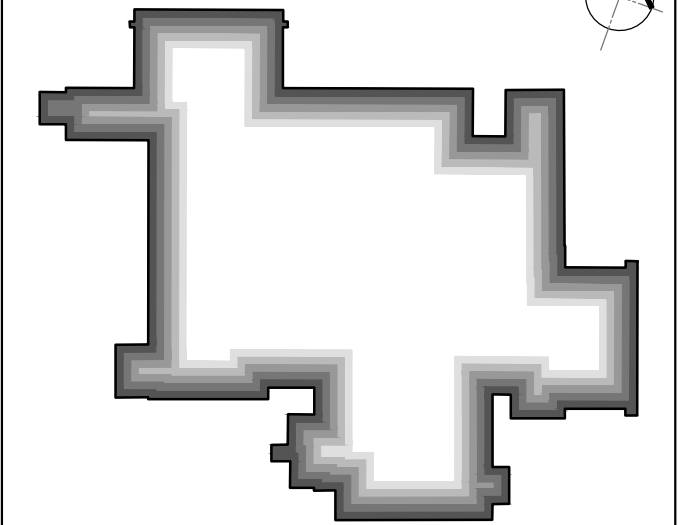

STAGE - F
DESIGN ISSUE

All details referenced in call outs supersede general arrangement or larger depictions.

Rev	Date	By	Chk	Comment
P2	12.06.12	RKC	JAS	Detail revd.
P1	28.05.12	RKC	JAS	Issued for Stage F

BRINGING IDEAS TO LIFE

FRANKHAM

Frankham Consultancy Group Limited
21 Perryman Road
Haywards Heath RH16 3TP
t 01444 444900 f 01444 455642
enquiries@frankham.com
www.frankham.com

Client

Mansell
Contract N°: MC0269

Project Title

Eastbourne & Worthing
Crematoria
Refurbishments and Alterations


Drawing Title

EASTBOURNE
Eastbourne Crematorium
Proposed Sections & Details


Drawn by: RKC	Scale: 1:5@A1	Date: 23.05.12
Designed by: FCG	Checked by: JAS	Approved by: AC

File Ref.: X:\FRANKHAM\2_080512\80 CREMATORIA\WORKING\400 DETAIL COORDINATES - 200611171531 20.06.11 12:18:39

Drawing No. 521260-A-413-E	Rev. P2
-------------------------------	------------

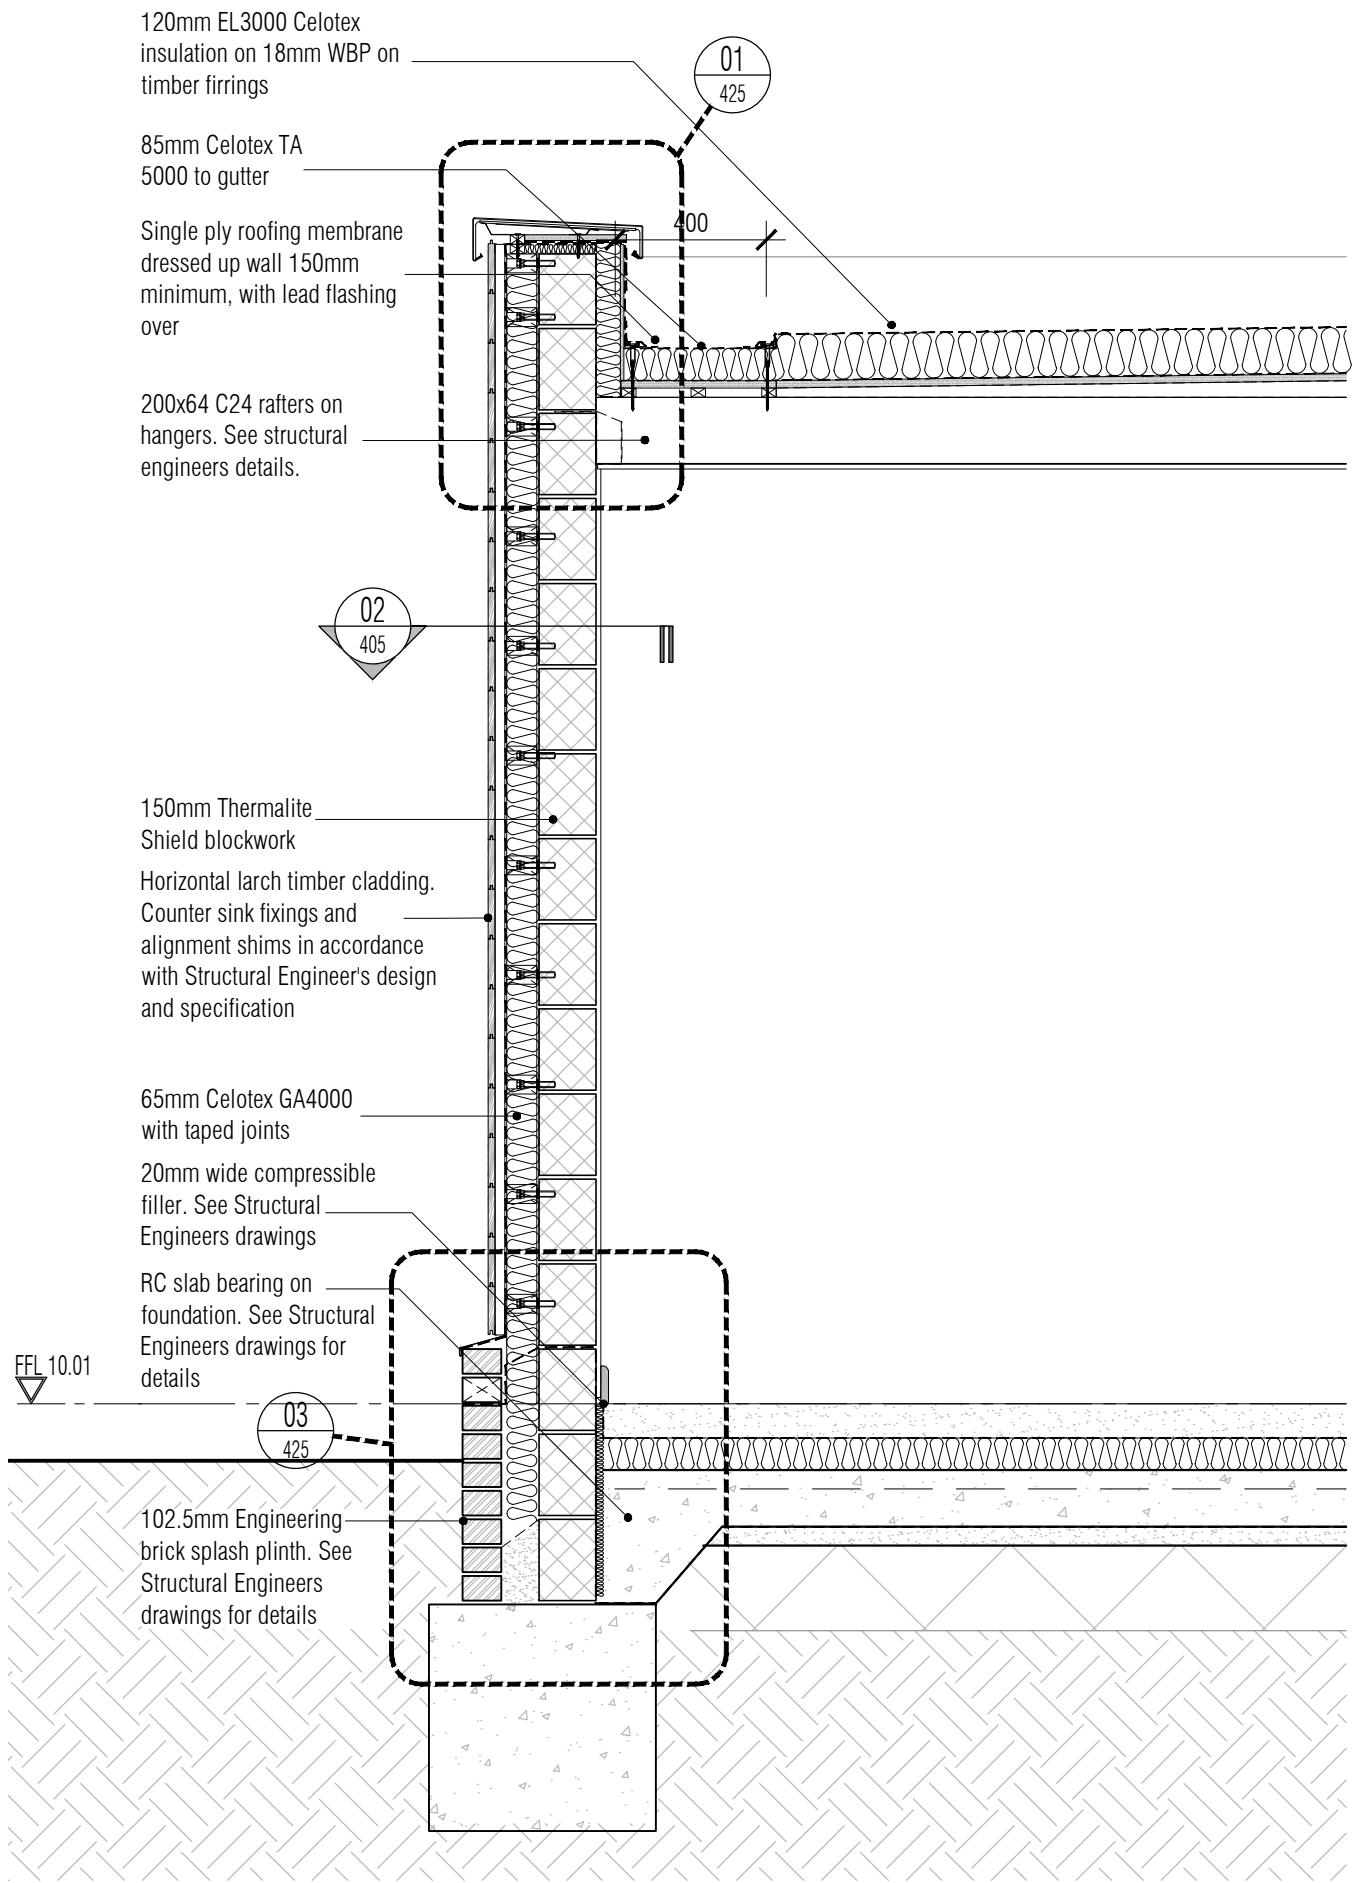


01 Detail Section A Through Staff Room Extension
Scale: 1:20

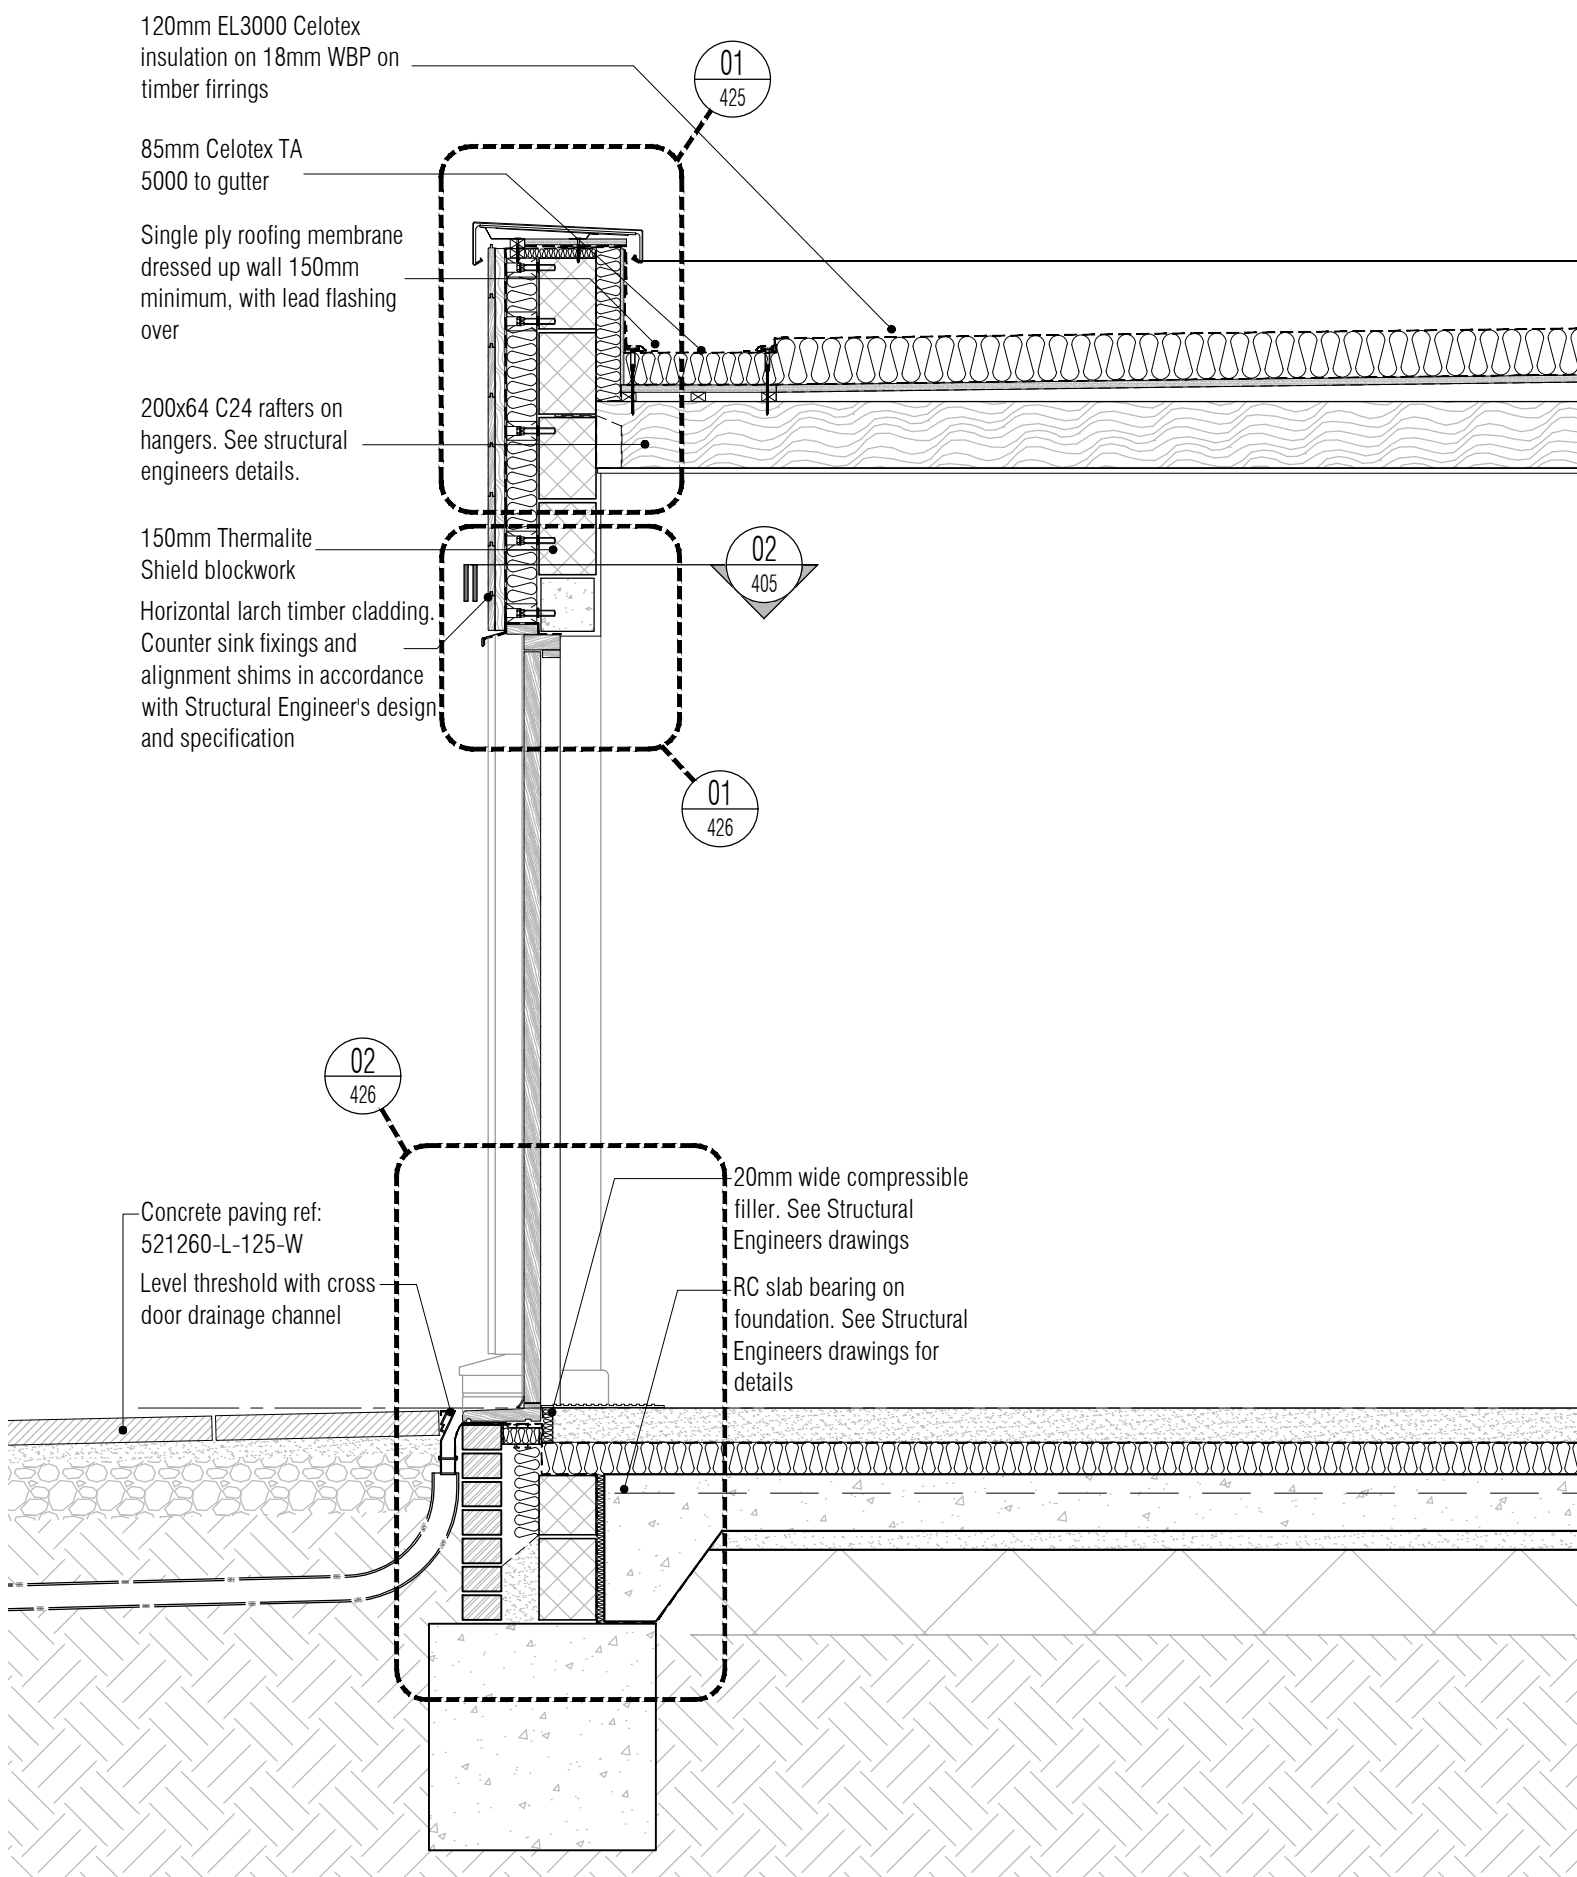


03 Detail Section C Through Staff Room Door
Scale: 1:20

NB: All information based on supplied third party survey information.
All discrepancies to be reported to FCG immediately upon discovery.

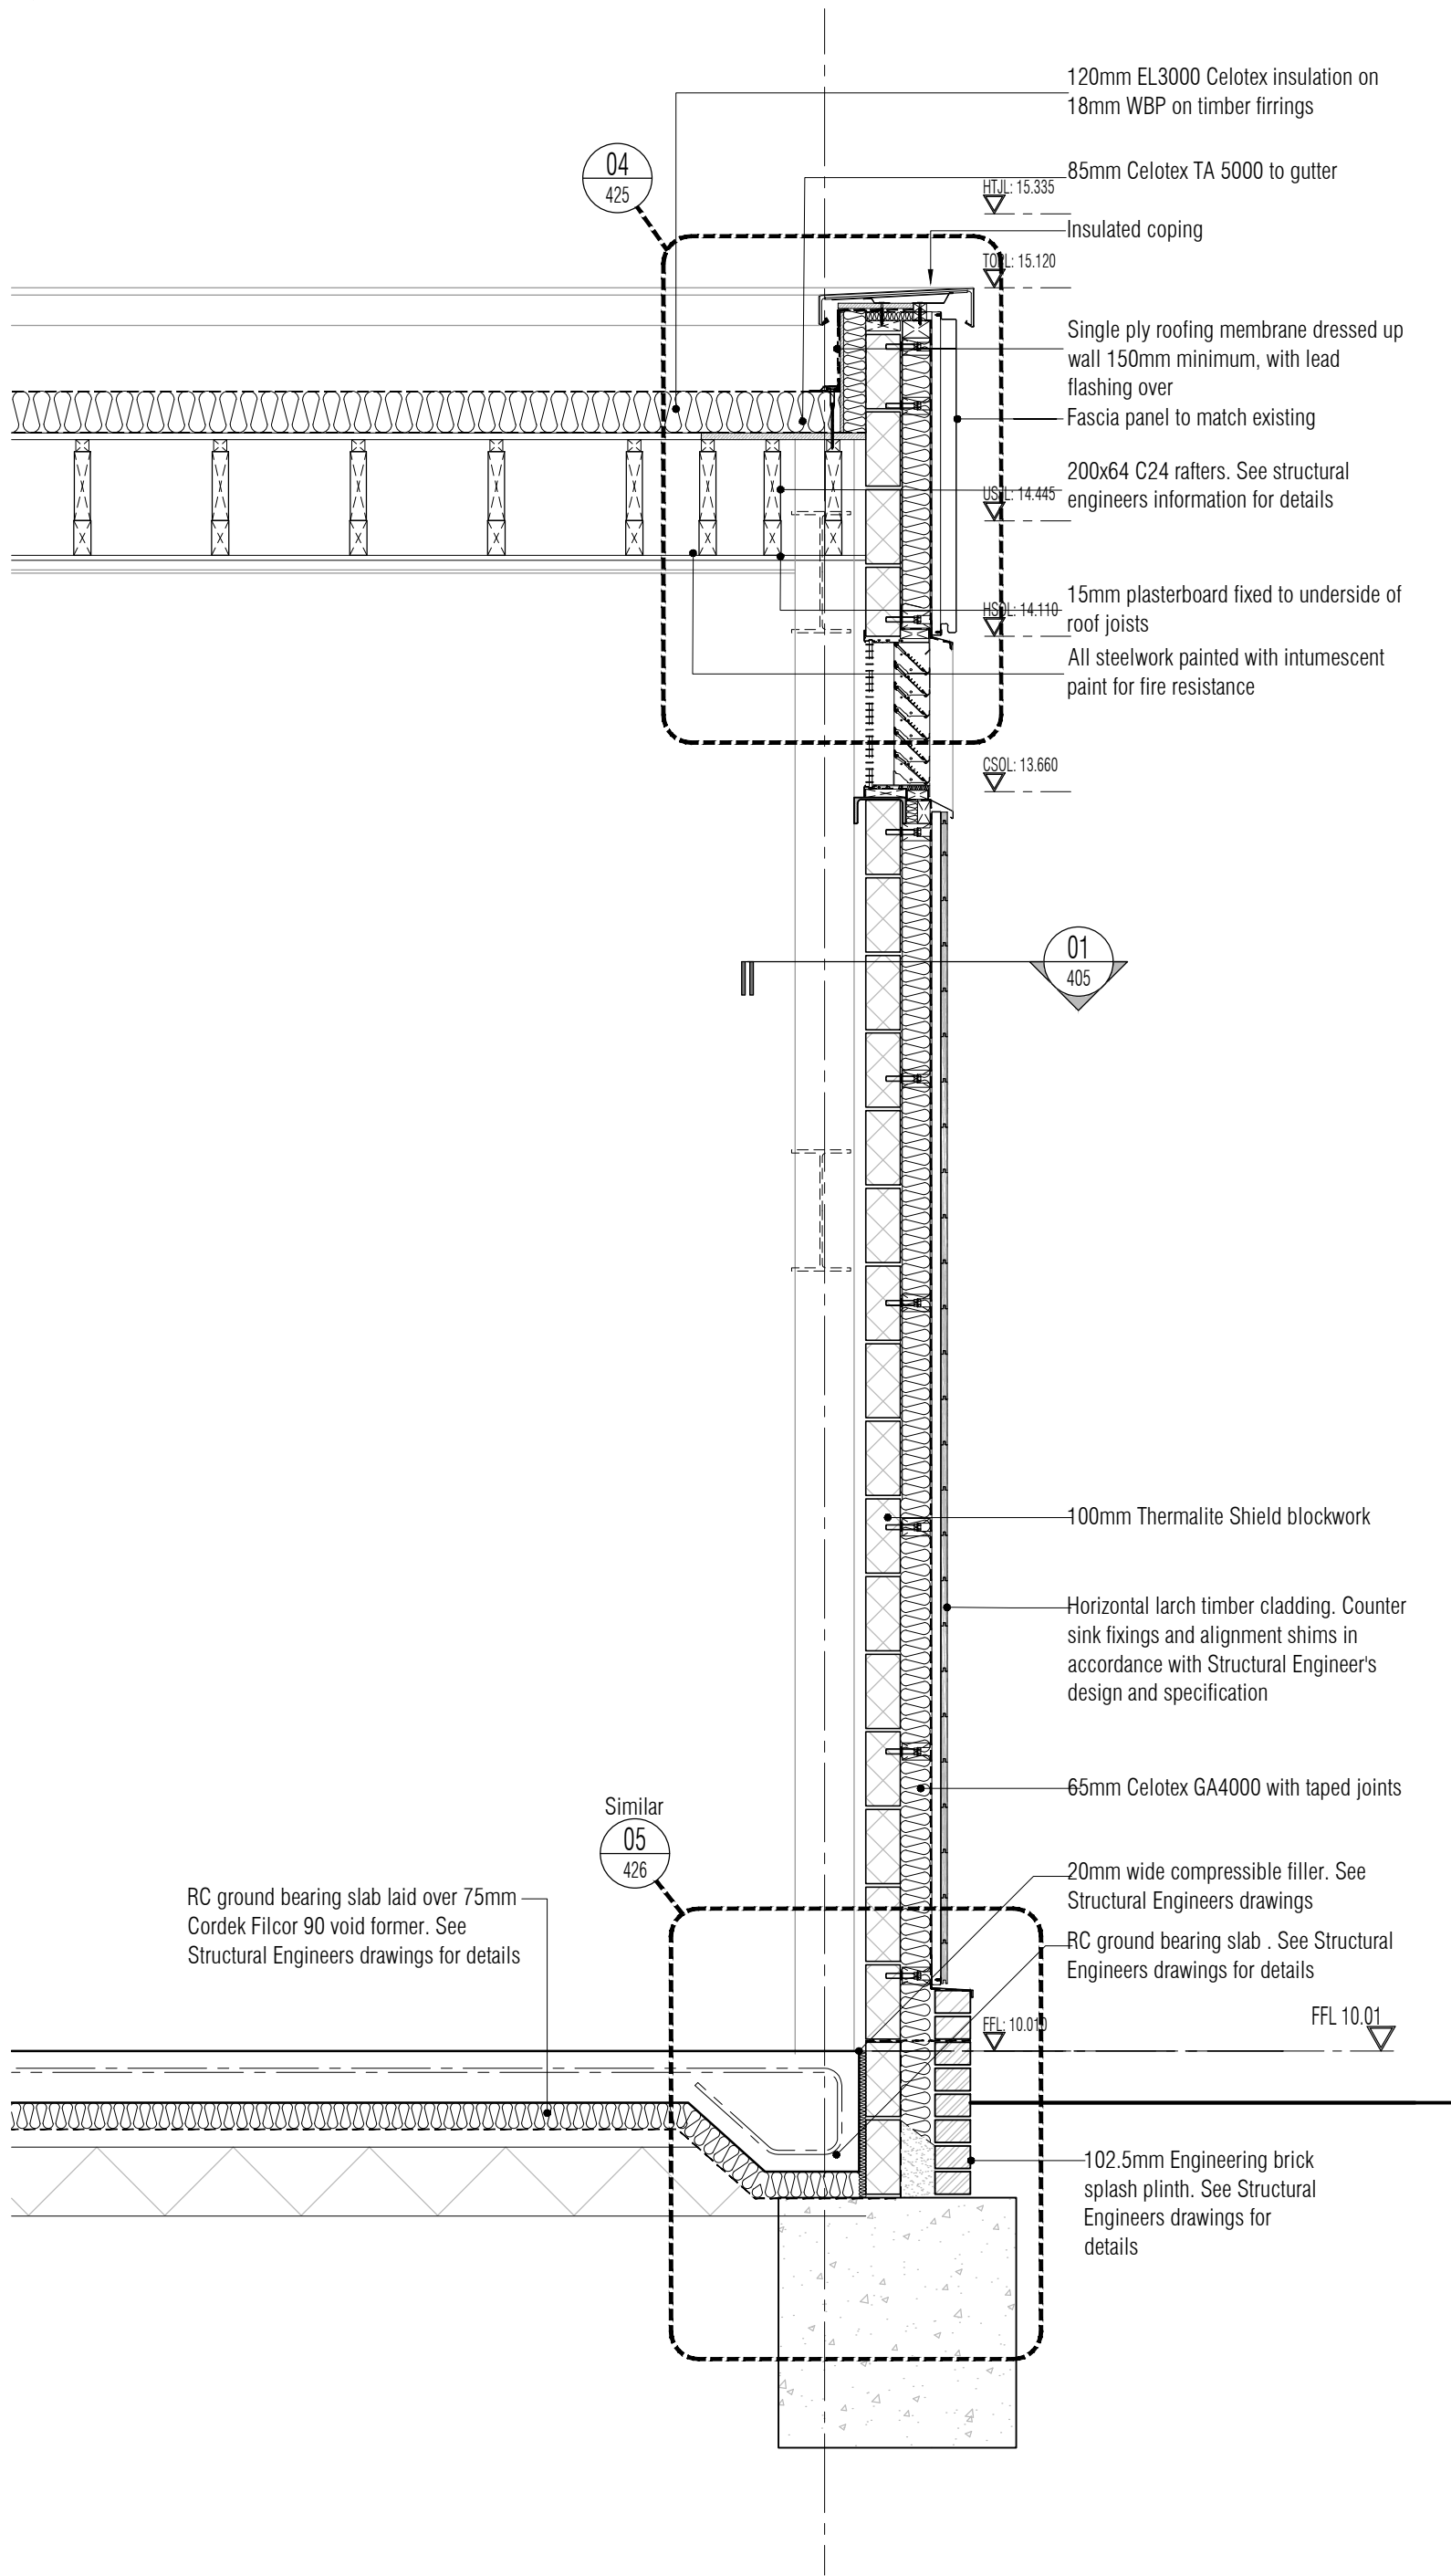


02 Detail Section B Through Abatement Room Extension
Scale: 1:20

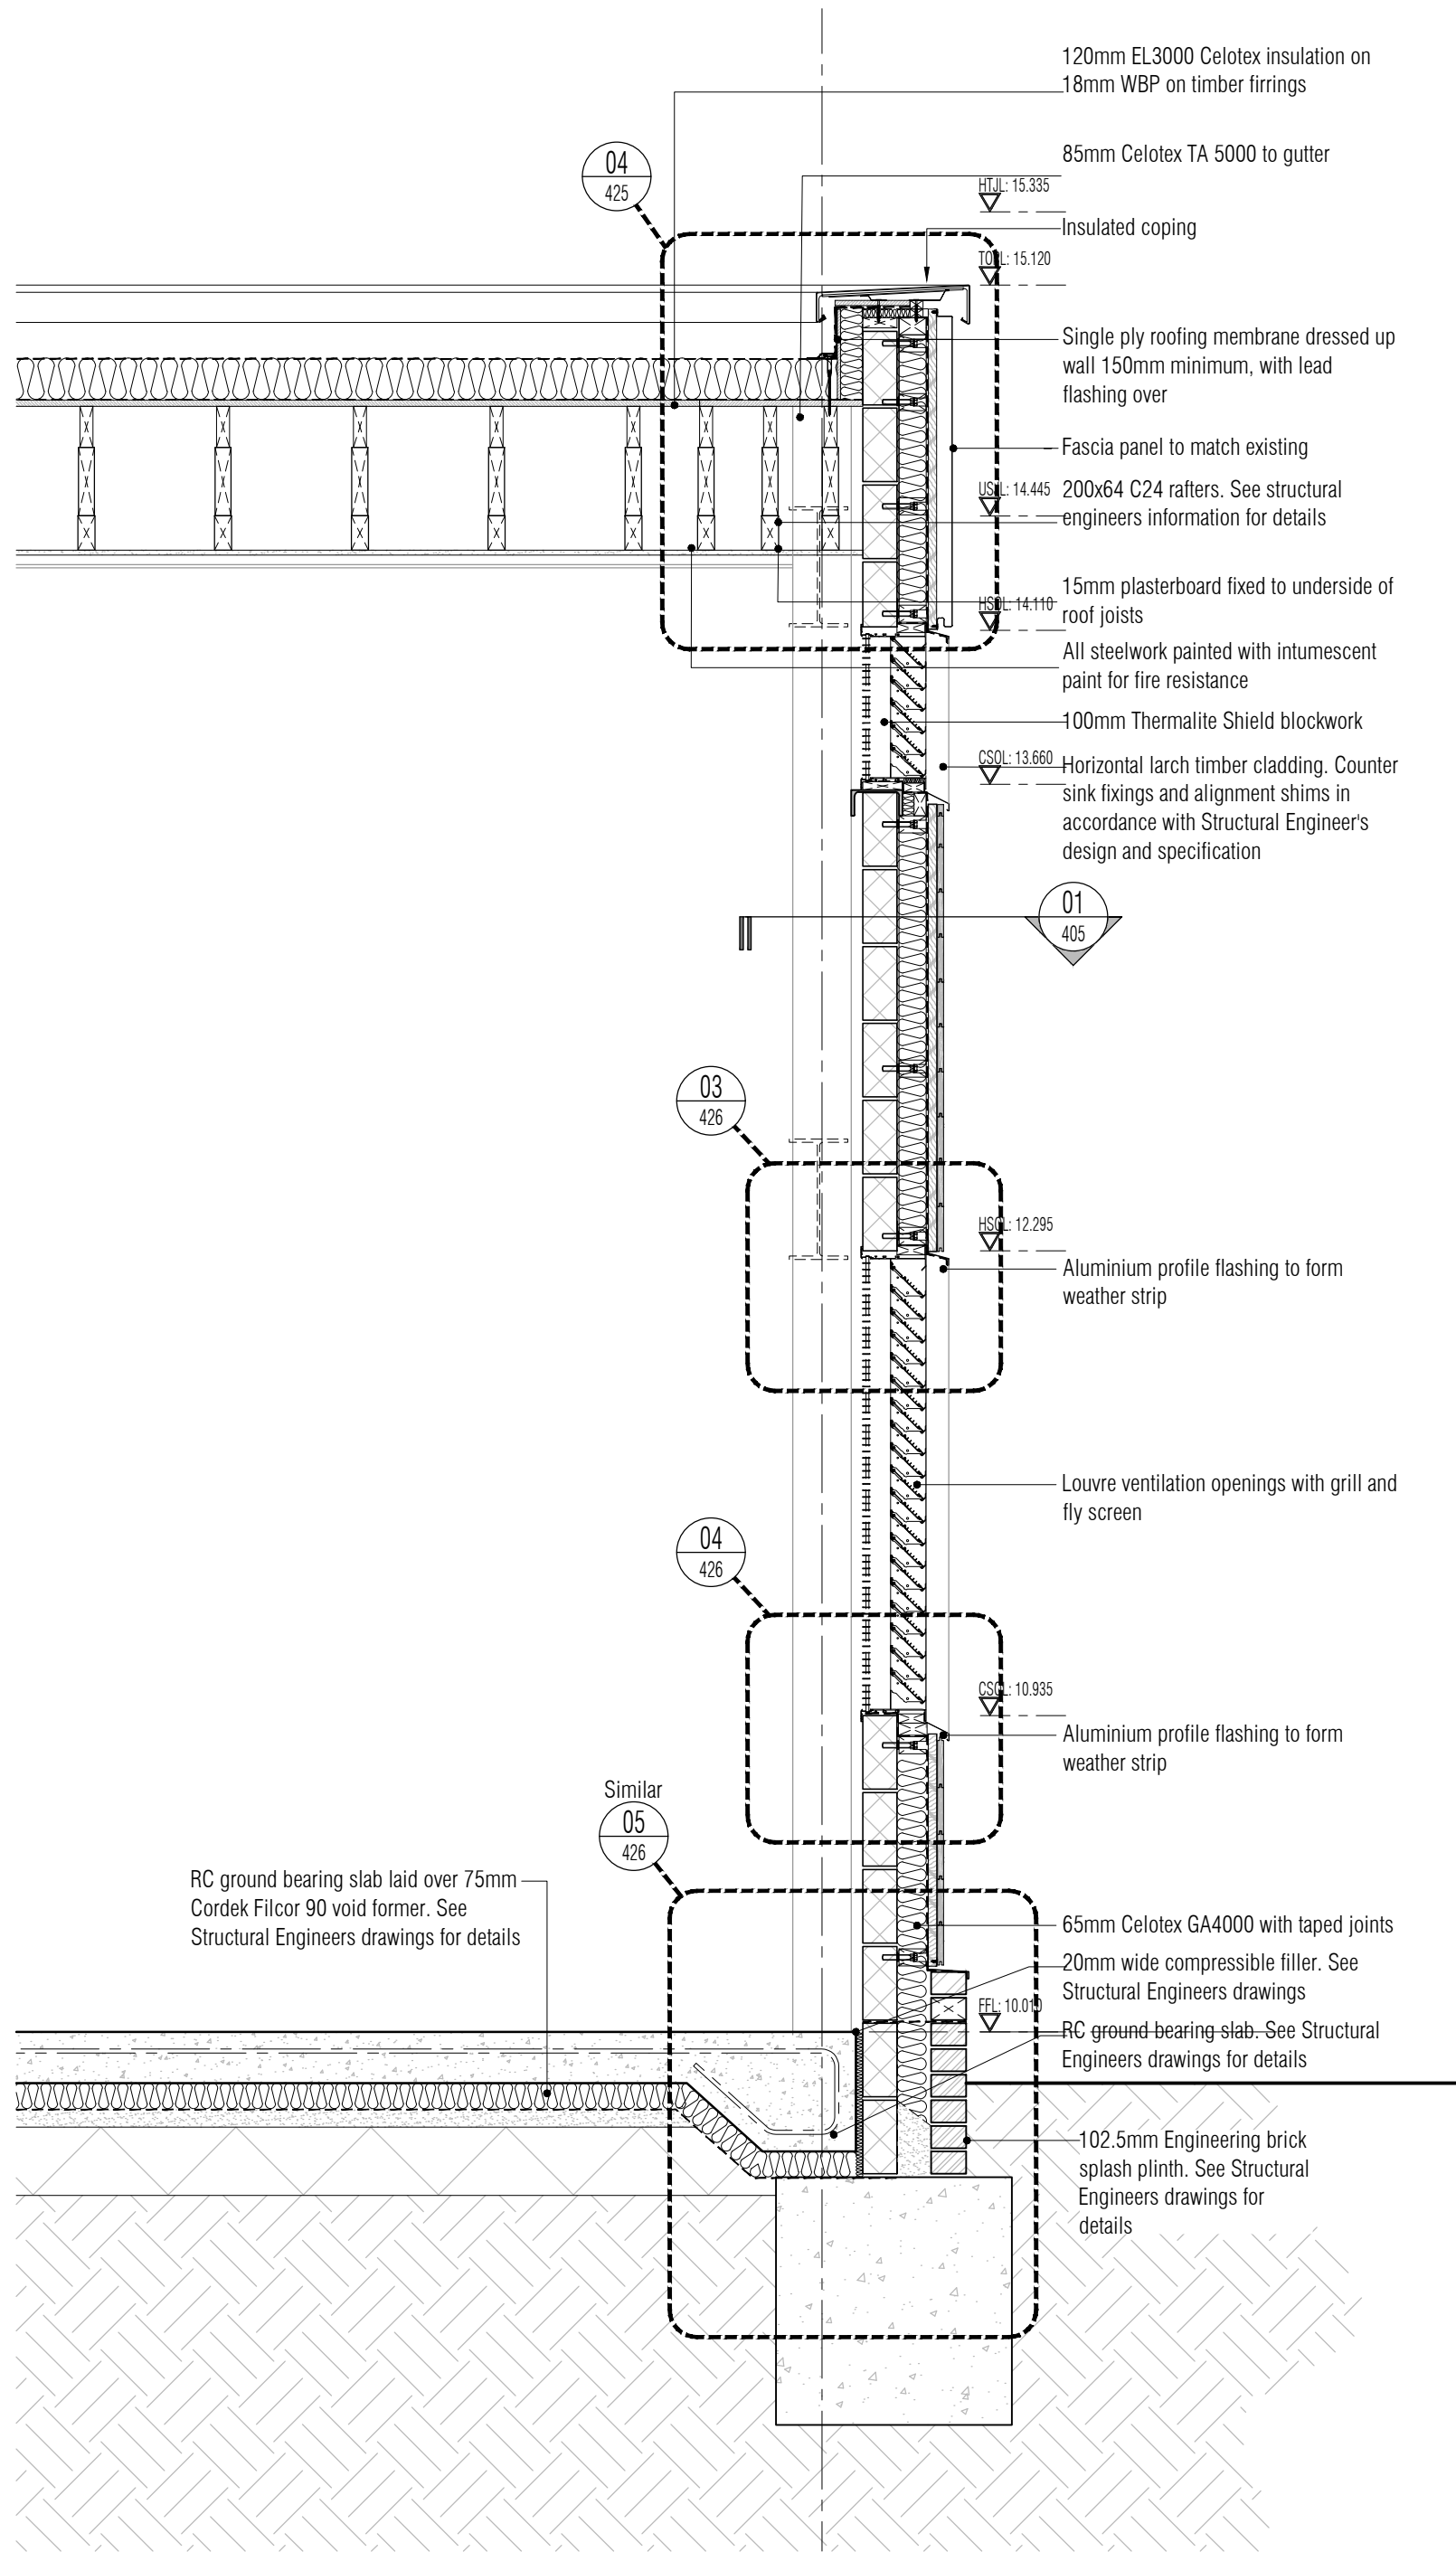

04 Detail Section B Through Louvres in Abatement Room Extension
Scale: 1:20

NOTES: Do not scale this drawing. All dimensions to be checked on site prior to commencement or manufacture.
Key Plan (nts)

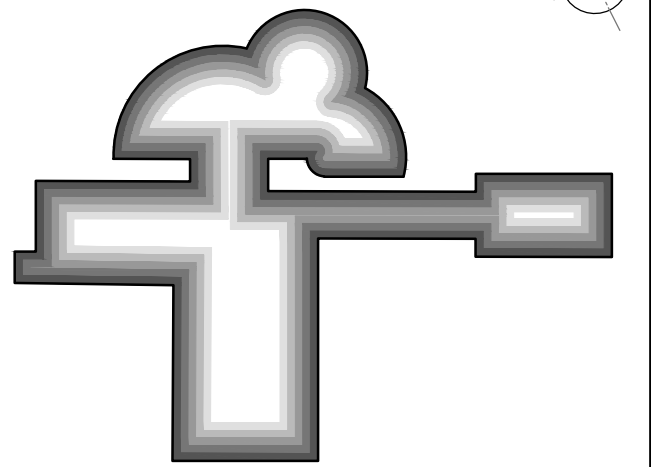

ISSUED FOR CONSTRUCTION

All details referenced in call outs supercede general arrangement or larger depictions.

Rev	Date	By	CHK	Comment
C2	09.07.12	RKC	JAS	Issued for Construction
P7	01.06.12	RKC	JAS	Issued for Stage F
P6	18.05.12	RKC	JAS	Sections read per CC3
C1	23.04.12	RKC	JAS	Issued for CONSTRUCTION

BRINGING IDEAS TO LIFE



FRANKHAM

Frankham Consultancy Group Limited
21 Perryman Road
Haywards Heath RH16 3TP
t 01444 444900 f 01444 455642
enquiries@frankham.com
www.frankham.com

Client
Mansell
Contract N°: Worthing

Project Title
Eastbourne & Worthing
Crematoria
Refurbishments and Alterations


Drawing Title
Worthing
Worthing Crematorium
Wall Sections A, B, C & D

Drawn by: RKC	Scale: 1:20@A1	Date: 07.02.12
Designed by: FCG	Checked by: JAS	Approved by: AC


File Ref.: 307380-A-415-W-000 - 20061121546 20.06.11.12.18.46

Drawing No. 521260-A-415-W	Rev. C2
-------------------------------	------------


All Disabled and Ambulant Disabled facilities to comply with Approved Document Part M - Access to and use of buildings*, Disability Discrimination Act 1995 and BS83000 as required

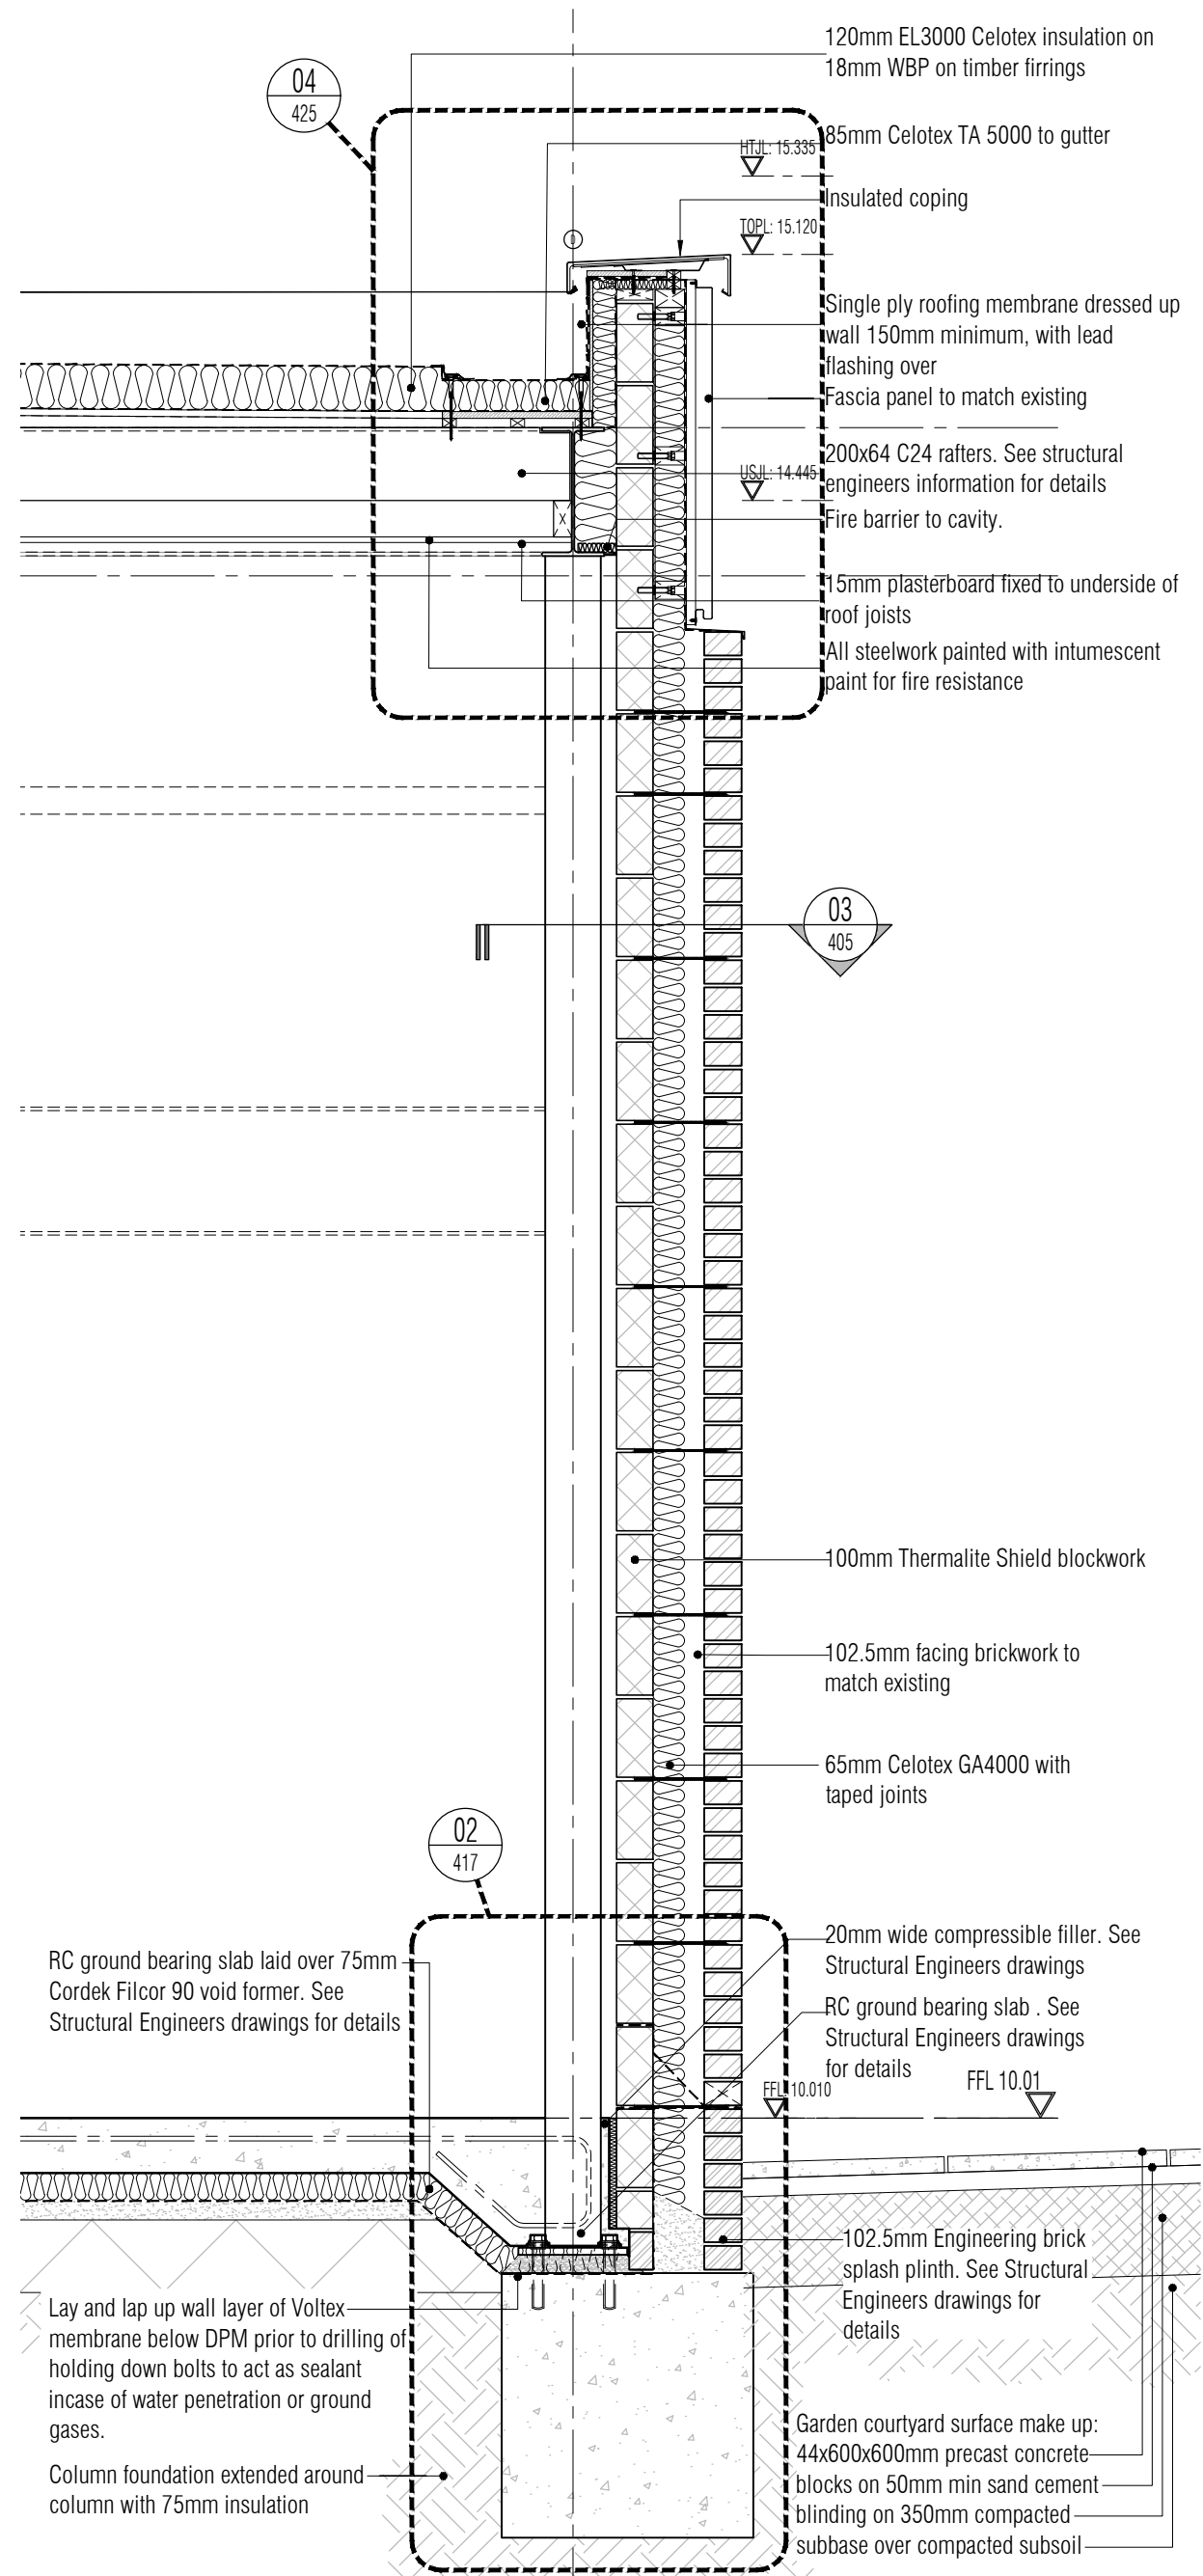


01 Detail Section G Through Plant Room / Courtyard
Scale: 1:20

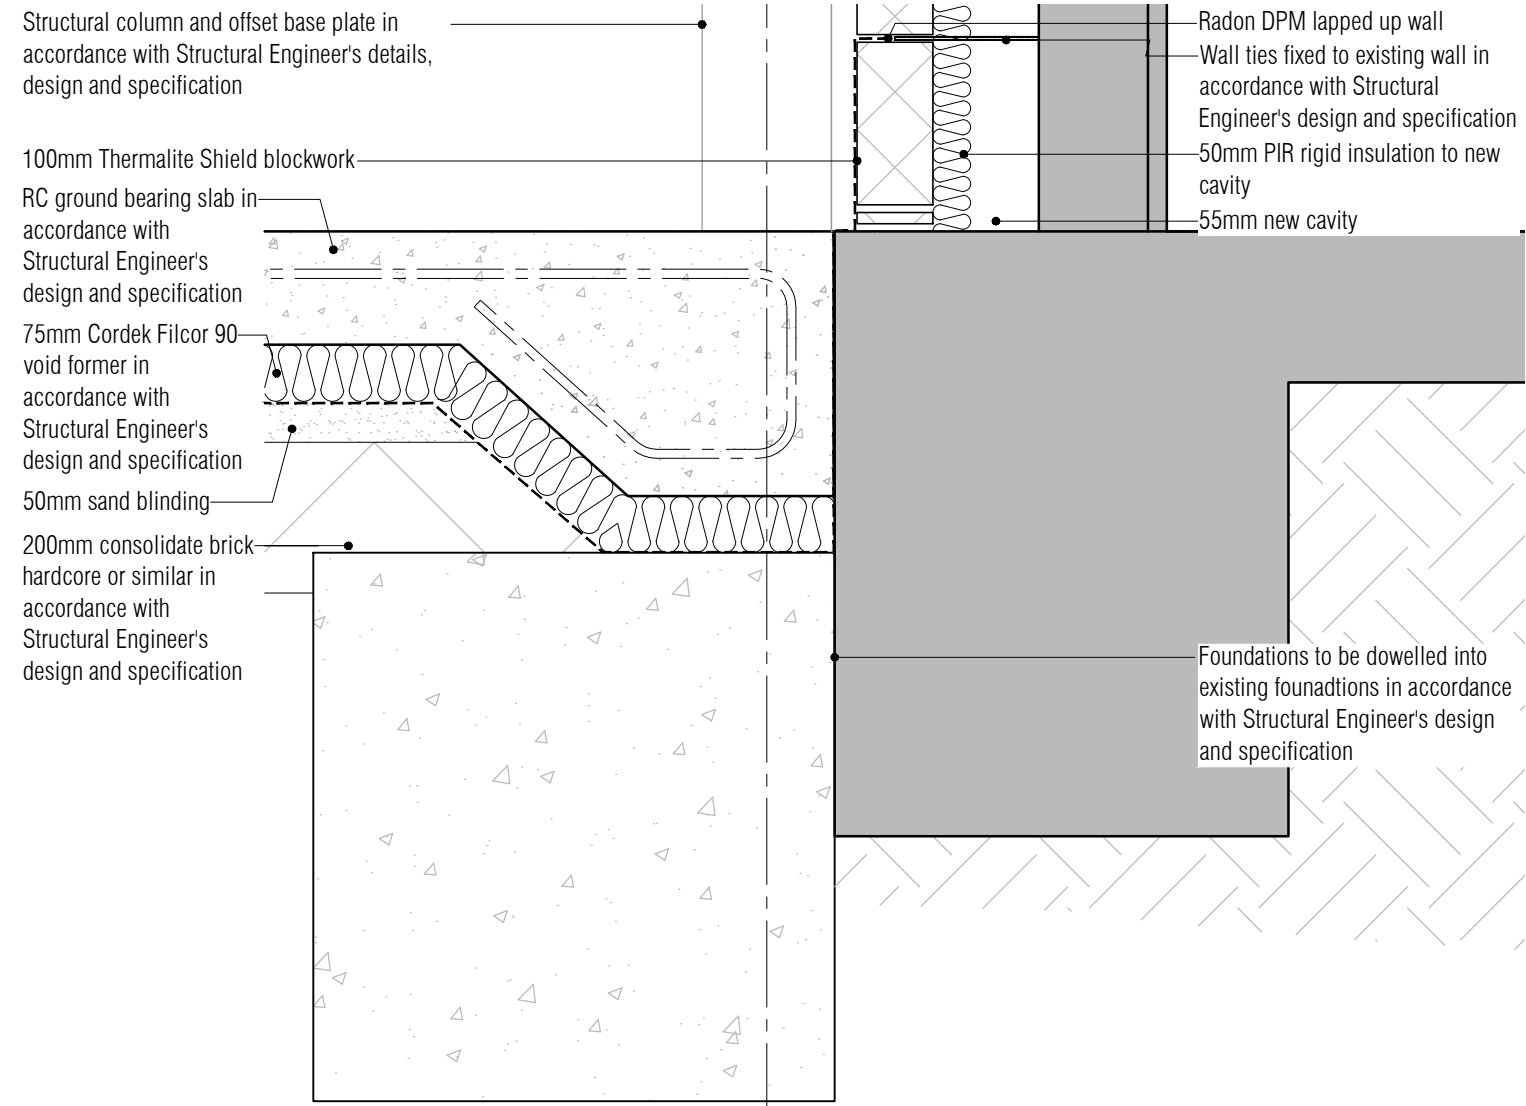


05 Offset Foundation Detail
Scale: 1:10

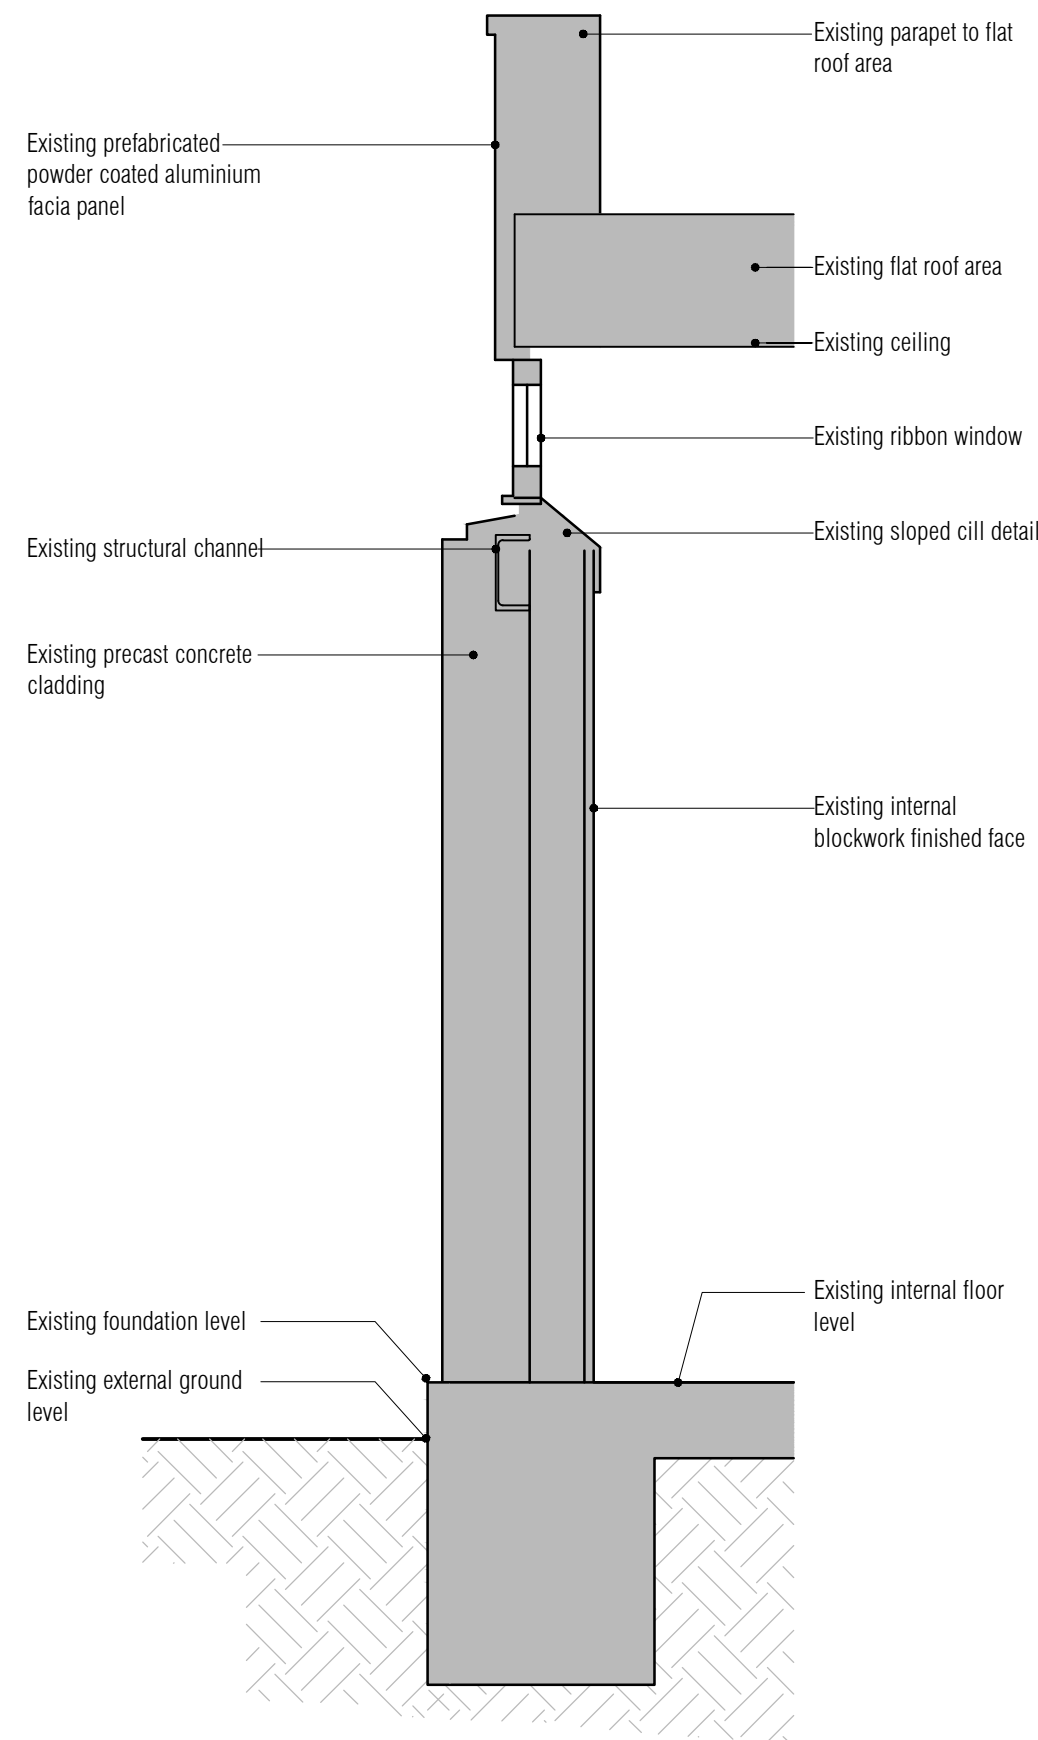


02 Detail Section H Through Existing Flower Prep Wall
Scale: 1:20

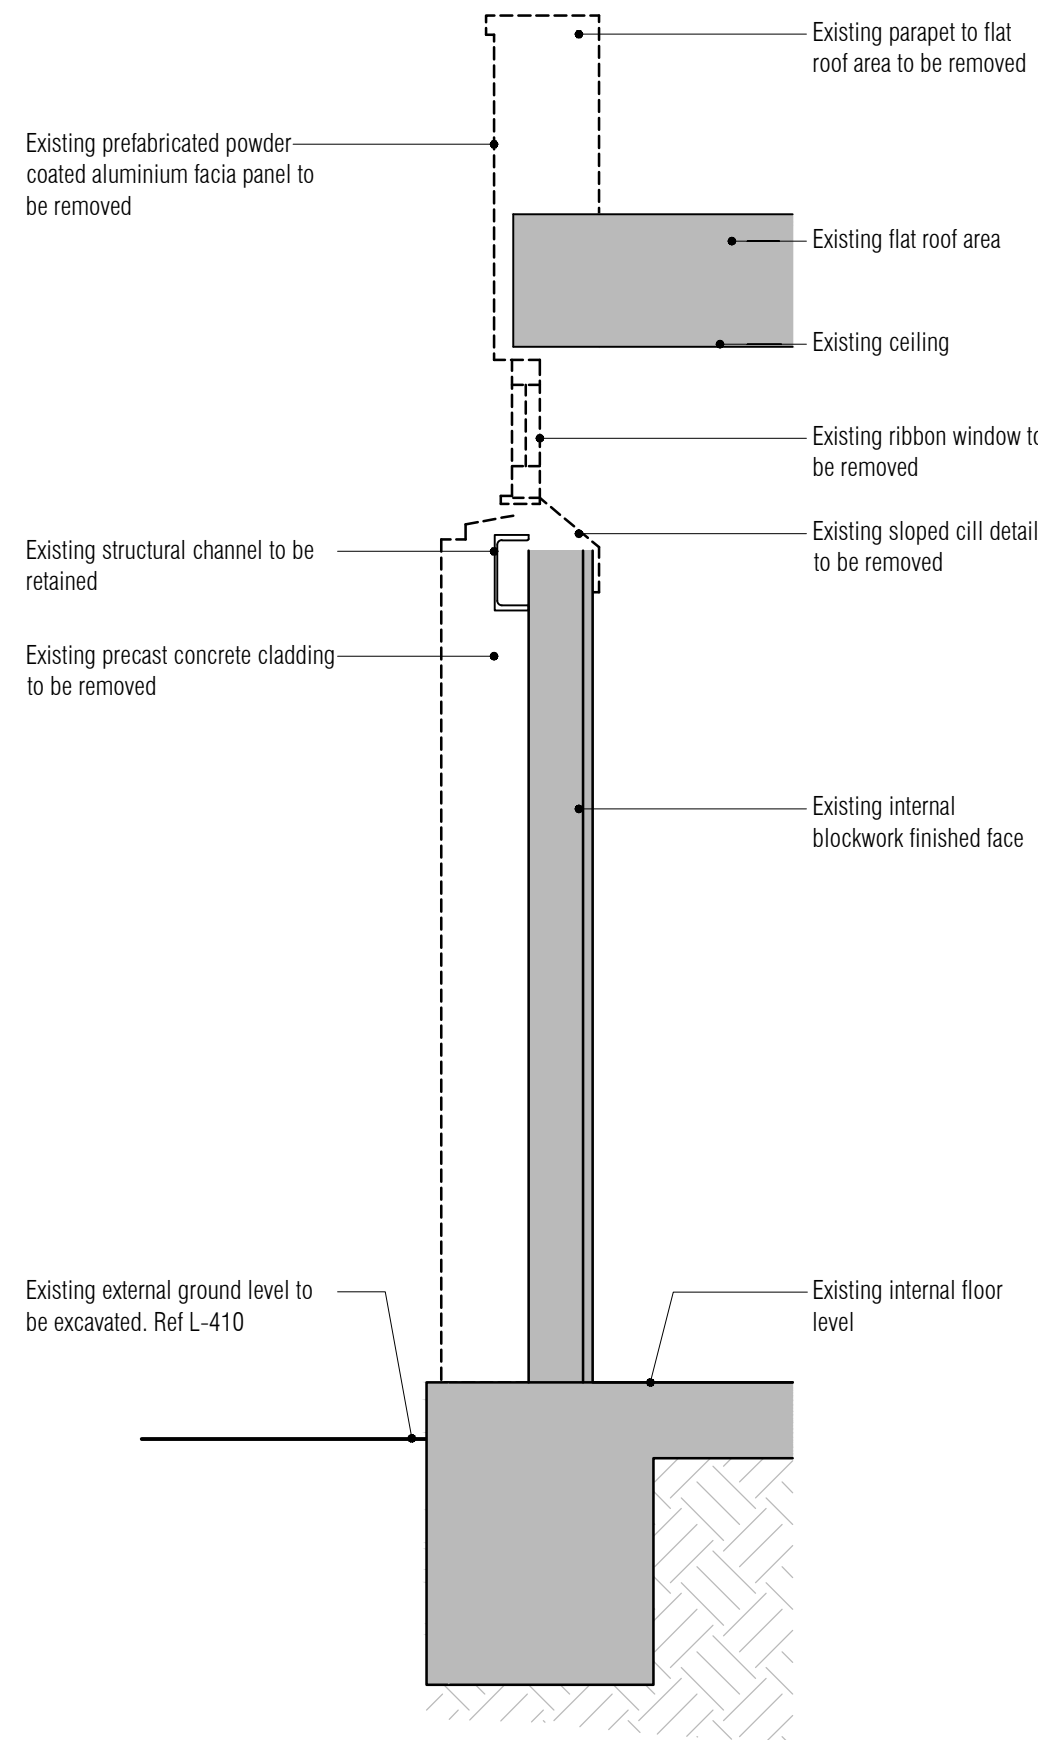

03 Detail Section H Through Demolished Flower Prep Wall
Scale: 1:20

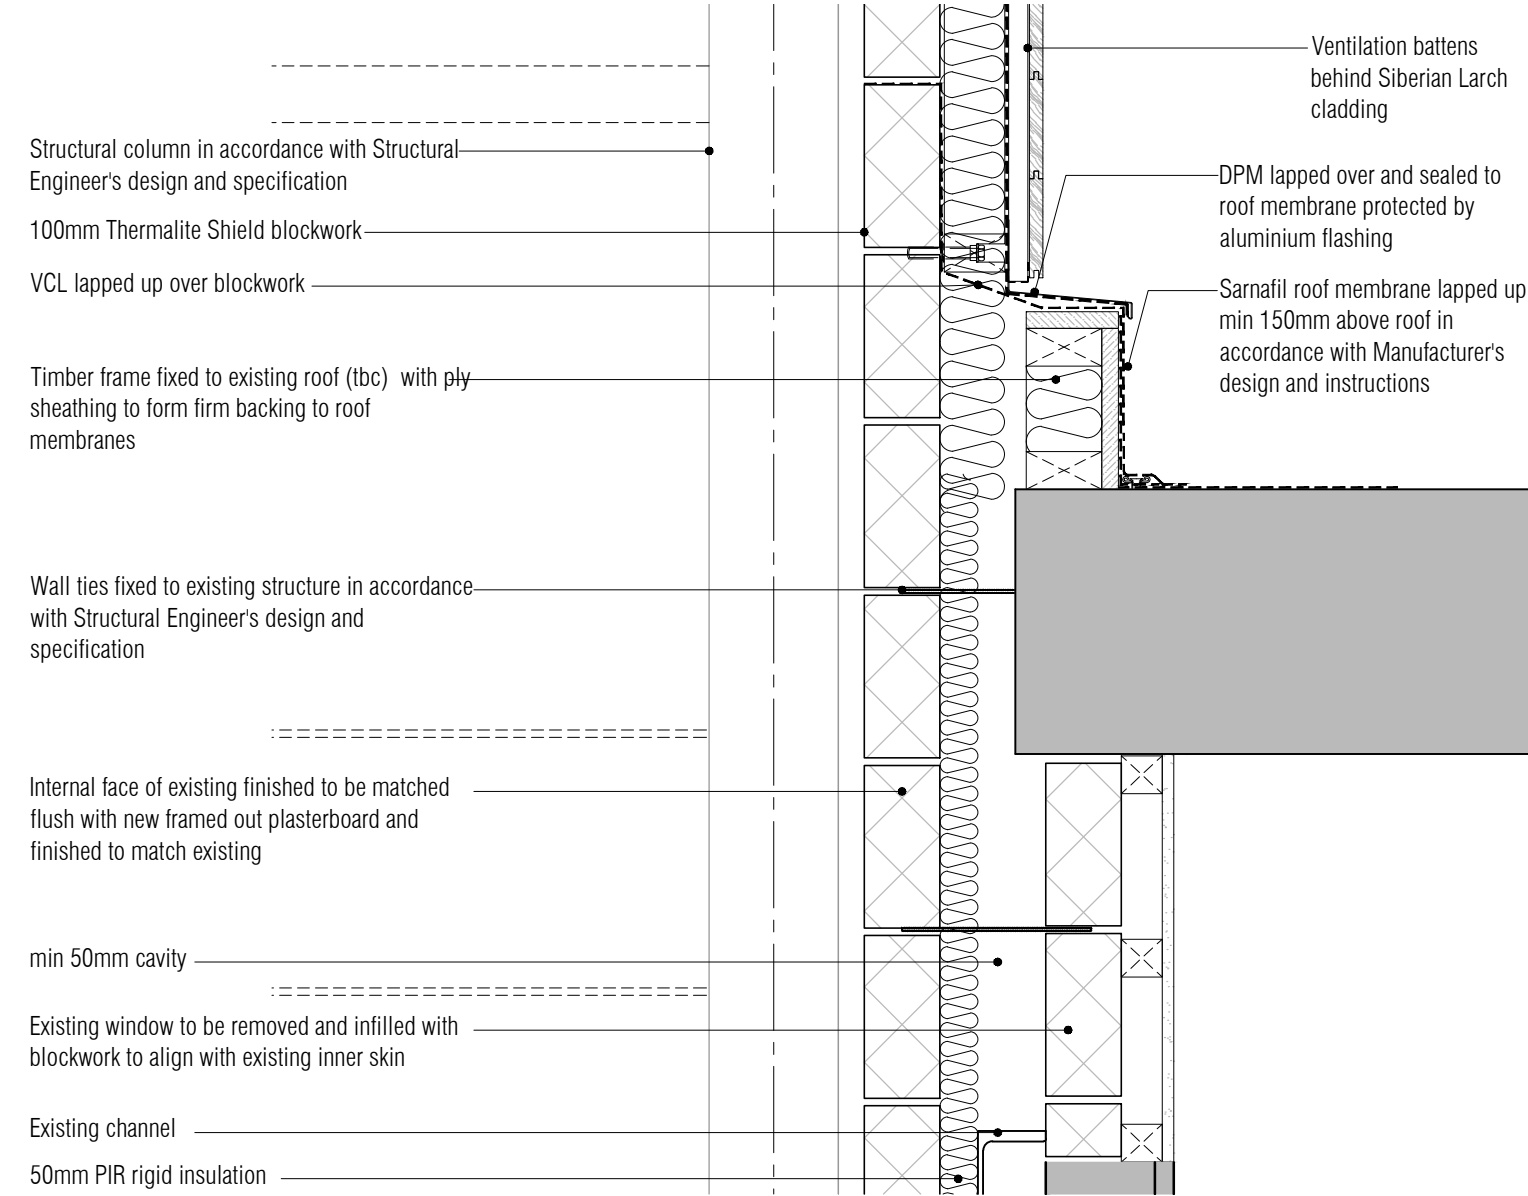


06 Parapet Support Detail
Scale: 1:10

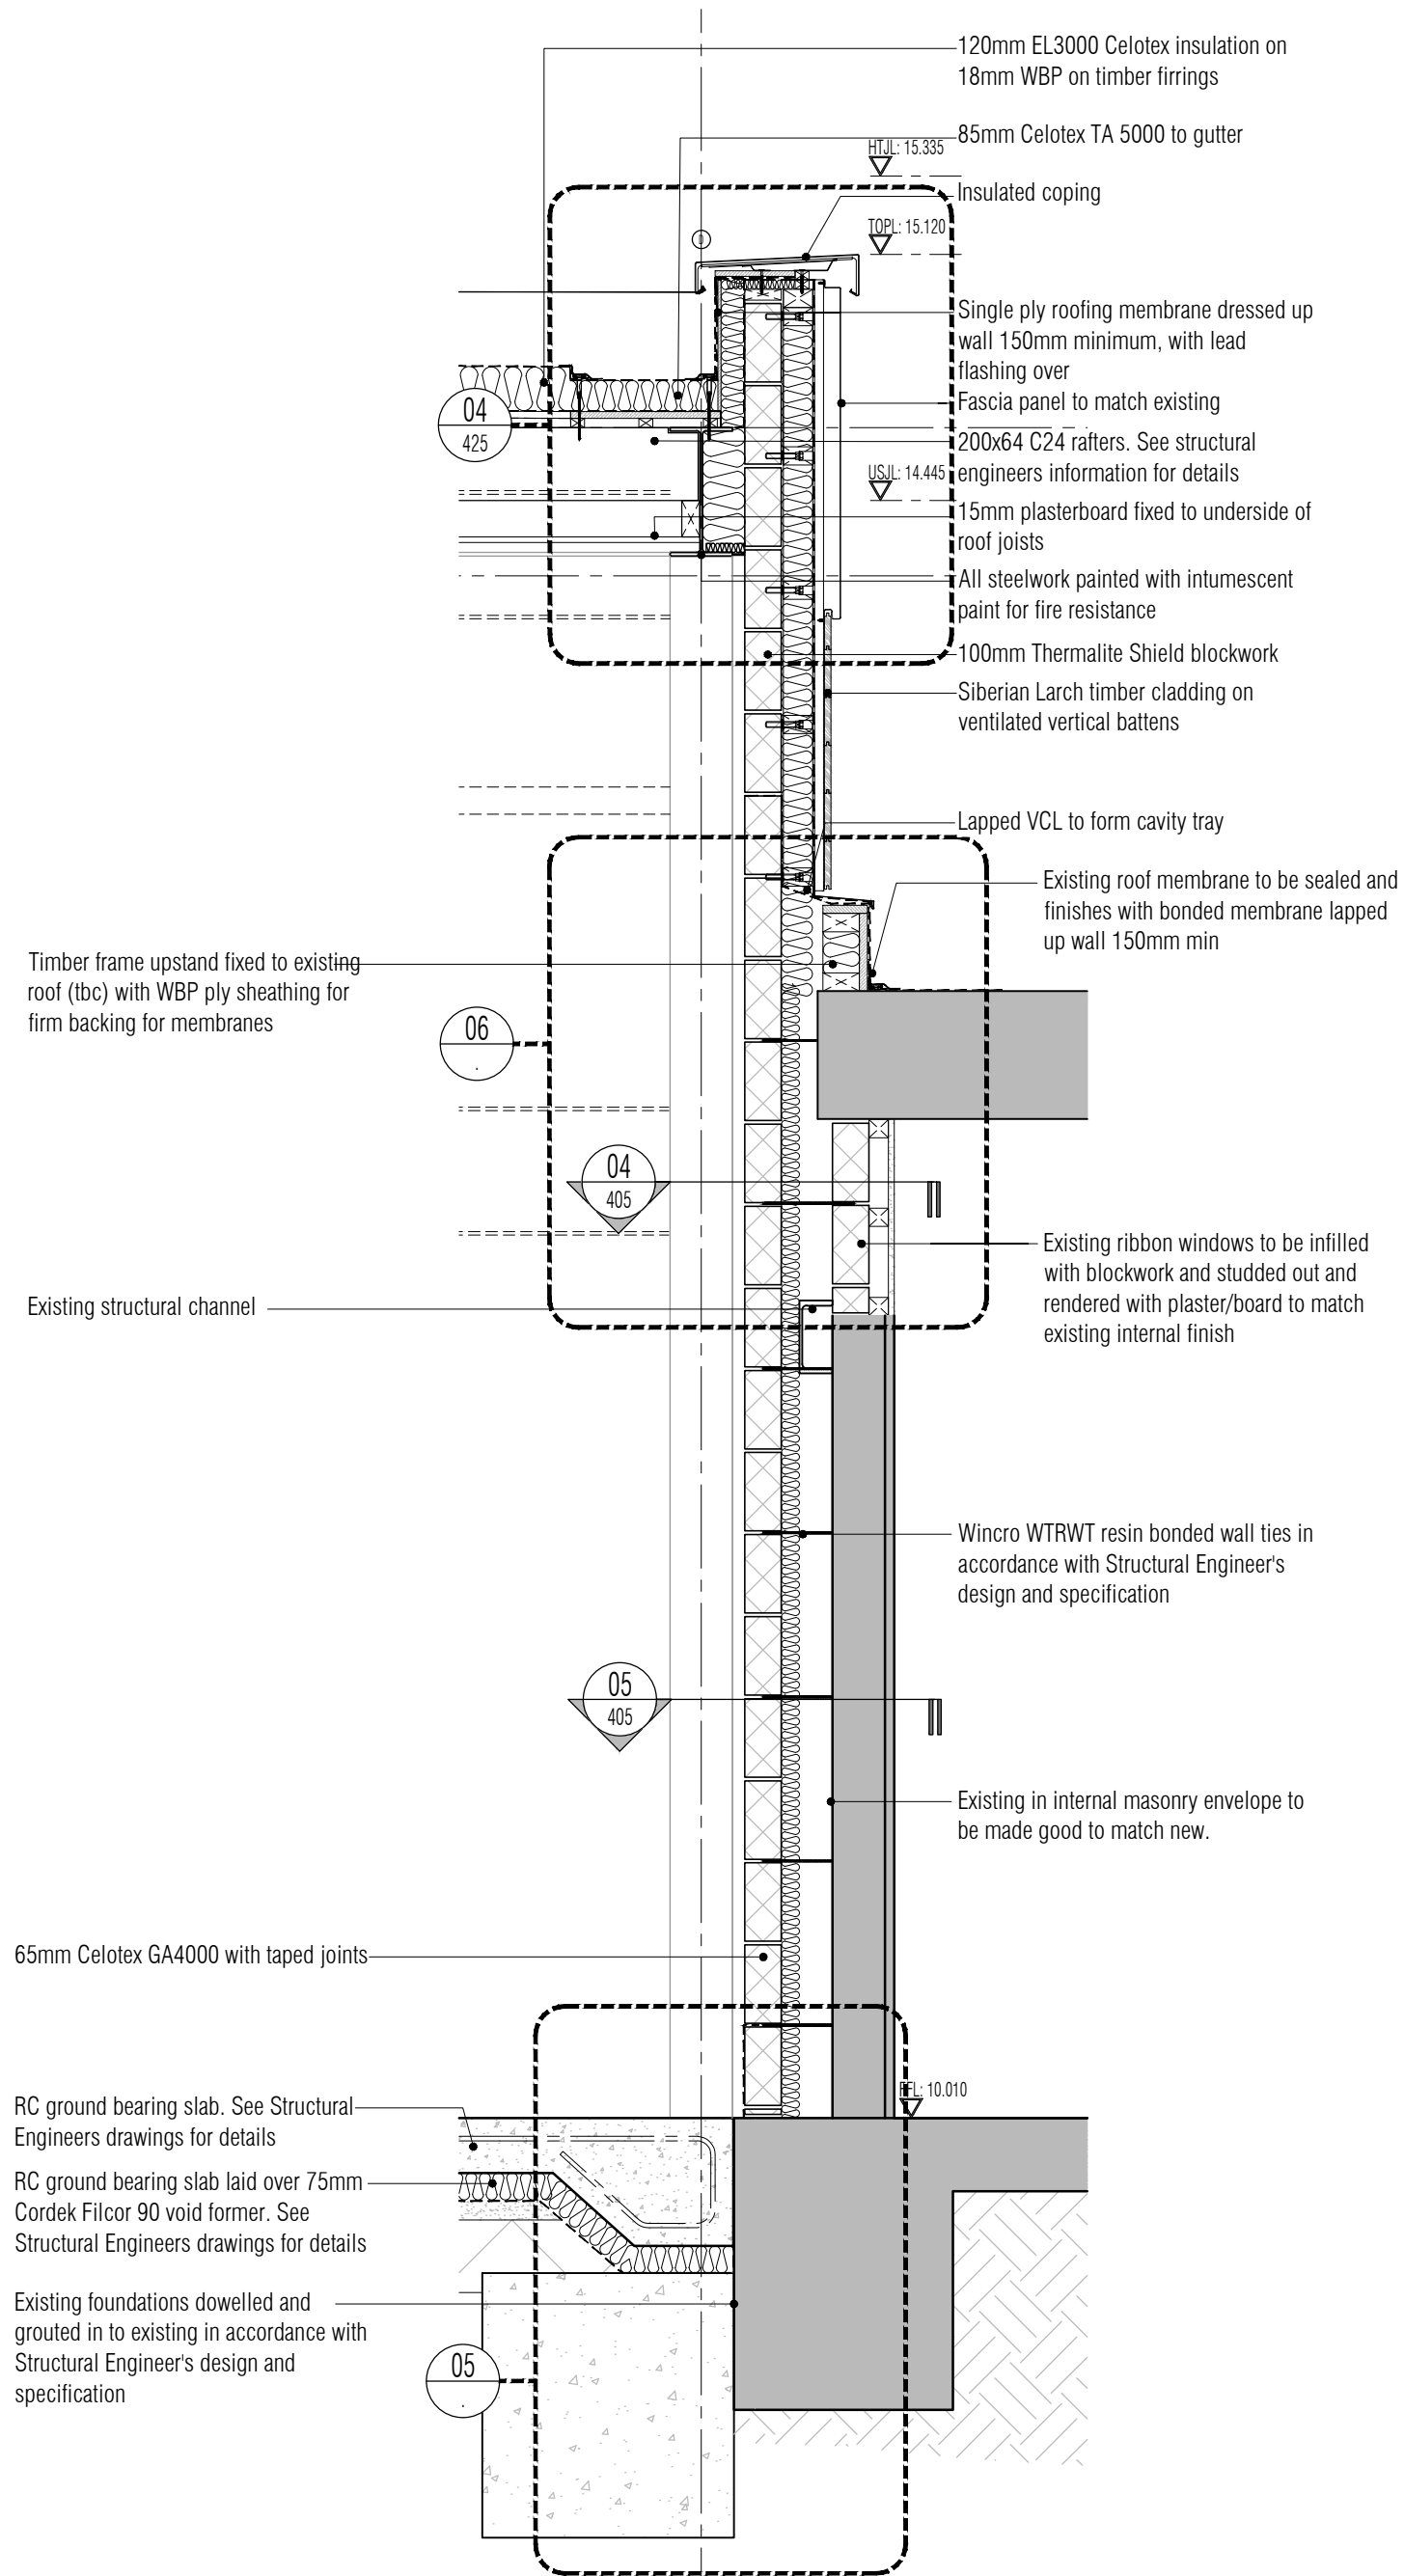

04 Detail Section H Through Plant Room / Flower Prep Wall
Scale: 1:20

NOTES: Do not scale this drawing. All dimensions to be checked on site prior to commencement or manufacture.
Key Plan (nts)

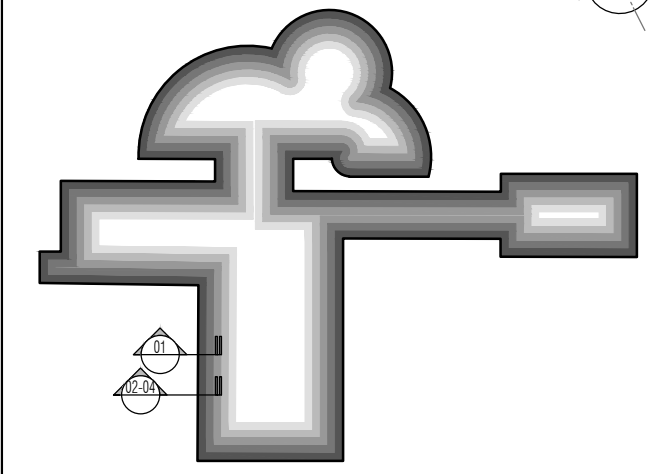

ISSUED FOR CONSTRUCTION

All details referenced in call outs supercede general arrangement or larger depictions.

Rev	Date	By	Chk	Comment
C4	20.08.12	RKC	JAS	Details revd. Cladding to replace brickwork
C3	12.06.12	RKC	JAS	Detail/Section revd to show existing
C2	01.06.12	RKC	JAS	Column foundation revd. Courtyard makeup added
C1	23.04.12	RKC	JAS	Issued for CONSTRUCTION

BRINGING IDEAS TO LIFE


FRANKHAM

Frankham Consultancy Group Limited
21 Perryman Road
Haywards Heath RH16 3TP
t 01444 444900 f 01444 455642
enquiries@frankham.com
www.frankham.com


Client	 Contract N°: Worthing	
Project Title	Eastbourne & Worthing Crematoria Refurbishments and Alterations	
Drawing Title	 Worthing Crematorium Wall Sections G thro' to Courtyard & H thro' to Flower prep	
Drawn by:	Scale:	Date:
RKC	1:20@A1	02.04.12
Designed by:	Checked by:	Approved by:
FCG	JAS	AC
File Ref.: X:\FRANKHAM\2_08051210 CREMATORIA\WORK\449 DETAIL COORDINATOR: 20.06.11 12:18:54		
Drawing No. 521260-A-416-W		Rev. C4

NB: All information based on supplied third party survey information.
All discrepancies to be reported to FCG immediately upon discovery.

All Disabled and Ambulant Disabled facilities to comply with Approved Document Part M - 'Access to and use of buildings', Disability Discrimination Act 1995 and BS83000 as required

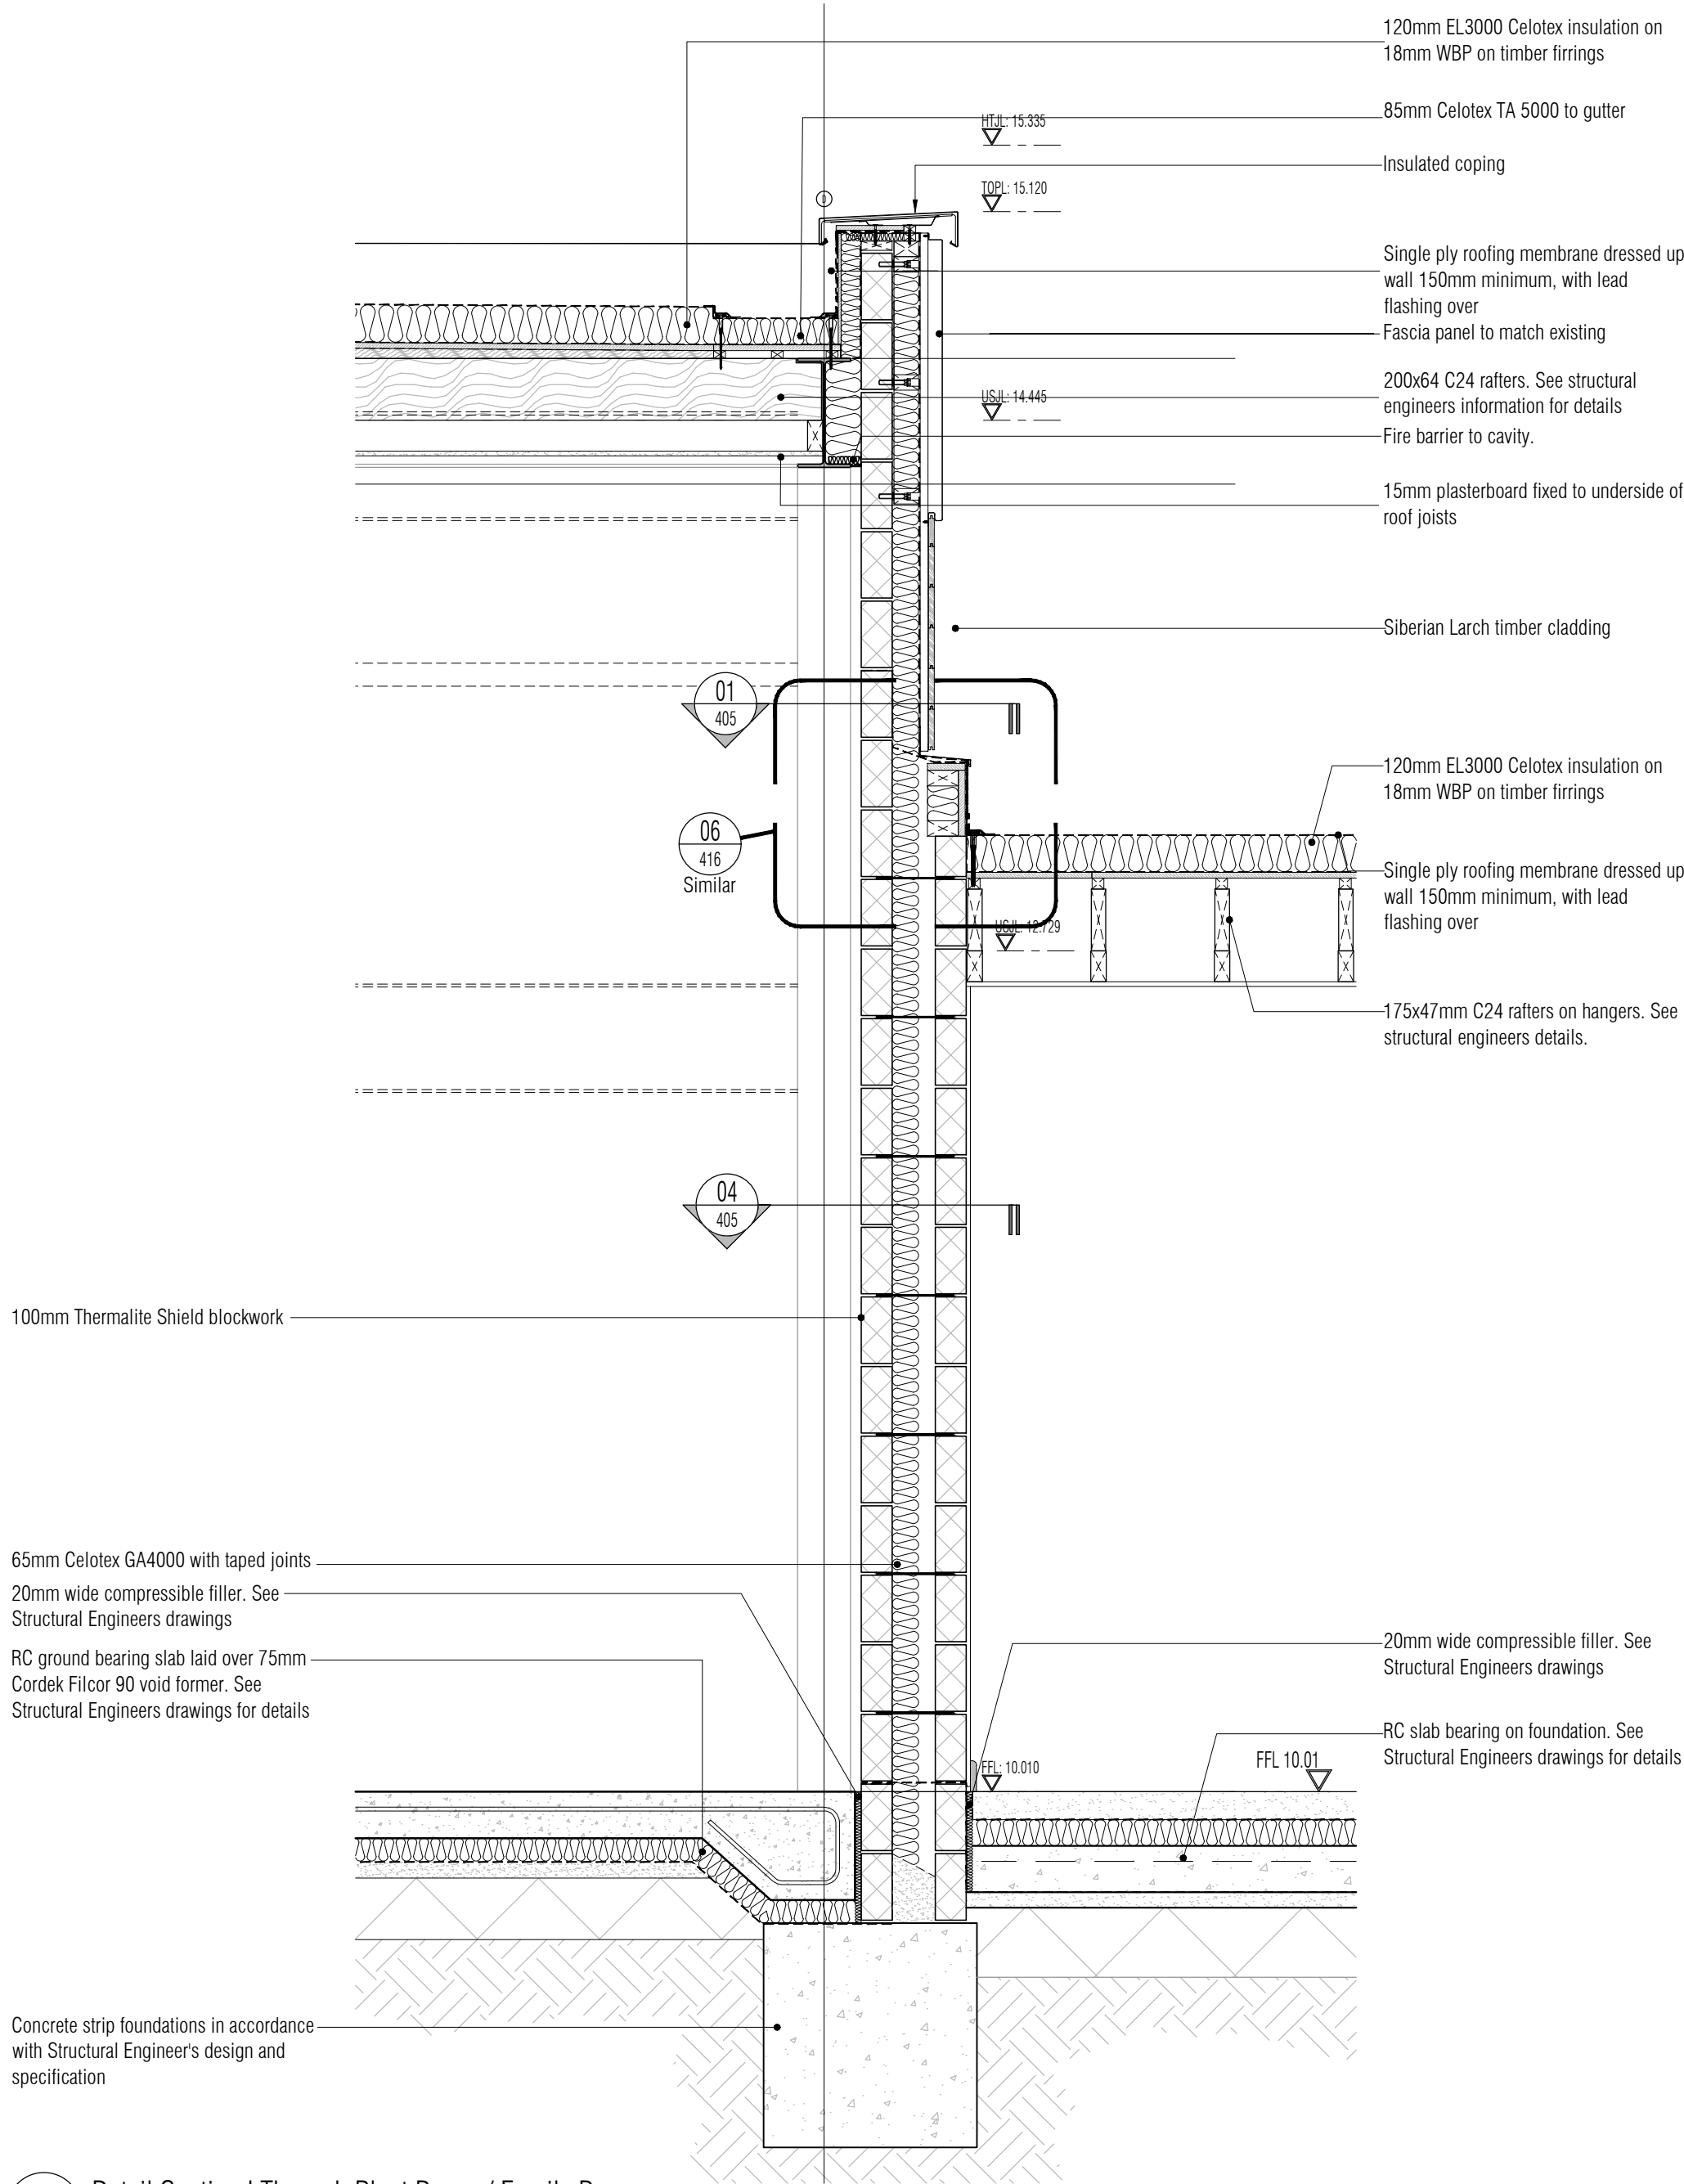


01 Detail Section I Through Plant Room / Family Room
Scale: 1:20

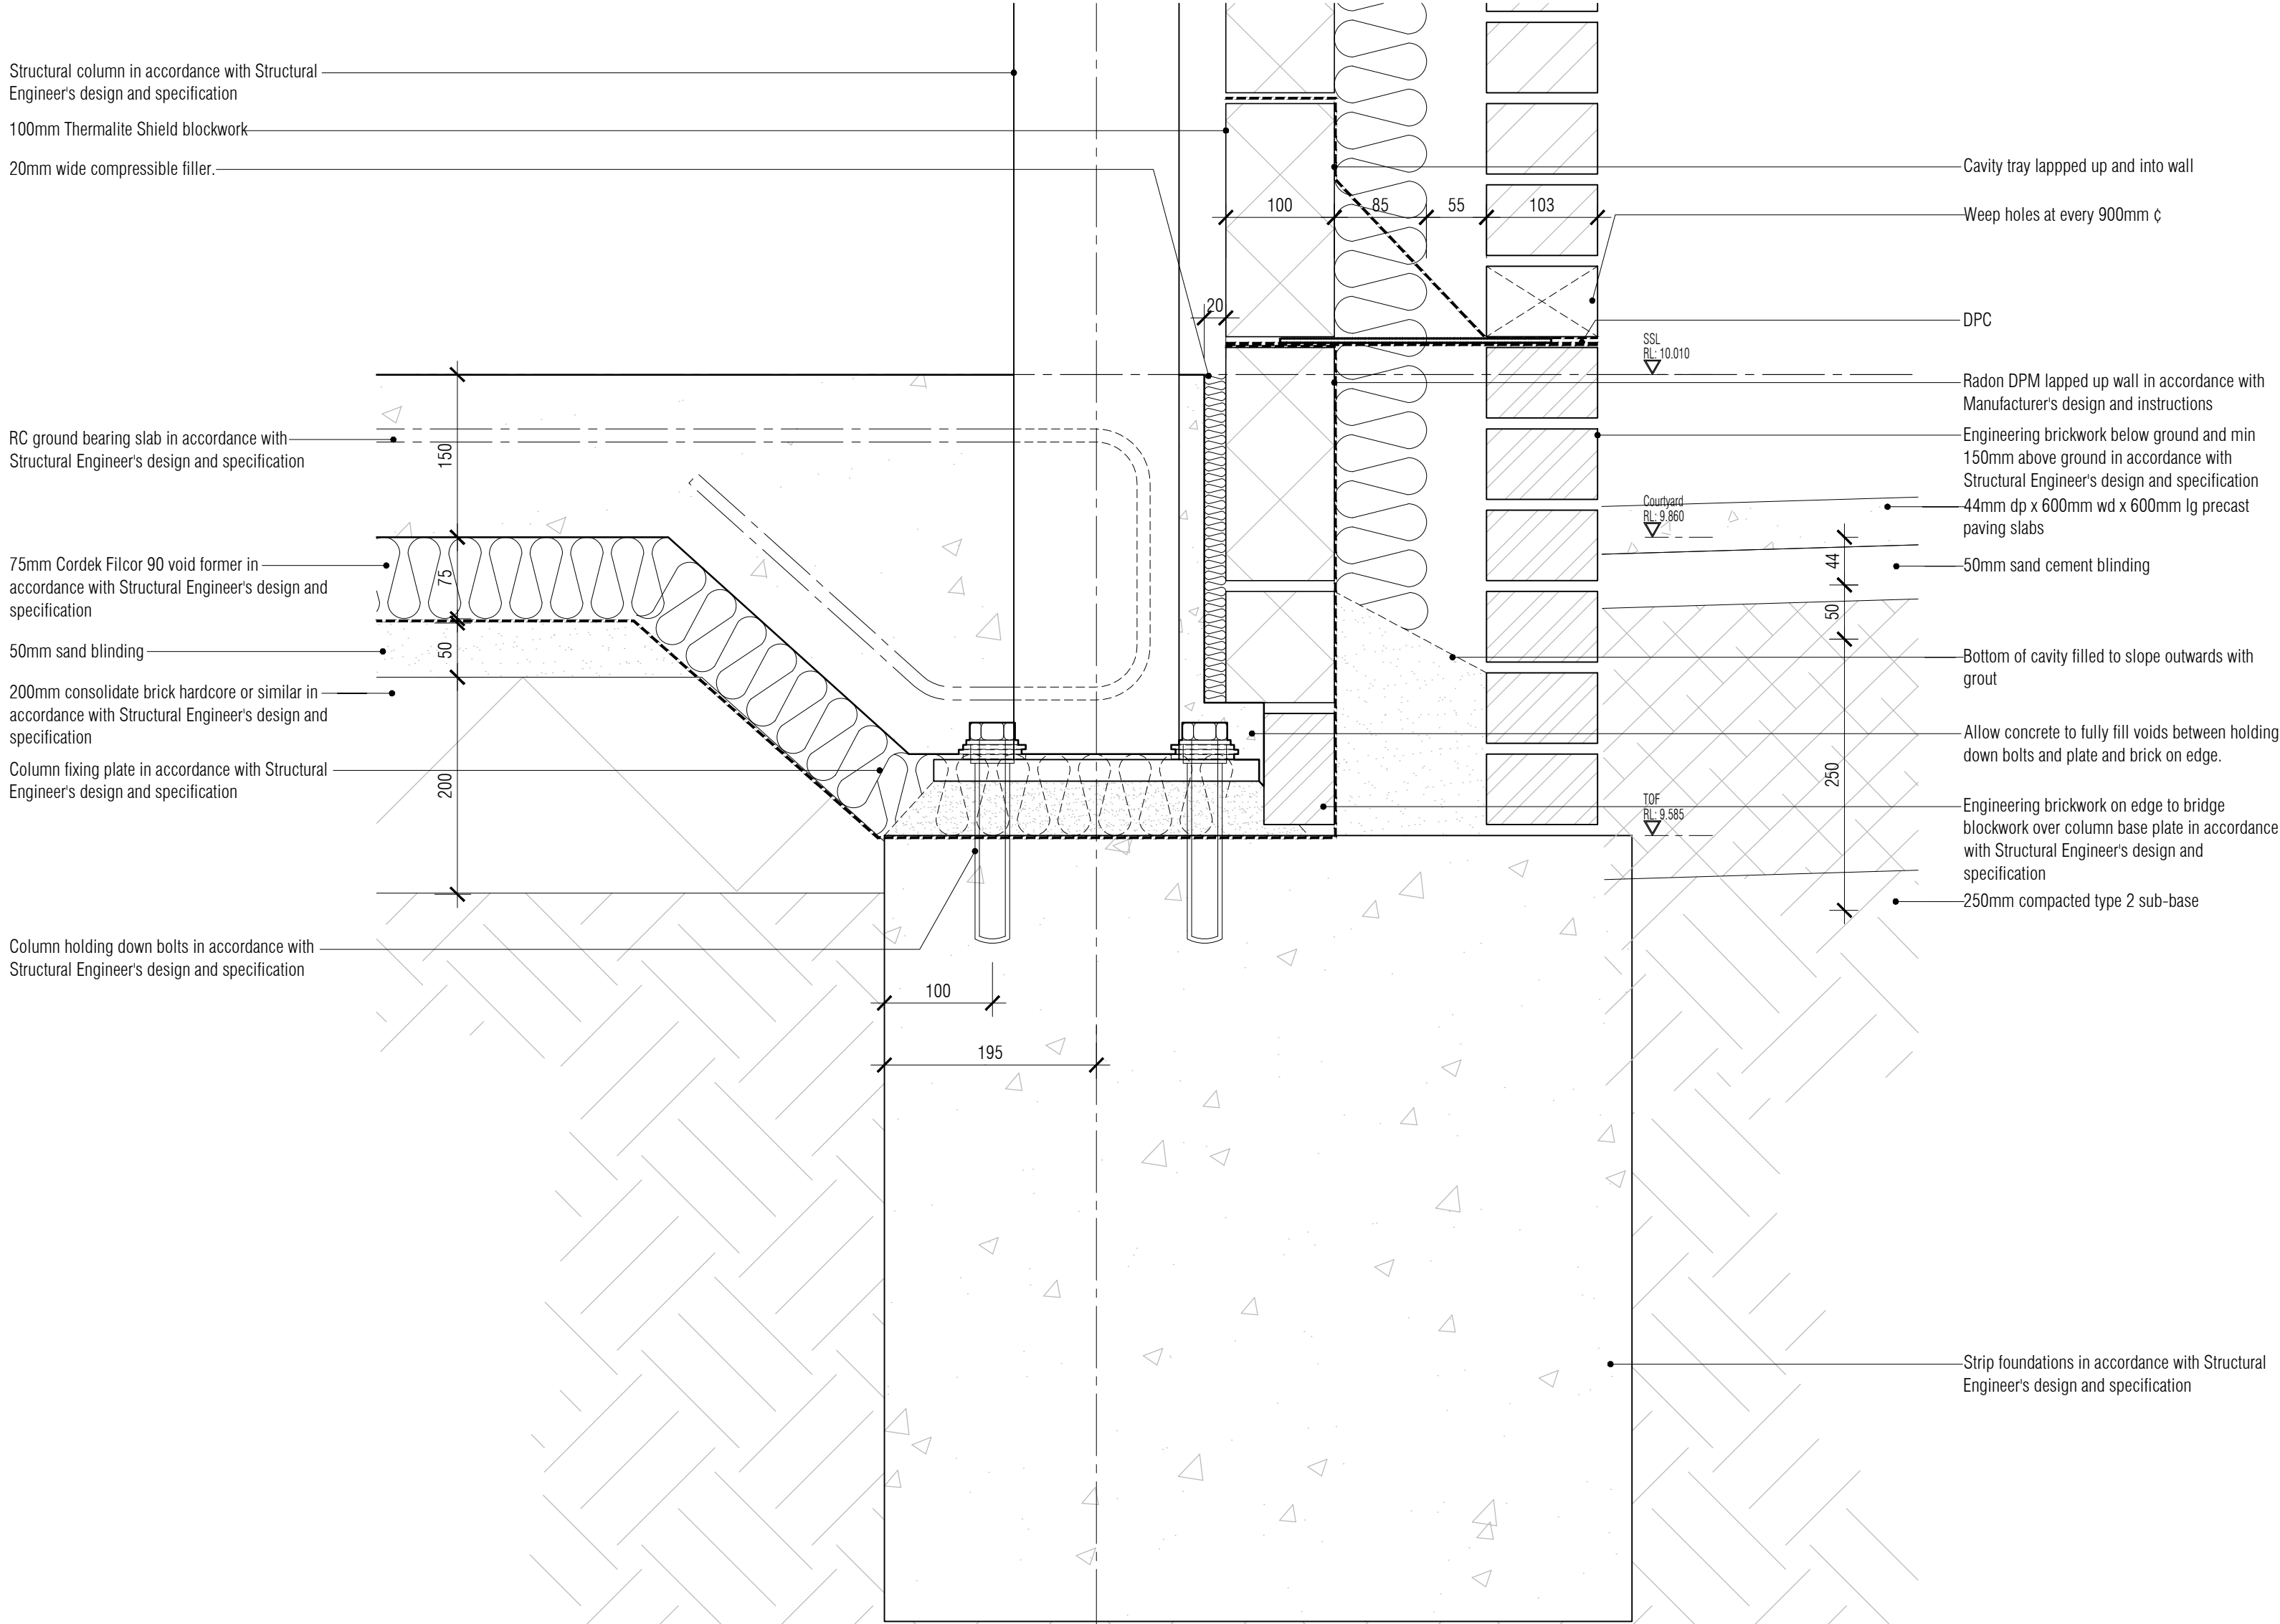

02 Courtyard Surface & Column Base Foundation Fixing Detail
Scale: 1:5

NOTES: Do not scale this drawing. All dimensions to be checked on site prior to commencement or manufacture.
Key Plan (nts)

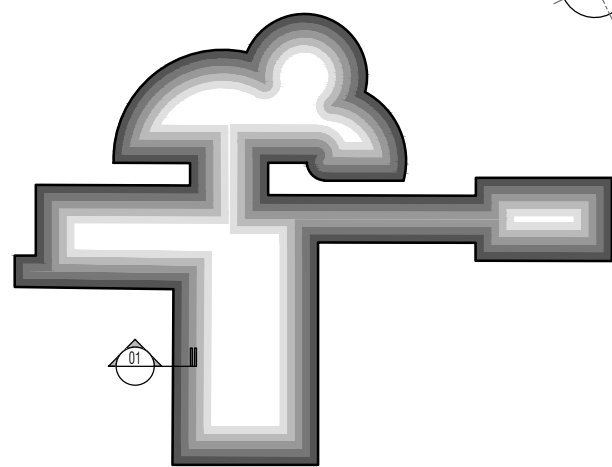

ISSUED FOR CONSTRUCTION

All details referenced in call outs supercede general arrangement or larger depictions.

Rev	Date	By	Chk	Comment
C4	20.08.12	RKC	JAS	Cladding revd
C3	21.06.12	RKC	JAS	Polythene DPM changed to Radon DPM
C2	25.05.12	RKC	JAS	Detail added for Building Control
C1	23.04.12	RKC	JAS	Issued for CONSTRUCTION

BRINGING IDEAS TO LIFE



FRANKHAM

Frankham Consultancy Group Limited
21 Perryman Road
Haywards Heath RH16 3TP
t 01444 444900 f 01444 455642
enquire@frankham.com
www.frankham.com

Client
Mansell
Contract N°: Worthing

Project Title
Eastbourne & Worthing
Crematoria
Refurbishments and Alterations


Drawing Title
Worthing
Worthing Crematorium
Wall Sections I

Drawn by: RKC	Scale: 1:20@A1	Date: 02.04.12
Designed by: FCG	Checked by: JAS	Approved by: AC


File Ref.: 301360-A-417-W-0001 - 200811211550 20.06.11.12.18.58

Drawing No. 521260-A-417-W	Rev. C4
-------------------------------	------------


NB: All information based on supplied third party survey information.
All discrepancies to be reported to FCG immediately upon discovery.

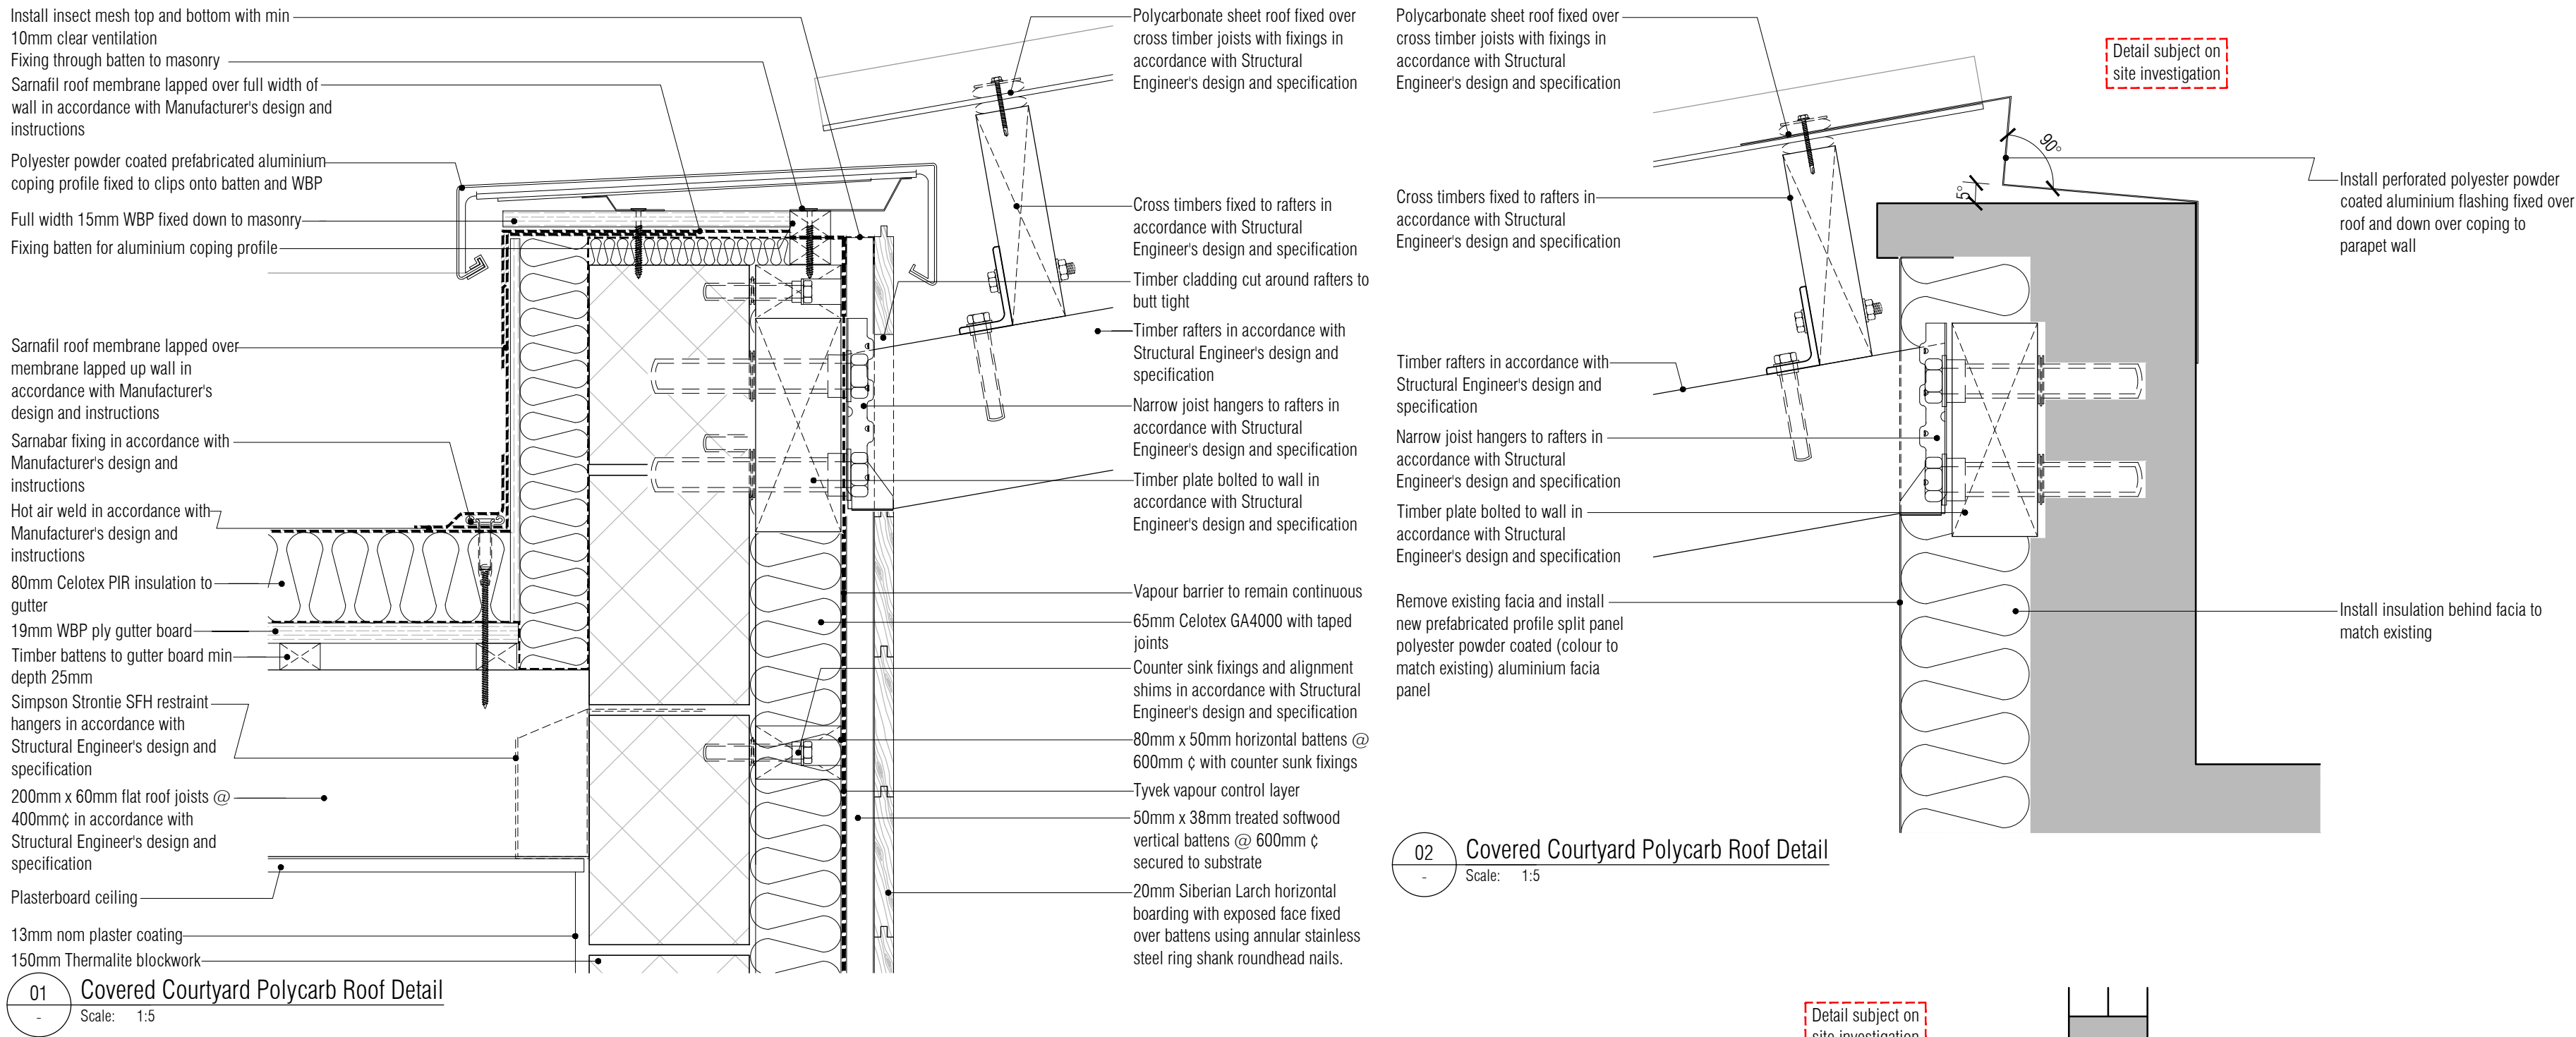


01 Covered Courtyard Polycarb Roof Detail
Scale: 1:5

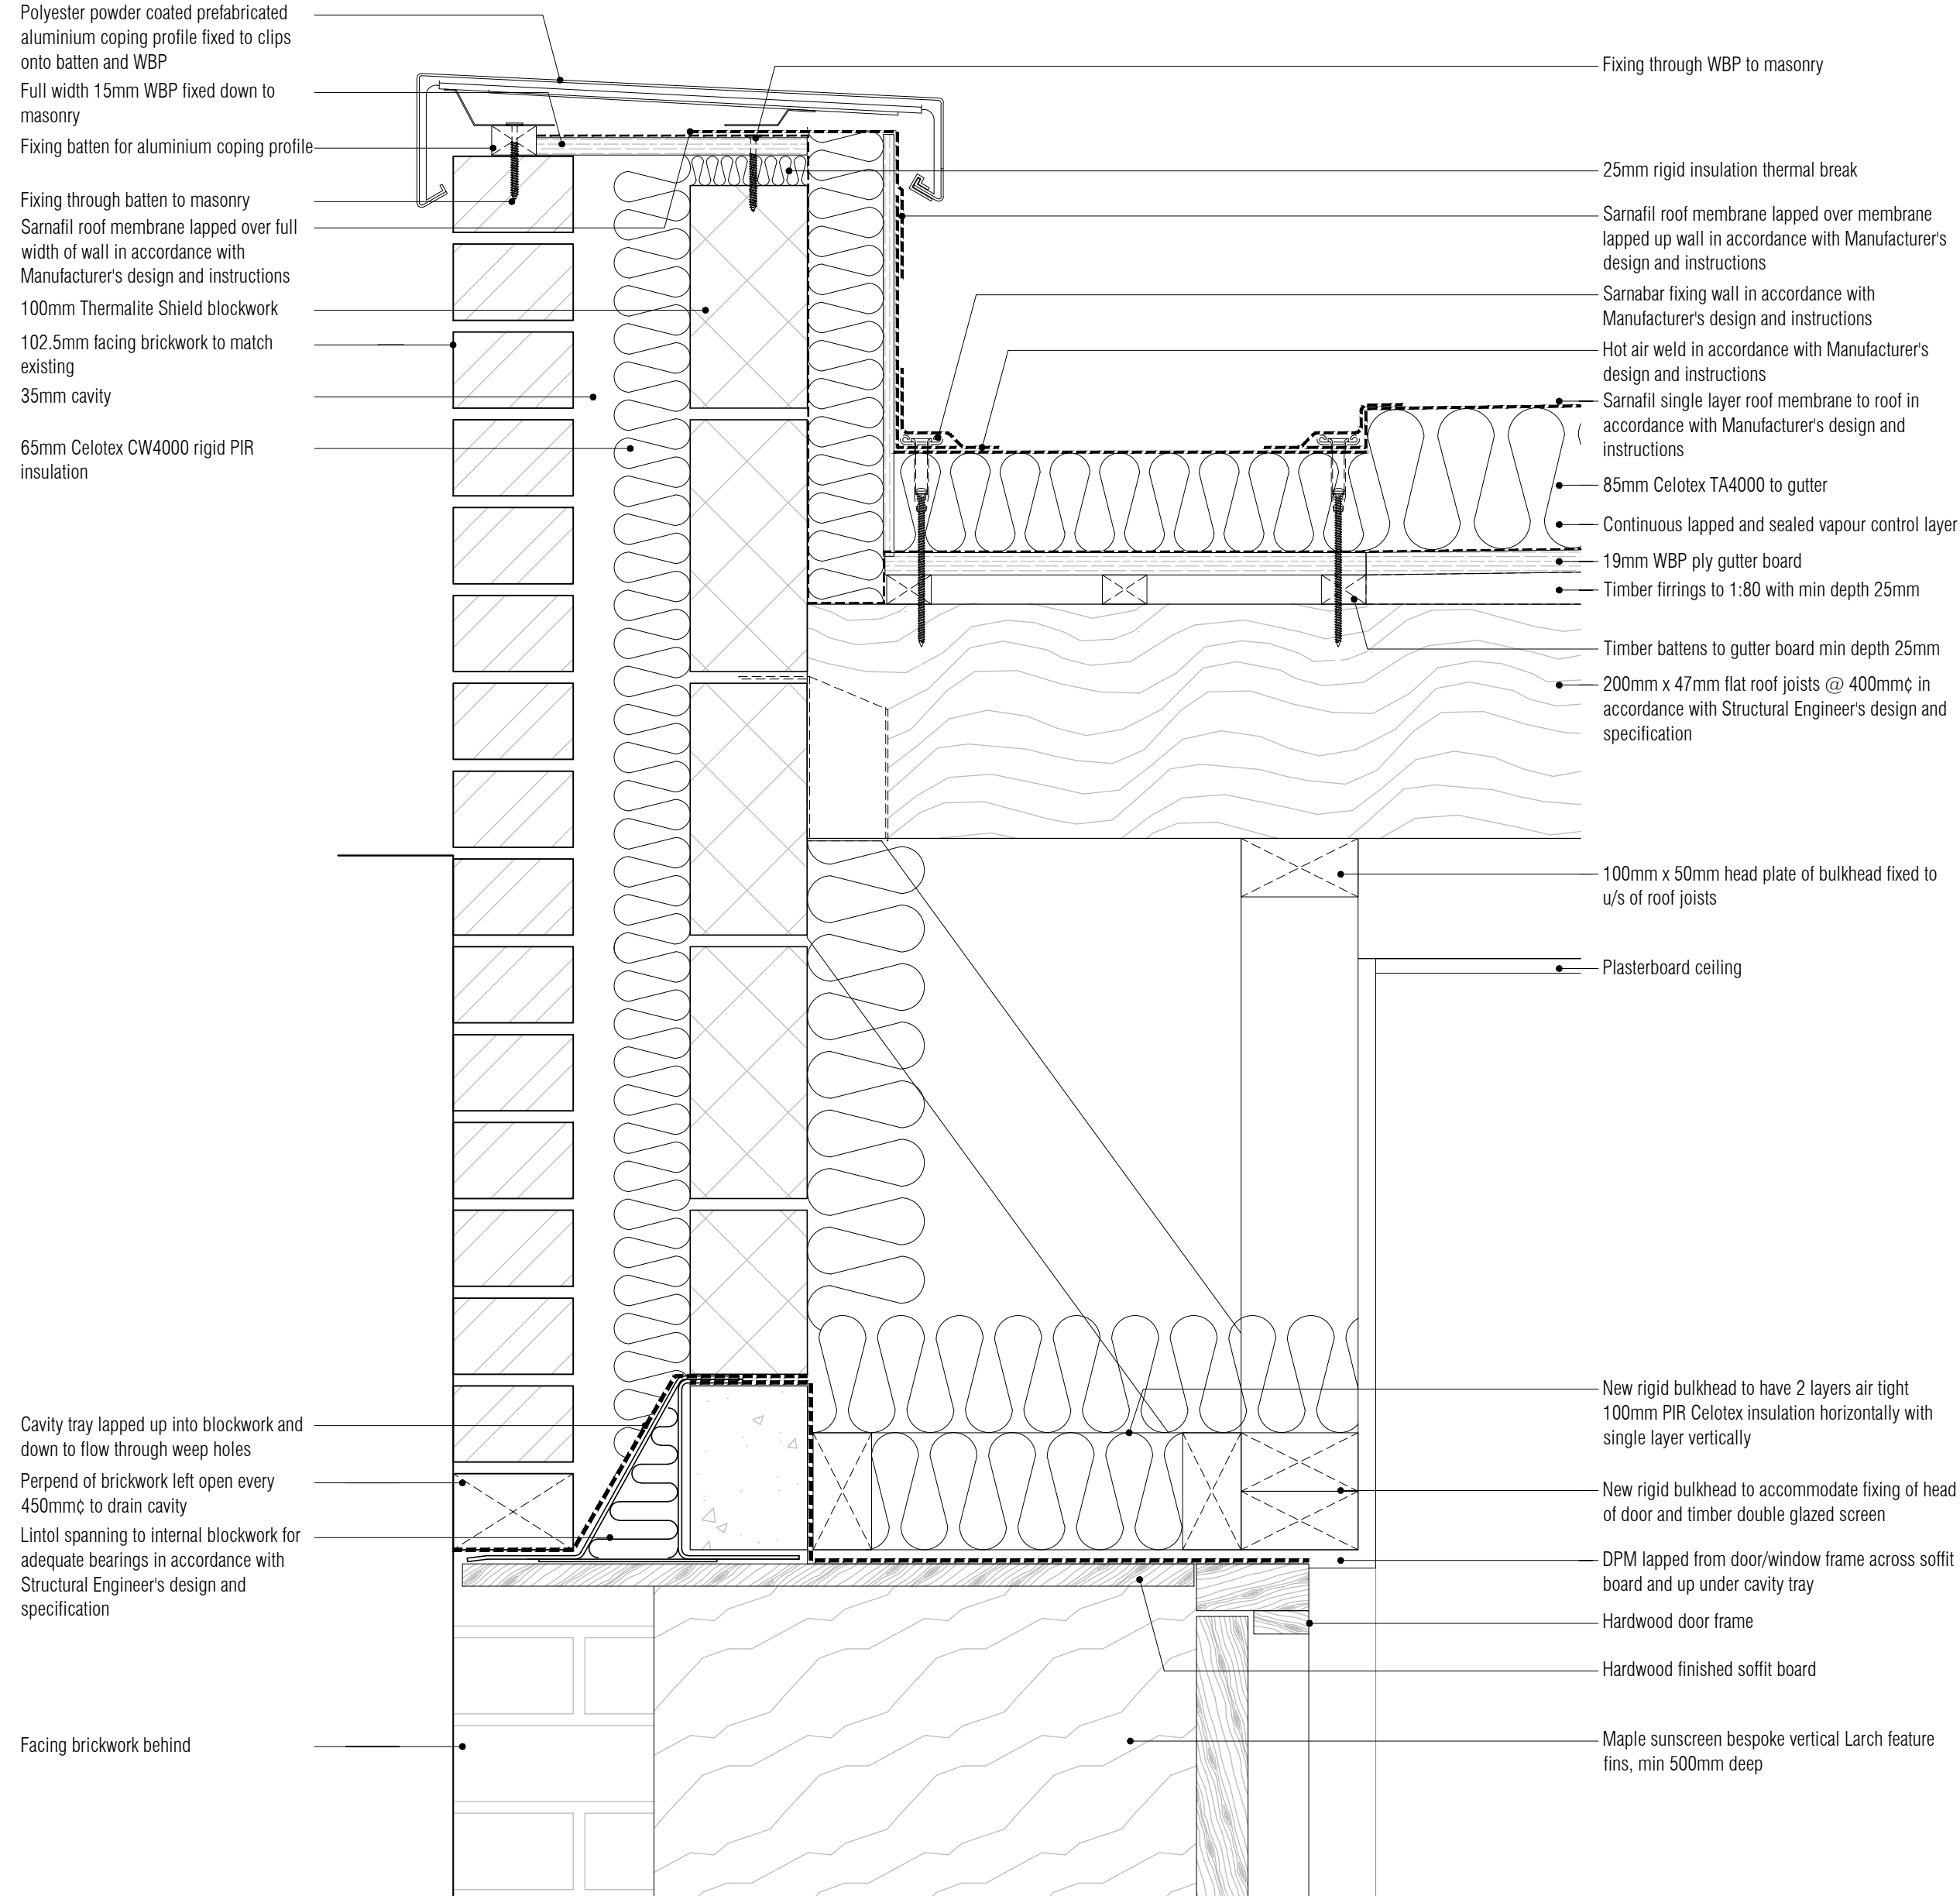

02 Courtyard Extension Family Room Glazed Screen Bulkhead Detail
Scale: 1:5

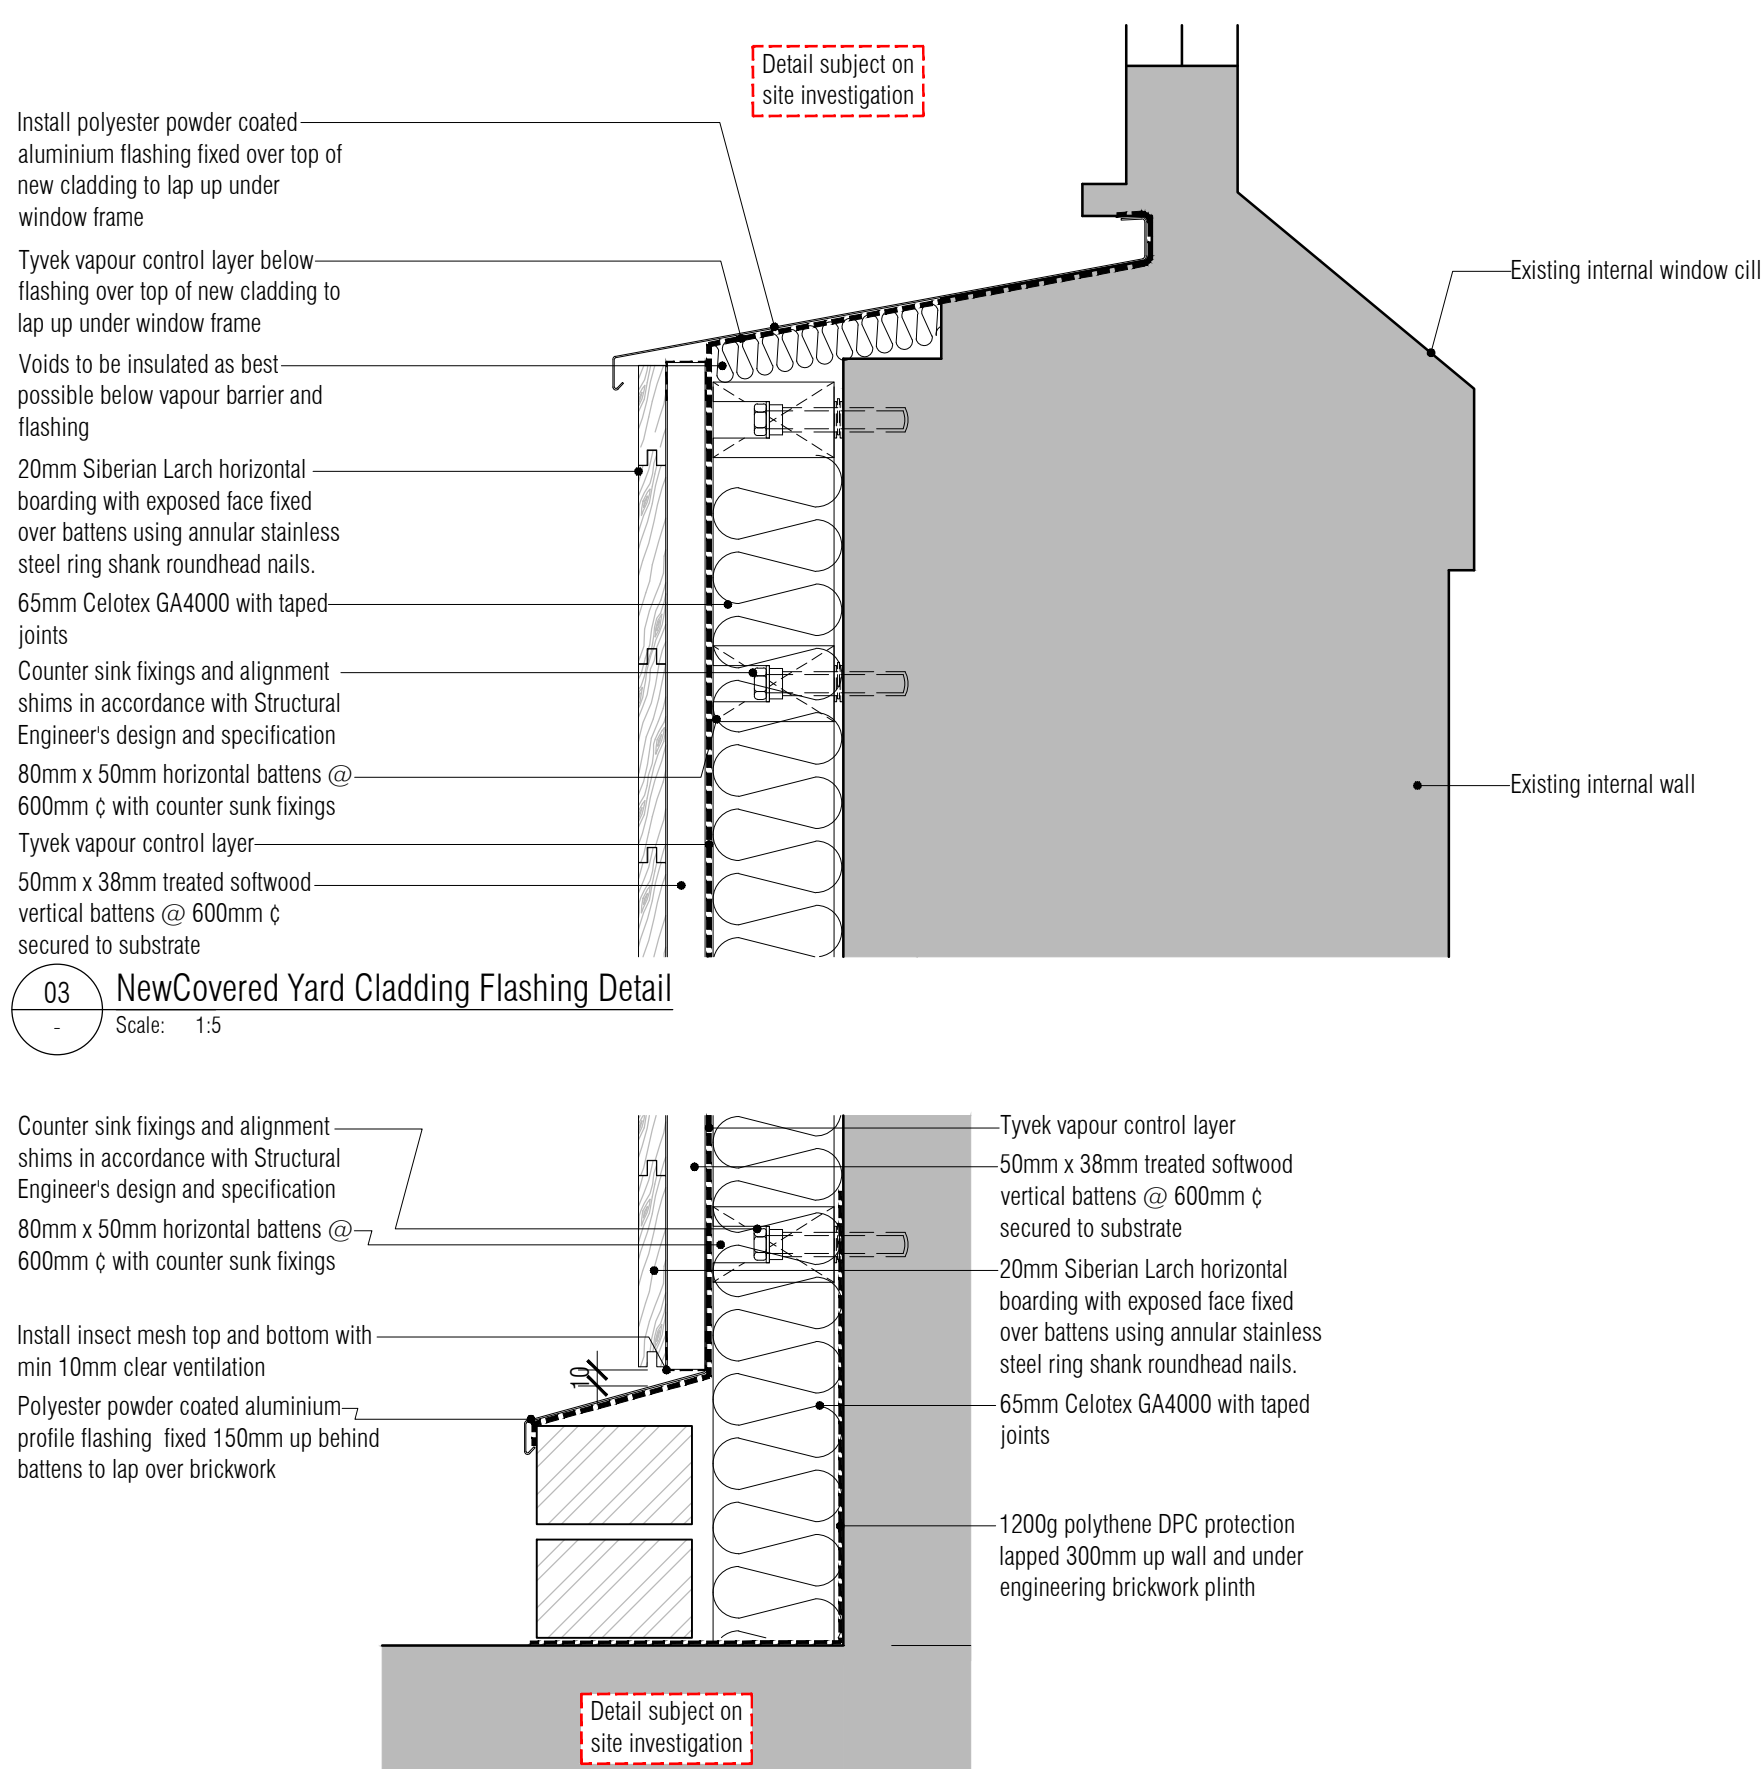


03 New Covered Yard Cladding Flashing Detail
Scale: 1:5

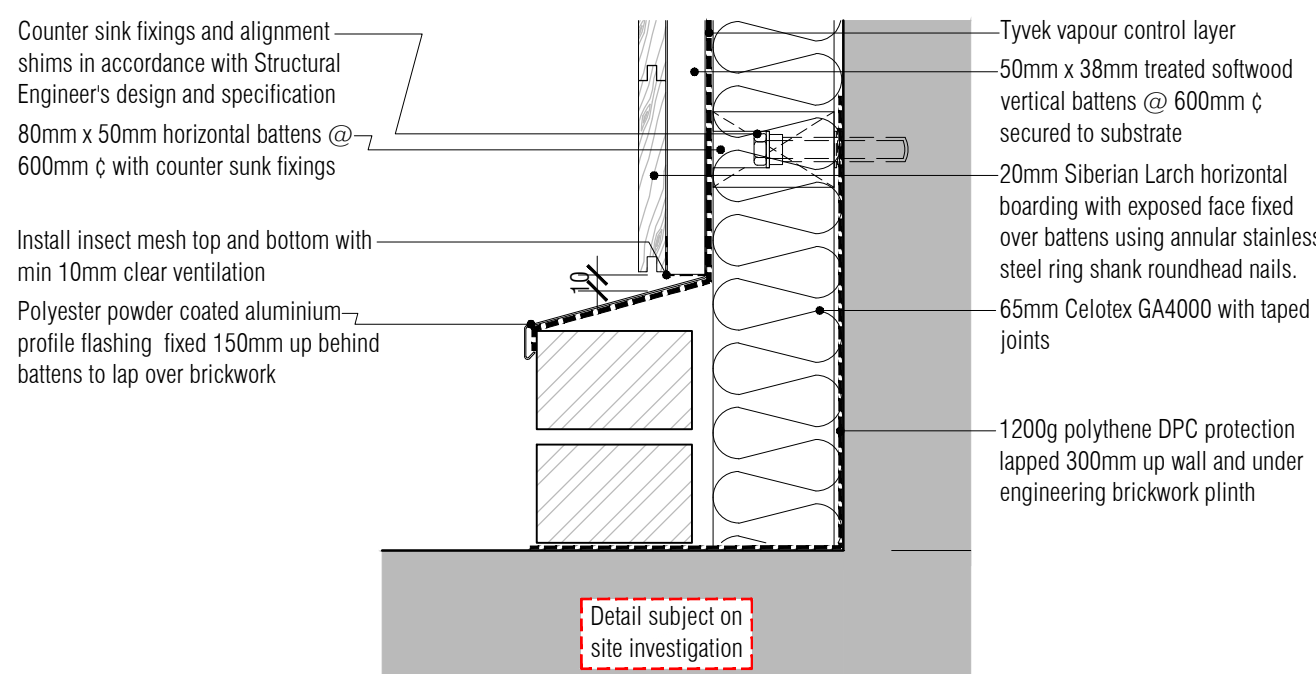

04 New Covered Yard Cladding Plinth Detail
Scale: 1:5

NOTES: Do not scale this drawing. All dimensions to be checked on site prior to commencement or manufacture.
Key Plan (nts)

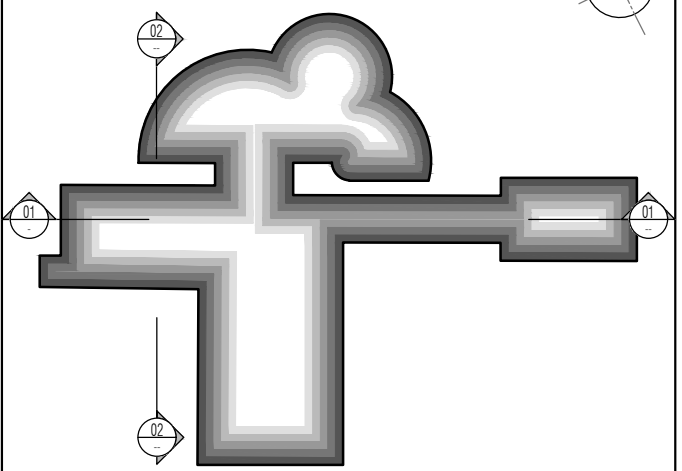

ISSUED FOR CONSTRUCTION

All details referenced in call outs supercede general arrangement or larger depictions.

Rev	Date	By	Chk	Comment
C1	09.07.12	RKC	JAS	Issued for Construction
P2	01.06.12	RKC	JAS	Detail added
P1	25.05.12	RKC	JAS	Issued for Stage E

BRINGING IDEAS TO LIFE


FRANKHAM

Frankham Consultancy Group Limited
21 Pymms Road
Haywards Heath RH16 3TP
t 01444 444900 f 01444 455642
enquiries@frankham.com
www.frankham.com


Client		 Contract N°: Worthing	
Project Title Eastbourne & Worthing Crematoria Refurbishments and Alterations			
Drawing Title  Worthing Crematorium Covered Courtyard Polycarb Roof and Cladding Details			
Drawn by: RKC	Scale: 1:5@A1	Date: 25.05.12	
Designed by: FCG	Checked by: JAS	Approved by: AC	
File Ref: X:\FRANKHAM\2_08051210 CREMATORIA\WORK\489 DETAIL COORDINATES 317360-A-418-W-0001 - 200811121901			
Drawing No. 521260-A-418-W		Rev. C1	

NB: All information based on supplied third party survey information.
All discrepancies to be reported to FCG immediately upon discovery.


All Disabled and Ambulant Disabled facilities to comply with Approved Document Part M - Access to and use of buildings*, Disability Discrimination Act 1995 and BS83000 as required

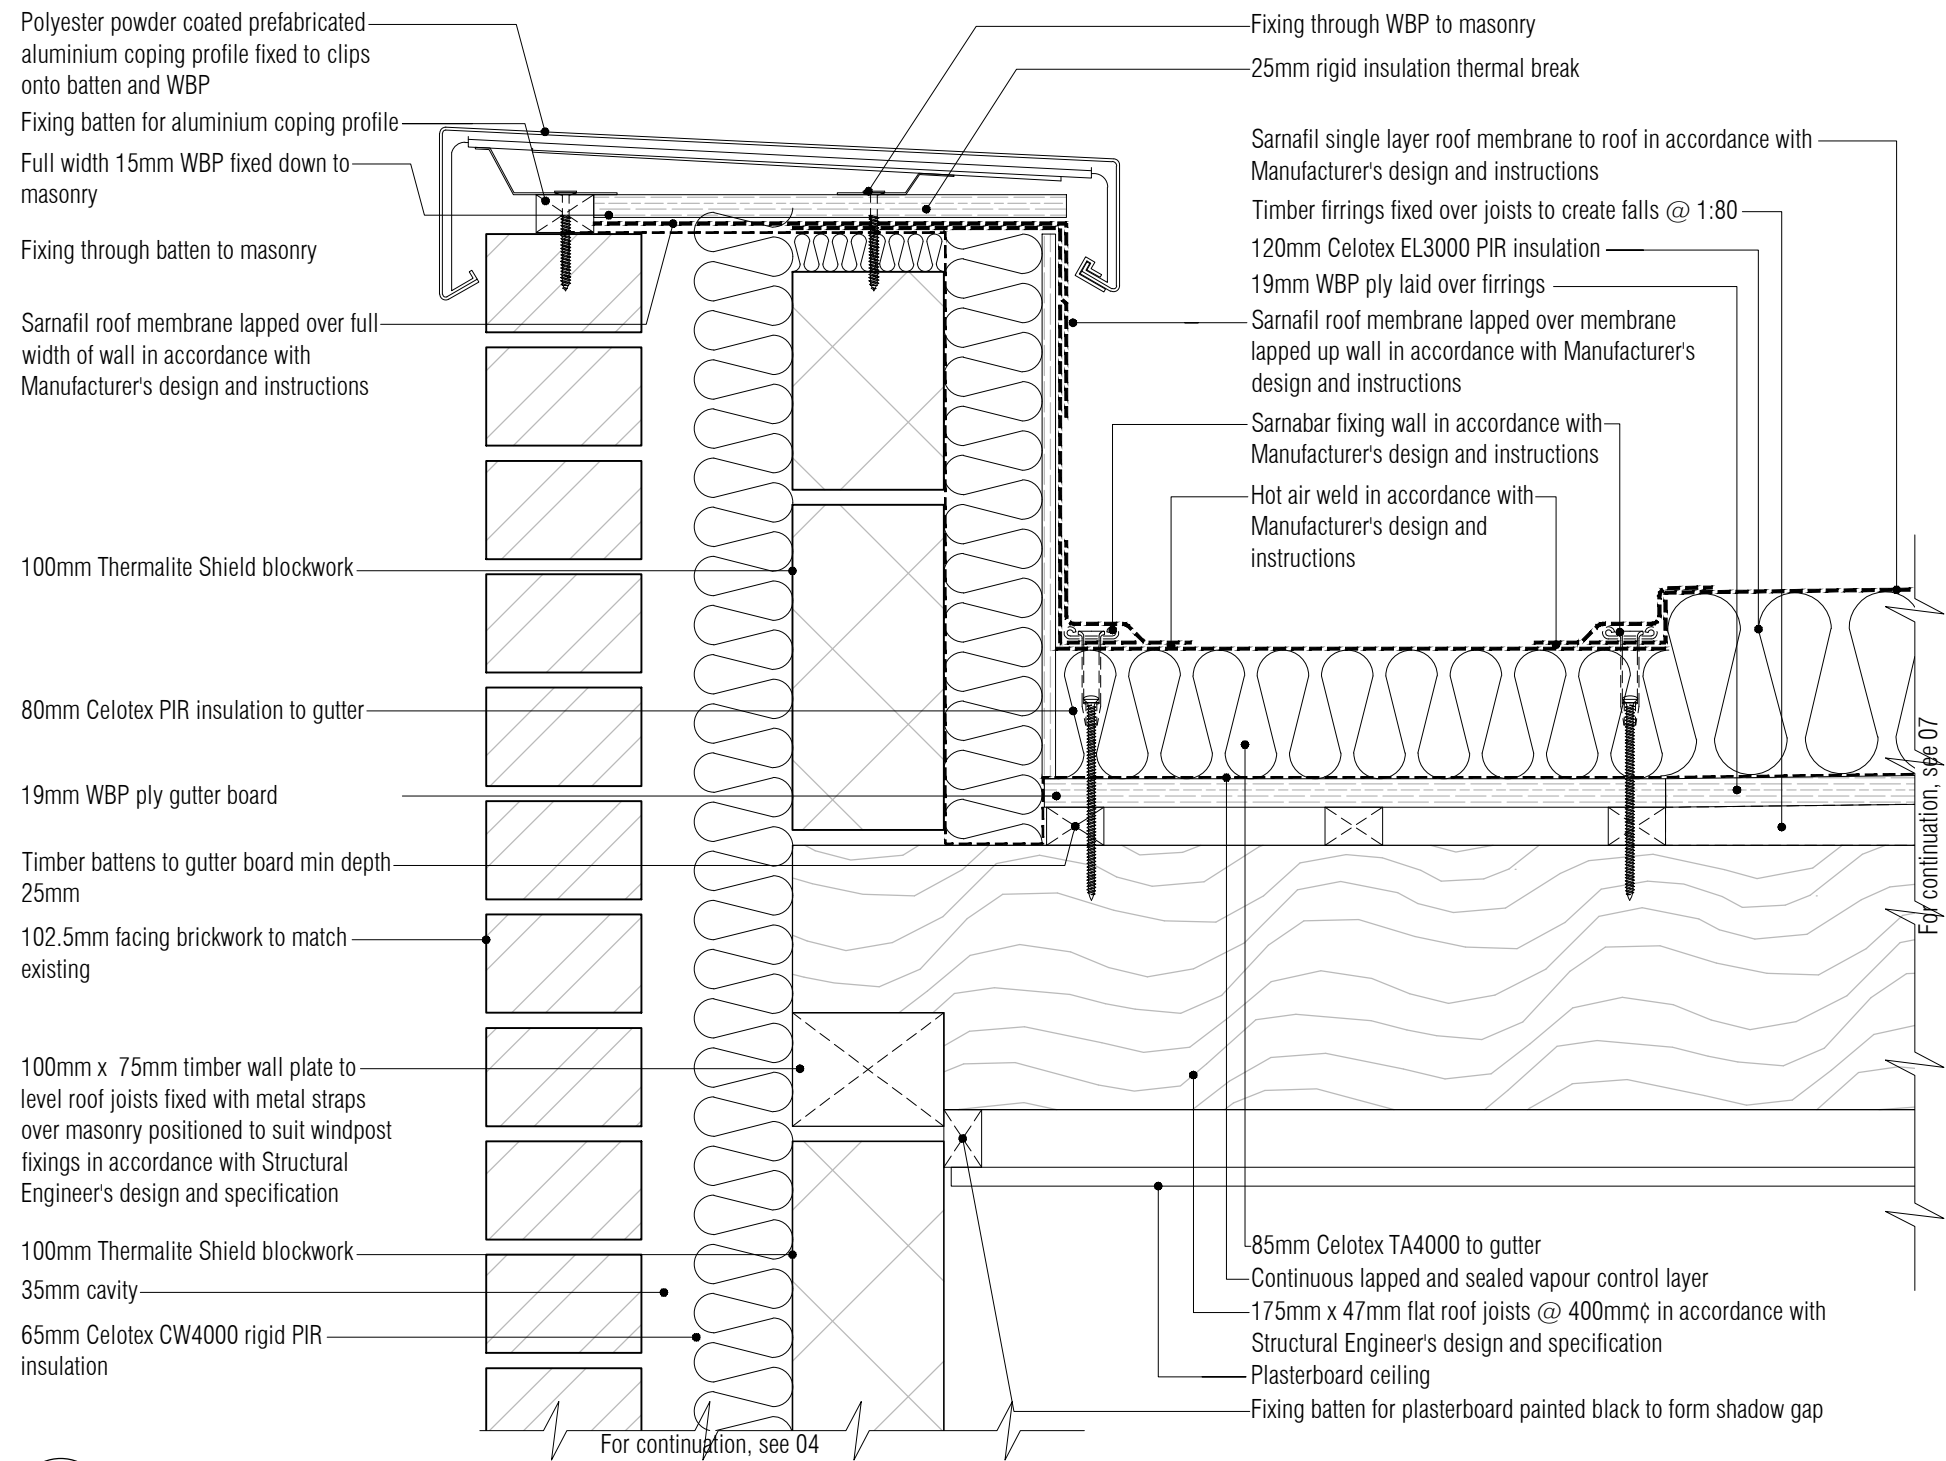


01 Typical Parapet & Gutter Detail

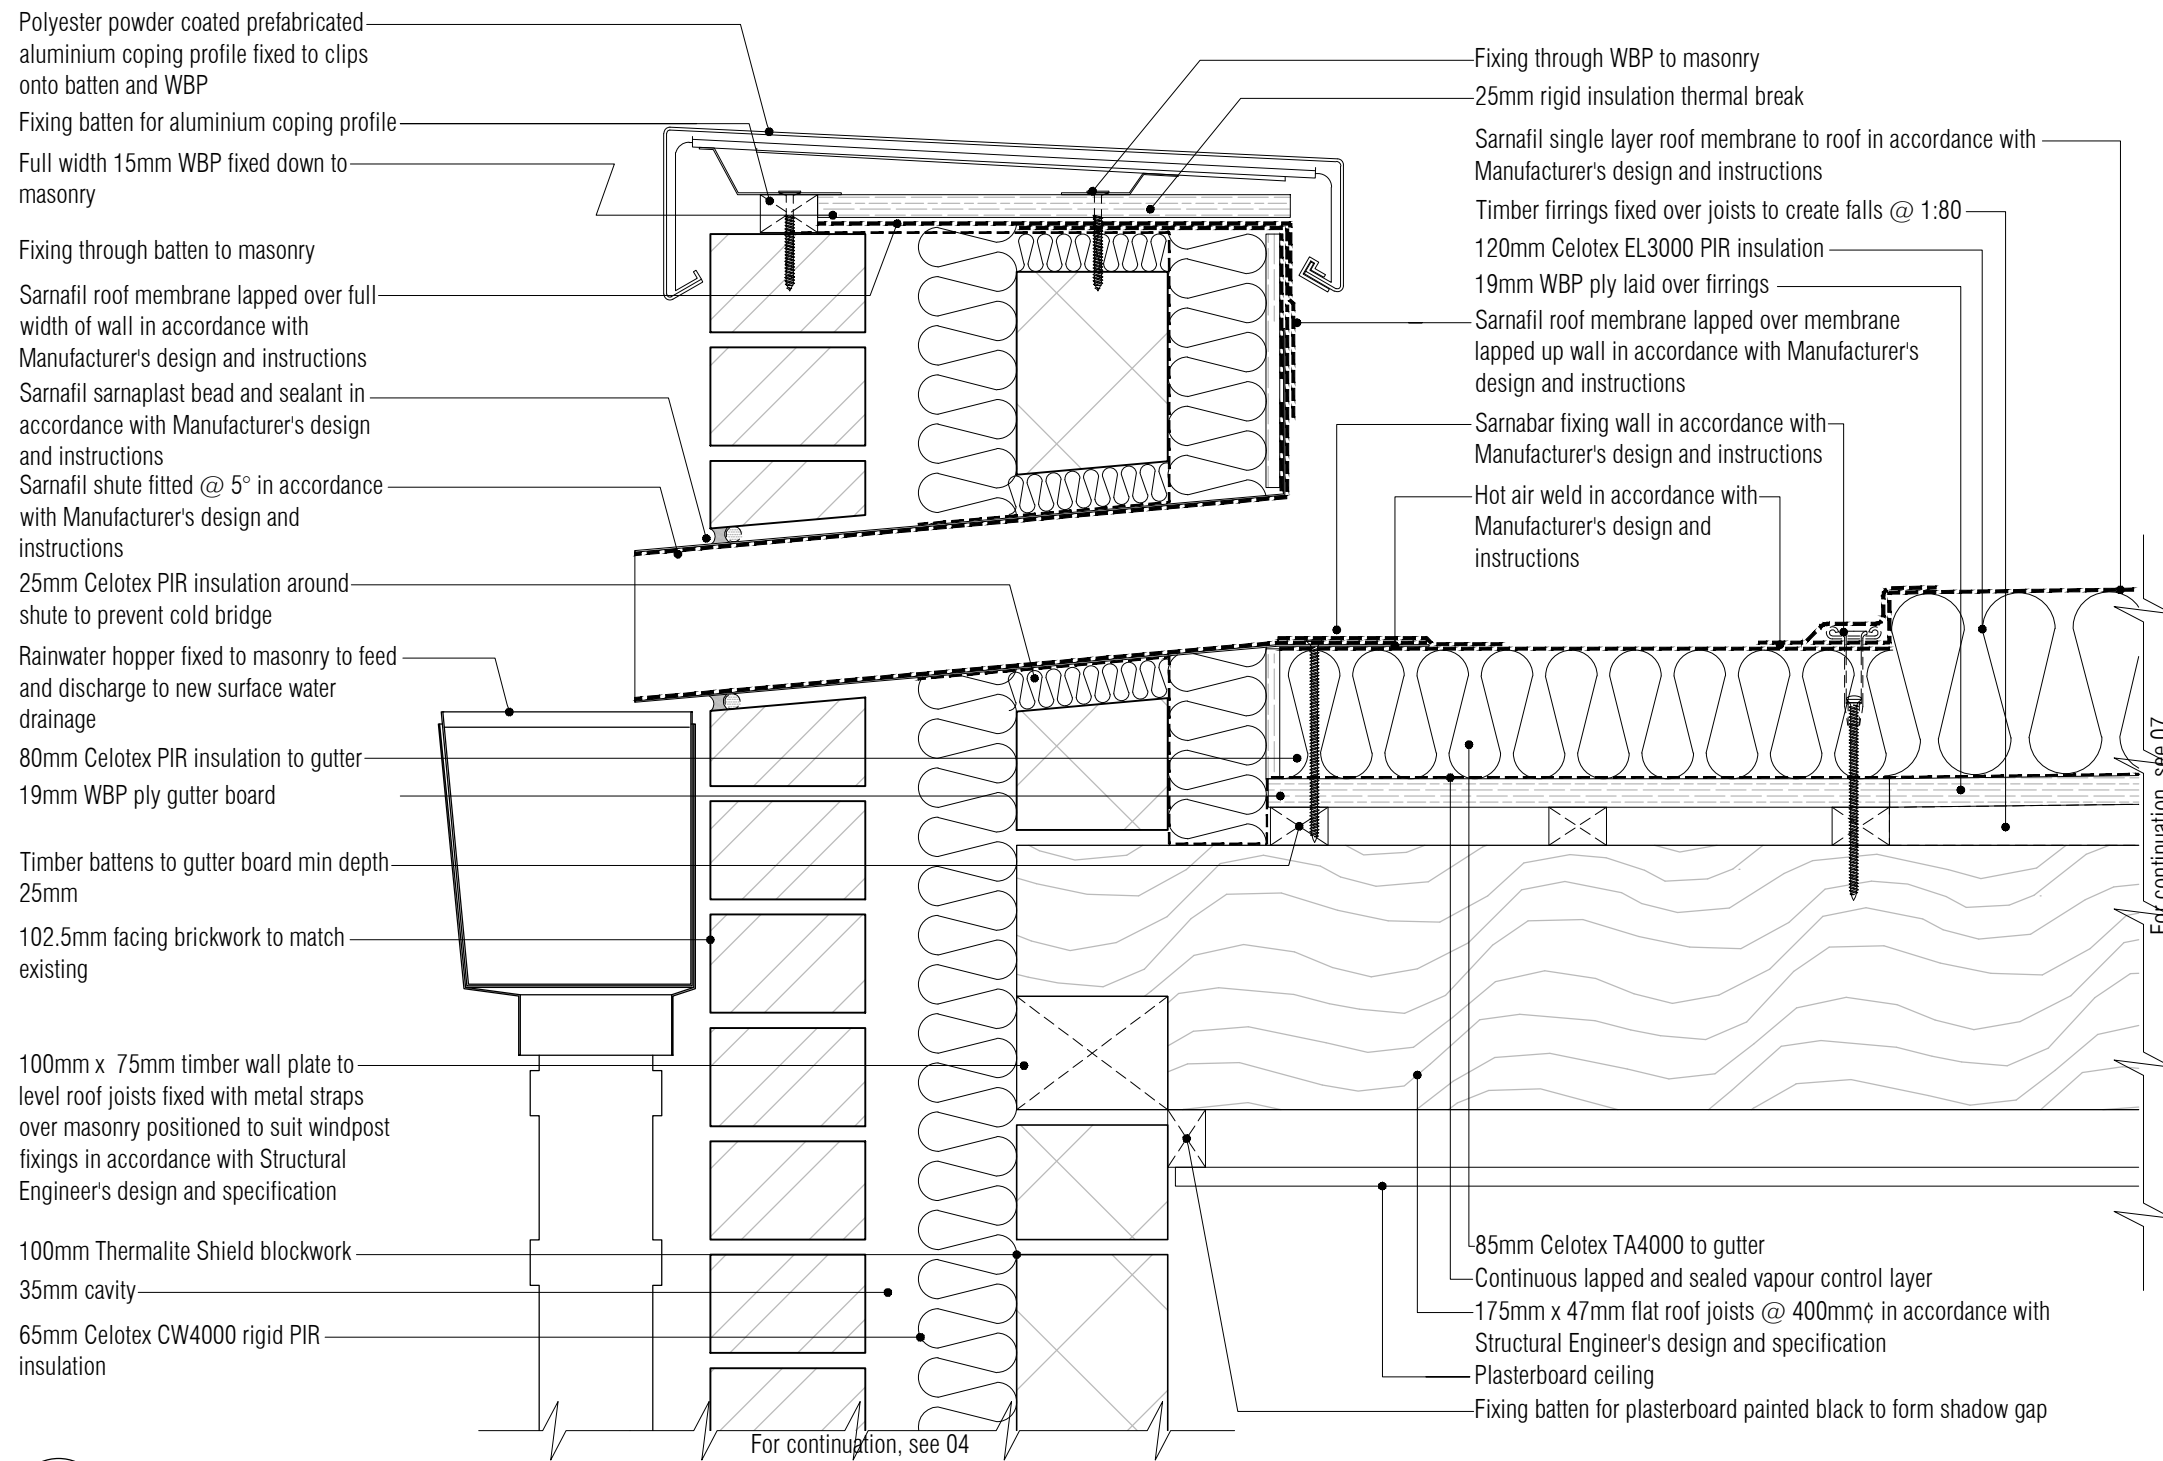


02 Typical Parapet Outlet & Hopper Detail

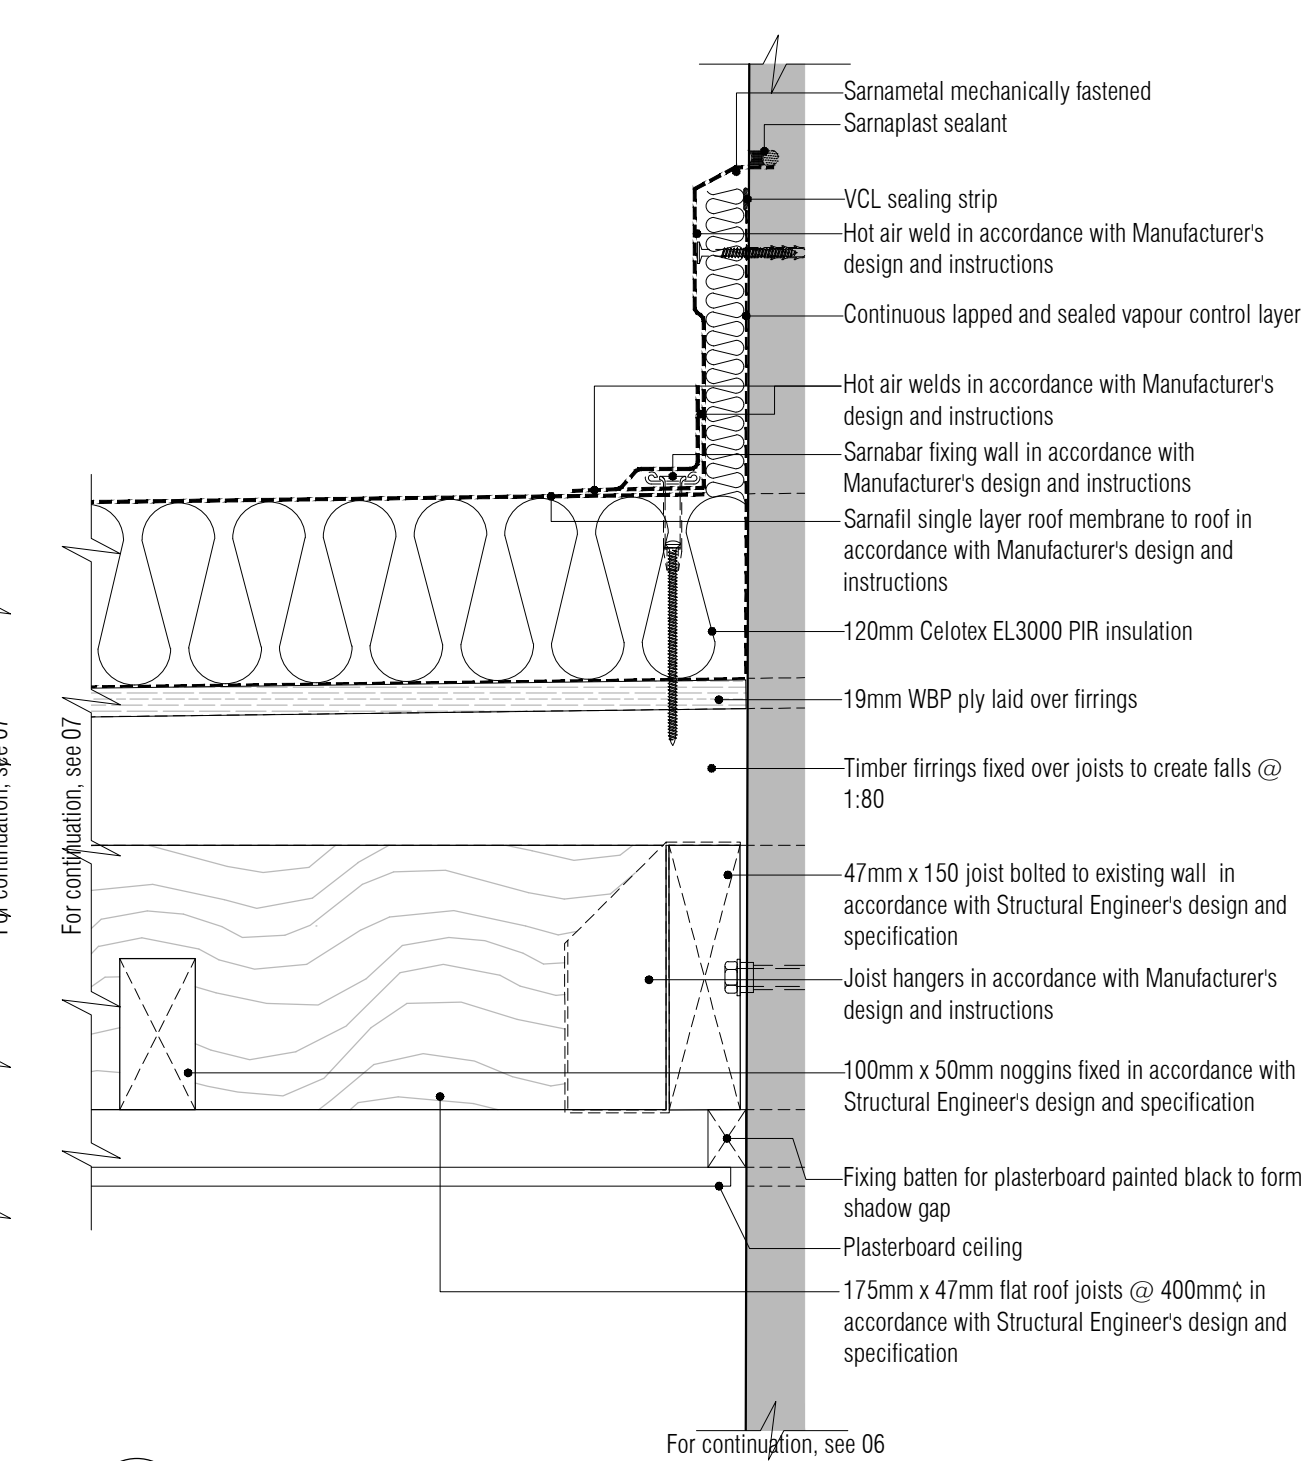


03 Typical Existing Wall / Joist Abutment Detail

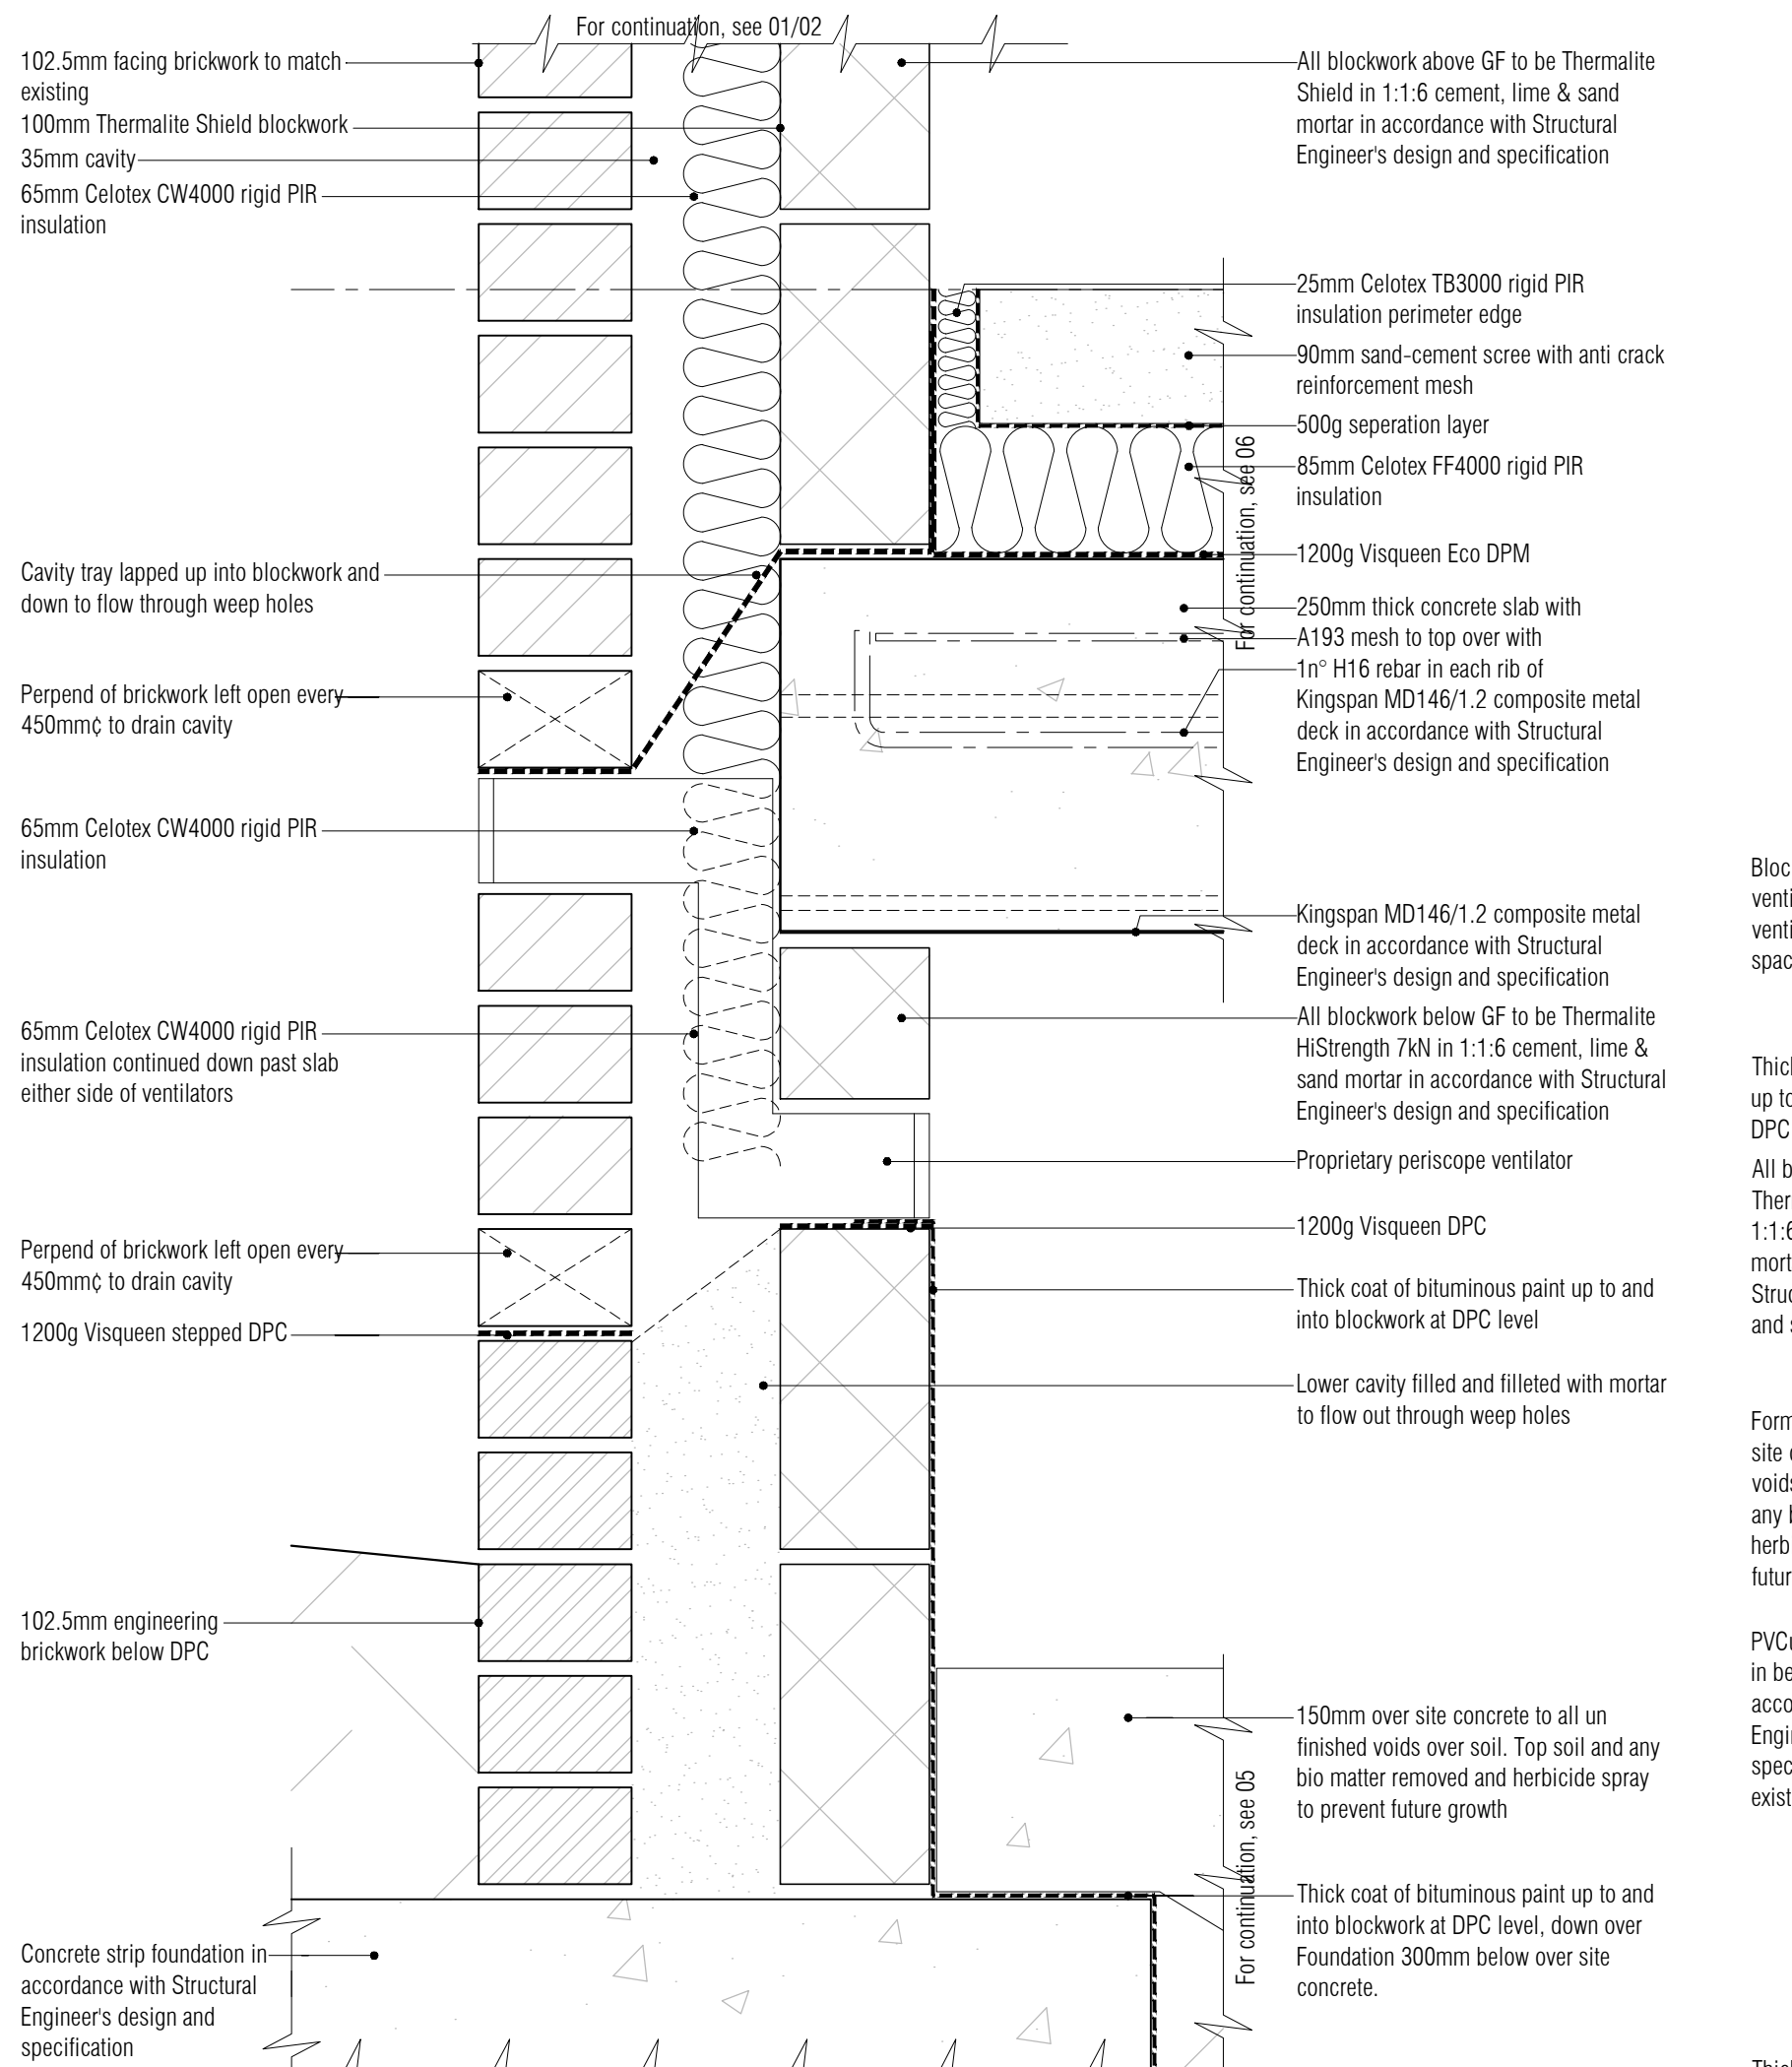


04 Typical Suspended Slab Wall Detail

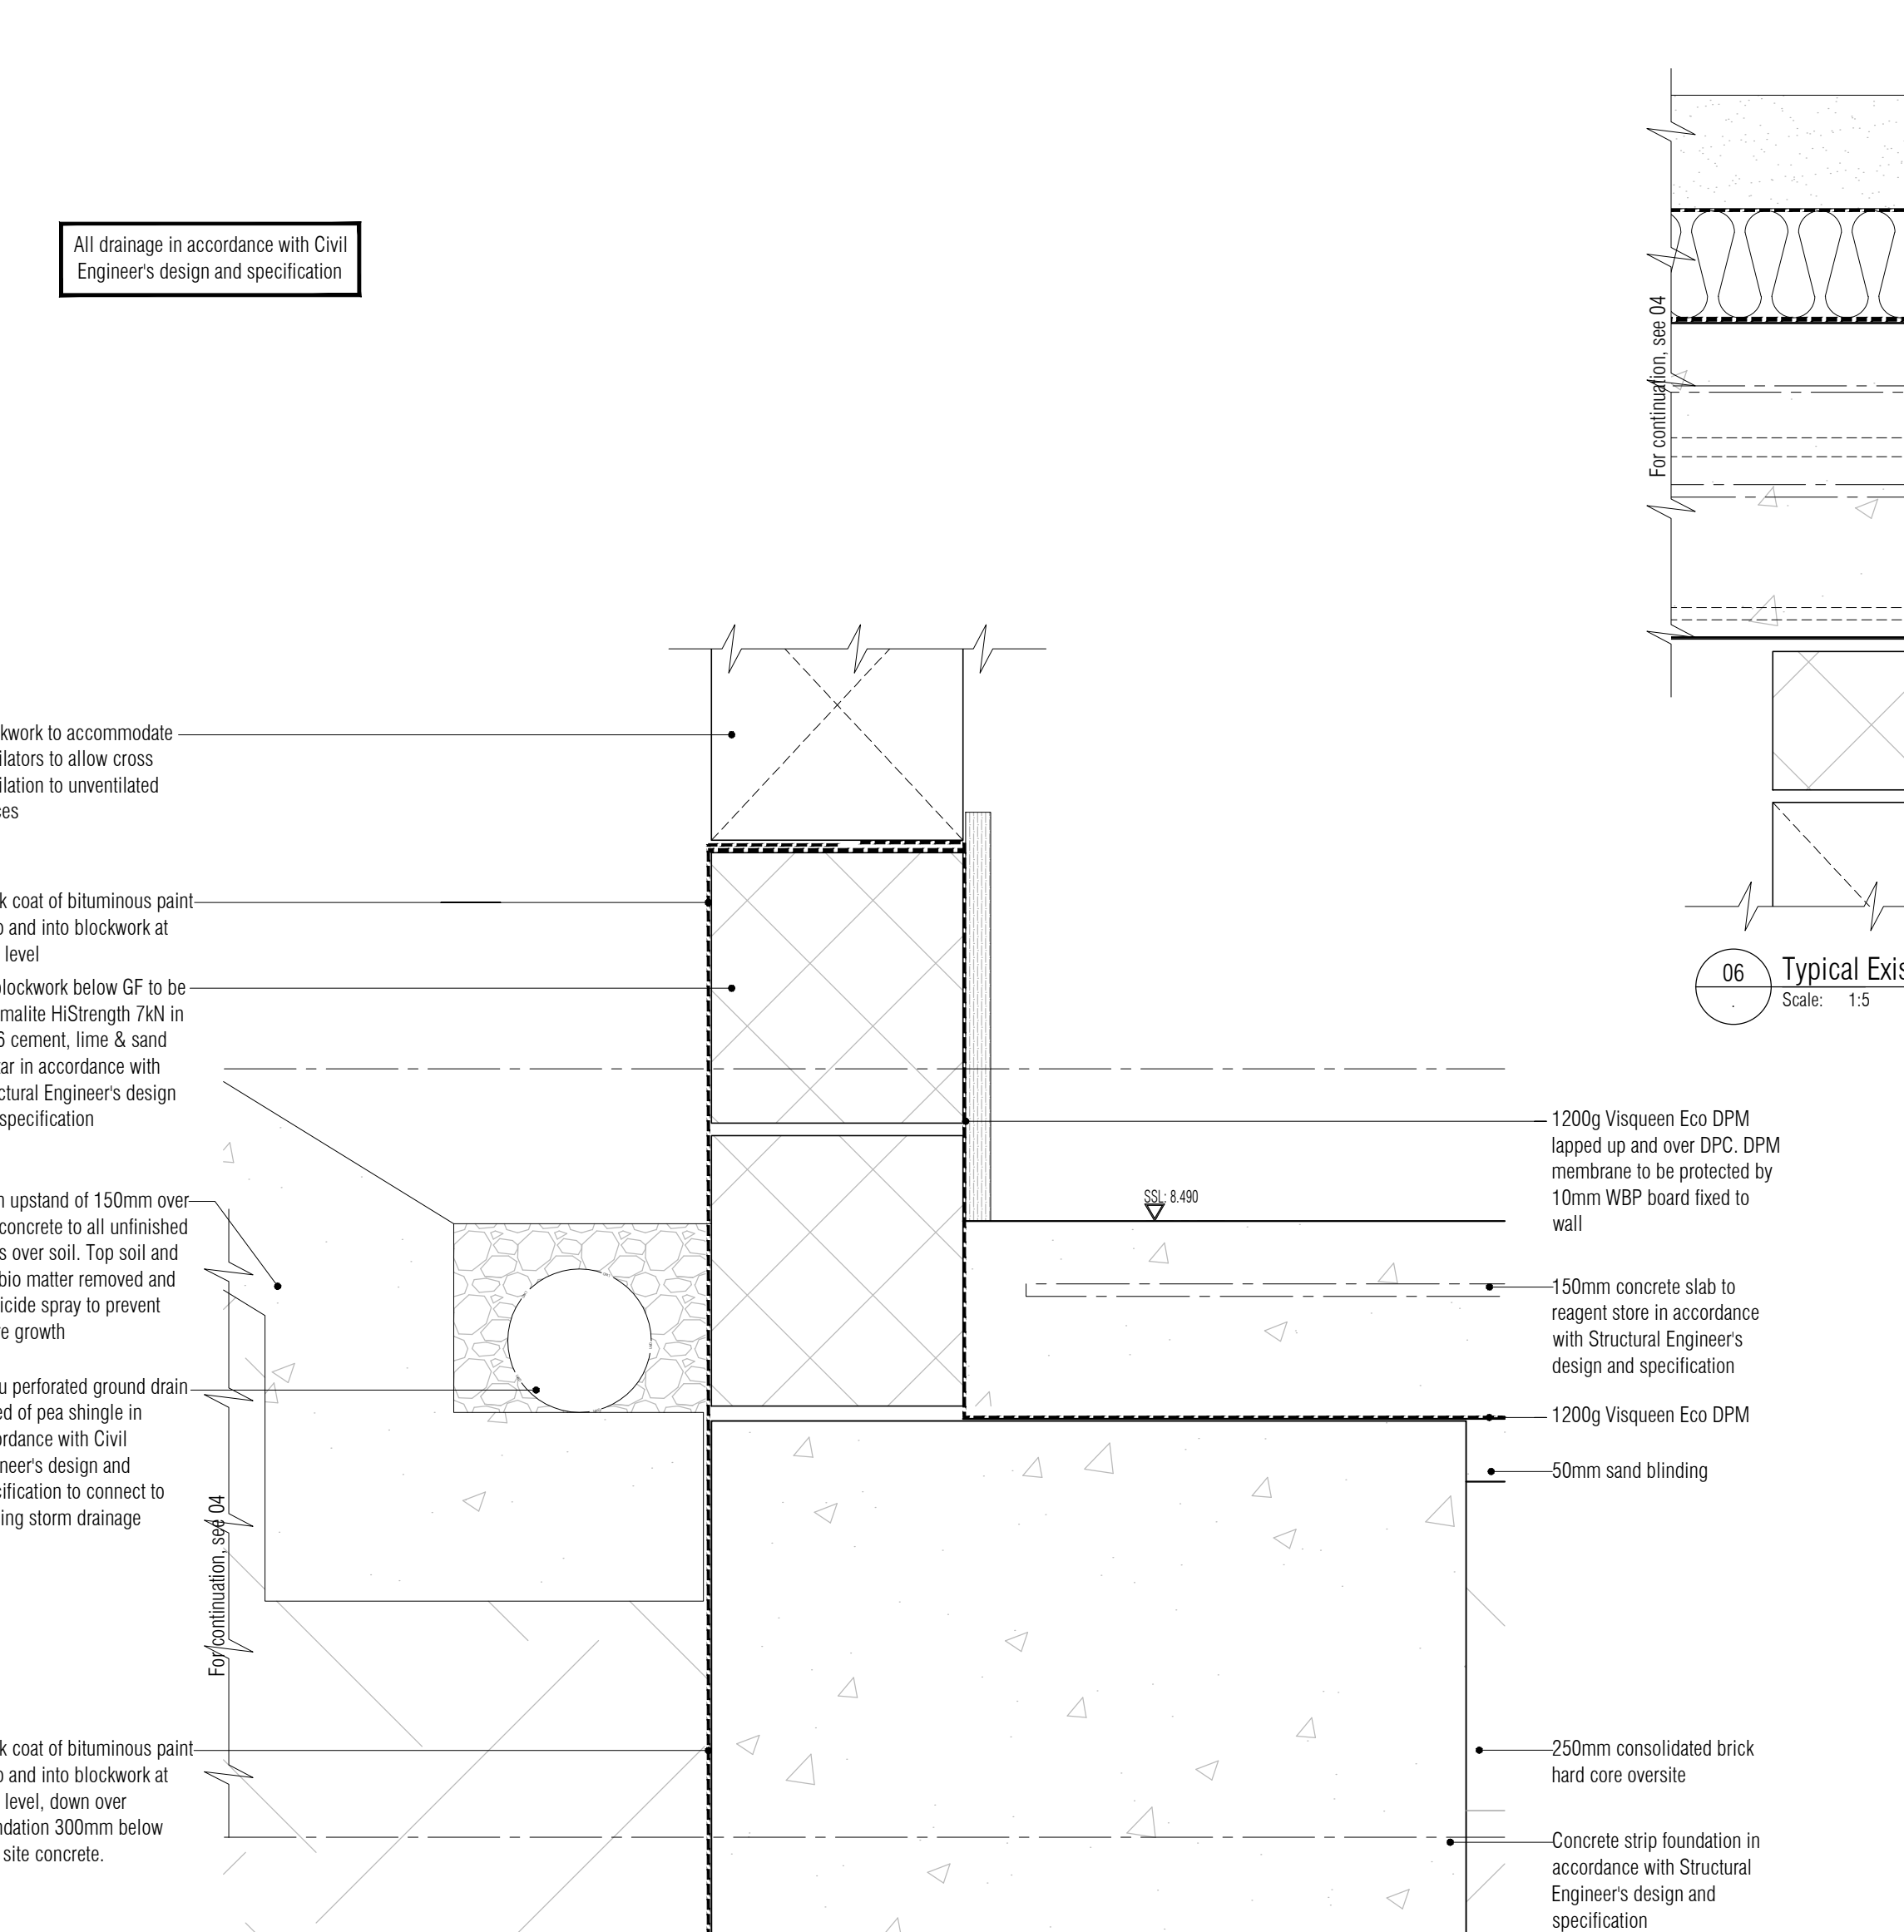

05 Typical Existing Wall / Joist Abutment Detail

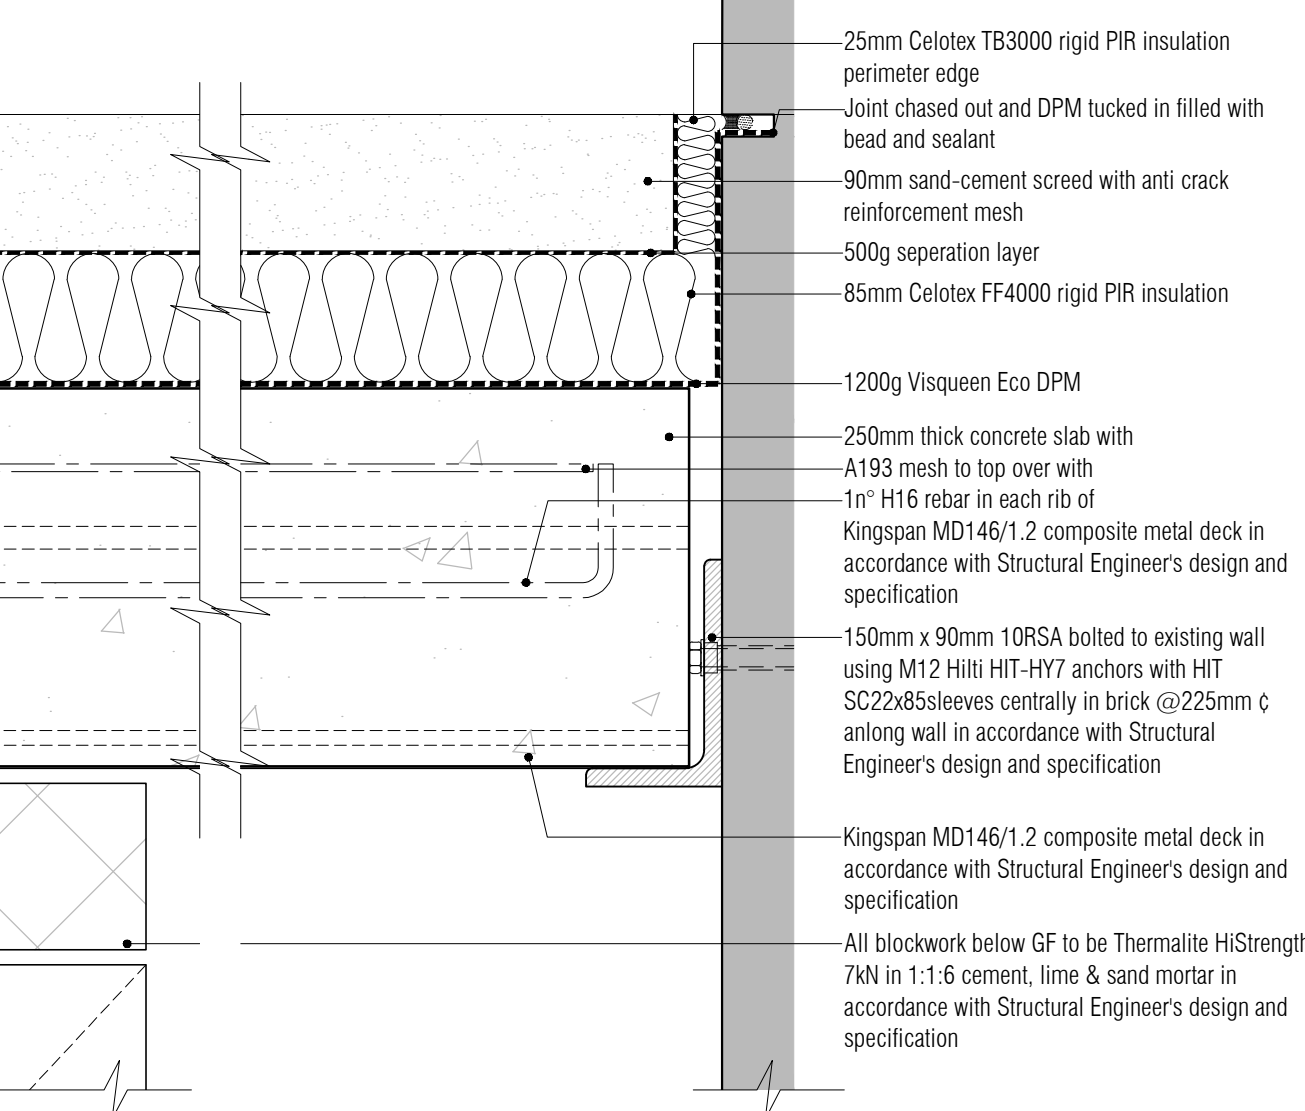


06 Typical Existing Wall / Joist Abutment Detail

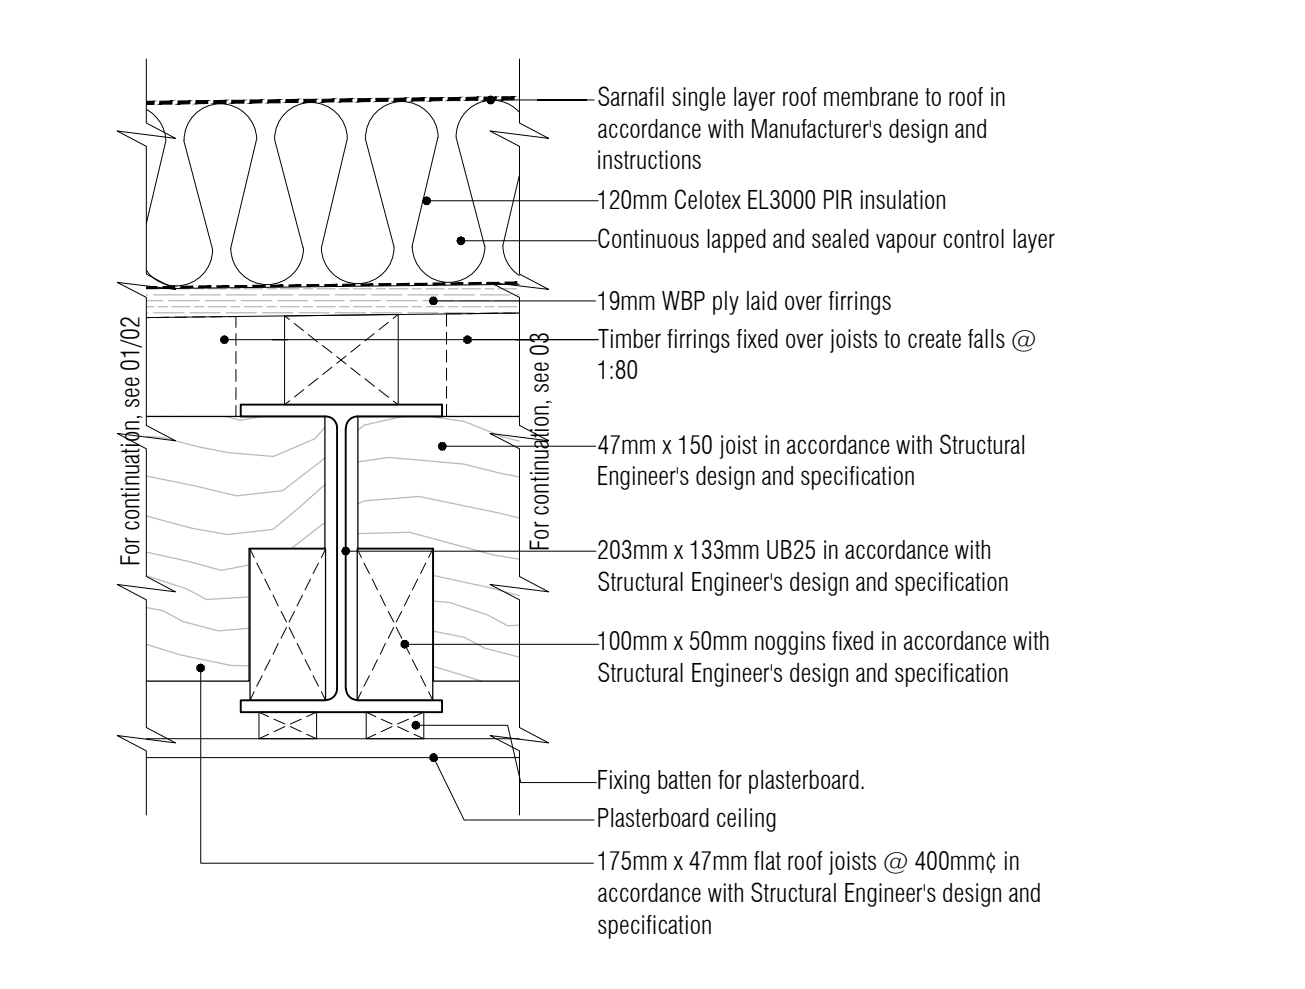

07 Joists / Beam Intersect Detail


NOTES: Do not scale this drawing. All dimensions to be checked on site prior to commencement or manufacture. Key Plan (nts)

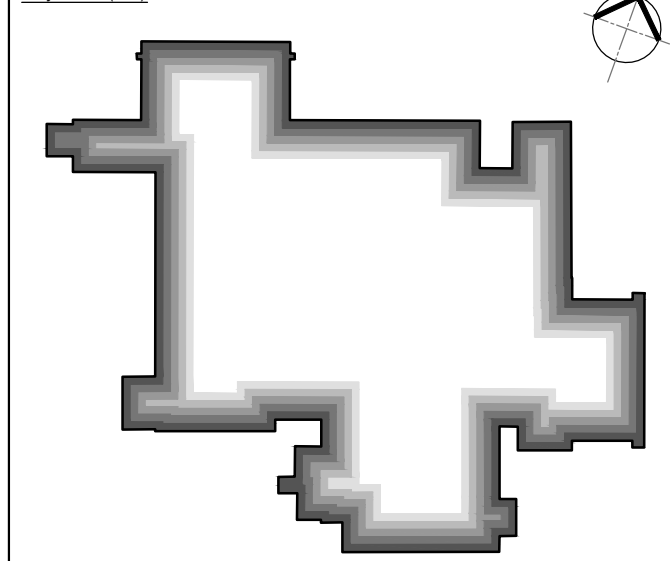

ISSUED FOR CONSTRUCTION

All details referenced in call outs supercede general arrangement or larger depictions.

Rev	Date	By	Chk	Comment
C2	05.07.12	RKC	JAS	Slab level dropped, Details revd
C1	29.03.12	RKC	JAS	Issued for CONSTRUCTION

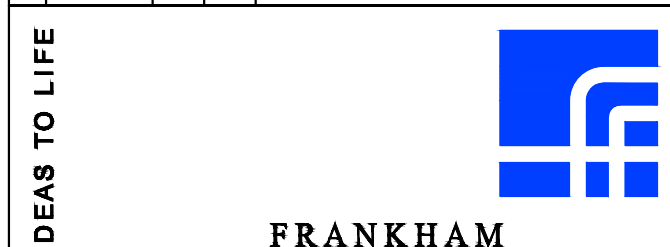

Frankham Consultancy Group Limited
21 Perryman Road
Haywards Heath RH16 3TP
t 01444 444900 f 01444 455642
enquiry@frankham.com
www.frankham.com

Client
Mansell
Contract N°: MC0269

Project Title
Eastbourne & Worthing
Crematoria
Refurbishments and Alterations

Drawing Title
EASTBOURNE
Eastbourne Crematorium
Details



Drawn by: RKC	Scale: 1:5@A1	Date: 14.02.12
Designed by: FCG	Checked by: JAS	Approved by: AC

File Ref.: 521260-A-420-E-000 - 200611121923

Drawing No. 521260-A-420-E	Rev. C2
-------------------------------	------------




NB: All information based on supplied third party survey information.
All discrepancies to be reported to FCG immediately upon discovery.

All Disabled and Ambulant Disabled facilities to comply with Approved Document Part M - Access to and use of buildings*, Disability Discrimination Act 1995 and BS83000 as required

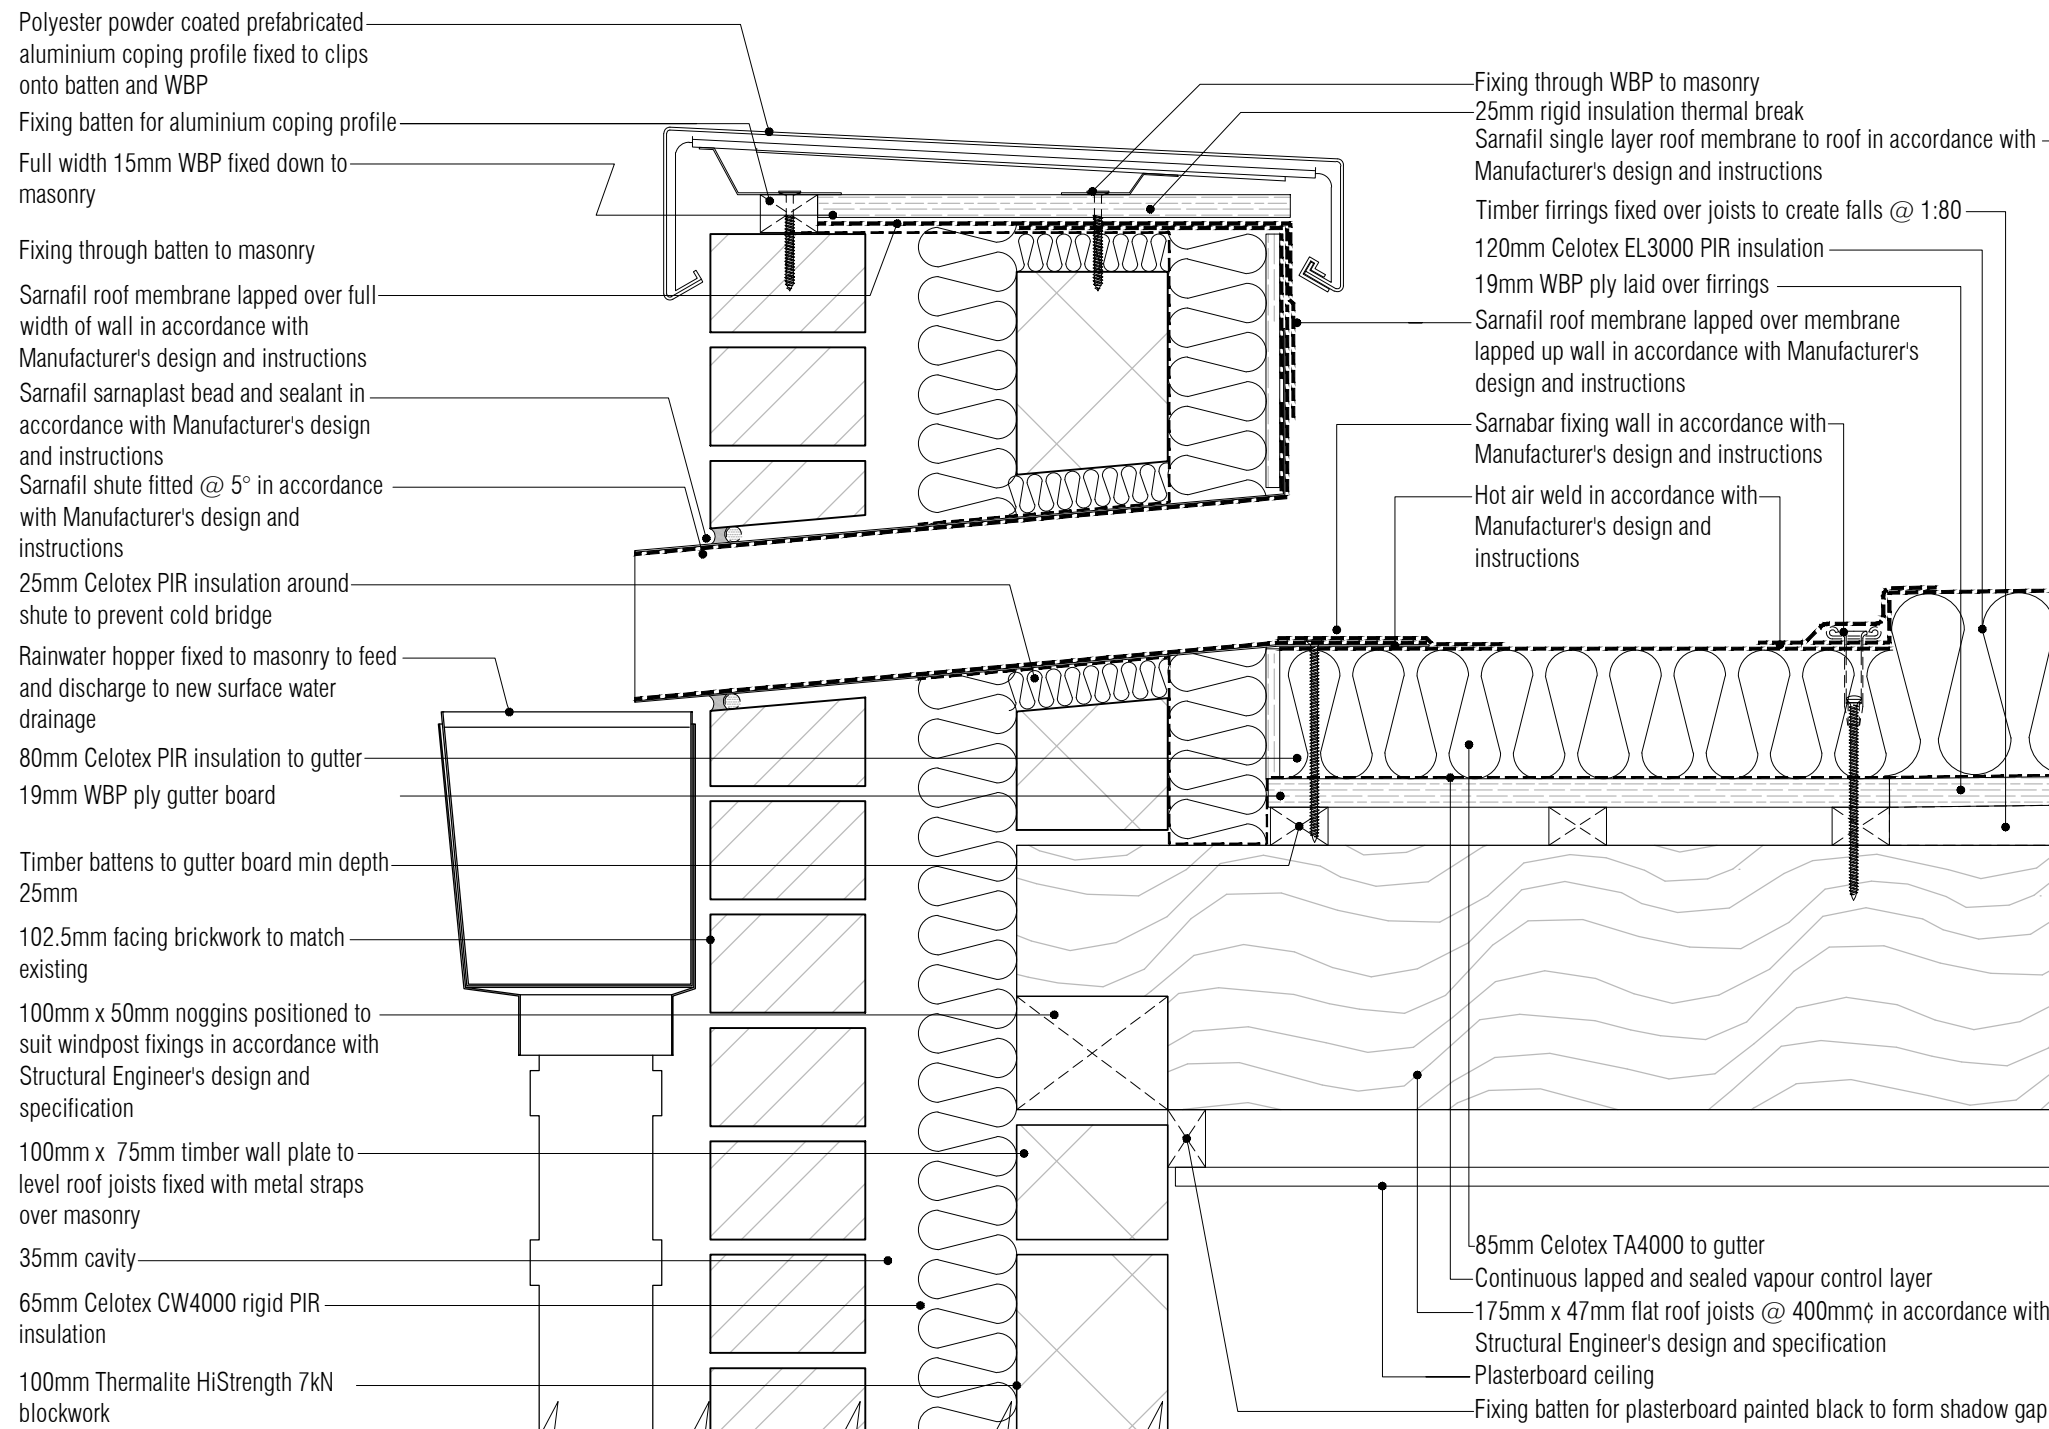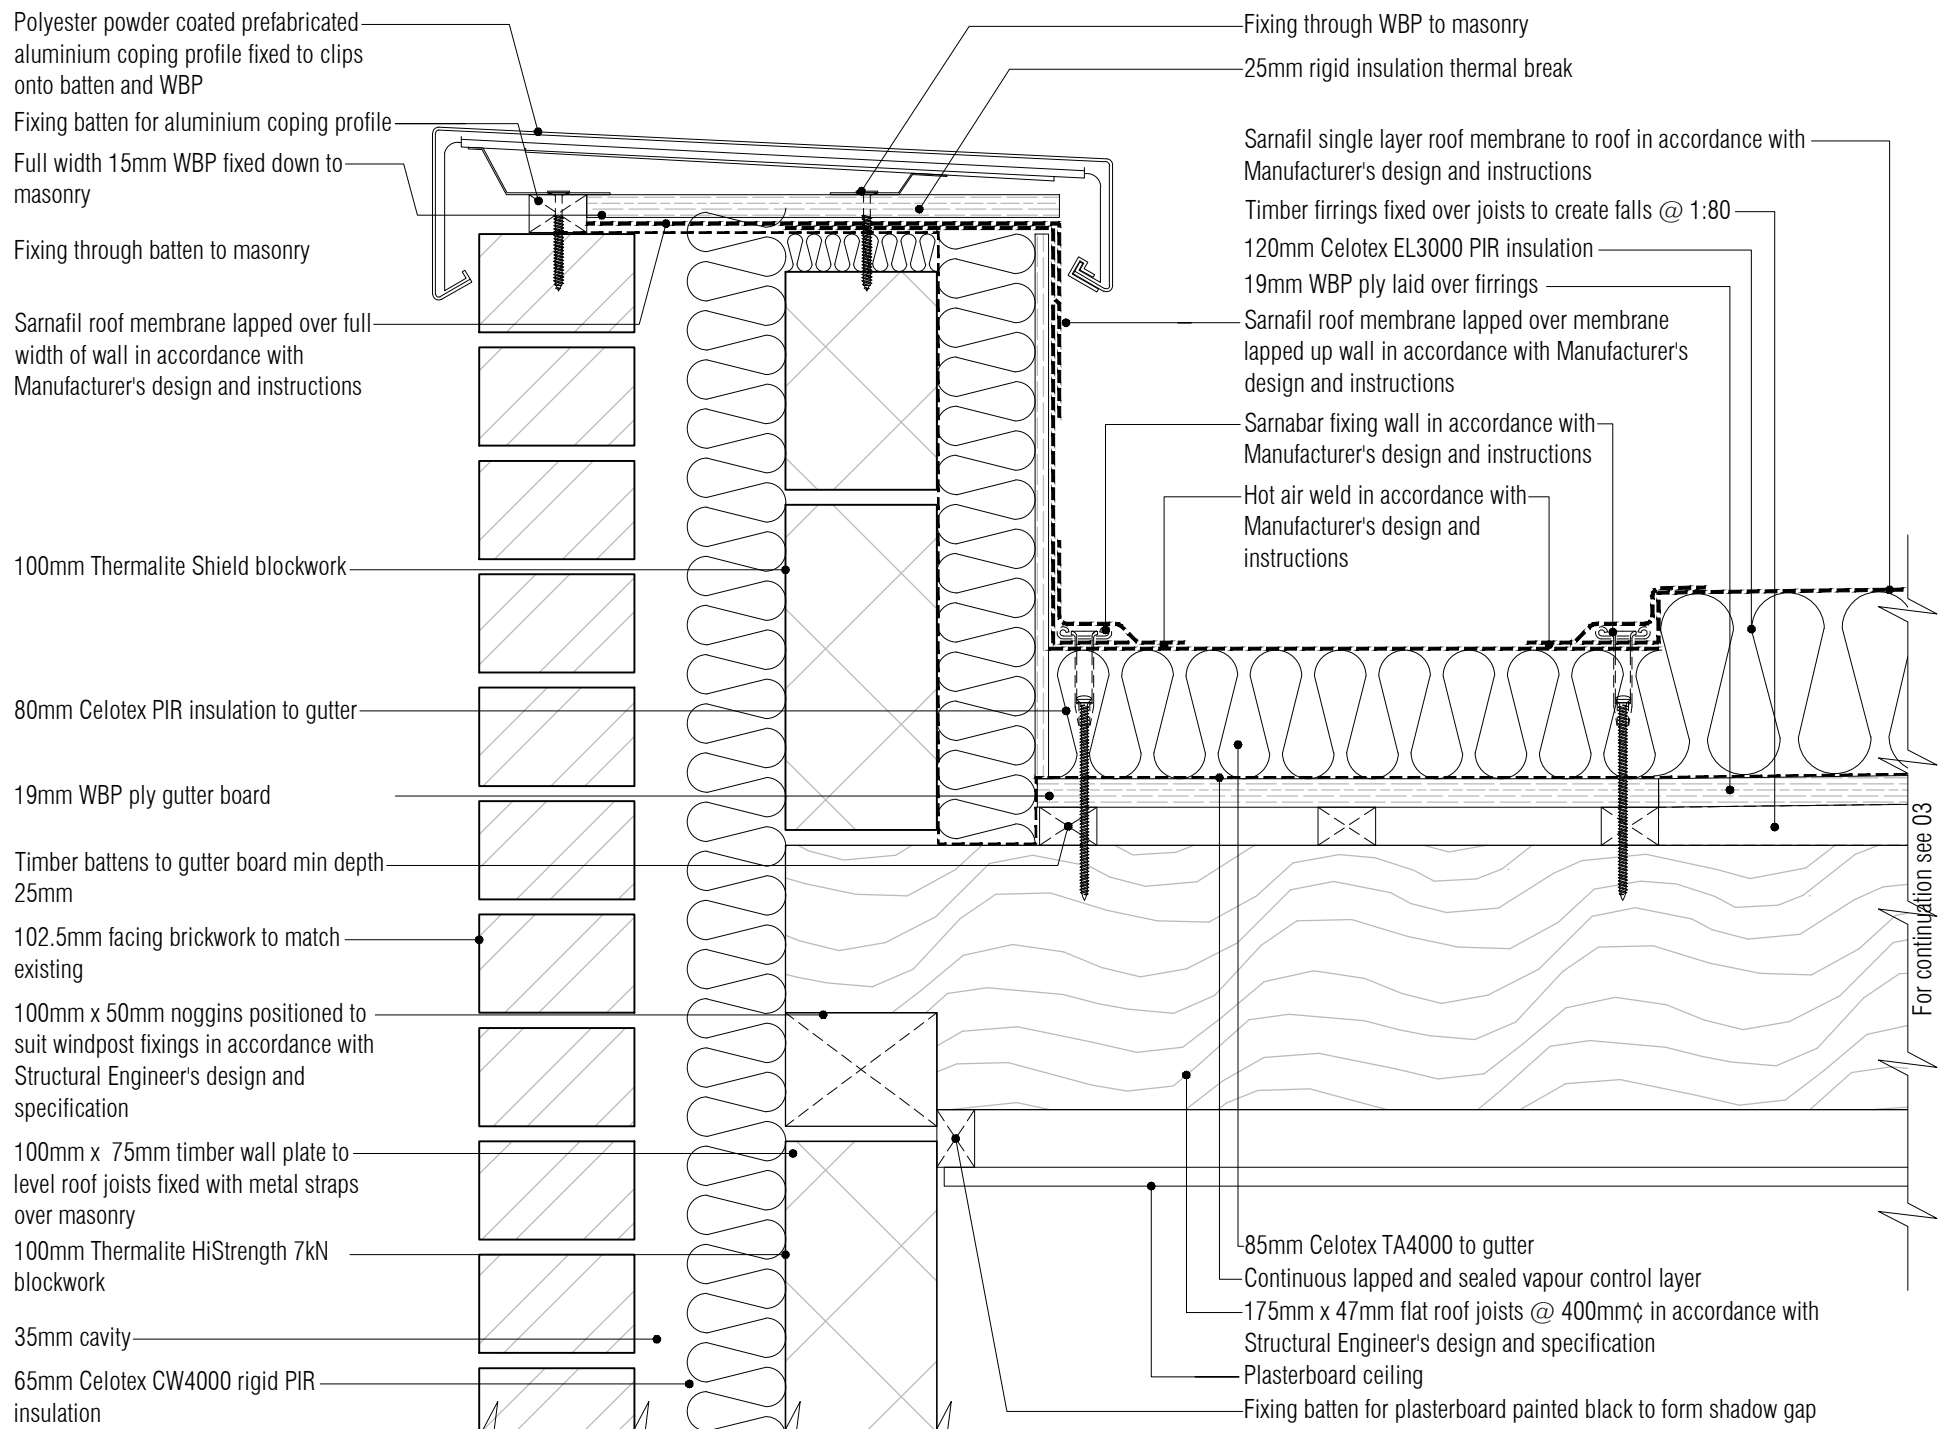


All drainage in accordance with Civil Engineer's design and specification

NB: All levels are approximate and are subject to further site investigation prior to construction. All discrepancies to be reported to FCG immediately

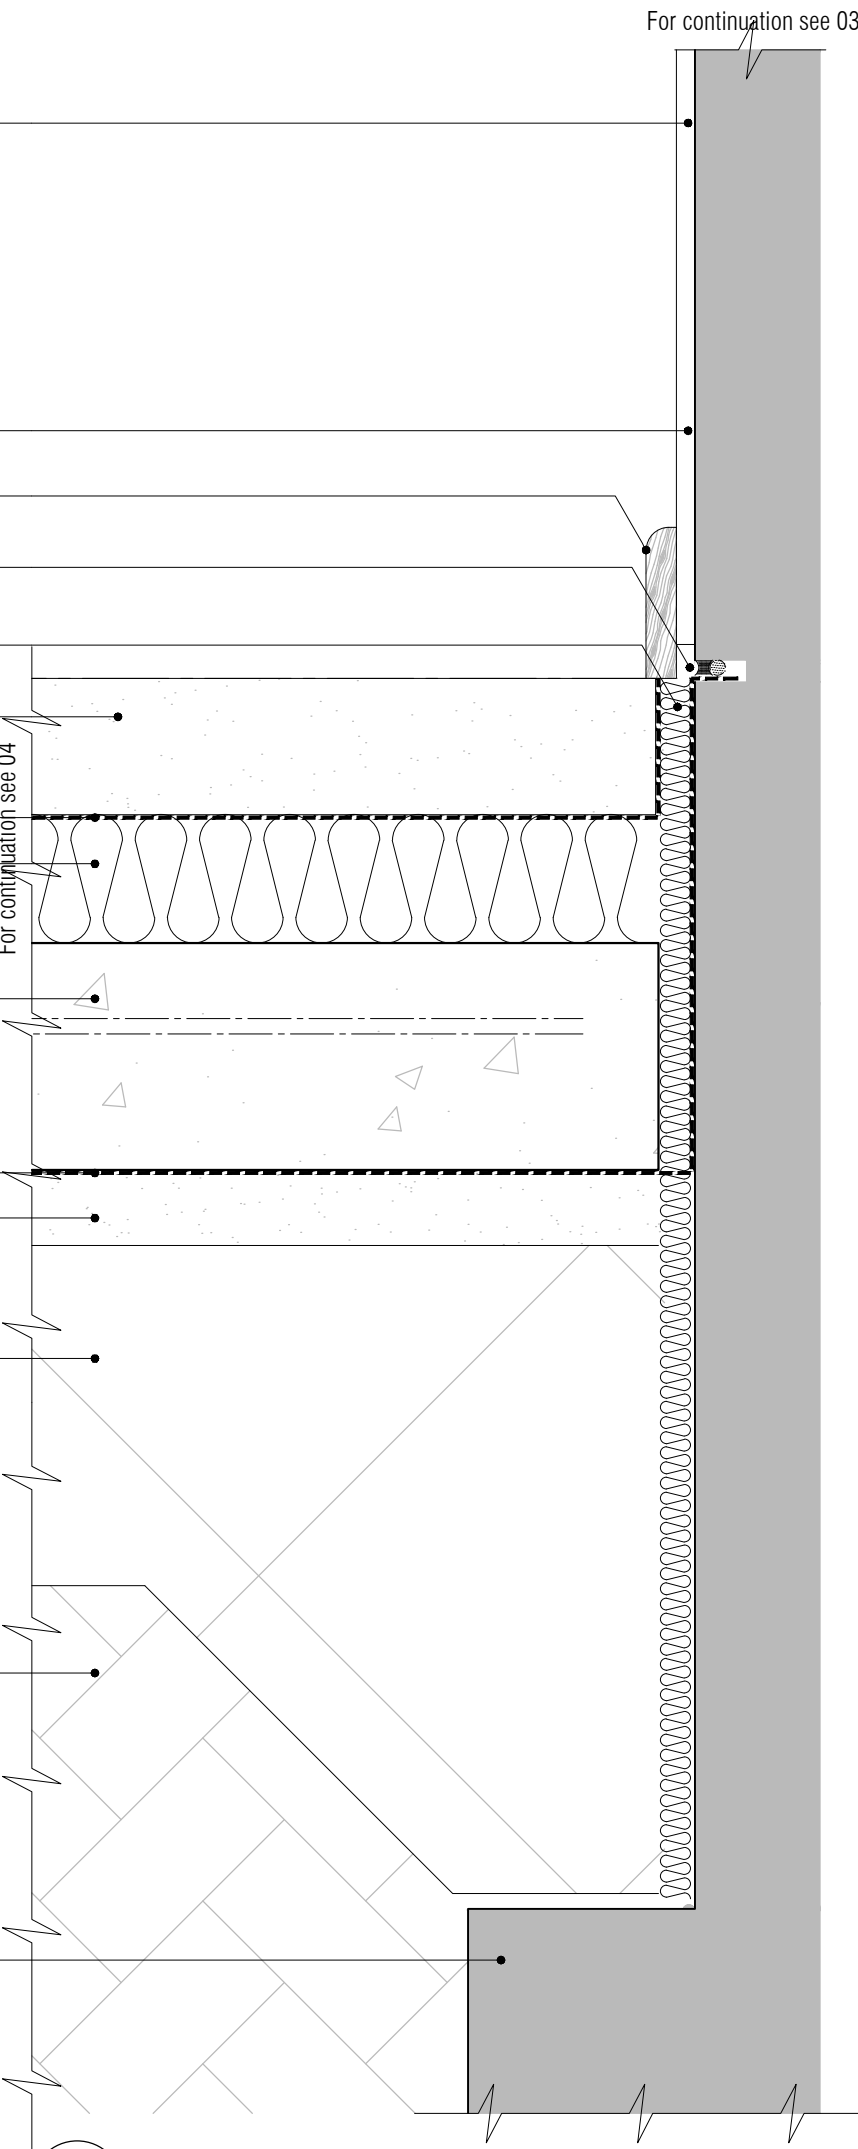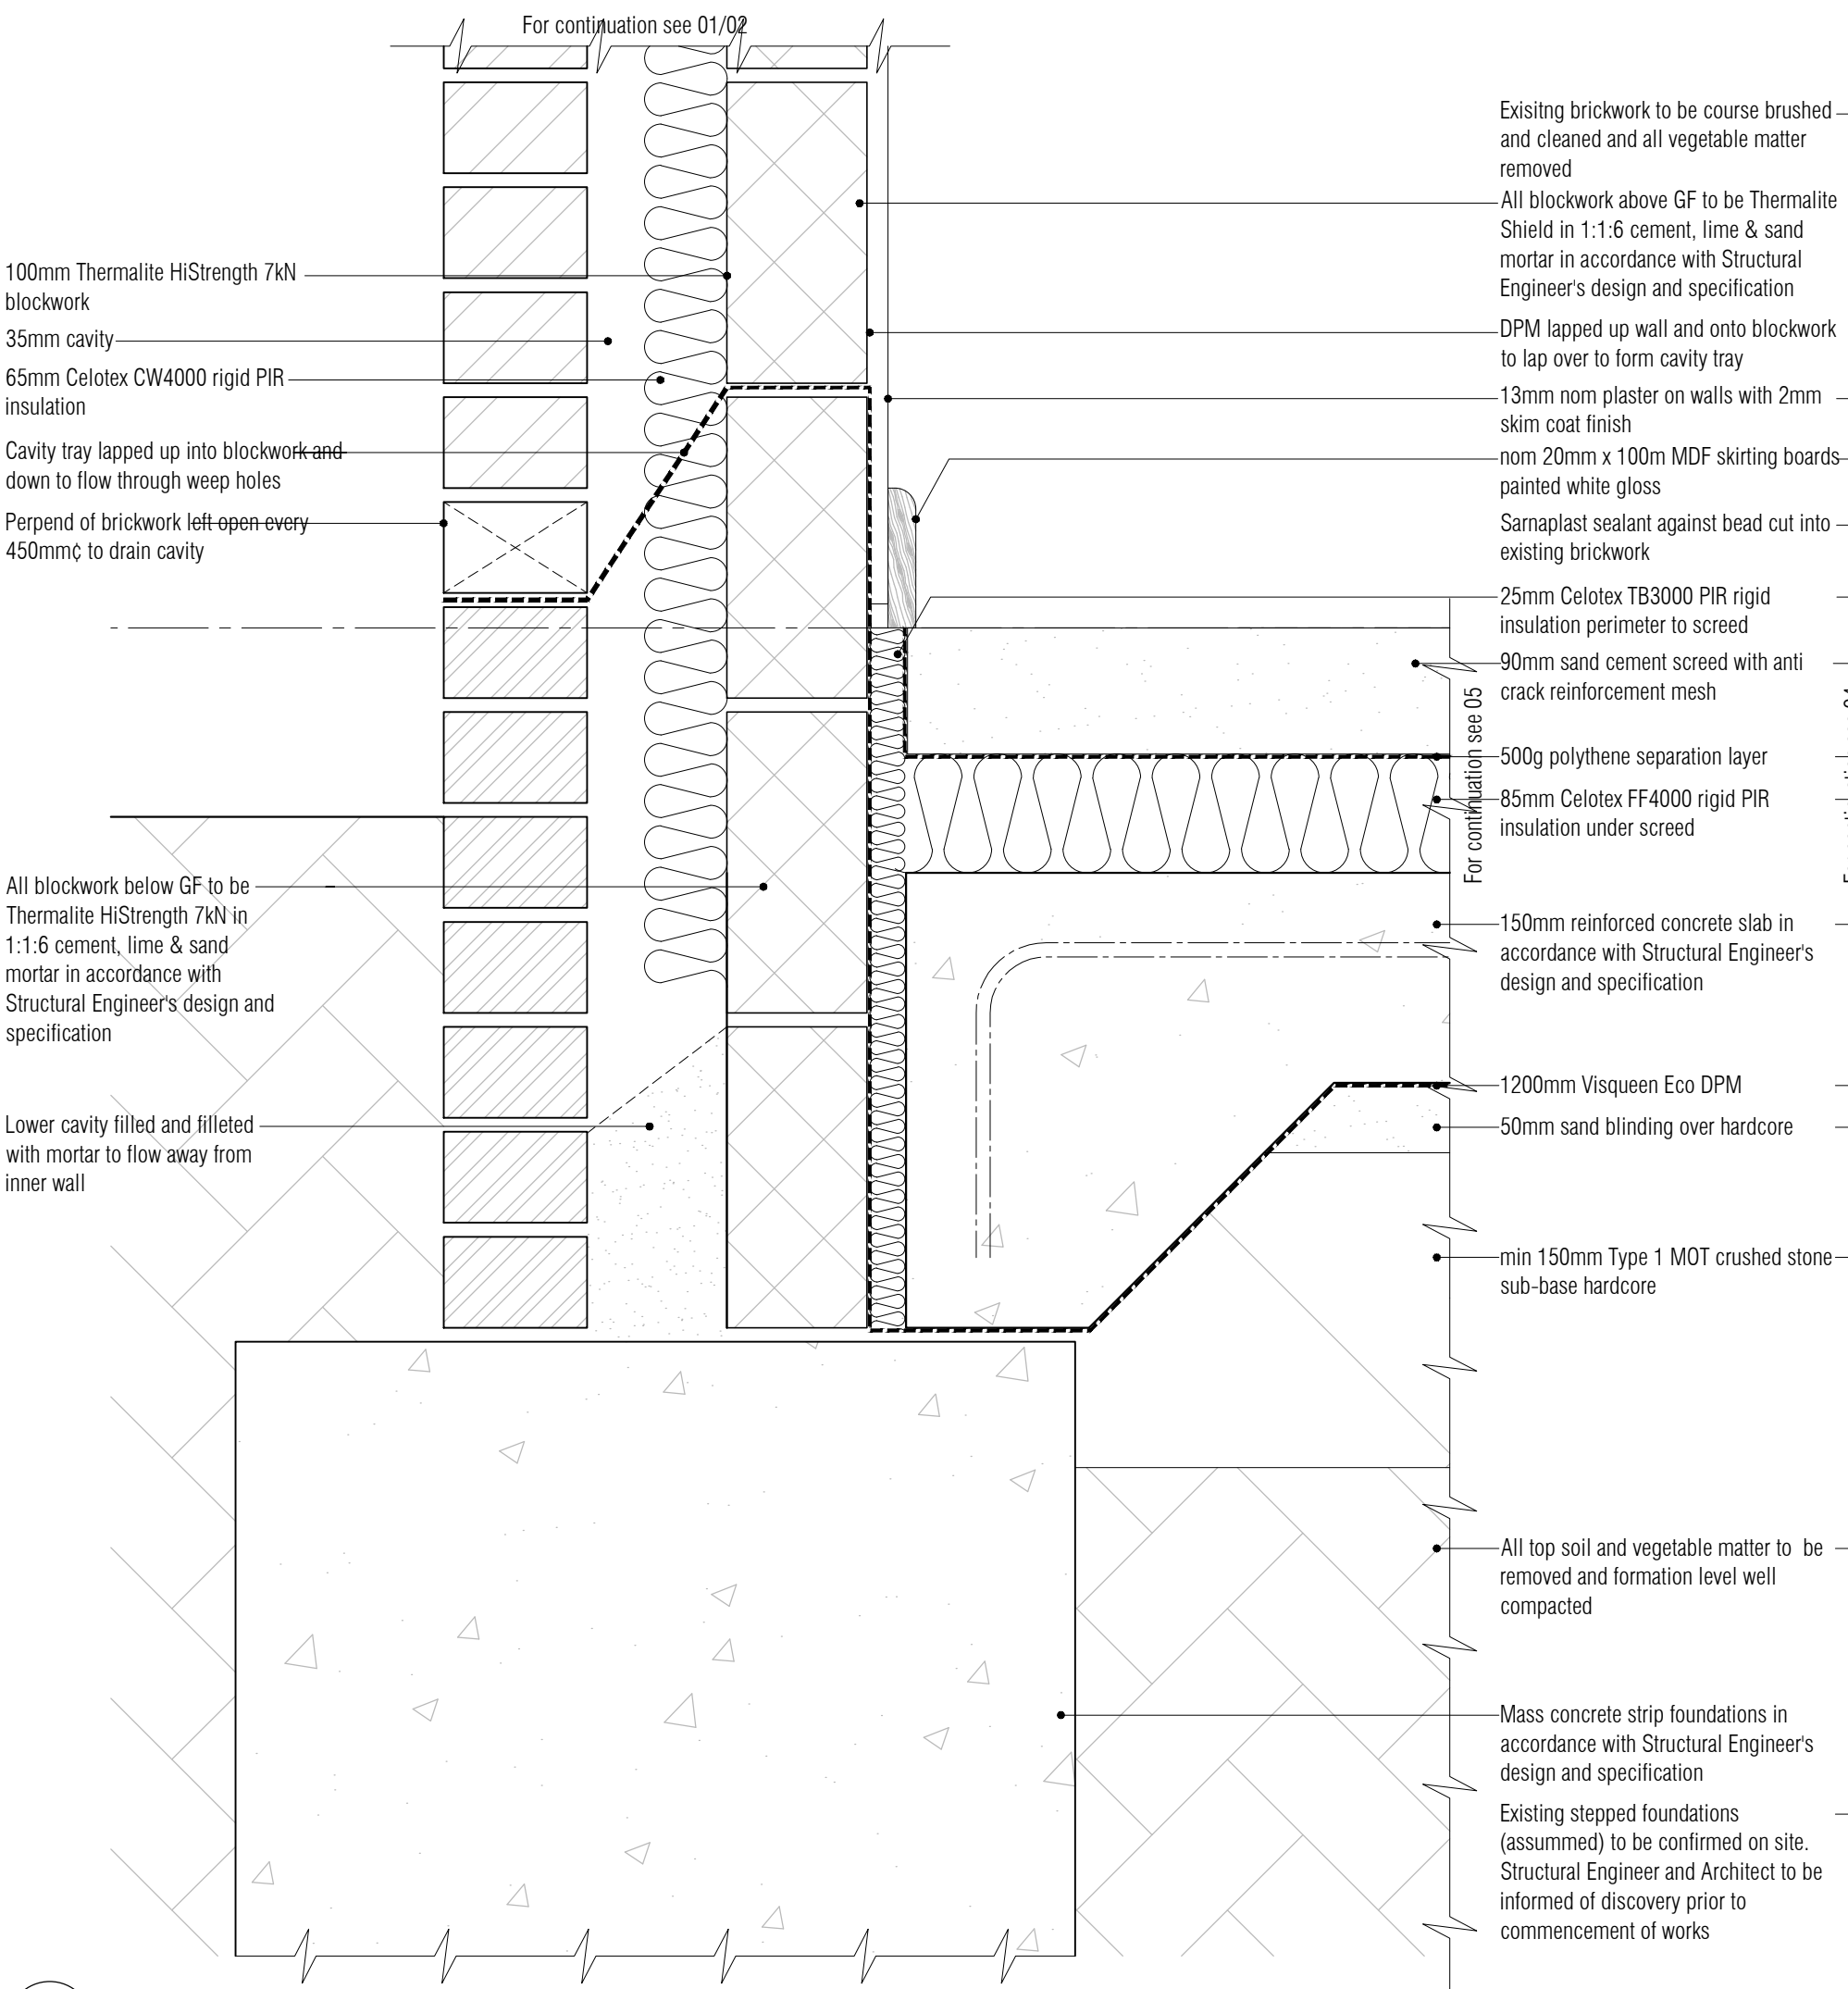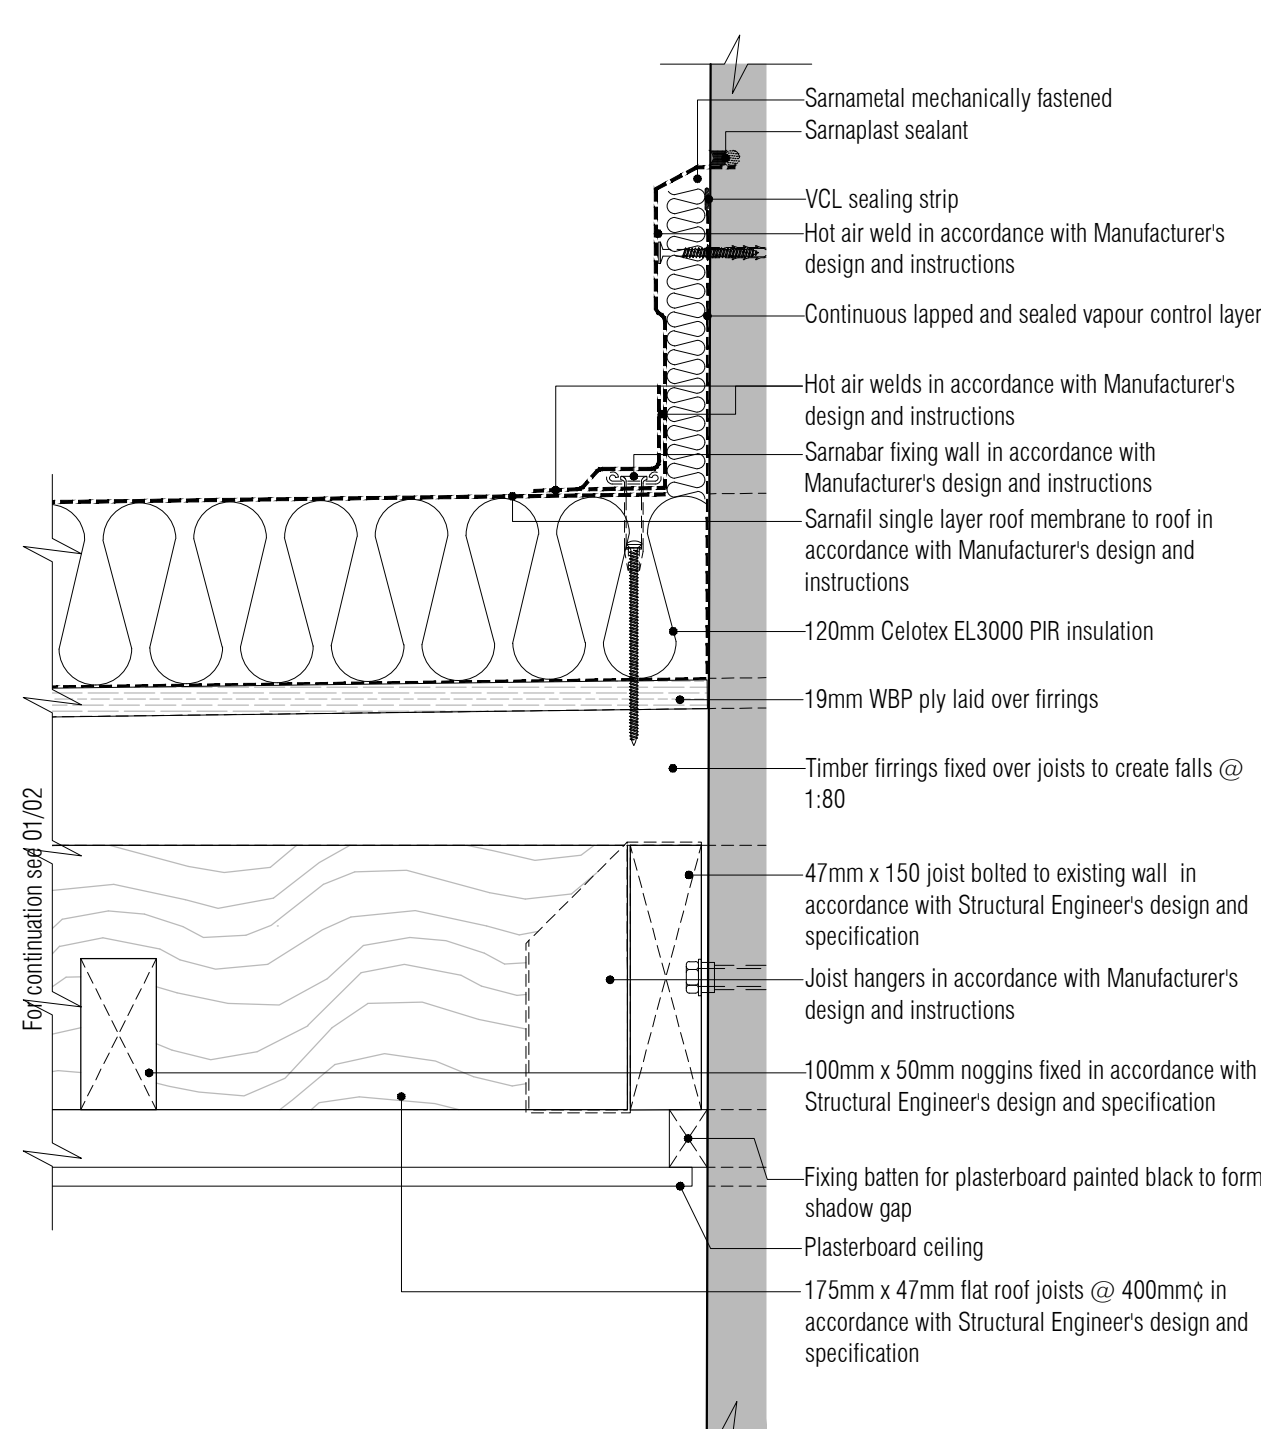

NB: All information based on supplied third party survey information. All discrepancies to be reported to FCG immediately upon discovery.

NOTES: Do not scale this drawing. All dimensions to be checked on site prior to commencement or manufacture. Key Plan (nts)

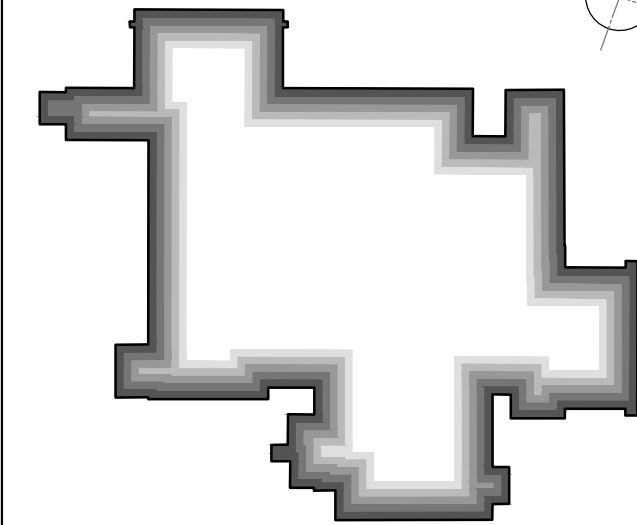

ISSUED FOR CONSTRUCTION

All details referenced in call outs supercede general arrangement or larger depictions.

Rev	Date	By	Chk	Comment
C1	29.03.12	RKC	JAS	Issued for CONSTRUCTION

BRINGING IDEAS TO LIFE



FRANKHAM

Frankham Consultancy Group Limited
21 Perryman Road
Haywards Heath RH16 3TP
t 01444 444900 f 01444 455642
enquire@frankham.com
www.frankham.com

Client
Mansell
Contract N°: MC0269

Project Title
Eastbourne & Worthing
Crematoria
Refurbishments and Alterations


Drawing Title
EASTBOURNE
Eastbourne Crematorium
Details

Drawn by: RKC
Scale: 1:5@A1
Date: 14.02.12


Designed by: FCG
Checked by: JAS
Approved by: AC

File Ref.: 307360-A-421-E-000 - 200611171551
20.06.11 12:19:32


Drawing No.
521260-A-421-E
Rev.
C1

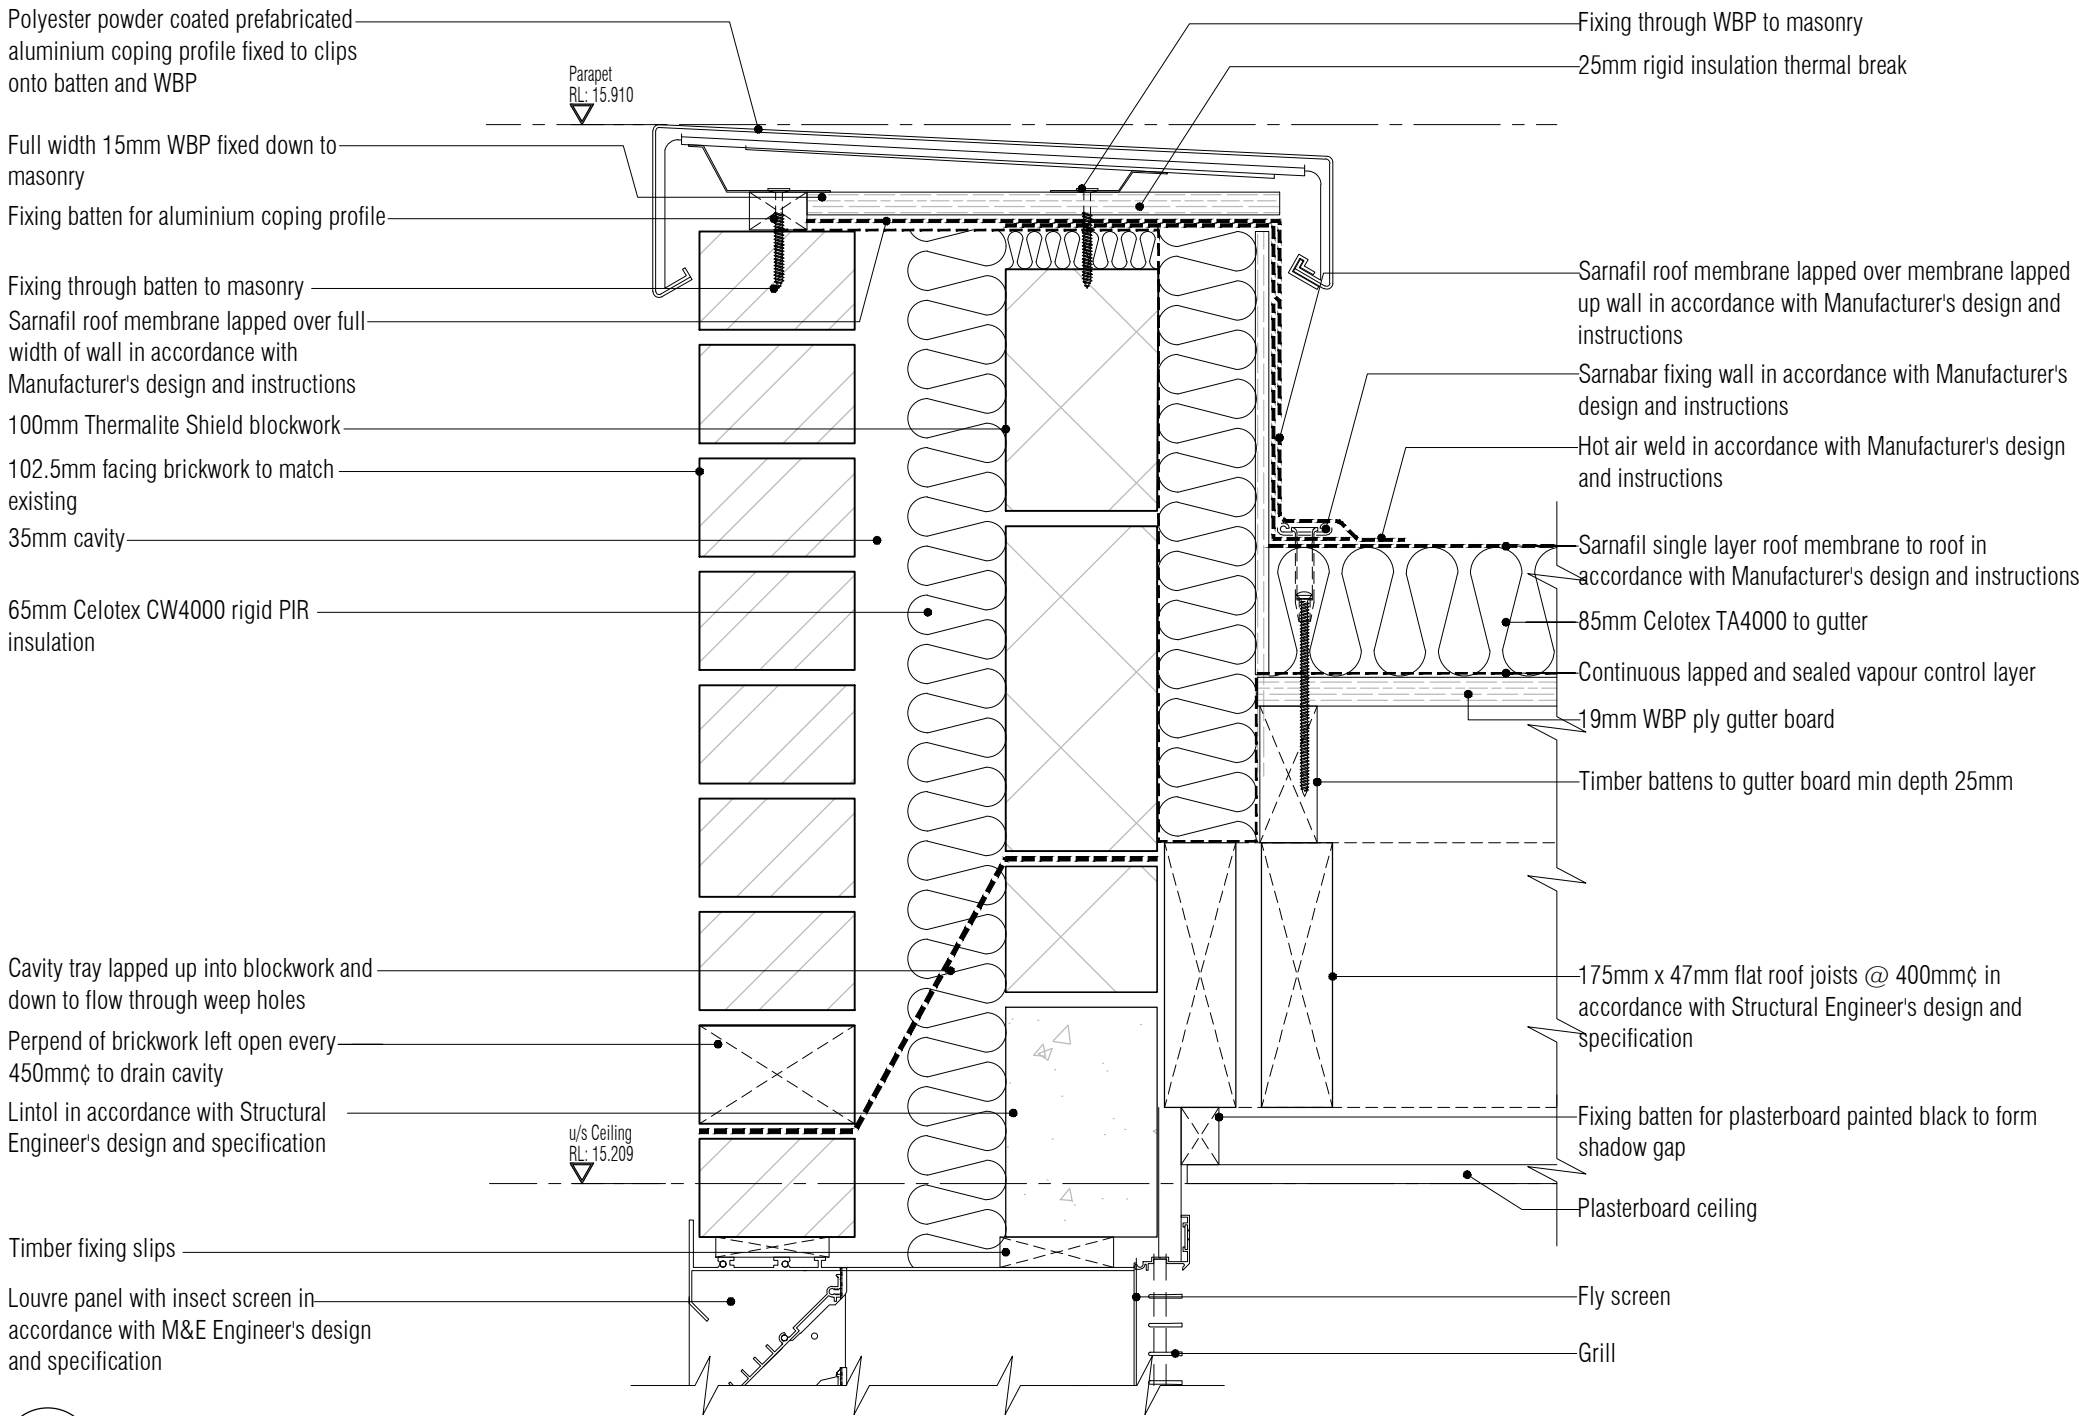


01 Parapet / Louvre Detail
Scale: 1:5

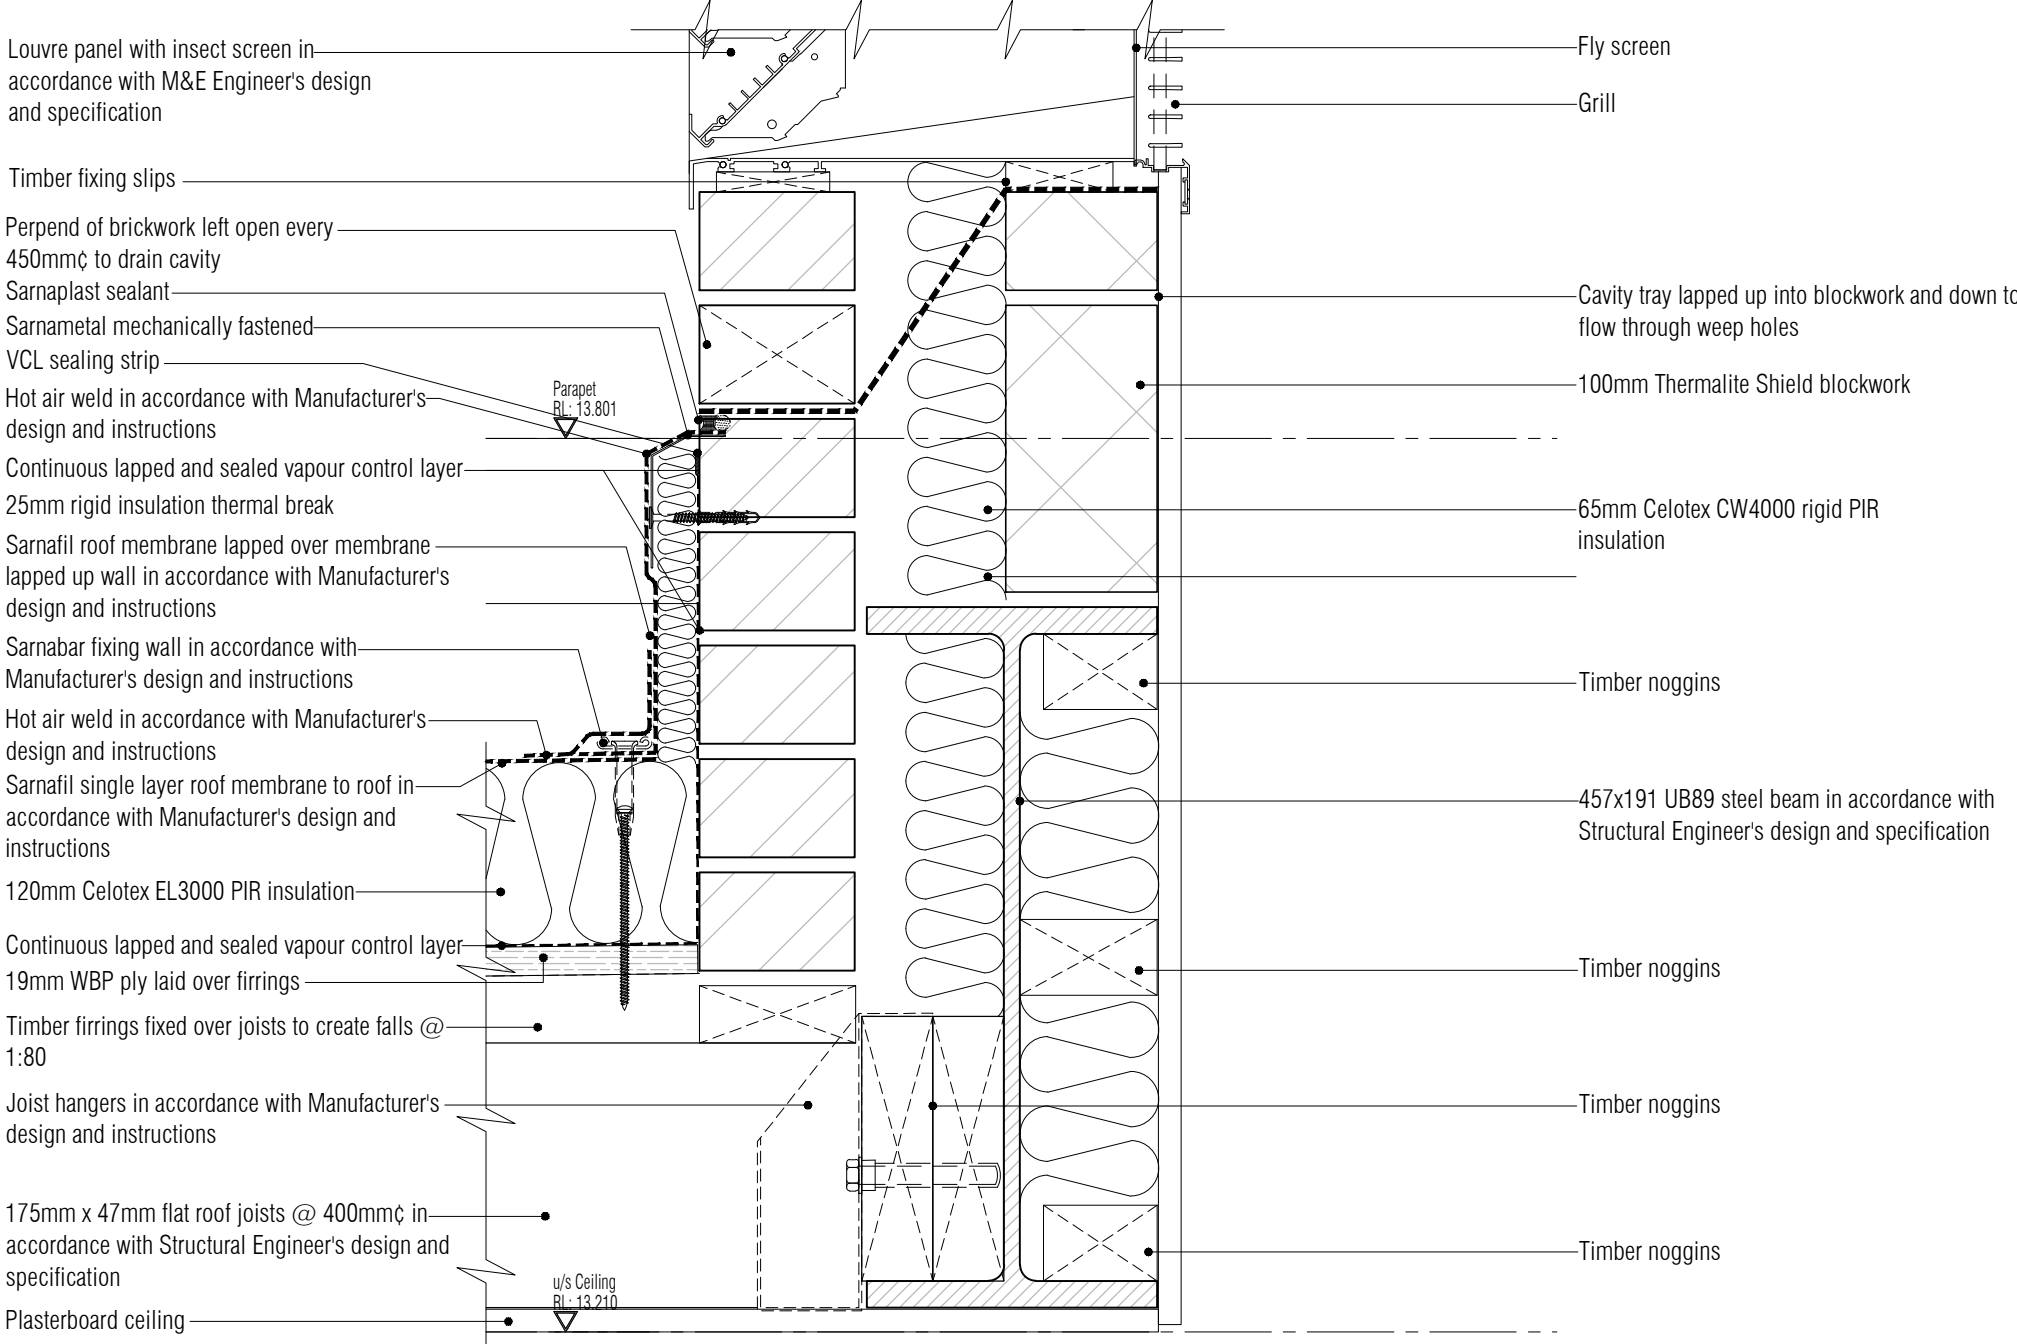


02 Roof / Louvre Detail
Scale: 1:5

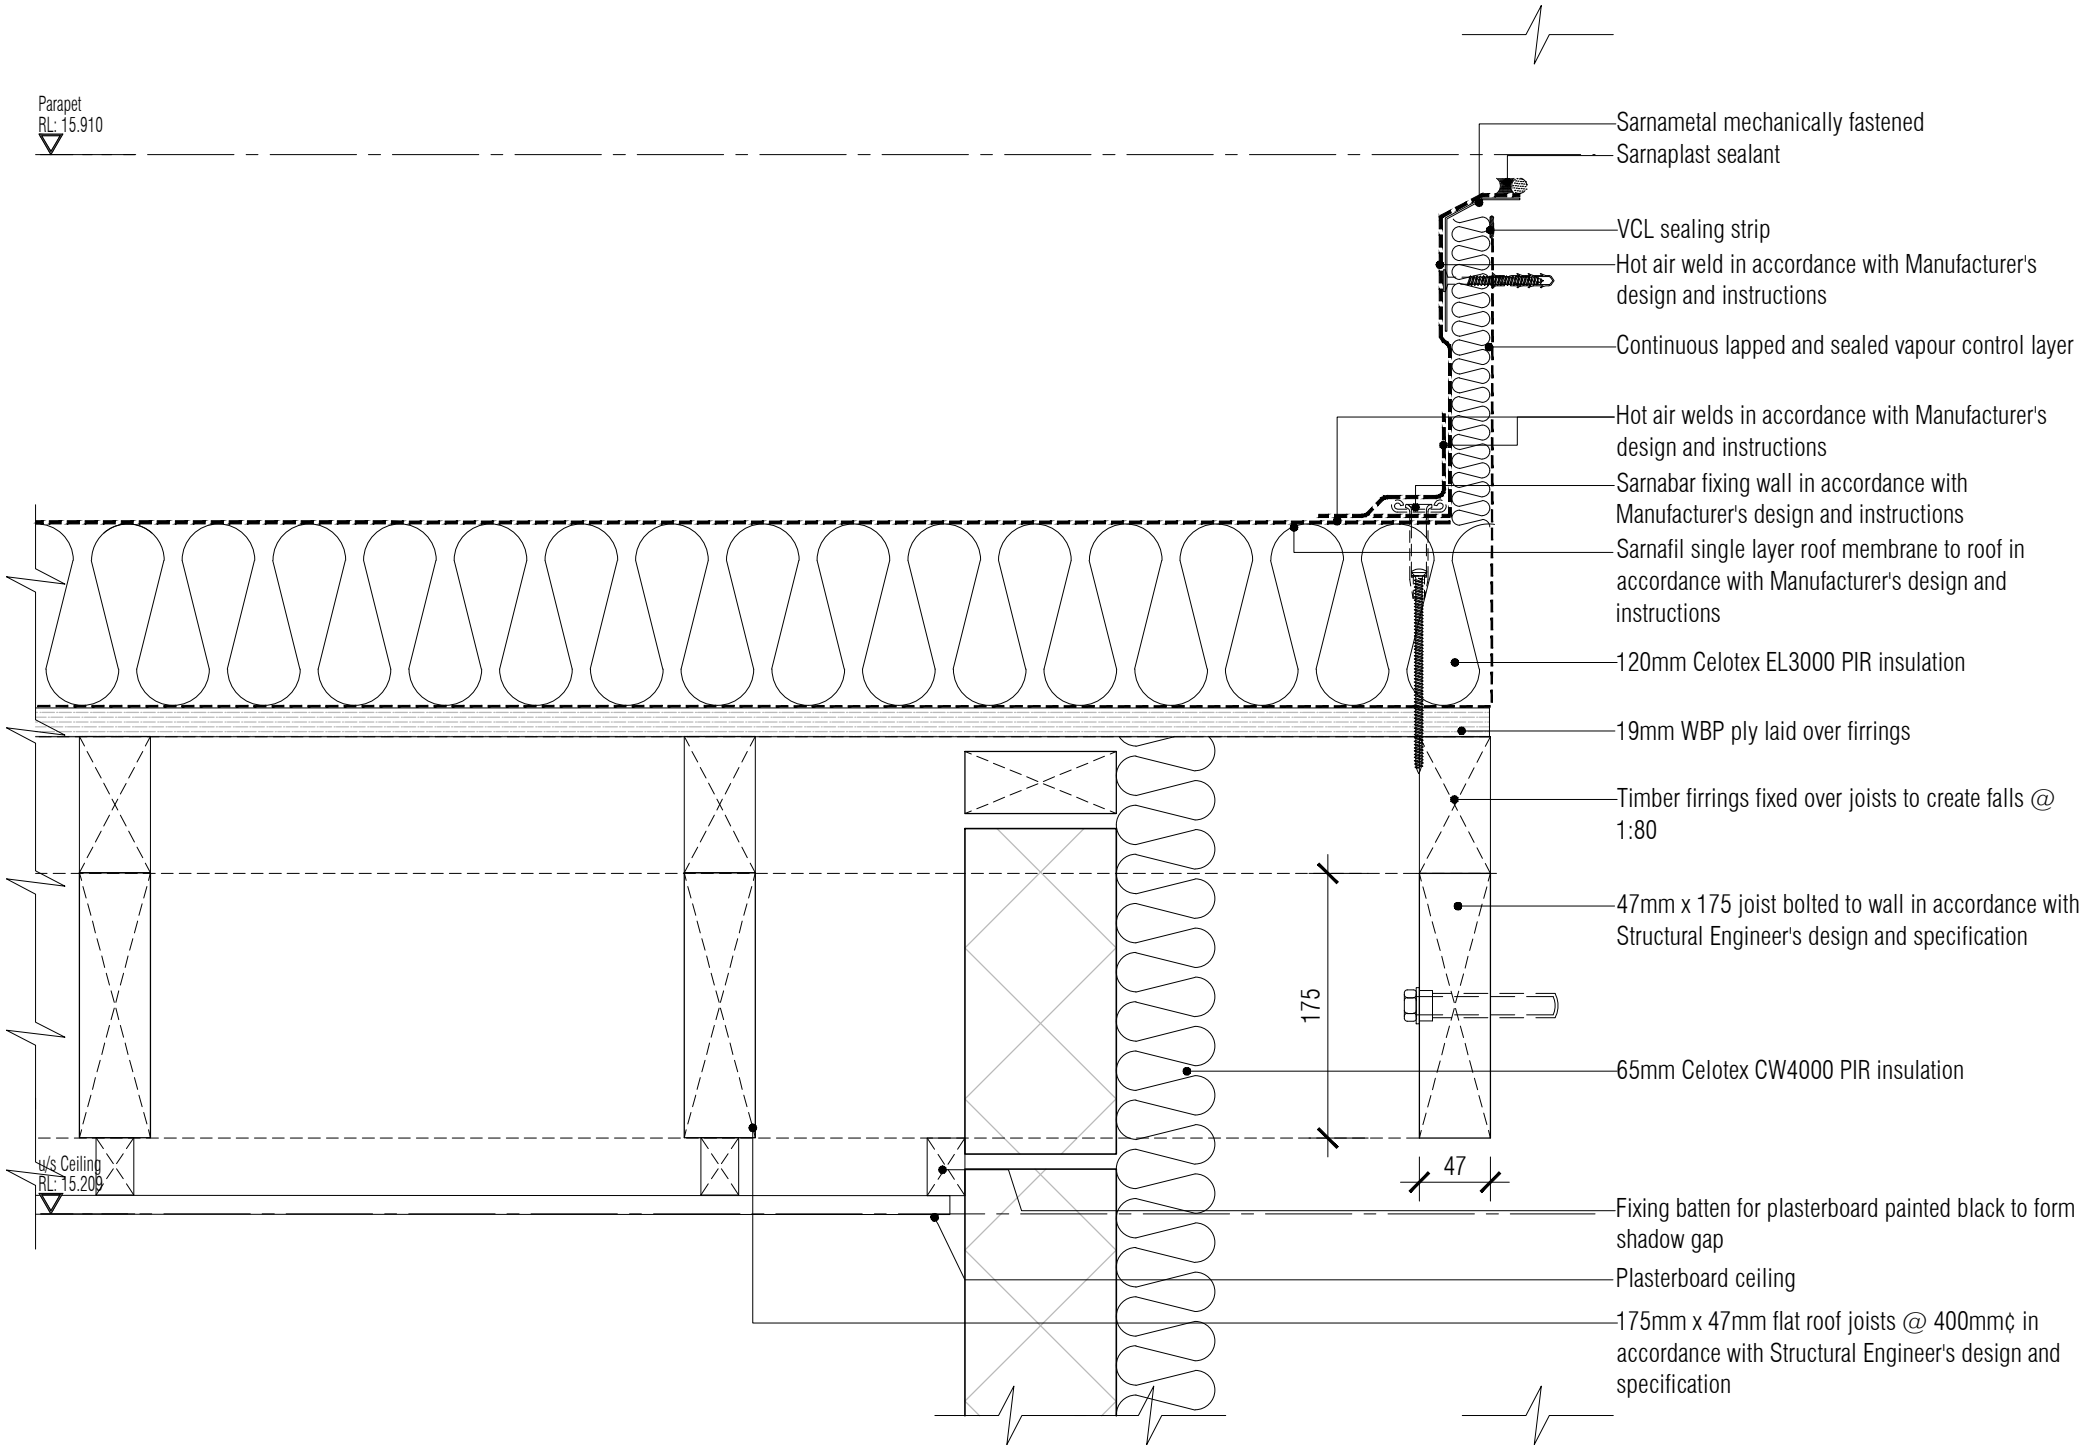

03 Abutment Detail
Scale: 1:5

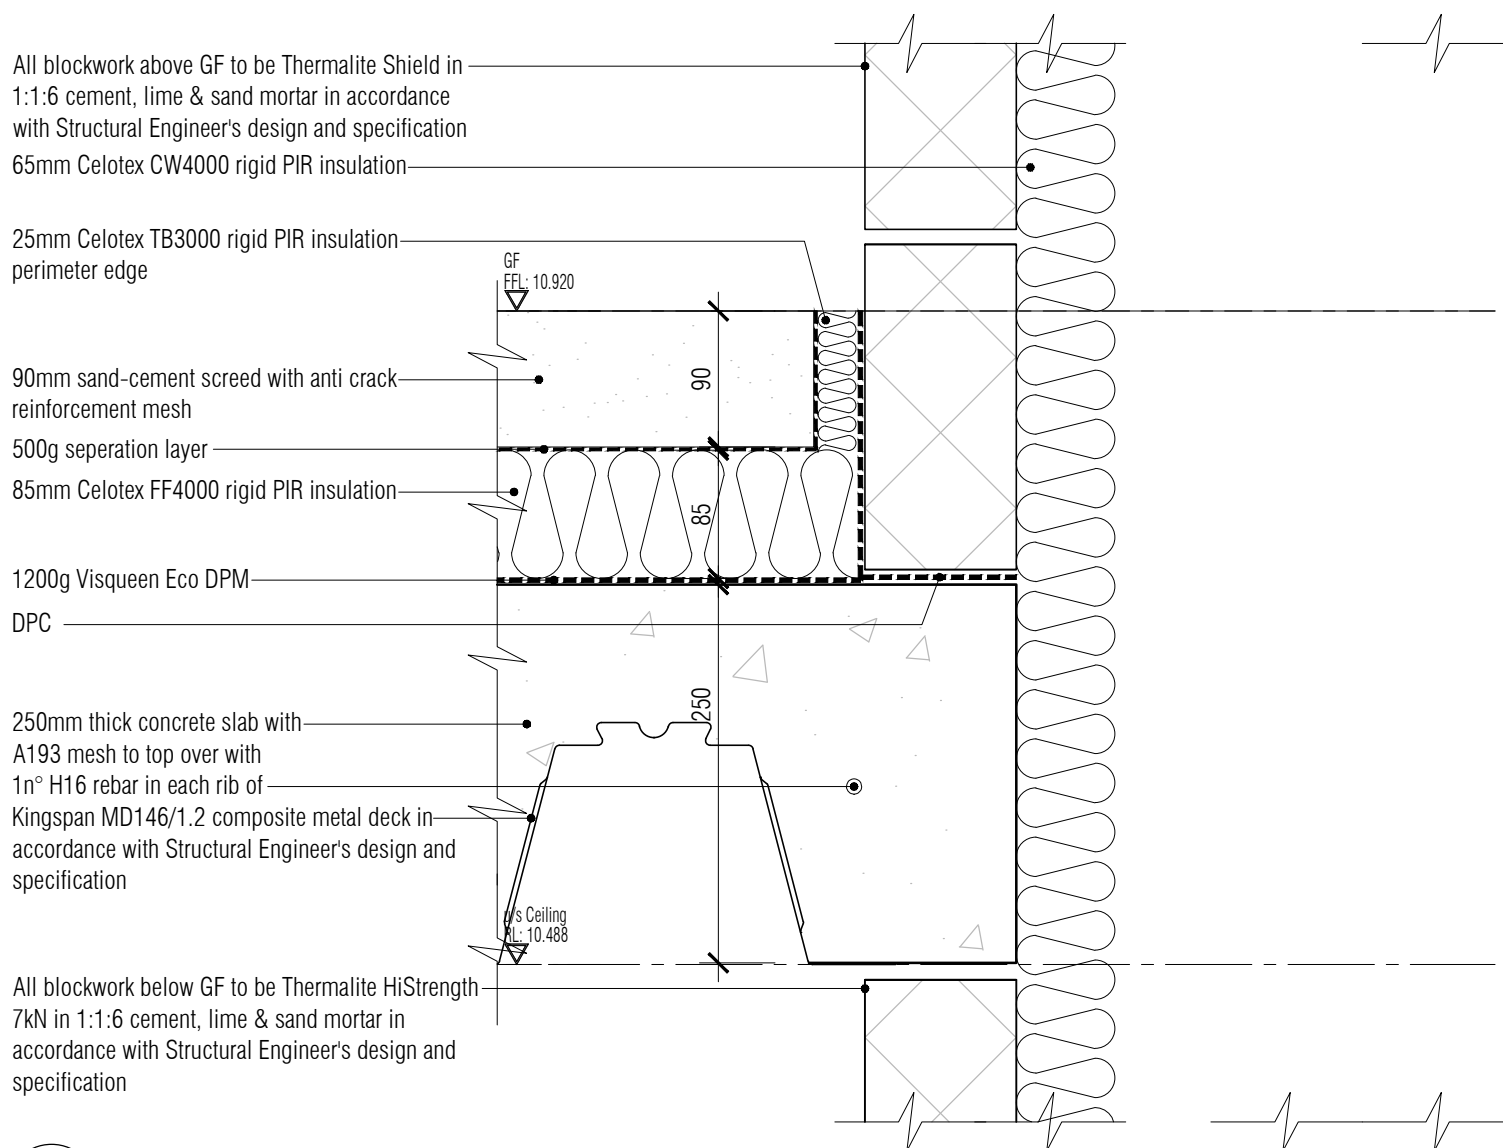


04 Floor End Detail
Scale: 1:5

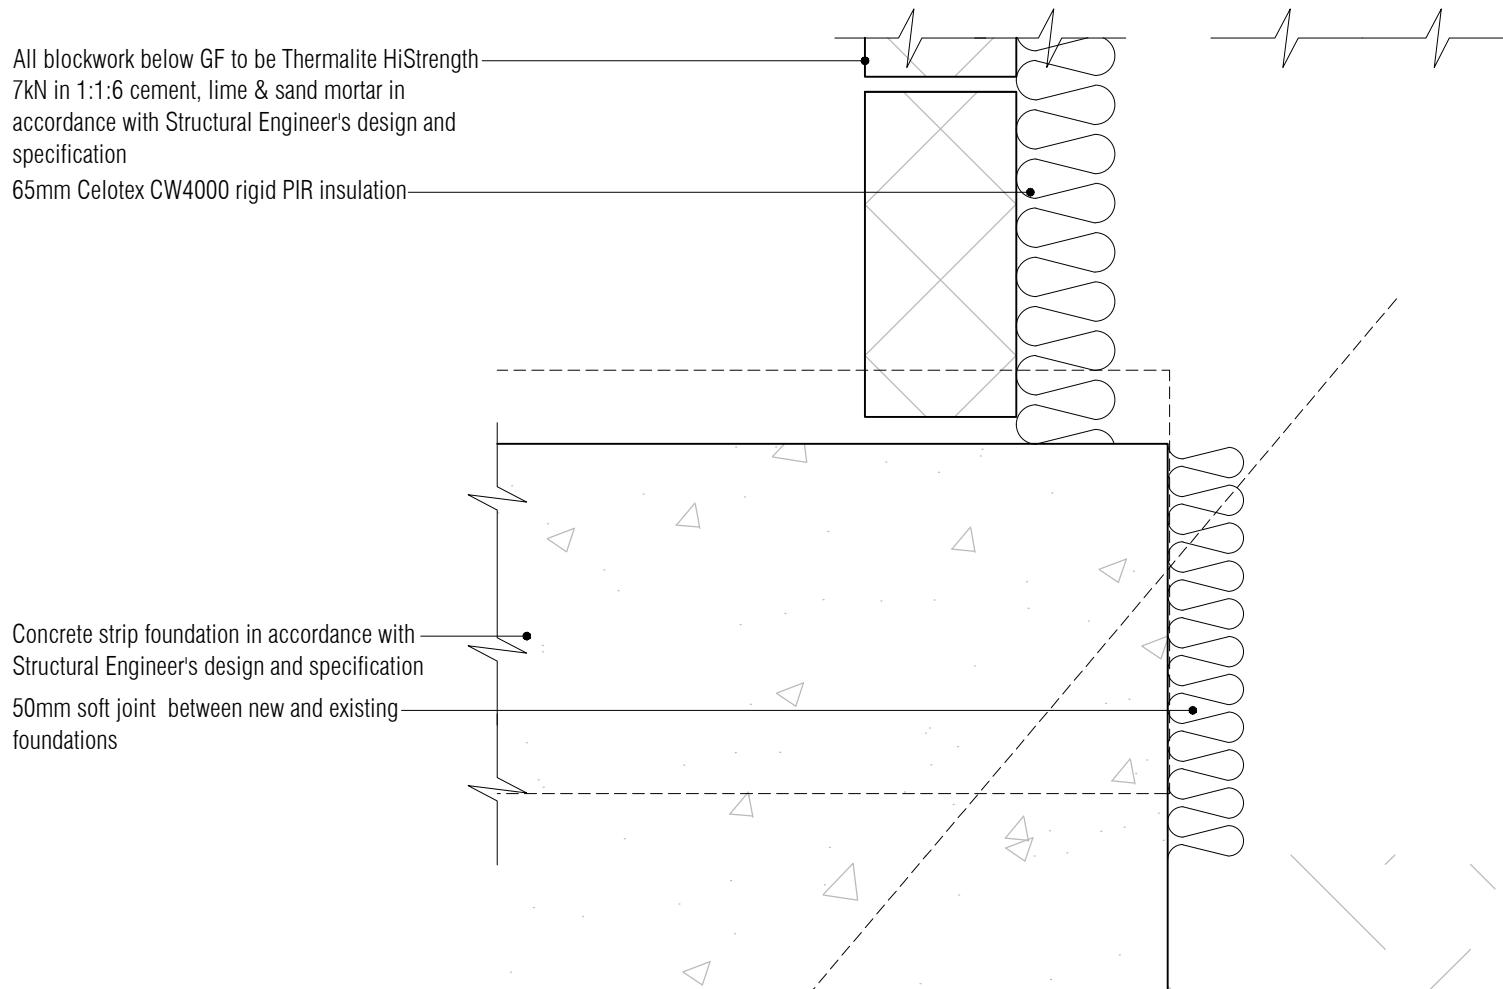

05 Foundation / Adjacent Foundation Detail
Scale: 1:5

NOTES: Do not scale this drawing. All dimensions to be checked on site prior to commencement or manufacture.
Key Plan (nts)

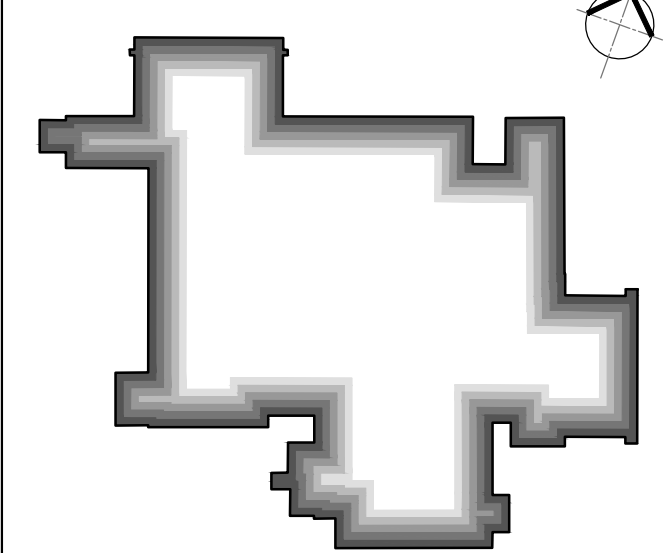

ISSUED FOR CONSTRUCTION

All details referenced in call outs supersede general arrangement or larger depictions.

Rev	Date	By	Chk	Comment
C2	04.04.12	RKC	JAS	Gen revs
C1	29.03.12	RKC	JAS	Issued for CONSTRUCTION

BRINGING IDEAS TO LIFE

FRANKHAM

Frankham Consultancy Group Limited
21 Perryman Road
Haywards Heath RH16 3TP
t 01444 444000 f 01444 455642
enquire@frankham.com
www.frankham.com

Client

Mansell
Contract N°: MC0269

Project Title

Eastbourne & Worthing
Crematoria
Refurbishments and Alterations

Drawing Title


EASTBOURNE
Eastbourne Crematorium
Proposed Details

Drawn by: RKC	Scale: 1:5 @ A1	Date: 15.03.12
Designed by: FCG	Checked by: JAS	Approved by: AC


File Ref.: X:\FRANKHAM\2_080512\01 CREMATORIA\ARCHIVE\400 DETAIL COORDINATES
307360-A-422-E.DWG - 29/06/11 12:19:45

Drawing No. 521260-A-422-E	Rev. C2
-------------------------------	------------


NB: All information based on supplied third party survey information.
All discrepancies to be reported to FCG immediately upon discovery.

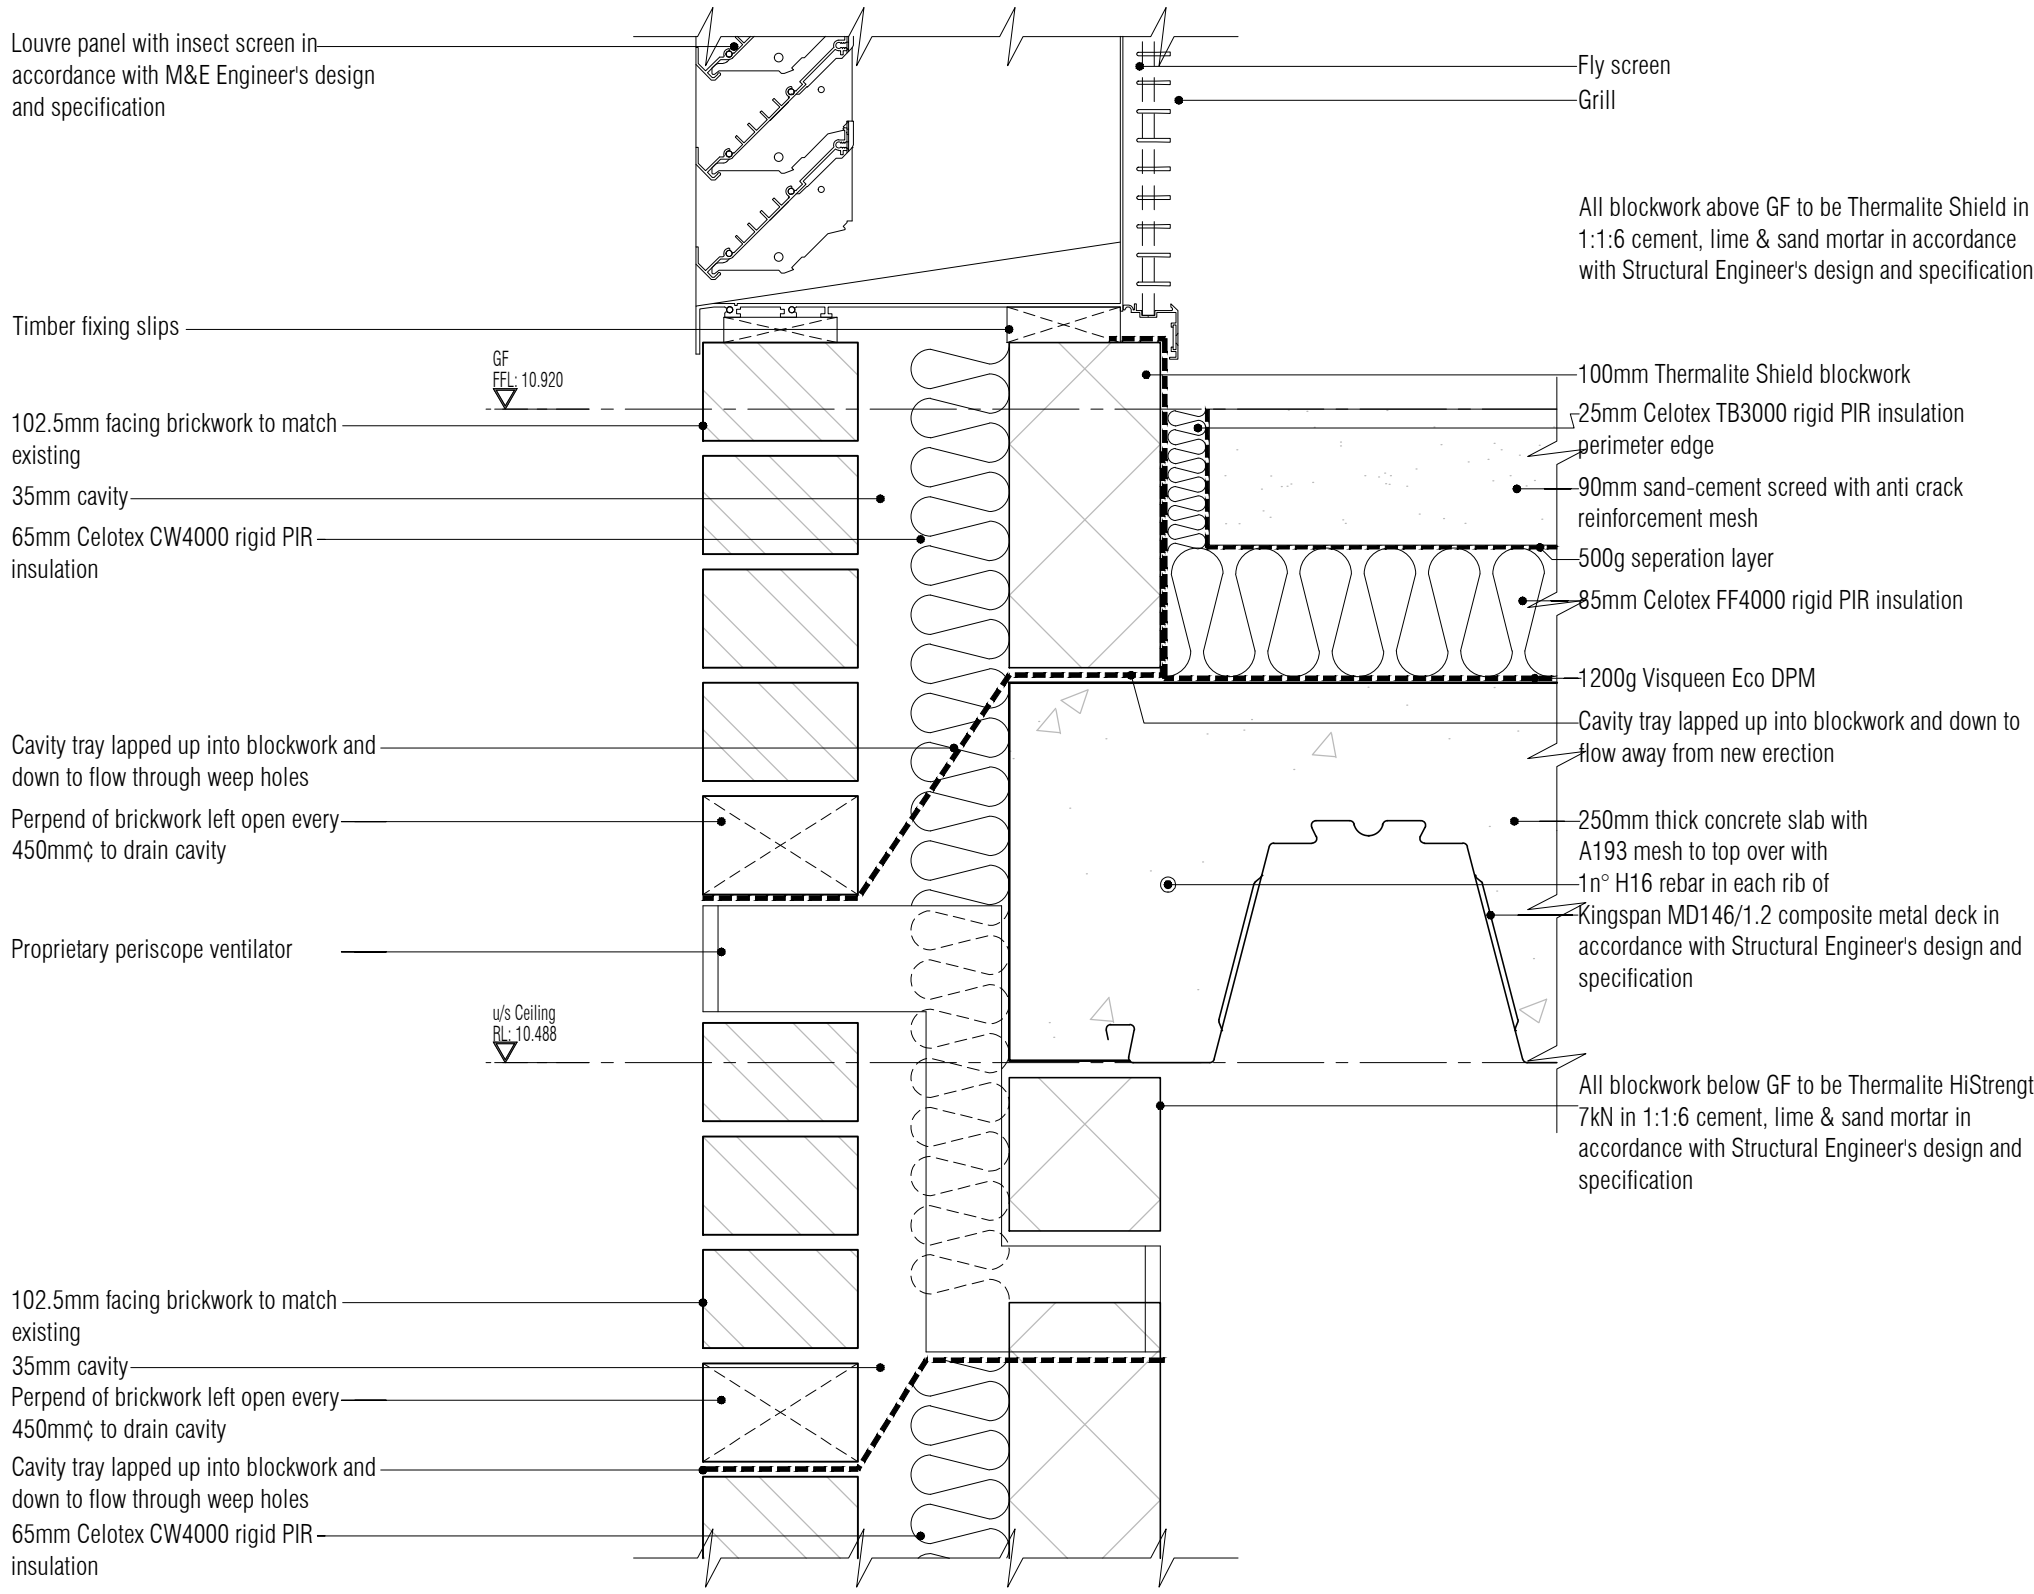


03 Floor / Louvre Detail
Scale: 1:5

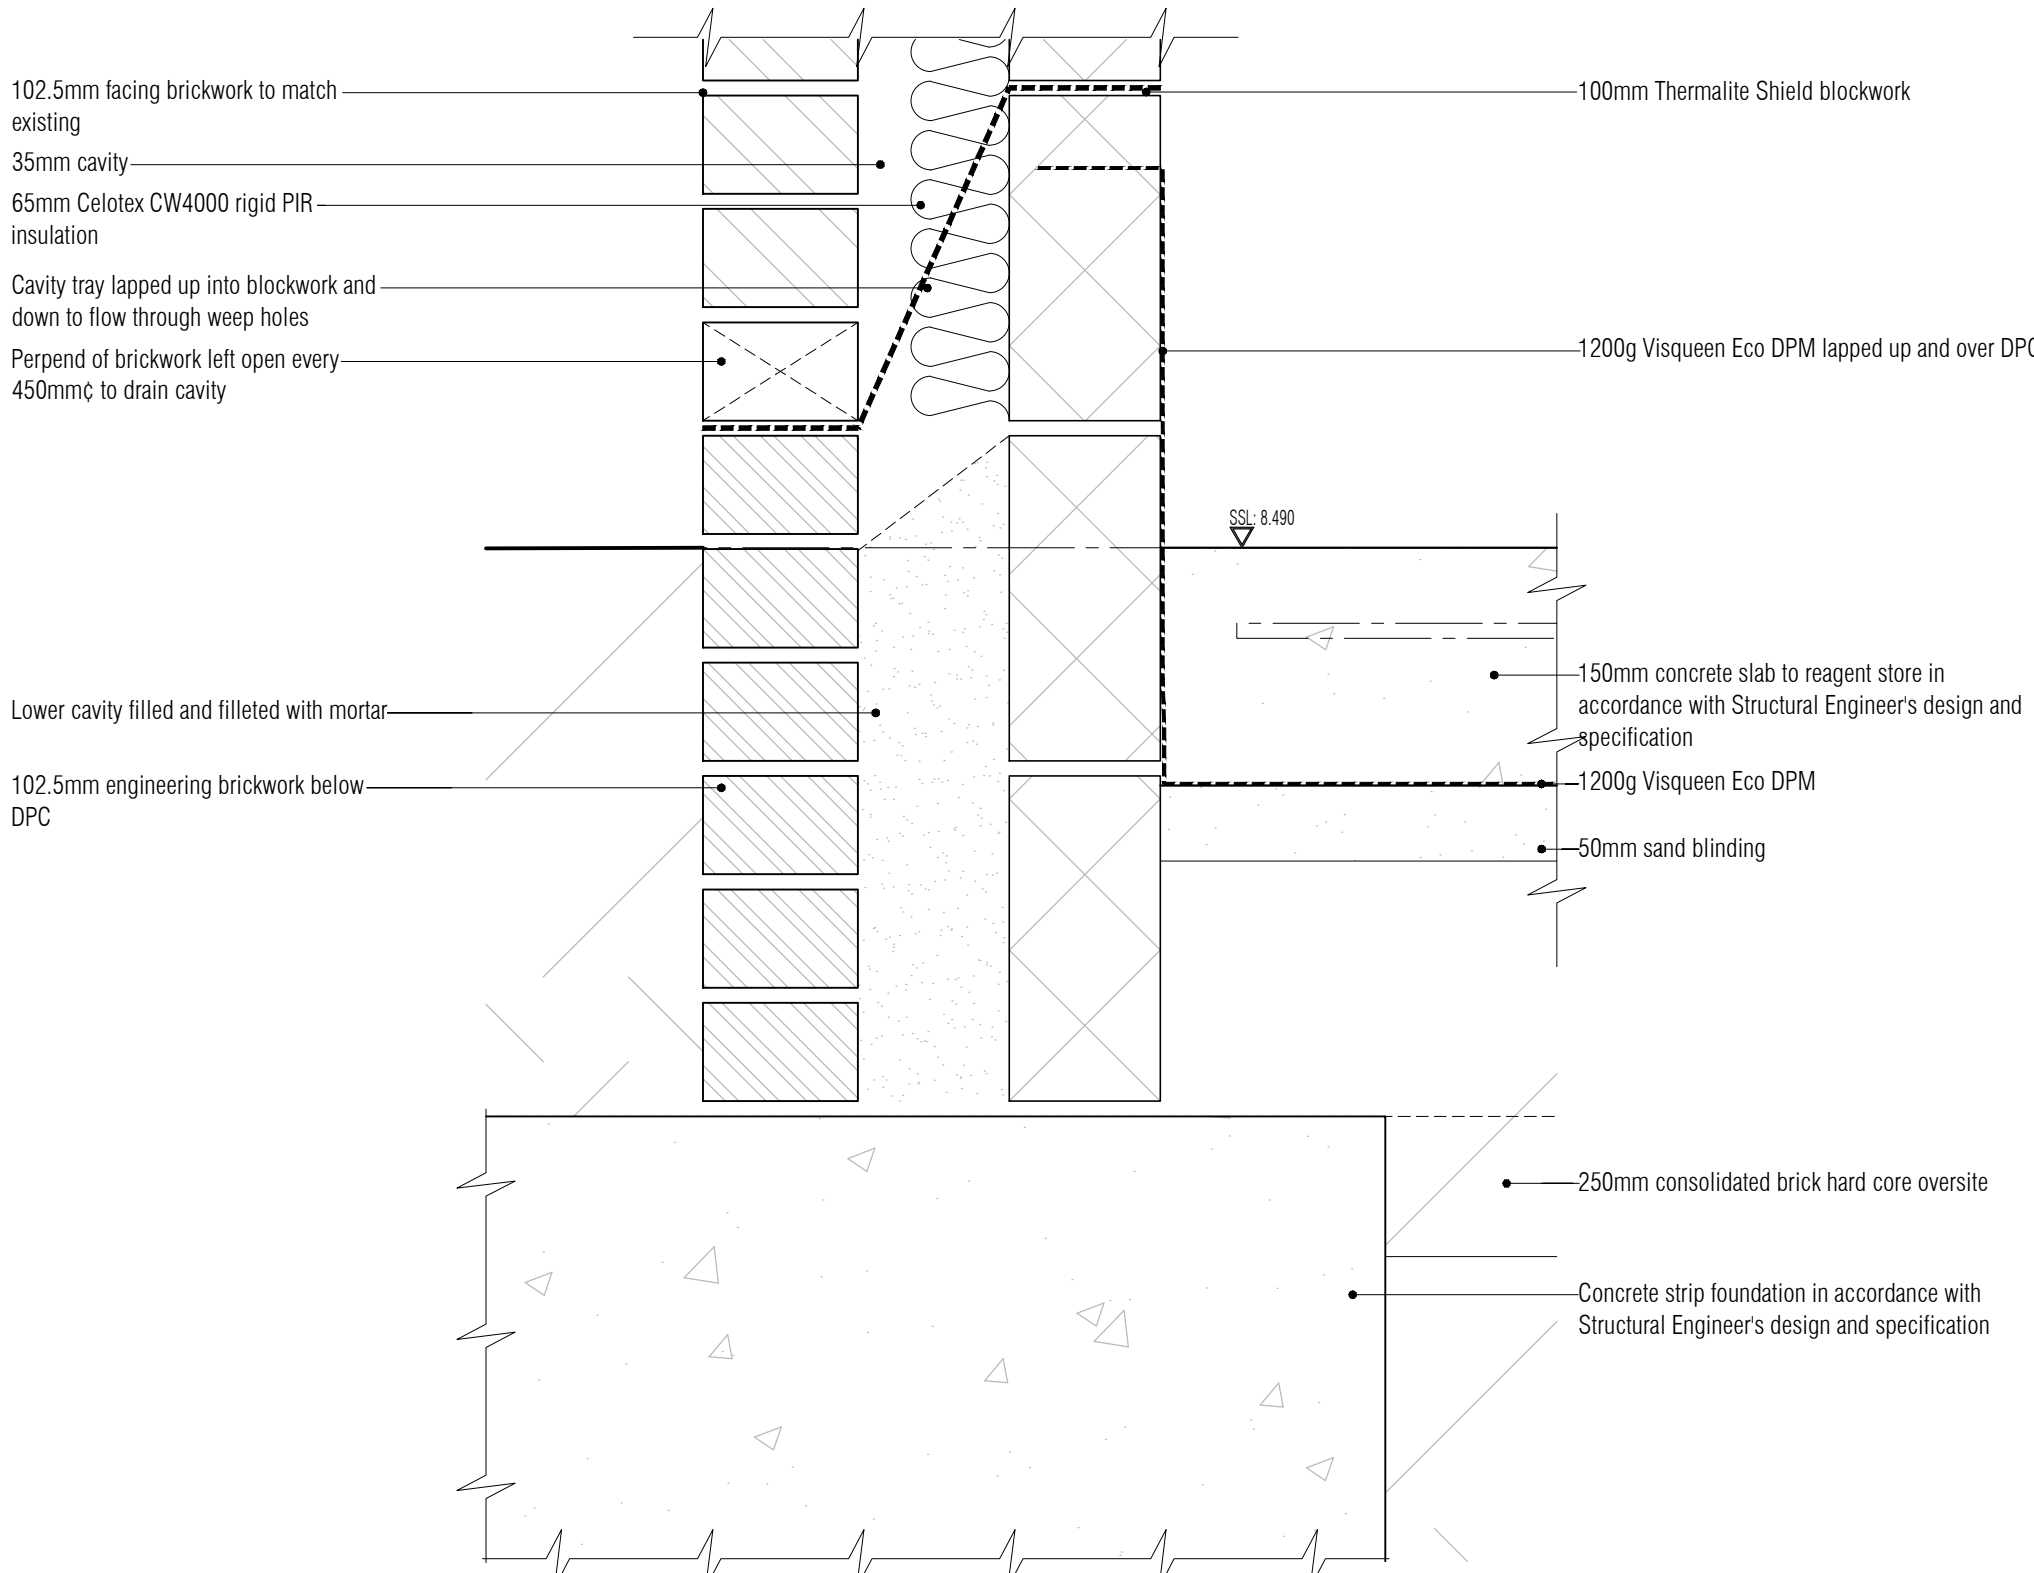

01 Foundation / Floor Detail
Scale: 1:5

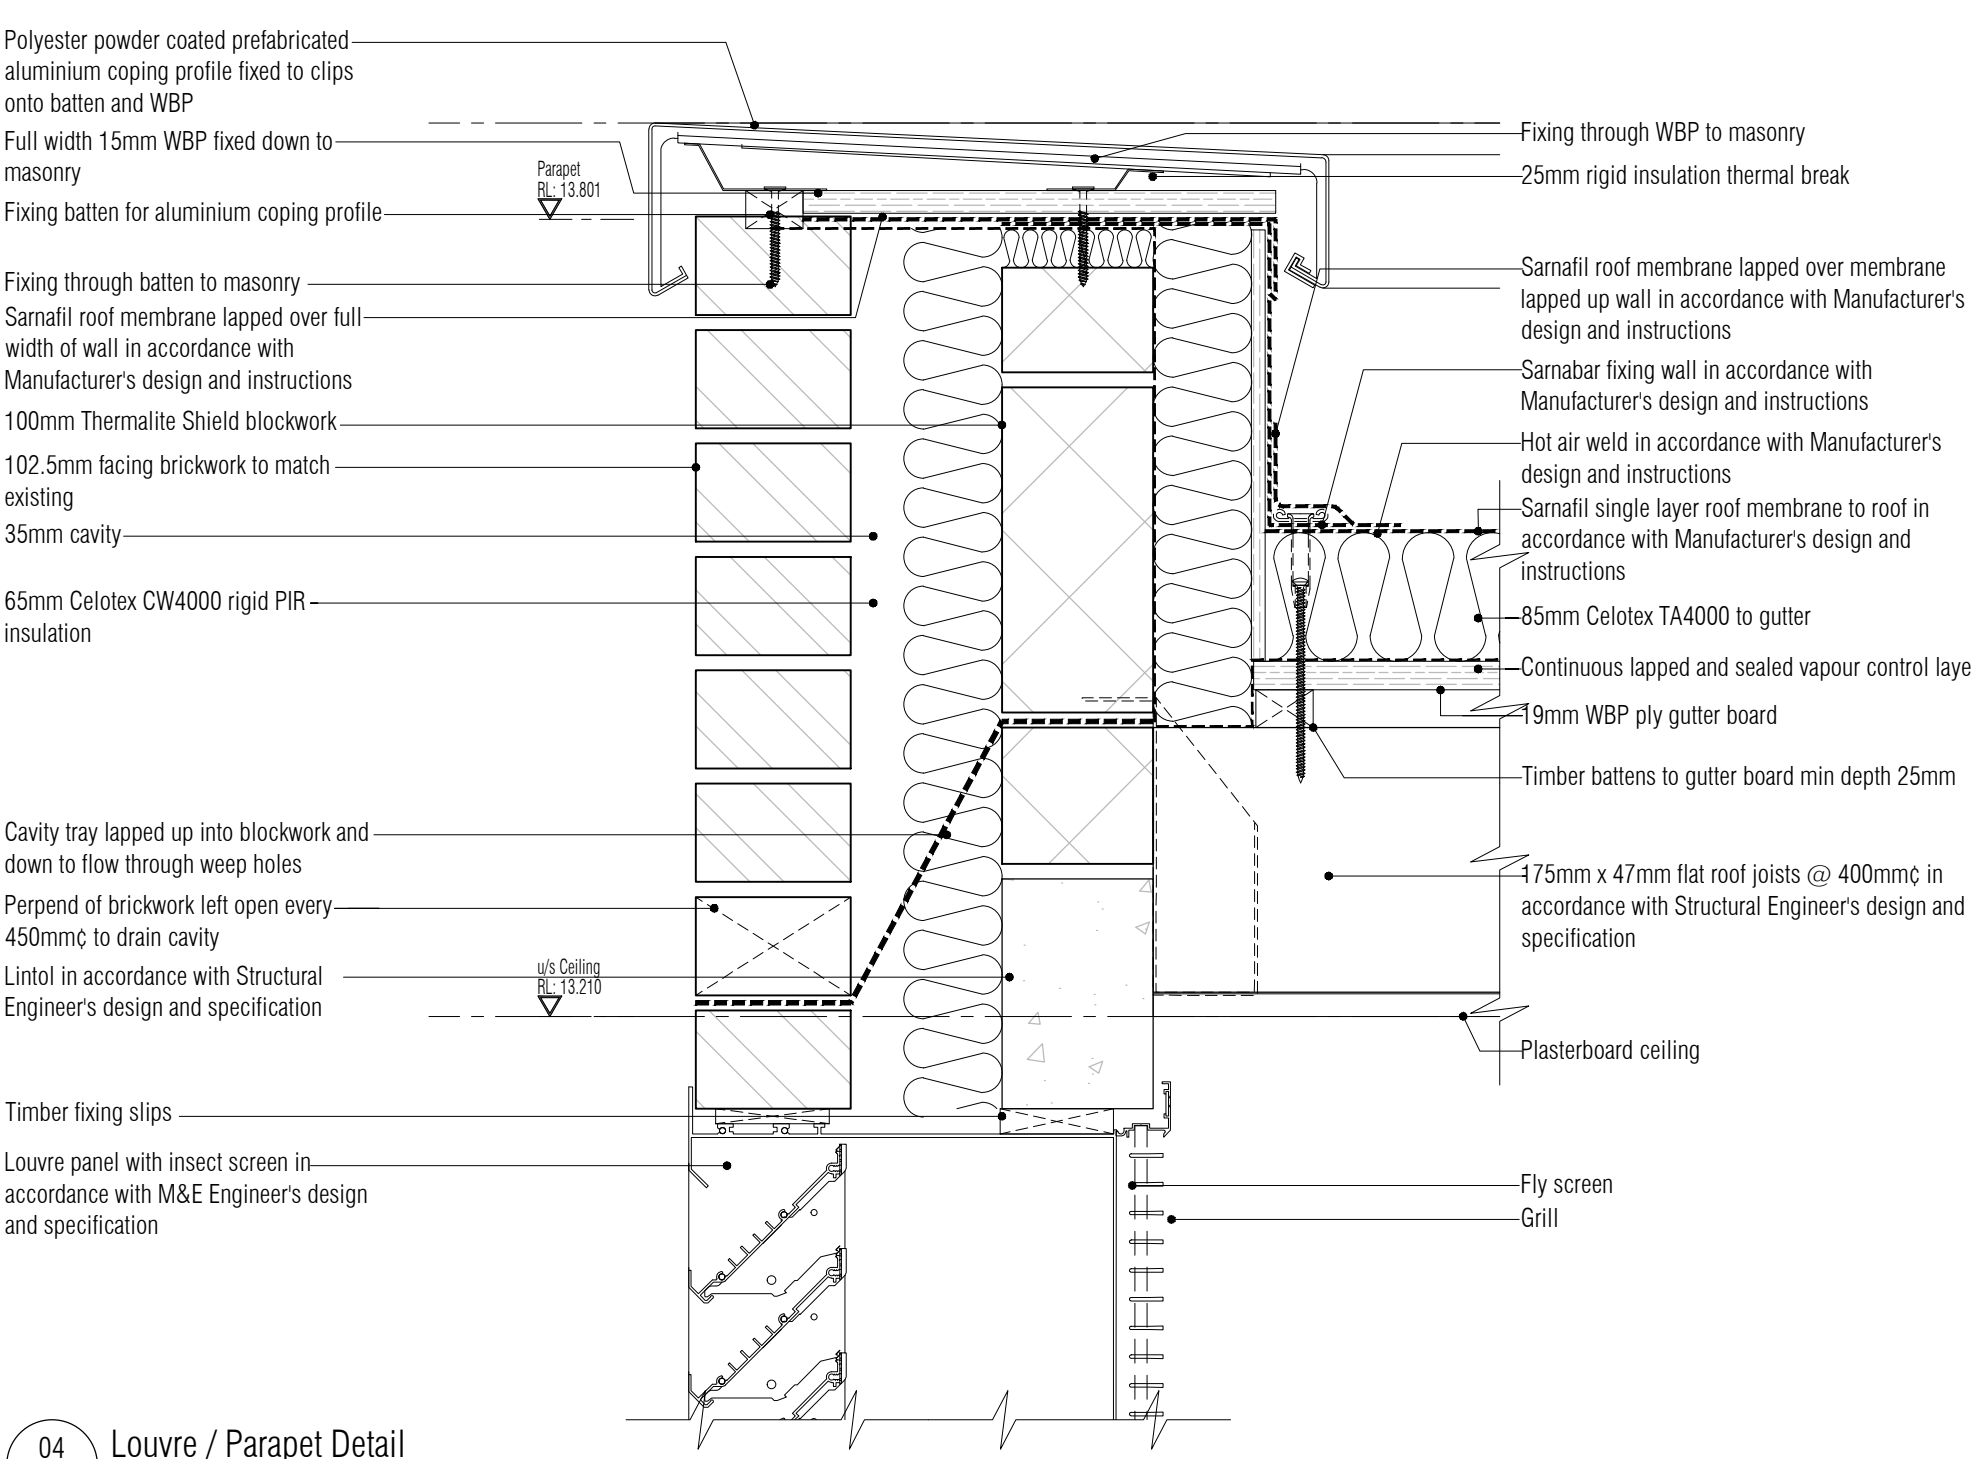


04 Louvre / Parapet Detail
Scale: 1:5

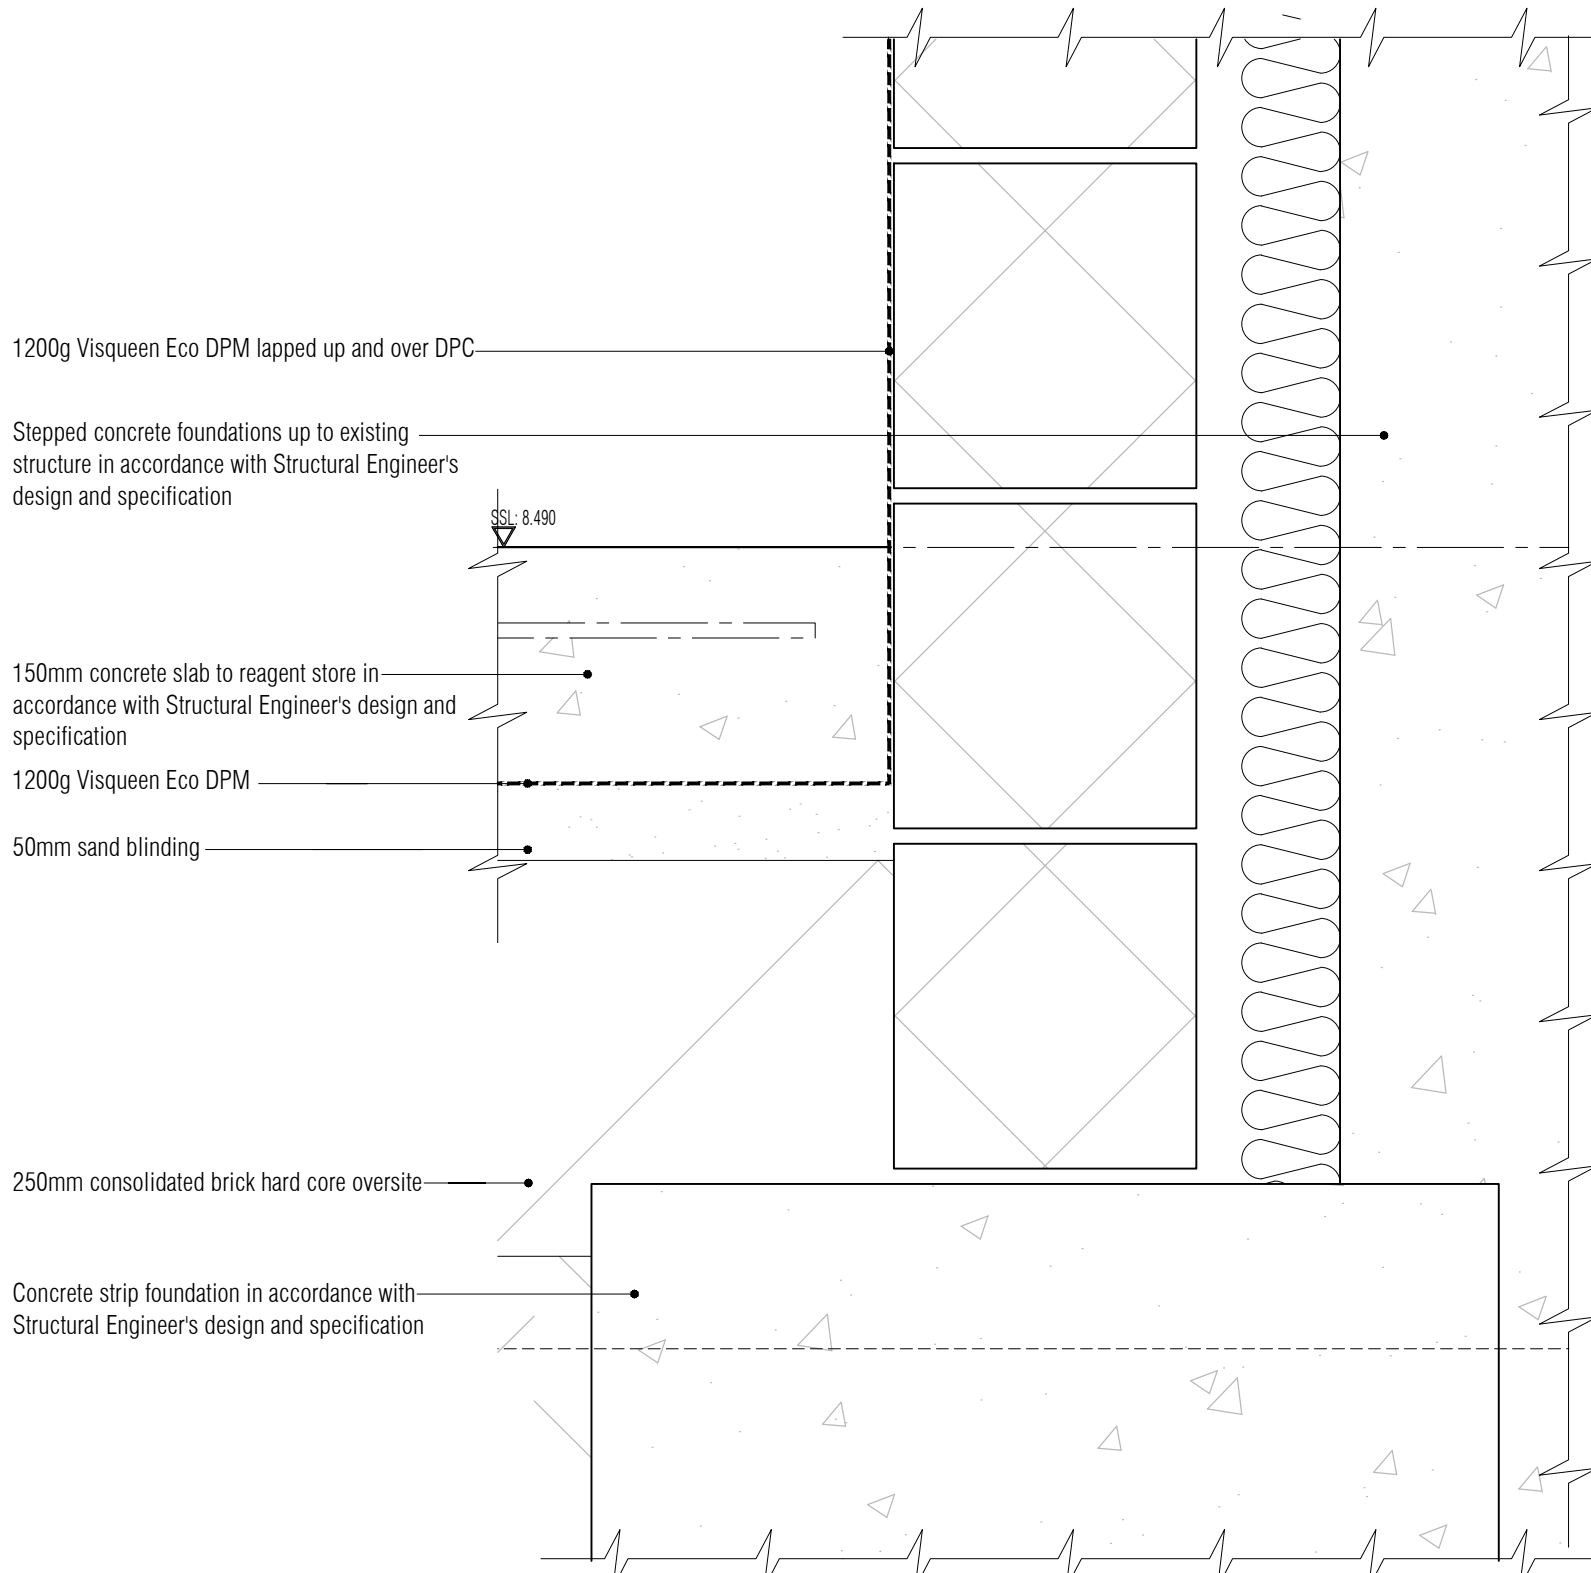

02 Foundation / Floor Detail
Scale: 1:5

NOTES: Do not scale this drawing. All dimensions to be checked on site prior to commencement or manufacture.
Key Plan (nts)

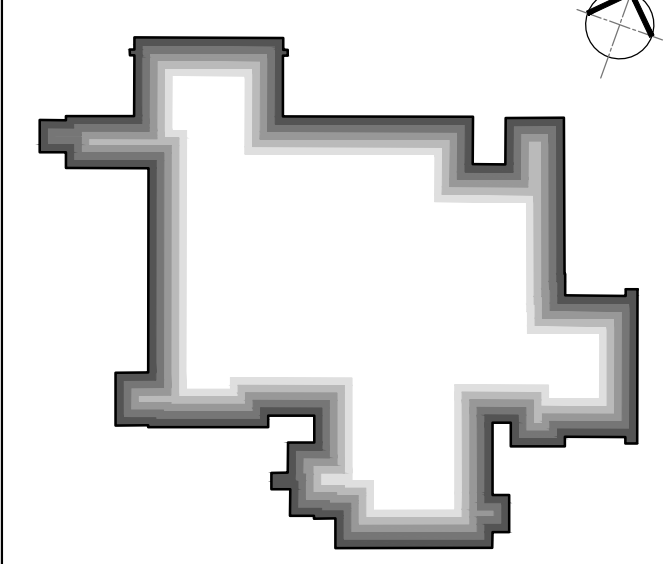

ISSUED FOR CONSTRUCTION

All details referenced in call outs supersede general arrangement or larger depictions.

Rev	Date	By	Chk	Comment
C2	05.07.12	RKC	JAS	reagent room revd
C1	29.03.12	RKC	JAS	Issued for CONSTRUCTION

BRINGING IDEAS TO LIFE

FRANKHAM

Frankham Consultancy Group Limited
21 Perryman Road
Haywards Heath RH16 3TP
t 01444 444900 f 01444 455642
enquire@frankham.com
www.frankham.com

Client

Mansell
Contract N°: MC0269

Project Title

Eastbourne & Worthing
Crematoria
Refurbishments and Alterations

Drawing Title

EASTBOURNE
Eastbourne Crematorium
Proposed Details


Drawn by: RKC	Scale: 1:5 @ A1	Date: 15.03.12
Designed by: FCG	Checked by: JAS	Approved by: AC

File Ref.: 307360-A-423-E-090 - 200611121957


Drawing No. 521260-A-423-E	Rev. C2
-------------------------------	------------

NB: All information based on supplied third party survey information.
All discrepancies to be reported to FCG immediately upon discovery.


All Disabled and Ambulant Disabled facilities to comply with Approved Document Part M - Access to and use of buildings*, Disability Discrimination Act 1995 and BS83000 as required

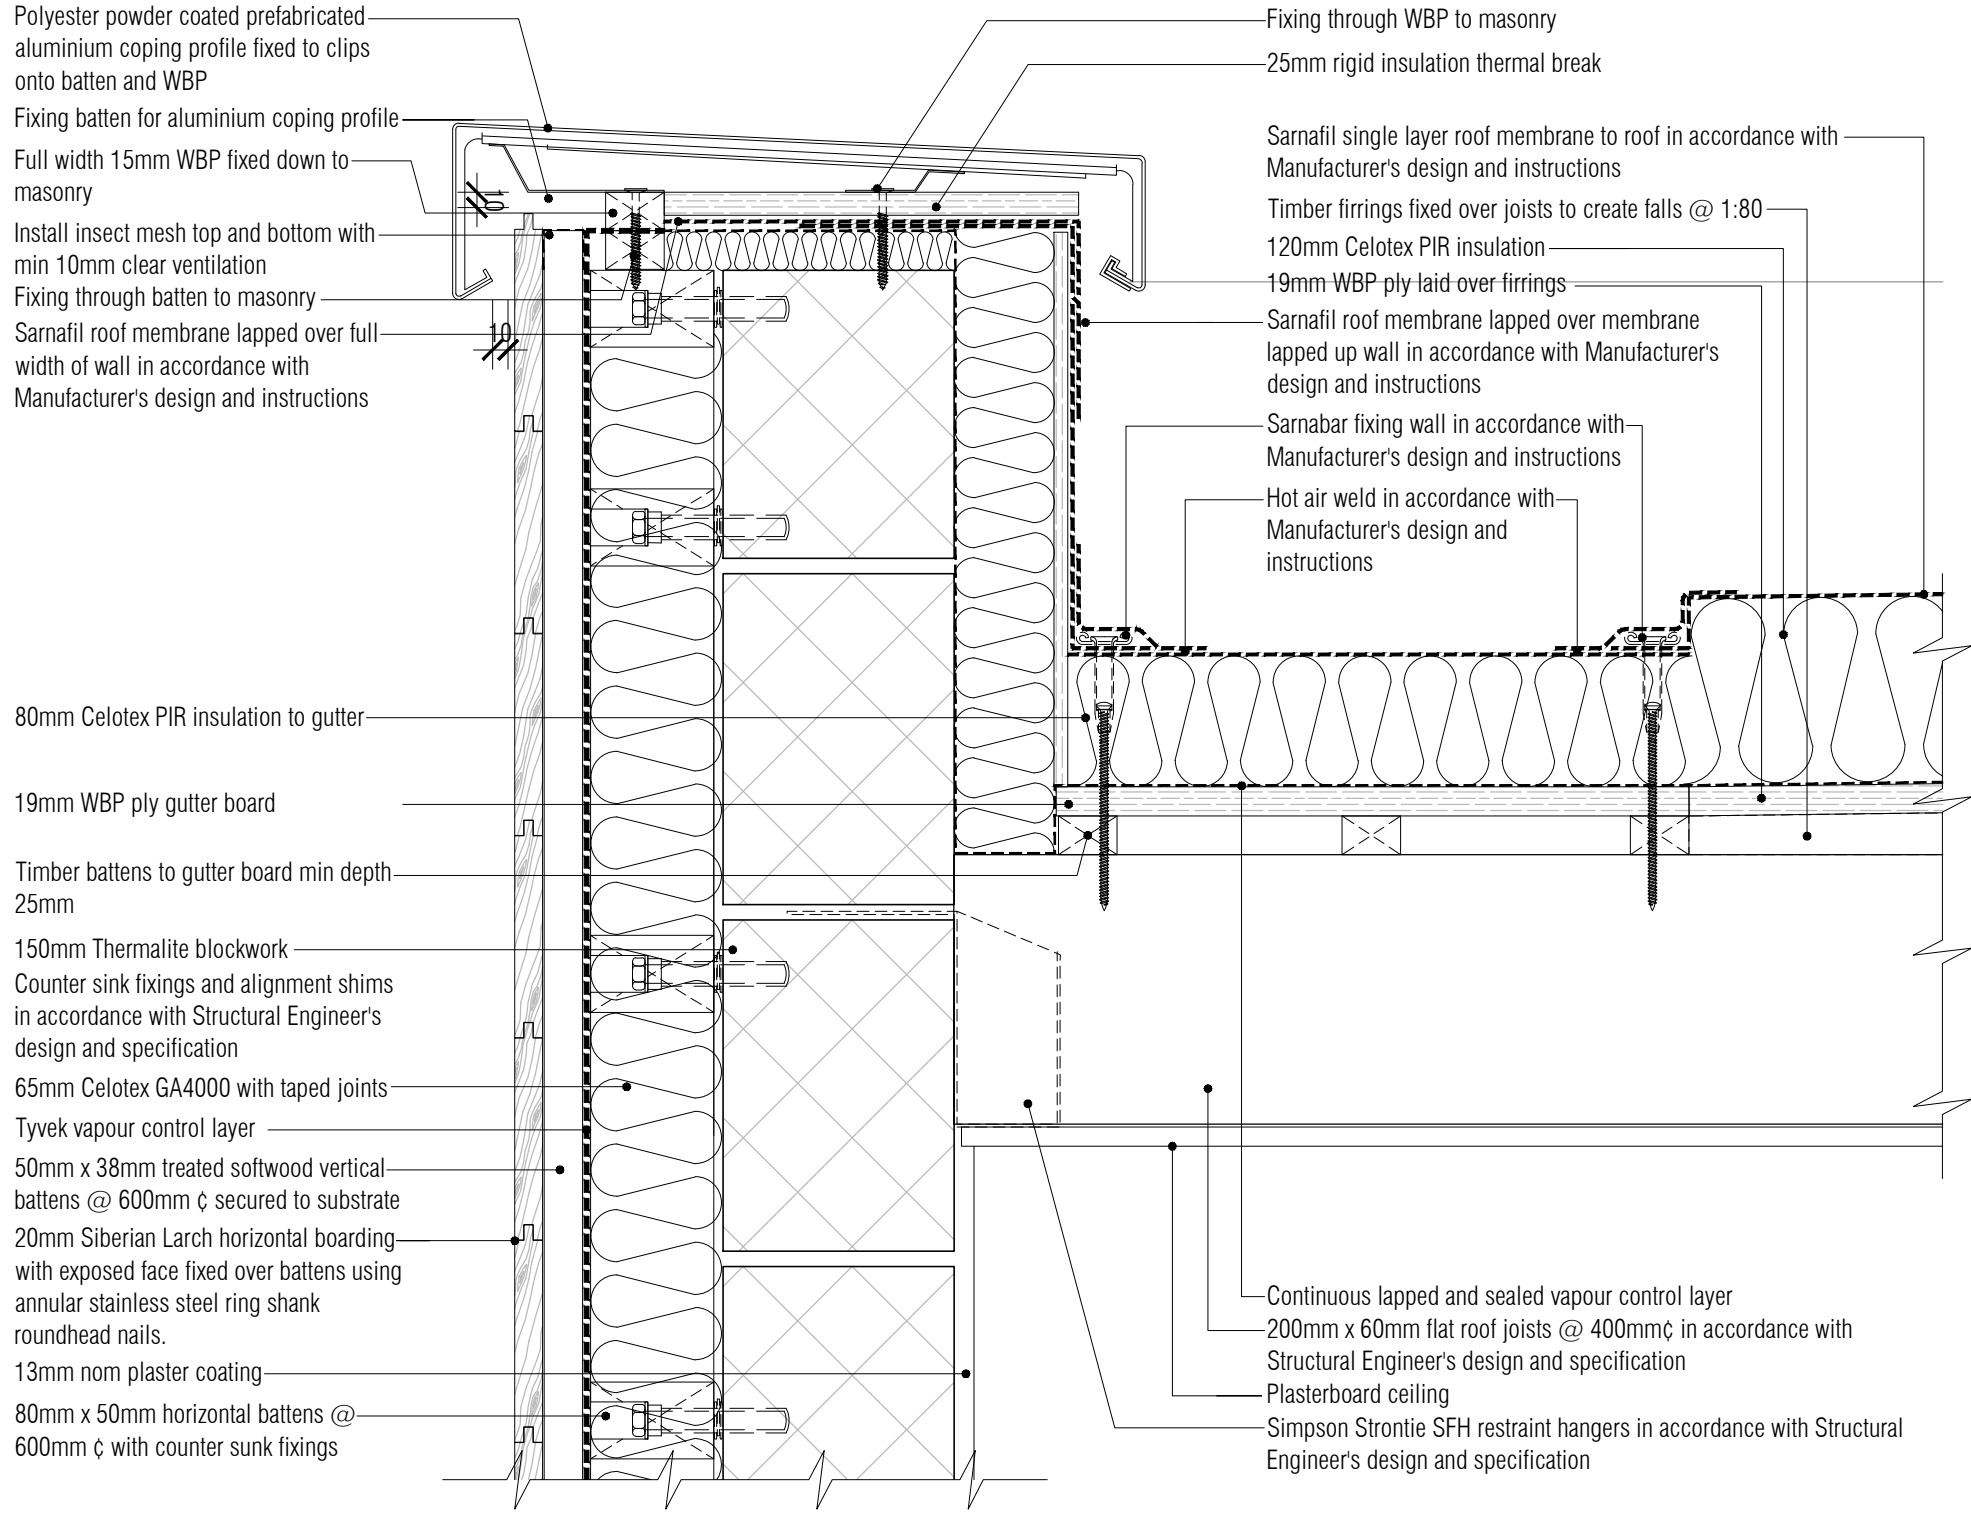


01 Typical Parapet & Gutter Detail
Scale: 1:5

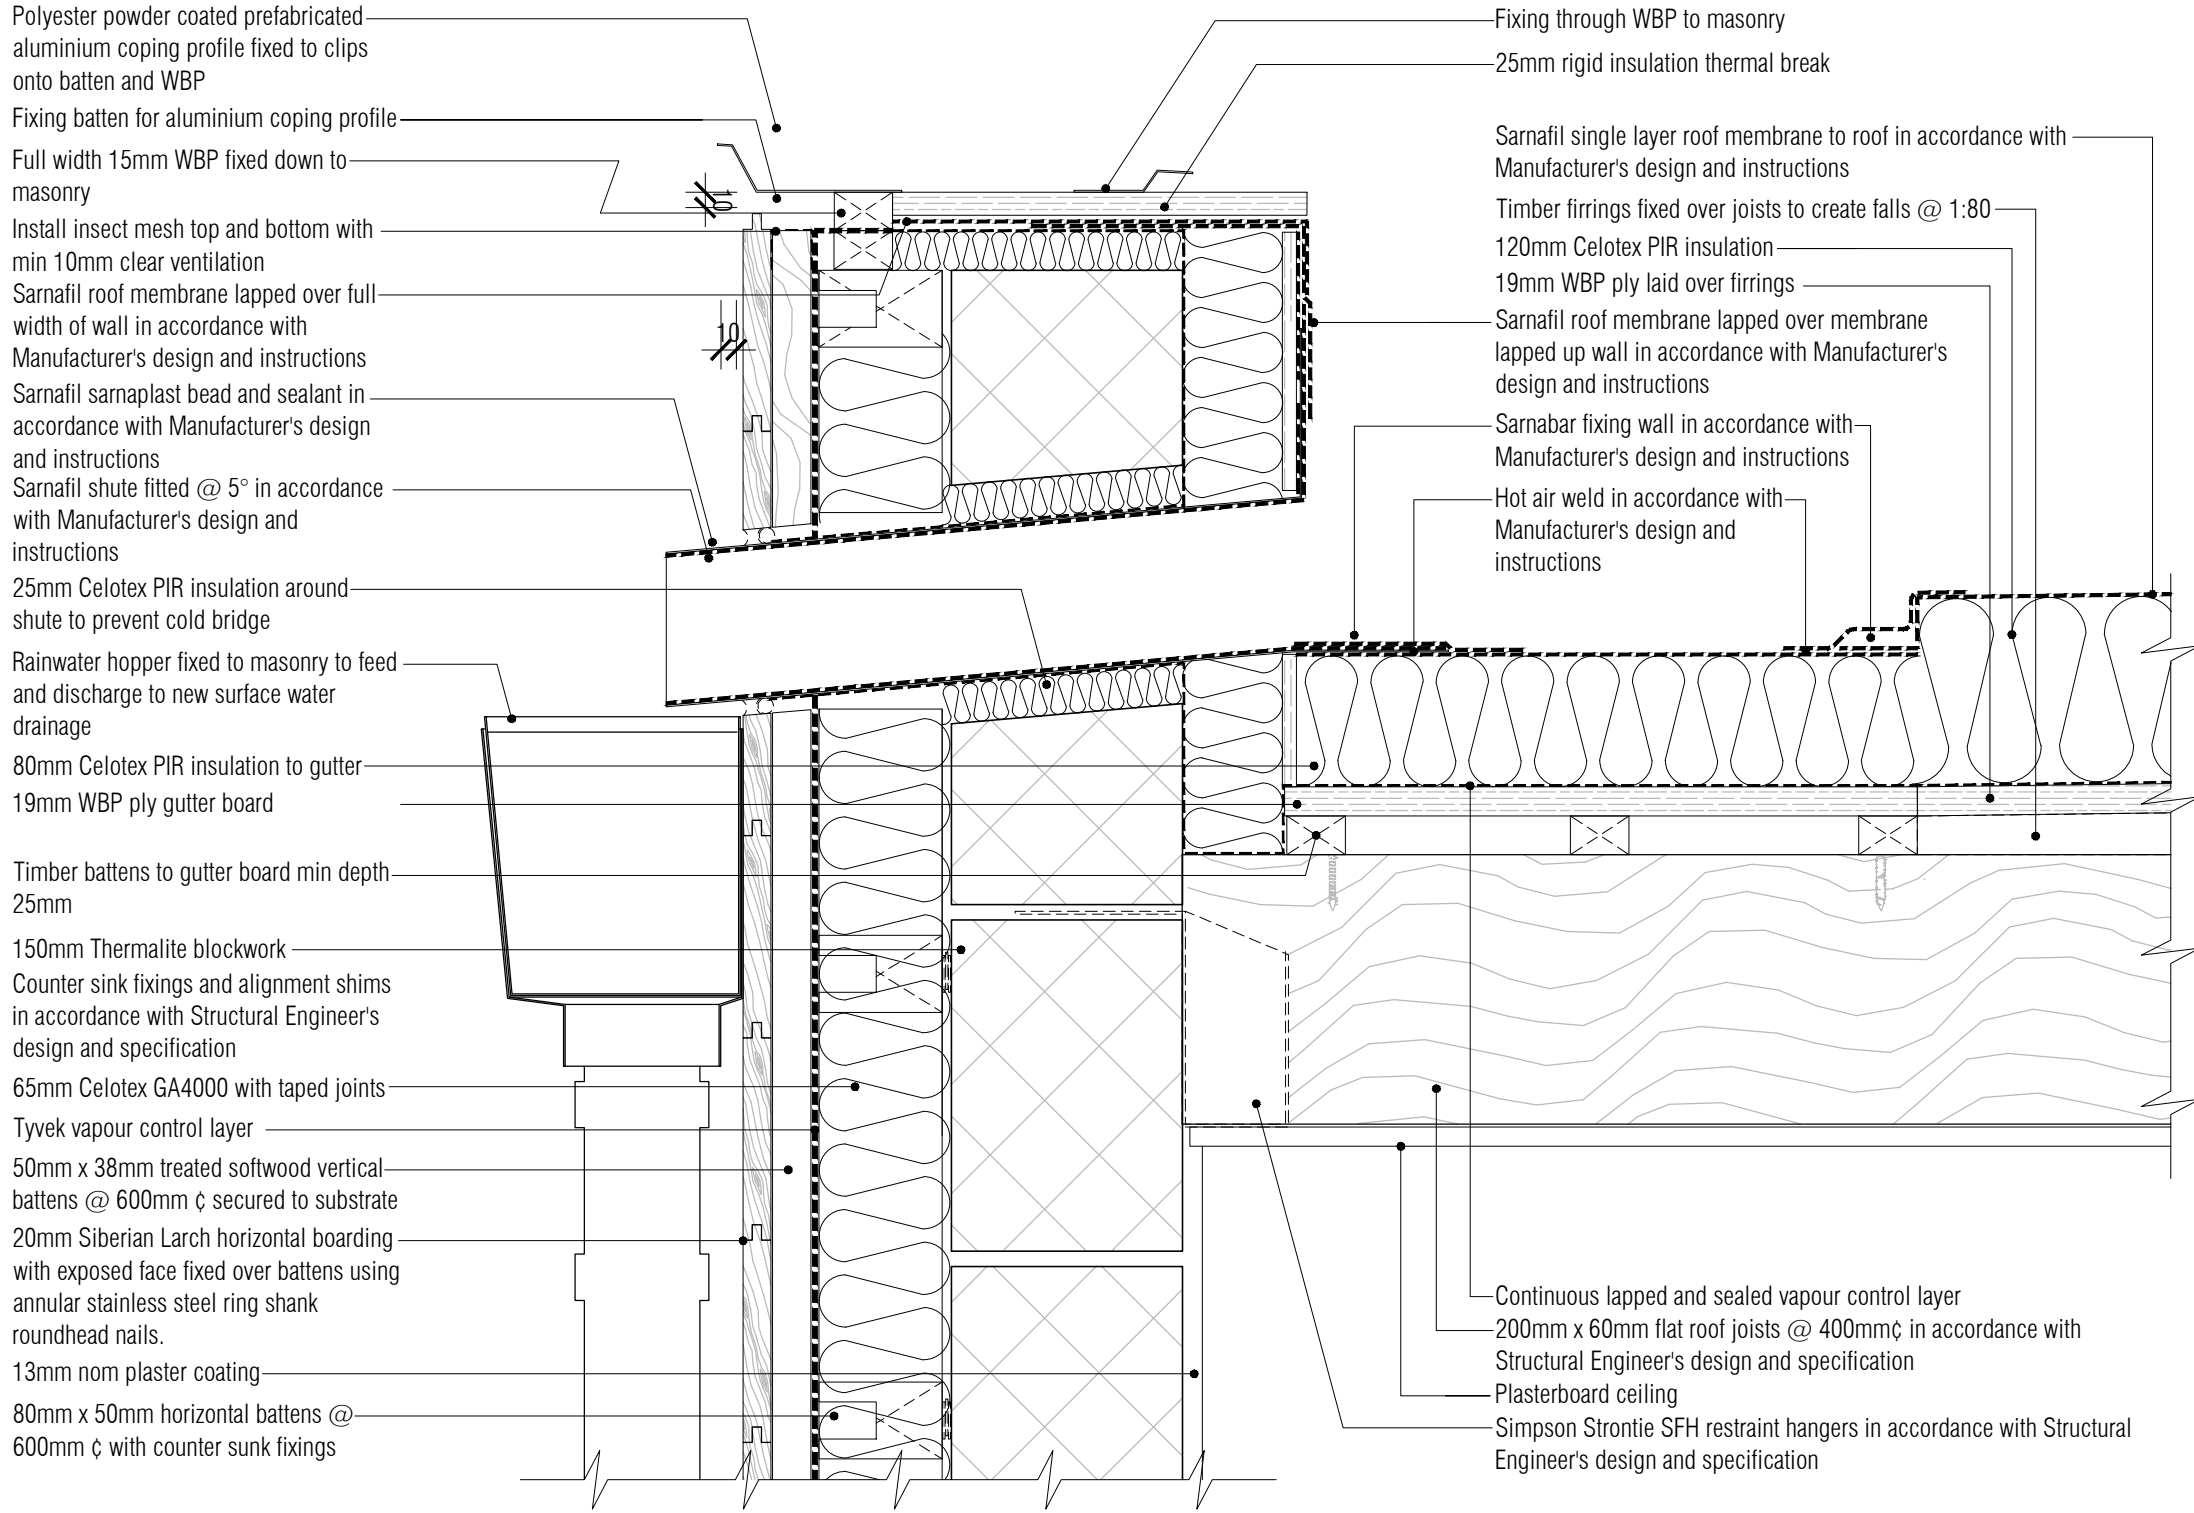

02 Typical Parapet Outlet & Hopper Detail
Scale: 1:5

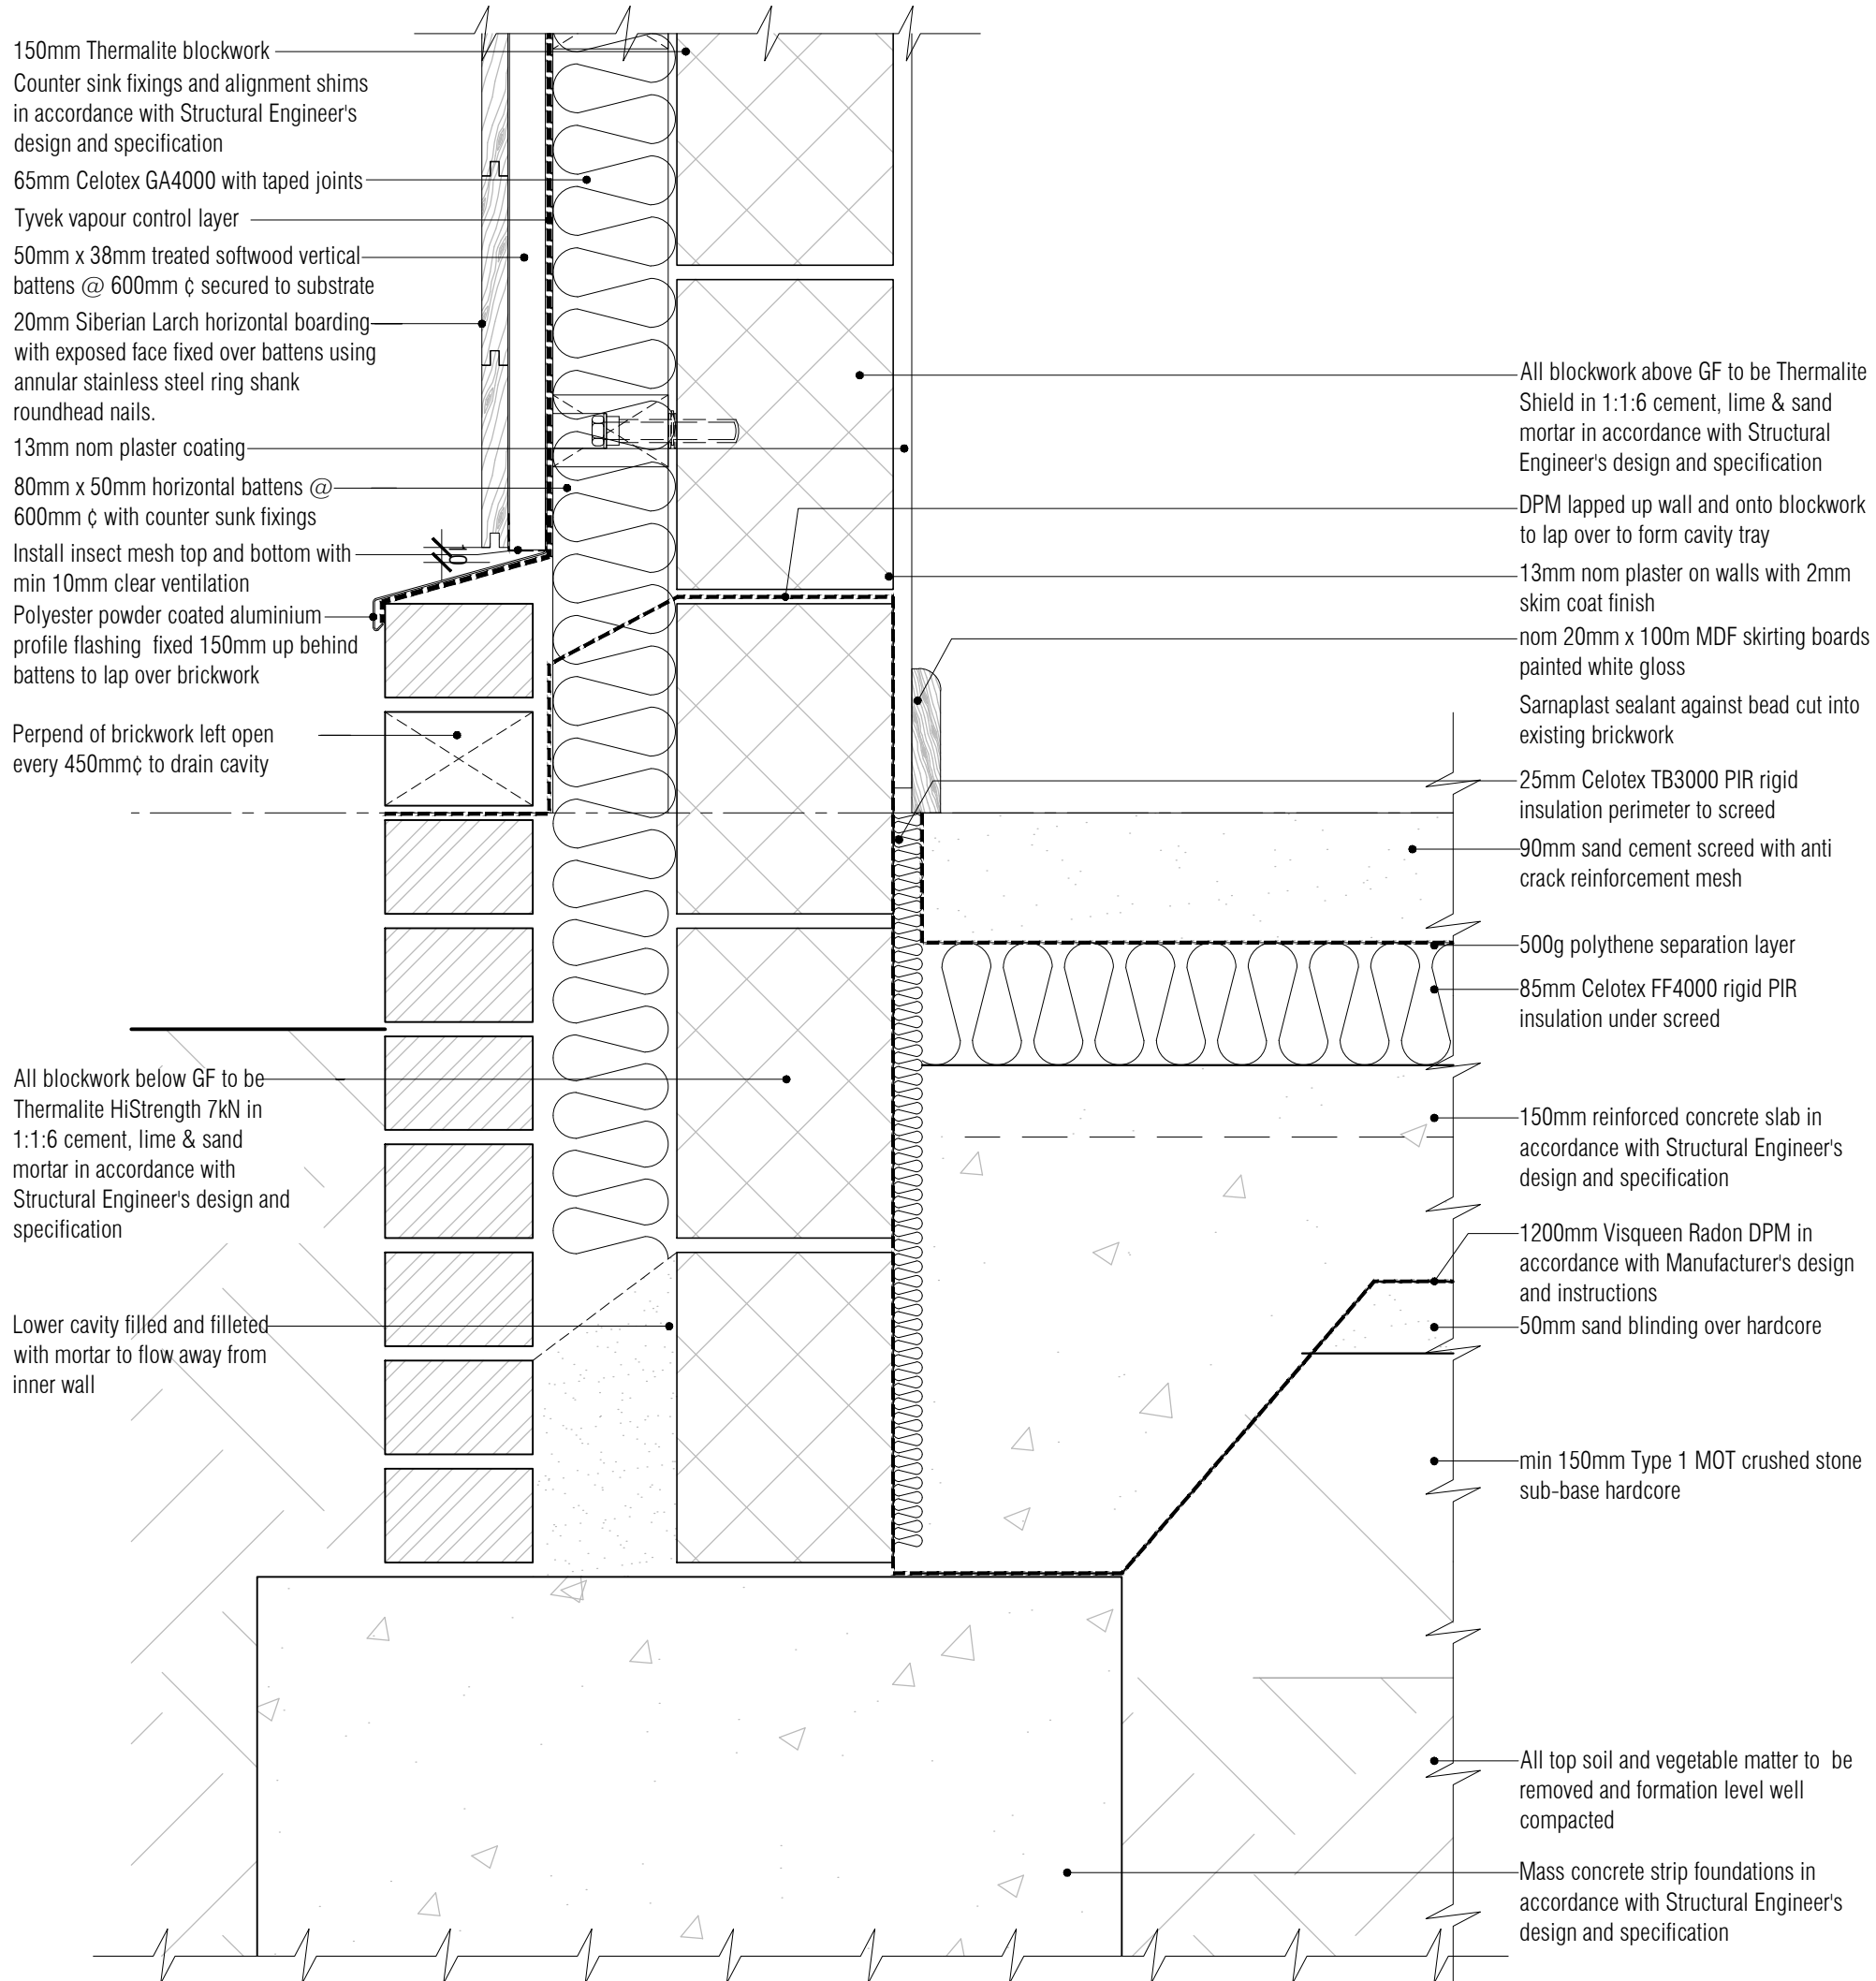


03 Typical Staff Room Wall Floor Interface Detail
Scale: 1:5

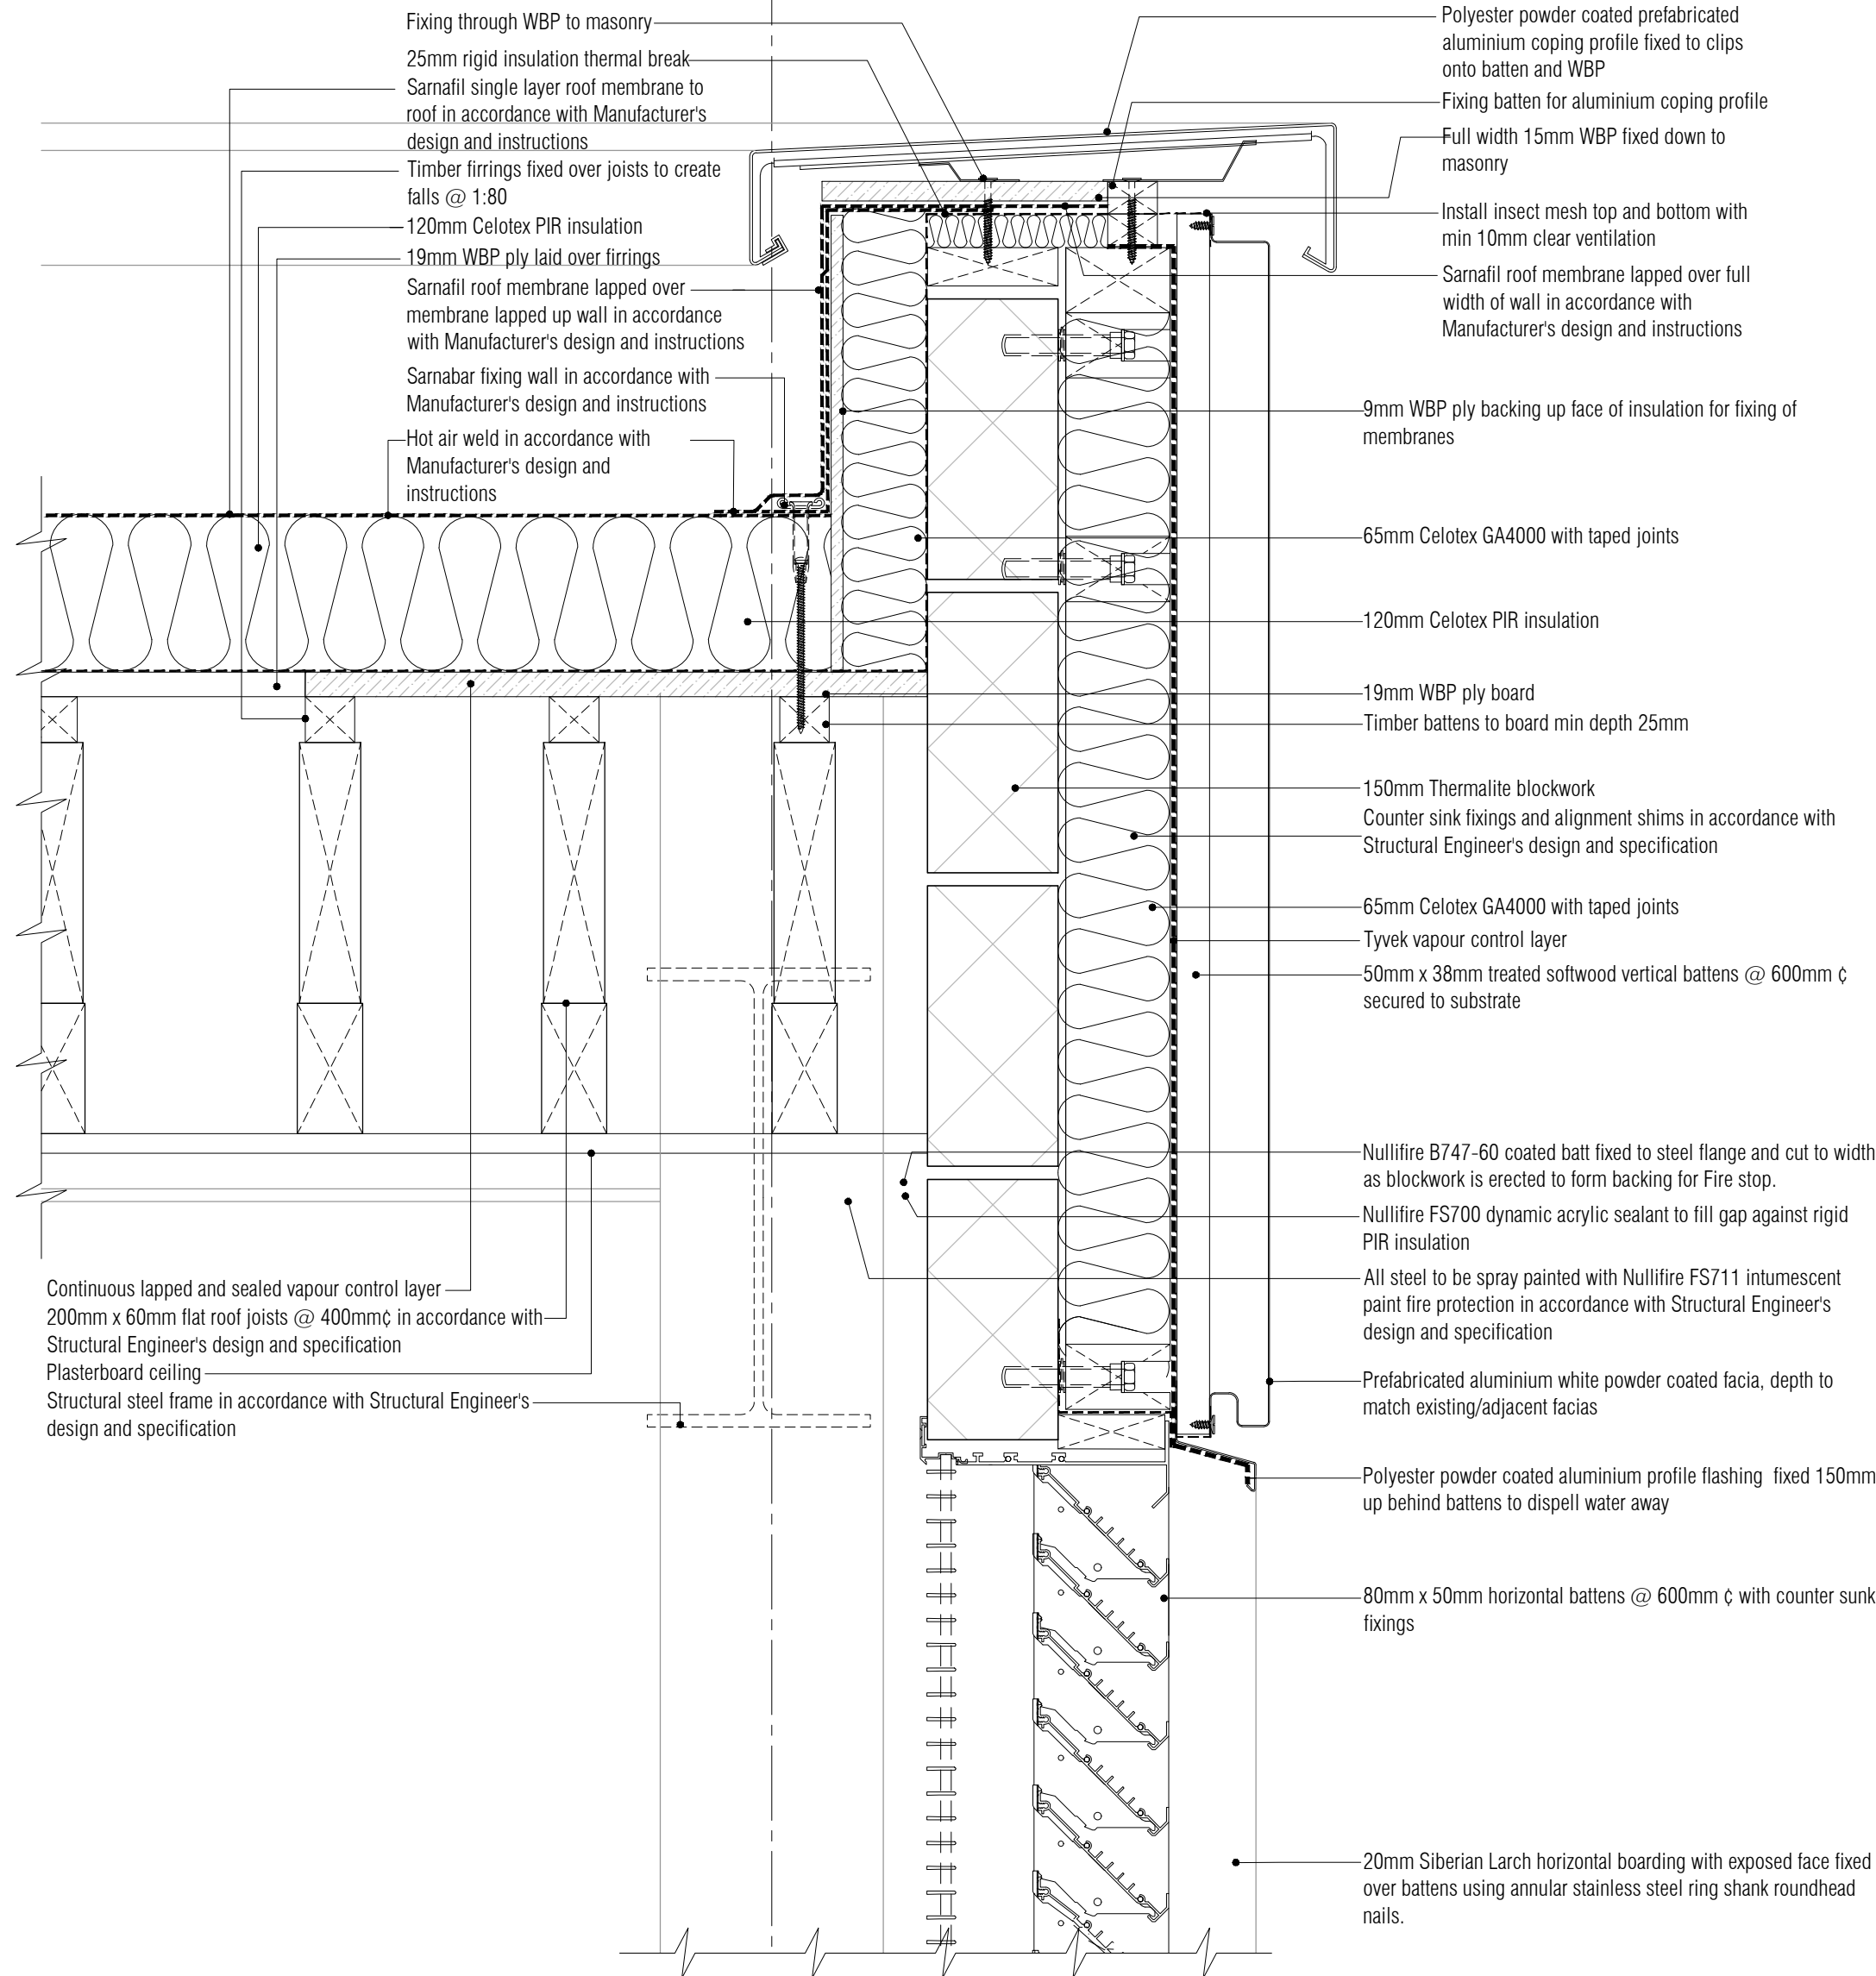

04 Typical Plant Room Wall Roof Interface Detail
Scale: 1:5

NB: All information based on supplied third party survey information.
All discrepancies to be reported to FCG immediately upon discovery.

NOTES: Do not scale this drawing. All dimensions to be checked on site prior to commencement or manufacture.
Key Plan (nts)

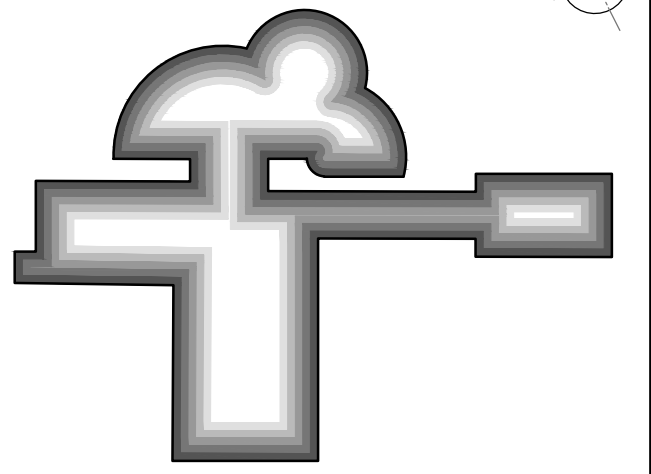

ISSUED FOR CONSTRUCTION

All details referenced in call outs supercede general arrangement or larger depictions.

Rev	Date	By	Chk	Comment
C3	21.06.12	RKC	JAS	Polythene DPM changed to Radon DPM
C2	19.06.12	RKC	JAS	Absence removed. Issued for Construction.
C1	23.04.12	RKC	JAS	Issued for CONSTRUCTION


BRINGING IDEAS TO LIFE

FRANKHAM


Frankham Consultancy Group Limited
21 Perryman Road
Haywards Heath RH16 3TP
t 01444 444000 f 01444 455642
enquiries@frankham.com
www.frankham.com

Client	 Contract N°: Worthing		
Project Title	Eastbourne & Worthing Crematoria Refurbishments and Alterations		
Drawing Title	 Worthing Crematorium Detail		
Drawn by: RKC	Scale: 1:5@A1	Date: 05.03.12	
Designed by: FCG	Checked by: JAS	Approved by: AC	
File Ref.: 301360-A-425-W-0001 - 200811120001 20.06.11 12.20.04			
Drawing No. 521260-A-425-W			Rev. C3


All Disabled and Ambulant Disabled facilities to comply with Approved Document Part M -
Access to and use of buildings*, Disability Discrimination Act 1995 and BS83000 as required

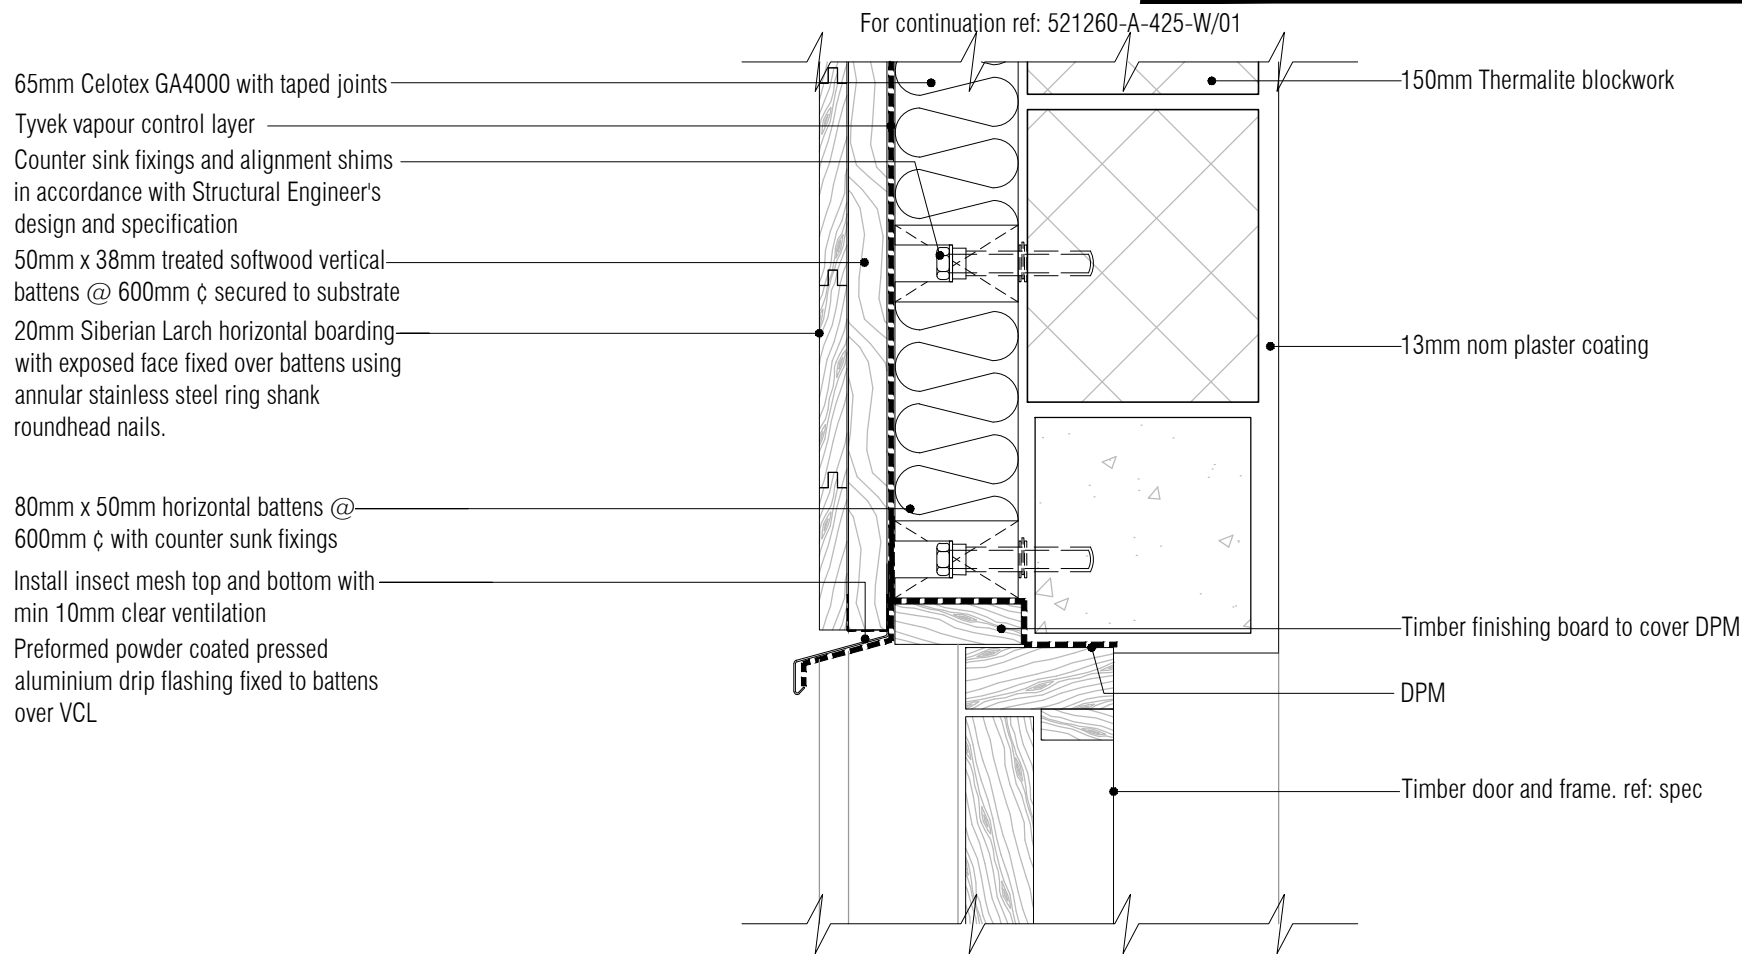


01 Typical Door Head Detail
Scale: 1:5

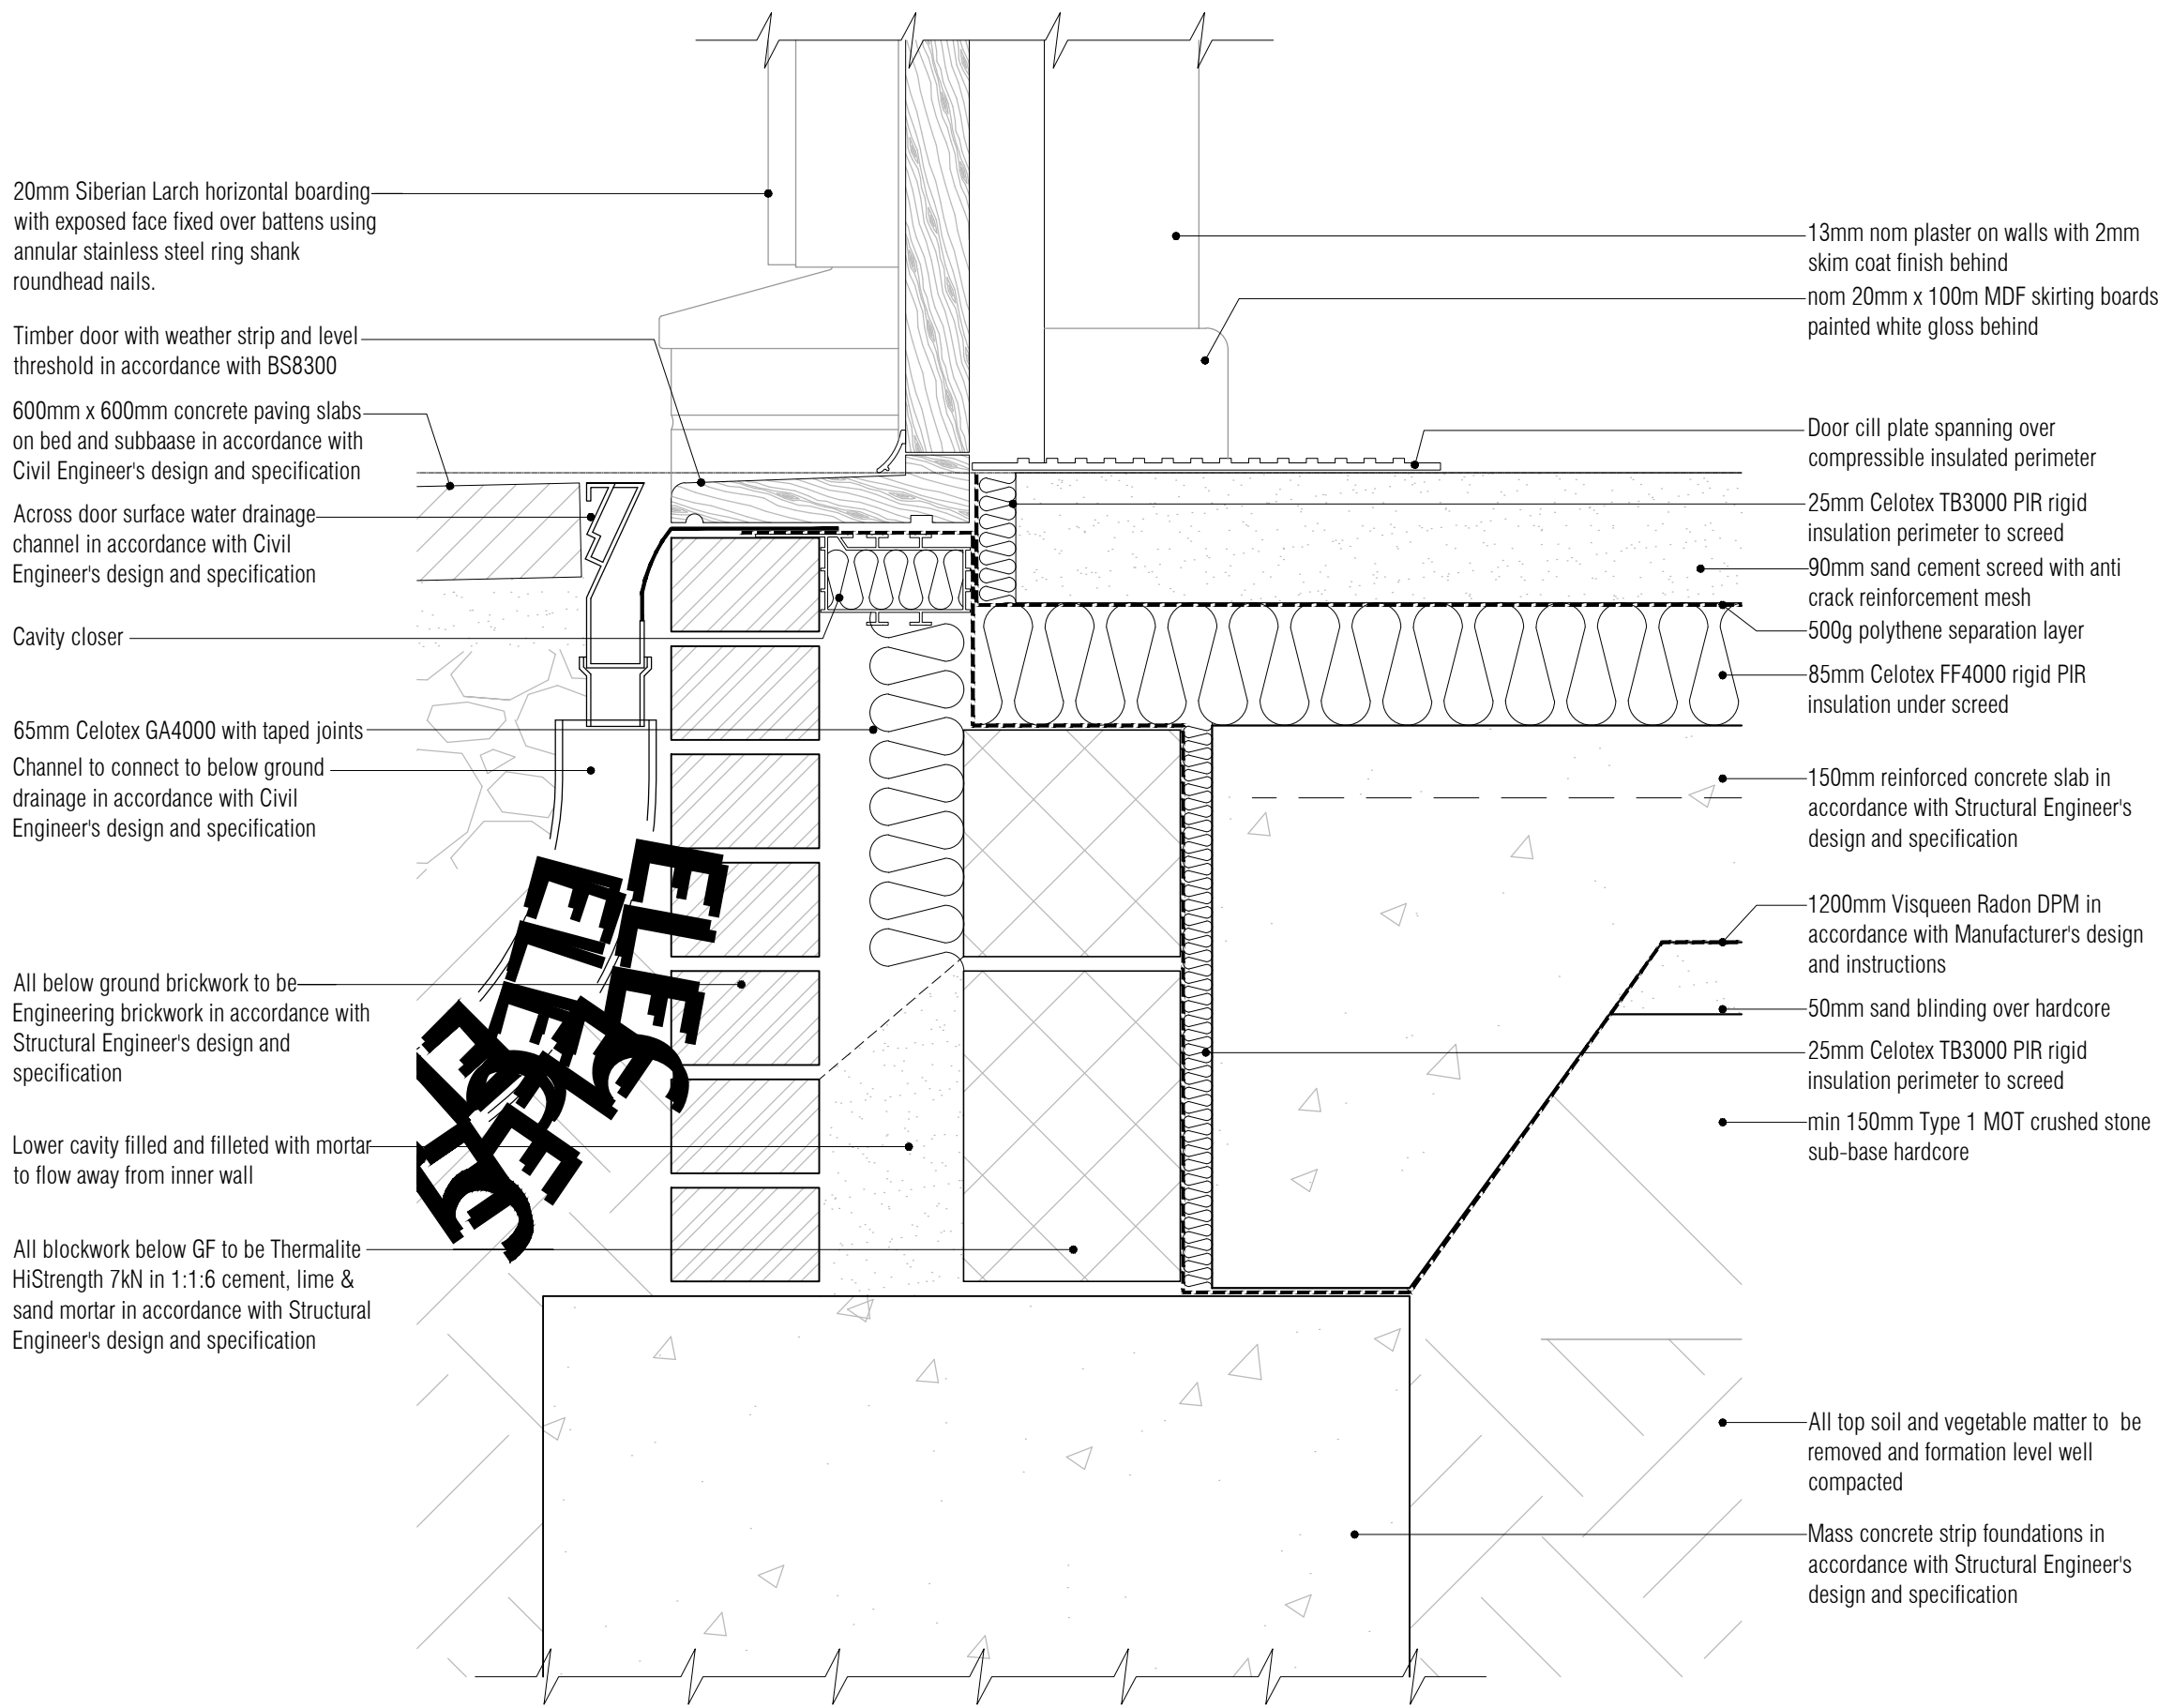


02 Typical Level Threshold Door Cill Detail
Scale: 1:5

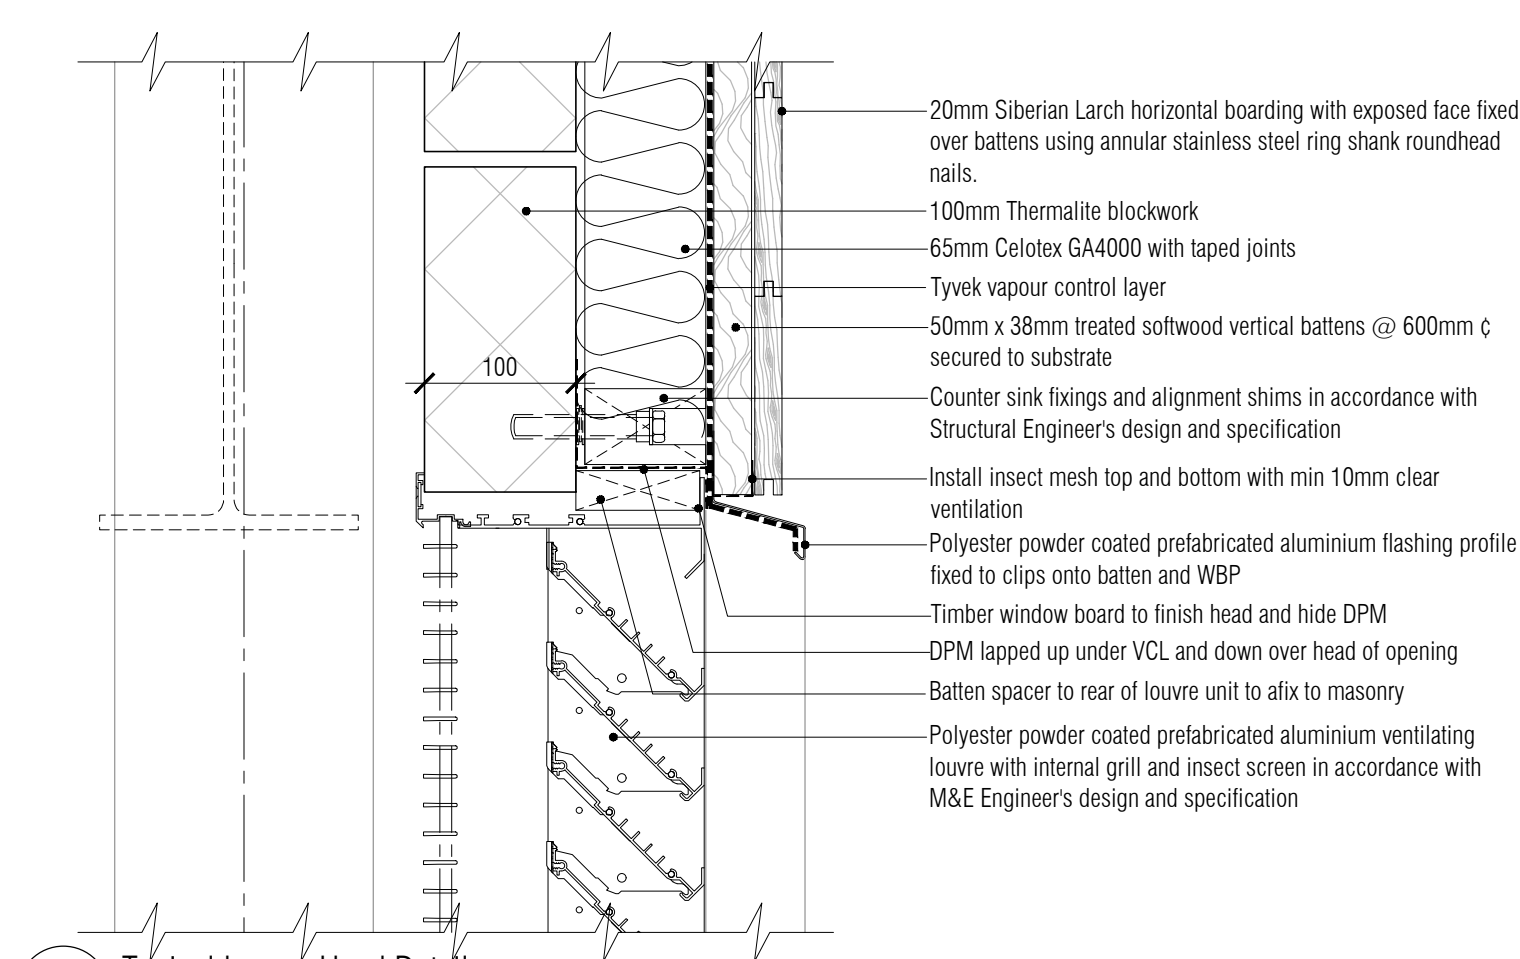

03 Typical Louvre Head Detail
Scale: 1:5

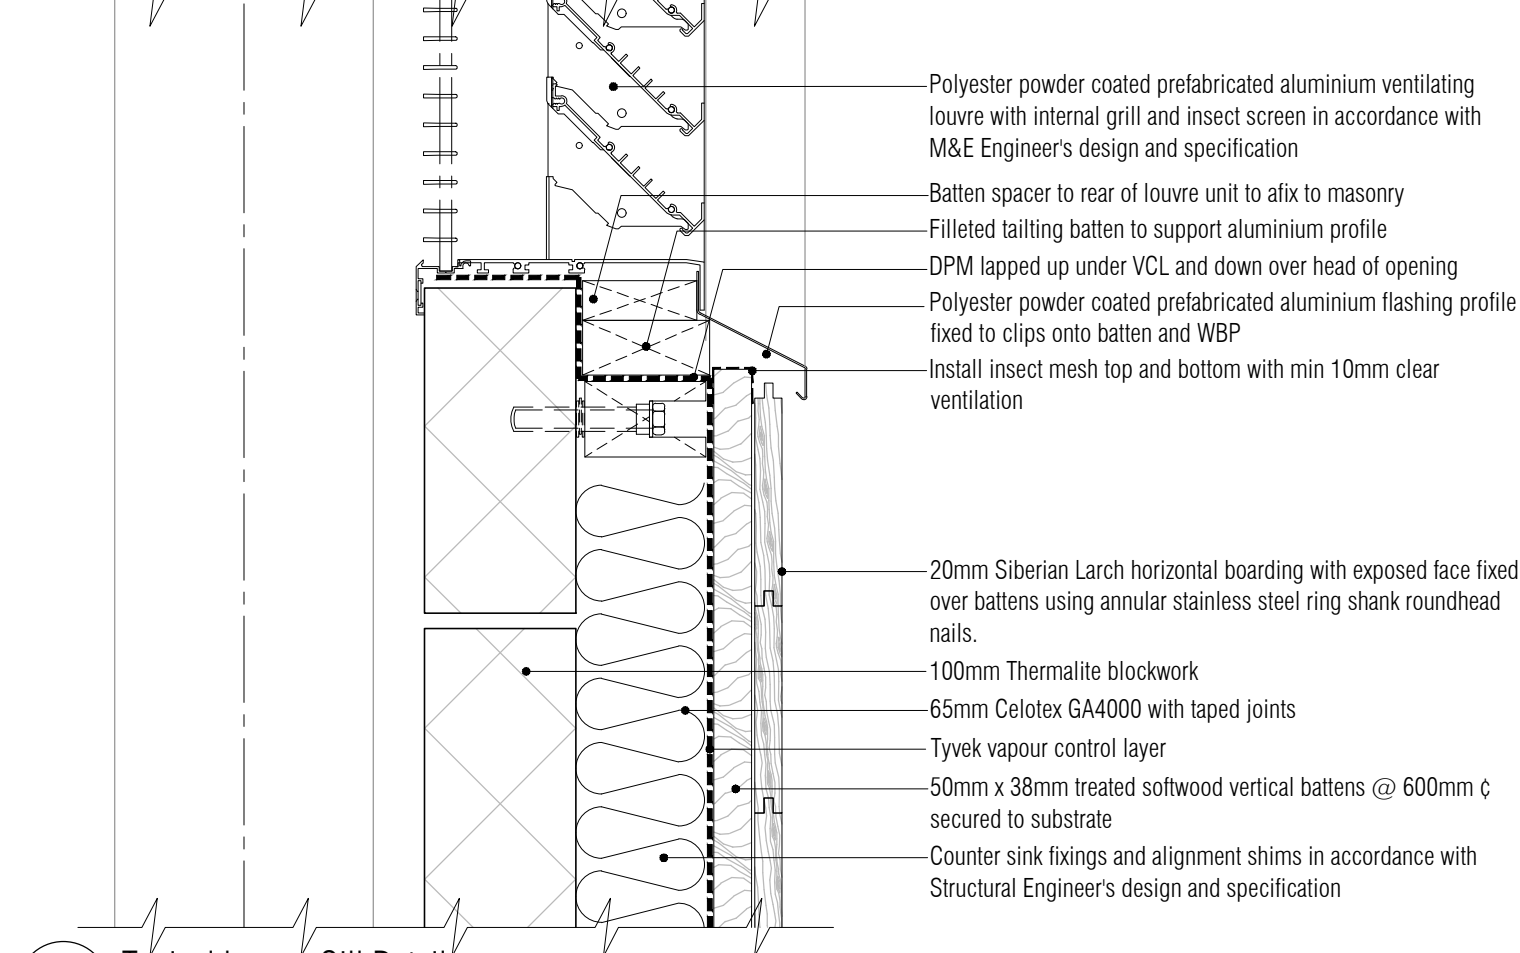


04 Typical Louvre Cill Detail
Scale: 1:5

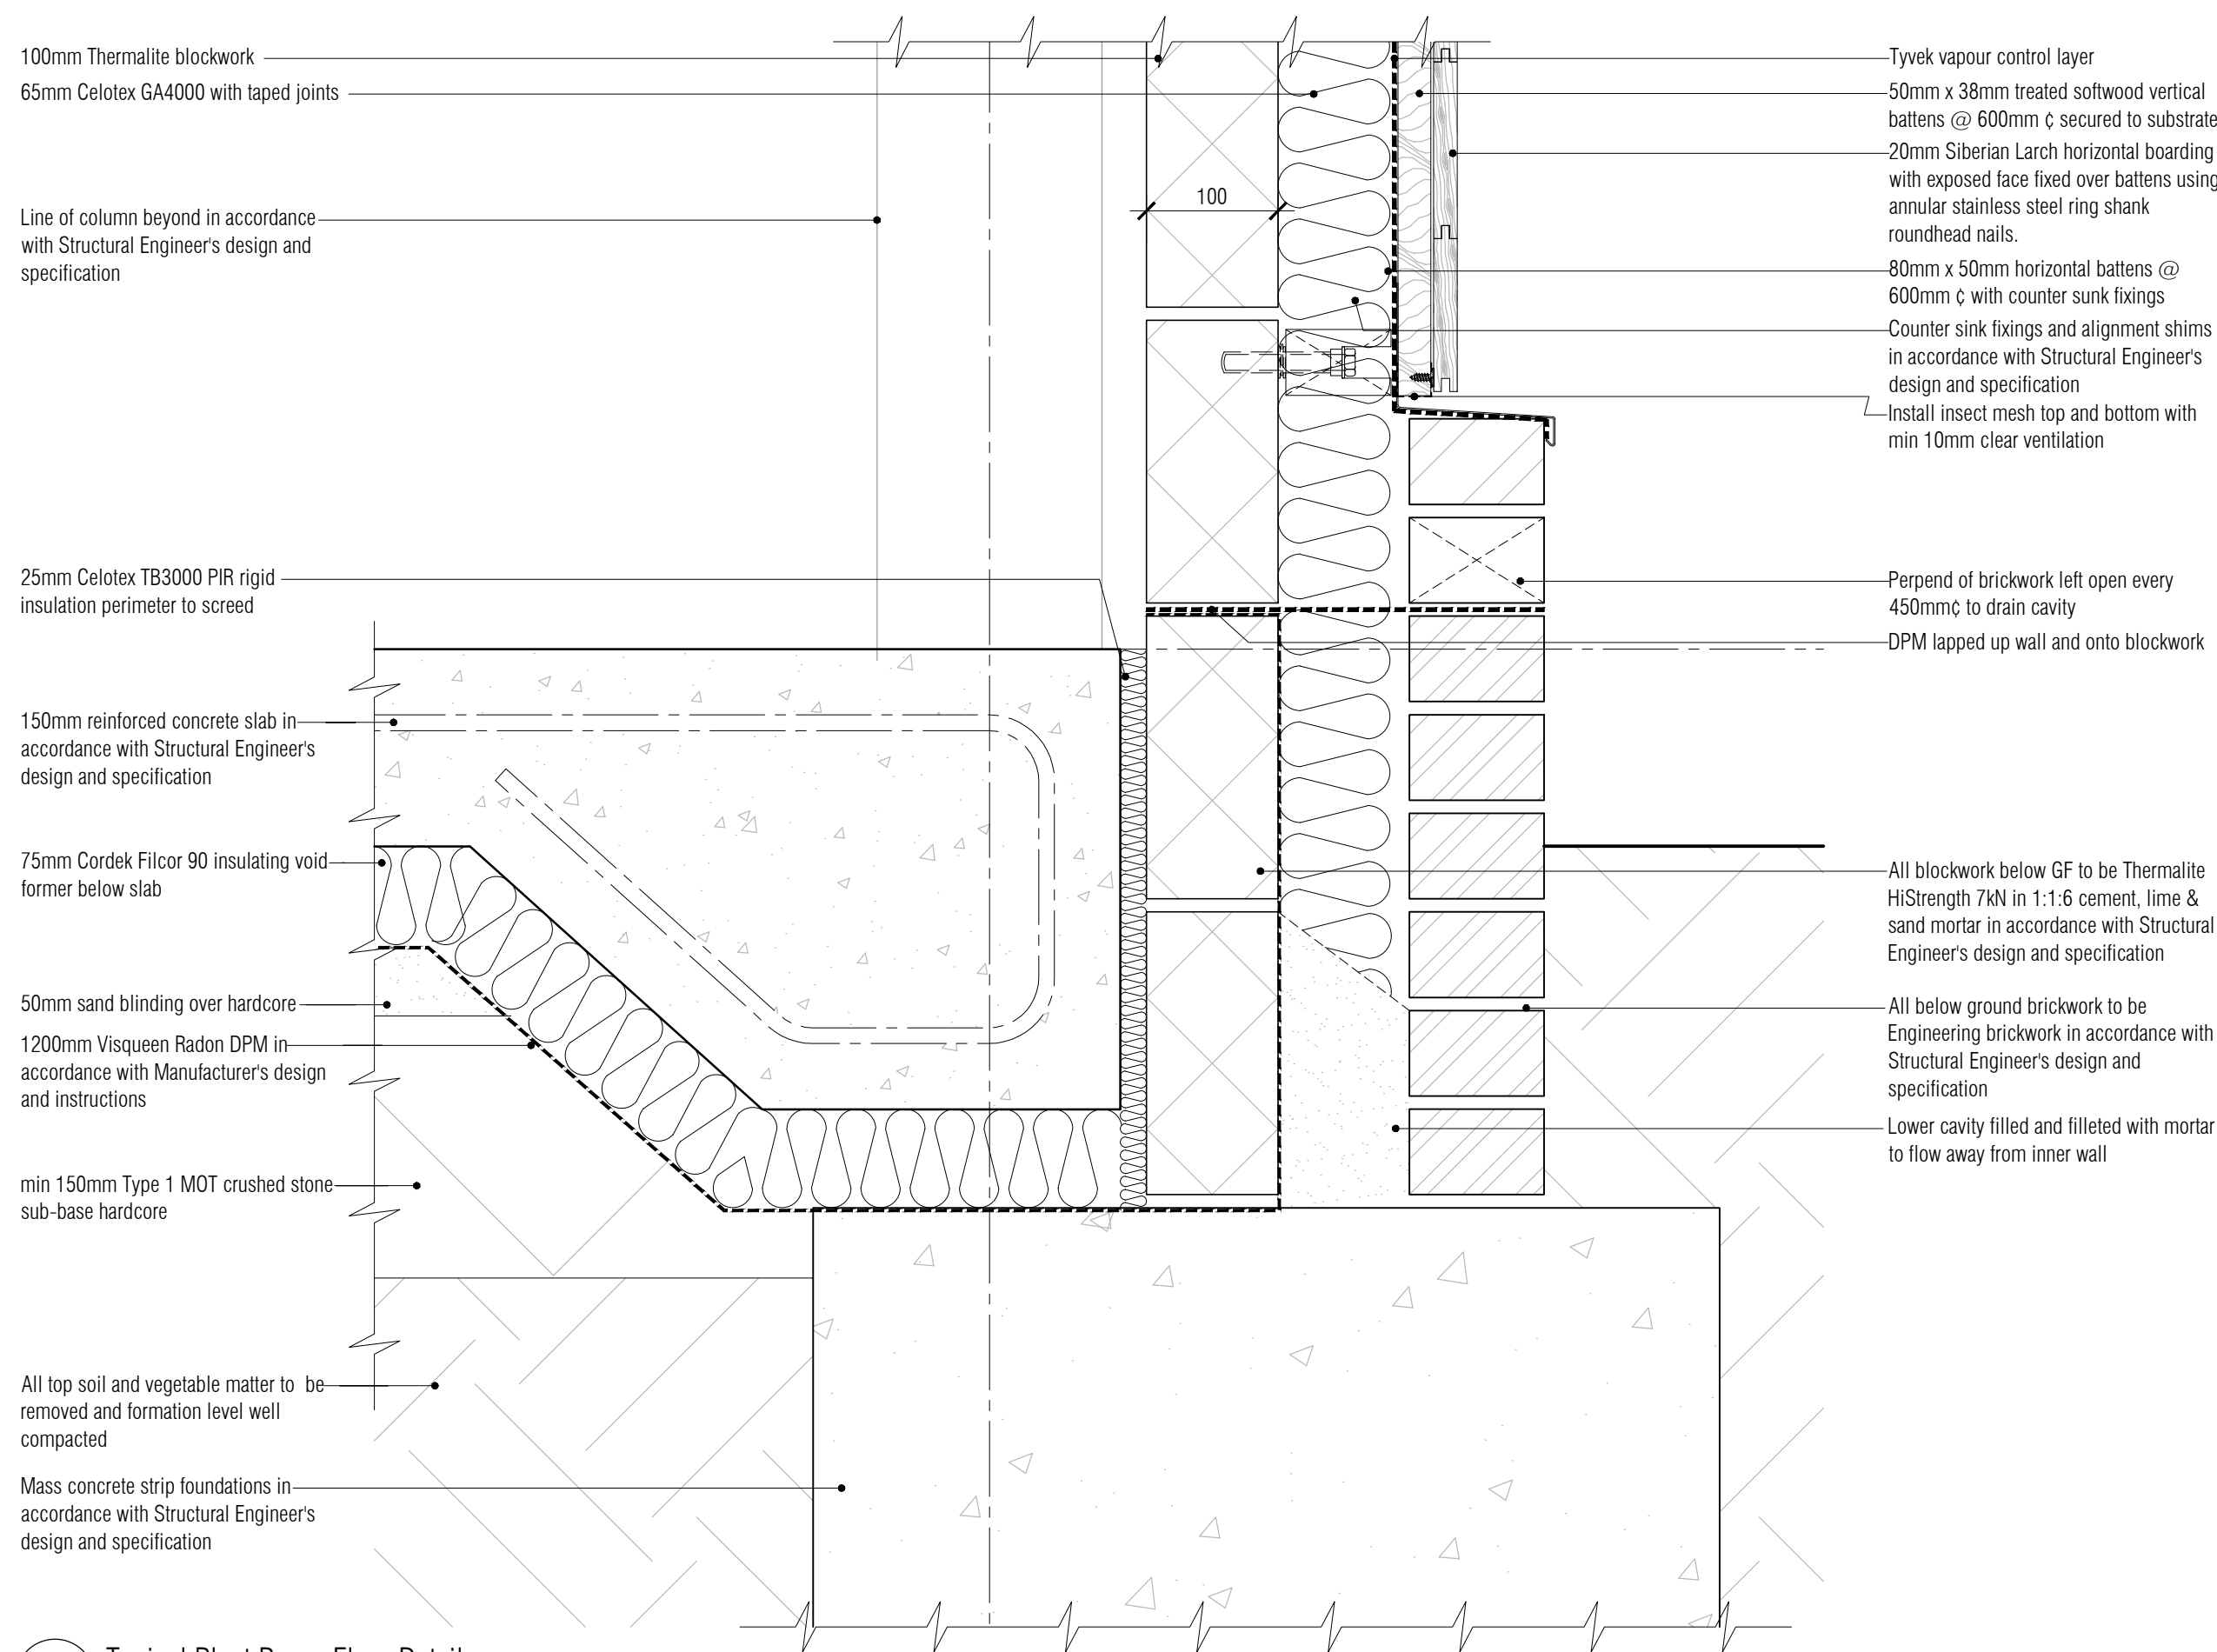

05 Typical Plant Room Floor Detail
Scale: 1:5

NOTES: Do not scale this drawing. All dimensions to be checked on site prior to commencement or manufacture.
Key Plan (nts)

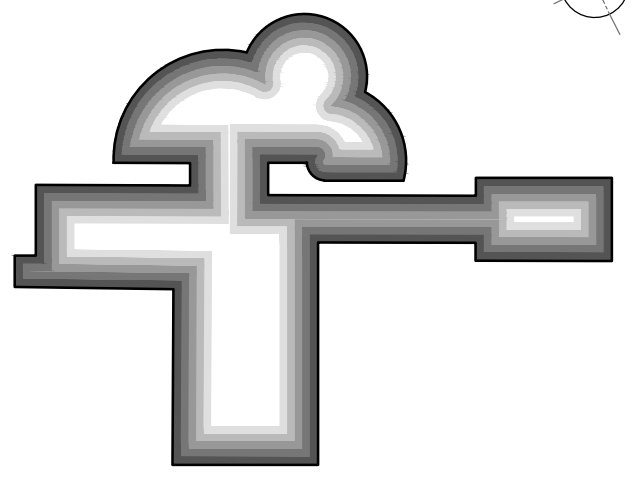

ISSUED FOR
CONSTRUCTION

All details referenced in call outs supersede general arrangement or larger depictions.

Rev	Date	By	Chk	Comment
C2	09.07.12	RKC	JAS	Issued for Construction
P5	21.06.12	RKC	JAS	Polythene DPM changed to Radon DPM
P4	01.06.12	RKC	JAS	Issued for Stage F
P3	18.05.12	RKC	JAS	Details rev'd per CC3
C1	23.04.12	RKC	JAS	Issued for CONSTRUCTION

BRINGING IDEAS TO LIFE



FRANKHAM

Frankham Consultancy Group Limited
21 Perrymount Road
Haywards Heath RH16 3TP
t 01444 444900 f 01444 455642
enquire@frankham.com
www.frankham.com

Client
Mansell
Contract N°: Worthing

Project Title
Eastbourne & Worthing
Crematoria
Refurbishments and Alterations


Drawing Title
Worthing
Worthing Crematorium
Detail

Drawn by: RKC	Scale: 1:5@A1	Date: 08.03.12
Designed by: FCG	Checked by: JAS	Approved by: AC

File Ref.: X:\FRANKHAM\2-080512180 CREMATORIA\WORKHOUSE 400 DETAIL COORDINATES
20.06.11 12:20:11


Drawing No. 521260-A-426-W	Rev. C2
-------------------------------	------------

NB: All information based on supplied third party survey information.
All discrepancies to be reported to FCG immediately upon discovery.

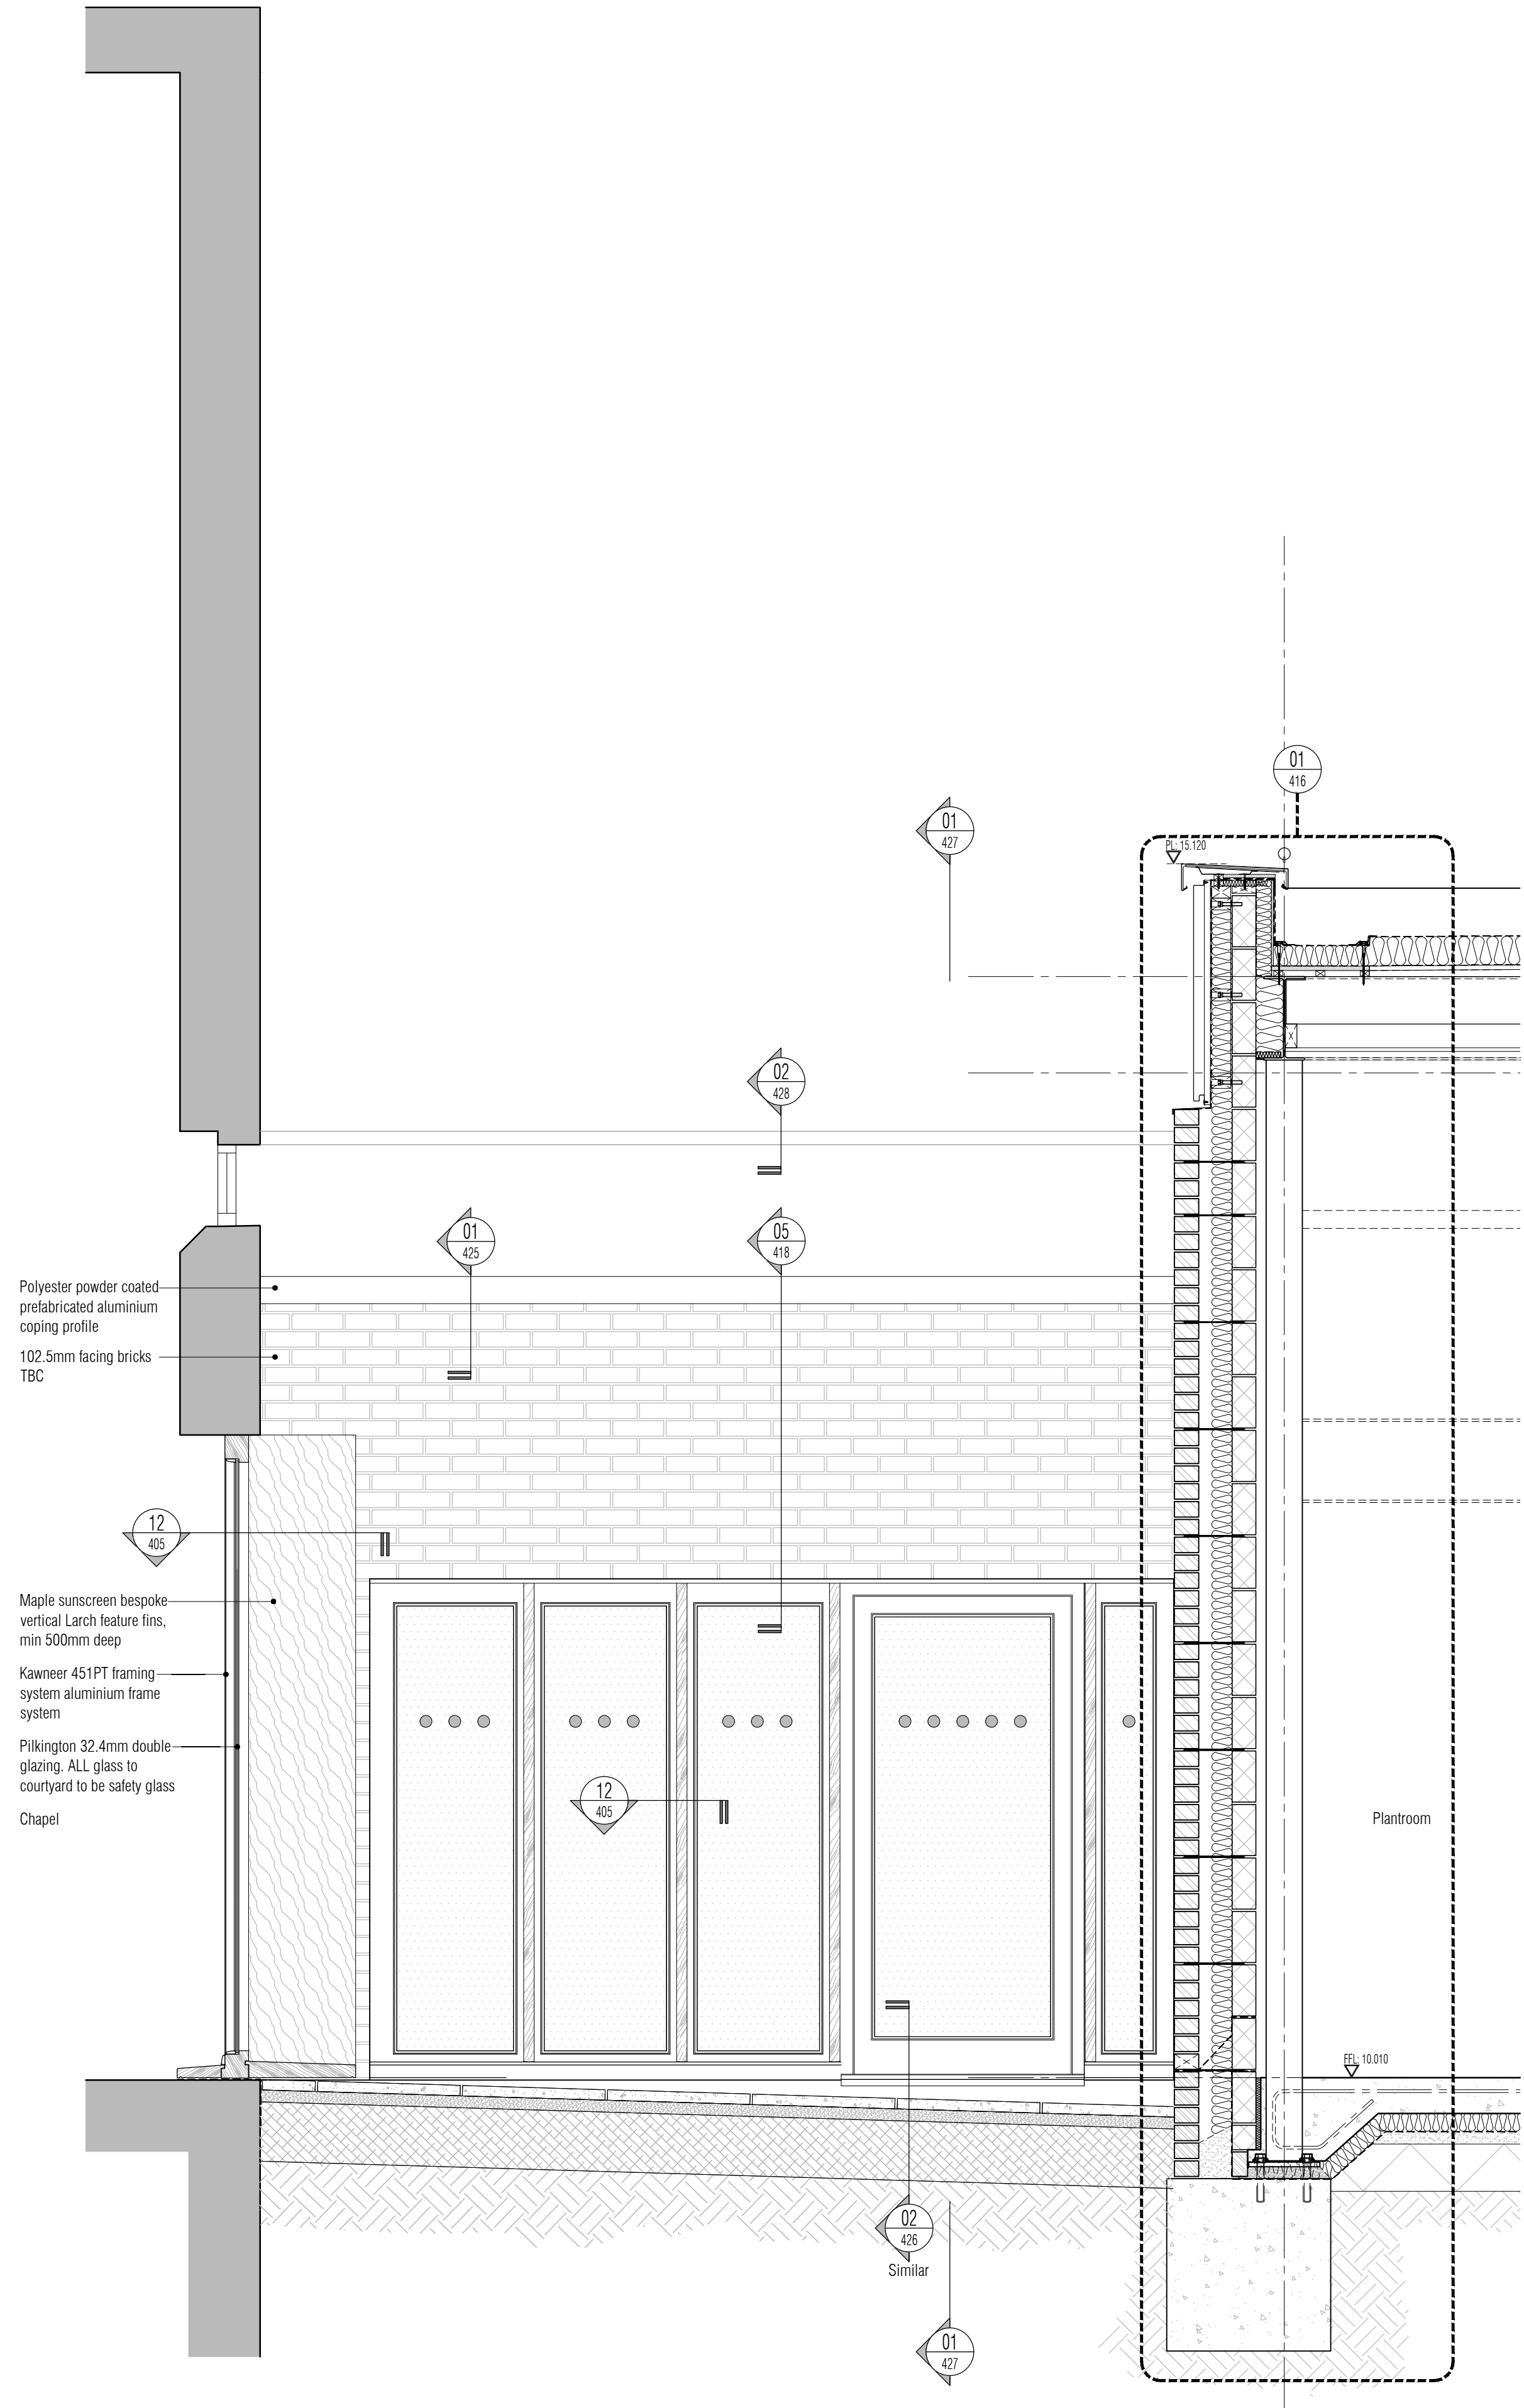


01 Family Room Glazed Screen Elevation
Scale: 1:20

NB: All information based on supplied third party survey information.
All discrepancies to be reported to FCG immediately upon discovery.

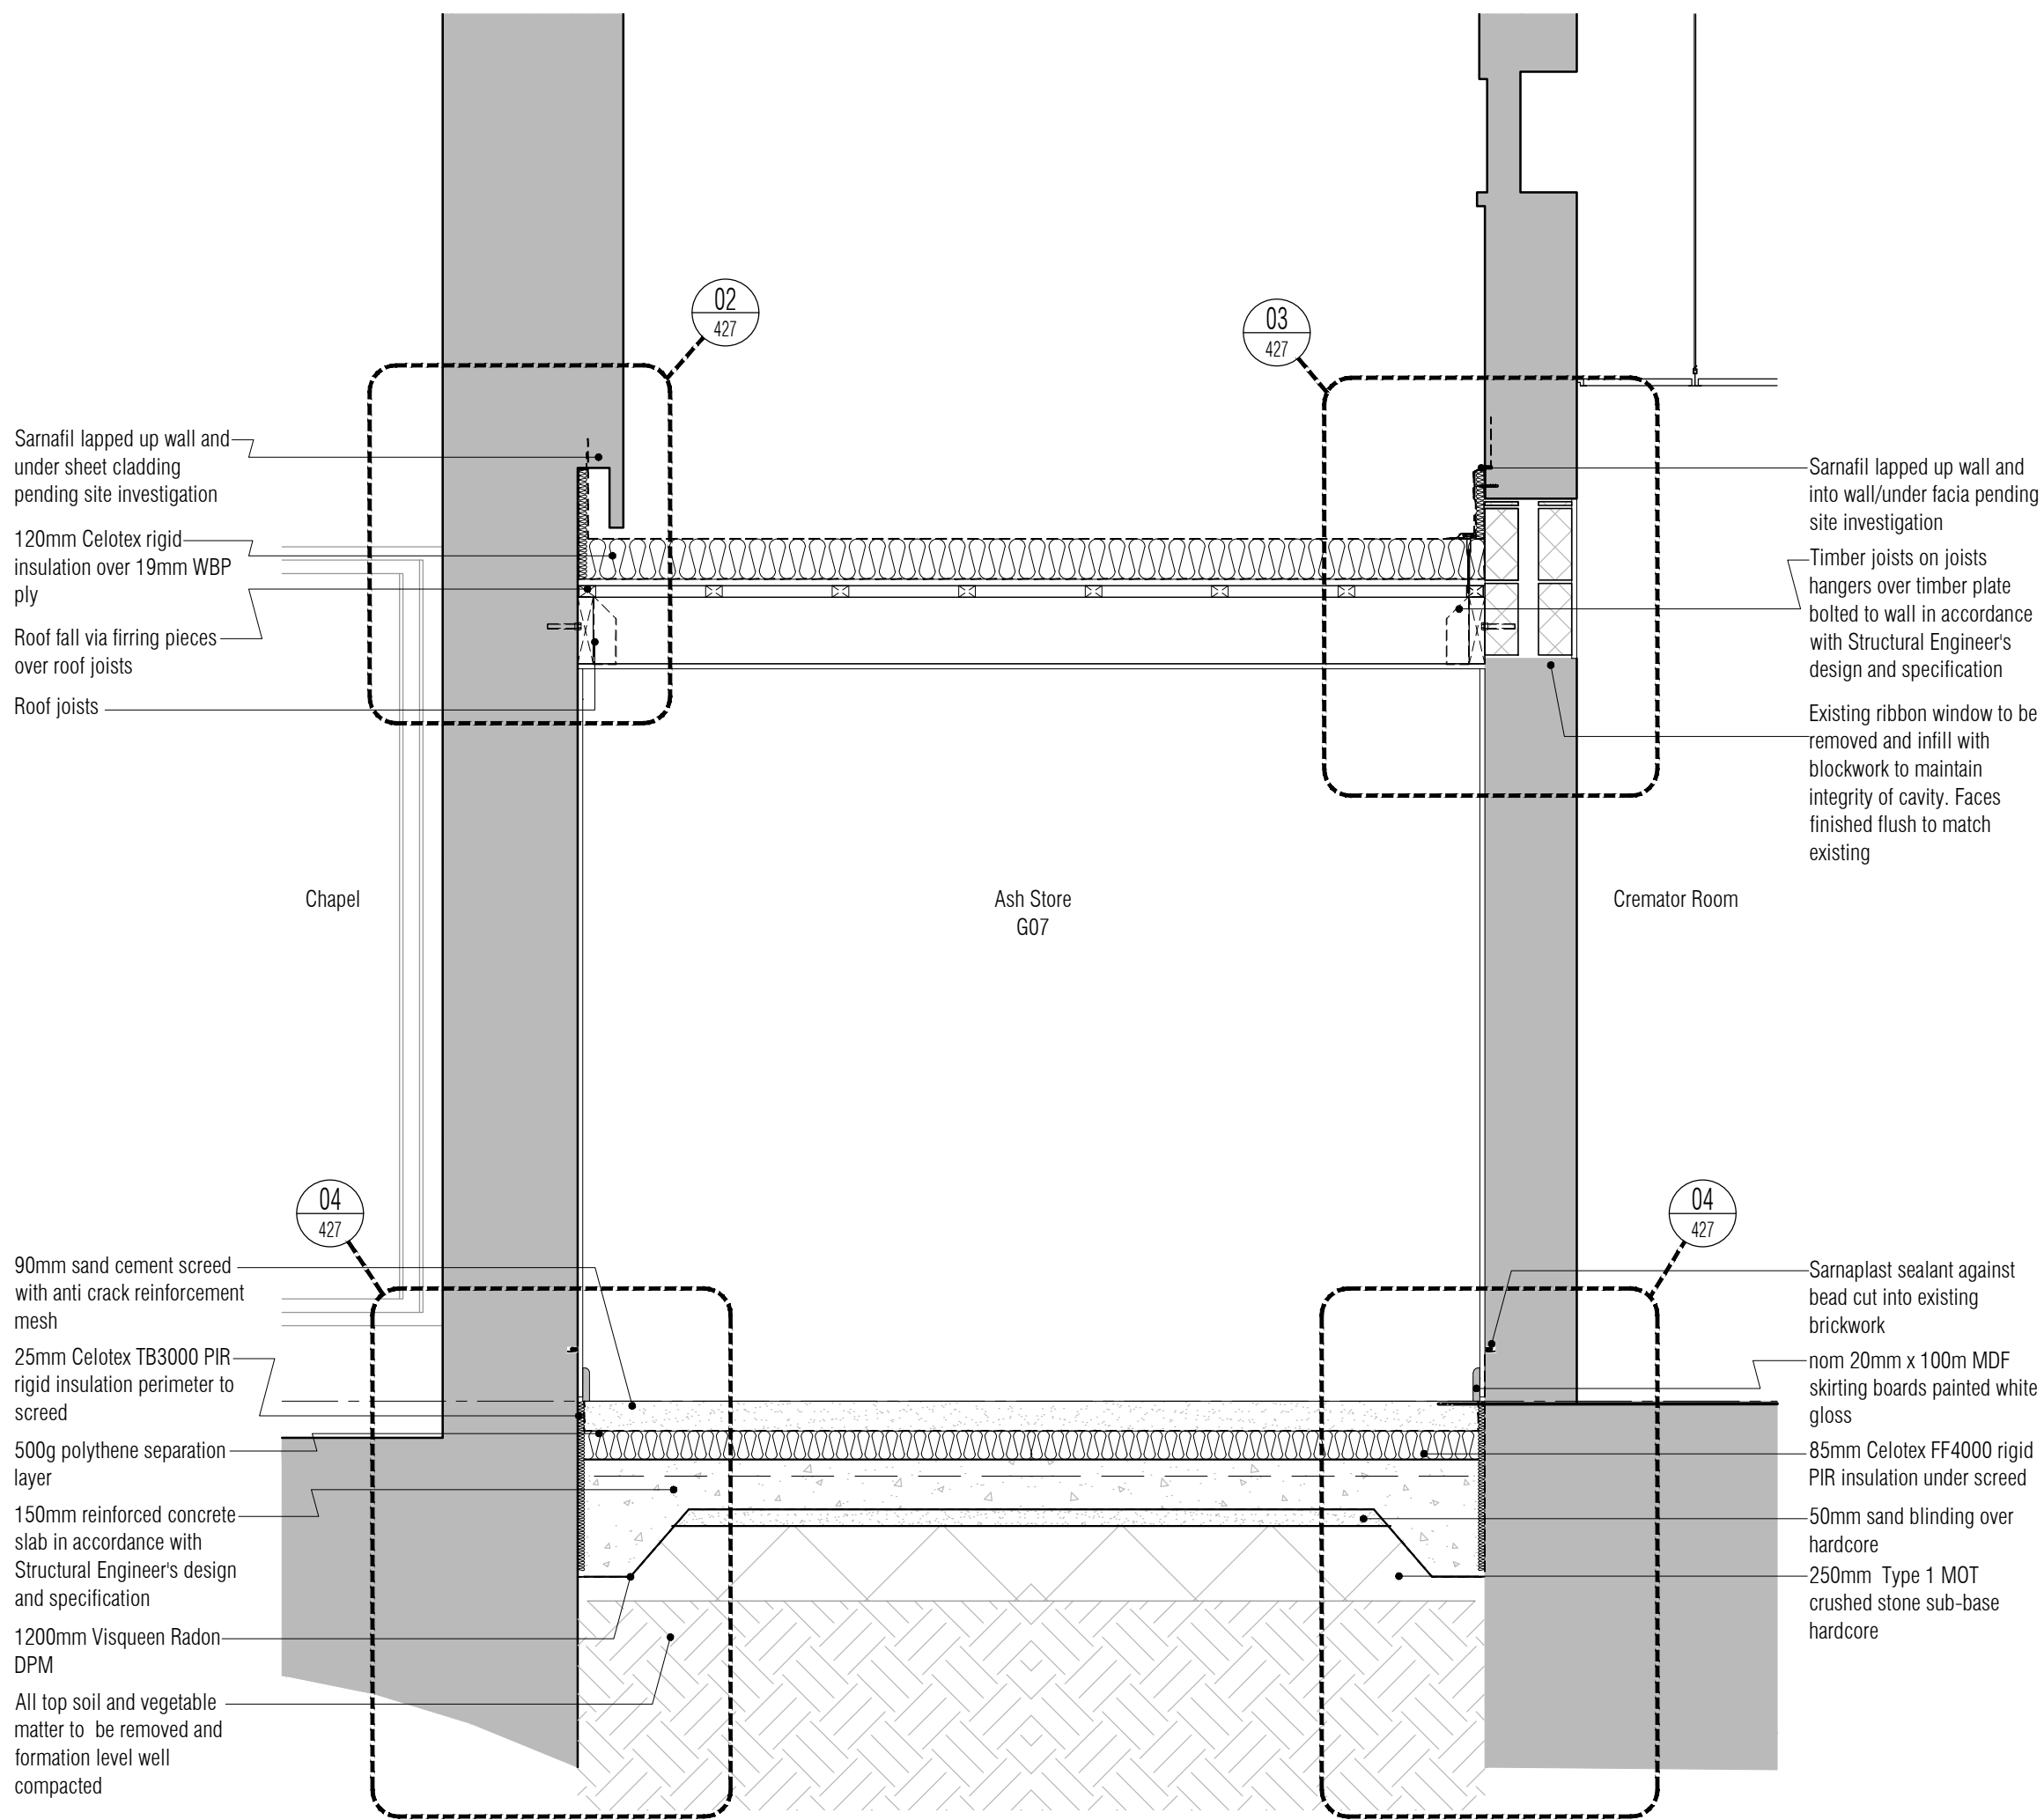


03 Ash Store Extension Section
Scale: 1:20

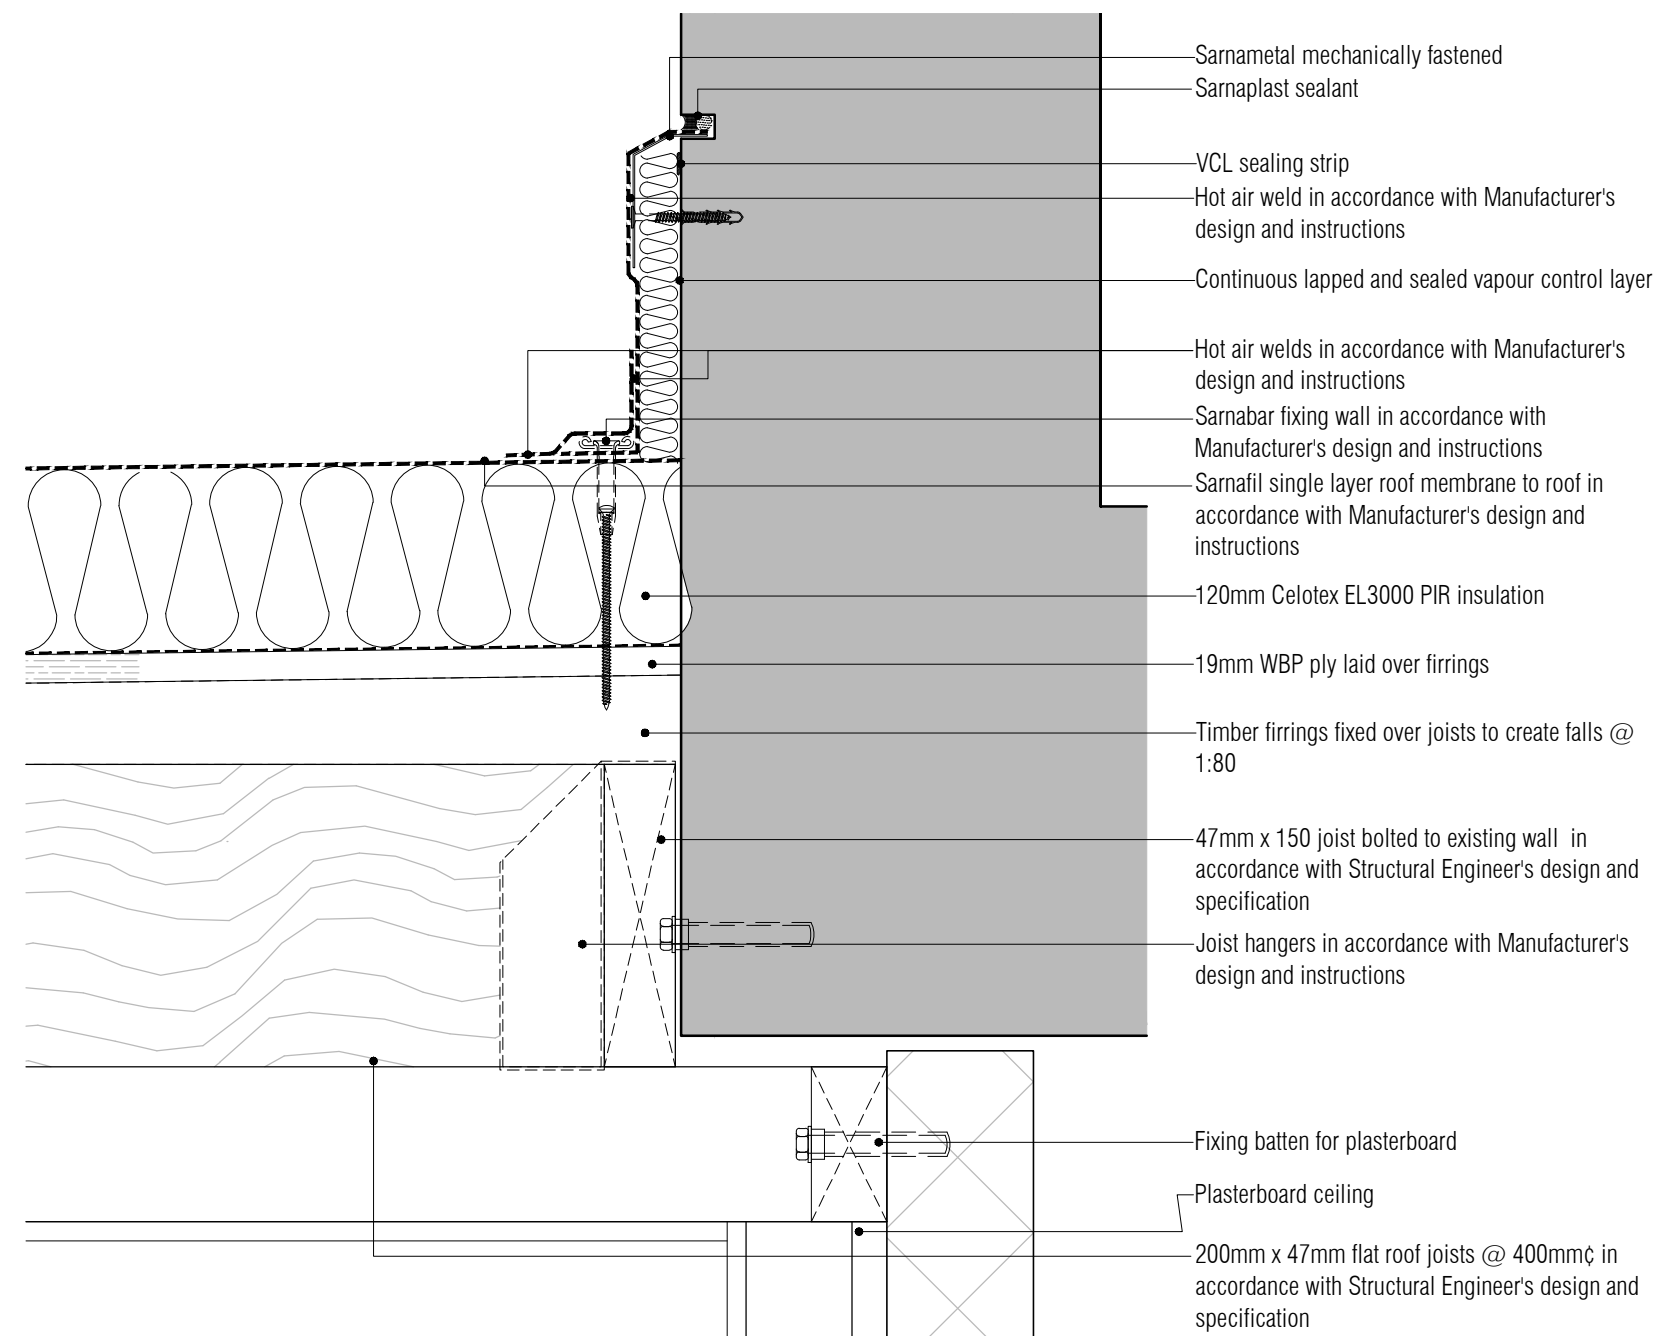

02 Family Room Extension Roof Abutment Detail
Scale: 1:5

NOTES: Do not scale this drawing. All dimensions to be checked on site prior to commencement or manufacture.
Key Plan (nts)

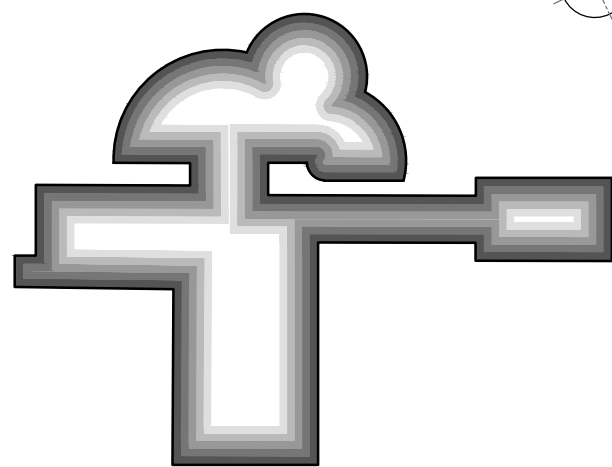

ISSUED FOR CONSTRUCTION

All details referenced in call outs supercede general arrangement or larger depictions.

Rev	Date	By	Chk	Comment
C3	20.08.12	RKC	JAS	Roof revd
C2	09.07.12	RKC	JAS	Issued for Construction
P2	21.06.12	RKC	JAS	Polythene DPM changed to Radon DPM
P1	01.06.12	RKC	JAS	Issued for Stage F

BRINGING IDEAS TO LIFE



FRANKHAM

Frankham Consultancy Group Limited
21 Perryman Road
Haywards Heath RH16 3TP
t 01444 444900 f 01444 455642
enquiry@frankham.com
www.frankham.com

Client
Mansell
Contract N°: Worthing






Project Title
Eastbourne & Worthing
Crematoria
Refurbishments and Alterations

Drawing Title
Worthing
Worthing Crematorium
Courtyard Glazed Family Room Screen
and Ash Store Section and Details


Drawn by: RKC	Scale: 1:20, 5@A1	Date: 29.05.12
Designed by: FCG	Checked by: JAS	Approved by: AC

File Ref.: X:\FRANKHAM\2_080512180 CREMATORIA\WORK\449 449 DETAIL COORDINATES
307360-A-428-W-046 - 200611120020 20.06.11 12.20.24

Drawing No. 521260-A-428-W	Rev. C3
-------------------------------	------------

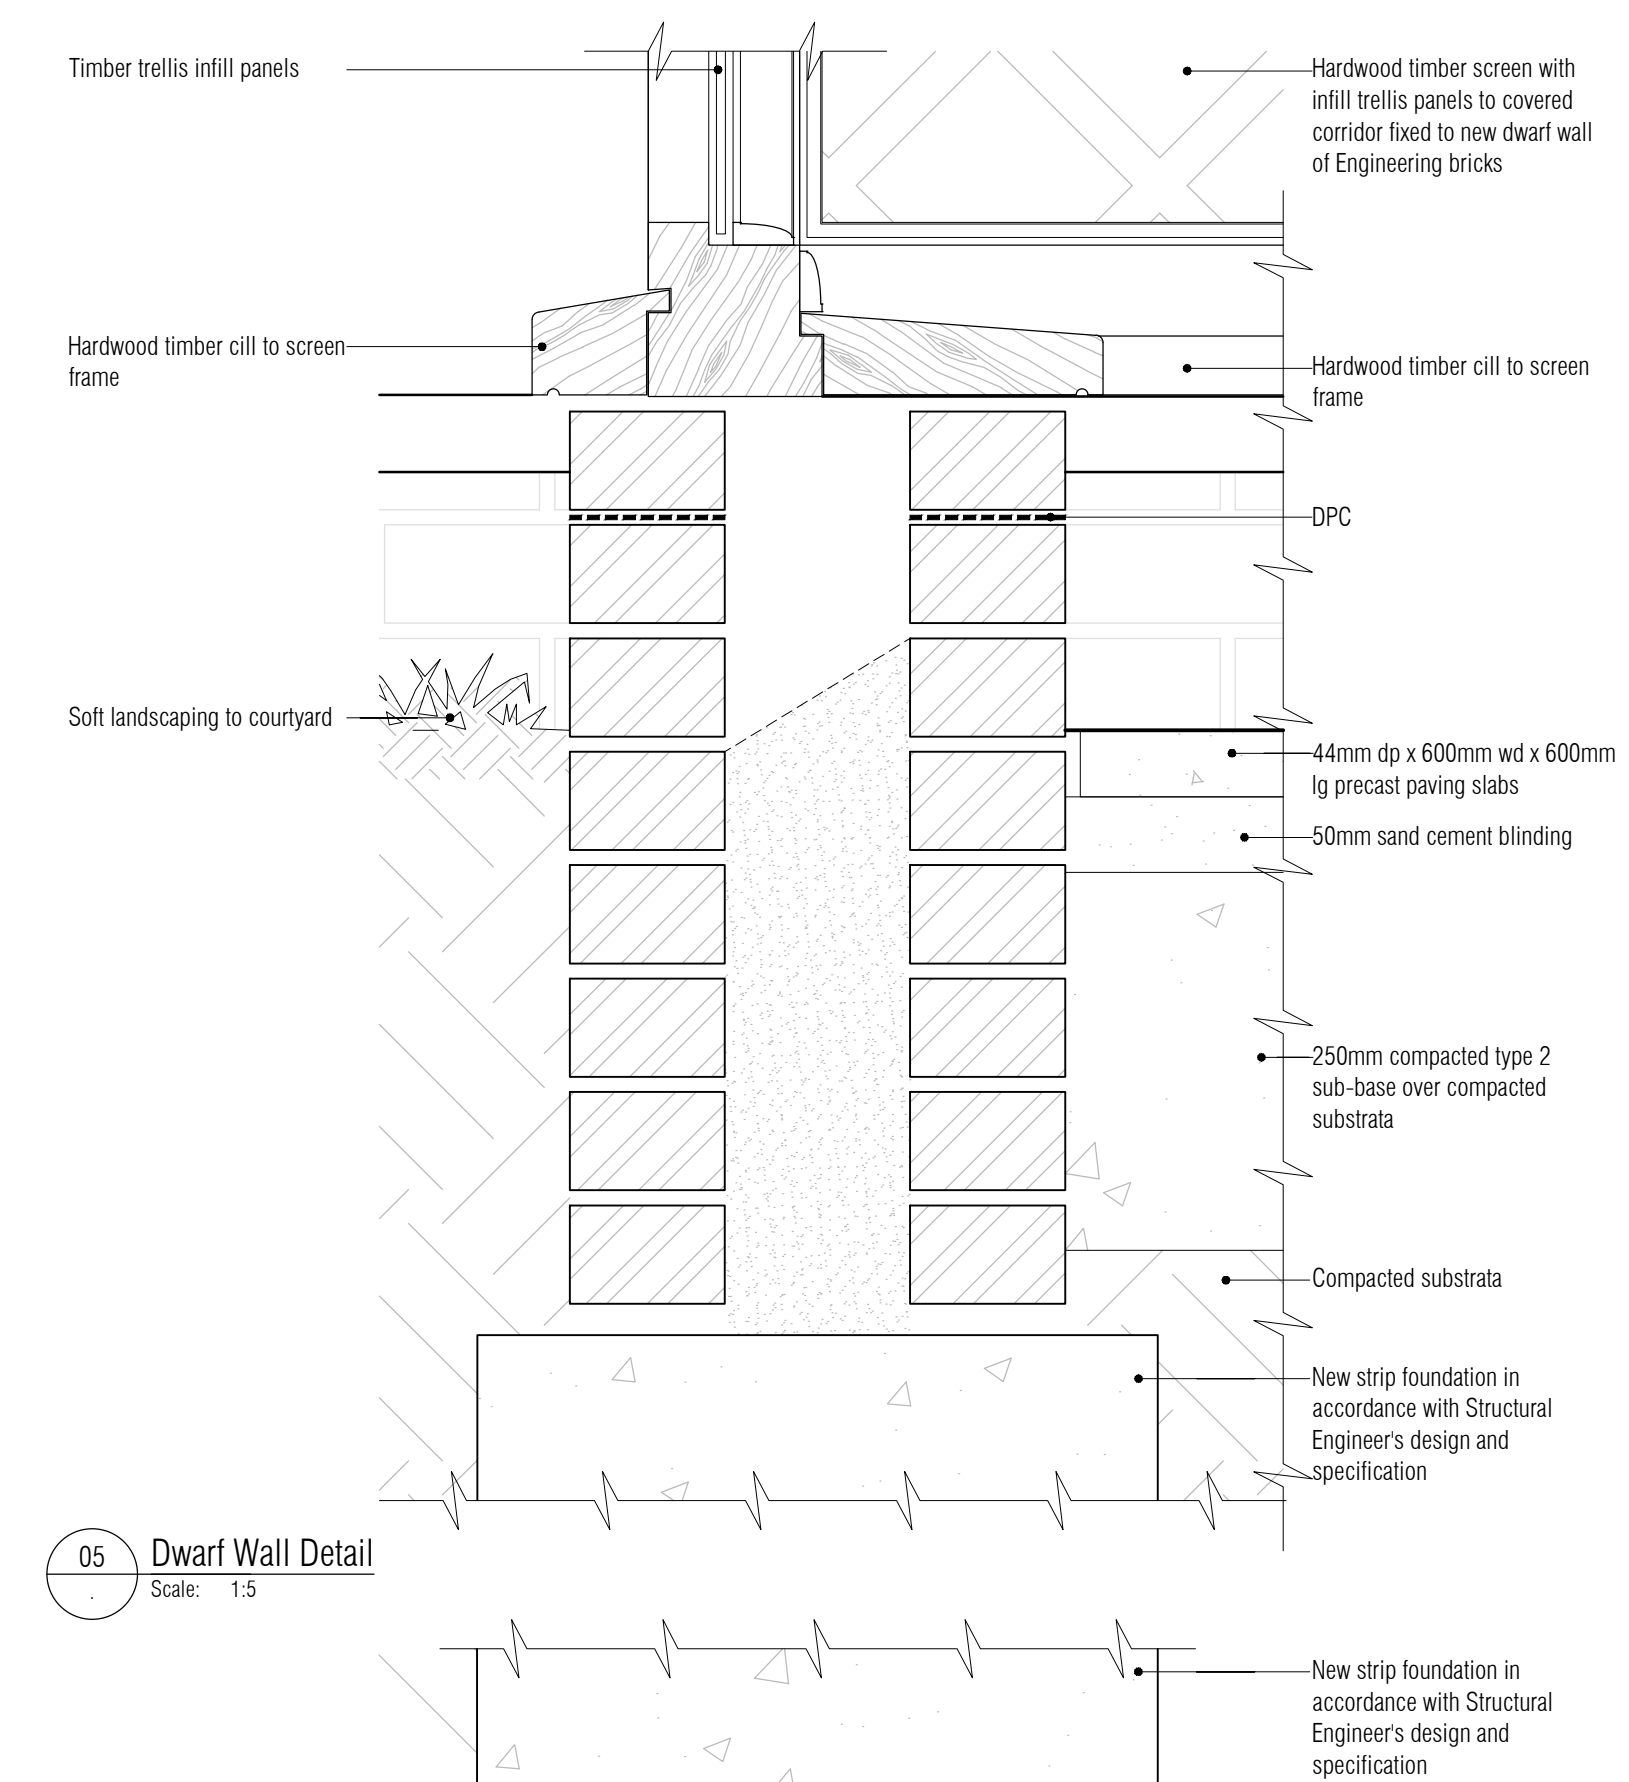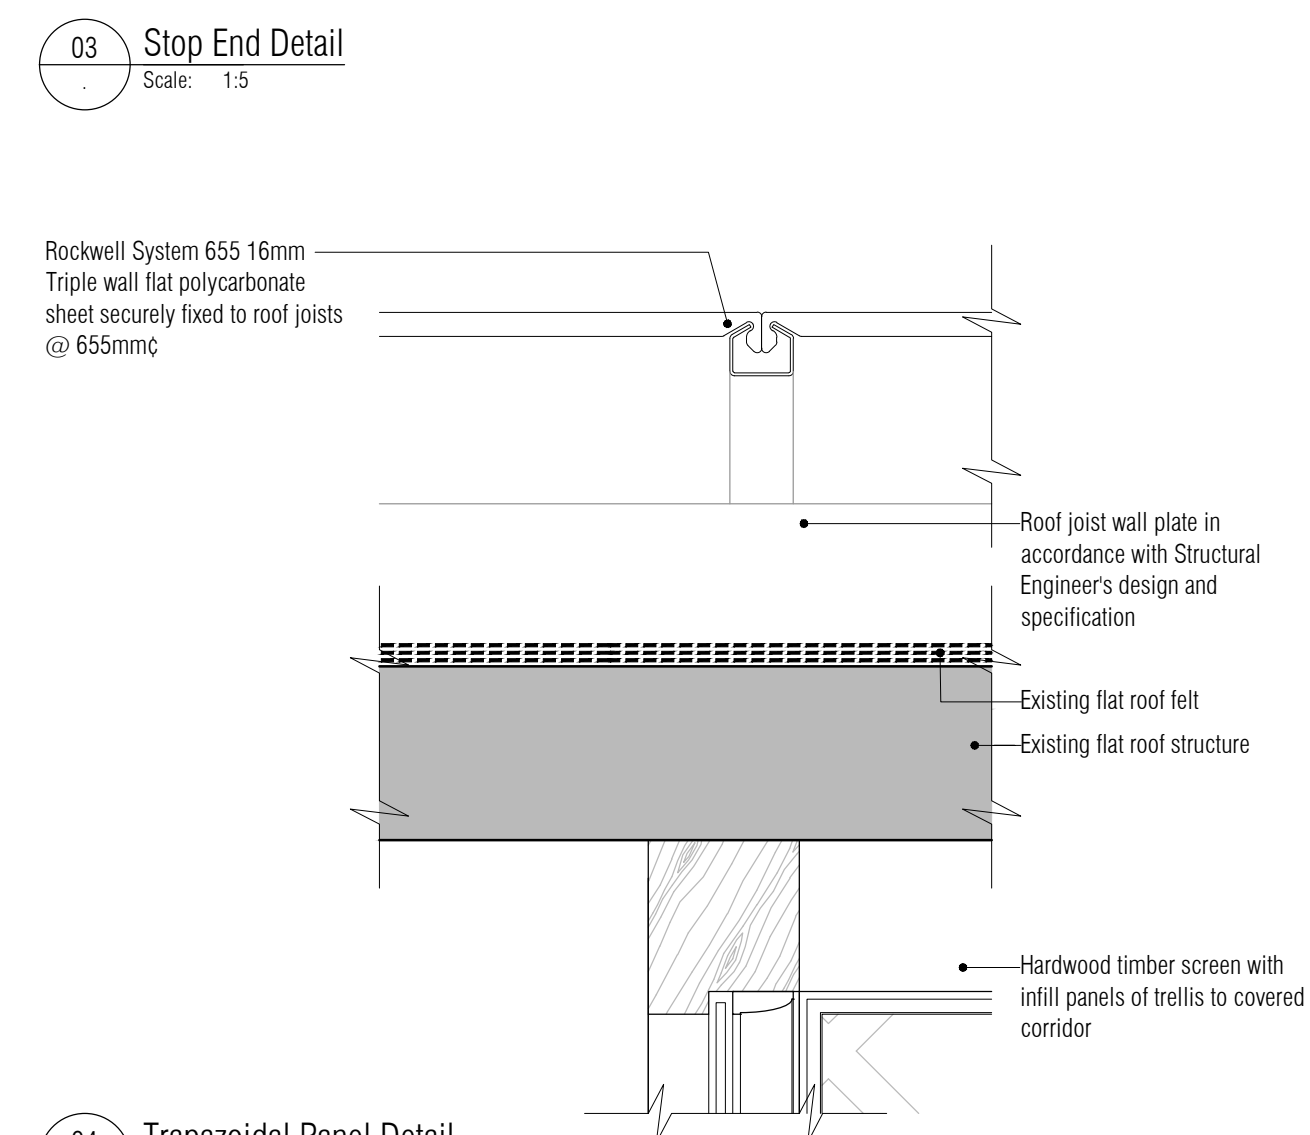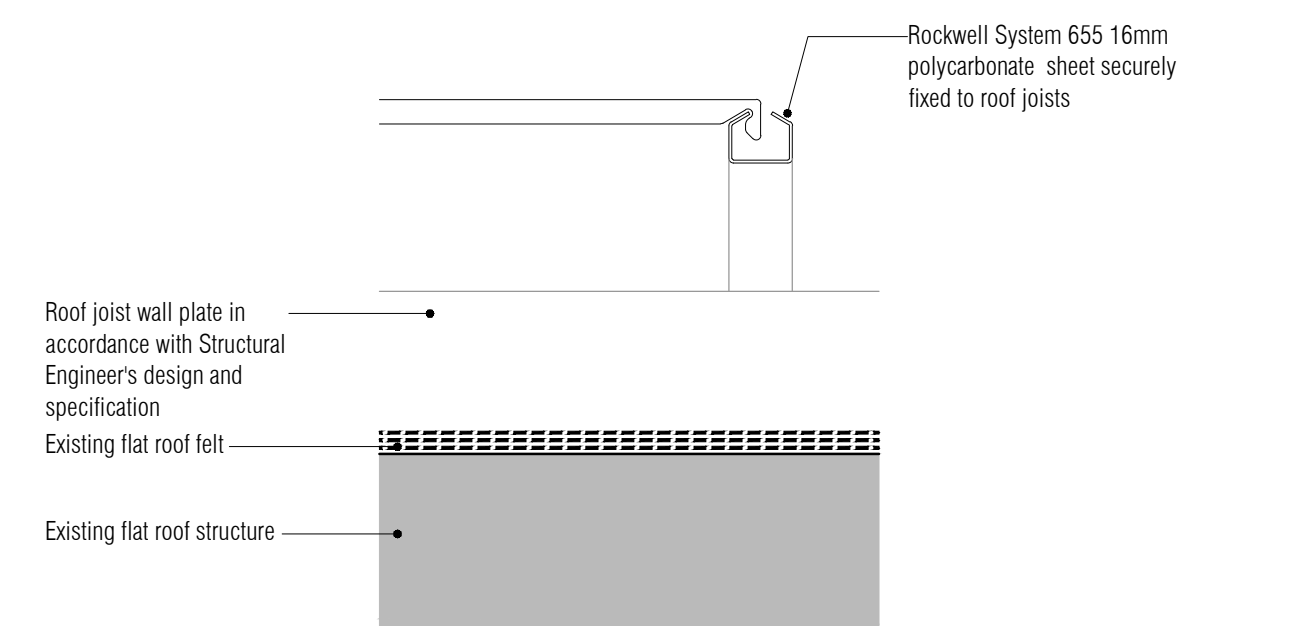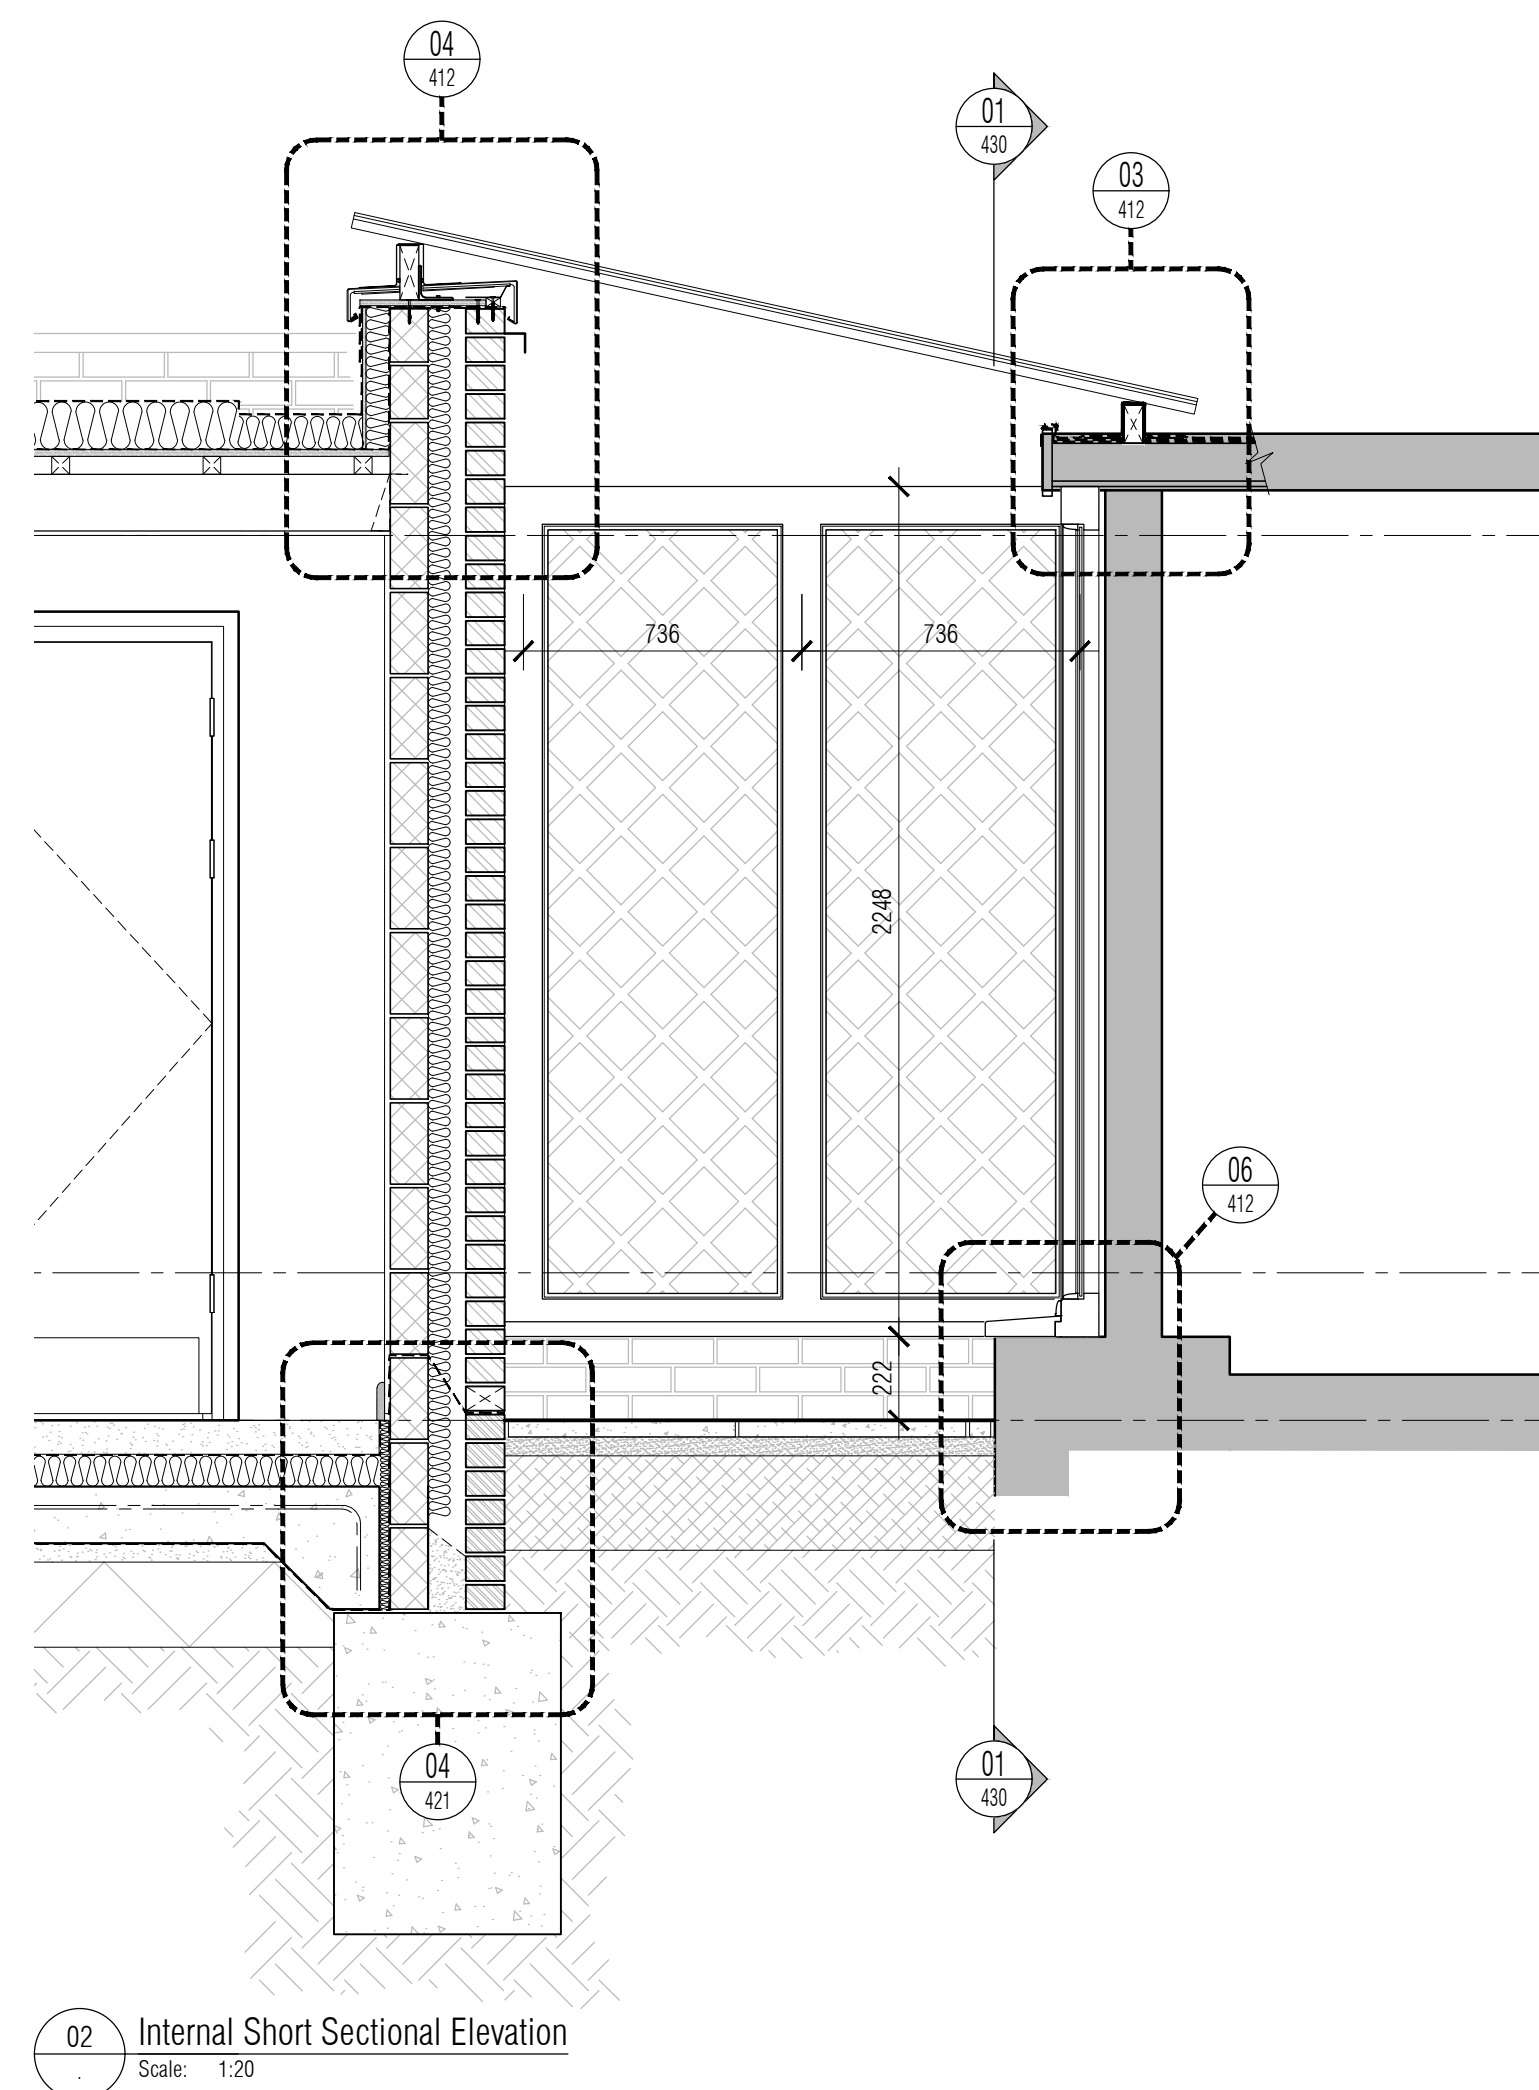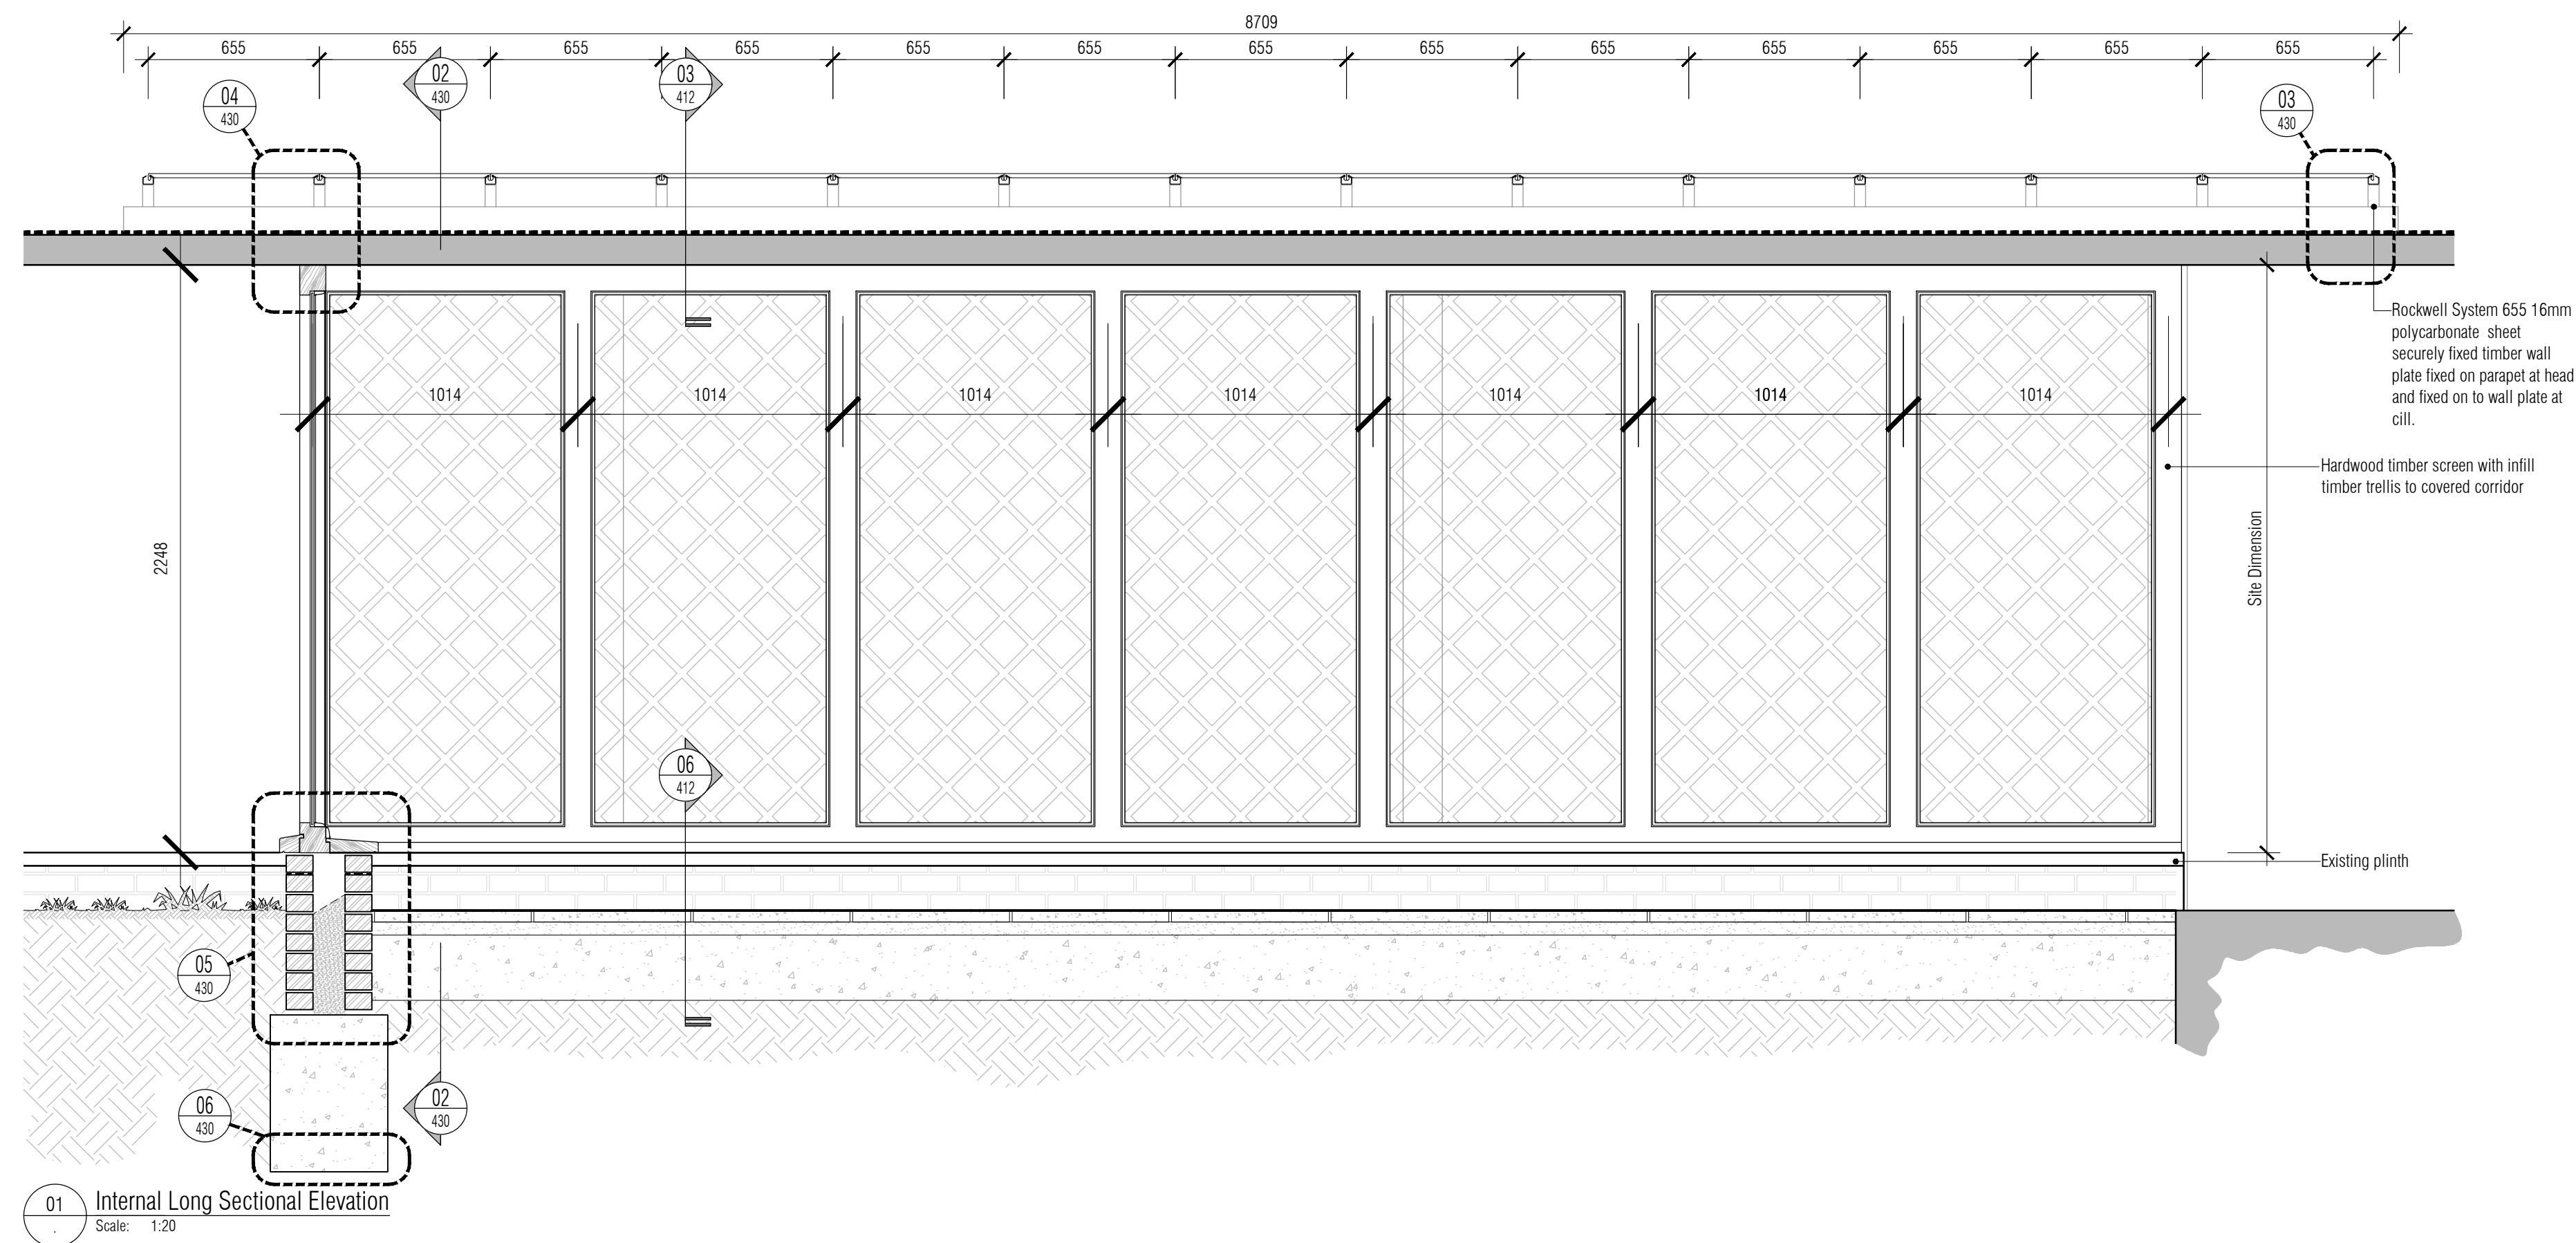

NOTES: Do not scale this drawing. All dimensions to be checked on site prior to commencement or manufacture.

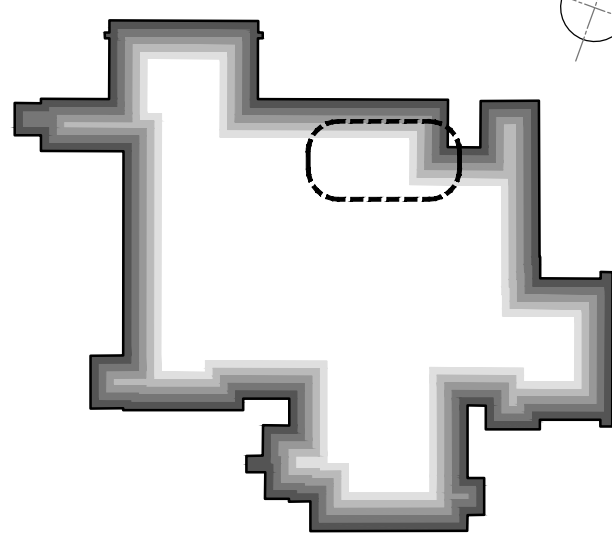

STAGE - F
DESIGN ISSUE

All details referenced in call outs supersede general arrangement or larger depictions.

P2	01.06.12	RKC	JAS	Glazing changed to trellis. Root revd.	
P1	28.05.12	RKC	JAS	Issued for Stage E	
Rev	Date	By	Chk	Comment	

BRINGING IDEAS TO LIFE



FRANKHAM

Frankham Consultancy Group Limited
21 Perrymount Road
Haywards Heath RH16 3TP
t 01444 444900 f 01444 455642
enquire@frankham.com
www.frankham.com

Client


Mansell
Author Realty

Contract N°: MC0269

Project Title	Eastbourne & Worthing Crematoria Refurbishments and Alterations
---------------	---

Drawing Title

EASTBOURNE
Bournemouth Council

Eastbourne Crematorium
Timber Trellis Covered Walkway
Elevations and Details

Drawn by: RKC	Scale: 1:20@A1	Date: 28.05.12
Designed by: FCG	Checked by: JAS	Approved by: AC

File Ref.: X:\FRANKHAM2-JOB5-521260-CREATOR\IA\FCH400-499-DETAIL-SCHEMATICS.
521260-A-430-E.DWG - 200611122029 20:06:11-12:20:29

Drawing No. 521260-A-430-E	Rev. P2
-------------------------------	------------

NB: All information based on supplied third party survey information.
All discrepancies to be reported to FCG immediately upon discovery.