



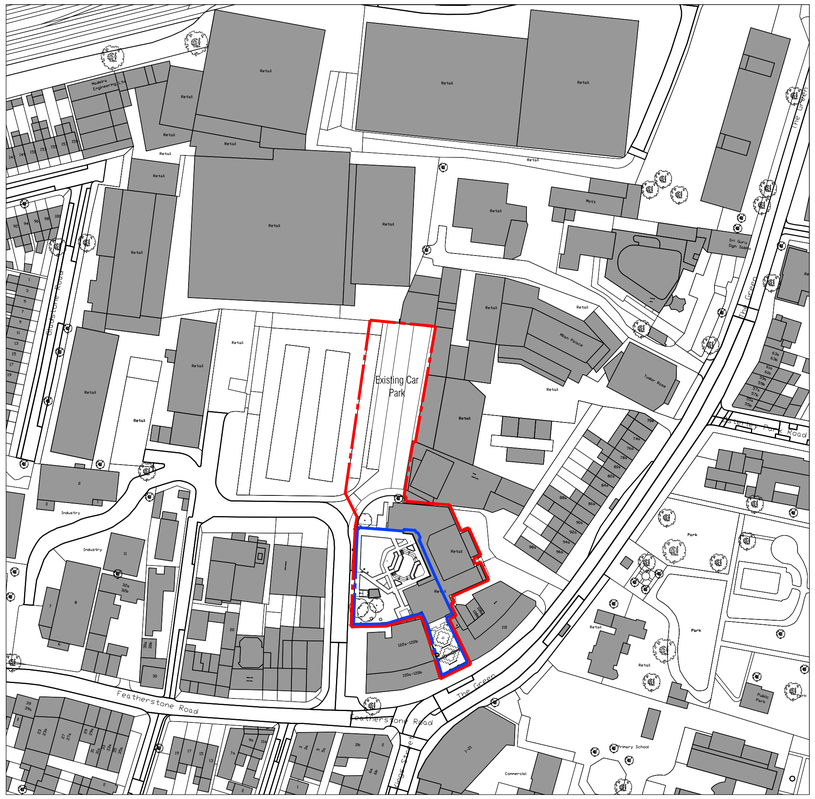


01 Location Plan
001 Scale:1:1250

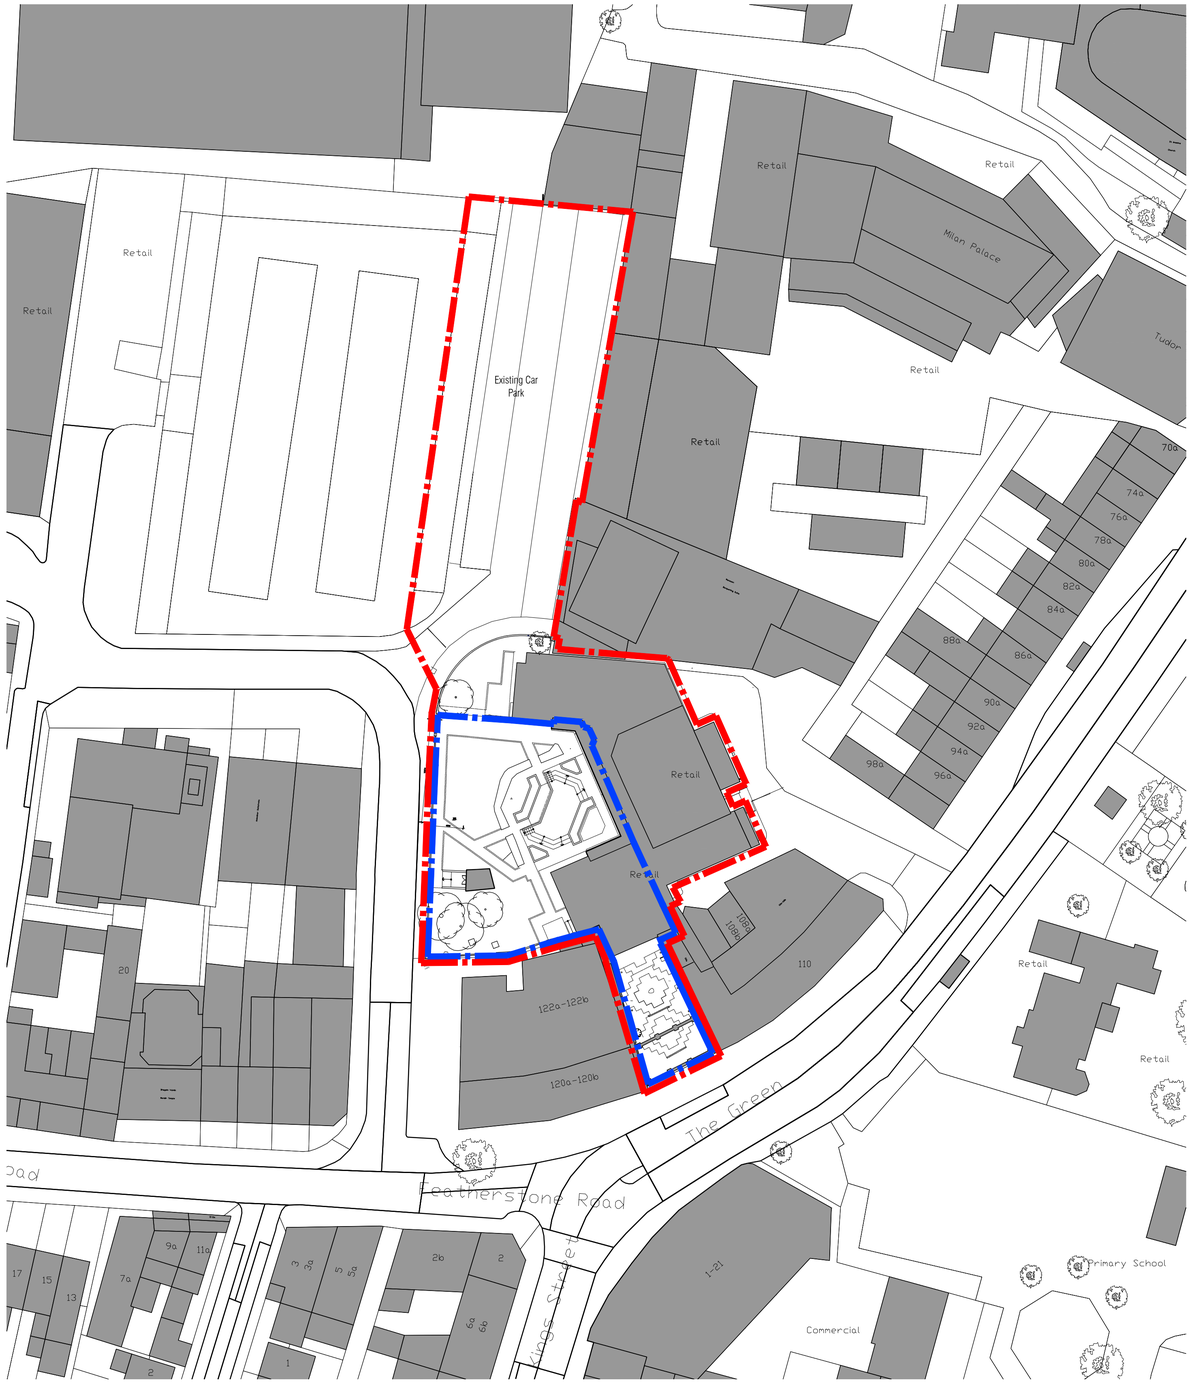

02 Location Plan
001 Scale:1:500

NOTES: Do not scale this drawing. All dimensions to be checked on site prior to commencement or manufacture.

Key Plan

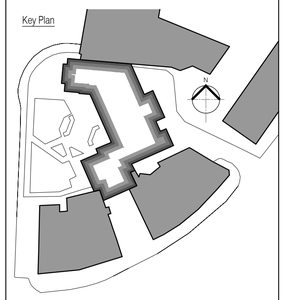

Boundaries Legend

Denotes Site Ownership Boundary

Denotes New Building Works Boundary

Scale Bar

0 5 10 15 20 25 30 1:500

0 10 20 30 40 50 60 70 1:1250

ISSUED FOR CONSTRUCTION

Rev	Date	By	Chk	Comment
C1	03.07.13	RKC	JAS	Issued for CONSTRUCTION

BRINGING IDEAS TO LIFE

FRANKHAM

Frankham Consultancy Group Limited
21 Perrymount Road
Haywards Heath RH16 3TP
t 01444 444900 f 01444 455642
enquire@frankham.com
www.frankham.com

Client

Ealing
www.ealing.gov.uk

Project Title

Dominion Arts Centre
Southall
London

Drawing Title


Existing Location Plan

Drawn by:	Scale:	Date:
RKC	Varies@A1	07.12.12
Designed by:	Checked by:	Approved by:
FCG	-	-


File Ref.: X:\2009\2124970 - LB EALING - DOMINION ARTS CENTRE\ARCHIVE_BIM_BLOCK AND SITE PLANS\224970-A-001.DWG - 2009/11/2216 20.06.11 13:27:57

Drawing No. 224970-A-001

Rev. C1

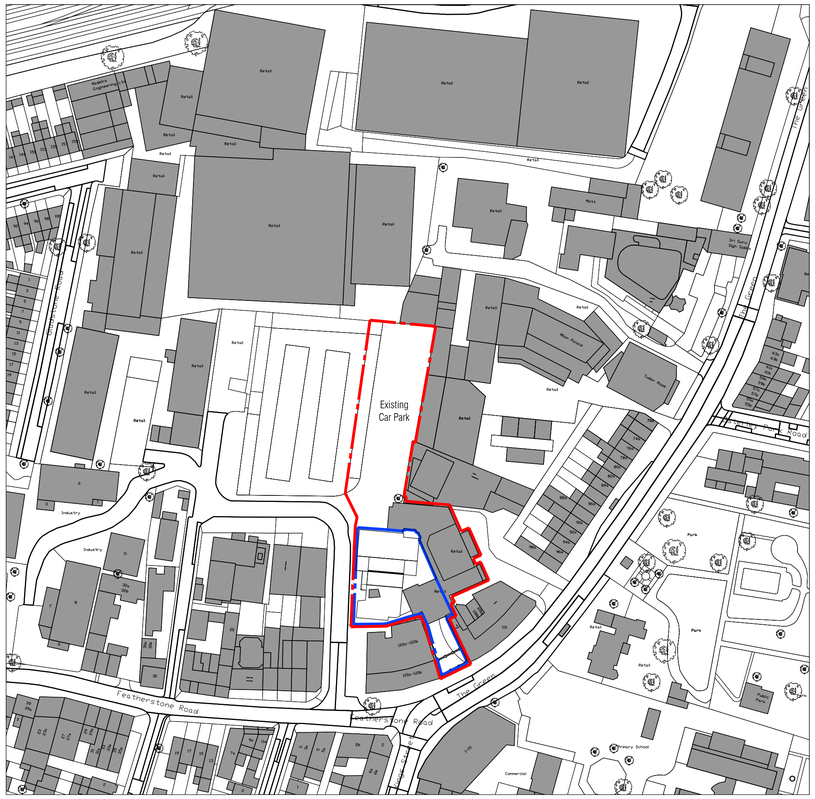


01 001 Location Plan
Scale:1:1250

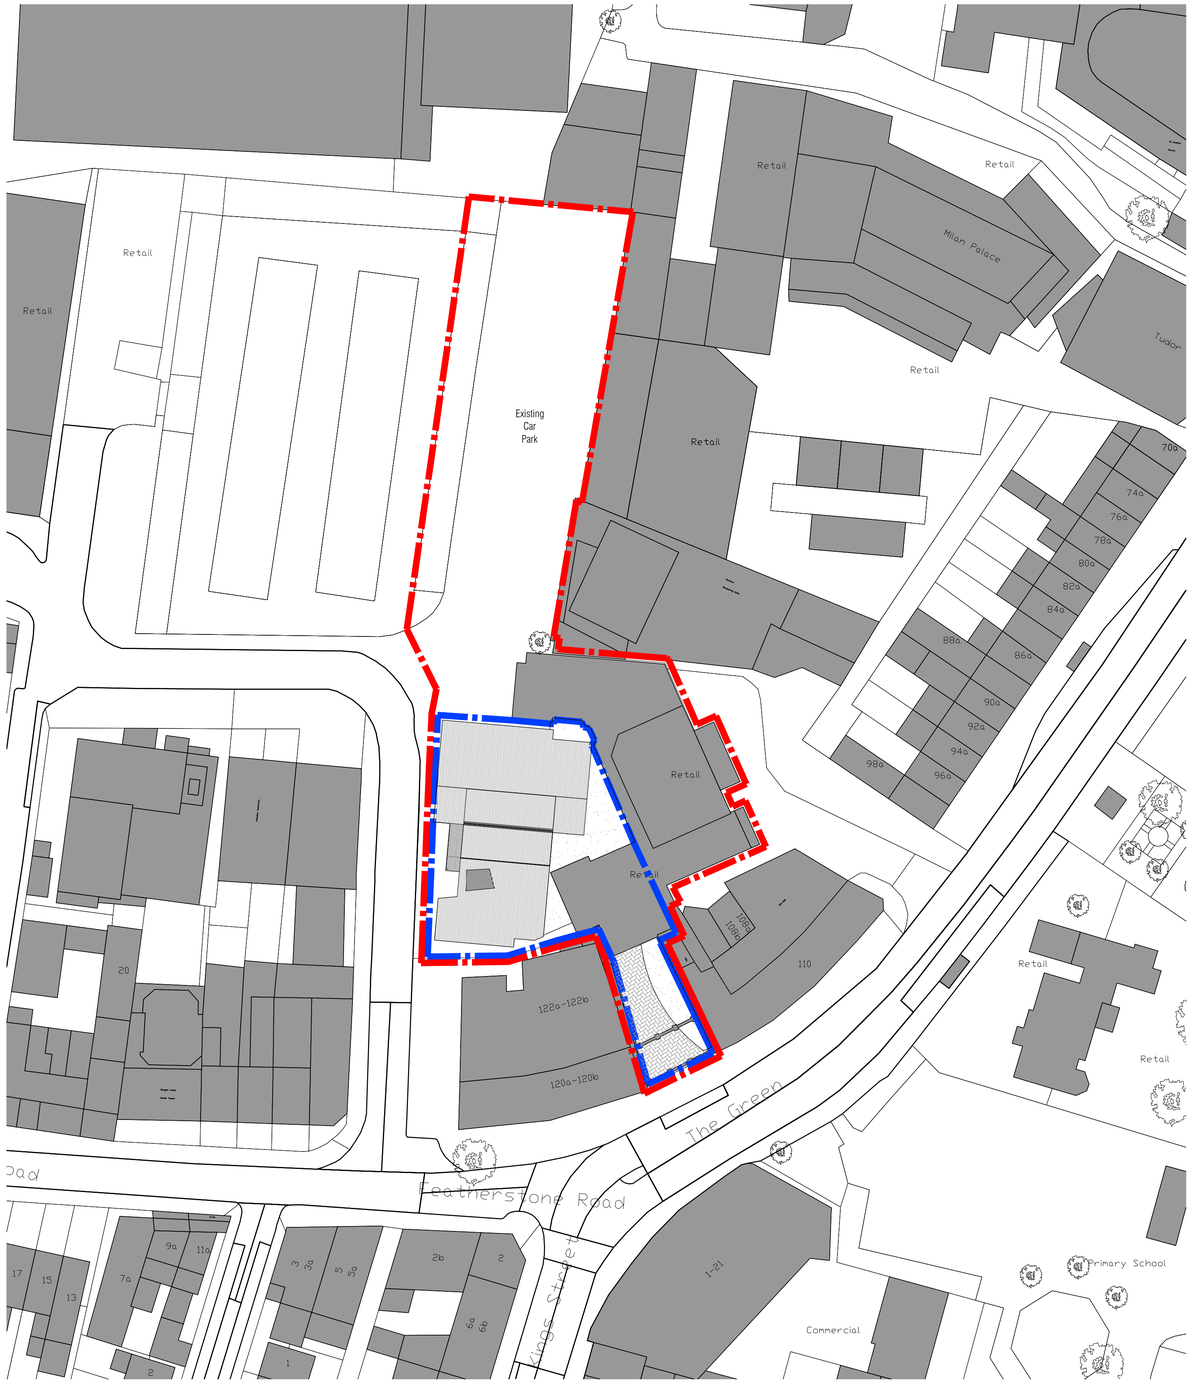

02 001 Site Plan
Scale:1:500

NOTES: Do not scale this drawing. All dimensions to be checked on site prior to commencement or manufacture.

Key Plan

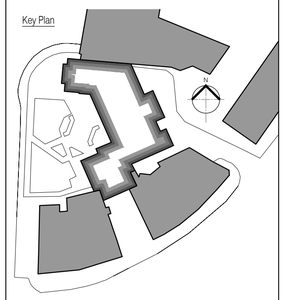

Site Legend
- Denotes brick pavers
- Denotes grass

Boundaries Legend
- Denotes Site Ownership Boundary
- Denotes New Building Works Boundary

Scale Bar
0 5 10 15 20 25 30 1:500
0 10 20 30 40 50 60 70 1:1250

ISSUED FOR CONSTRUCTION

Rev	Date	By	Chk	Comment
C1	03.07.13	RKC	JAS	Issued for CONSTRUCTION

BRINGING IDEAS TO LIFE

FRANKHAM

Frankham Consultancy Group Limited
21 Perrymount Road
Haywards Heath RH16 3TP
t 01444 444900 f 01444 455542
enquire@frankham.com
www.frankham.com

Client: Ealing www.ealing.gov.uk


Project Title: Dominion Arts Centre, Southall, London

Drawing Title: Proposed Location

Drawn by:	Scale:	Date:
RKC	Varies@A1	07.12.12
Designed by:	Checked by:	Approved by:
FCG	-	-

File Ref.: X:\2008\224970 - LEALNE, DOMINION ARTS CENTRE\ARCHIVE_BIM_BLOCK AND SITE PLANS\224970-A-002.DWG - 2008111280Z 20:06:11 13/28/02


Drawing No.	Rev.
224970-A-002	C1

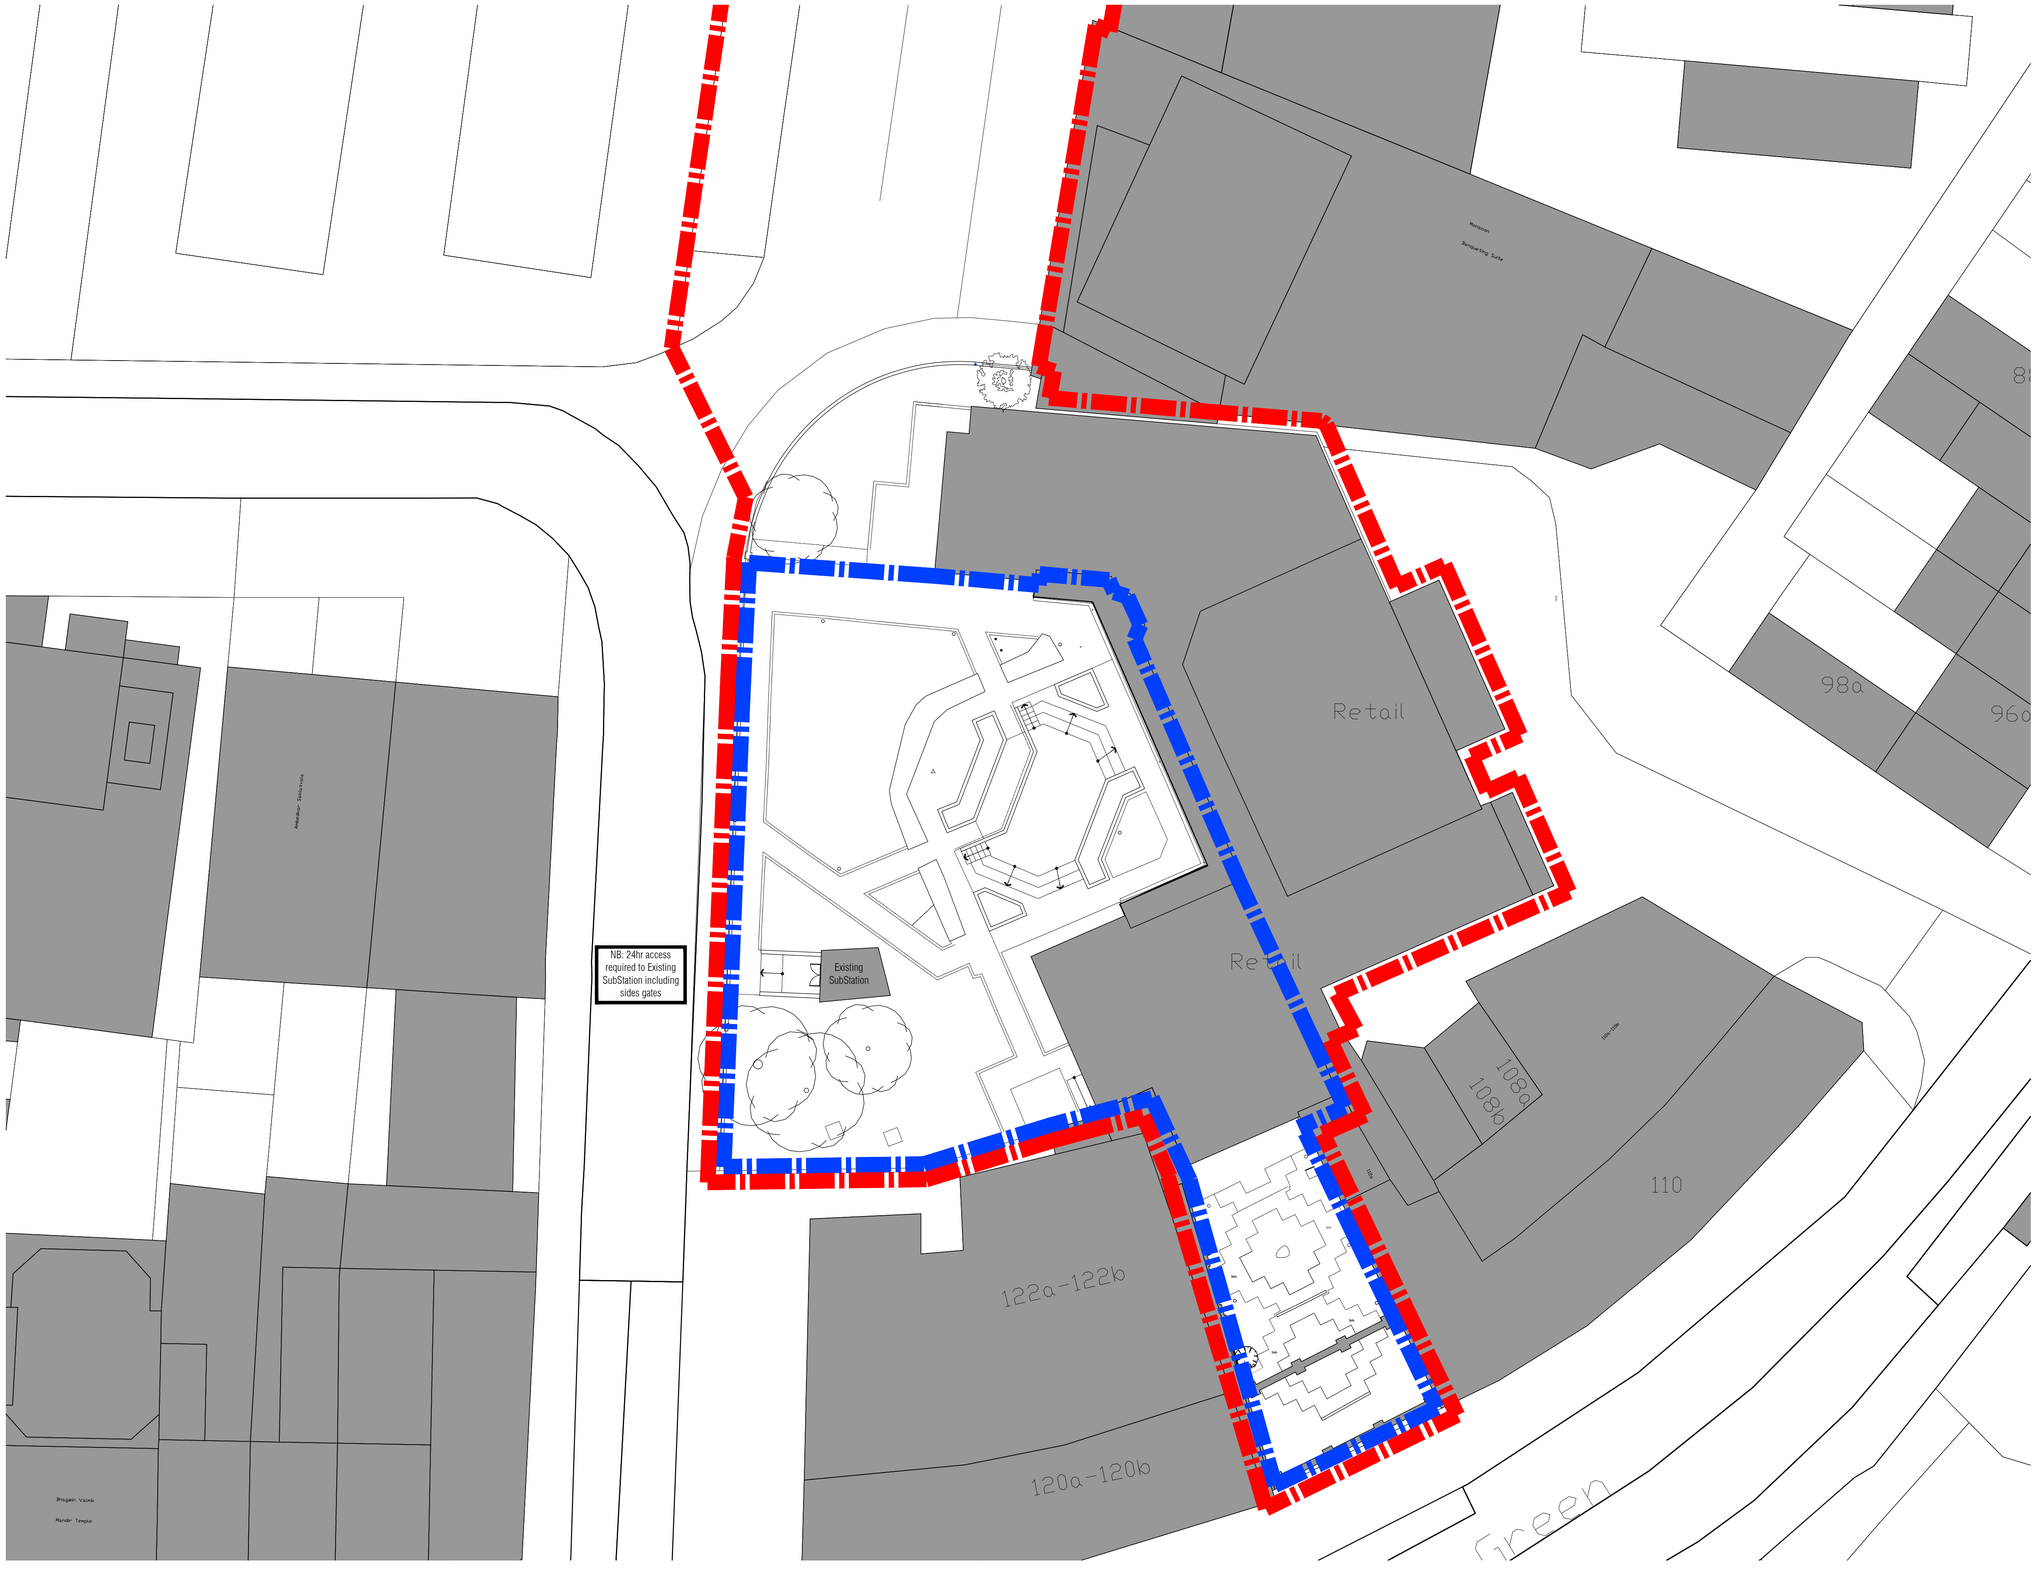

01 003 Location Plan
Scale:1:200

NOTES: Do not scale this drawing. All dimensions to be checked on site prior to commencement or manufacture.

Key Plan

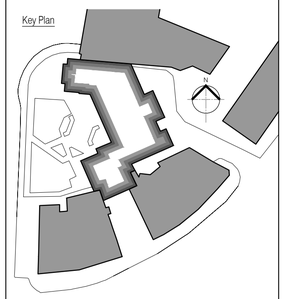

Site Legend

Denotes brick pavers

Denotes grass

Boundaries Legend

Denotes Site Ownership Boundary

Denotes New Building Works Boundary

Scale Bar

0 2 4 6 1:100

0 2 4 6 8 10 12 1:200

ISSUED FOR CONSTRUCTION

Rev	Date	By	Chk	Comment
C1	03.07.13	RKC	JAS	Issued for CONSTRUCTION

BRINGING IDEAS TO LIFE

FRANKHAM

Frankham Consultancy Group Limited
21 Perrymount Road
Haywards Heath RH16 3TP
t 01444 444900 f 01444 455642
enquire@frankham.com
www.frankham.com

Client

Ealing
www.ealing.gov.uk

Project Title

Dominion Arts Centre
Southall
London

Drawing Title


Existing Site Plan

Drawn by:	Scale:	Date:
RKC	Varies@A1	19.12.12
Designed by:	Checked by:	Approved by:
FCG	-	-

File Ref.: X:\2009\0224970 - LEALING - DOMINION ARTS CENTRE\ARCHIVE_999_BLOCK AND SITE PLANS\ 224970-A-003.DWG - 2009-11-13@08:07

Drawing No.	Rev.
224970-A-003	C1


224970-A-005 For continuation, refer to dwg:

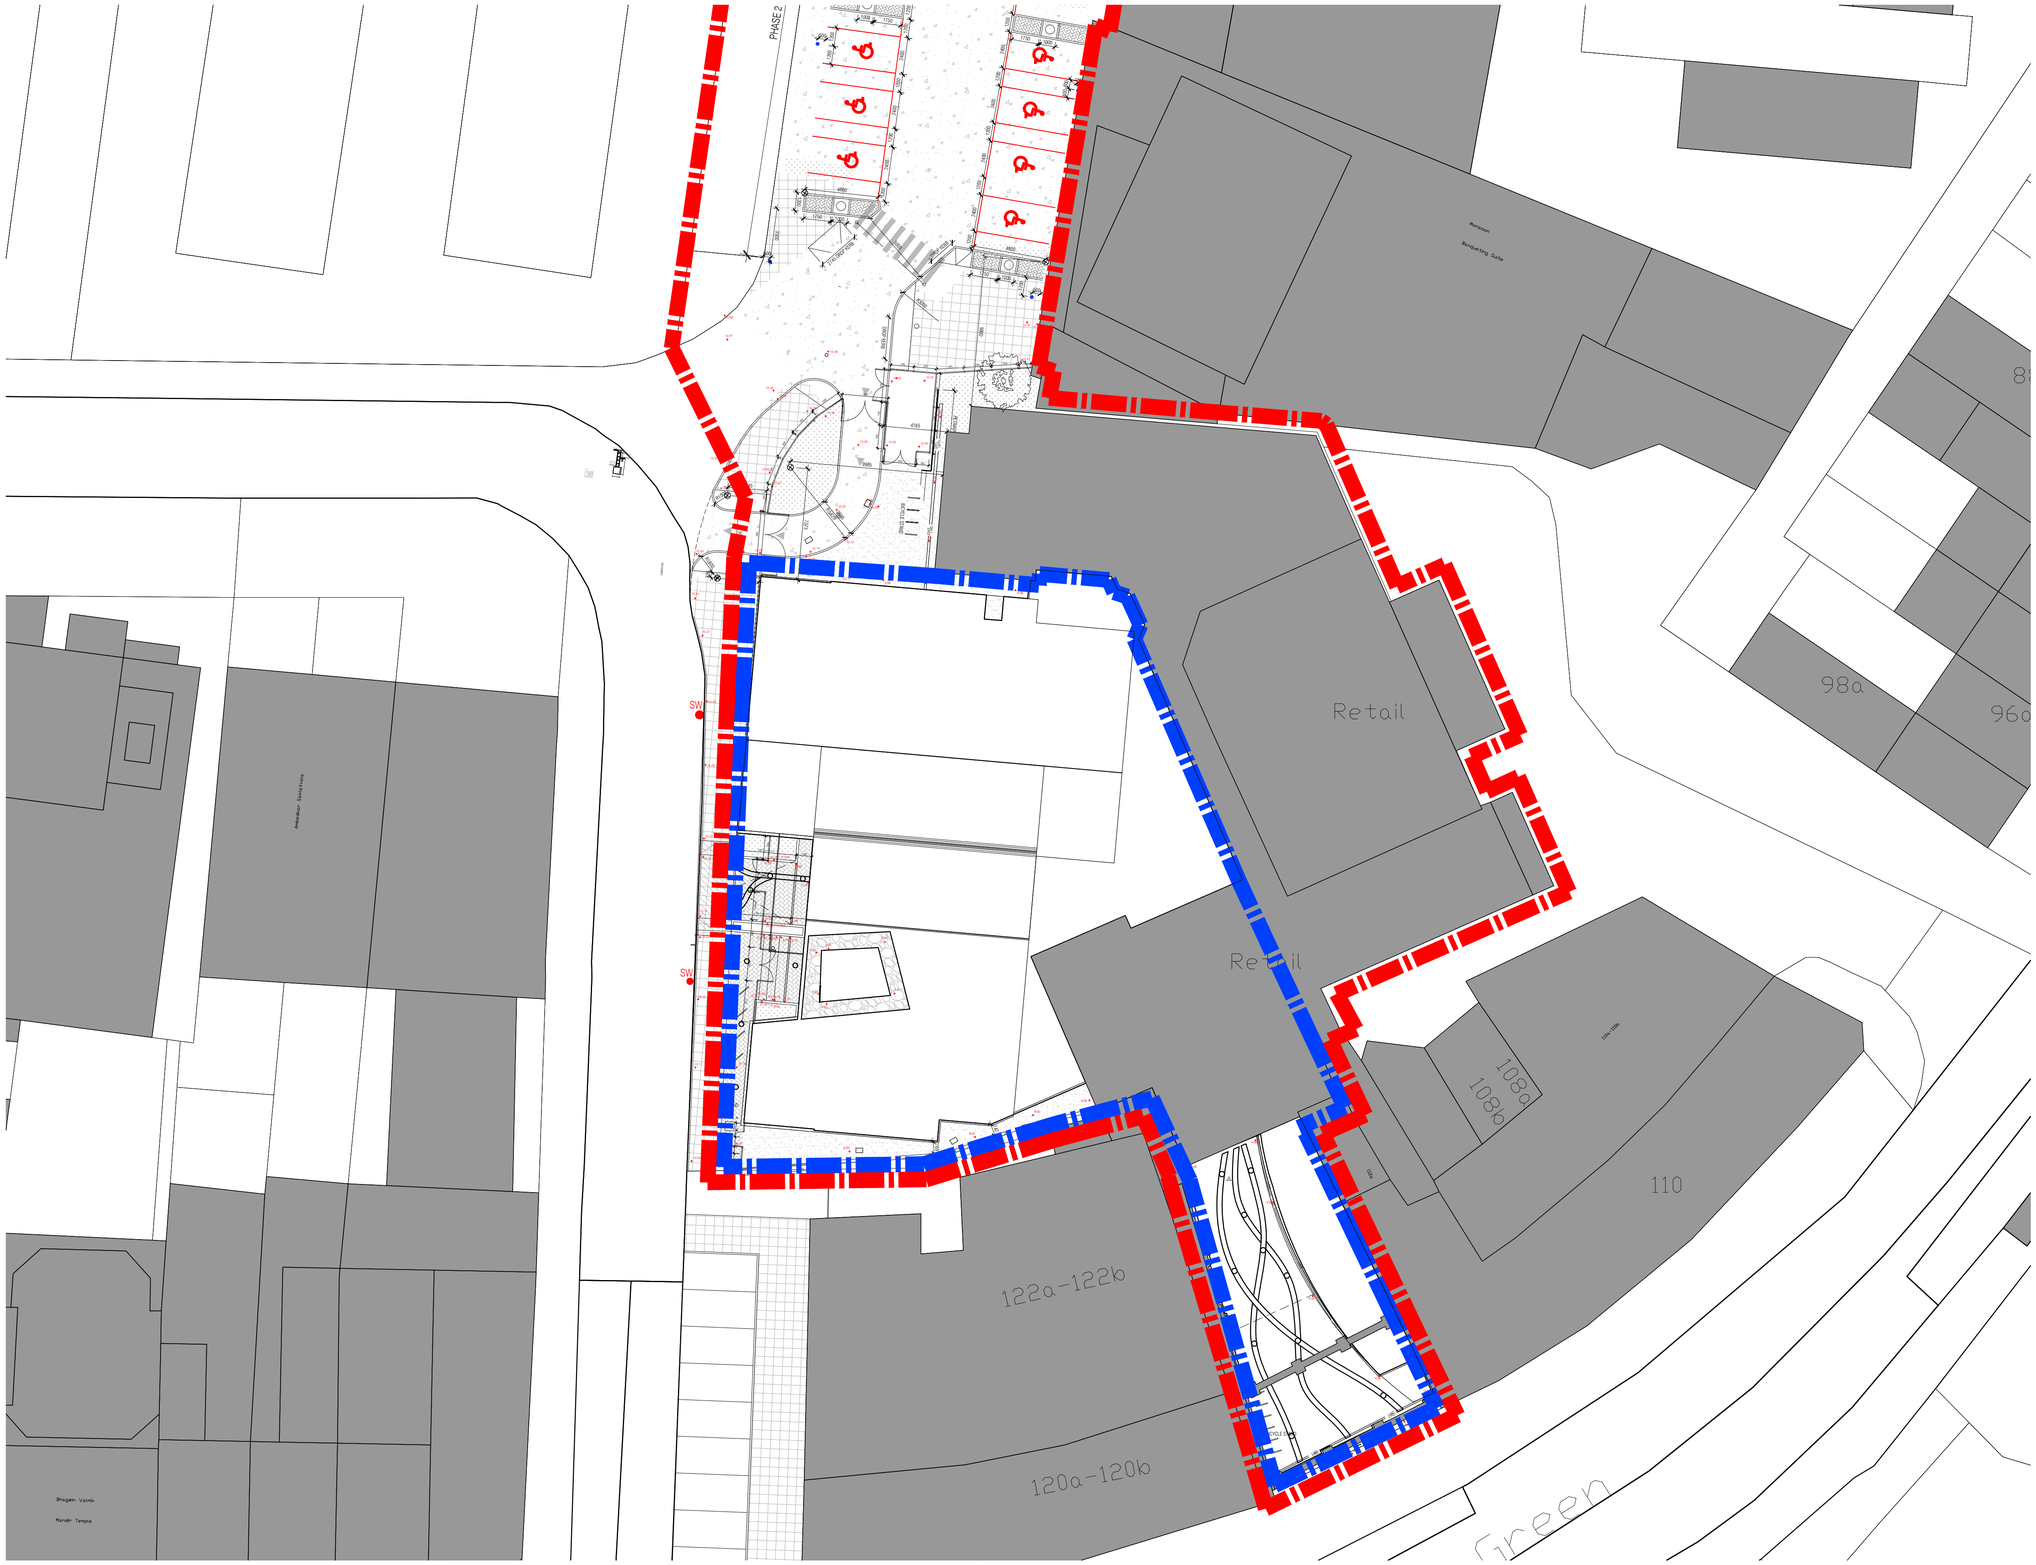

01 / 003 Location Plan
Scale:1:200

NOTES: Do not scale this drawing. All dimensions to be checked on site prior to commencement or manufacture.

Key Plan

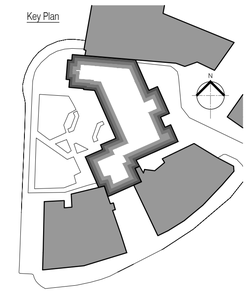

Site Legend

- Denotes new brick pavers
- Denotes grass
- Denotes highways paving slabs
- Denotes tarmac footpath
- Denotes new car park surfacing
- E — Denotes Electrical car charging points. See Electrical Engineers specification
- Denotes tactile paving at vehicle crossing points
- Denotes gravel with terram underlay
- Denotes Electrical Car charging point
- Denotes lampost car park lighting

Boundaries Legend

- Denotes Site Ownership Boundary
- Denotes New Building Works Boundary

Scale Bar

0 2 4 6 1:100
0 2 4 6 8 10 12 1:200

ISSUED FOR CONSTRUCTION

Rev	Date	By	Chk	Comment
C1	03.07.13	RKC	JAS	Issued for CONSTRUCTION

BRINGING IDEAS TO LIFE

FRANKHAM

Frankham Consultancy Group Limited
21 Perrymount Road
Haywards Heath RH16 3TP
t 01444 444900 f 01444 455642
enquire@frankham.com
www.frankham.com

Client: Ealing — www.ealing.gov.uk

Project Title: Dominion Arts Centre, Southall, London

Drawing Title: Proposed Site Plan

Drawn by:	Scale:	Date:
RKC	Varies@A1	19.12.12
Designed by:	Checked by:	Approved by:
FCG	-	-

File Ref.: X:\2008\0224970 - LB EALING - DOMINION ARTS CENTRE\ARCH\3D0_BIM_BLOCK AND SITE PLANS\224970-A-004.DWG - 2008/112813 — 20:06:11 13/12/13


Drawing No. 224970-A-004 | Rev. C1



01 005 External Work
Scale:1:200




02 005 External Work
Scale:1:200

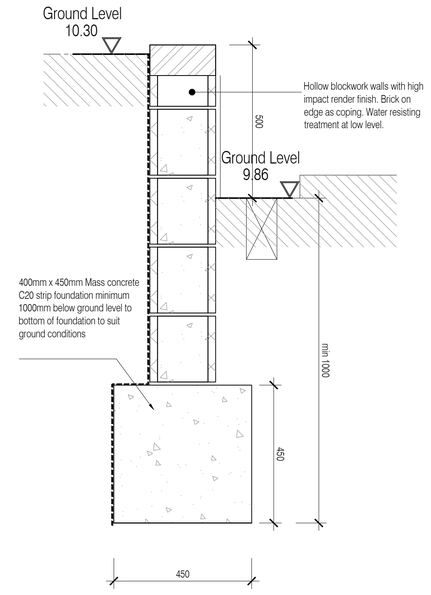

03 005 Retaining wall detail
Scale:1:10

NOTES: Do not scale this drawing. All dimensions to be checked on site prior to commencement or manufacture.

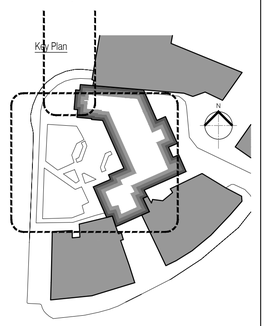

Site Legend

- Denotes new brick pavers
- Denotes grass
- Denotes highways paving slabs
- Denotes tarmac footpath
- Denotes new car park surfacing
- E Denotes Electrical car charging points. See Electrical Engineers specification
- Denotes tactile paving at vehicle crossing points
- Denotes gravel with terram underlay
- Denotes Electrical Car charging point
- Denotes lampost car park lighting

Boundaries Legend

- Denotes Site Ownership Boundary
- Denotes New Building Works Boundary

Scale Bar

0 2 4 6 1:100
0 2 4 6 8 10 12 1:200

ISSUED FOR AS-BUILT

Rev	Date	By	Chk	Comment
AB	30.09.14	CH	AC	Issued for AS-BUILT

BRINGING IDEAS TO LIFE

FRANKHAM

Frankham Consultancy Group Limited
21 Perrymount Road
Haywards Heath RH16 3TP
t 01444 444900 f 01444 455642
enquire@frankham.com
www.frankham.com

Client
Ealing
www.ealing.gov.uk

Project Title
Dominion Arts Centre
Southall
London


Drawing Title
Proposed
External Works Plan

Drawn by:	Scale:	Date:
RKC	1:200@A1	17.12.12
Designed by:	Checked by:	Approved by:
FCG	-	-

File Ref.: X:\2008\0224970 - LB EALING - DOMINION ARTS CENTRE\ARCH\DSE_006_BLOCK AND SITE PLANS 224970-A-005.DWG - 2008/11/2819 20:06:11:13:28:19


Drawing No. 224970-A-005
Rev. AB


© The Local Data Company

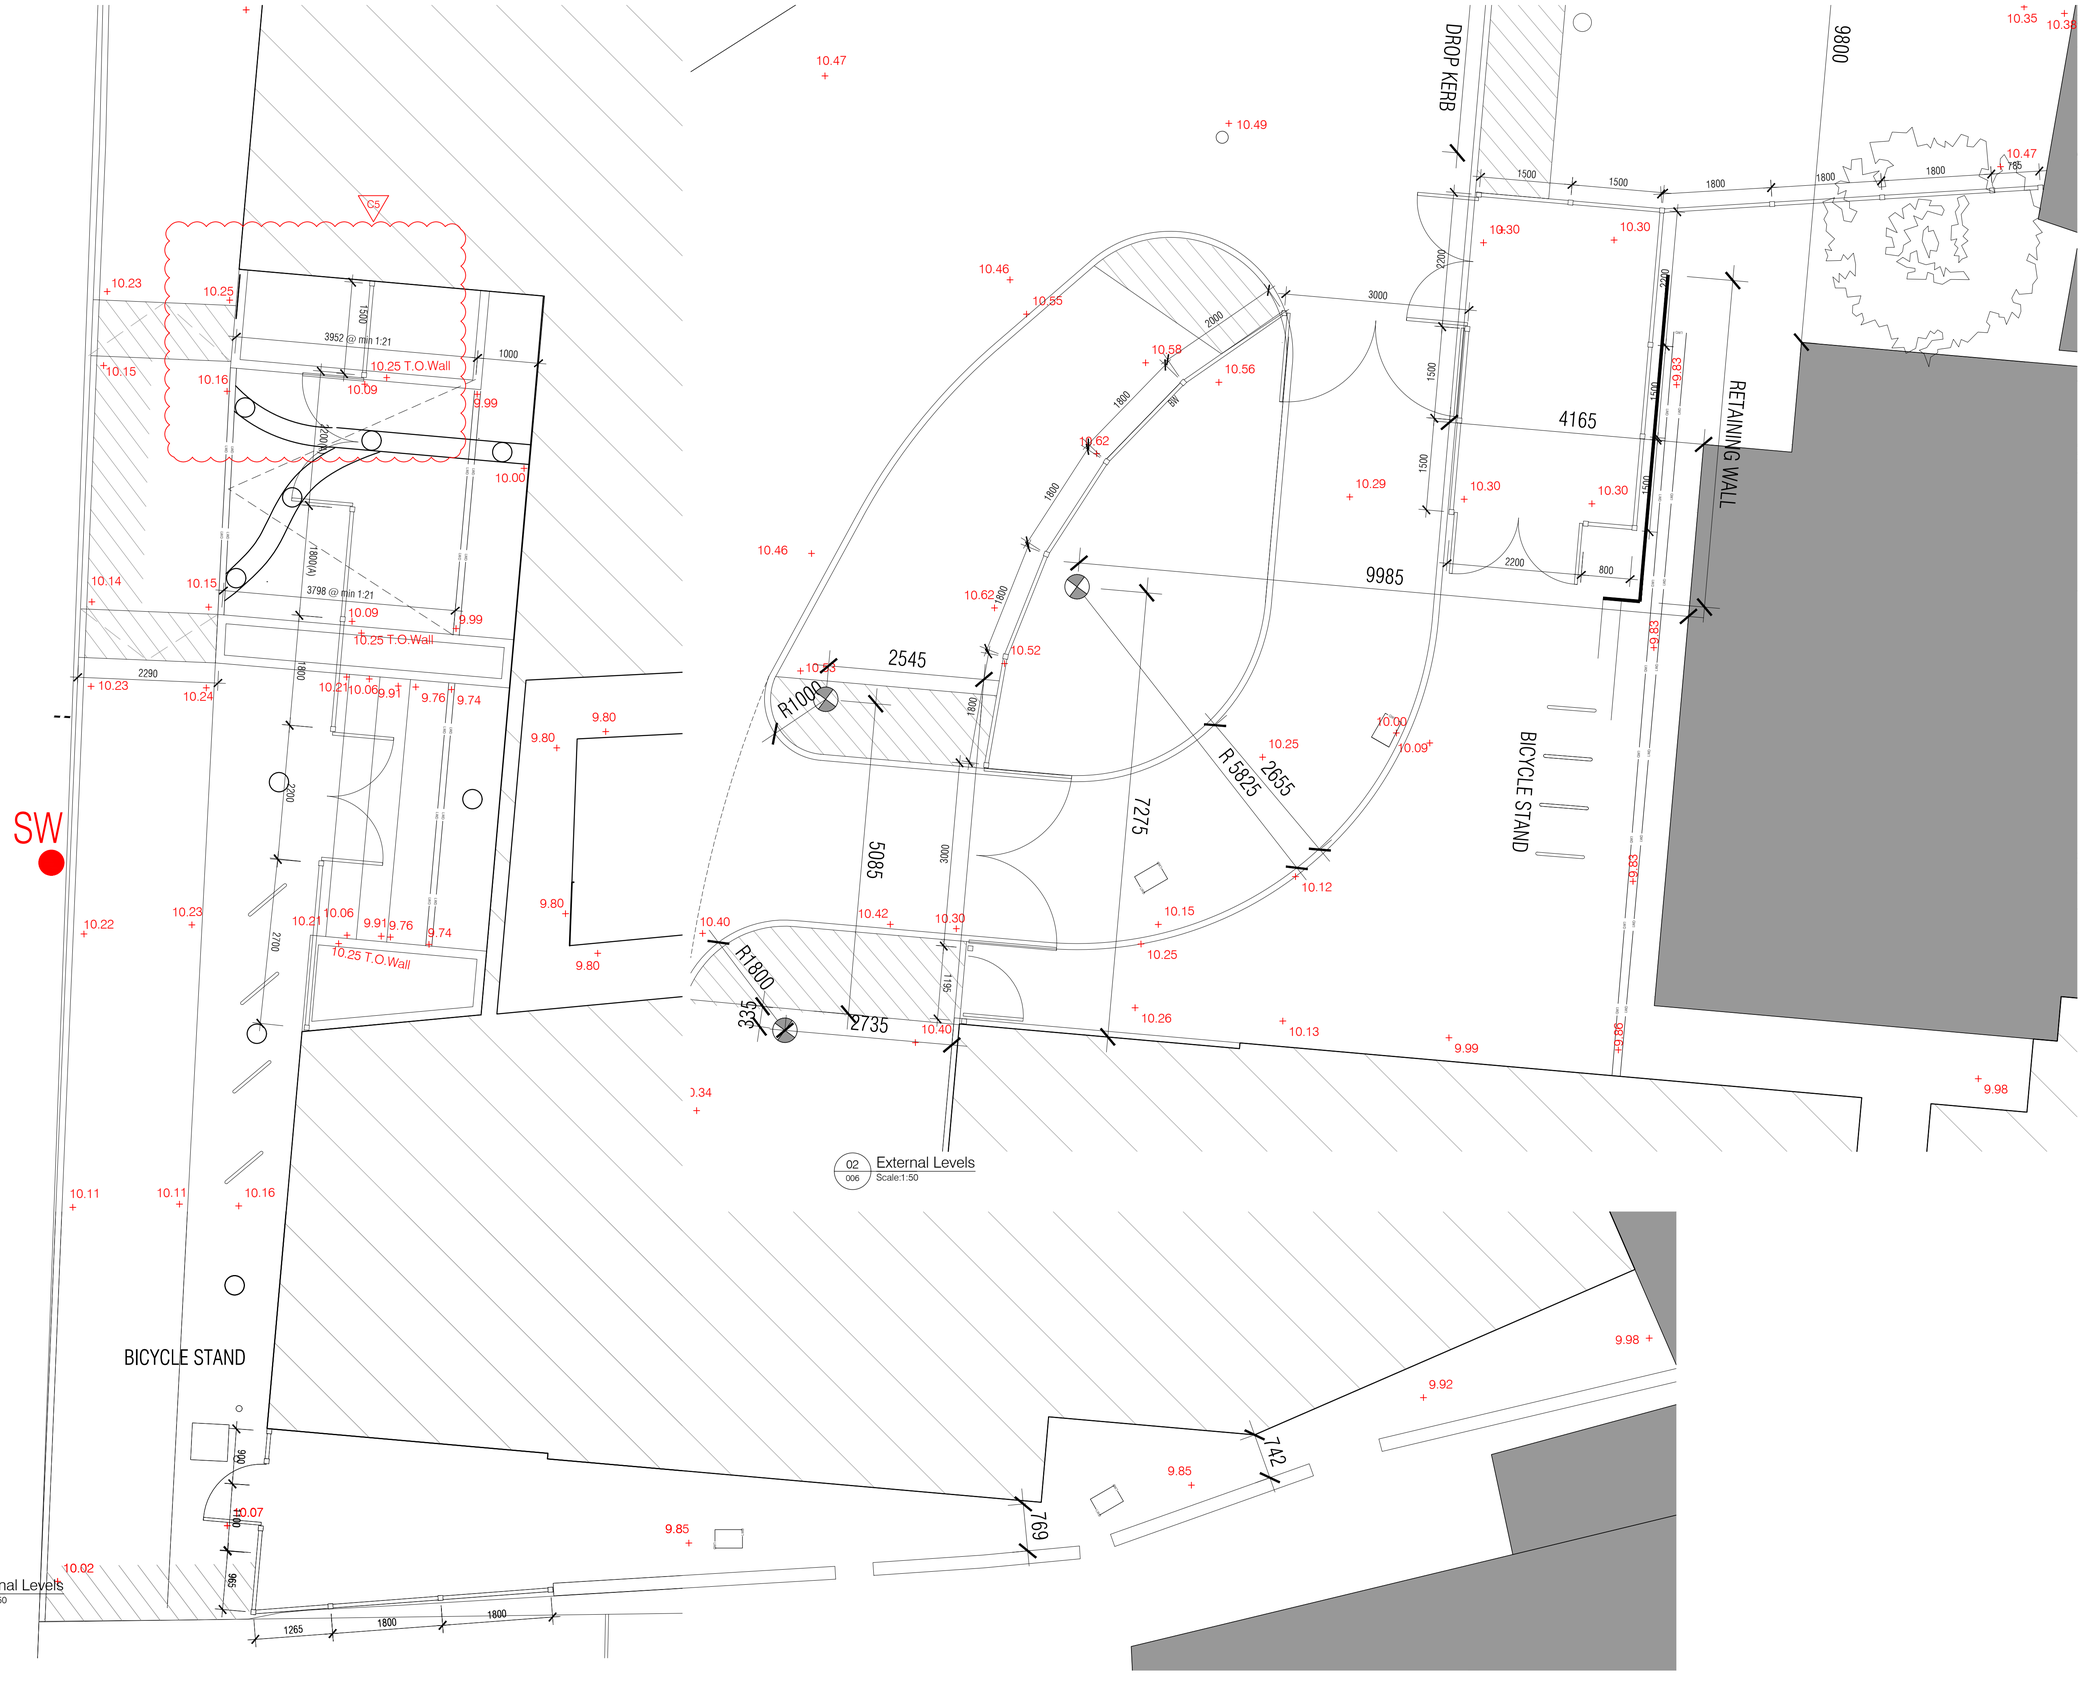

NOTES: Do not scale this drawing. All dimensions to be checked on site prior to commencement or manufacture.

Key Plan
(nts)

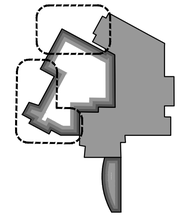

Site Legend

- Denotes new brick pavers
- Denotes grass
- Denotes highways paving slabs
- Denotes tarmac footpath
- Denotes new car park surfacing
- E Denotes Electrical car charging points. See Electrical Engineers specification
- Denotes tactile paving at vehicle crossing points
- Denotes gravel with terram underlay
- Denotes Electrical Car charging point
- Denotes lampost car park lighting

Scale Bar

0 2 4 6 1:100
0 2 4 6 8 10 12 1:200

ISSUED FOR CONSTRUCTION

Rev	Date	By	Chk	Comment
C5	29.04.29	CH	AC	Fence line adjusted
C4	24.04.14	CH	AC	Paving adjusted
C3	26.03.14	CH	AC	Bin store adjusted
C2	13.03.14	CH	AC	Binstore adjusted
C1	03.07.13	RKC	JAS	Issued for CONSTRUCTION

BRINGING IDEAS TO LIFE

FRANKHAM

Frankham Consultancy Group Limited
21 Perrymount Road
Haywards Heath RH16 3TP
t 01444 444900 f 01444 455642
enquire@frankham.com
www.frankham.com

Client
Ealing
www.ealing.gov.uk


Project Title
Dominion Arts Centre
Southall
London

Drawing Title
Proposed
External Works Plan
Levels

Drawn by:	Scale:	Date:
RKC	1:50@A1	24.04.13
Designed by:	Checked by:	Approved by:
FCG	-	-

File Ref.: X:\2008\2\2401 - LB EALING - DOMINION ARTS CENTRE\ARCHIVE_BIN_BLOCK AND SITE PLANS\224970-A-006.DWG 20/06/2011 13:28:26


Drawing No.	Rev.
224970-A-006	C5

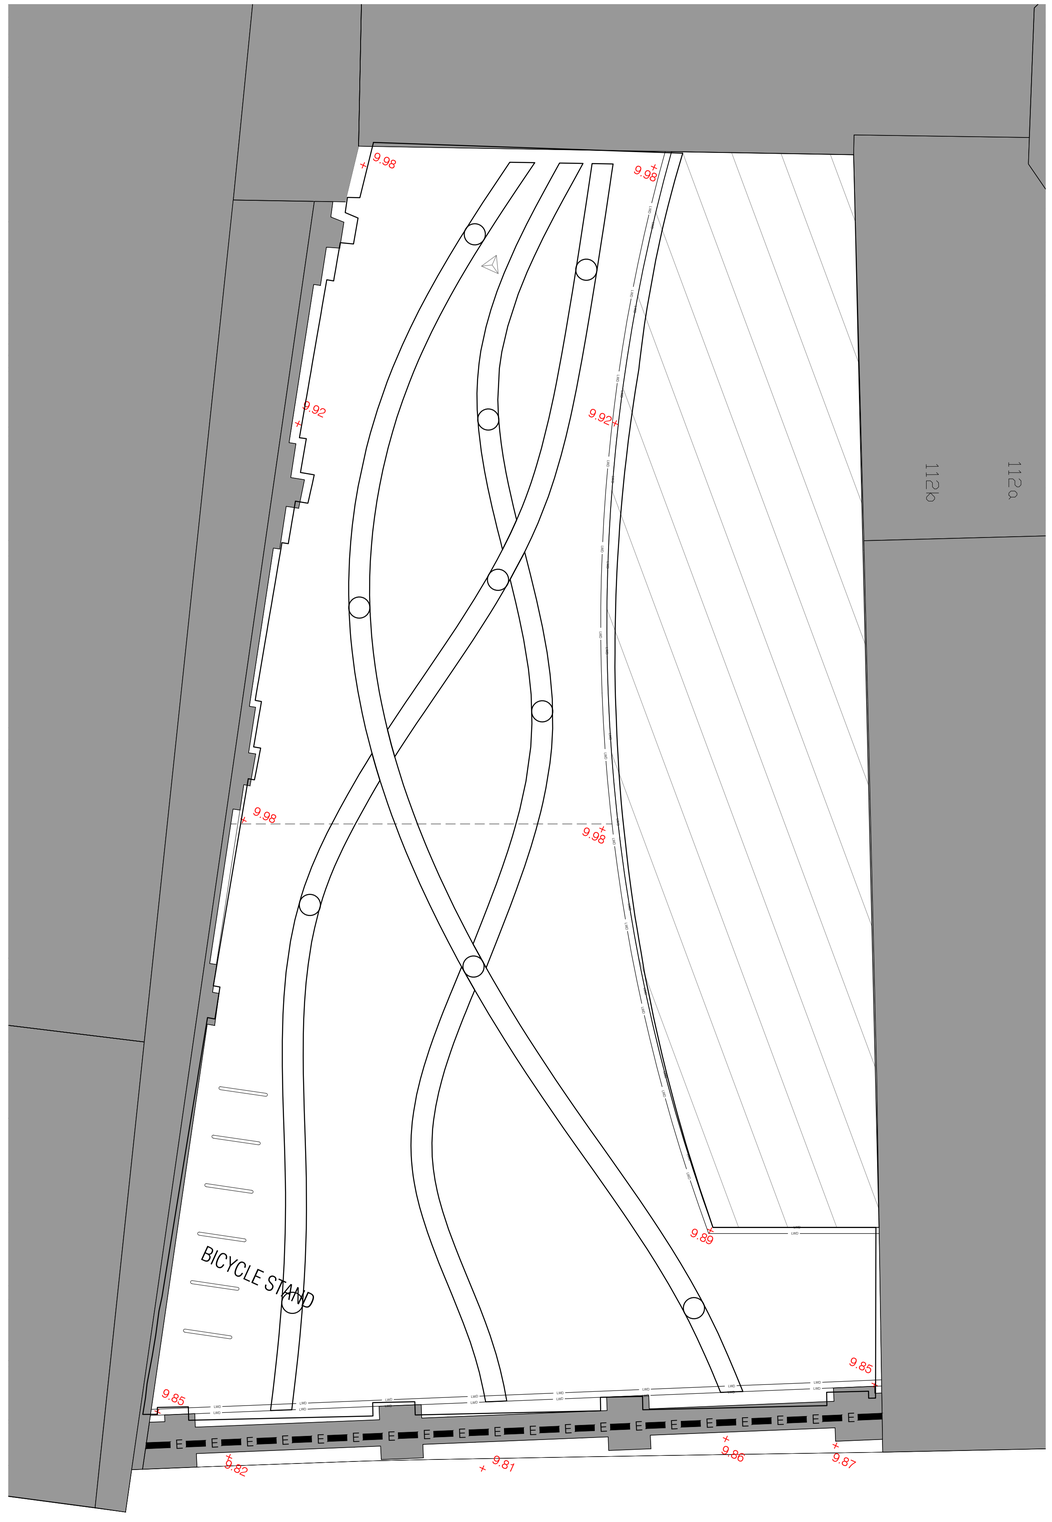

01 / 007 External Levels
Scale:1:50

NOTES: Do not scale this drawing. All dimensions to be checked on site prior to commencement or manufacture.

Key Plan
(nts)

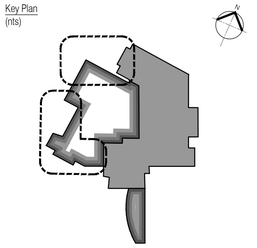

Site Legend

- Denotes new brick pavers
- Denotes grass
- Denotes highways paving slabs
- Denotes tarmac footpath
- Denotes new car park surfacing
- E — Denotes Electrical car charging points. See Electrical Engineers specification
- Denotes tactile paving at vehicle crossing points
- Denotes gravel with terram underlay
- Denotes Electrical Car charging point
- Denotes lampost car park lighting

Scale Bar

0 2 4 6 1:100
0 2 4 6 8 10 12 1:200

ISSUED FOR CONSTRUCTION

Rev	Date	By	Chk	Comment
C1	03.07.13	RKC	JAS	Issued for CONSTRUCTION

BRINGING IDEAS TO LIFE

FRANKHAM

Frankham Consultancy Group Limited
21 Perrymount Road
Haywards Heath RH16 3TP
t 01444 444900 f 01444 455642
enquire@frankham.com
www.frankham.com

Client
Ealing
www.ealing.gov.uk


Project Title
Dominion Arts Centre
Southall
London


Drawing Title
Proposed
External Works Plan
Front Levels

Drawn by:	Scale:	Date:
RKC	1:50@A1	24.04.13
Designed by:	Checked by:	Approved by:
FCG	-	-


File Ref.: K:\2000\224970 - LB EALING - DOMINION ARTS CENTRE\ARCHIVE_WIP_BLOCK AND SITE PLANS\224970-A-007.DWG - 2000113281
20:06:11 13:28:31

Drawing No. 224970-A-007 Rev. C1

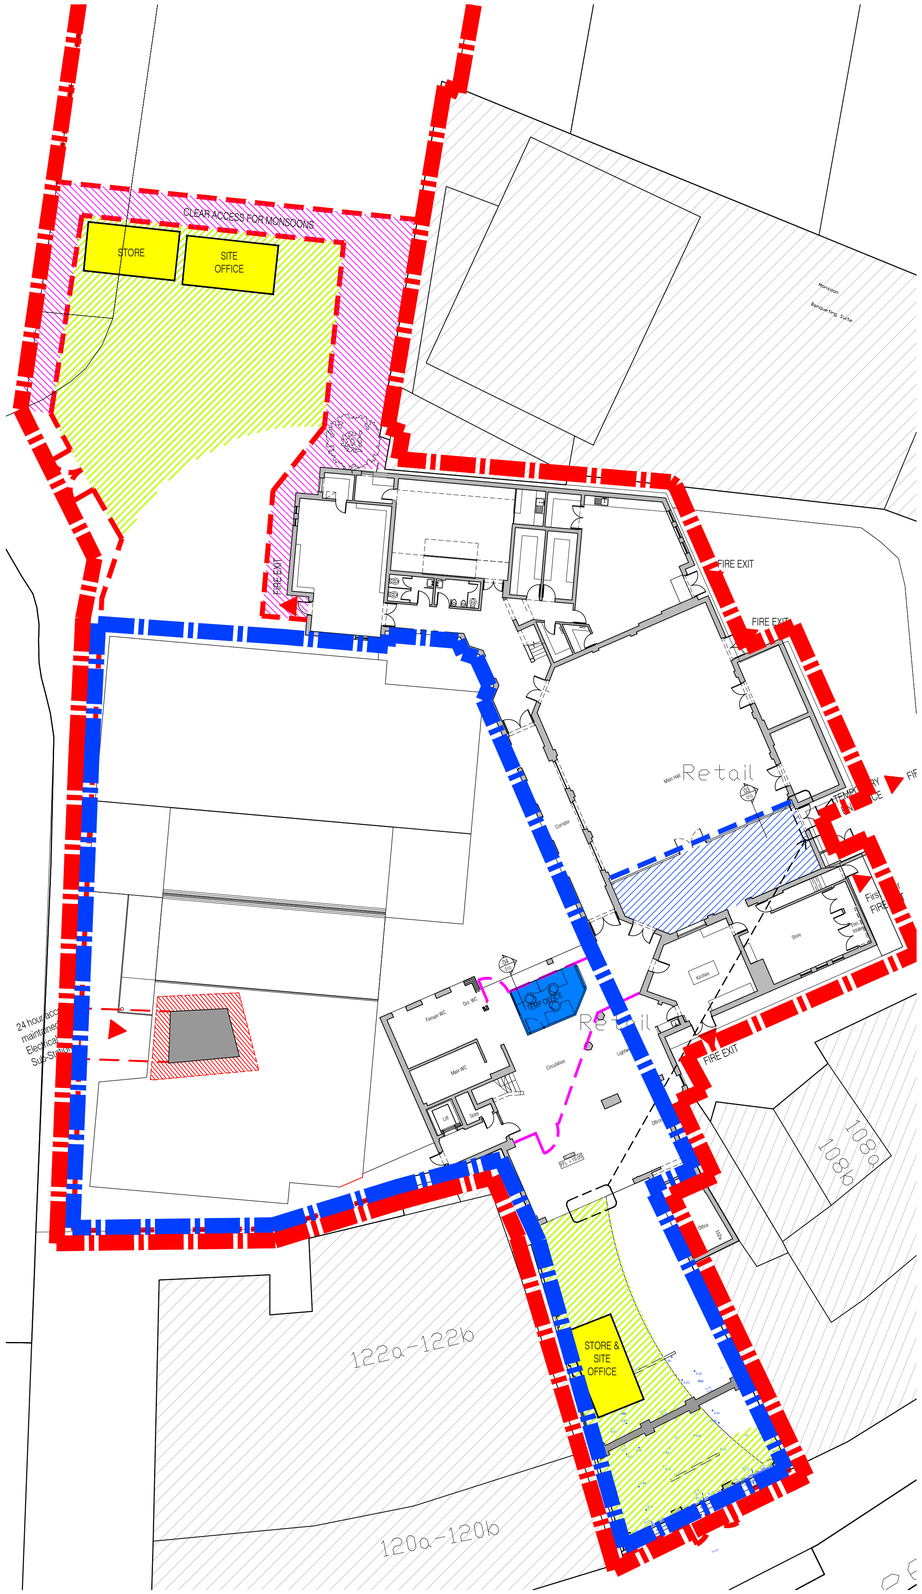
CLEAR ACCESS FOR MONSOONS
STORE
SITE OFFICE
FIRE EXIT
FIRE EXIT
FIRE EXIT
Main Hall
Retail
Retail
Kitchen
Store
Female WC
Male WC
Circulation
Office
Office
Office

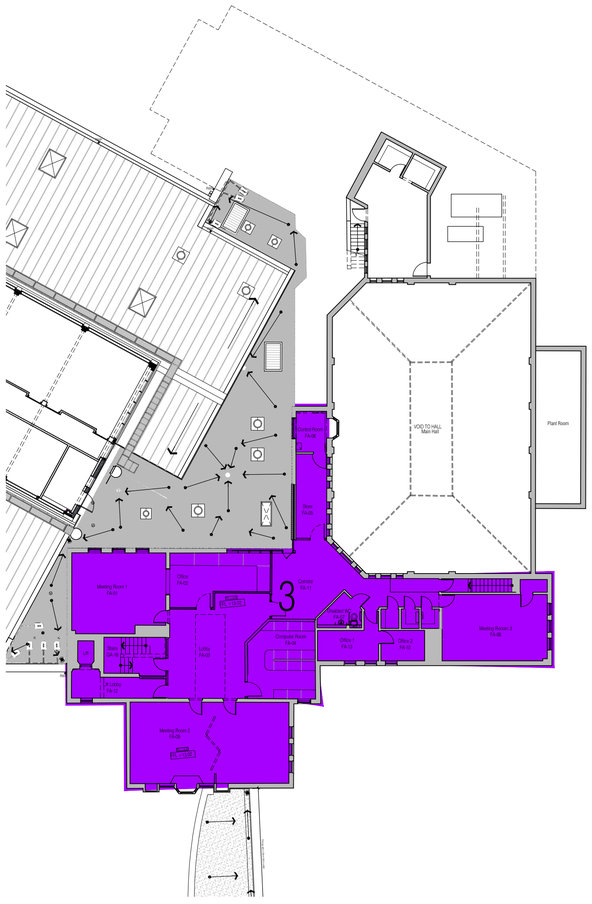

02 / 010 First Floor Phasing
Scale:1:200

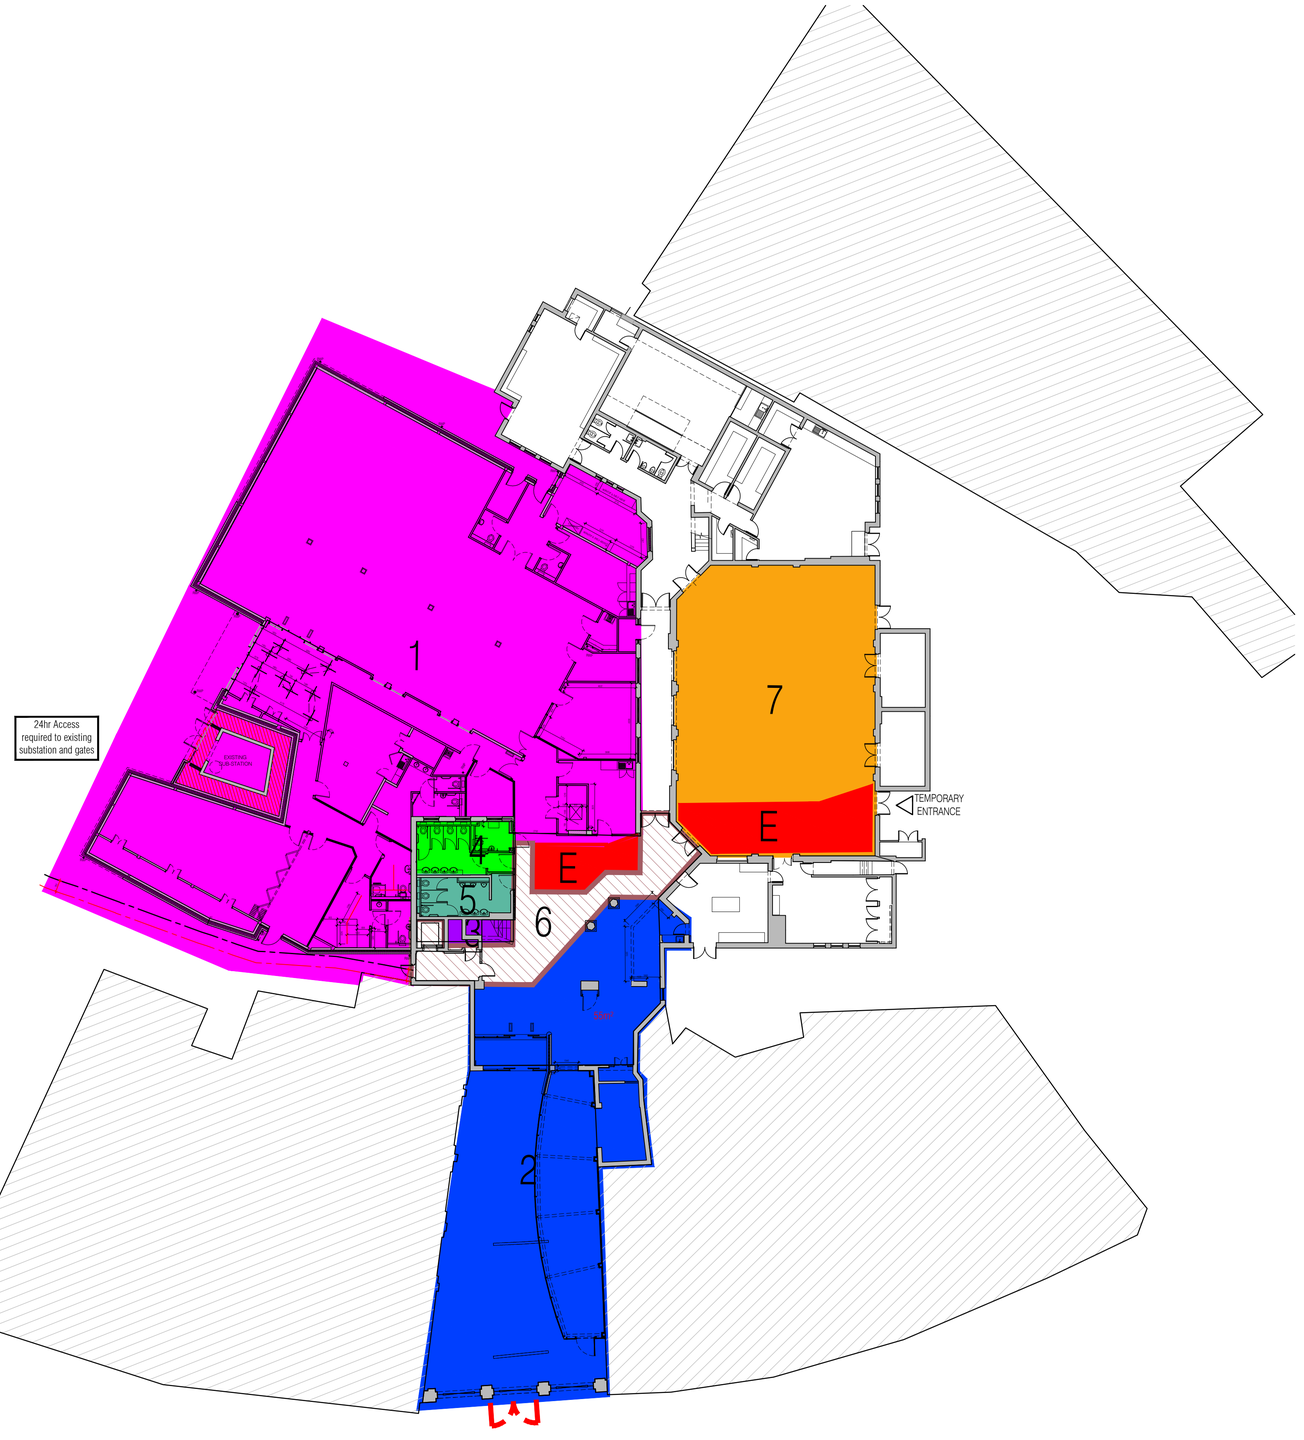


01 / 010 Ground Floor Phasing
Scale:1:200

NB: Contractor to allow for erection or temporary office and internal hoardings out of hours

NOTES: Do not scale this drawing. All dimensions to be checked on site prior to commencement or manufacture.

Key Plan

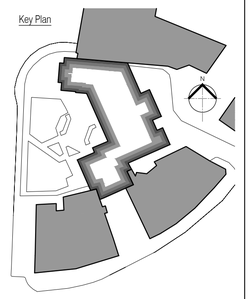

PHASING KEY

For detailed phasing Information refer to Phasing Programme

- Enabling Works (out of hours)
- Phase 1
- Phase 2
- Phase 3
- Phase 4
- Phase 5
- Phase 6
- Phase 7

Scale Bar

0 2 4 6 1:100
0 2 4 6 8 10 12 1:200

ISSUED FOR CONSTRUCTION

Rev	Date	By	Chk	Comment
C1	03.07.13	RKC	JAS	Issued for CONSTRUCTION

BRINGING IDEAS TO LIFE

FRANKHAM

Frankham Consultancy Group Limited
21 Perrymount Road
Haywards Heath RH16 3TP
t 01444 444900 f 01444 455642
enquire@frankham.com
www.frankham.com

Client

Ealing
www.ealing.gov.uk

Project Title

Dominion Arts Centre
Southall
London


Drawing Title

Construction Phasing Plan

Drawn by:	Scale:	Date:
RKC	Varies@A1	20.02.13
Designed by:	Checked by:	Approved by:
FCG	-	-

File Ref.: K:\2000\0224970 - LB EALING - DOMINION ARTS CENTRE\ARCHIVE_RM_BLOCK AND SITE PLANS\224970-A-011.DWG - 20090111339.4 20:06:11 13:28:56


Drawing No. 224970-A-011 Rev. C1

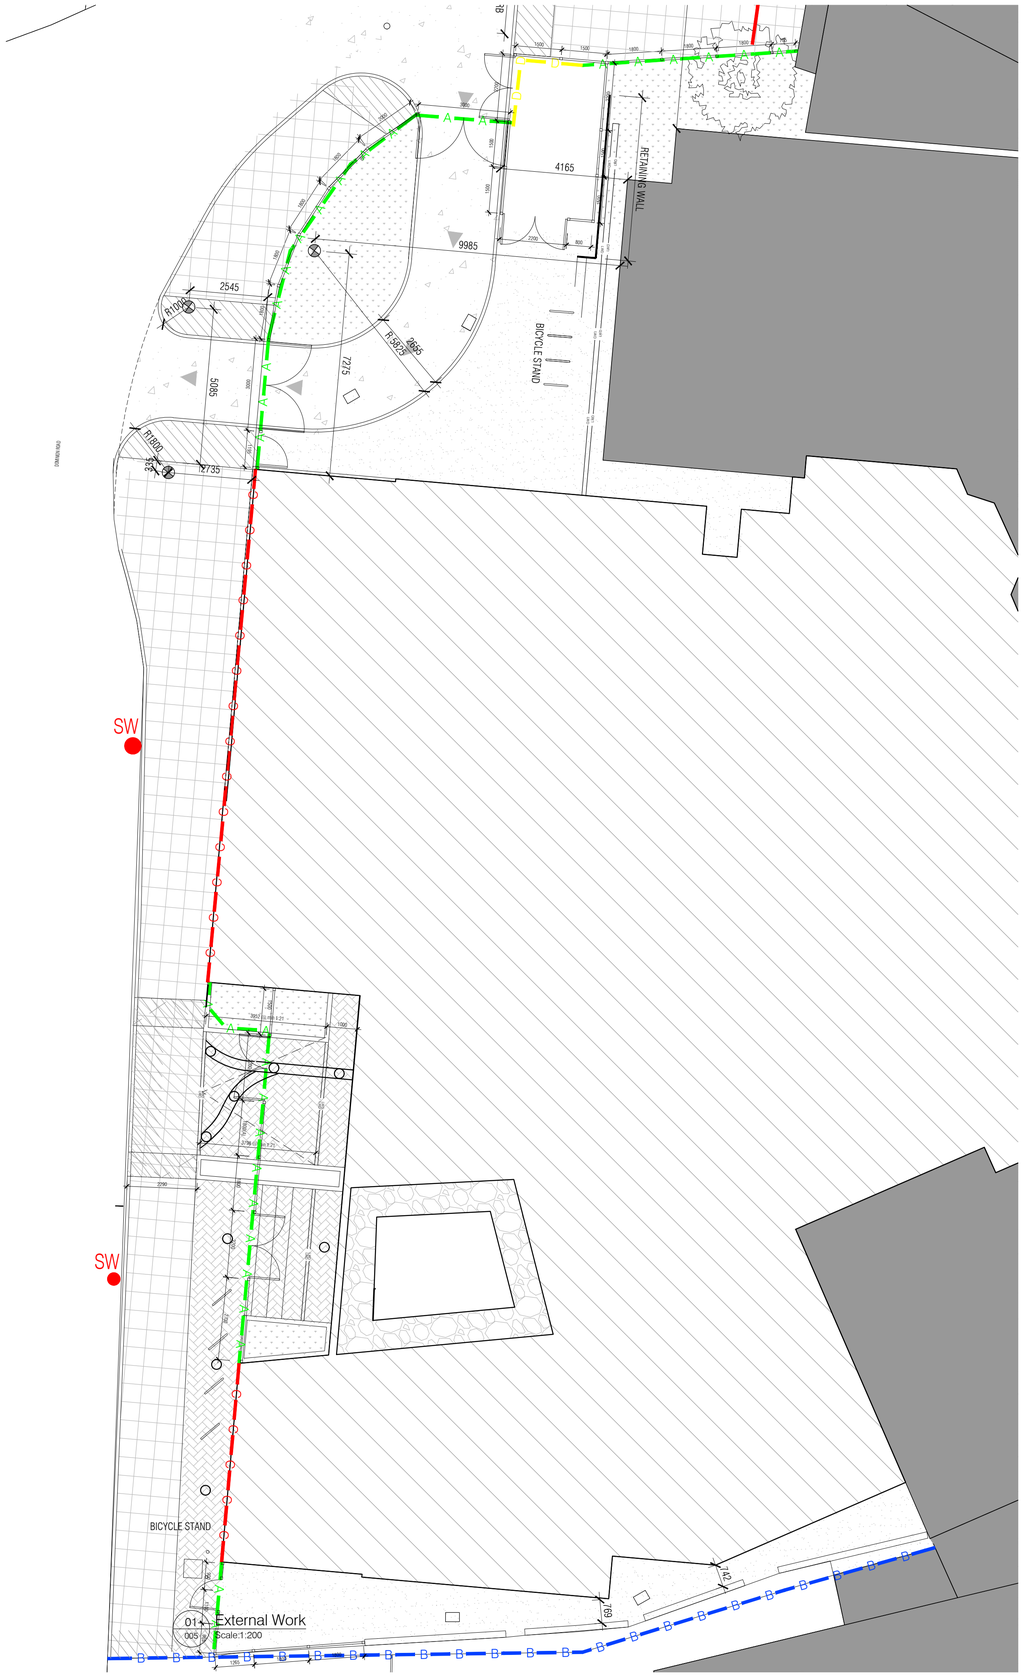



NOTES: Do not scale this drawing. All dimensions to be checked on site prior to commencement or manufacture.

Key Plan

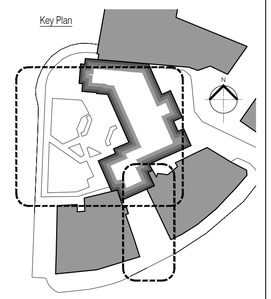

Boundaries Legend

- Denotes Site Ownership Boundary
- Denotes New Building Works Boundary
- A Denotes New fence and gates as 006/011
- B Denotes Existing Fenced Boundary
- C Denotes Proposed Building as Boundary
- D Denotes Binstore Enclosure
- E Denotes Existing Brick Arch & Gates

Scale Bar

0 2 4 6 1:100

0 2 4 6 8 10 12 1:200

ISSUED FOR CONSTRUCTION

Rev	Date	By	Chk	Comment
C1	20.02.14	CH	AC	Issued for CONSTRUCTION

BRINGING IDEAS TO LIFE

FRANKHAM

Frankham Consultancy Group Limited
21 Perrymount Road
Haywards Heath RH16 3TP
t 01444 444900 f 01444 455542
enquire@frankham.com
www.frankham.com

Client

Ealing
www.ealing.gov.uk

Project Title

Dominion Arts Centre
Southall
London

Drawing Title

Proposed
Boundary Treatment Plan


Drawn by:	Scale:	Date:
RKC	1:100@A1	20.02.14
Designed by:	Checked by:	Approved by:
FCG	-	-

File Ref.: X:\2000\2\2401 - LEALNE, DOMINION ARTS CENTRE\ARCH\DOC\BB_BLOCK AND SITE PLANS 2401S-A-012.DWG - 2008/11/20@14:20:06:11:13:29:03

Drawing No.	Rev.
224970-A-012	C1



01 External Work
013 Scale:1:100

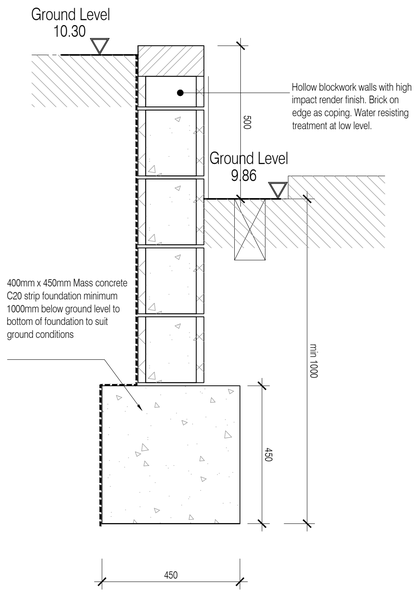




02 External Work
013 Scale:1:100

NOTES: Do not scale this drawing. All dimensions to be checked on site prior to commencement or manufacture.

Key Plan

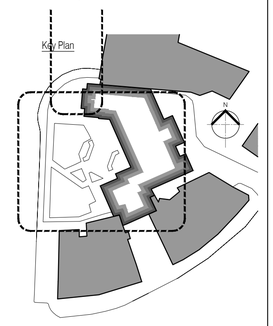

Site Legend

- Denotes new brick pavers
- Denotes grass
- Denotes highways paving slabs
- Denotes tarmac footpath
- Denotes new car park surfacing
- E — Denotes Electrical car charging points. See Electrical Engineers specification
- Denotes tactile paving at vehicle crossing points
- Denotes gravel with terram underlay
- Denotes Electrical Car charging point
- Denotes lampost car park lighting

Boundaries Legend

- Denotes Site Ownership Boundary
- Denotes New Building Works Boundary

Scale Bar

0 2 4 6 1:100
0 2 4 6 8 10 12 1:200

ISSUED FOR CONSTRUCTION

Rev	Date	By	Chk	Comment
C1	08.05.14	CH	AC	Issued for CONSTRUCTION

BRINGING IDEAS TO LIFE

FRANKHAM

Frankham Consultancy Group Limited
21 Perrymount Road
Haywards Heath RH16 3TP
t 01444 444900 f 01444 455842
enquire@frankham.com
www.frankham.com

Client: Ealing — www.ealing.gov.uk

Project Title
Dominion Arts Centre
Southall
London


Drawing Title
Proposed
External Works Plan
Car Park Setting Out

Drawn by:	Scale:	Date:
RKC	1:100@A1	08.05.14
Designed by:	Checked by:	Approved by:
FCG	-	-

File Ref.: K:\2008\224970 - LB EALING - DOMINION ARTS CENTRE\ARCH\DB_BIM_BLOCK AND SITE PLANS 224970-A-013.DWG - 20080113SH9 20:06:11 13:29:10

Drawing No. 224970-A-013 Rev. C1

For continuation, please refer to dwg: 224970-A-101

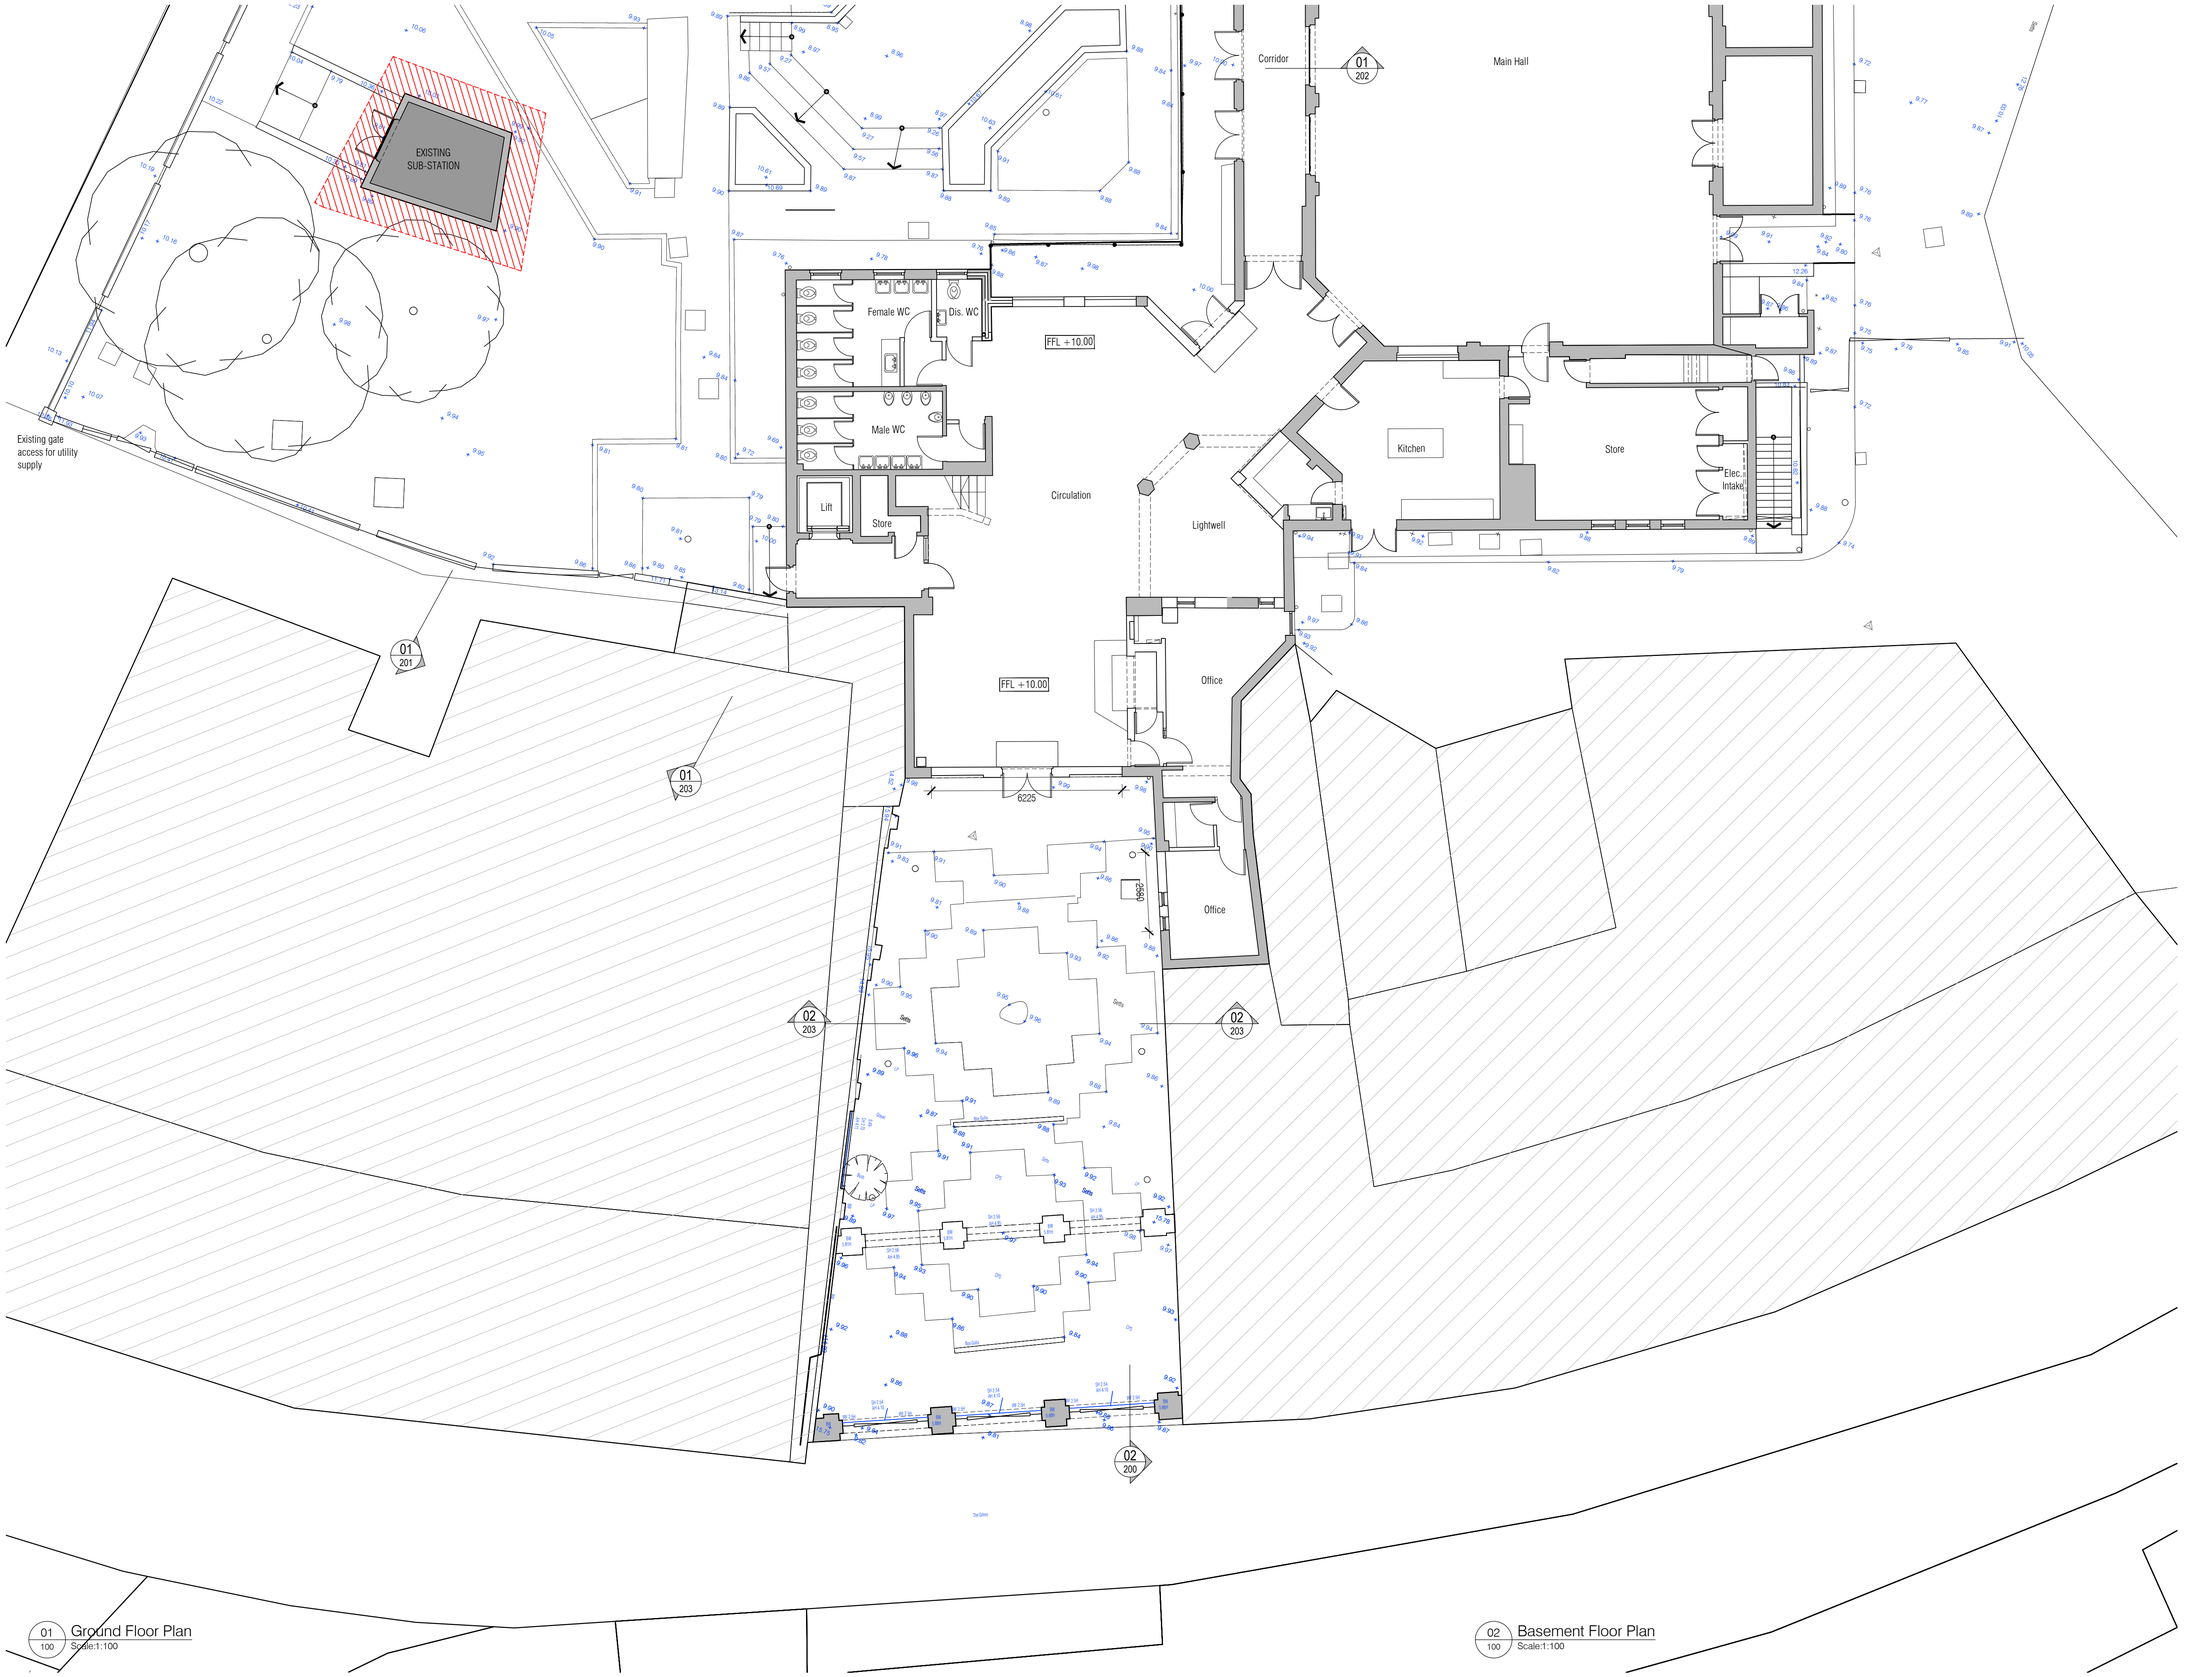


01 100 Ground Floor Plan
Scale:1:100

02 100 Basement Floor Plan
Scale:1:100

NOTES: Do not scale this drawing. All dimensions to be checked on site prior to commencement or manufacture.

Key Plan

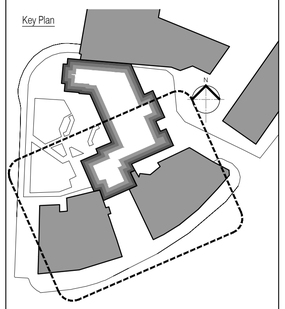

Scale Bar

0 1 2 3 1:50
0 2 4 6 1:100

ISSUED FOR CONSTRUCTION

Rev	Date	By	Chk	Comment
C1	03.07.13	RKC	JAS	Issued for CONSTRUCTION

BRINGING IDEAS TO LIFE

FRANKHAM

Frankham Consultancy Group Limited
21 Perrymount Road
Haywards Heath RH16 3TP
t 01444 444900 f 01444 455642
enquire@frankham.com
www.frankham.com

Client
Ealing
www.ealing.gov.uk

Project Title
Dominion Arts Centre
Southall
London

Drawing Title
Existing Ground Floor Plan
1 of 2


Drawn by:	Scale:	Date:
RKC	1:100@A1	07.12.12
Designed by:	Checked by:	Approved by:
FCG	-	-

File Ref.: X:\2008\2224970 - LB EALING - DOMINION ARTS CENTRE\ARCH\1SE_1BI_LOCATION PLANS AND ISA - 224970-A-100.DWG - 20/06/2011 13:29:32

Drawing No. 224970-A-100
Rev. C1

NOTES: Do not scale this drawing. All dimensions to be checked on site prior to commencement or manufacture.

Key Plan

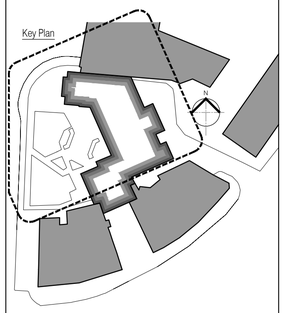

Scale Bar

0 1 2 3 1:50

0 2 4 6 1:100

ISSUED FOR CONSTRUCTION

Rev	Date	By	Chk	Comment
C1	03.07.13	RKC	JAS	Issued for CONSTRUCTION

BRINGING IDEAS TO LIFE

FRANKHAM

Frankham Consultancy Group Limited
21 Perrymount Road
Haywards Heath RH16 3TP
t 01444 444900 f 01444 455642
enquire@frankham.com
www.frankham.com

Client

Ealing
www.ealing.gov.uk

Project Title

Dominion Arts Centre
Southall
London

Drawing Title

Existing Ground Floor Plan
2 of 2

Drawn by:	Scale:	Date:
RKC	1:100@A1	07.12.12
Designed by:	Checked by:	Approved by:
FCG	-	-


File Ref.: H:\2009\224970 - LEALING - DOMINION ARTS CENTRE\ARCH\3D_19\ LOCATION PLANS AND GA\ 224970-A-101.DWG - 2008111250\8 20:06:11 13/09/29

Drawing No. 224970-A-101 Rev. C1

01 - Existing Ground Floor Plan
Scale:1:100

For continuation, please refer to dwg: 224970-A-100




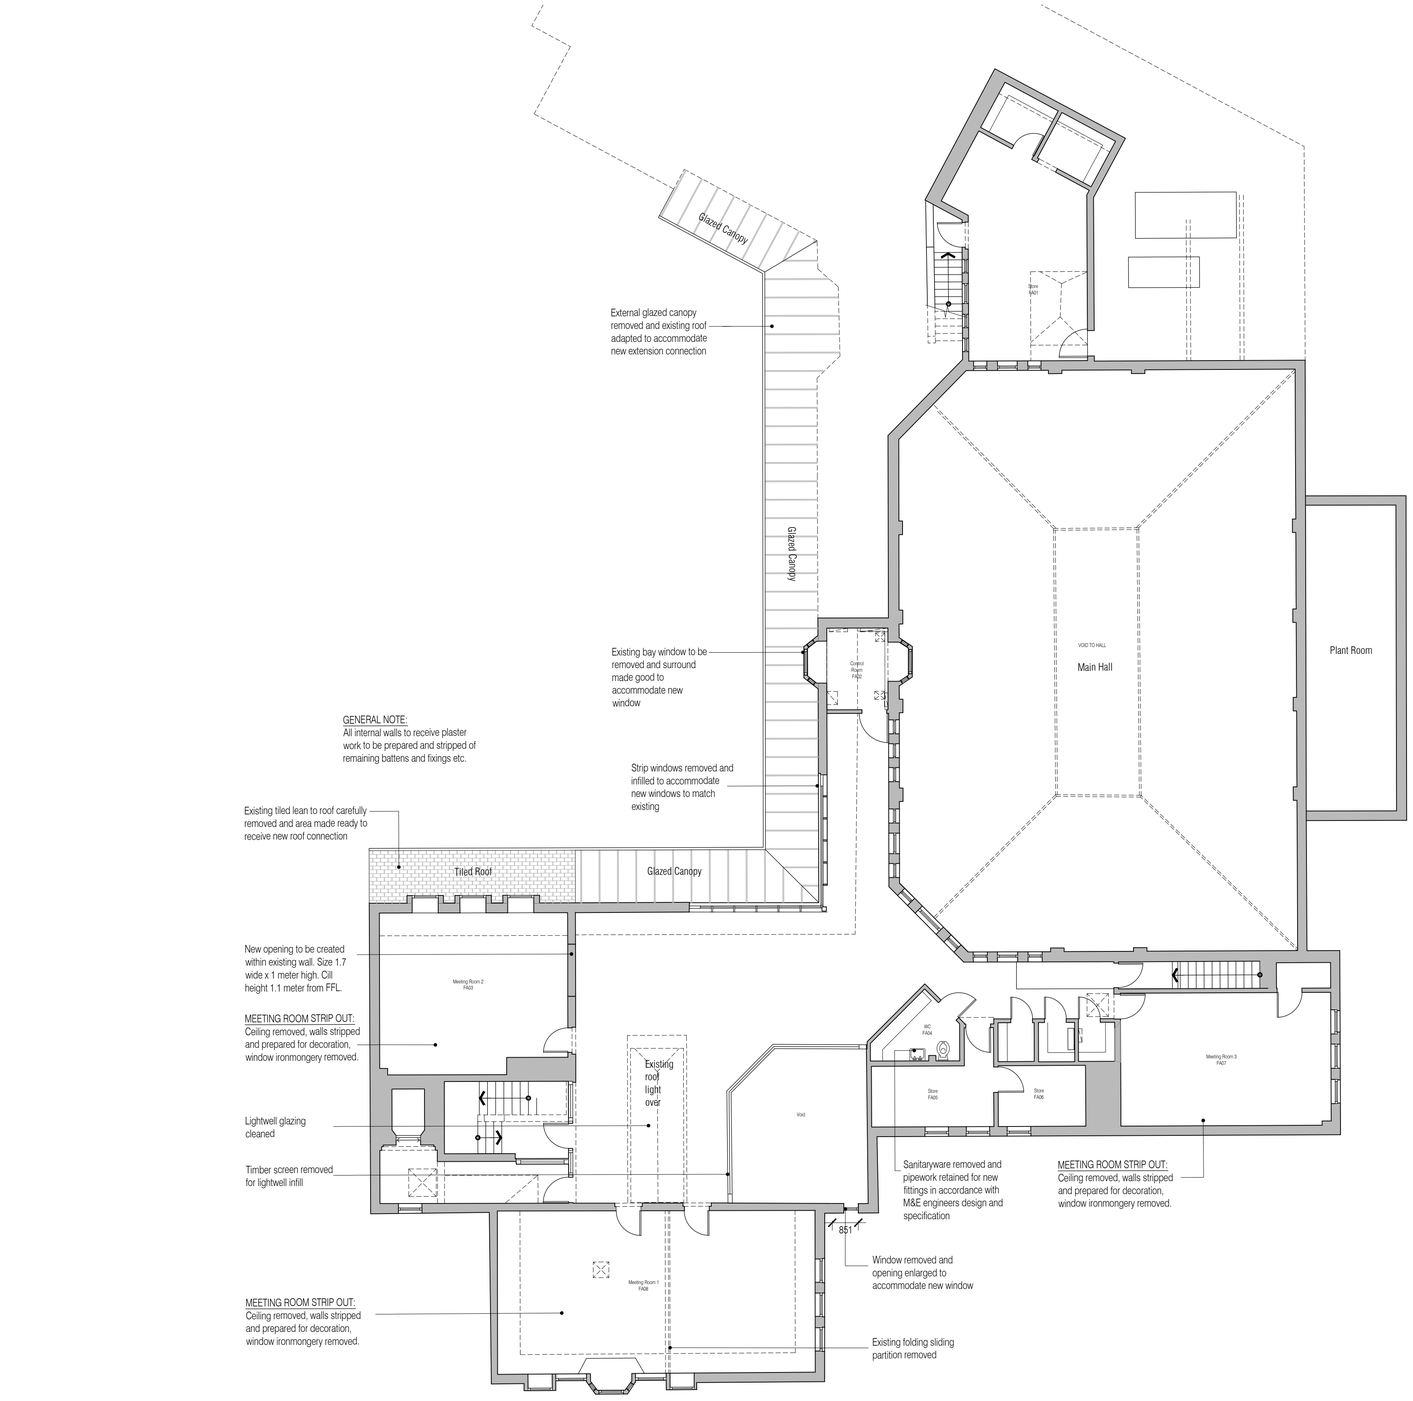

01 - Existing First Floor Plan
Scale:1:100

NOTES: Do not scale this drawing. All dimensions to be checked on site prior to commencement or manufacture.

Key Plan
(nts)

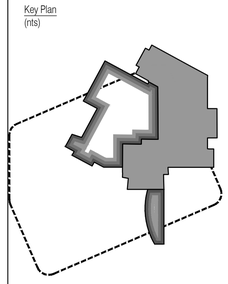

Scale Bar

0 1 2 3 1:50
0 2 4 6 1:100

ISSUED FOR CONSTRUCTION

Rev	Date	By	Chk	Comment
C1	03.07.13	RKC	JAS	Issued for CONSTRUCTION

BRINGING IDEAS TO LIFE

FRANKHAM

Frankham Consultancy Group Limited
21 Perrymount Road
Haywards Heath RH16 3TP
t 01444 444900 f 01444 455642
enquire@frankham.com
www.frankham.com

Client
Ealing
www.ealing.gov.uk

Project Title
Dominion Arts Centre
Southall
London


Drawing Title
Existing First Floor Plan

Drawn by:	Scale:	Date:
RKC	1:100@A1	08.12.12
Designed by:	Checked by:	Approved by:
FCG	-	-

File Ref.: X:\2000\224970 - LB EALING - DOMINION ARTS CENTRE\ARCH\10_19_LOCATION PLANS AND GA\ 224970-A-102.DWG - 20061113\294

Drawing No. 224970-A-102
Rev. C1

For continuation, please refer to dwg: 224970-A-111

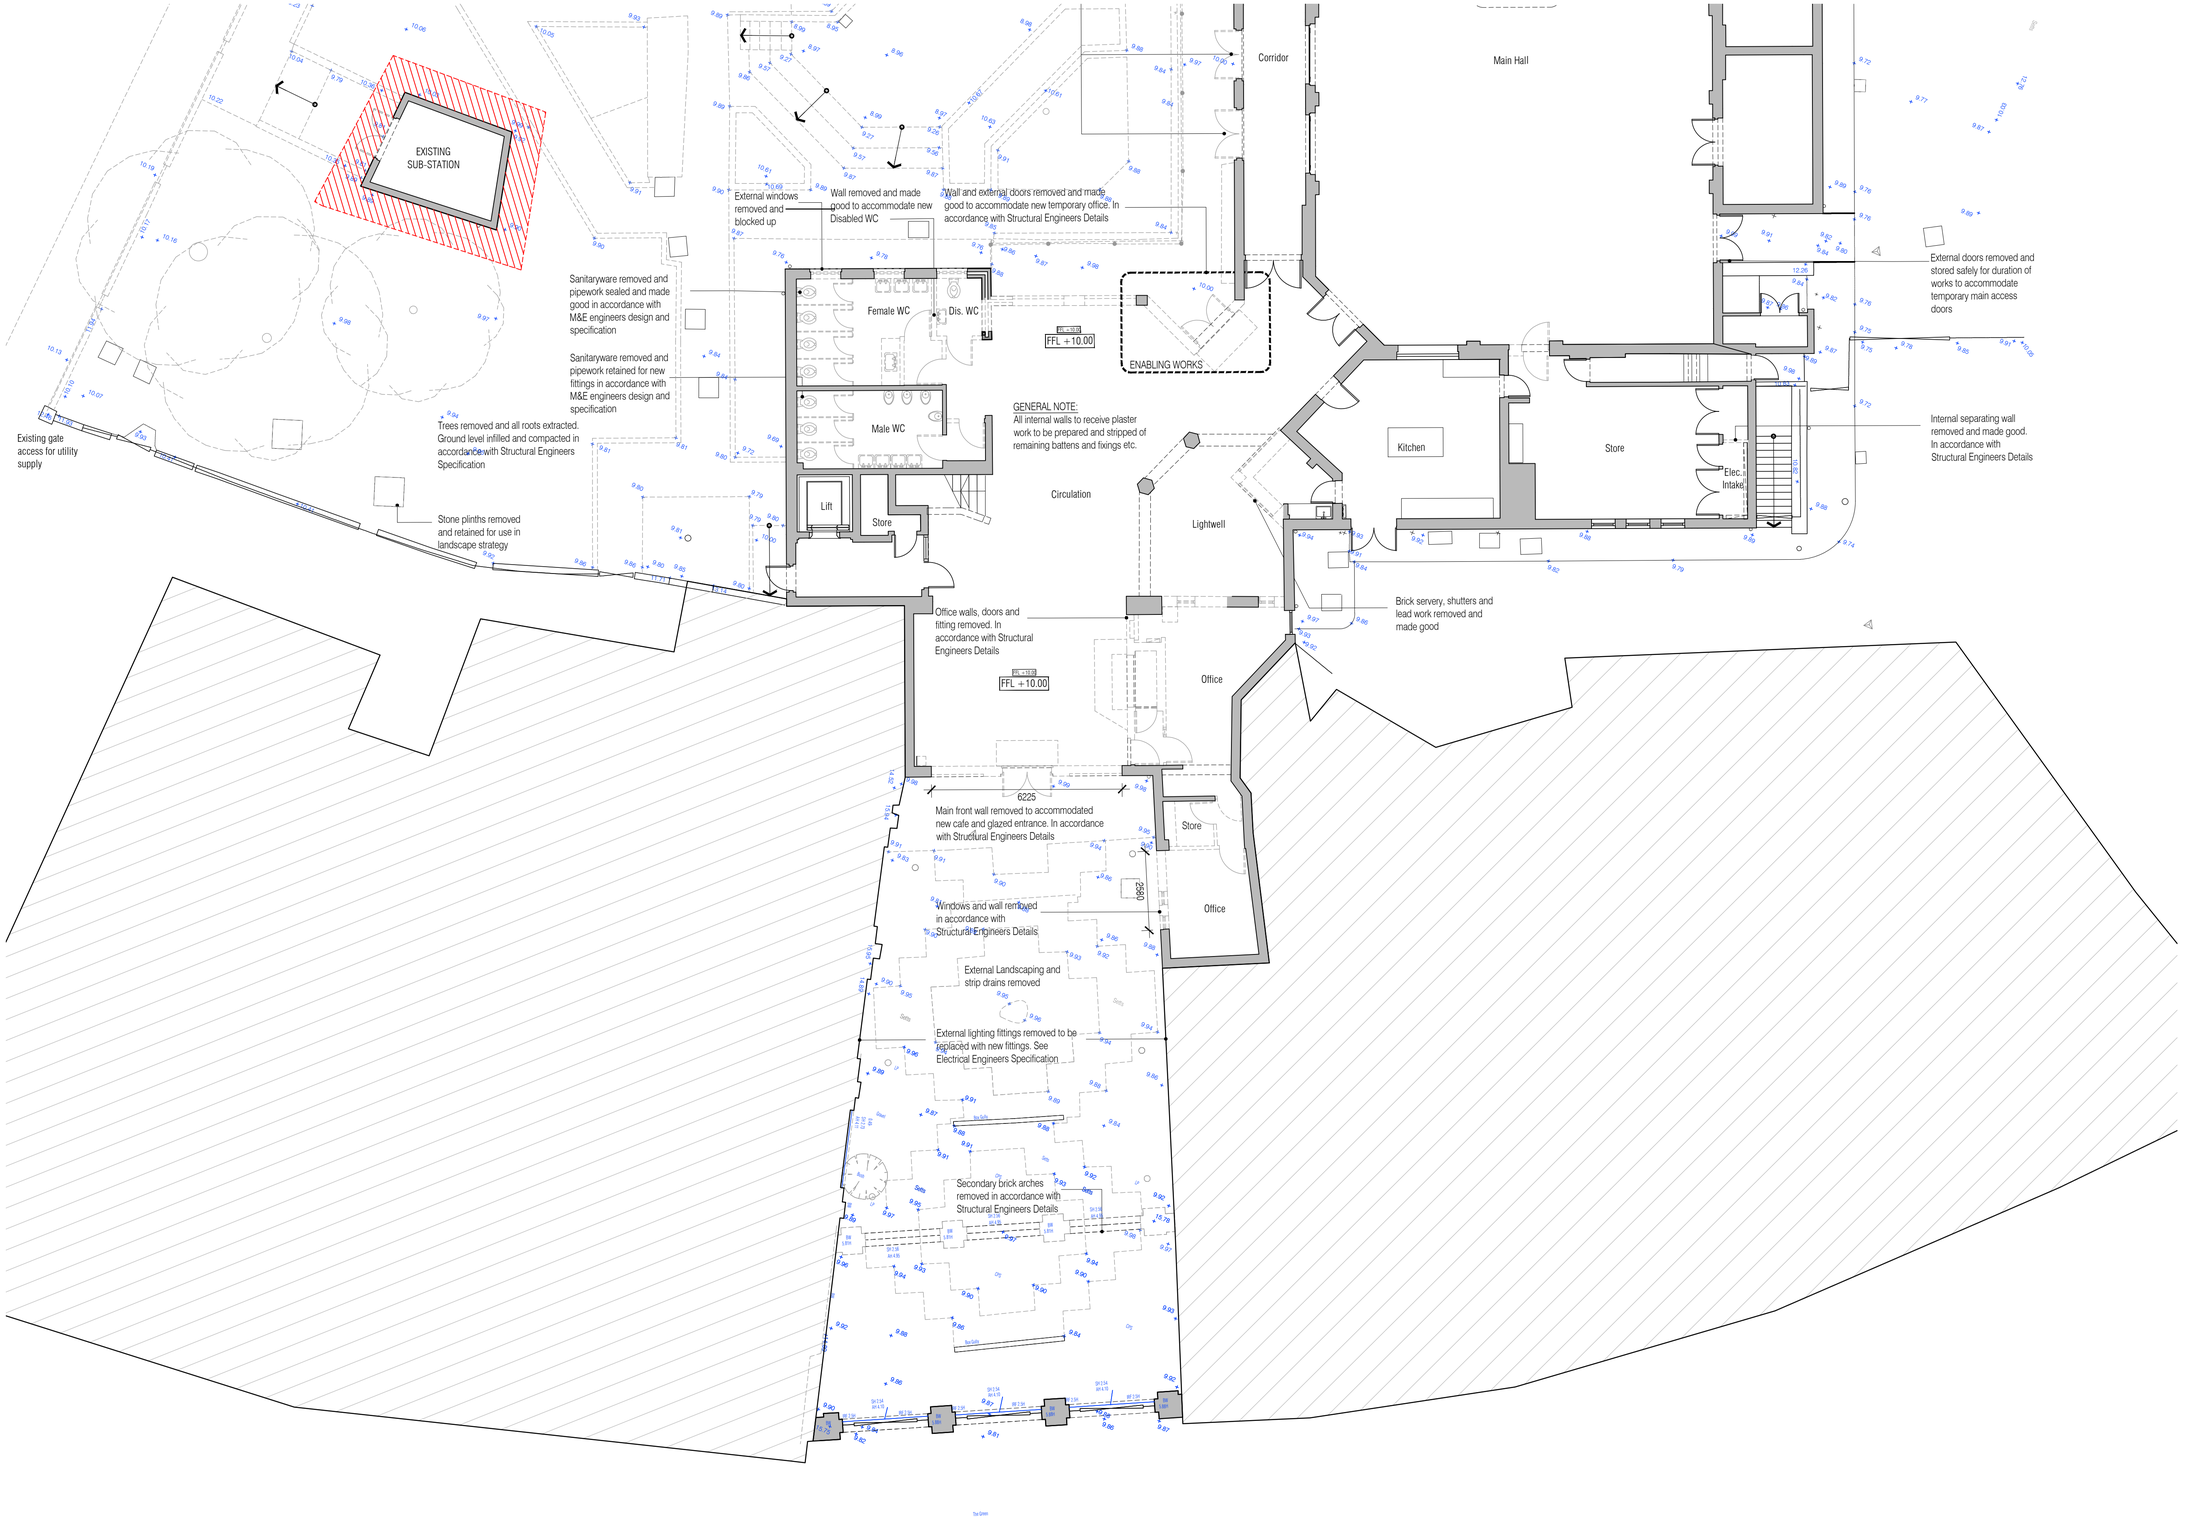


01 Proposed Ground Level Demolition Plan
Scale:1:100


NOTES: Do not scale this drawing. All dimensions to be checked on site prior to commencement or manufacture.

Key Plan

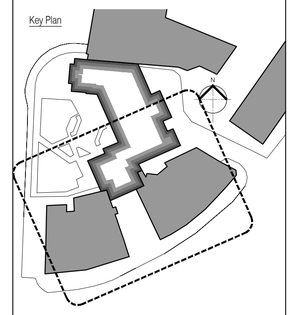

Demolition Note:
All surface water drainage affected by the demolition work to be adopted on a temporary basis as required. Drains to be maintained for as long a s possible.

Scale Bar

0 1 2 3 1:50
0 2 4 6 1:100

ISSUED FOR CONSTRUCTION

Rev	Date	By	Chk	Comment
C1	03.07.13	RKC	JAS	Issued for CONSTRUCTION

BRINGING IDEAS TO LIFE

FRANKHAM

Frankham Consultancy Group Limited
21 Perrymount Road
Haywards Heath RH16 3TP
t 01444 444900 f 01444 456642
enquiries@frankham.com
www.frankham.com

Client
Ealing
www.ealing.gov.uk


Project Title
Dominion Arts Centre
Southall
London

Drawing Title
Proposed
External and Internal Ground Floor
Demolition Plan
1 of 2

Drawn by:	Scale:	Date:
RKC	1:100@A1	07.12.12
Designed by:	Checked by:	Approved by:
FCG	-	-

File Ref.: X:\2000\0224970 - LB EALING - DOMINION ARTS CENTRE\ARCH\100_199_LOCATION PLANS AND GA\...\224970-A-110.DWG - 20/06/2013 12:29:50

Drawing No. 224970-A-110 Rev. C1

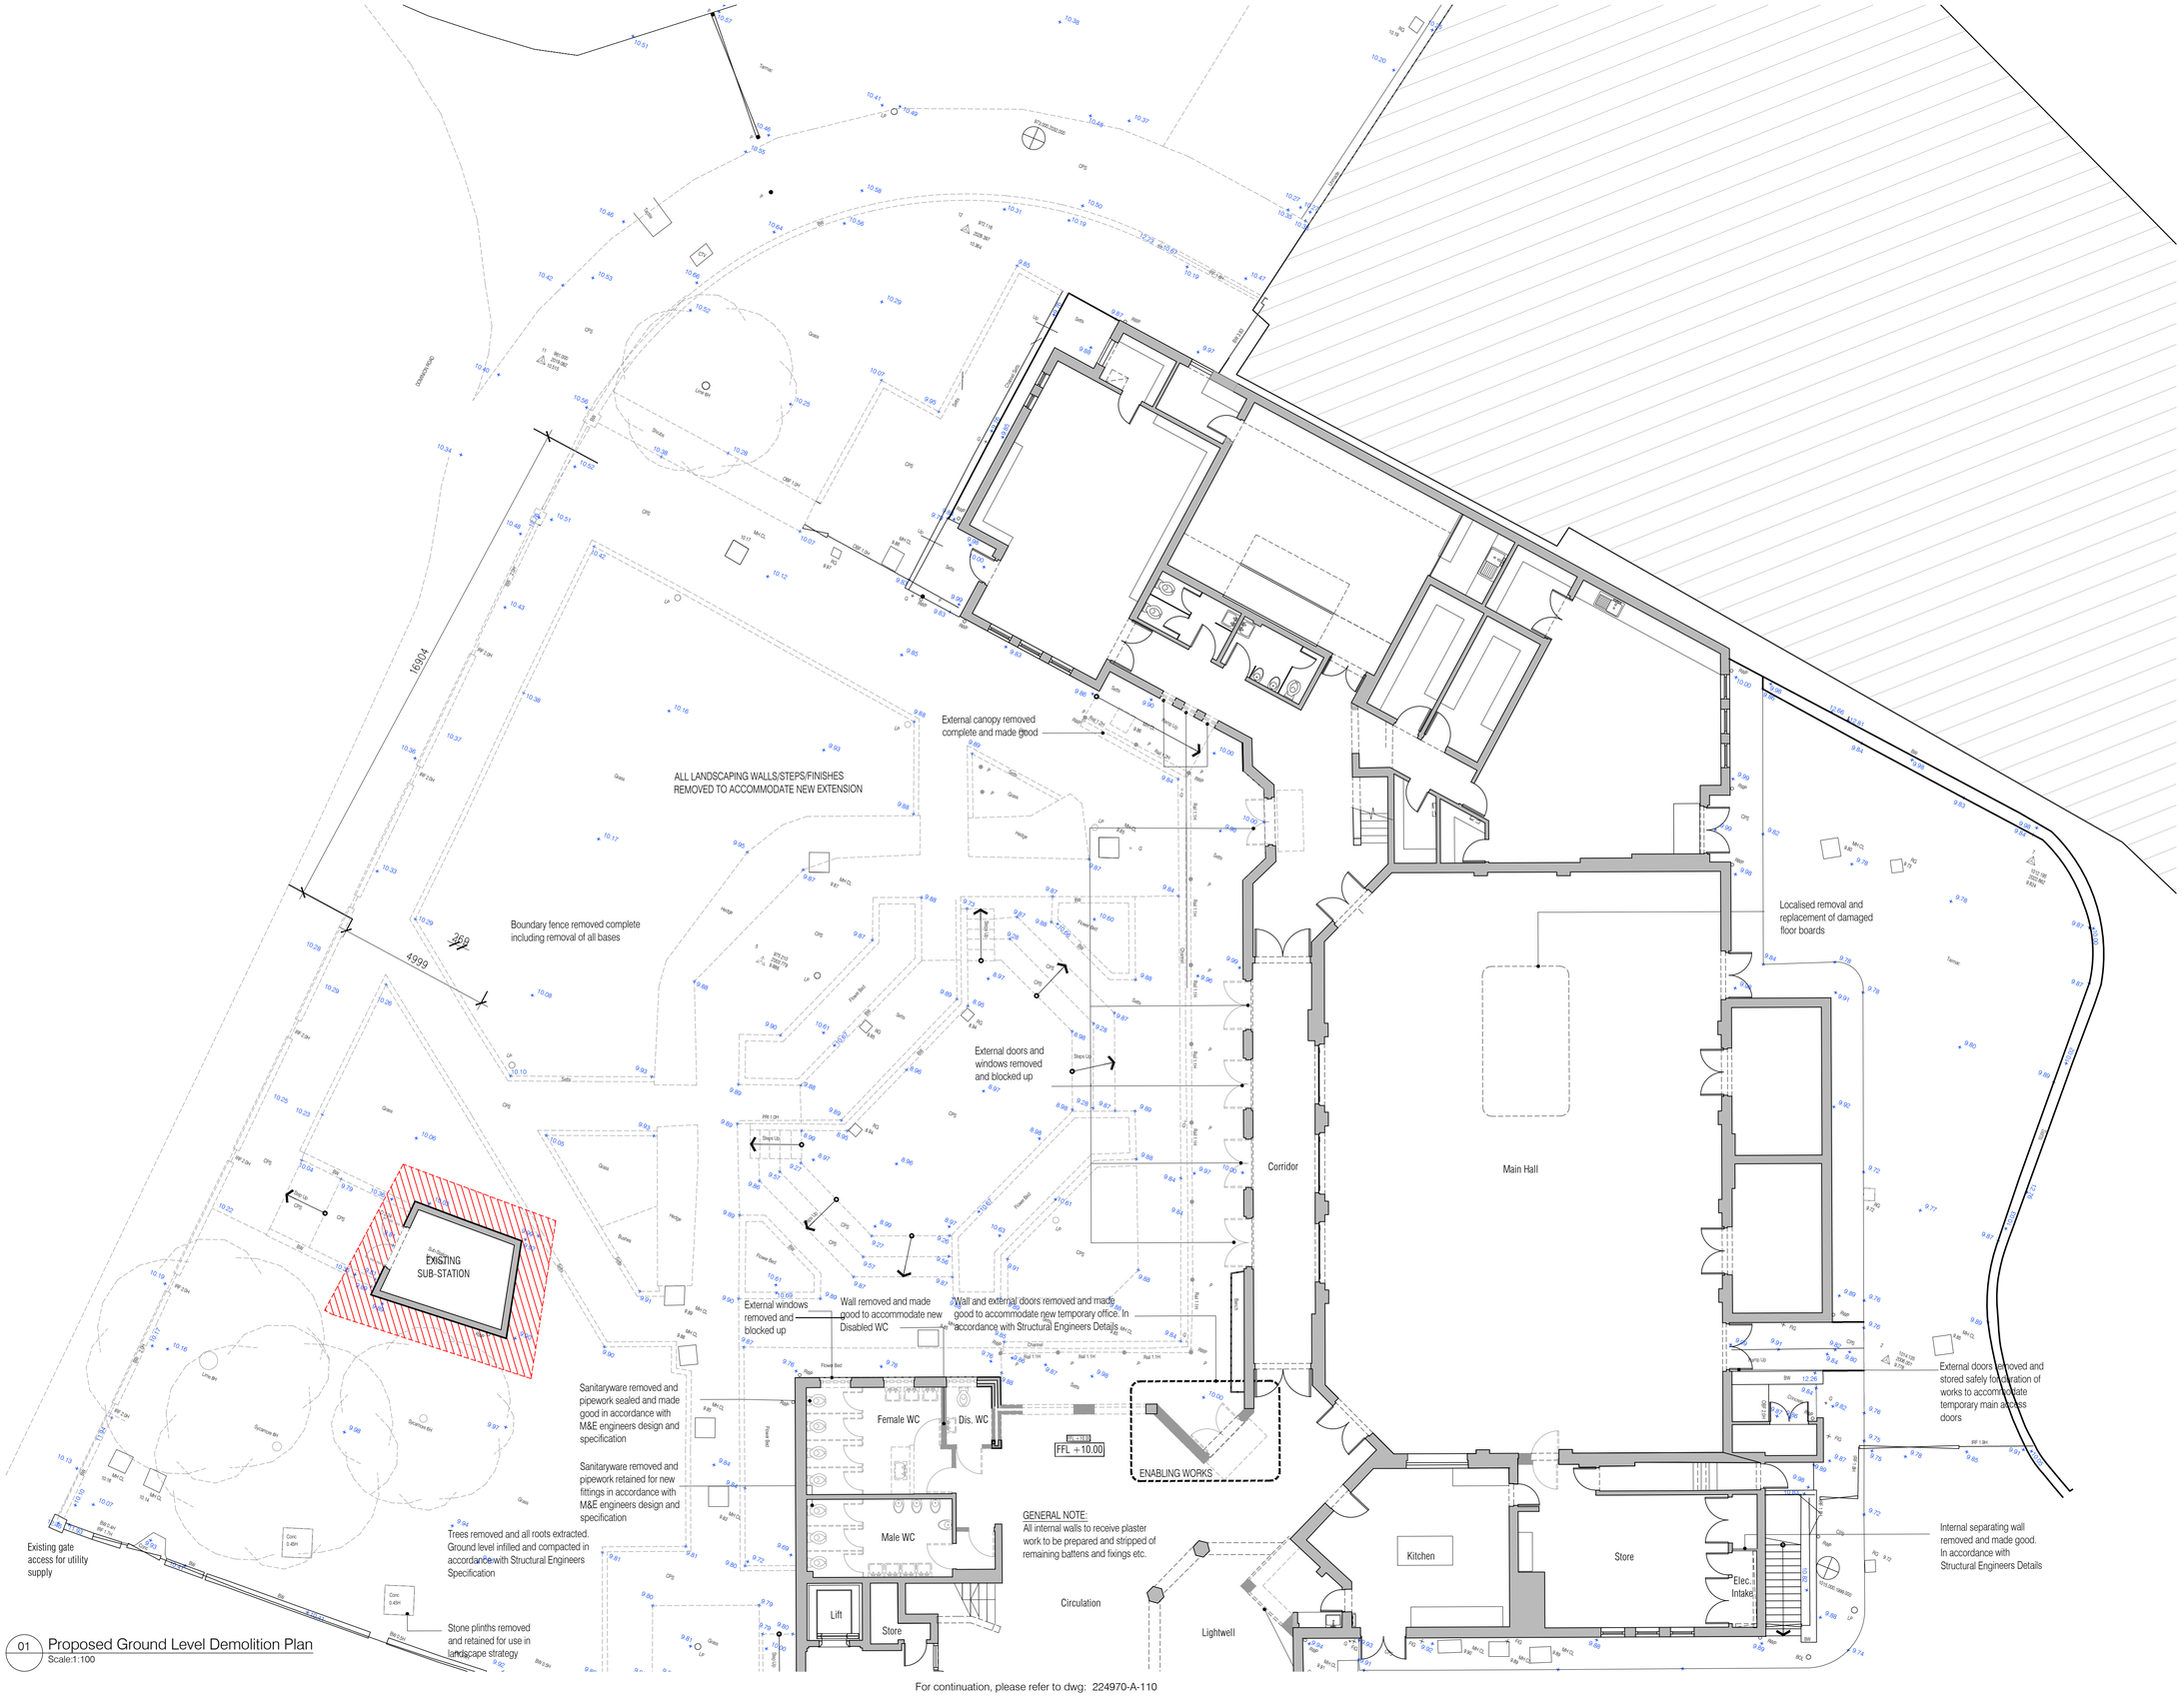


01 Proposed Ground Level Demolition Plan
Scale:1:100

For continuation, please refer to dwg: 224970-A-110

NOTES: Do not scale this drawing. All dimensions to be checked on site prior to commencement or manufacture.

Key Plan

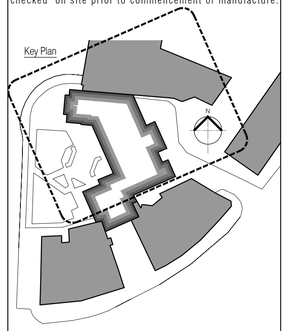

Demolition Note:
All surface water drainage affected by the demolition work to be adopted on a temporary basis as required. Drains to be maintained for as long a s possible.

Scale Bar

0 1 2 3 1:50
0 2 4 6 1:100

ISSUED FOR CONSTRUCTION

Rev	Date	By	Chk	Comment
C1	03.07.13	RKC	JAS	Issued for CONSTRUCTION

BRINGING IDEAS TO LIFE

FRANKHAM

Frankham Consultancy Group Limited
21 Perrymount Road
Haywards Heath RH16 3TP
t 01444 444900 f 01444 455642
enquire@frankham.com
www.frankham.com

Client
Ealing
www.ealing.gov.uk


Project Title
Dominion Arts Centre
Southall
London

Drawing Title
Proposed
External and Internal Ground Floor
Demolition Plan
2 of 2

Drawn by:	Scale:	Date:
RKC	1:100@A1	07.12.12
Designed by:	Checked by:	Approved by:
FCG	-	-

File Ref.: H:\2009\224970 - LEALING - DOMINION ARTS CENTRE\ARCH\3D_19_LOCATION PLANS AND GA\224970-A-111.DWG - 2009111700S 20:06:11 13/09/55


Drawing No. 224970-A-111 Rev. C1

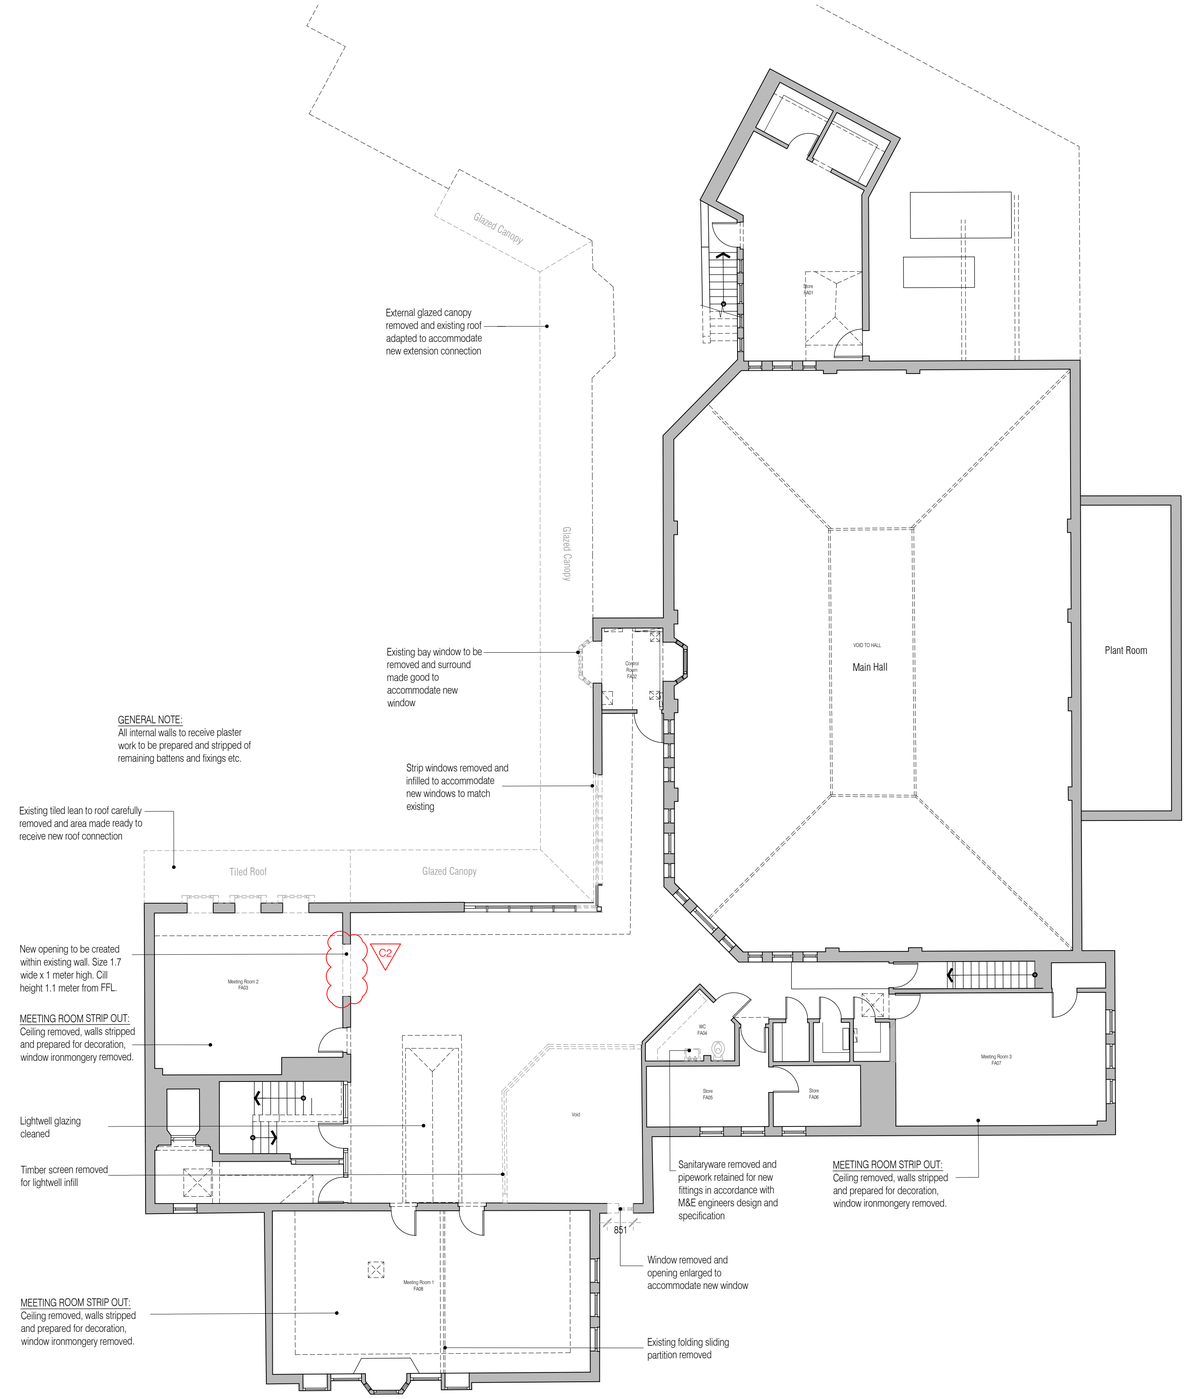

01 Proposed First Floor Demolition Plan
Scale:1:100

NOTES: Do not scale this drawing. All dimensions to be checked on site prior to commencement or manufacture.

Key Plan
(nts)

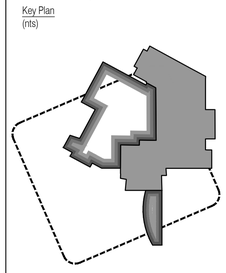

Demolition Note:
All surface water drainage affected by the demolition work to be adopted on a temporary basis as required. Drains to be maintained for as long a s possible.

Scale Bar

0 1 2 3 1:50
0 2 4 6 1:100

ISSUED FOR CONSTRUCTION

REVISION ISSUE DATE REQUIRED
REVISED - BUT NOT ISSUED

Rev	Date	By	Chk	Comment
C2		PR	AC	Openings added
C1	03.07.13	RKC	JAS	Issued for CONSTRUCTION

BRINGING IDEAS TO LIFE

FRANKHAM

Frankham Consultancy Group Limited
21 Perrymount Road
Haywards Heath RH16 3TP
t 01444 444900 f 01444 455642
enquire@frankham.com
www.frankham.com

Client
Ealing
www.ealing.gov.uk

Project Title
Dominion Arts Centre
Southall
London


Drawing Title
Proposed
First Floor
Demolition Plan

Drawn by:	Scale:	Date:
RKC	1:100@A1	08.12.12
Designed by:	Checked by:	Approved by:
FCG	-	-

File Ref.: X:\2008\224970 - LB EALING - DOMINION ARTS CENTRE\ARCH\10_1B_LOCATION PLANS AND GA\ 224970-A-112.DWG - 20061113

Drawing No. 224970-A-112
Rev. C2

For continuation, please refer to dwg: 224970-A-121

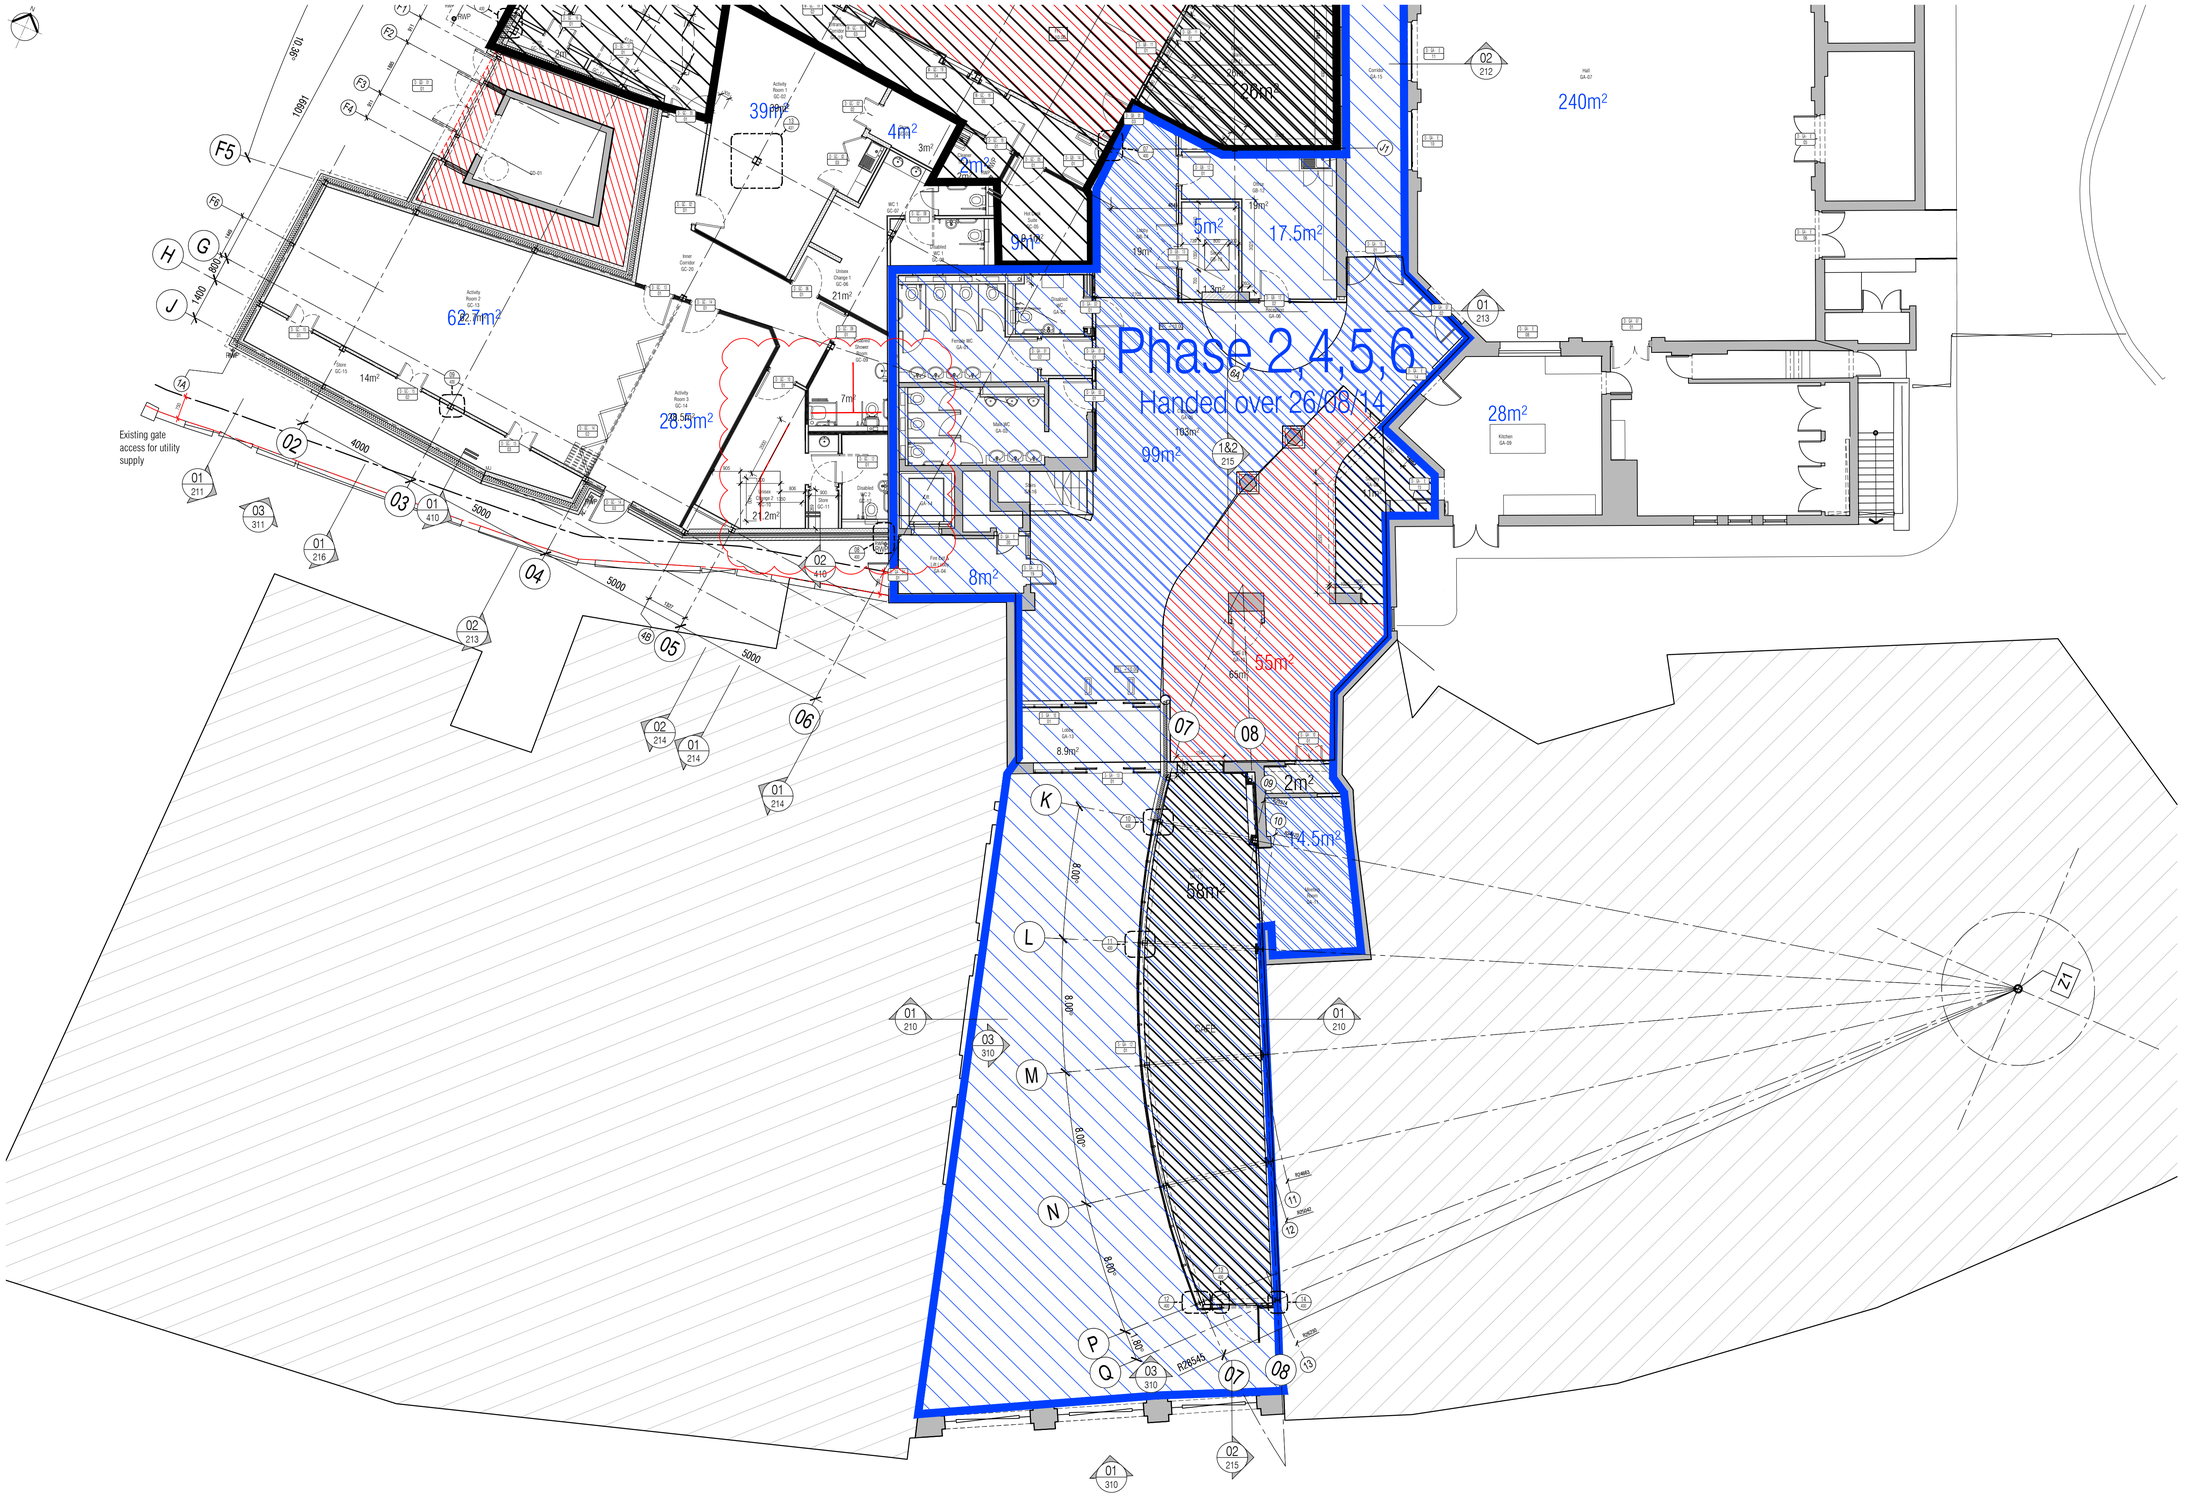


01 / 120 Ground Floor Plan Plan
Scale:1:100

02 / 120 Basement Floor Plan
Scale:1:100

NOTES: Do not scale this drawing. All dimensions to be checked on site prior to commencement or manufacture.

Key Plan

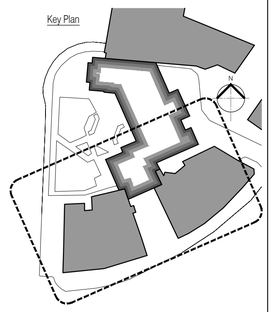

All steelwork to be erected in accordance with Structural Engineer's design and specification. For all steelwork information inc. bracing, refer to Structural Engineers drawings

Opening Reference Legend

Denotes floor level — Denotes room n°

Denotes opening type: Door, Window, Screen — D - P13 — 0 — Denotes opening n°

ISSUED FOR CONSTRUCTION

Rev	Date	By	Chk	Comment
C12	11.08.14	CH	AC	Room areas added
C11	29.04.14	CH	AC	GC-11 adjusted
C10	24.01.14	CH	AC	Server Room adjusted
C9	23.01.14	CH	AC	Server room adjusted
C8	23.01.14	CH	AC	Server Room adjusted

BRINGING IDEAS TO LIFE

FRANKHAM

Frankham Consultancy Group Limited
21 Perrymount Road
Haywards Heath RH16 3TP
t 01444 444900 f 01444 455642
enquire@frankham.com
www.frankham.com

Client: Ealing — www.ealing.gov.uk

Project Title: Dominion Arts Centre, Southall, London

Drawing Title: Proposed Ground Floor Plan 1 of 2


Drawn by:	Scale:	Date:
RKC	1:100@A1	07.12.12
Designed by:	Checked by:	Approved by:
FCG	-	-

File Ref.: K:\2000\[224970 - 2] EALING - DOMINION ARTS CENTRE\ARCH\DB_199_LOCATION PLANS AND GA-224970-A-120.DWG - 20081133010 — 20:06:11 13:30:12

Drawing No. 224970-A-120 — Rev. C12


DOMINION
CENTRE & LIBRARY

For continuation, please refer to dwg: 224970-A-121

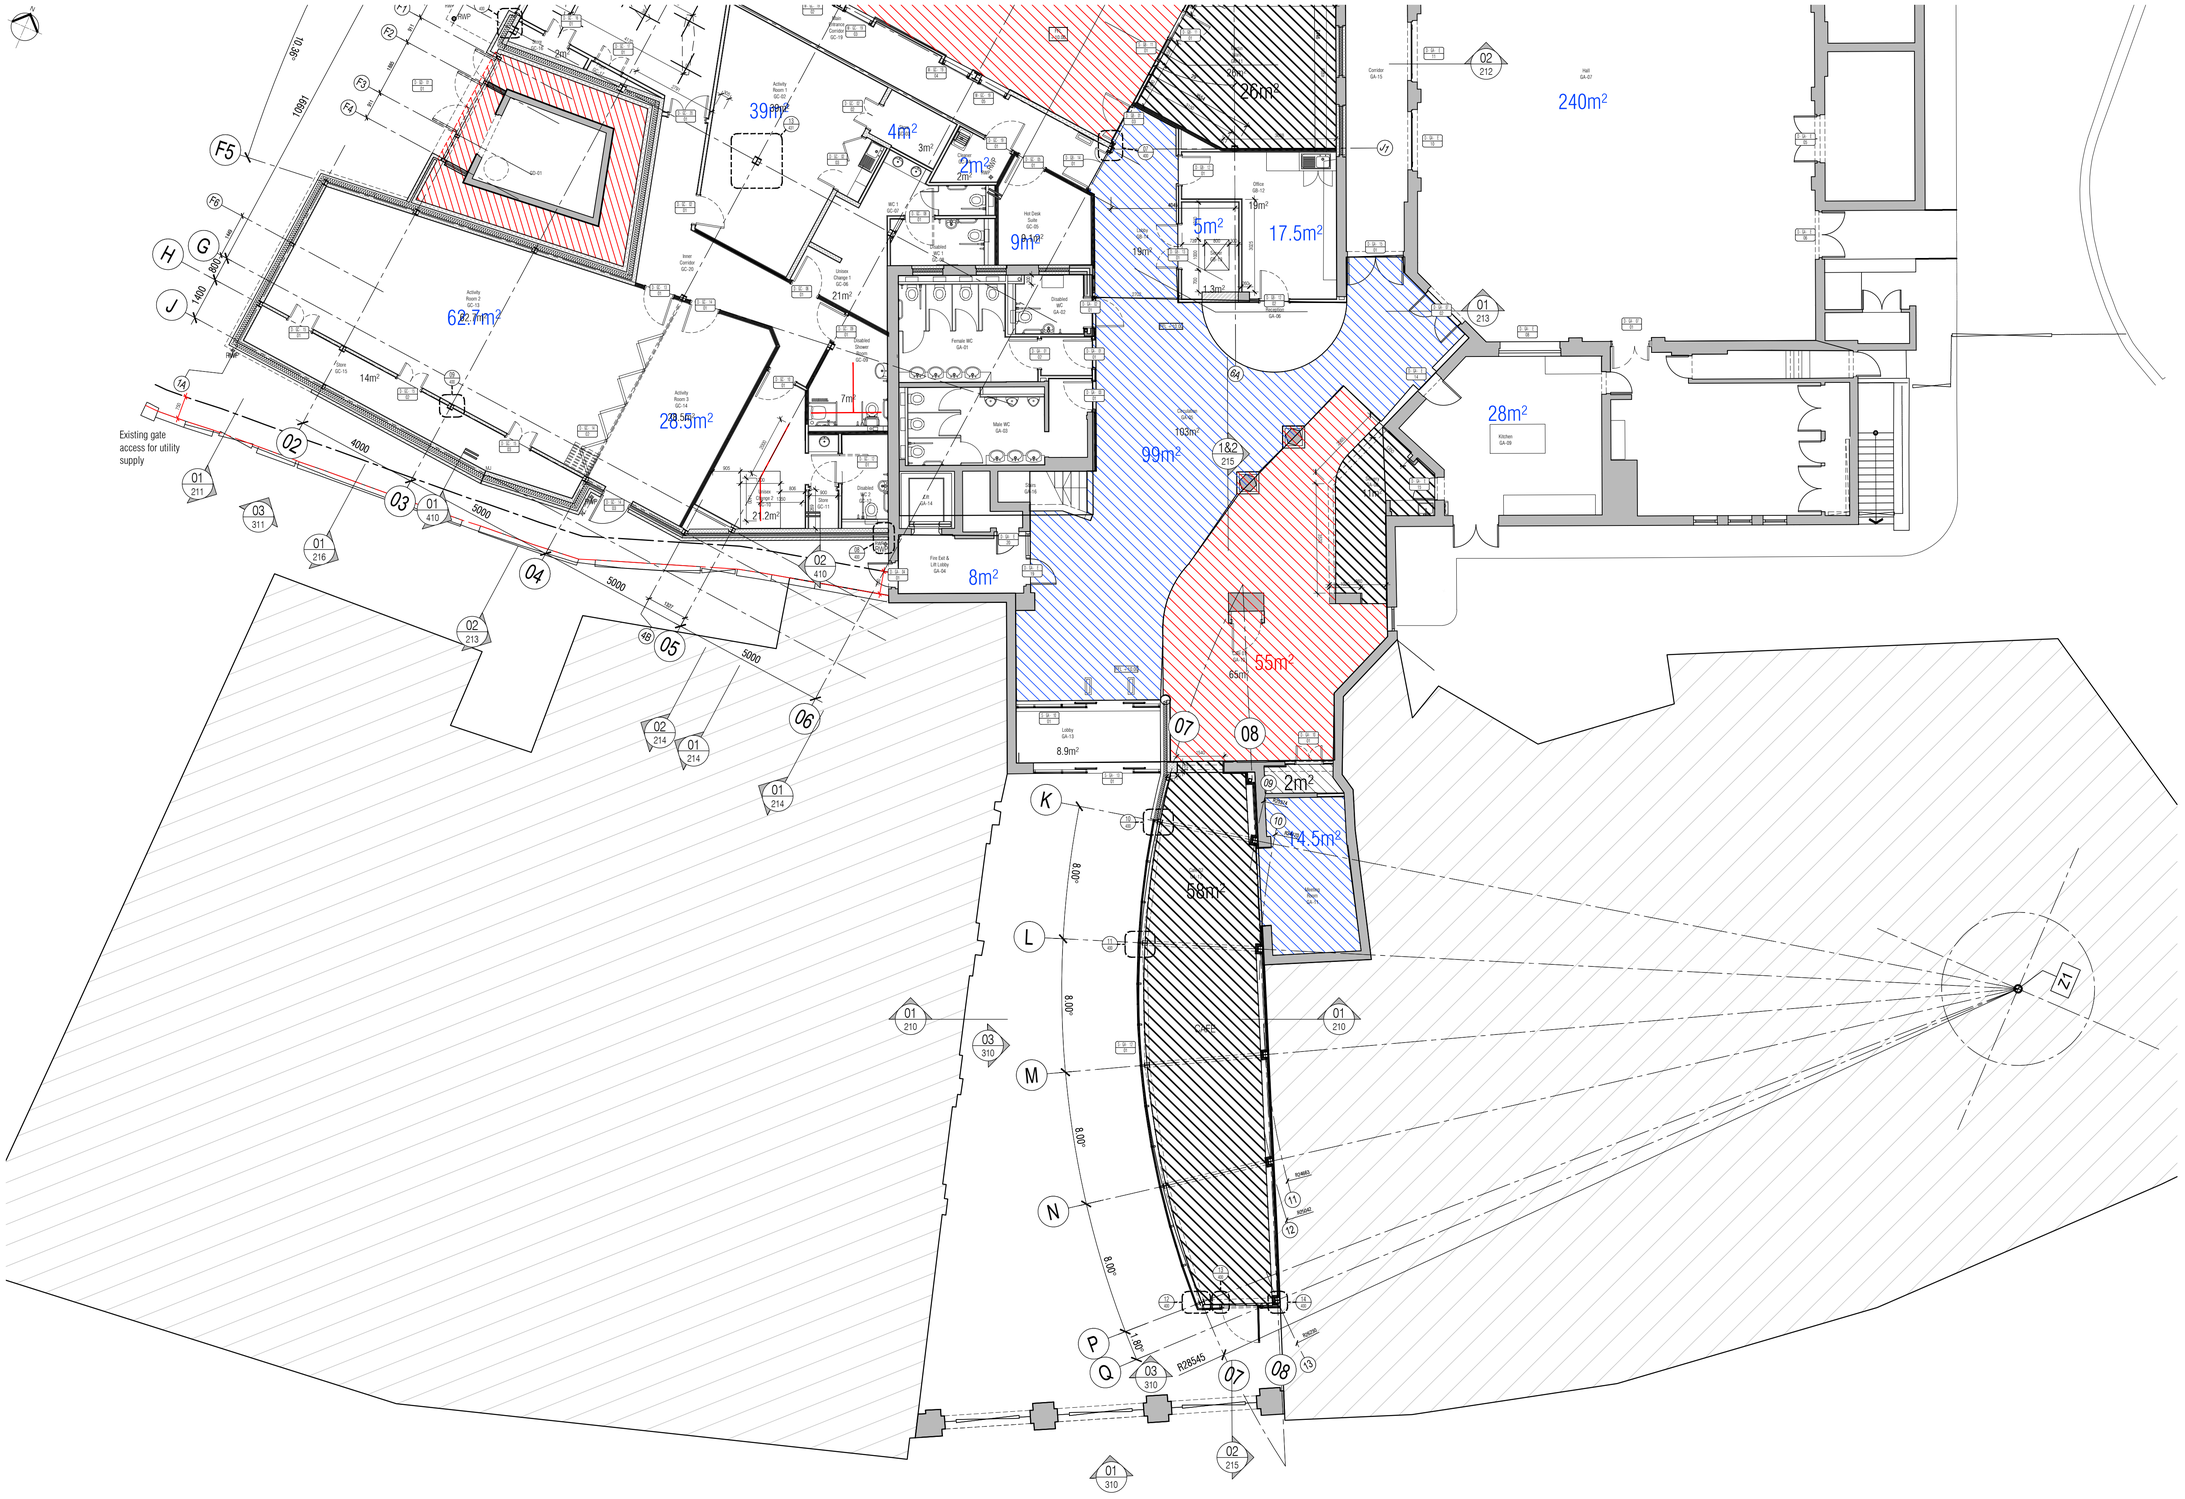


01 / 120 Ground Floor Plan Plan
Scale:1:100

02 / 120 Basement Floor Plan
Scale:1:100

NOTES: Do not scale this drawing. All dimensions to be checked on site prior to commencement or manufacture.

Key Plan

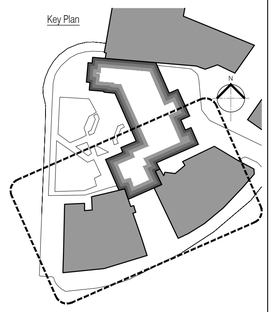

All steelwork to be erected in accordance with Structural Engineer's design and specification. For all steelwork information inc. bracing, refer to Structural Engineers drawings

Opening Reference Legend

Denotes floor level — Denotes room n°

Denotes opening type: Door, Window, Screen — Denotes opening n°

ISSUED FOR CONSTRUCTION

Rev	Date	By	Chk	Comment
C12	11.08.14	CH	AC	Room areas added
C11	29.04.14	CH	AC	GC-11 adjusted
C10	24.01.14	CH	AC	Server Room adjusted
C9	23.01.14	CH	AC	Server room adjusted
C8	23.01.14	CH	AC	Server Room adjusted

BRINGING IDEAS TO LIFE

FRANKHAM

Frankham Consultancy Group Limited
21 Perrymount Road
Haywards Heath RH16 3TP
t 01444 444900 f 01444 455642
enquire@frankham.com
www.frankham.com

Client: Ealing — www.ealing.gov.uk


Project Title: Dominion Arts Centre, Southall, London

Drawing Title: Proposed Ground Floor Plan 1 of 2

Drawn by:	Scale:	Date:
RKC	1:100@A1	07.12.12
Designed by:	Checked by:	Approved by:
FCG	-	-

File Ref.: K:\2000\[224970 - 22 EALING - DOMINION ARTS CENTRE\ARCH\3D_199_LOCATION PLANS AND GA-224970-A-121.DWG - 20080113323 — 20:06:11 13:30:23


Drawing No. 224970-A-121 — Rev. C12

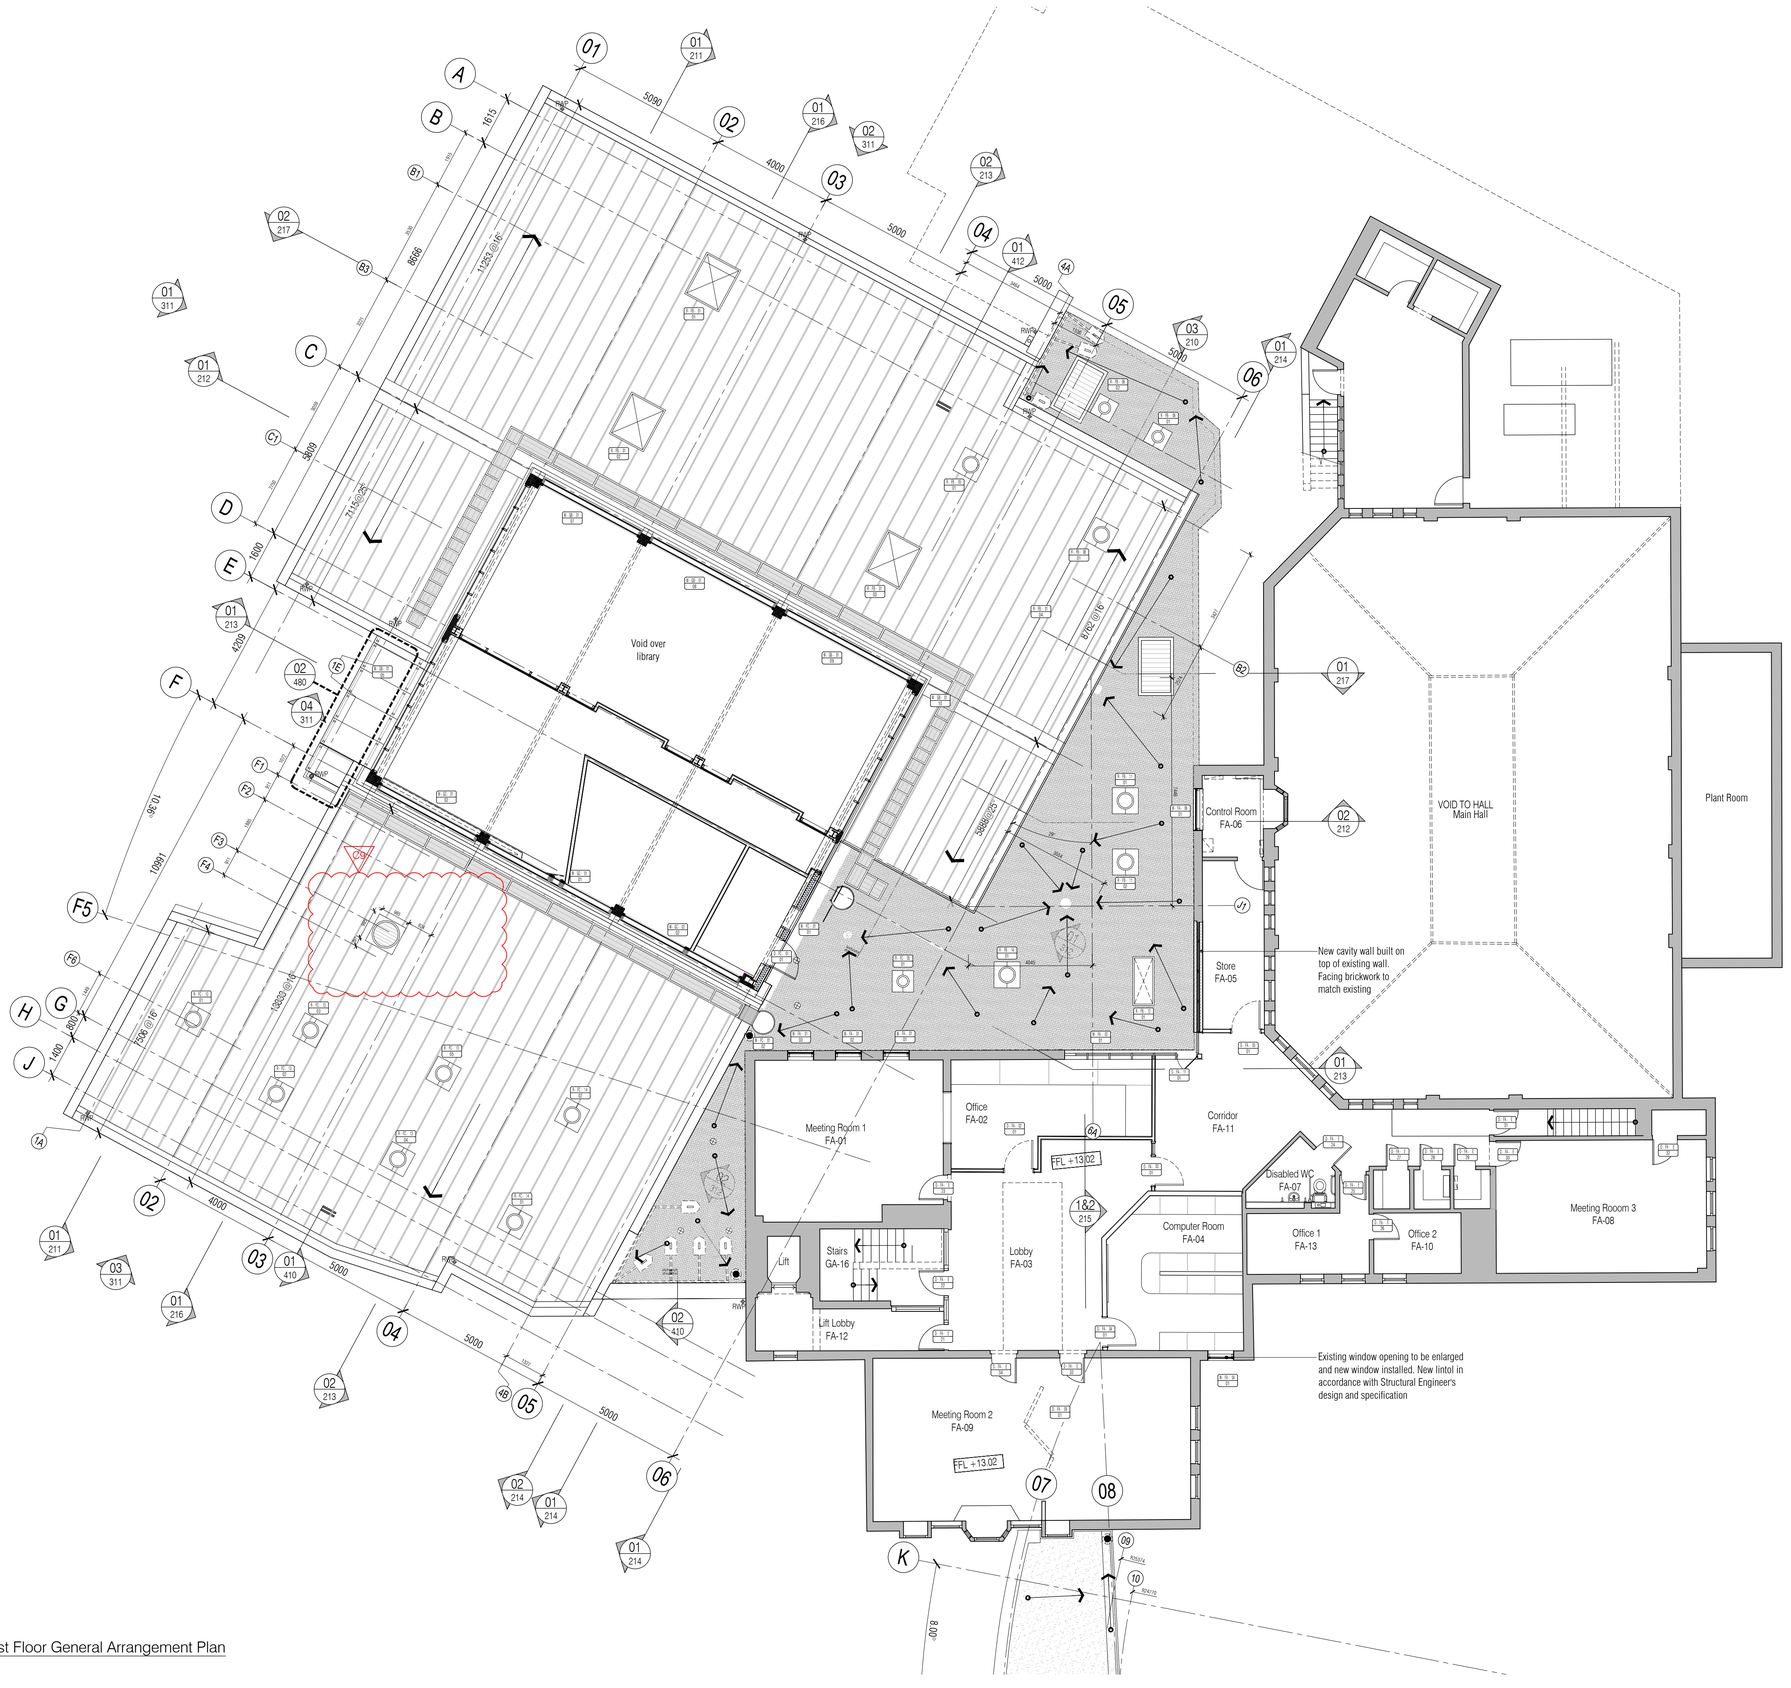

01 Proposed First Floor General Arrangement Plan
Scale:1:100

NOTES: Do not scale this drawing. All dimensions to be checked on site prior to commencement or manufacture.

Key Plan
(nts)

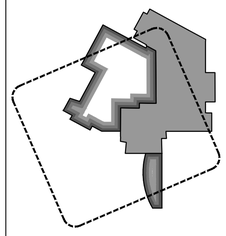

Roof Furniture & Equipment Legend

- Denotes Ventilation plant
- Denotes openable roof light
- Denotes unopeneable roof light
- Denotes roof access cat walk with mansafe accompanyment equipment
  Denotes cat ladder with fall protection cage
- Denotes circular rainwater outlet
- Denotes against wall rainwater outlet

All steelwork to be erected in accordance with Structural Engineer's design and specification. For all steelwork information inc. bracing, refer to Structural Engineers drawings

Opening Reference Legend

Denotes floor level — Denotes room n°
Denotes opening type: Door, Window, Screen — 01 - F13 — 01 — Denotes opening n°

ISSUED FOR CONSTRUCTION

Rev	Date	By	Chk	Comment
C9	20.11.13	CH	AC	Roof cowl adjusted
C8	04.11.13	CH	AC	Parapet adjusted

BRINGING IDEAS TO LIFE

FRANKHAM

Frankham Consultancy Group Limited
21 Perrymount Road
Haywards Heath RH16 3TP
t 01444 444900 f 01444 455642
enquire@frankham.com
www.frankham.com

Client
Ealing
www.ealing.gov.uk


Project Title
Dominion Arts Centre
Southall
London


Drawing Title
Proposed
First Floor
General Arrangement
Plan

Drawn by:	Scale:	Date:
RKC	1:100@A1	08.12.12
Designed by:	Checked by:	Approved by:
FCG	-	-

File Ref.: X:\2008\0224970 - LB EALING - DOMINION ARTS CENTRE\ARCH\TDD_10B_LOCATION PLANS AND GA - 224970-A-122.DWG - 20081112834
20/06/11/13 30:36

Drawing No. 224970-A-122
Rev. C9

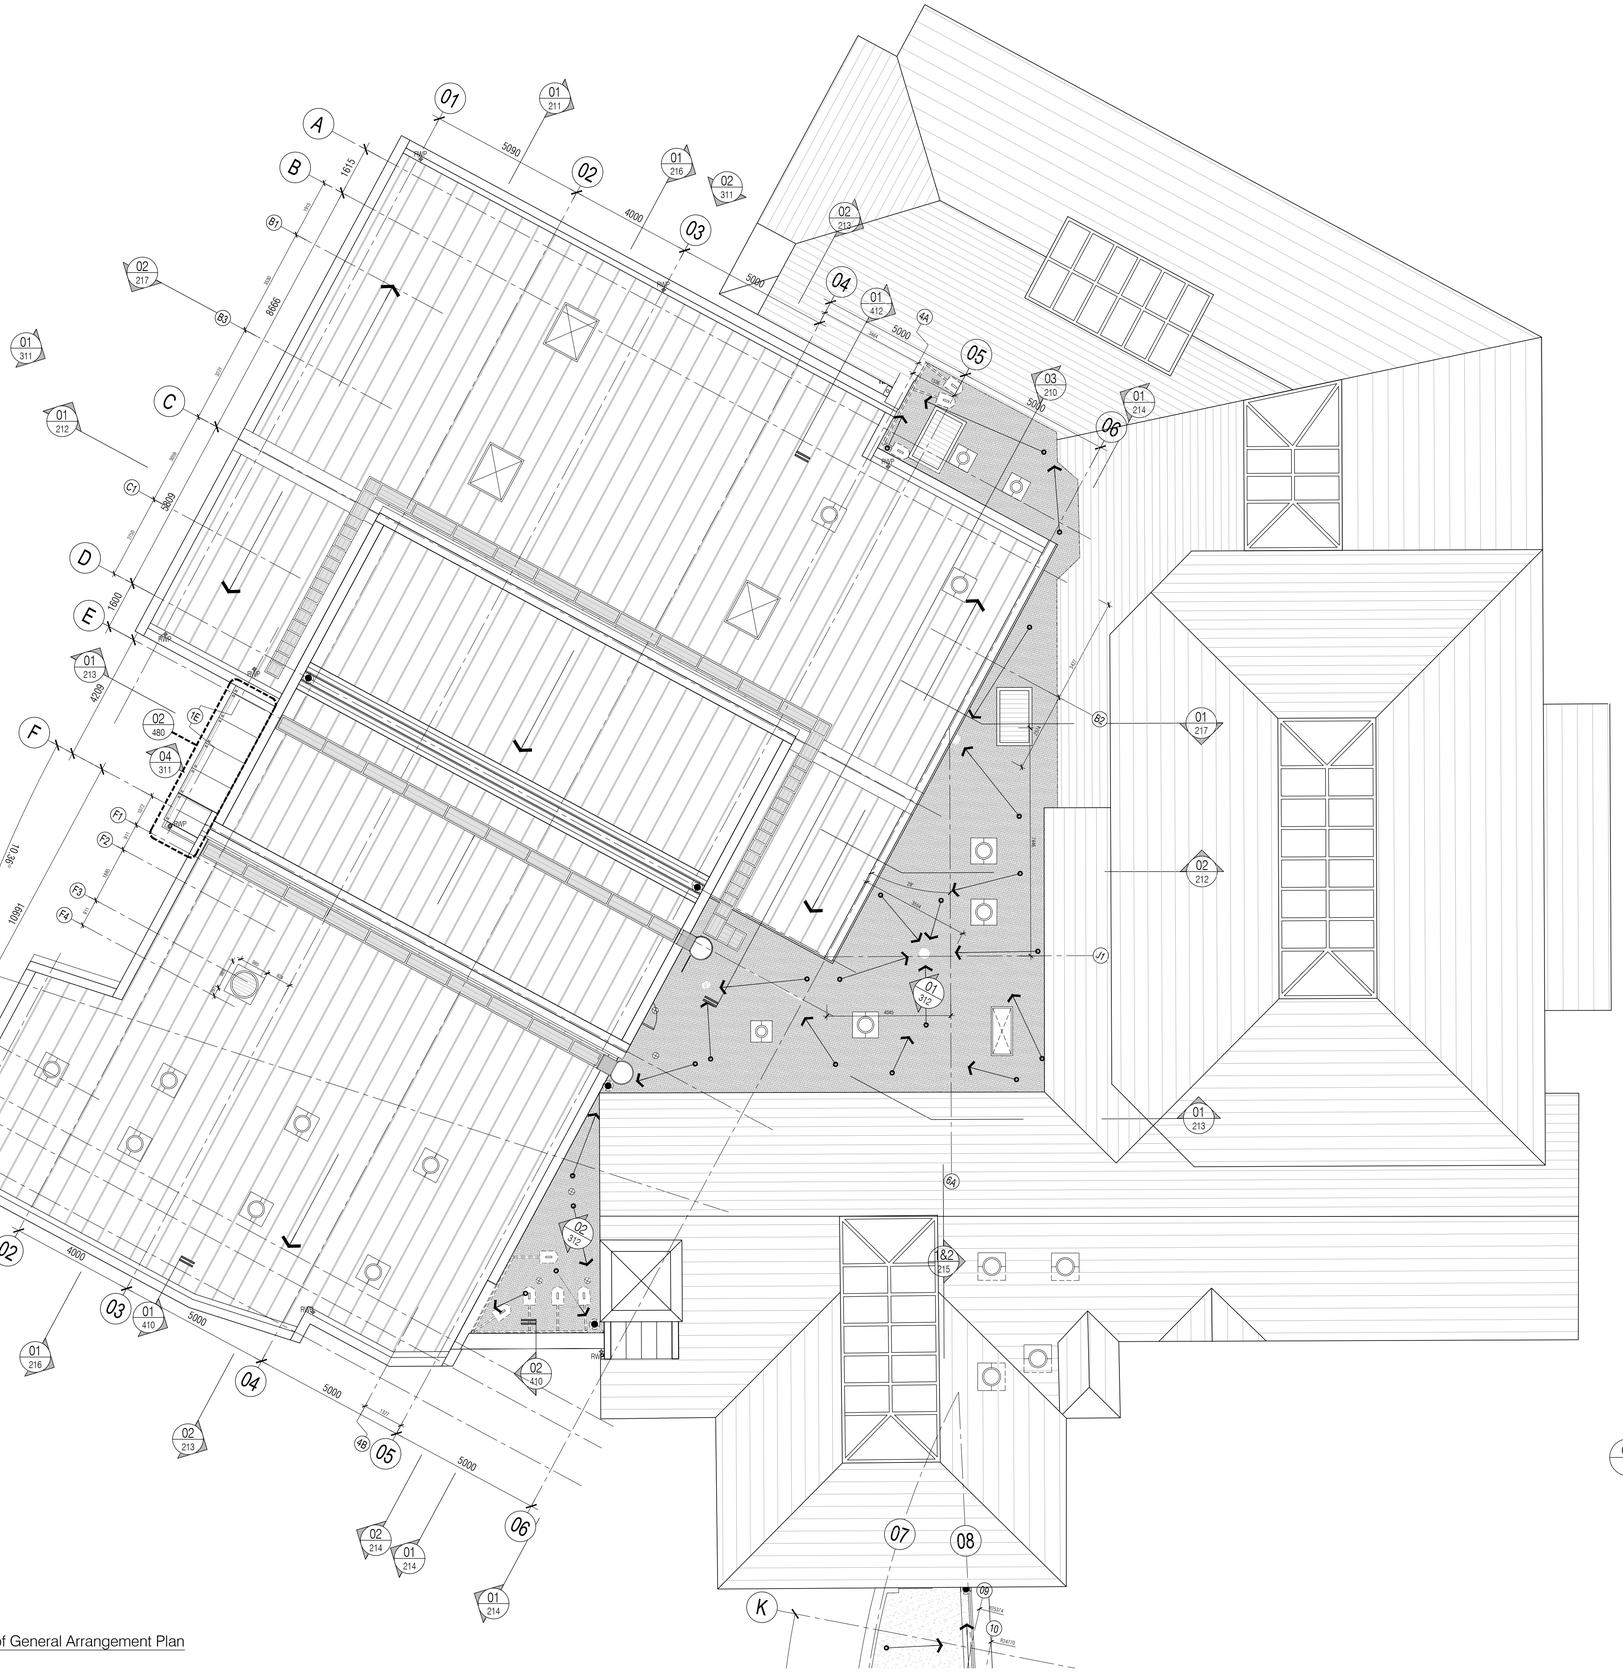
01
02
03
04
05
06
07
08
A
B
C
D
E
F
F1
F2
F3
F4
F5
G
H
J
K
1615
5000
4000
8666
1600
4020
10.98°
10991
1400
1800
5000
4000
5000
5000
5000
8.00°
8.00°
8.00°
1.90°
R28545
Fixing with 50mm fall to rear gutter
RWP
RWP
RWP

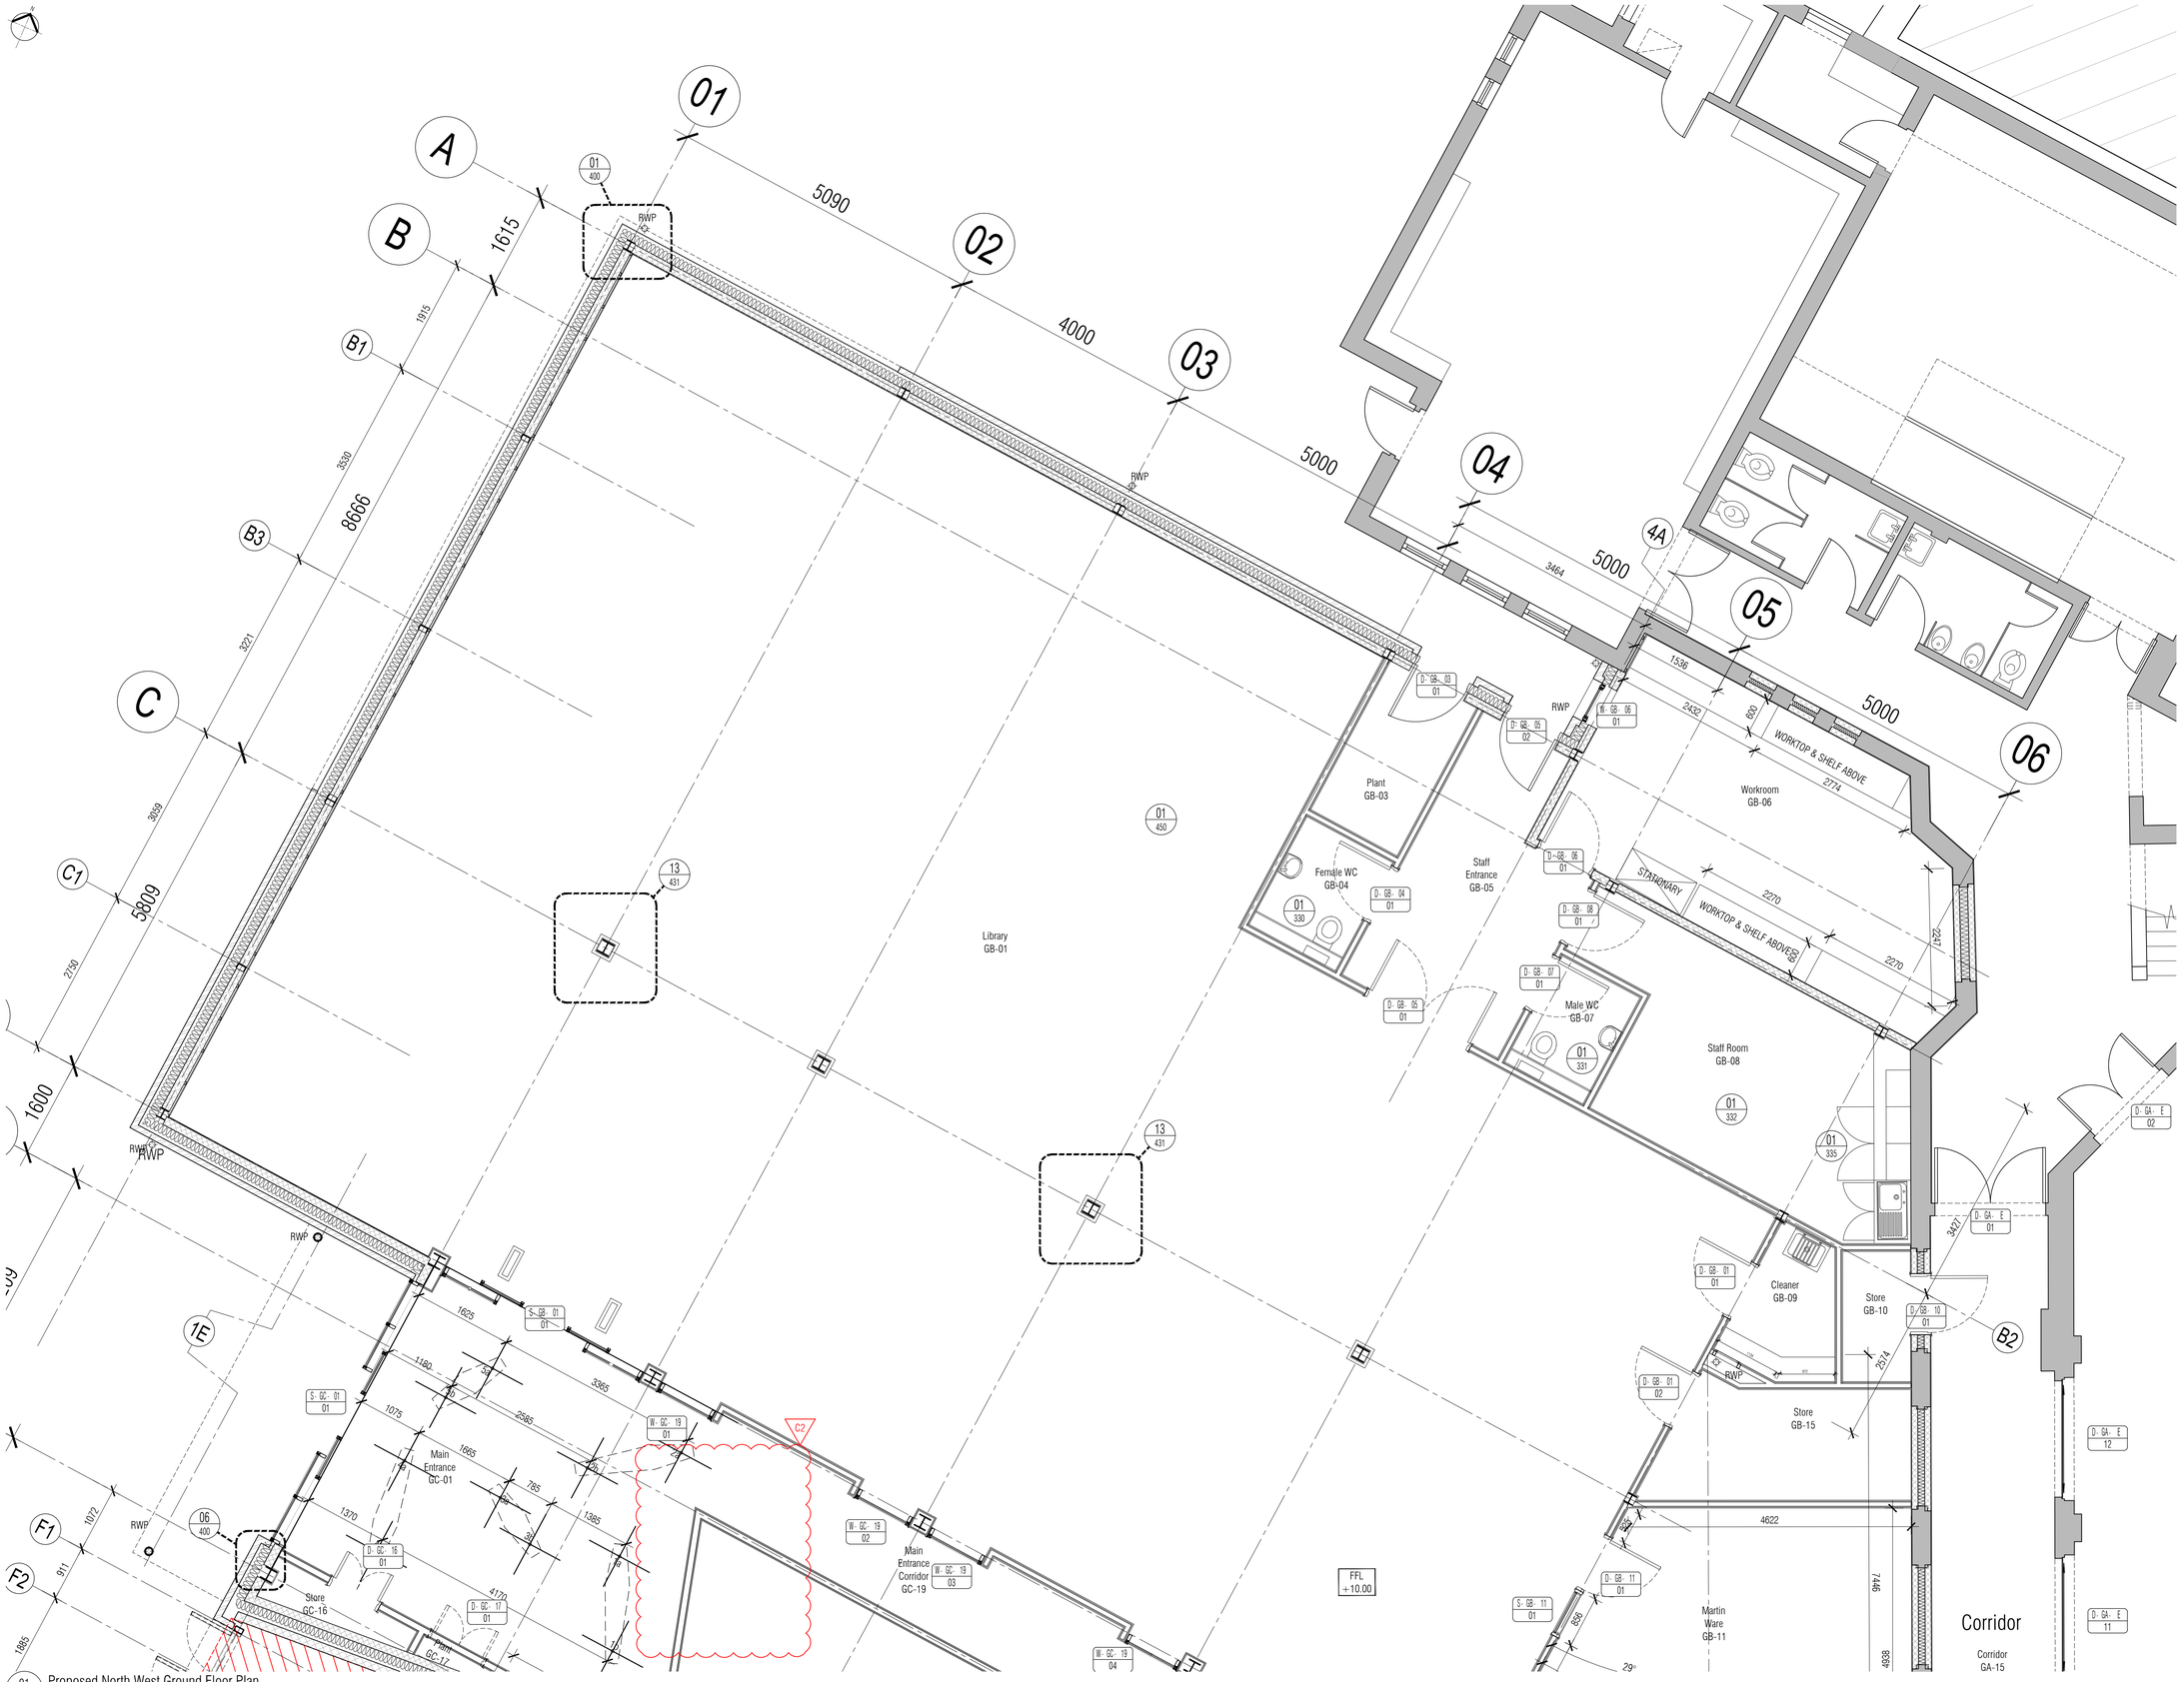


01 Proposed North West Ground Floor Plan
Scale: 1:50

For continuation, please refer to dwg: 224970-A-125

NOTES: Do not scale this drawing. All dimensions to be checked on site prior to commencement or manufacture.

Key Plan
(nts)

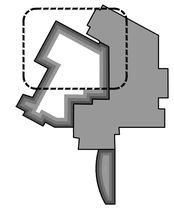

All steelwork to be erected in accordance with Structural Engineer's design and specification. For all steelwork information inc. bracing, refer to Structural Engineers drawings

Opening Reference Legend
Denotes floor level — Denotes room n°
Denotes opening type: Door, Window, Screen — D - F 13 / 01 — Denotes opening n°

ISSUED FOR CONSTRUCTION

Rev	Date	By	Chk	Comment
C2	24.10.2013	MLE	CH	Wall to GC02 moved
C1	03.07.13	RKC	JAS	Issued for CONSTRUCTION

BRINGING IDEAS TO LIFE

FRANKHAM

Frankham Consultancy Group Limited
21 Perrymount Road
Haywards Heath RH16 3TP
t 01444 449000 f 01444 455642
enquire@frankham.com
www.frankham.com

Client
Ealing
www.ealing.gov.uk

Project Title
Dominion Arts Centre
Southall
London


Drawing Title
Proposed
North West Ground Floor
General Arrangement Plan
1 of 3

Drawn by:	Scale:	Date:
RKC	1:50@A1	25.04.13
Designed by:	Checked by:	Approved by:
FCG	CDH	AGC

File Ref.: X:\2009\02\24970 - LB EALING - DOMINION ARTS CENTRE\ARCH\02_199_LOCATION PLANS AND GA\...\24970-A-124.DWG - 2009/11/02 03 20:06:11 13:31:33

Drawing No. 224970-A-124
Rev. C2

For continuation, please refer to dwg: 224970-A-124

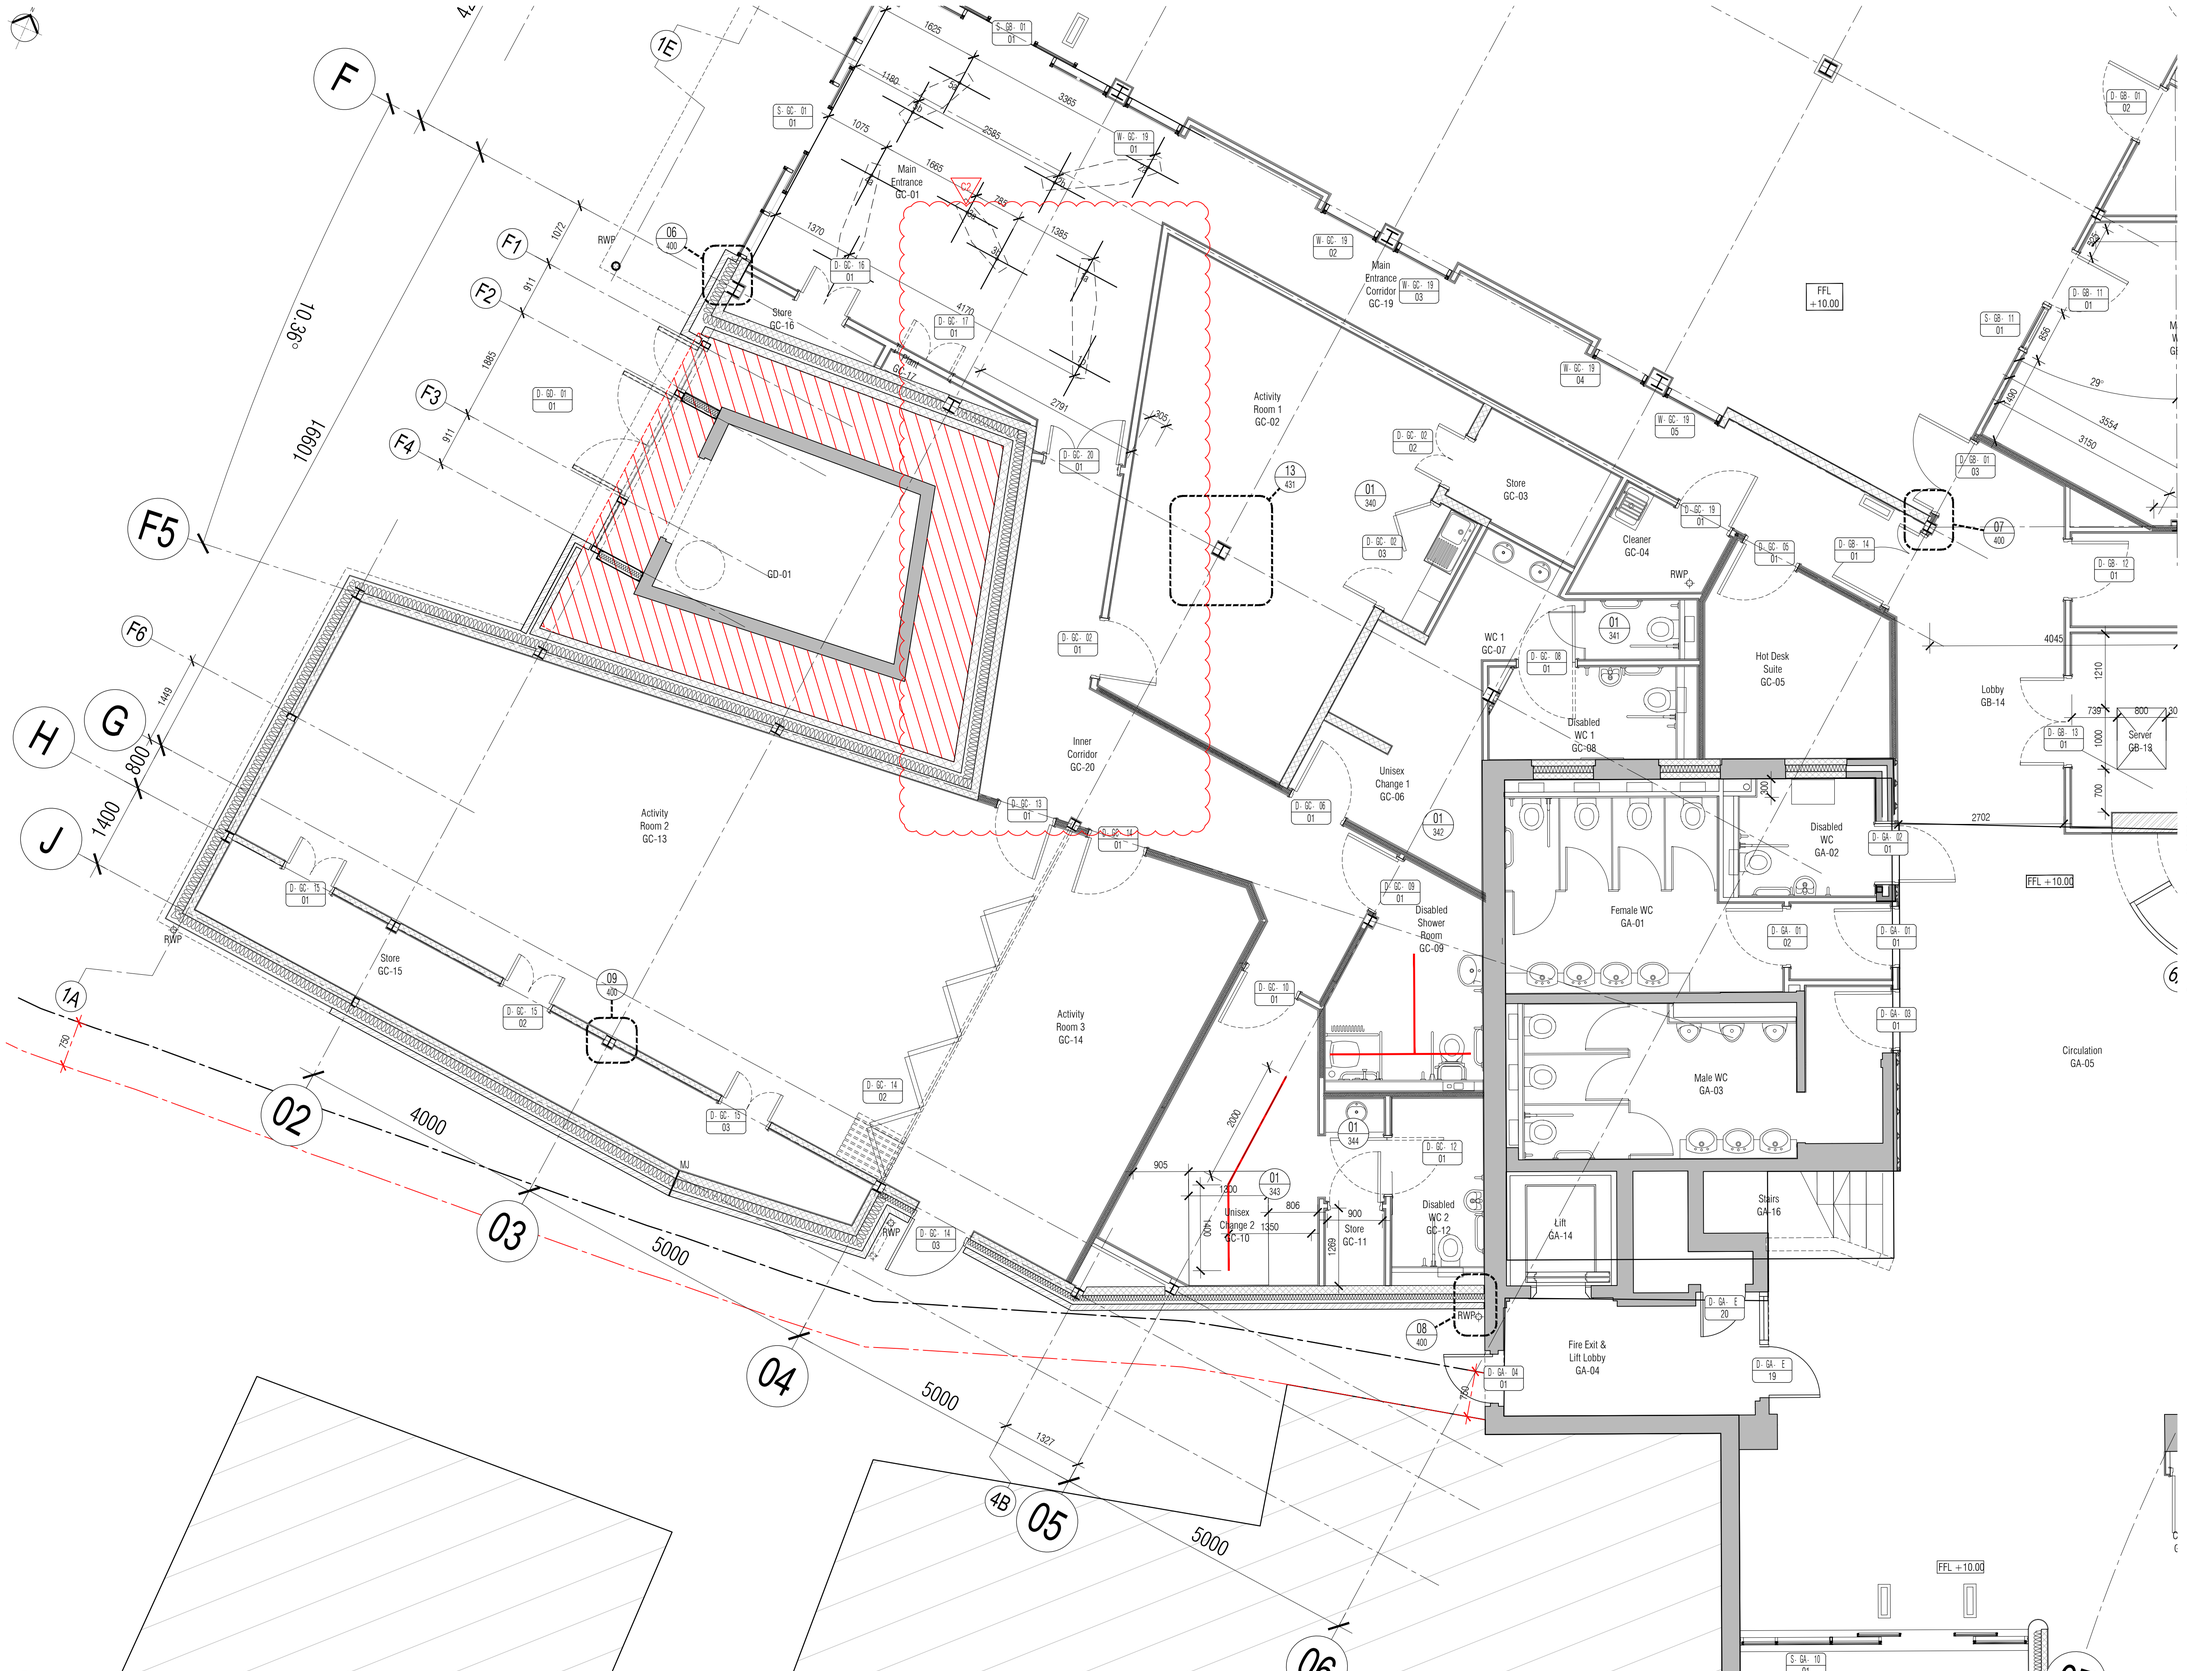


01 Proposed South West Ground Floor Plan
Scale: 1:50

For continuation, please refer to dwg: 224970-A-126 01

NOTES: Do not scale this drawing. All dimensions to be checked on site prior to commencement or manufacture.

Key Plan
(nts)

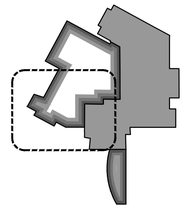

All steelwork to be erected in accordance with Structural Engineer's design and specification. For all steelwork information inc. bracing, refer to Structural Engineers drawings

Opening Reference Legend
Denotes floor level — Denotes room n°
Denotes opening type: Door, Window, Screen — D - F 13 01 — Denotes opening n°

ISSUED FOR CONSTRUCTION

Rev	Date	By	Chk	Comment
C2	24.10.13	MLE	CH	Wall to GC02 moved
C1	03.07.13	RKC	JAS	Issued for CONSTRUCTION

For continuation, please refer to dwg: 224970-A-126 02

BRINGING IDEAS TO LIFE

FRANKHAM

Frankham Consultancy Group Limited
21 Perrymount Road
Haywards Heath RH16 3TP
t 01444 444900 f 01444 455642
enquire@frankham.com
www.frankham.com

Client: Ealing — www.ealing.gov.uk


Project Title
Dominion Arts Centre
Southall
London

Drawing Title
Proposed
South West Ground Floor
General Arrangement Plan
2 of 3


Drawn by:	Scale:	Date:
RKC	1:50@A1	25.04.13
Designed by:	Checked by:	Approved by:
FCG	CDH	AGC

File Ref.: X:\2009\0224970 - LB EALING - DOMINION ARTS CENTRE\ARCH\3D_YBI_LOCATION PLANS AND GA\224970-A-125.DWG — 20/06/2011 13:31:42

Drawing No. 224970-A-125 — Rev. C2

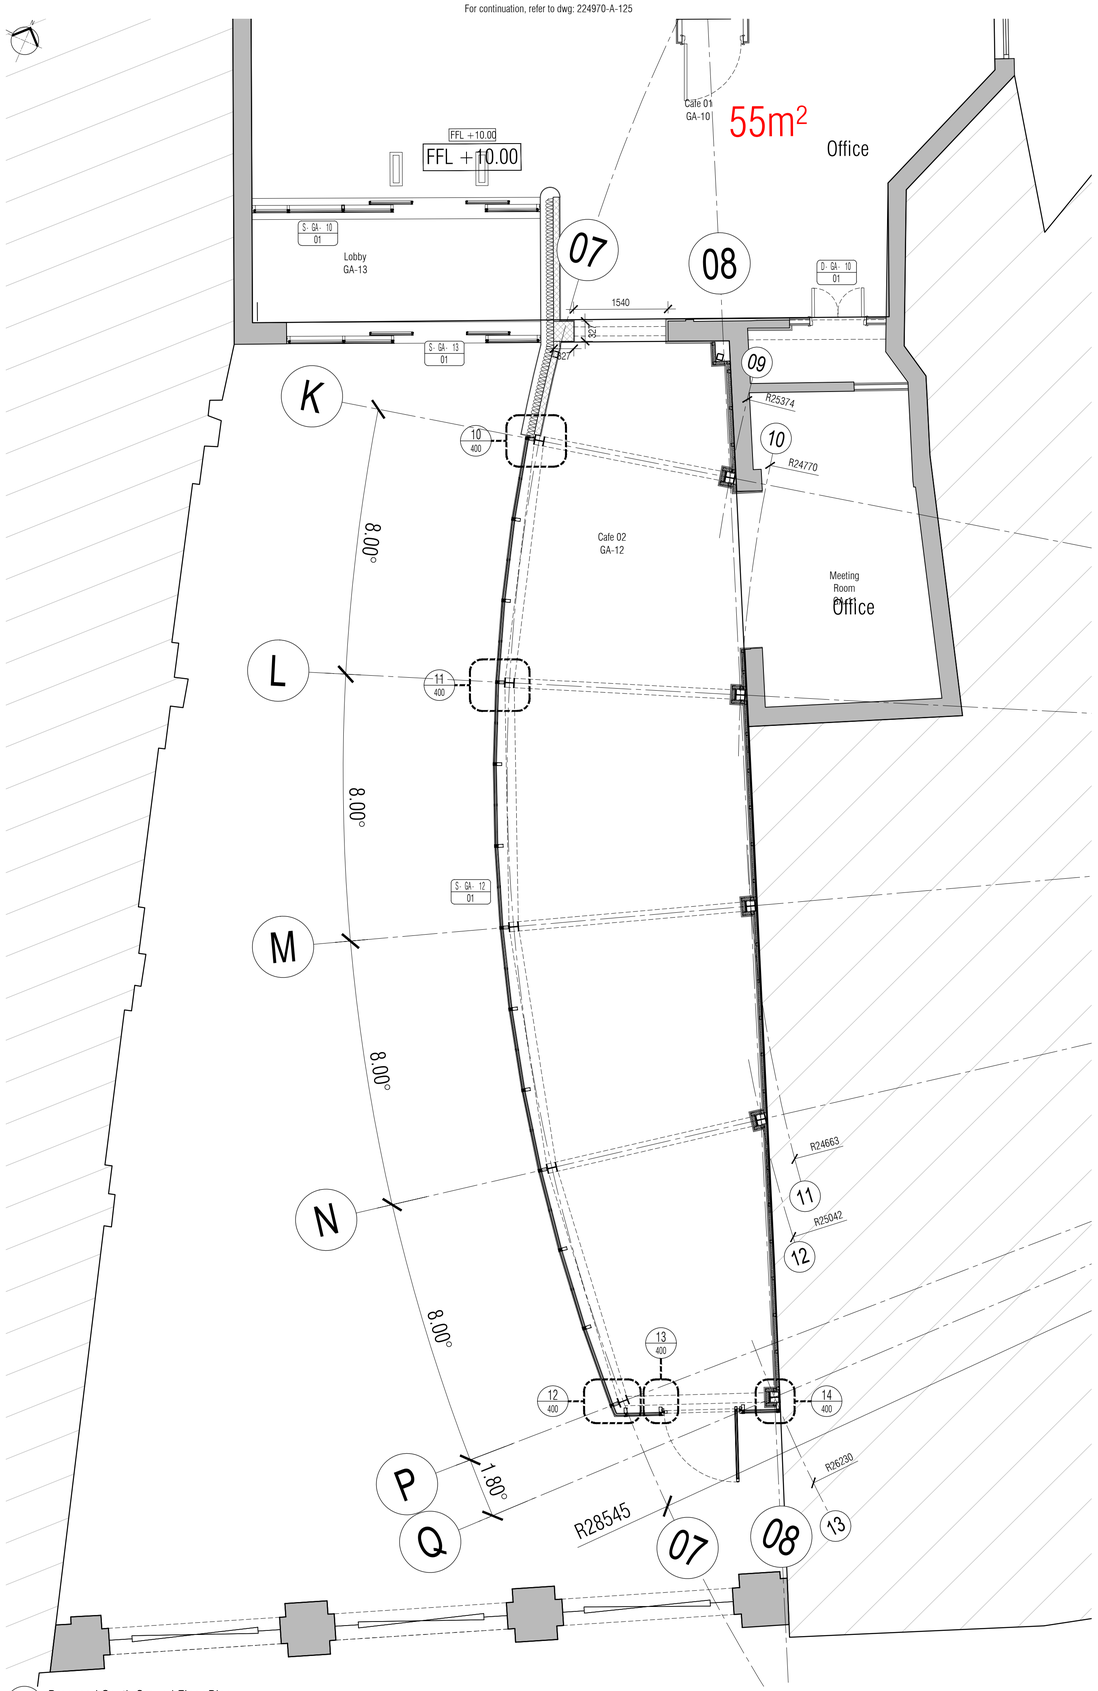

01 Proposed South Ground Floor Plan
Scale: 1:50

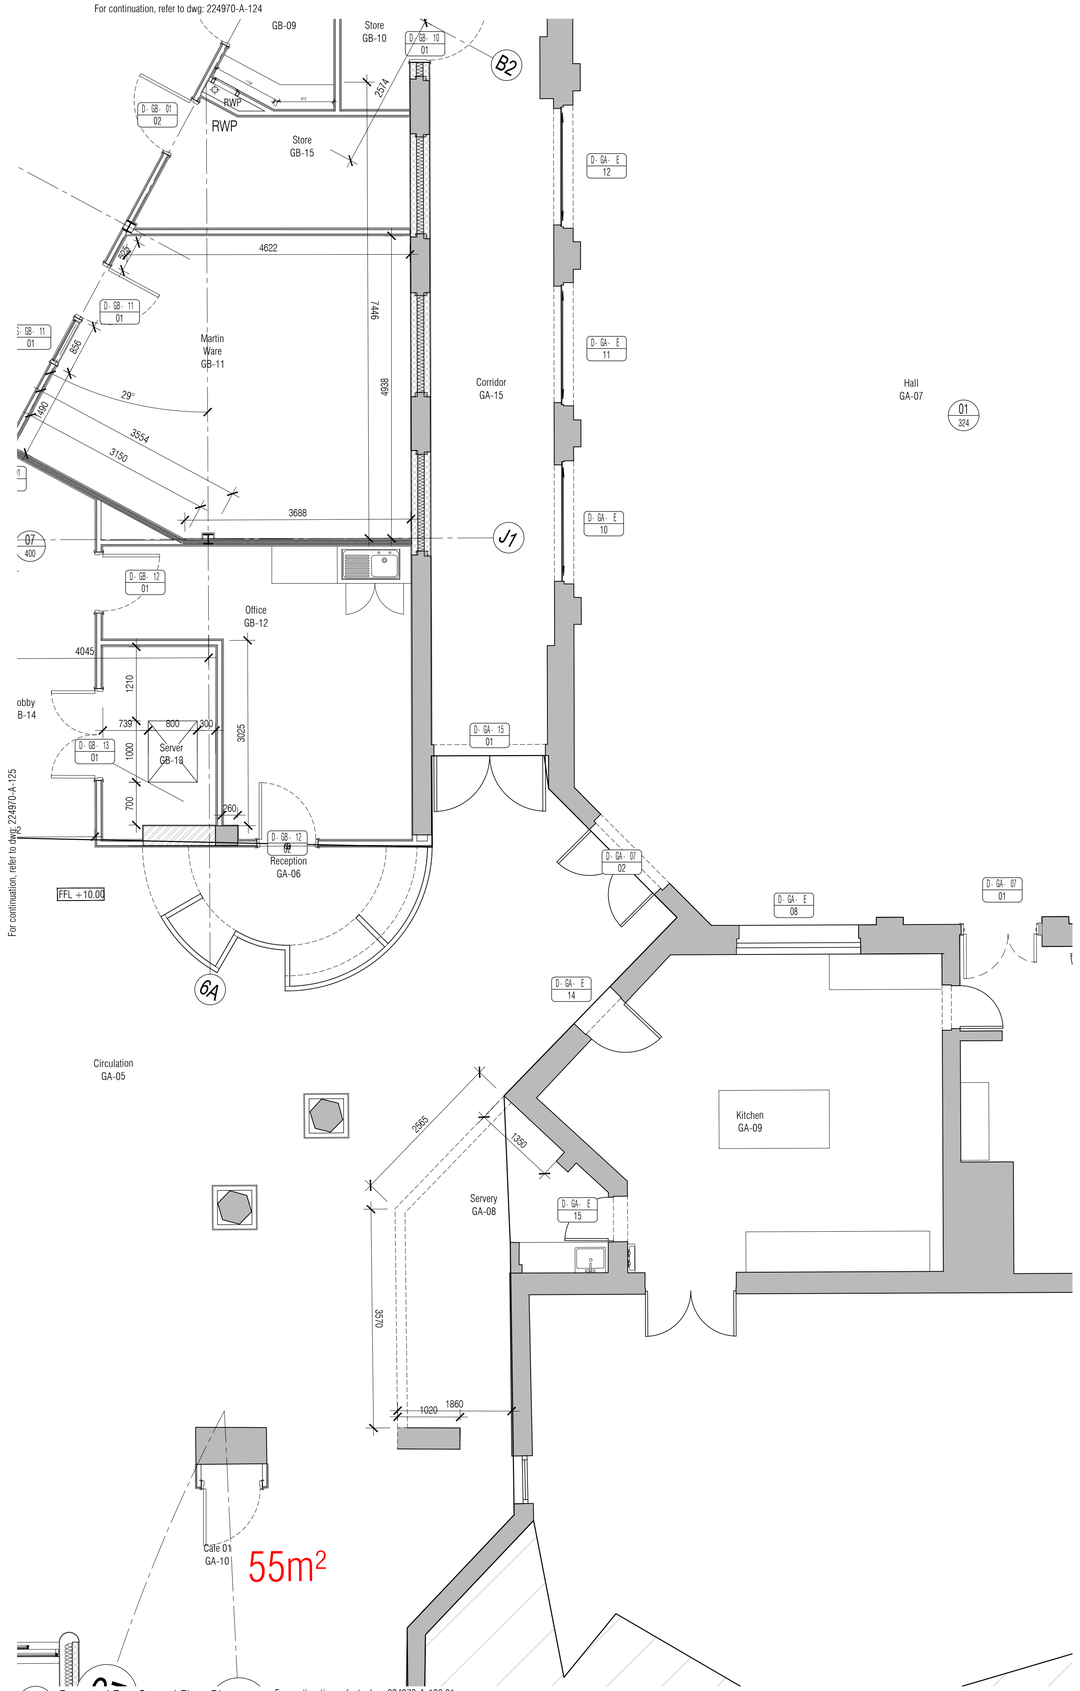


02 Proposed East Ground Floor Plan
Scale: 1:50

For continuation, refer to dwg: 224970-A-126 01

NOTES: Do not scale this drawing. All dimensions to be checked on site prior to commencement or manufacture.

Key Plan
(nts)

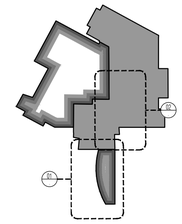

All steelwork to be erected in accordance with Structural Engineer's design and specification. For all steelwork information inc. bracing, refer to Structural Engineers drawings

Opening Reference Legend

Denotes floor level — Denotes room n°

Denotes opening type: Door, Window, Screen — D - F 13 01 — Denotes opening n°

ISSUED FOR CONSTRUCTION

Rev	Date	By	Chk	Comment
C1	03.07.13	RKC	JAS	Issued for CONSTRUCTION

BRINGING IDEAS TO LIFE

FRANKHAM

Frankham Consultancy Group Limited
21 Perrymount Road
Haywards Heath RH16 3TP
t 01444 444900 f 01444 455642
enquire@frankham.com
www.frankham.com

Client

Ealing
www.ealing.gov.uk

Project Title

Dominion Arts Centre
Southall
London


Drawing Title

Proposed
South & East Ground Floor
General Arrangement Plan
3 of 3

Drawn by:	Scale:	Date:
RKC	1:50@A1	25.04.13
Designed by:	Checked by:	Approved by:
FCG	CDH	AGC

File Ref.: X:\2009\0224970 - EALING - DOMINION ARTS CENTRE\ARCH\DE_RB_LOCATION PLANS AND GA-2345V5-A-126.DWG - 2009/11/13 20:06:11/13/31:52

Drawing No. 224970-A-126 | Rev. C1

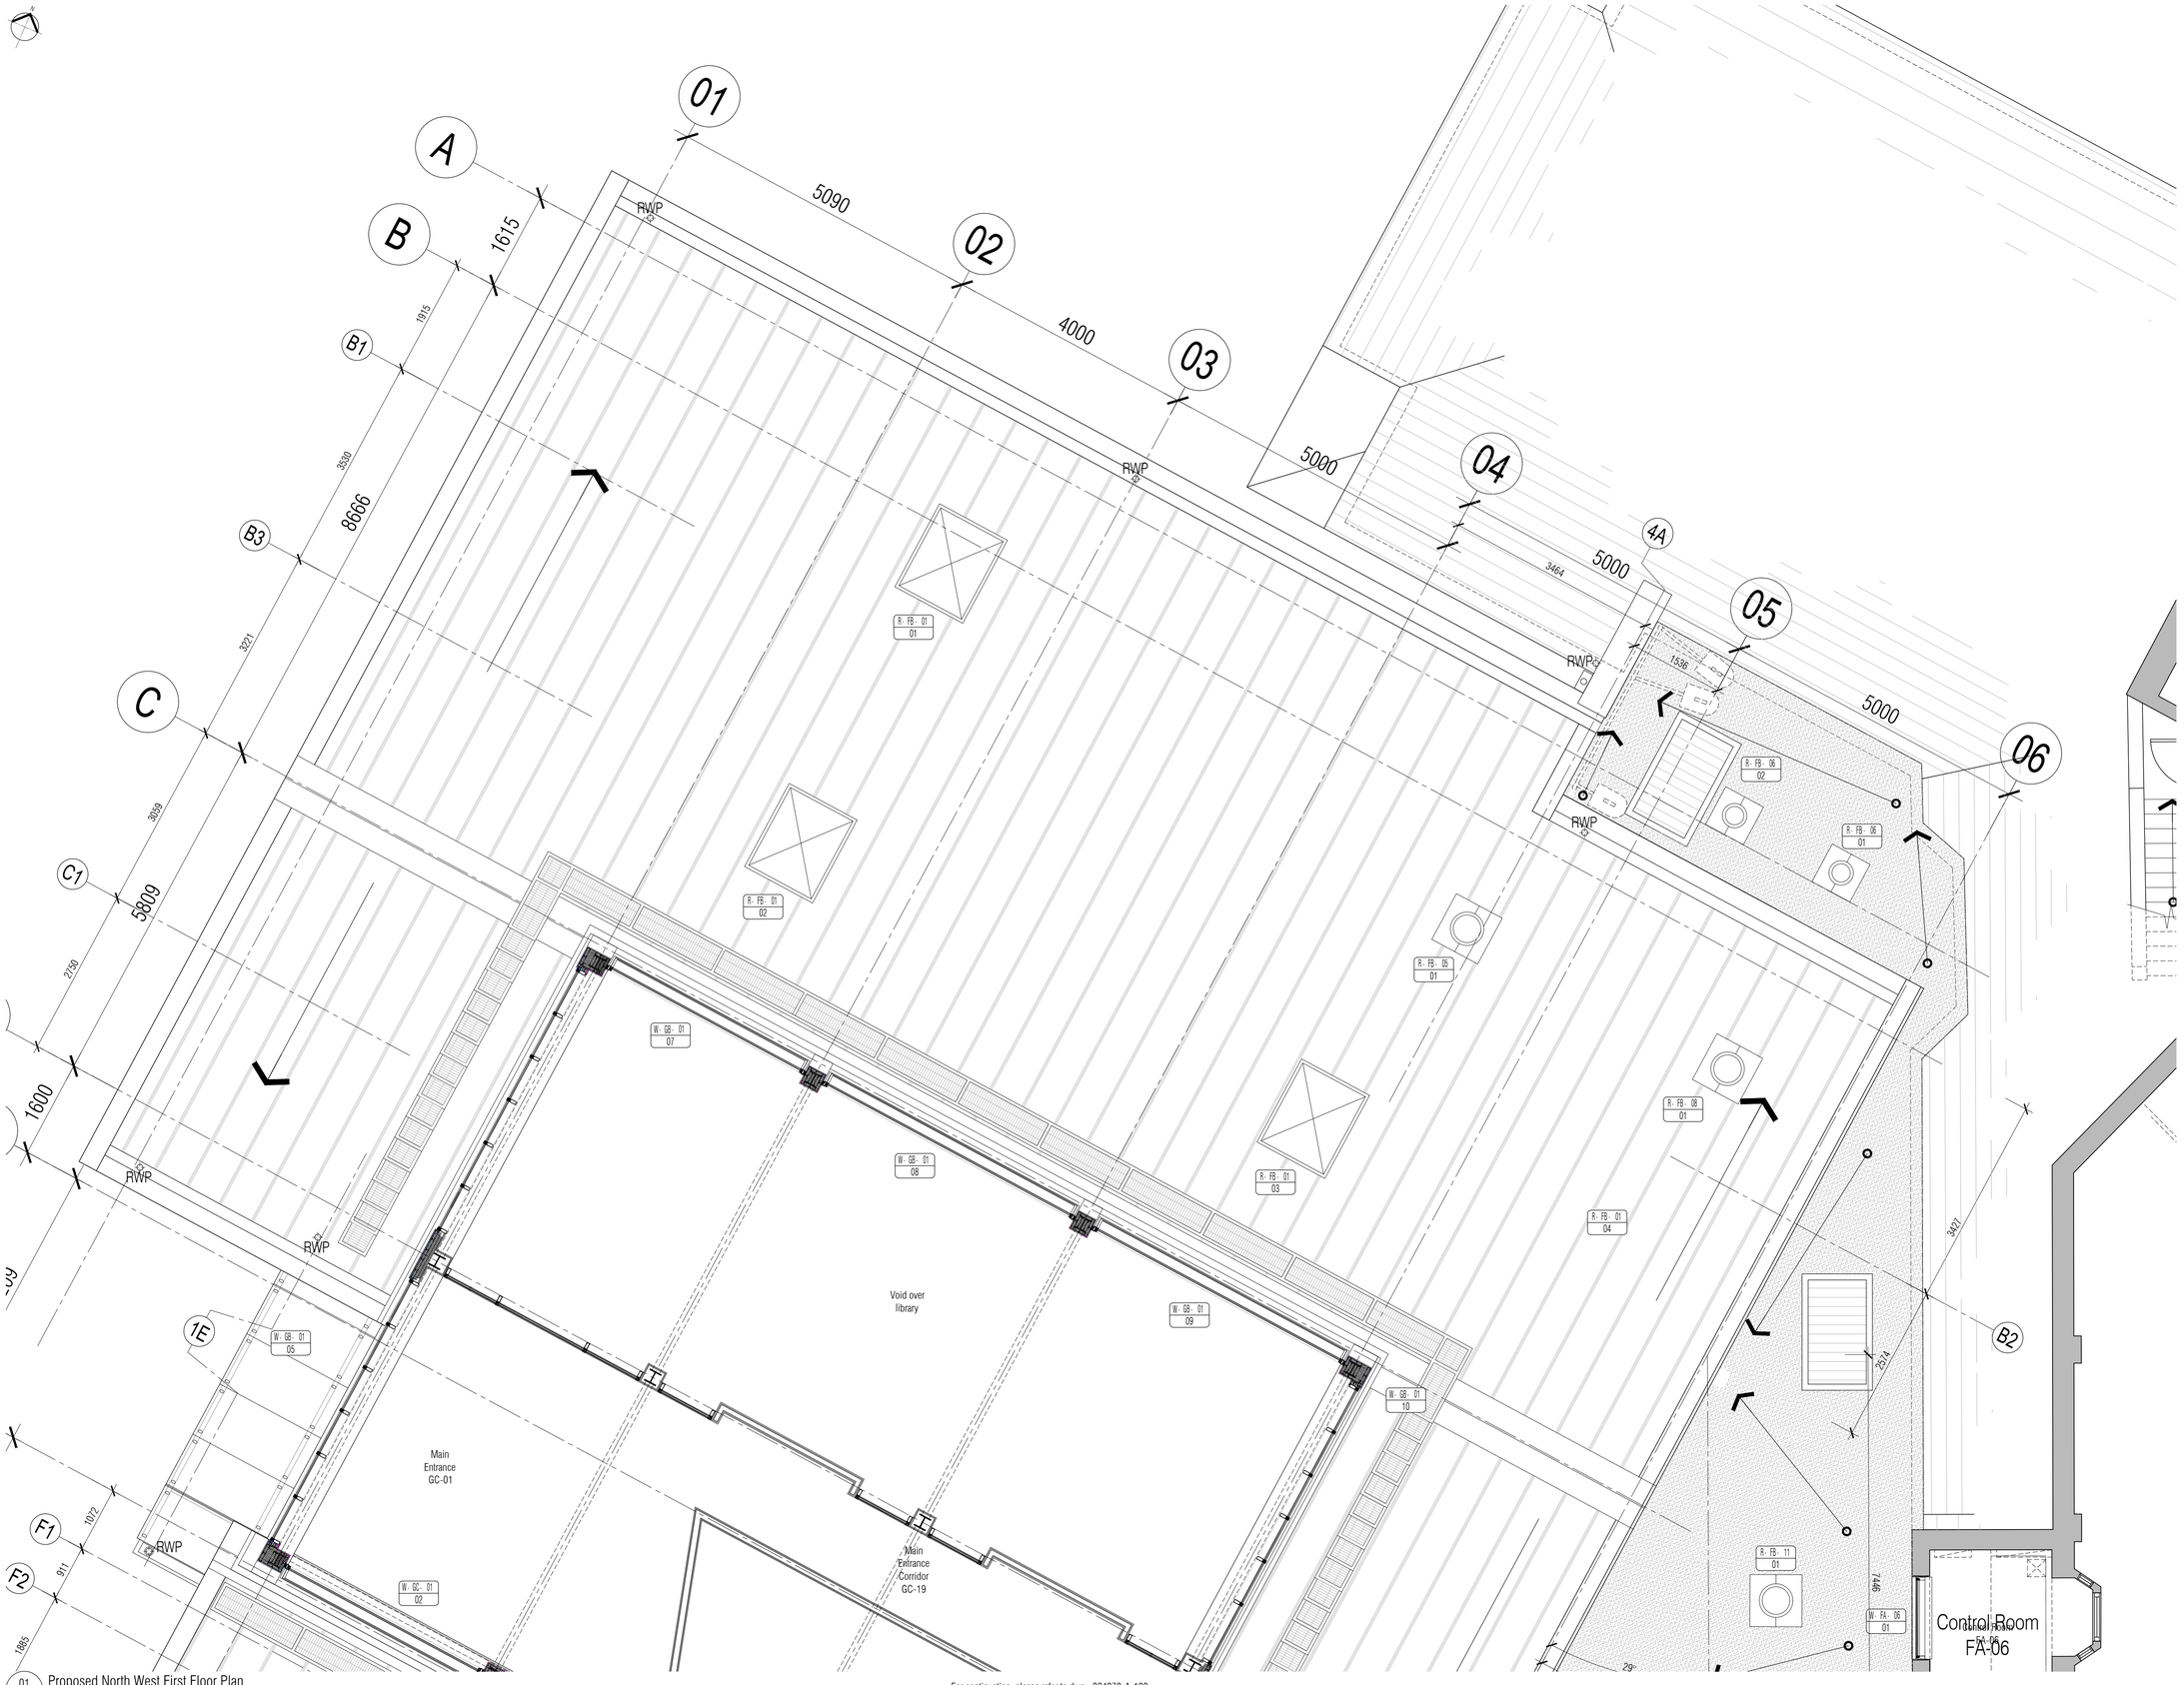


01 Proposed North West First Floor Plan
Scale: 1:50

For continuation, please refer to dwg: 224970-A-128

NOTES: Do not scale this drawing. All dimensions to be checked on site prior to commencement or manufacture.

Key Plan (nts)

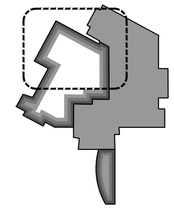

All steelwork to be erected in accordance with Structural Engineer's design and specification. For all steelwork information inc. bracing, refer to Structural Engineers drawings

Opening Reference Legend

Denotes floor level — Denotes room n°

Denotes opening type: Door, Window, Screen — 2D - P 1.5 / 01 — Denotes opening n°

ISSUED FOR CONSTRUCTION

Rev	Date	By	Chk	Comment
C1	03.07.13	RKC	JAS	Issued for CONSTRUCTION

BRINGING IDEAS TO LIFE

FRANKHAM

Frankham Consultancy Group Limited
21 Perrymount Road
Haywards Heath RH16 3TP
t 01444 449000 f 01444 455642
enquire@frankham.com
www.frankham.com

Client: Ealing — www.ealing.gov.uk

Project Title: Dominion Arts Centre, Southall, London


Drawing Title: Proposed North West First Floor General Arrangement Plan 1 of 3

Drawn by:	Scale:	Date:
RKC	1:50@A1	25.04.13
Designed by:	Checked by:	Approved by:
FCG	CDH	AGC

File Ref.: K:\2009\09224970 - LB EALING - DOMINION ARTS CENTRE\ARCH\SD_199_LOCATION PLANS AND GA\...\224970-A-127.DWG — 20/06/13 22:02 — 20/06/13 22:04

Drawing No.	Rev.
224970-A-127	C1

For continuation, please refer to dwg: 224970-A-127

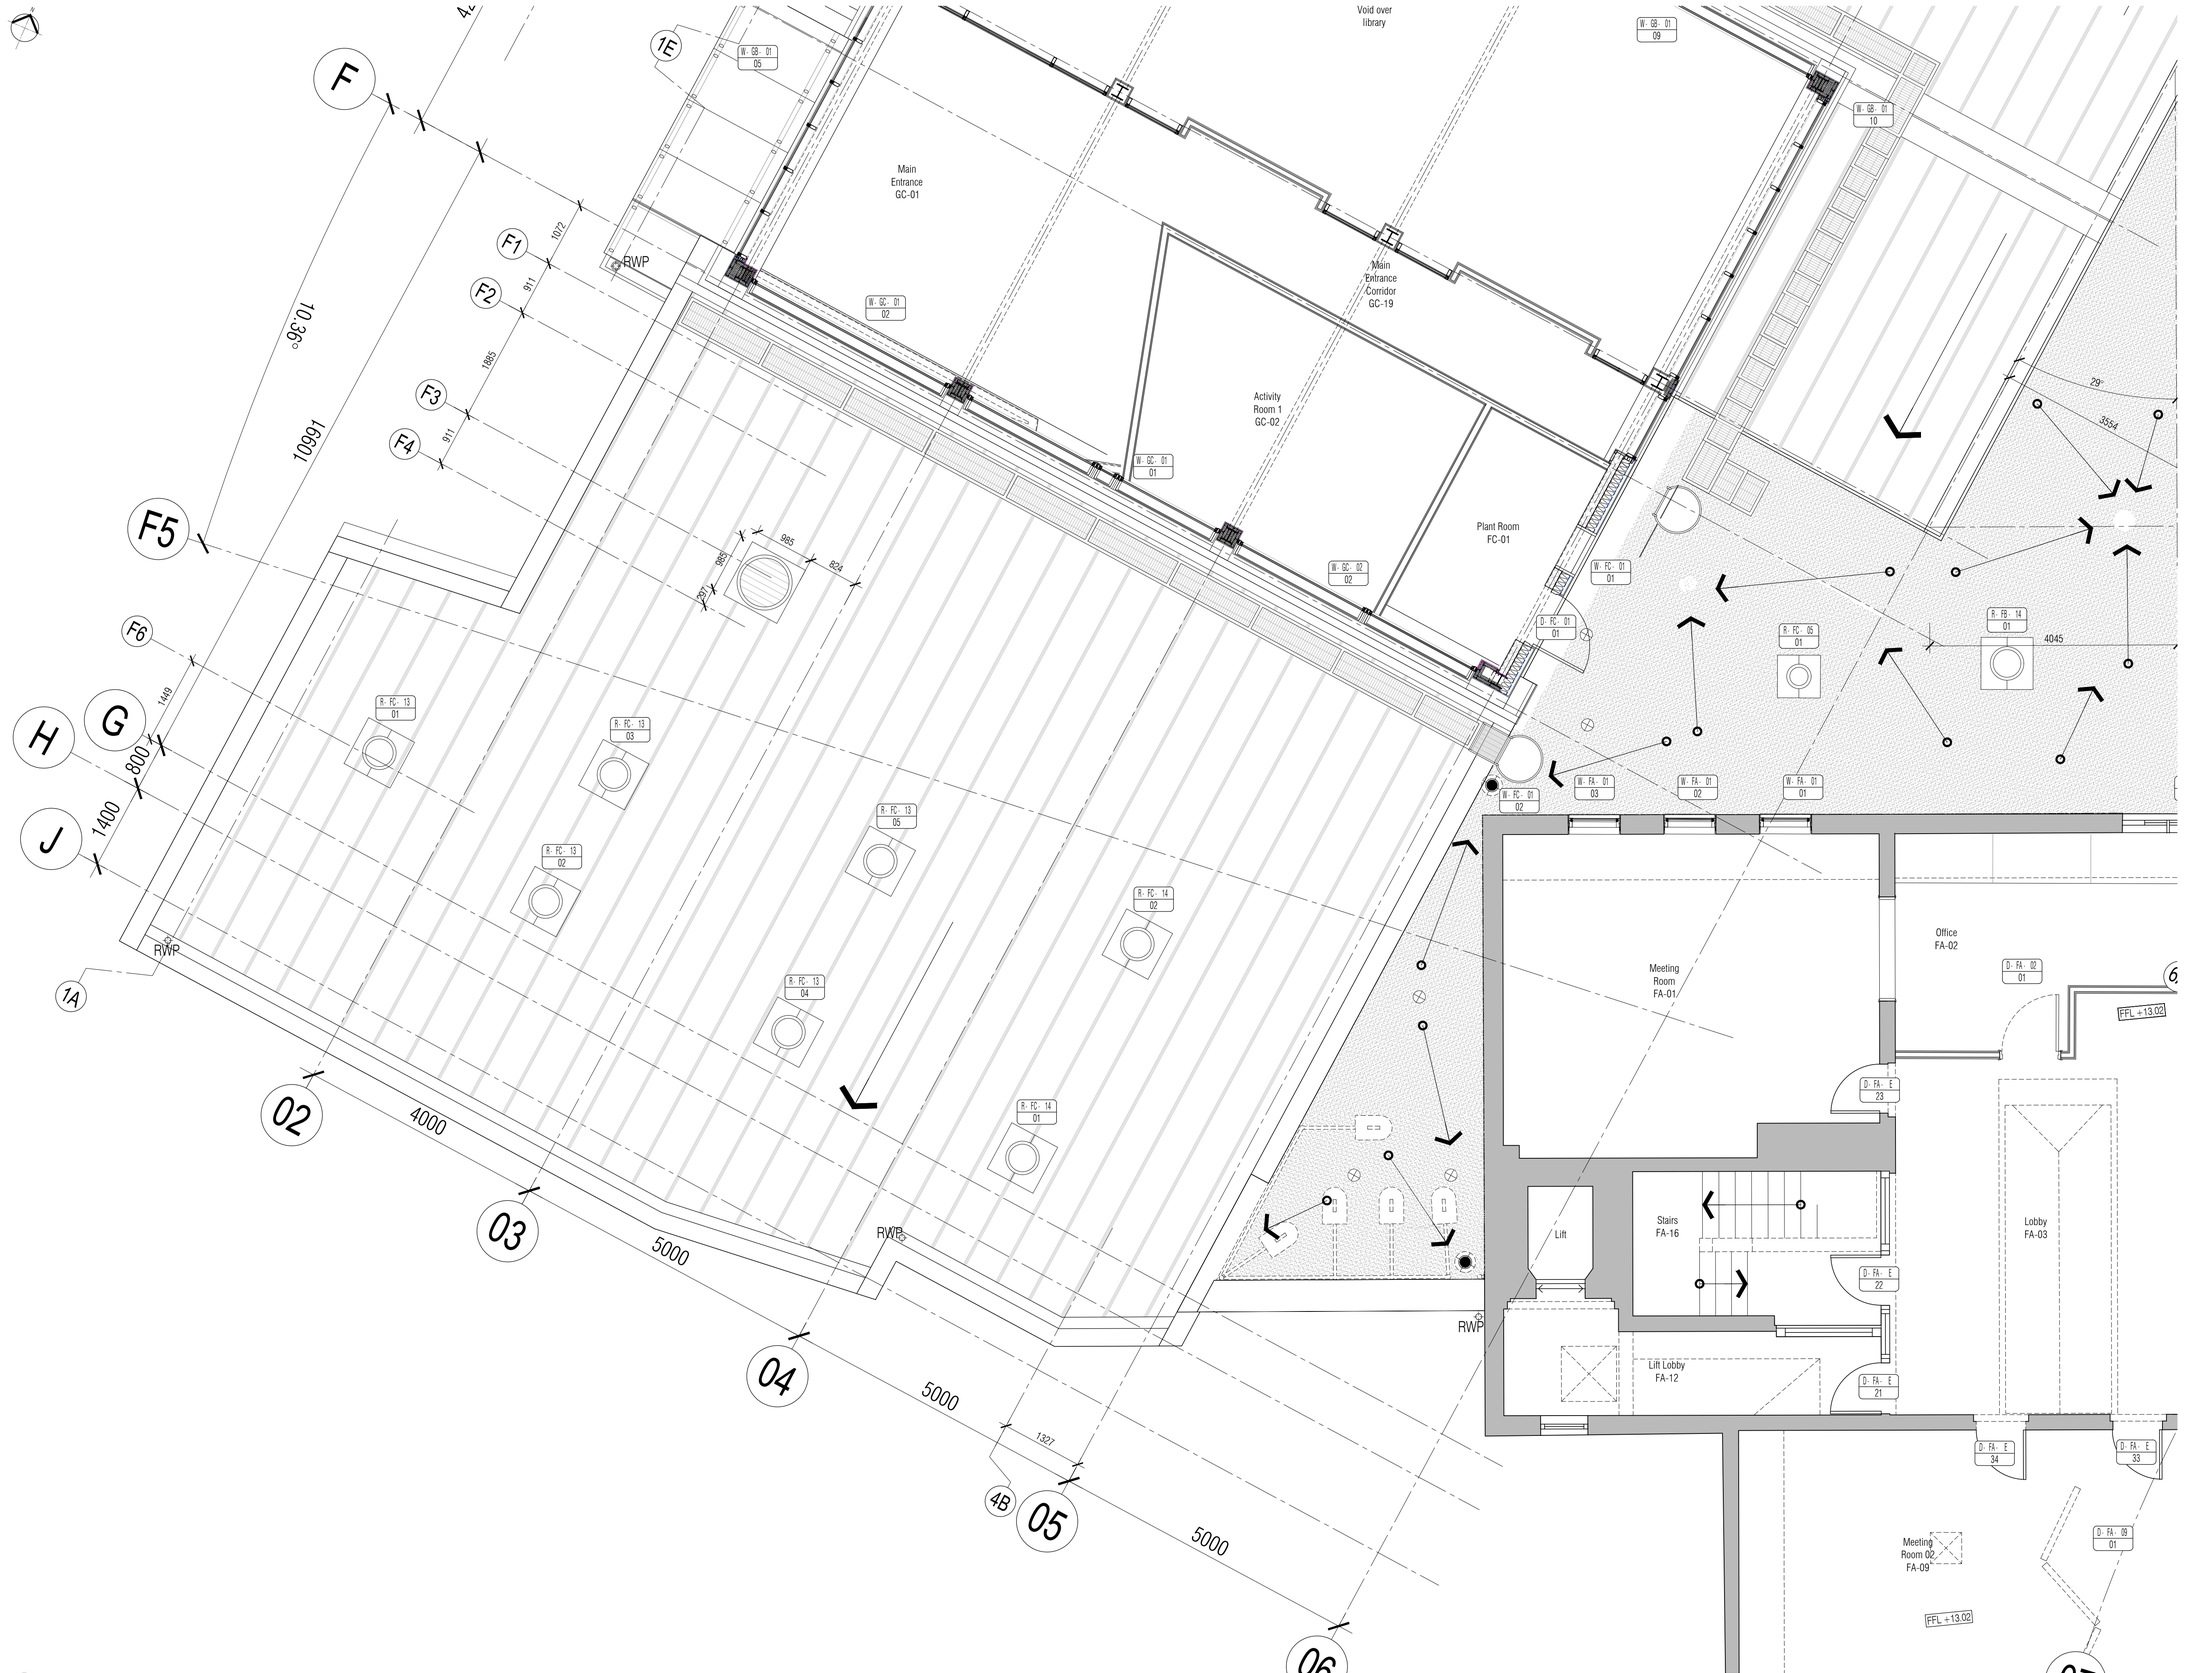


01 Proposed South West First Floor Plan
Scale: 1:50

For continuation, please refer to dwg: 224970-A-129 01

NOTES: Do not scale this drawing. All dimensions to be checked on site prior to commencement or manufacture.

Key Plan
(nts)

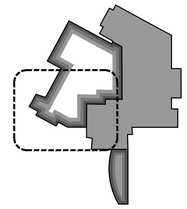

All steelwork to be erected in accordance with Structural Engineer's design and specification. For all steelwork information inc. bracing, refer to Structural Engineers drawings

Opening Reference Legend

Denotes floor level — Denotes room n°

Denotes opening type: Door, Window, Screen — D - F 13 01 — Denotes opening n°

ISSUED FOR CONSTRUCTION

Rev	Date	By	Chk	Comment
C1	03.07.13	RKC	JAS	Issued for CONSTRUCTION

For continuation, please refer to dwg: 224970-A-129 02

BRINGING IDEAS TO LIFE

FRANKHAM

Frankham Consultancy Group Limited
21 Perrymount Road
Haywards Heath RH16 3TP
t 01444 449000 f 01444 455642
enquire@frankham.com
www.frankham.com

Client
Ealing
www.ealing.gov.uk


Project Title
Dominion Arts Centre
Southall
London

Drawing Title
Proposed
South West First Floor
General Arrangement Plan
2 of 3


Drawn by:	Scale:	Date:
RKC	1:50@A1	25.04.13
Designed by:	Checked by:	Approved by:
FCG	CDH	AGC

File Ref.: X:\2009\02\224970 - LB EALING - DOMINION ARTS CENTRE\ARCH\02_169_LOCATION PLANS AND SA\...\224970-A-128.DWG - 2009/11/02/13 20:06:11:13:22:14

Drawing No. 224970-A-128 Rev. C1

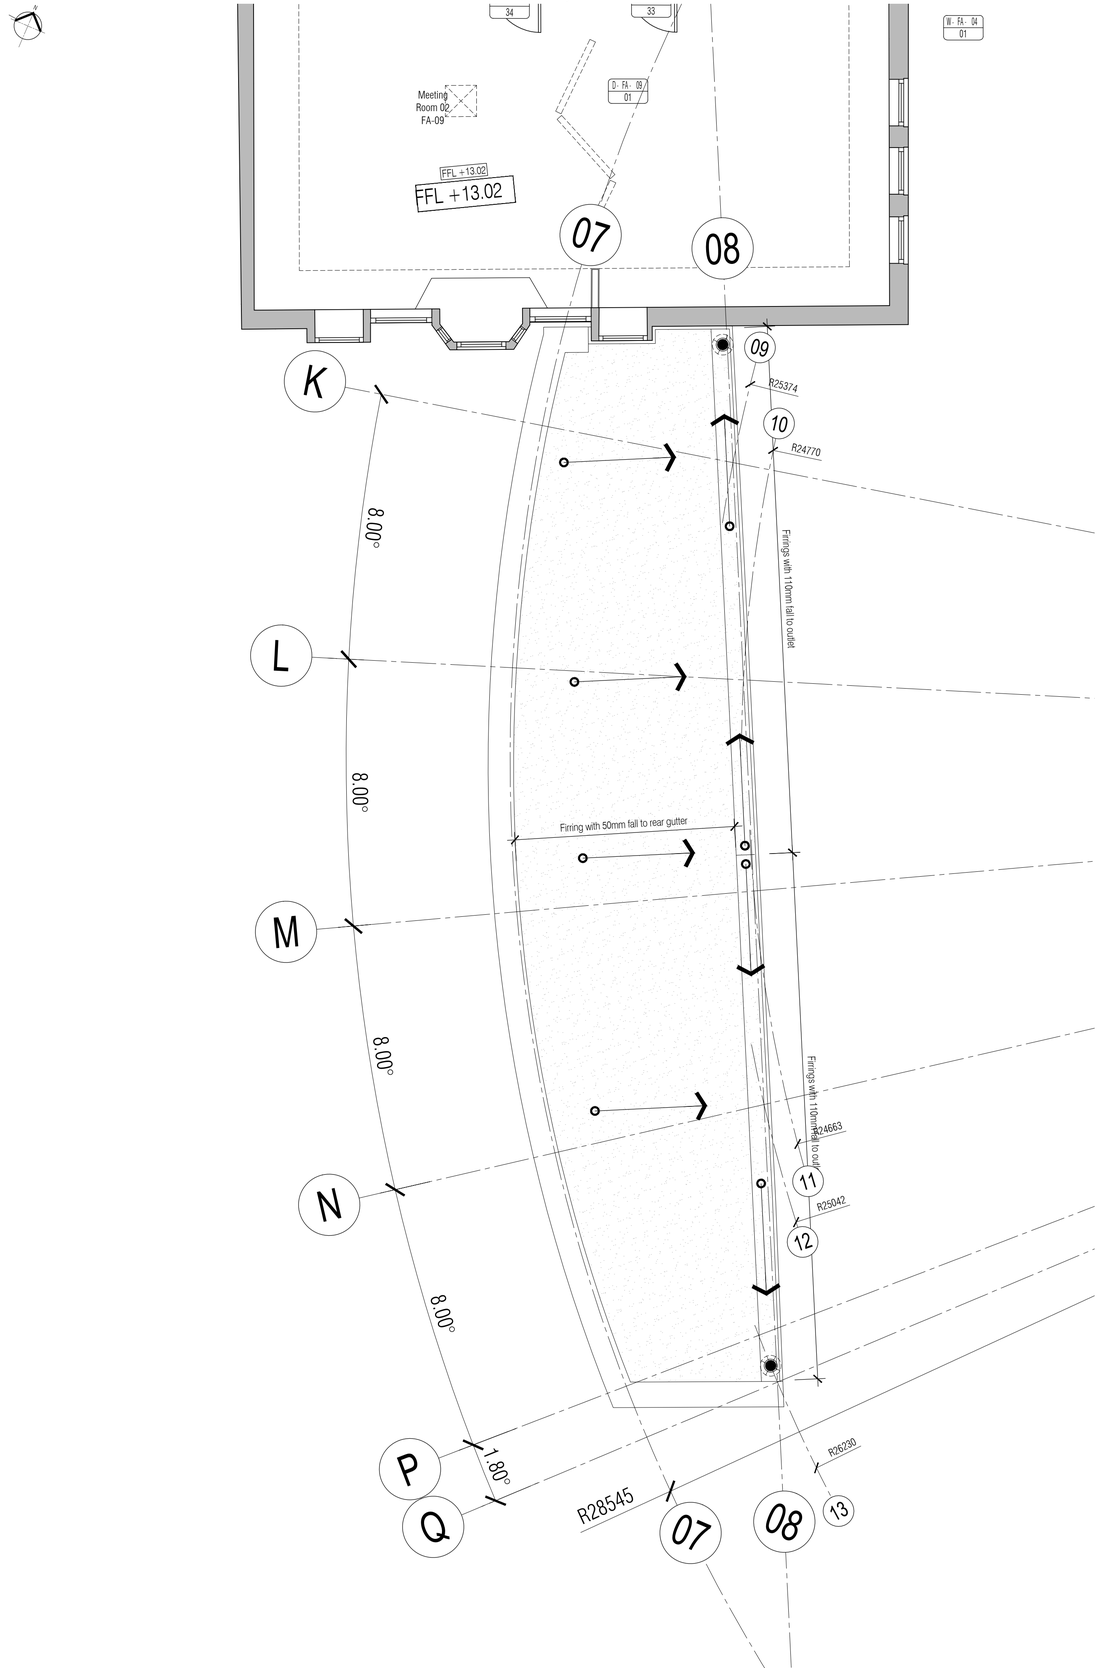


01 Proposed South First Floor Plan
Scale: 1:50

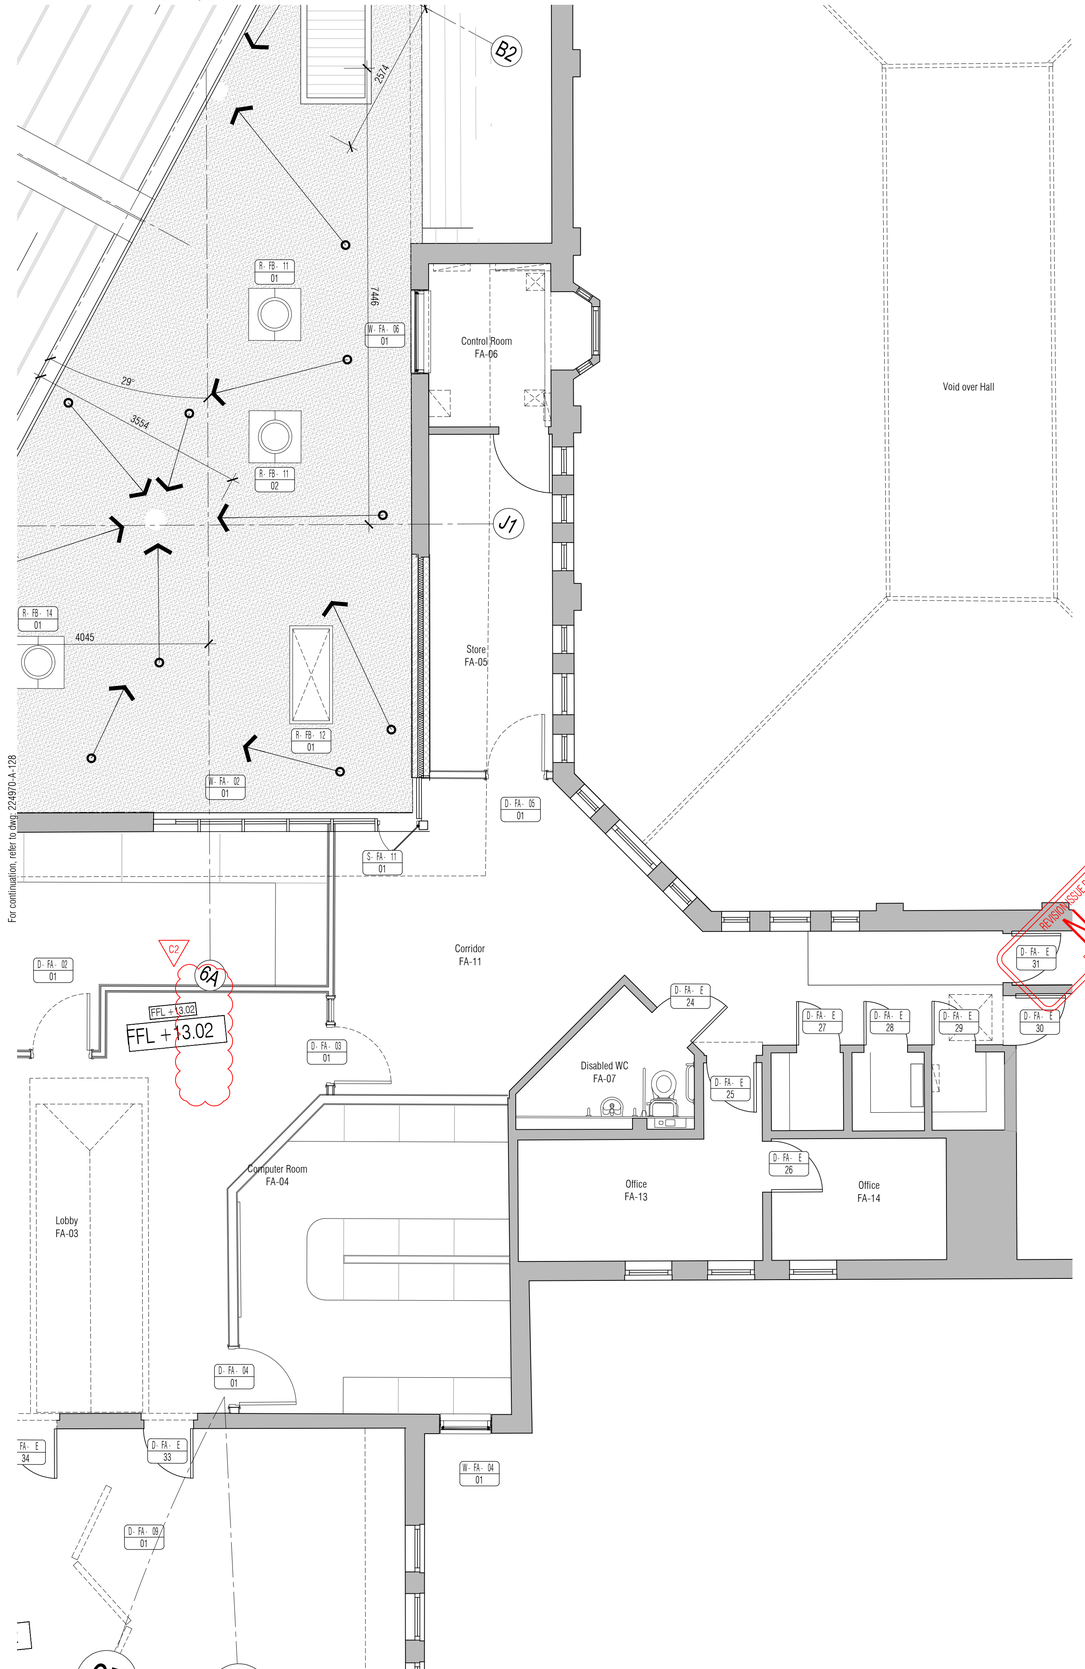

02 Proposed East First Floor Plan
Scale: 1:50

NOTES: Do not scale this drawing. All dimensions to be checked on site prior to commencement or manufacture.

Key Plan
(nts)

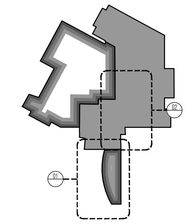

All steelwork to be erected in accordance with Structural Engineer's design and specification. For all steelwork information inc. bracing, refer to Structural Engineers drawings

Opening Reference Legend

Denotes floor level — Denotes room n°

Denotes opening type: Door, Window, Screen — D - FA - 13 01 — Denotes opening n°

ISSUED FOR CONSTRUCTION

REVISIONS ISSUE DATE REQUIRED

REVISIONS ARE NOT ISSUED

Rev	Date	By	Chk	Comment
C2		PR	AC	Openings added
C1	03.07.13	RKC	JAS	Issued for CONSTRUCTION

BRINGING IDEAS TO LIFE

FRANKHAM

Frankham Consultancy Group Limited
21 Perrymount Road
Haywards Heath RH16 3TP
t 01444 444900 f 01444 456642
enquiries@frankham.com
www.frankham.com

Client

Ealing
www.ealing.gov.uk

Project Title

Dominion Arts Centre
Southall
London

Drawing Title


Proposed
South & East First Floor
General Arrangement Plan
3 of 3

Drawn by:	Scale:	Date:
RKC	1:50@A1	25.04.13
Designed by:	Checked by:	Approved by:
FCG	CDH	AGC


File Ref.: X:\2000\2224970 - LB EALING - DOMINION ARTS CENTRE\ARCH\SD_199_LOCATION PLANS AND GA\...\224970-A-129.DWG — 20/06/13 13:32:27

Drawing No. 224970-A-129 | Rev. C2

For continuation, please refer to dwg: 224970-A-130

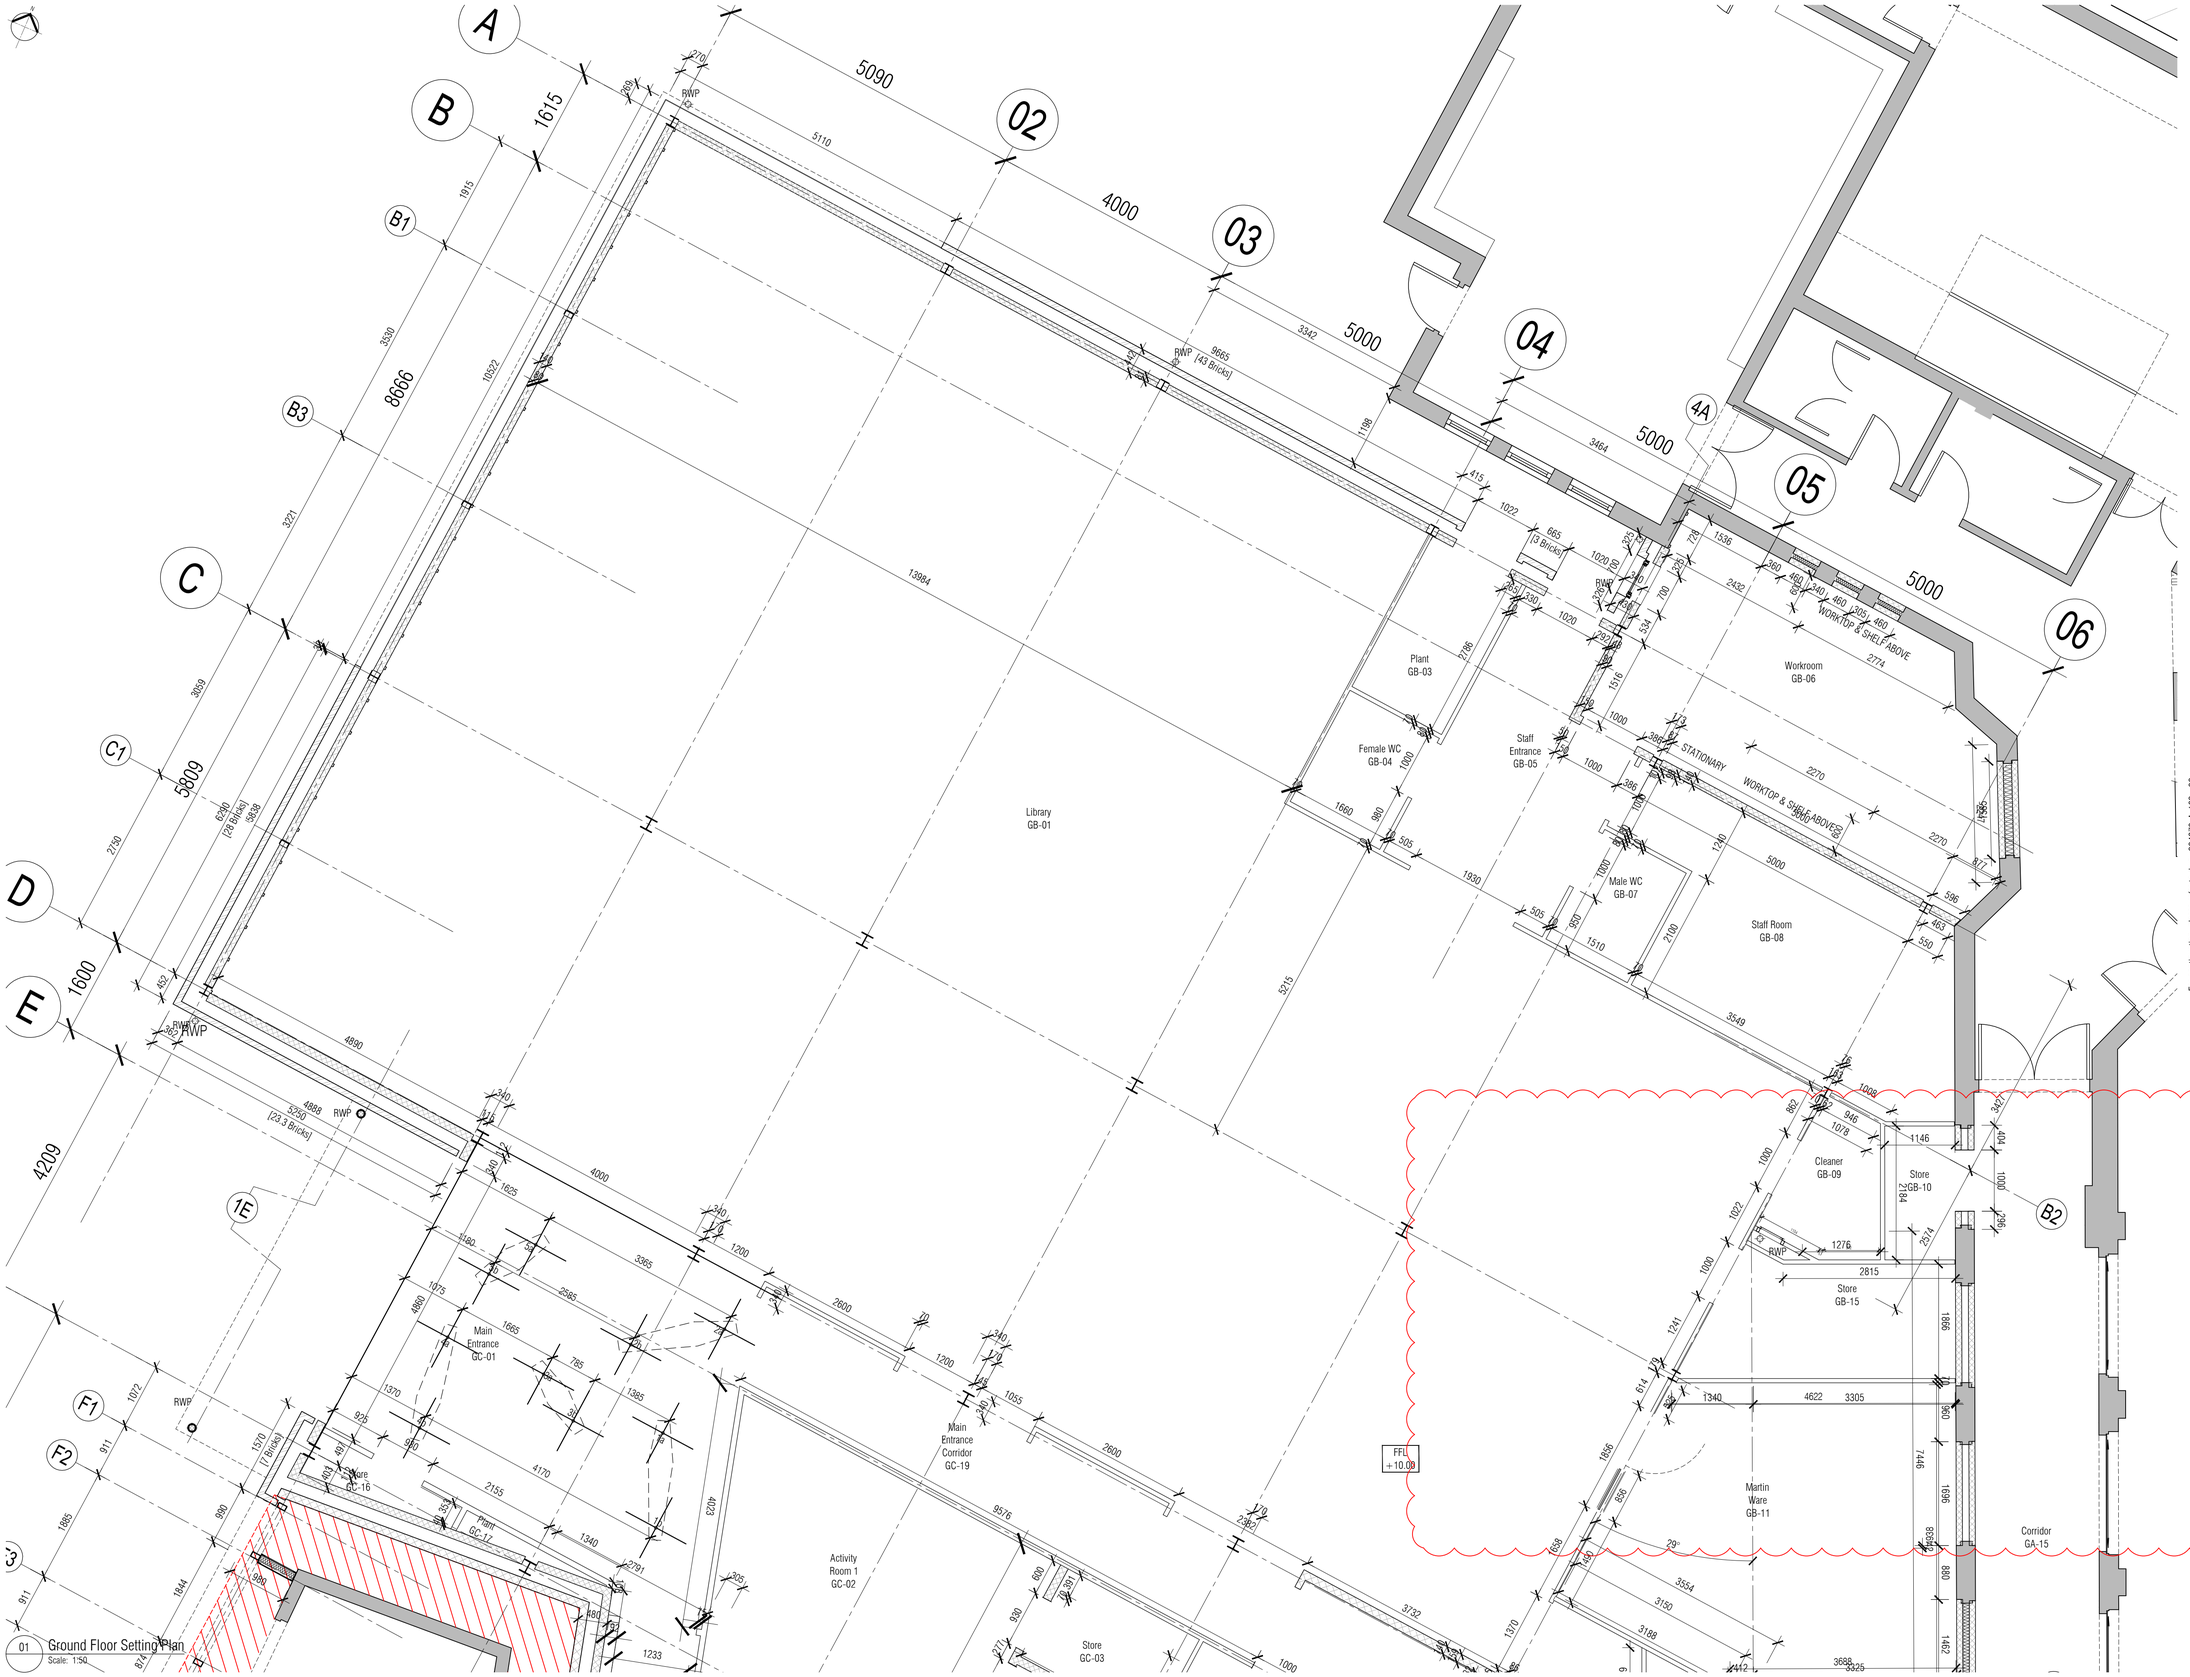
A
B
B1
B3
C
C1
D
E
1E
F1
F2
G3
01
02
03
04
4A
05
06
B2
Library
GB-01
Main
Entrance
GC-01
Store
GC-16
Plant
GC-17
Activity
Room 1
GC-02
Main
Entrance
Corridor
GC-19
Store
GC-03
Plant
GB-03
Female WC
GB-04
Staff
Entrance
GB-05
Workroom
GB-06
Male WC
GB-07
Staff Room
GB-08
Cleaner
GB-09
Store
GB-10
Store
GB-15
Martin
Ware
GB-11
Corridor
GA-15
WORKTOP & SHELF ABOVE
STATIONARY
FFL
+10.00
RWP
5090
4000
5000
3342
3464
1615
1915
3530
8666
10322
3221
13984
3059
5809
6320
[28.4 Bricks]
9838
2750
1600
4890
4868
5250
[23.3 Bricks]
4209
9665
[43 Bricks]
865
[3 Bricks]
1020
1536
2432
2774
2186
1516
1000
534
1660
960
505
1930
5275
1510
2109
3549
5000
2270
1240
1146
1078
946
1008
1276
2815
2574
2184
1241
1340
4622
3305
1856
3554
3150
3188
3668
3325
2791
4170
2155
4025
9576
3732
2600
1200
1055
1233
1625
2585
1665
1370
1386
1075
4860
1072
1570
[7 Bricks]
911
1844
1185
990
874
1600
1962
1936
1446
1961

For continuation, please refer to dwg: 224970-A-130

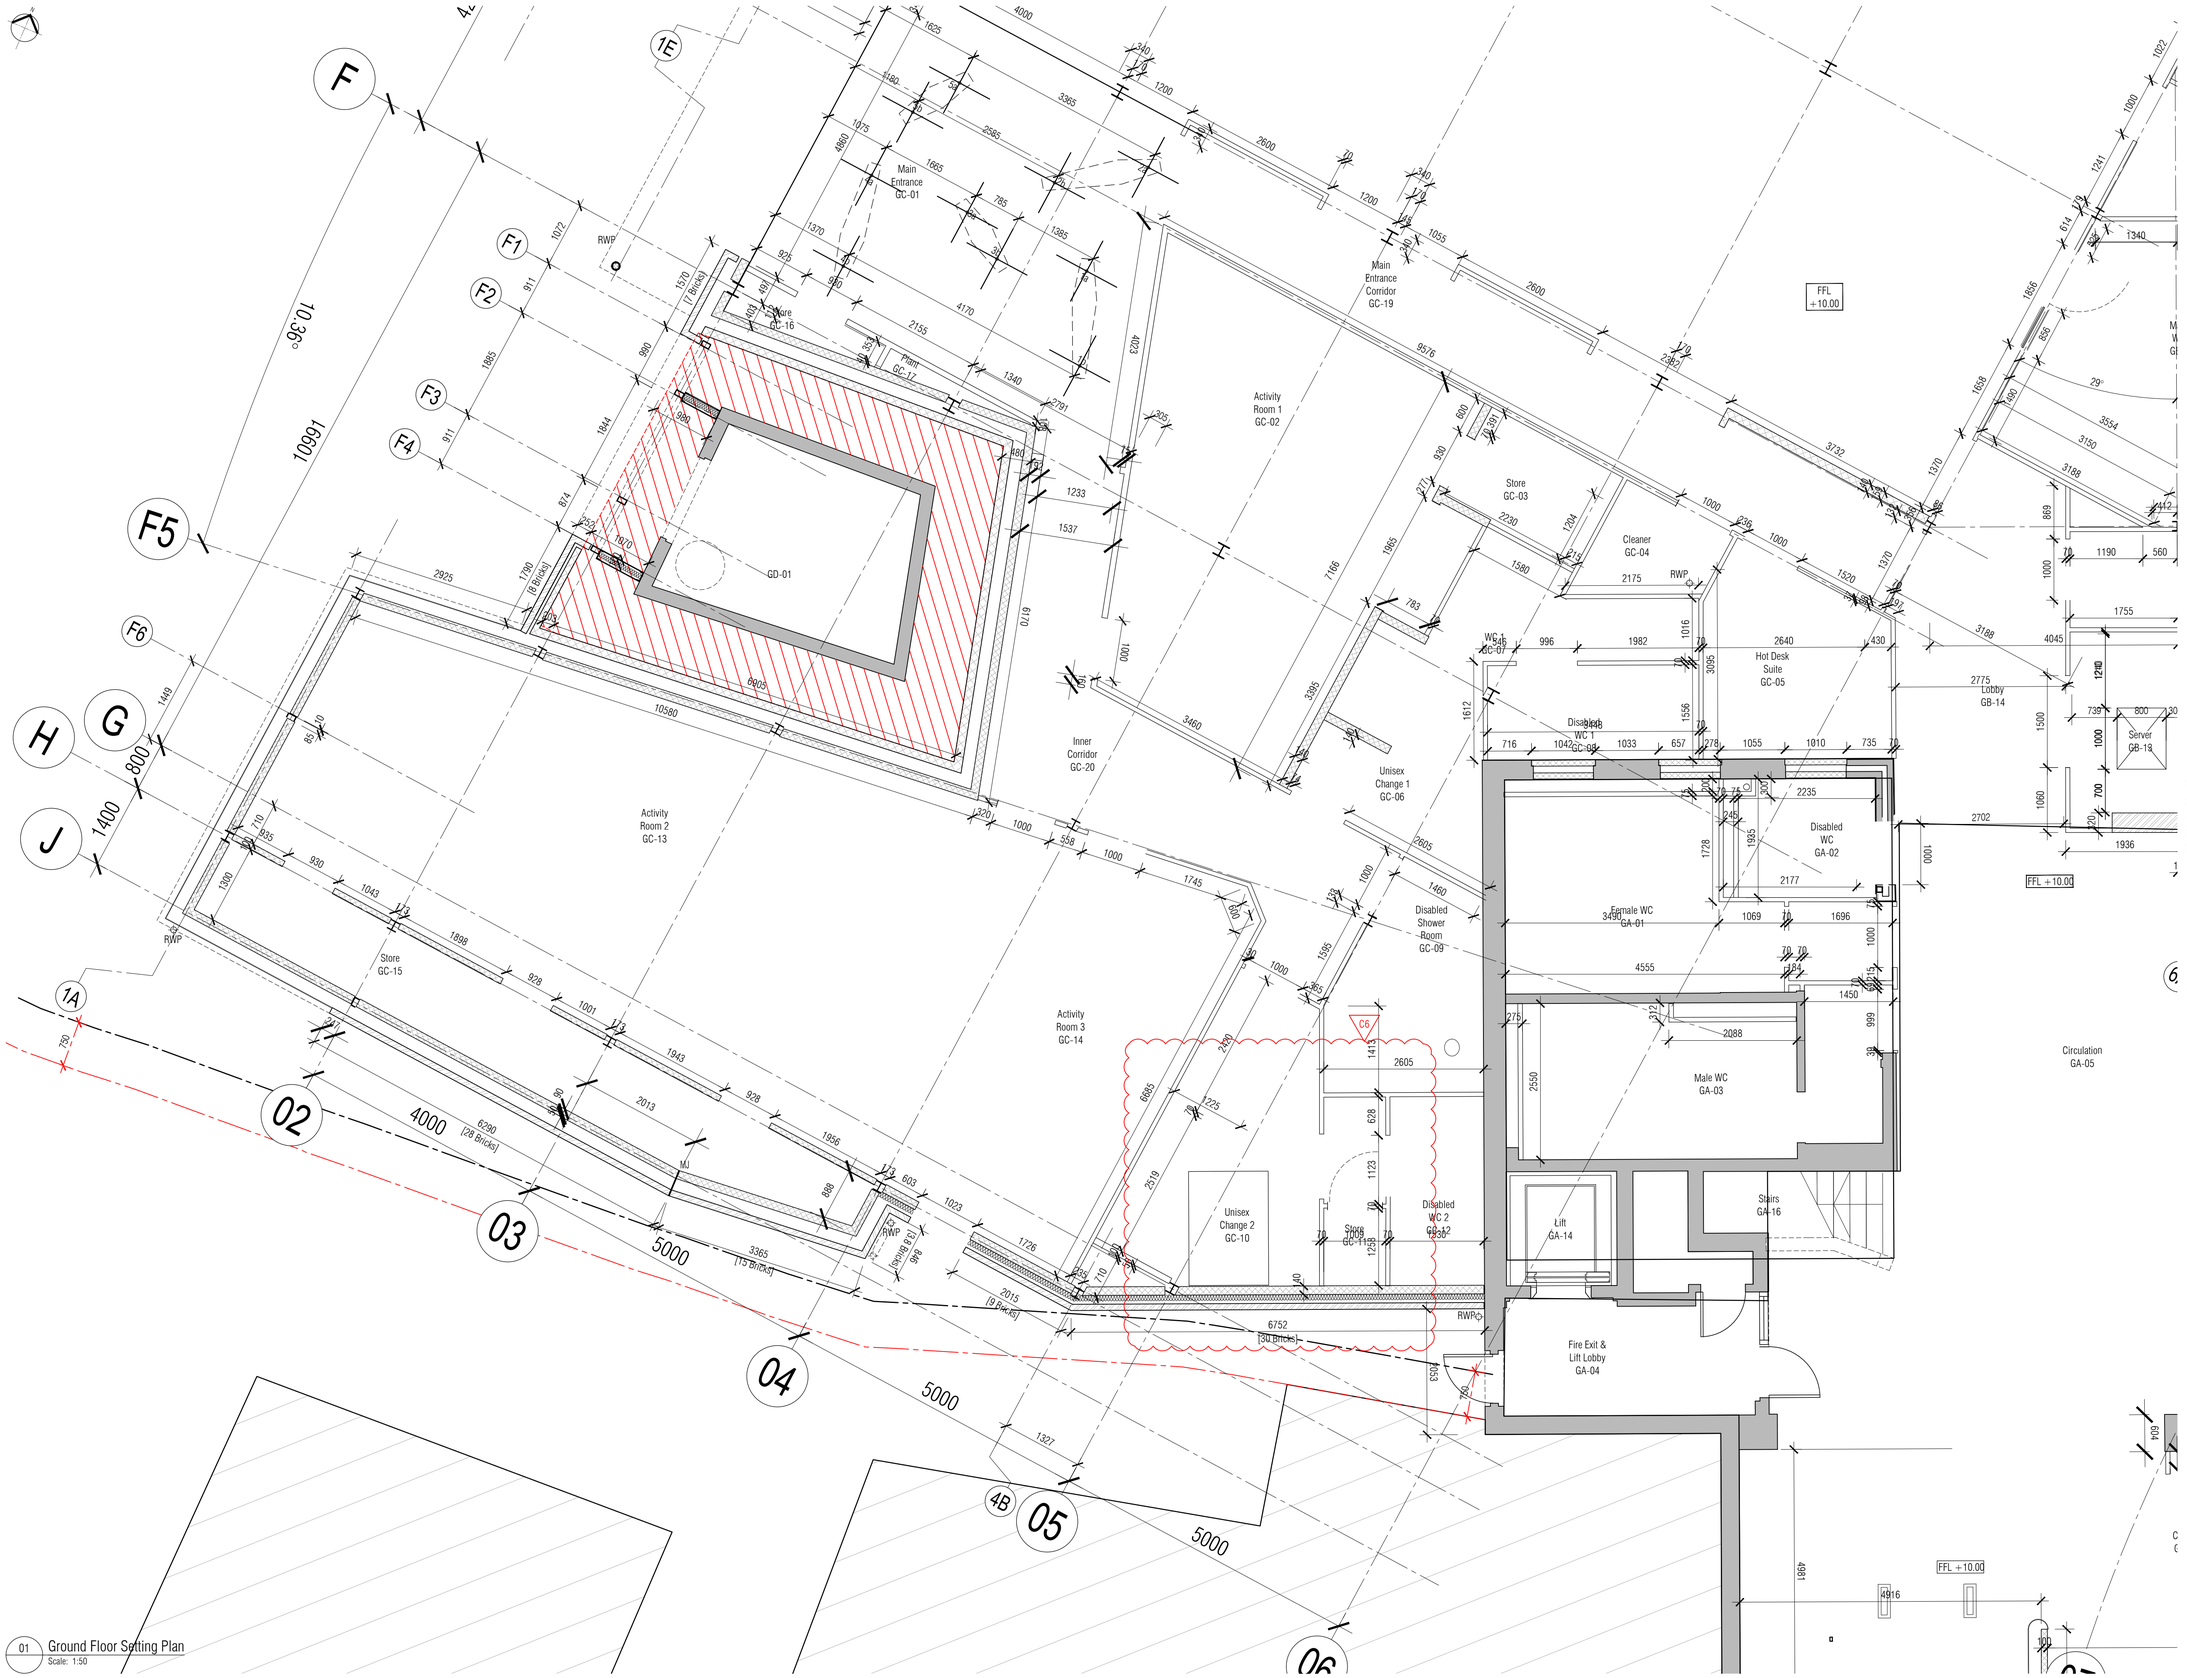


01 Ground Floor Setting Plan
Scale: 1:50

For continuation, please refer to dwg: 224970-A-132 - 01

NOTES: Do not scale this drawing. All dimensions to be checked on site prior to commencement or manufacture.

Key Plan
(nts)

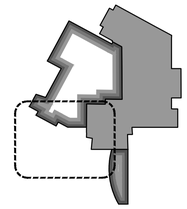

All steelwork to be erected in accordance with Structural Engineer's design and specification. For all steelwork information inc. bracing, refer to Structural Engineers drawings

ISSUED FOR CONSTRUCTION

Rev	Date	By	Chk	Comment
C6	29.04.14	CH	AC	WC adjusted
C5	11.12.13	CH	AC	Corridor walls adjusted
C4	04.12.13	CH	AC	Plant room omitted
C3	28.11.13	CH	AC	Brick setting out
C2	21.11.13	CH	AC	Dims added
C1	24.10.13	MLE	CH	Wall to GC02 moved
T2	NYI	RKC	JAS	walls revd
T1	02.04.13	RKC	JAS	DRAWING ISSUED FOR TENDER

BRINGING IDEAS TO LIFE

FRANKHAM

Frankham Consultancy Group Limited
21 Perrymount Road
Haywards Heath RH16 3TP
t 01444 444900 f 01444 455642
enquire@frankham.com
www.frankham.com

Client
Ealing
www.ealing.gov.uk

Project Title
Dominion Arts Centre
Southall
London

Drawing Title
Proposed
Ground Floor Setting Out Plan
2 of 3


Drawn by:	Scale:	Date:
RKC	1:50@A1	21.02.13
Designed by: FCG	Checked by: -	Approved by: -

File Ref.: X:\2009\2124973 - EALING, DOMINION ARTS CENTRE\ARCH\3D_VB_LOCATION PLANS AND GA\ 224970-A-131.DWG - 20/06/11:13:32:44

Drawing No.	Rev.
224970-A-131	C6




01 Ground Floor Setting Plan
Scale: 1:50

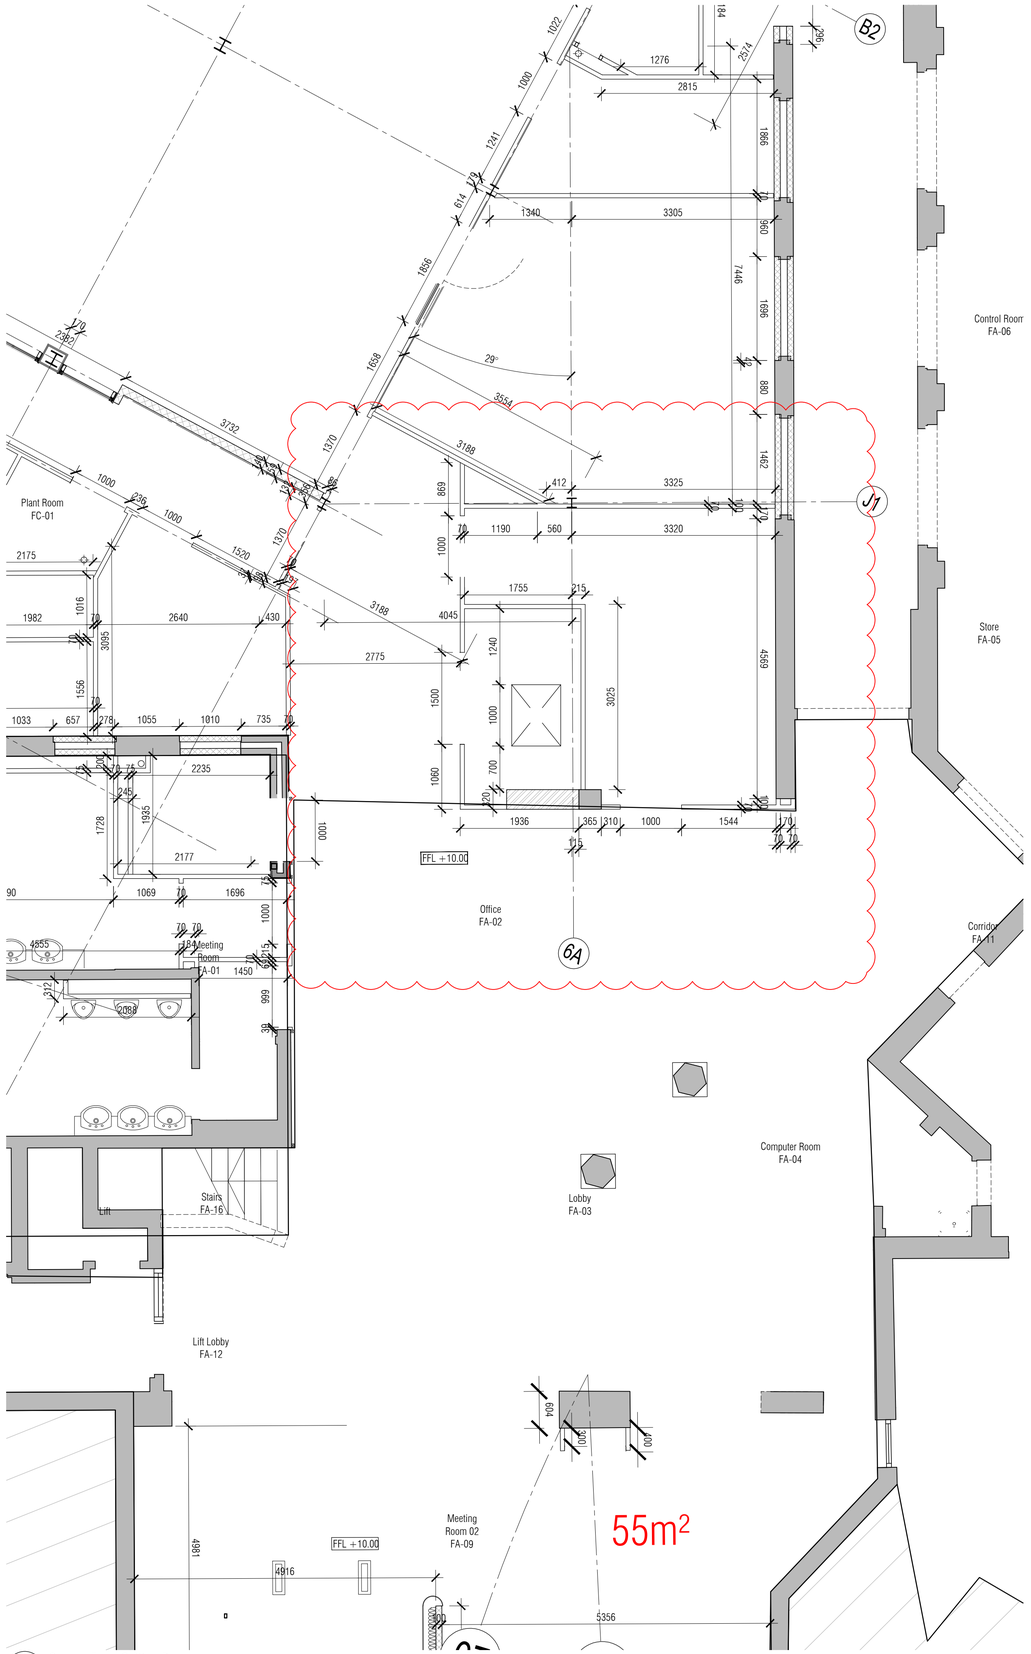

02 Ground Floor Setting Plan
Scale: 1:50

NOTES: Do not scale this drawing. All dimensions to be checked on site prior to commencement or manufacture.

Key Plan
(nts)

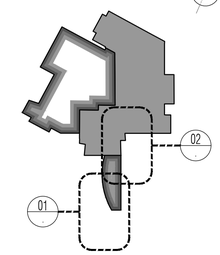

All steelwork to be erected in accordance with Structural Engineer's design and specification. For all steelwork information inc. bracing, refer to Structural Engineers drawings

ISSUED FOR CONSTRUCTION

Rev	Date	By	Chk	Comment
C4	24.01.14	CH	AC	Server Room adapted
C3	23.01.14	CH	AC	Server Room adapted
C2	23.01.14	CH	AC	Server Room adapted
C1	17.07.13	PR	AC	DRAWING ISSUED FOR CONSTRUCTION

BRINGING IDEAS TO LIFE

FRANKHAM

Frankham Consultancy Group Limited
21 Perrymount Road
Haywards Heath RH16 3TP
t 01444 444900 f 01444 456642
enquire@frankham.com
www.frankham.com

Client
Ealing
www.ealing.gov.uk


Project Title
Dominion Arts Centre
Southall
London

Drawing Title
Proposed
Ground Floor Setting Out Plan
3 of 3

Drawn by:	Scale:	Date:
RKC	1:50@A1	21.02.13
Designed by:	Checked by:	Approved by:
FCG	-	-


File Ref.: X:\2009\02\224970 - LB EALING - DOMINION ARTS CENTRE\ARCH\02_100_LOCATION PLANS AND SA\...\224970-A-132.DWG - 20/06/13 20:06:11:13:32:54

Drawing No. 224970-A-132
Rev. C4

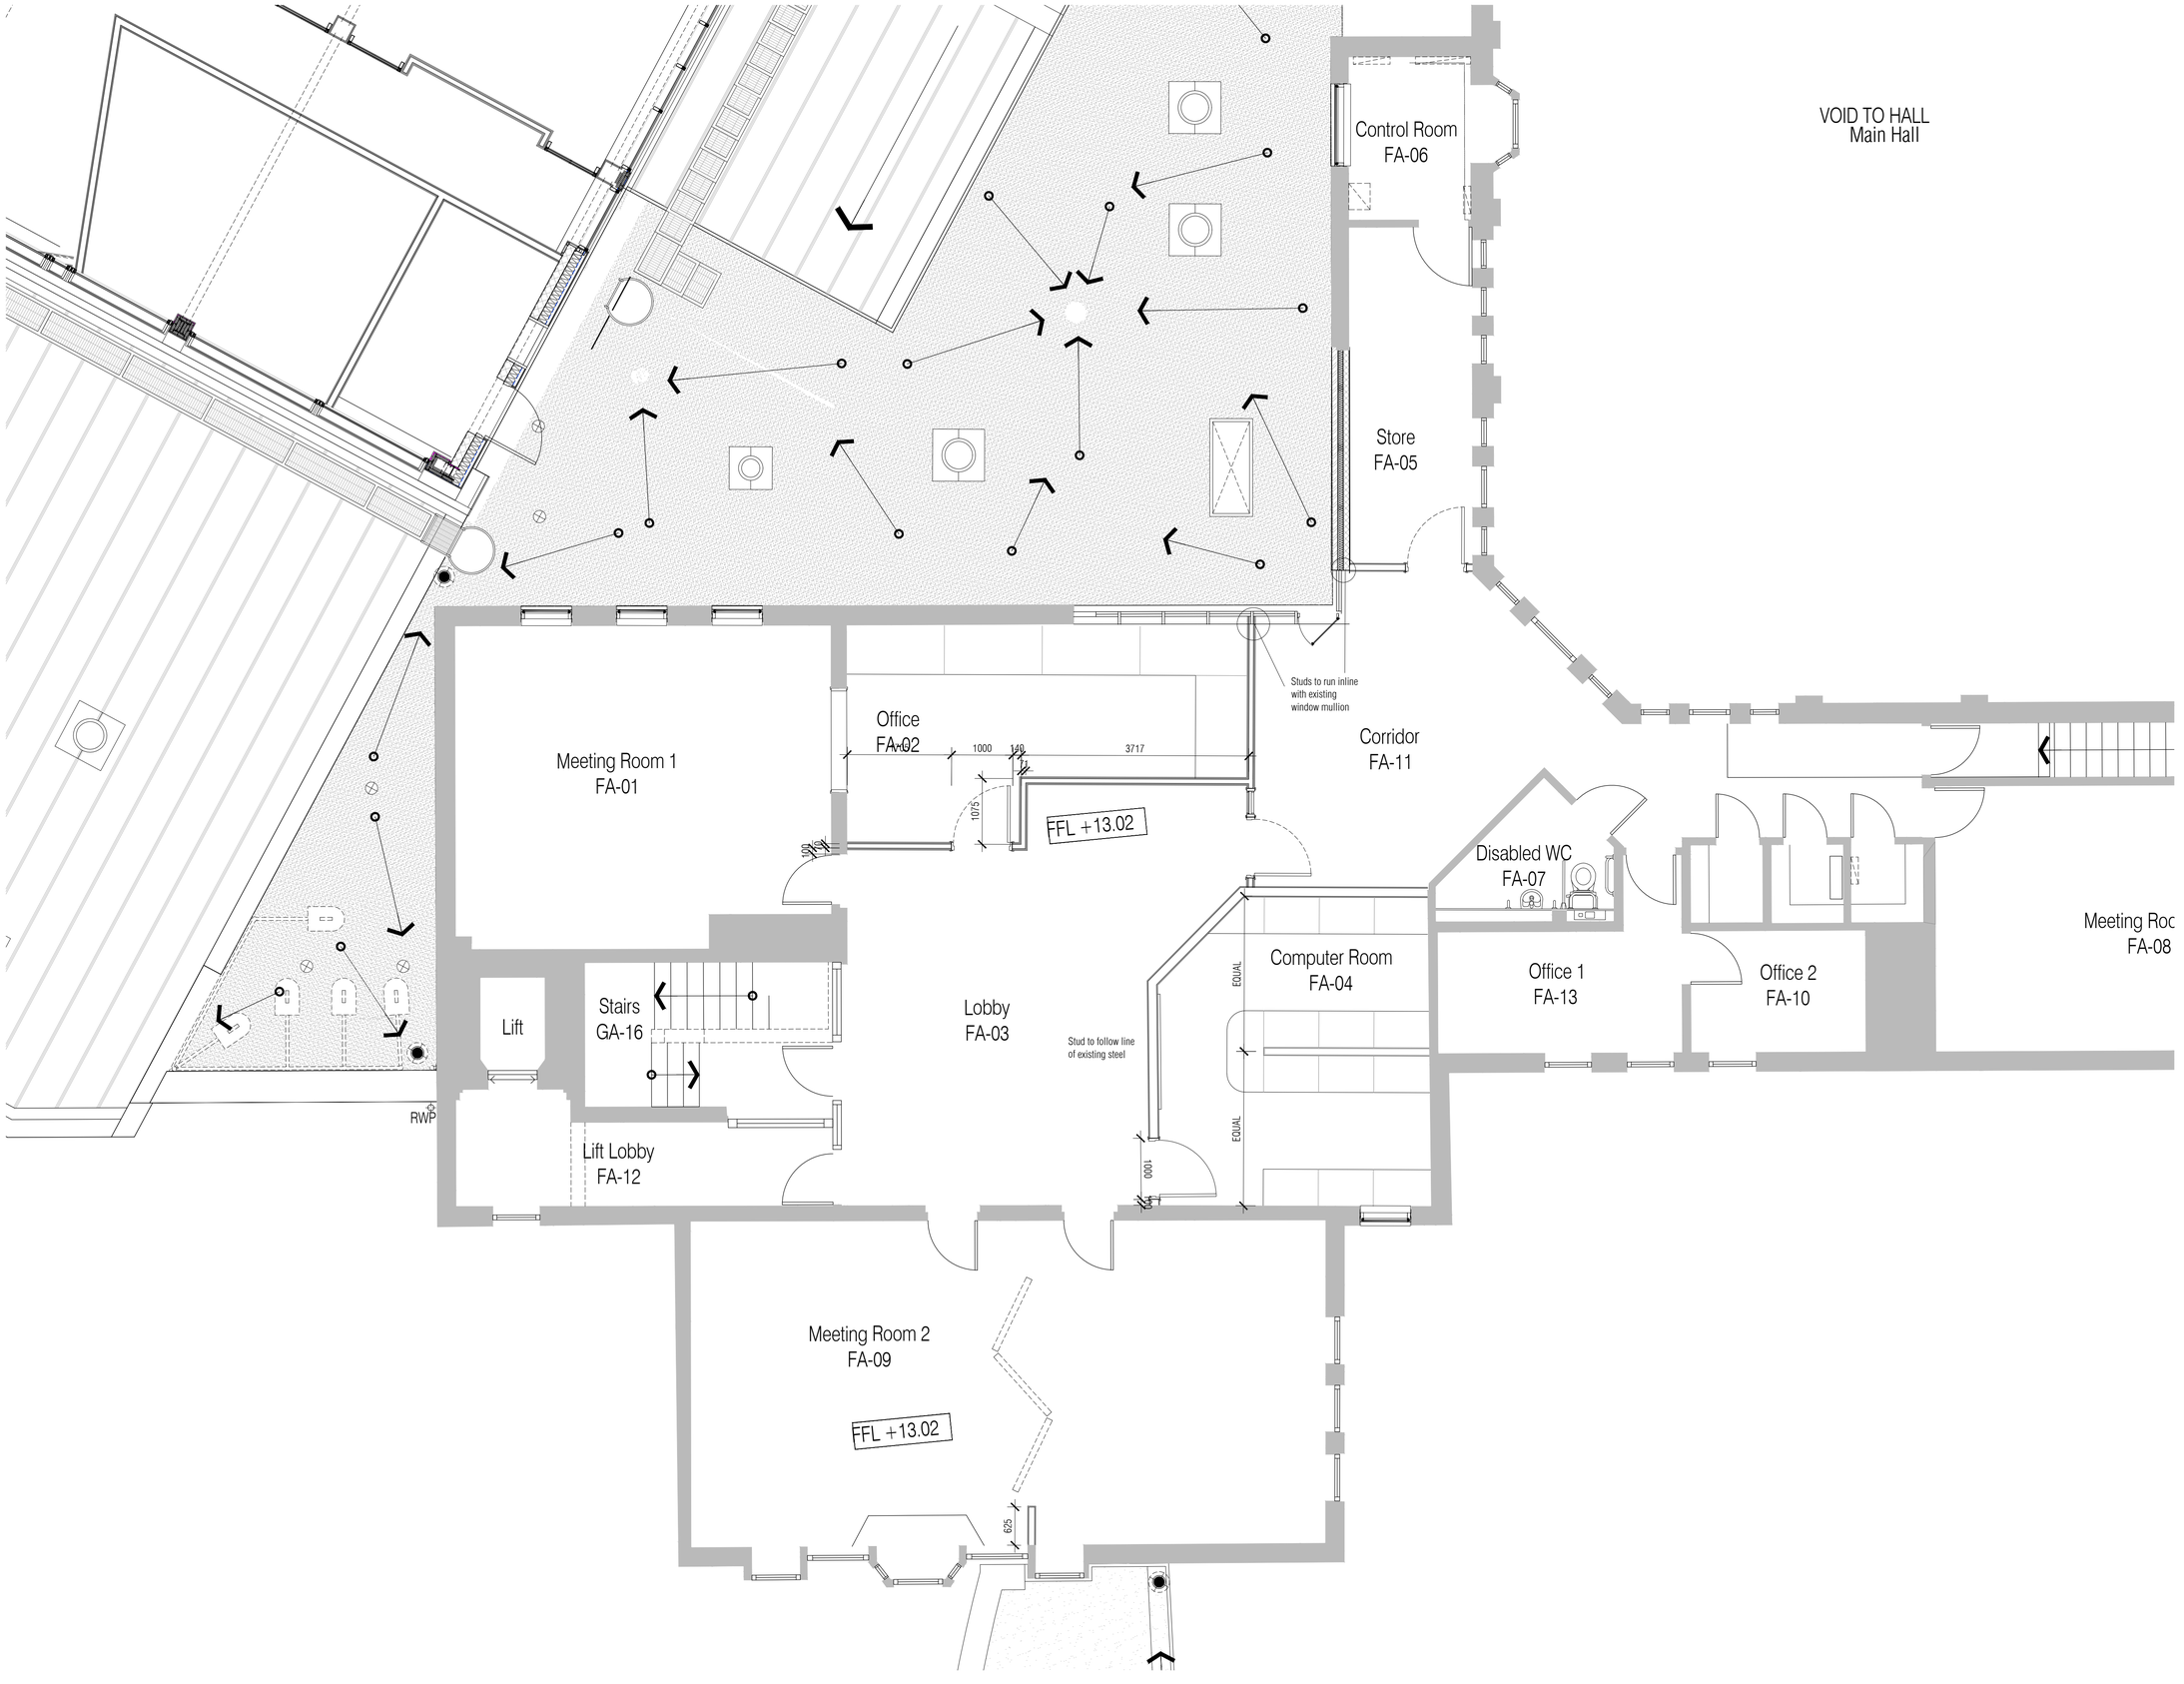

NOTES: Do not scale this drawing. All dimensions to be checked on site prior to commencement or manufacture.

Key Plan
(nts)

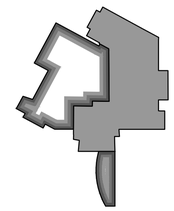

ISSUED FOR CONSTRUCTION

Rev	Date	By	Chk	Comment
C1	30.08.13	CH	AC	DRAWING ISSUED FOR CONSTRUCTION

BRINGING IDEAS TO LIFE

FRANKHAM

Frankham Consultancy Group Limited
21 Perrymount Road
Haywards Heath RH16 3TP
t 01444 444900 f 01444 455642
enquire@frankham.com
www.frankham.com

Client
Ealing
www.ealing.gov.uk


Project Title
Dominion Arts Centre
Southall
London

Drawing Title
Proposed First Floor Plan
Setting out Plan

Drawn by:	Scale:	Date:
RKC	1:50@A1	30.08.13
Designed by:	Checked by:	Approved by:
FCG	-	-

File Ref.: K:\2000\224970 - LB EALING - DOMINION ARTS CENTRE\ARCH\100_199_LOCATION PLANS AND GA\224970-A-133.DWG - 30/08/13 03:01
20:06:11 13:33:04

Drawing No. 224970-A-133
Rev. C1

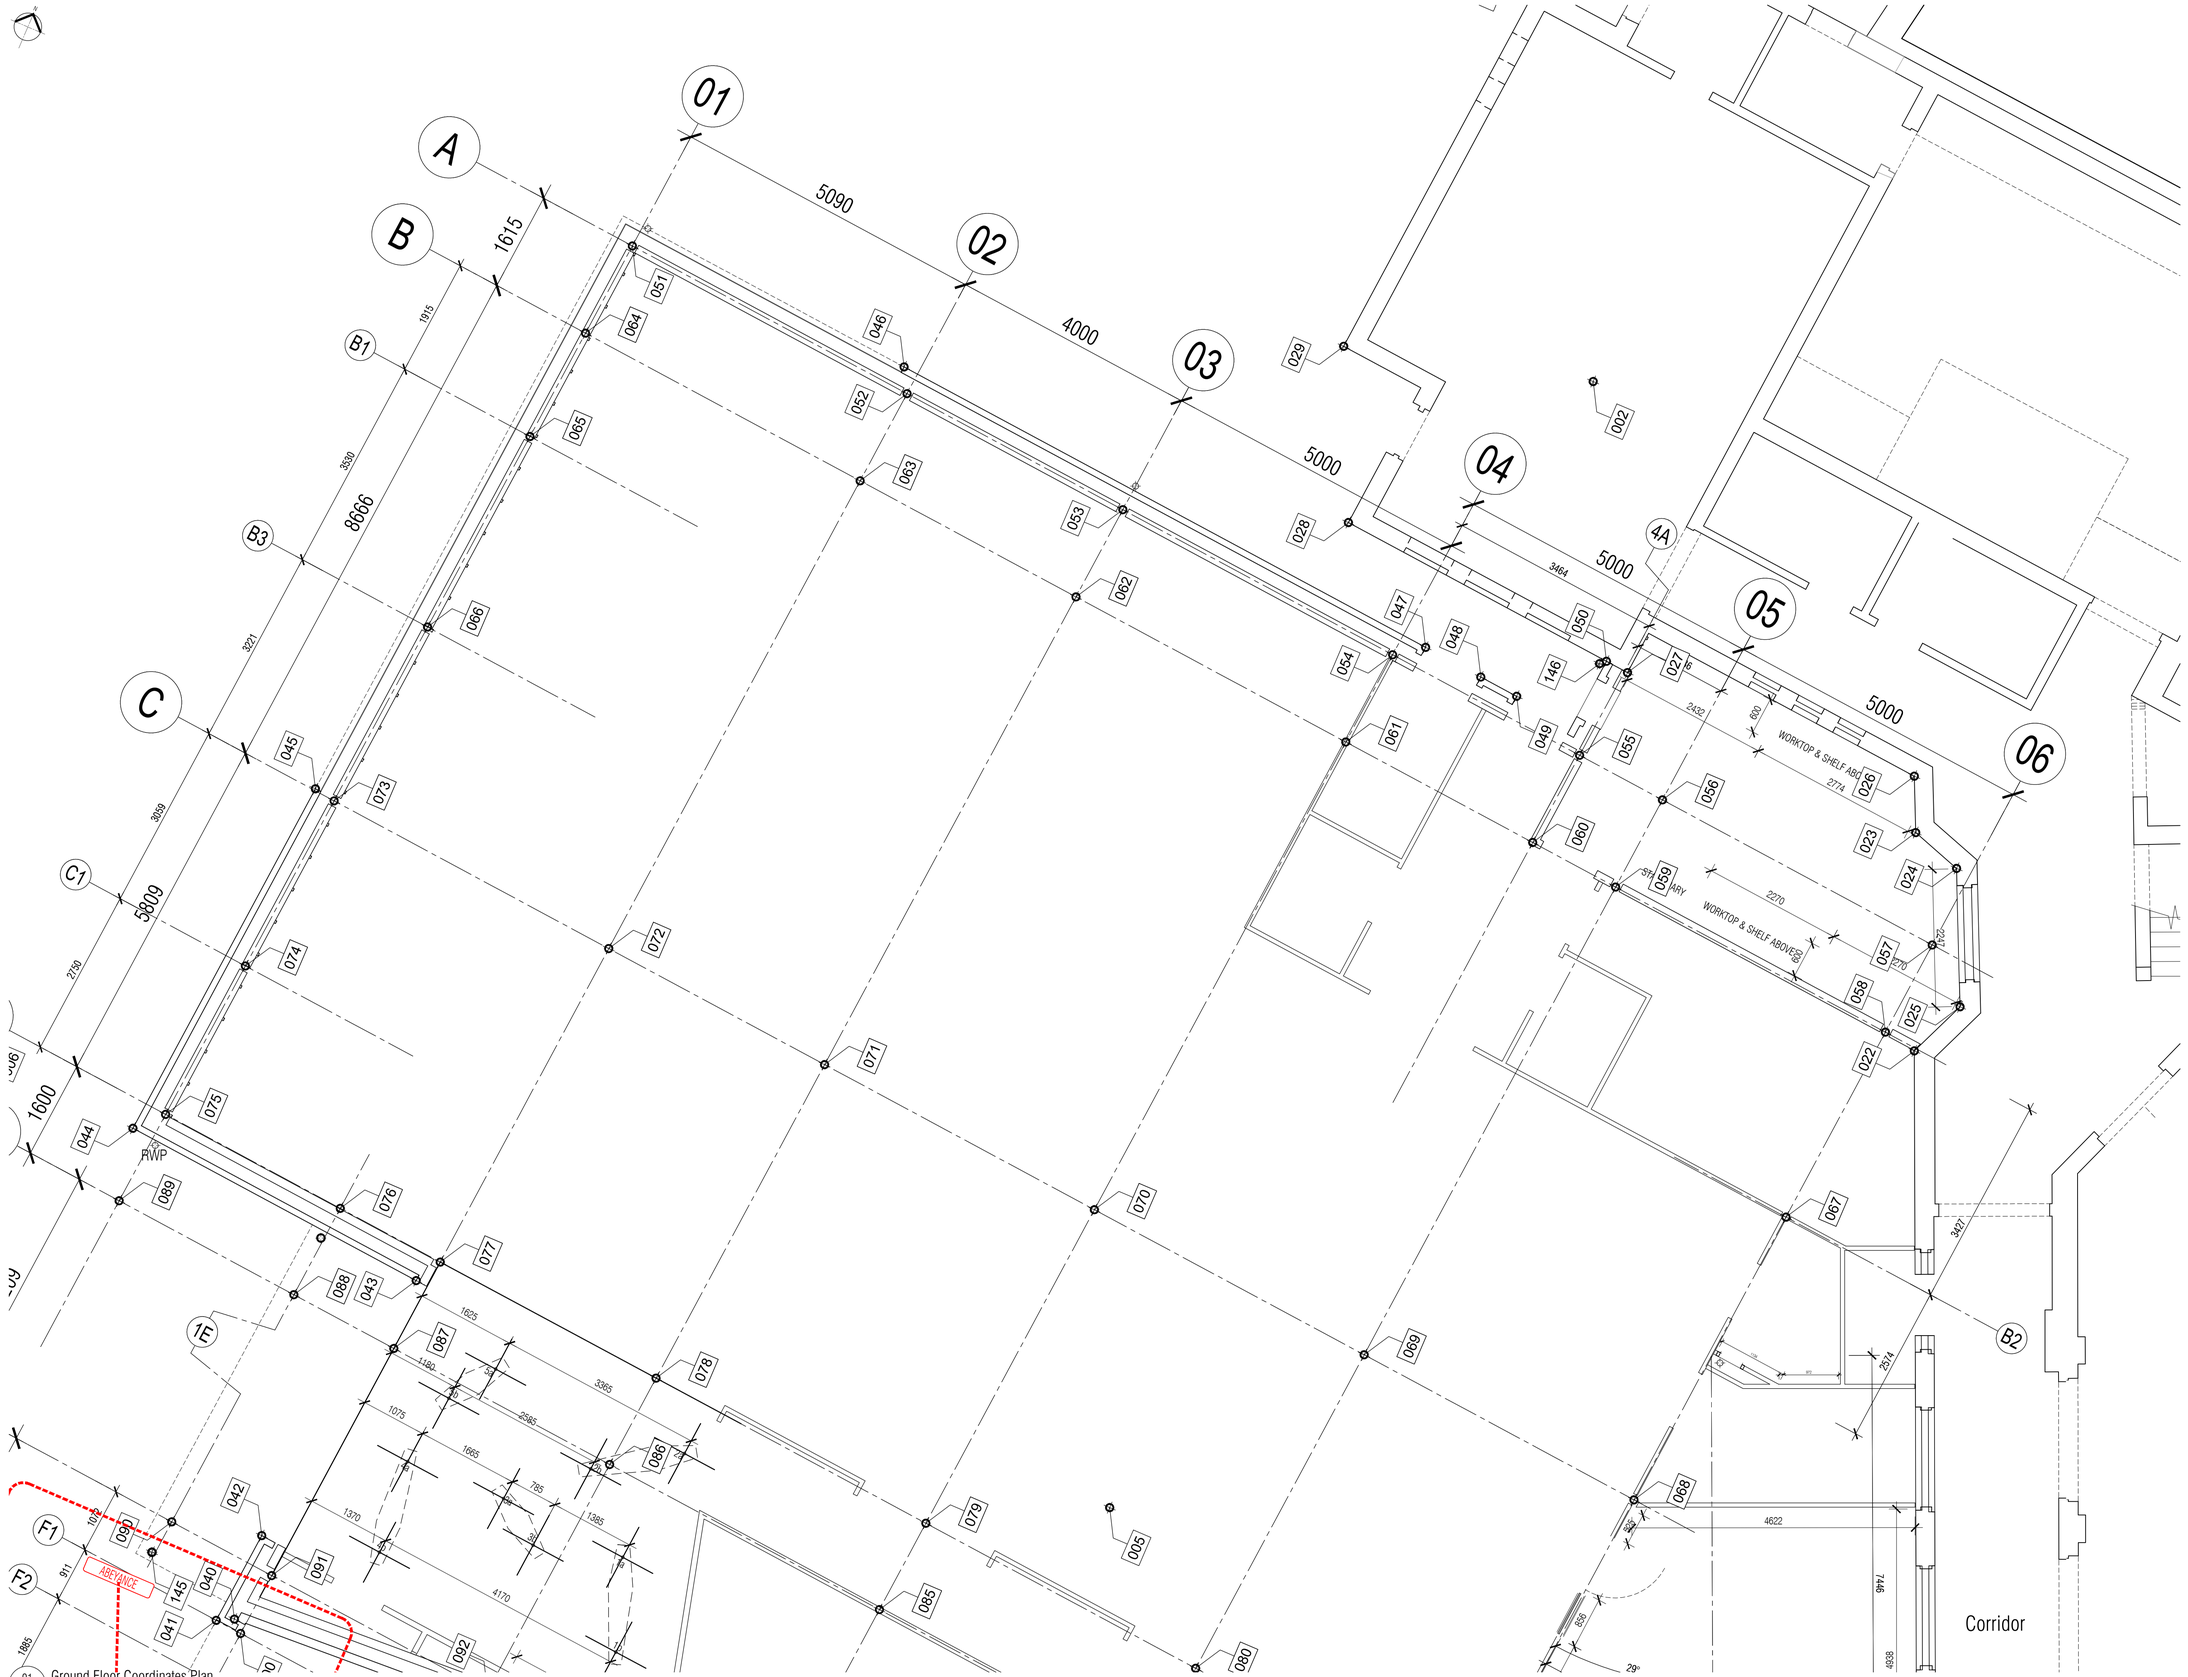


01 Ground Floor Coordinates Plan
Scale: 1:50

For continuation, please refer to dwg: 224970-A-136

NOTES: Do not scale this drawing. All dimensions to be checked on site prior to commencement or manufacture.

Key Plan
(nts)

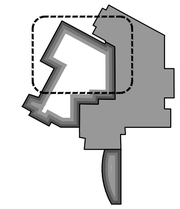

Checking and Setting Out Coordinates									
REF	EASTING	NORTHING	REF	EASTING	NORTHING	REF	EASTING	NORTHING	
047	512379.199	179454.934	120	512366.838	179421.837	119	512370.822	179421.487	
048	512380.017	179454.644	121	512363.768	179422.107	120	512366.838	179421.837	
049	512380.88	179454.787	122	512363.646	179420.712	121	512363.768	179422.107	
050	512382.001	179455.89	123	512366.715	179420.442	122	512363.646	179420.712	
051	512364.717	179455.644	124	512370.7	179420.092	123	512366.715	179420.442	
052	512368.787	179455.398	125	512375.68	179419.854	124	512370.7	179420.092	
053	512373.772	179455.048	126	512379.339	179419.333	125	512375.68	179419.854	
054	512378.752	179454.61	127	512380.561	179419.217	126	512379.339	179419.333	
055	512382.203	179454.307	128	512385.642	179418.779	127	512380.561	179419.217	
056	512383.733	179454.173	129	512387.439	179418.182	128	512385.642	179418.779	
057	512388.714	179453.735	130	512400.538	179418.835	129	512387.439	179418.182	
058	512388.573	179452.126	131	512401.129	179418.963	130	512400.538	179418.835	
059	512383.592	179452.563	132	512402.095	179415.845	131	512401.129	179418.963	
060	512382.062	179452.698	133	512398.553	179414.339	132	512402.095	179415.845	
061	512378.611	179453.001	134	512400.188	179410.708	133	512398.553	179414.339	
062	512373.63	179453.439	135	512403.808	179412.544	134	512400.188	179410.708	
063	512369.645	179453.789	136	512405.444	179409.534	135	512403.808	179412.544	
064	512364.575	179454.234	137	512405.138	179409.406	136	512405.444	179409.534	
065	512364.406	179452.327	138	512402.312	179407.339	137	512405.138	179409.406	
066	512364.099	179448.81	139	512404.885	179404.299	138	512402.312	179407.339	
067	512388.273	179448.712	140	512406.583	179405.914	139	512404.885	179404.299	
068	512387.614	179443.493	141	512406.747	179406.112	140	512406.583	179405.914	
069	512382.633	179443.93	142	512407.127	179406.333	141	512406.747	179406.112	
070	512377.652	179444.368	143	512405.521	179403.667	142	512407.127	179406.333	
071	512372.671	179444.806	144	512395.83	179402.963	143	512405.521	179403.667	
072	512368.687	179445.156	145	512365.923	179433.161	144	512395.83	179402.963	
			146	512381.912	179450.81	145	512365.923	179433.161	
						146	512381.912	179450.81	

ISSUED FOR CONSTRUCTION

Rev	Date	By	Chk	Comment
C1	17.07.13	PR	AC	DRAWING ISSUED FOR CONSTRUCTION

BRINGING IDEAS TO LIFE

FRANKHAM

Frankham Consultancy Group Limited
21 Perrymount Road
Haywards Heath RH16 3TP
t 01444 444900 f 01444 456642
enquiries@frankham.com
www.frankham.com

Client
Ealing
www.ealing.gov.uk

Project Title
Dominion Arts Centre
Southall
London


Drawing Title
Proposed
Ground Floor Coordinates Setting Out Plan
1 of 3

Drawn by:	Scale:	Date:
RKC	1:50@A1	10.05.13
Designed by:	Checked by:	Approved by:
FCG	-	-

File Ref.: X:\2009\09C21470 - LB EALING - DOMINION ARTS CENTRE\ARCH\ISE 19B_LOCATION PLANS AND GA\...\24970-A-135.DWG - 20/06/11 13:33:16

Drawing No.	Rev.
224970-A-135	C1

For continuation, please refer to dwg: 224970-A-135

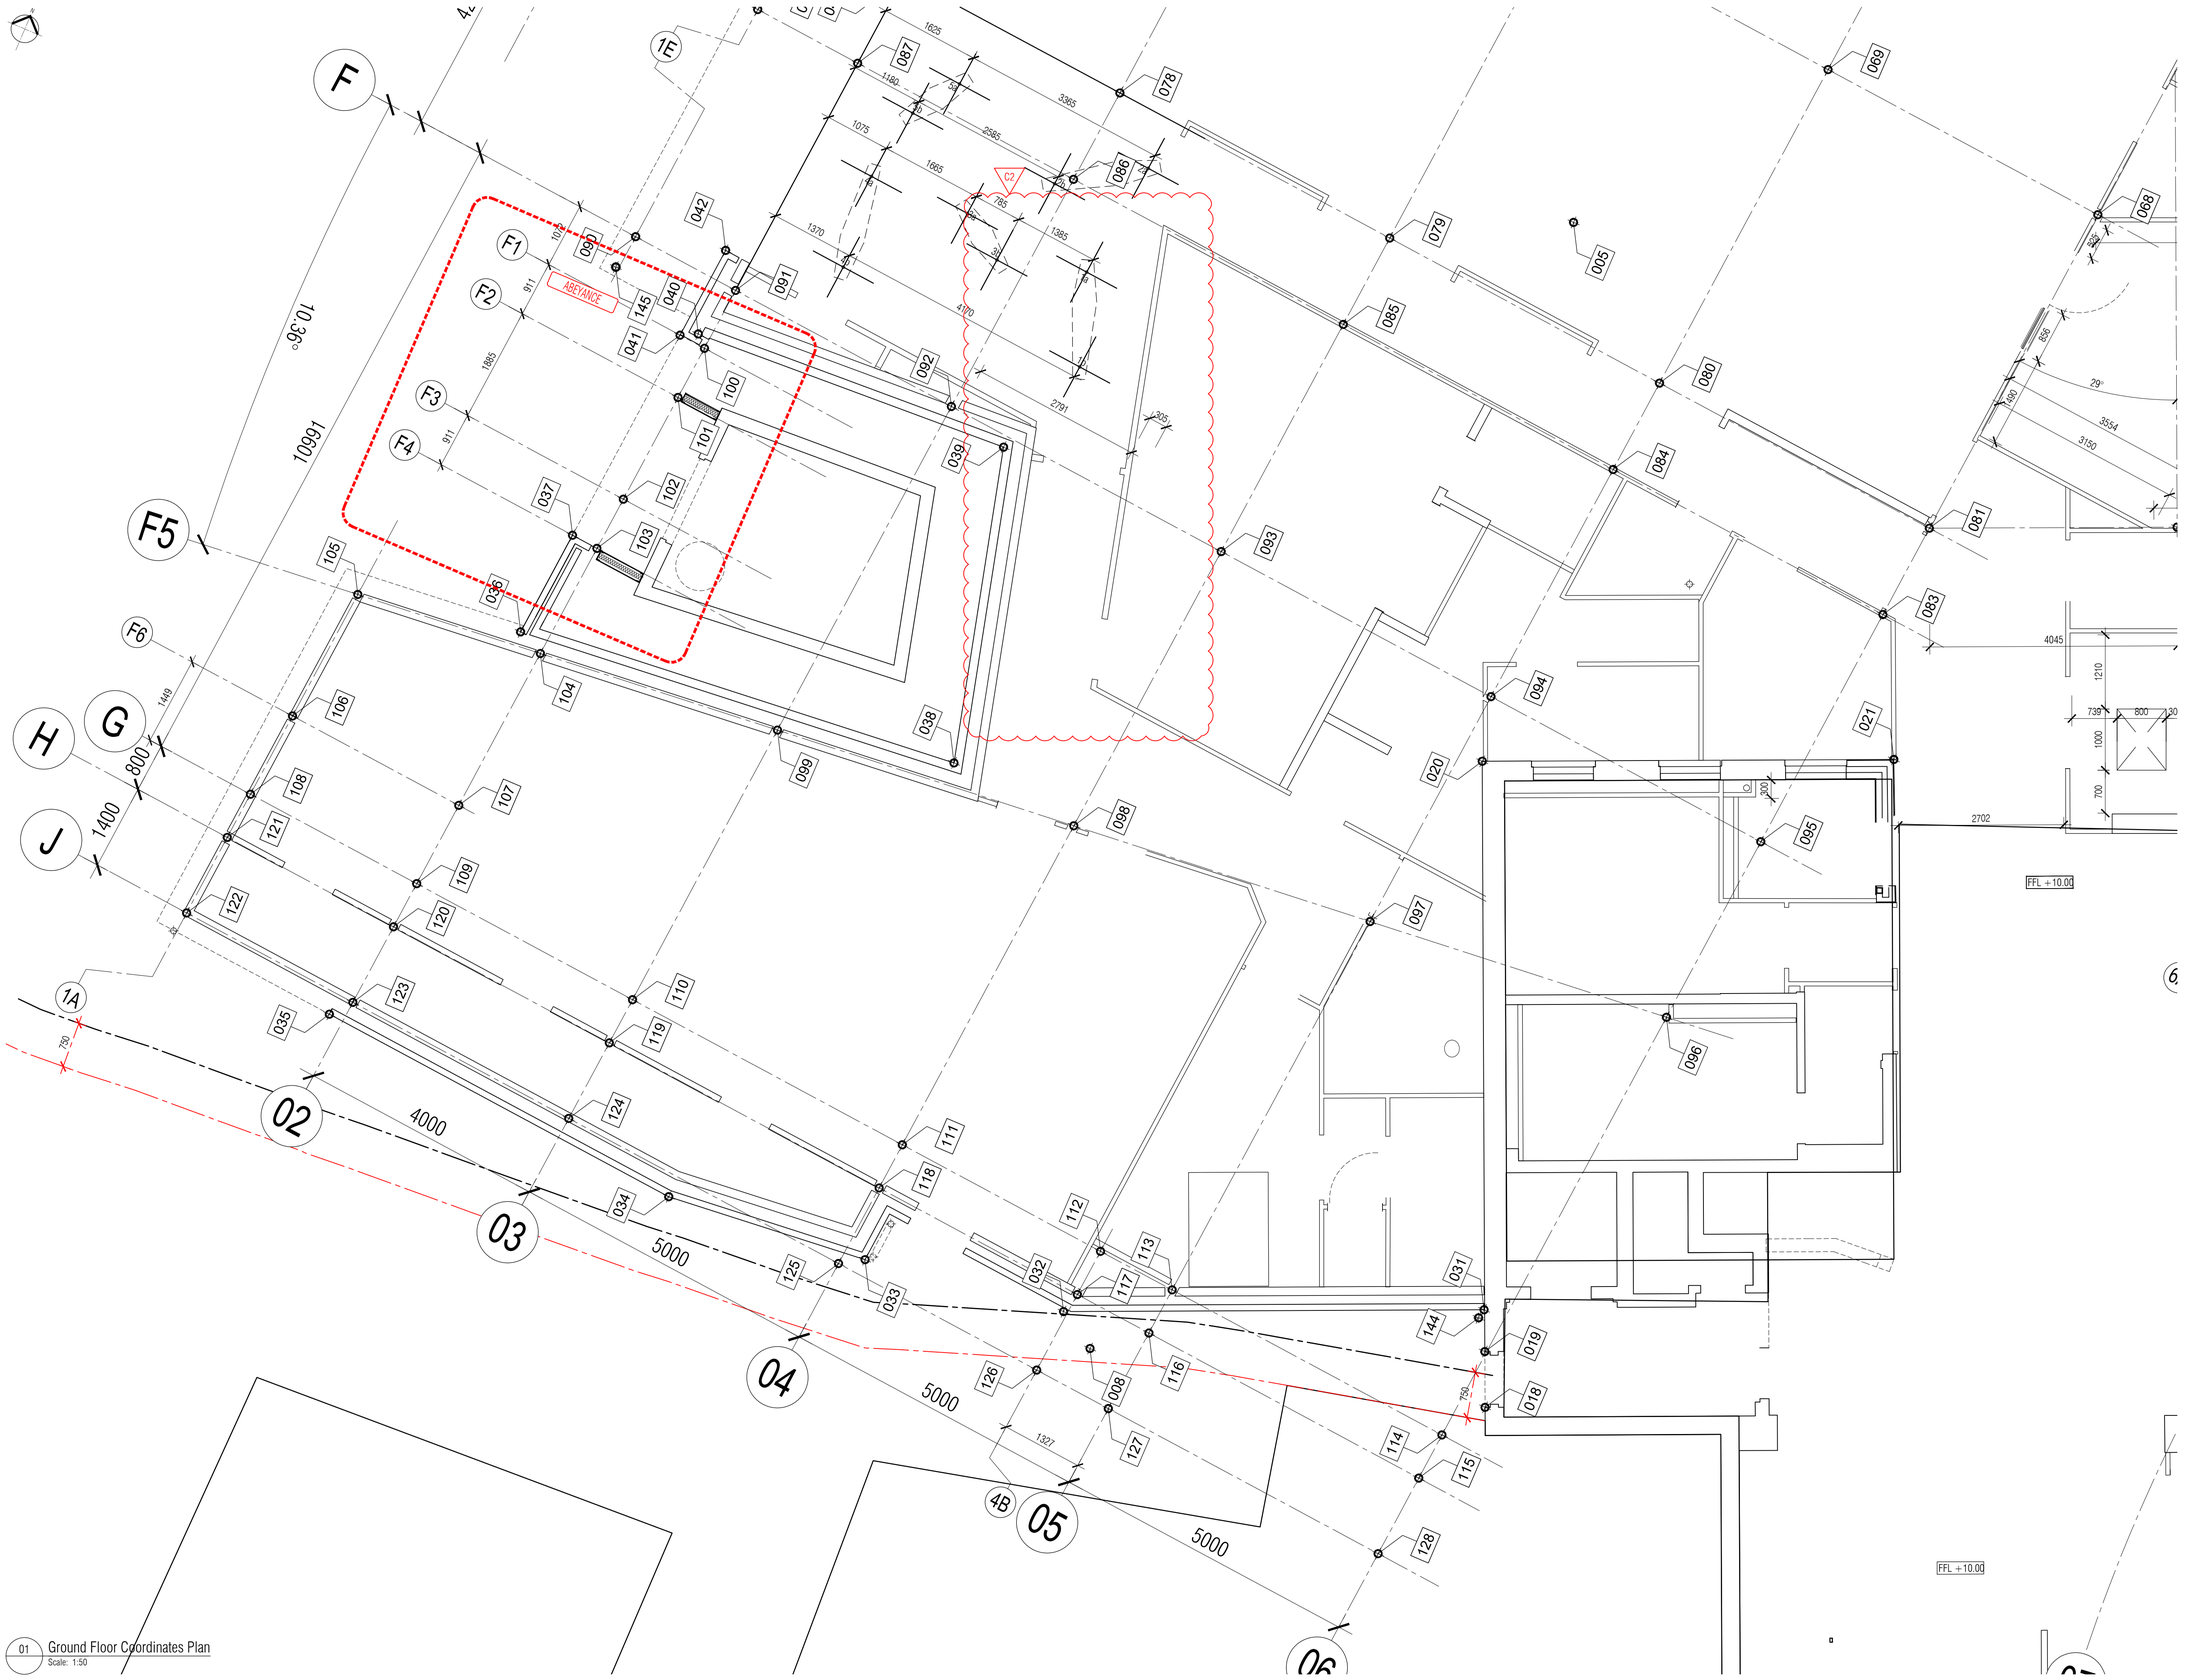


For continuation, please refer to dwg: 224970-A-137 - 01

01 Ground Floor Coordinates Plan
Scale: 1:50

NOTES: Do not scale this drawing. All dimensions to be checked on site prior to commencement or manufacture.

Key Plan
(nts)

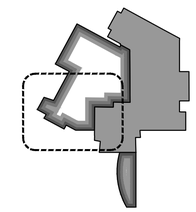

Checking and Setting Out Coordinates							
REF	EASTING	NORTHING		REF	EASTING	NORTHING	
001	512380	179480		073	512363.817	179445.602	
002	512380	179460		074	512363.599	179442.554	
003	512400	179460		075	512363.308	179439.815	
004	512400	179440		076	512366.533	179439.531	
005	512380	179440		077	512368.378	179439.369	
006	512360	179440		078	512372.583	179439.019	
007	512360	179420		079	512377.344	179438.581	
008	512380	179420		080	512382.325	179438.144	
009	512400	179420		081	512387.305	179437.706	
010	512400	179400		082	512391.015	179438.318	
011	512404.823	179399.993		083	512387.165	179436.112	
012	512401.508	179398.309		084	512382.184	179436.55	
013	512402.424	179415.224		085	512377.204	179436.988	
014	512401.87	179418.357		086	512372.223	179437.425	
015	512400.731	179418.674		087	512368.238	179437.776	
016	512398.731	179420.483		088	512366.393	179437.938	
017	512392.245	179417.639		089	512363.168	179438.221	
018	512386.504	179421.662		090	512366.025	179433.743	
019	512385.942	179422.497		091	512367.87	179433.583	
020	512382.101	179411.332		092	512371.854	179433.233	
021	512388.262	179434.51		093	512376.835	179432.795	
022	512389.127	179452.031		094	512381.816	179432.357	
023	512387.743	179455.313		095	512386.797	179431.919	
024	512388.586	179455.039		096	512386.572	179428.879	
025	512389.529	179452.987		097	512381.451	179428.206	
026	512387.598	179452.15		098	512378.39	179427.733	
027	512382.389	179455.856		099	512377.33	179427.26	
028	512377.237	179456.309		100	512367.776	179432.515	
029	512376.032	179458.921		101	512367.696	179431.607	
030	512376.618	179465.044		102	512367.531	179429.729	
031	512385.66	179423.119		103	512367.451	179428.822	
032	512379.565	179425.383		104	512367.281	179426.881	
033	512376.054	179419.663		105	512364.162	179426.59	
034	512372.704	179419.563		106	512363.965	179425.348	
035	512366.438	179420.113		107	512367.035	179424.079	
036	512366.644	179427.078		108	512363.838	179422.903	
037	512367.001	179428.861		109	512366.908	179422.633	
038	512374.189	179427.905		110	512370.892	179422.283	
039	512372.899	179432.958		111	512375.873	179421.846	
040	512387.591	179432.89		112	512379.532	179421.524	
041	512367.326	179432.564		113	512380.854	179421.408	
042	512367.463	179434.118		114	512380.934	179420.97	
043	512368.137	179438.937		115	512385.765	179420.174	
044	512362.508	179439.396		116	512380.784	179420.611	
045	512363.456	179445.662		117	512379.462	179420.728	
046	512368.571	179453.78		118	512375.803	179421.049	
047	512379.199	179454.934		119	512370.822	179421.487	
048	512380.217	179454.844		120	512366.838	179421.837	
049	512380.88	179454.787		121	512363.768	179422.107	
050	512382.001	179454.89		122	512363.646	179420.712	
051	512364.717	179455.844		123	512366.715	179420.442	
052	512369.787	179455.398		124	512370.7	179420.092	
053	512373.772	179455.048		125	512375.68	179419.654	
054	512378.752	179454.61		126	512379.339	179419.333	
055	512382.203	179454.307		127	512380.561	179419.217	
056	512383.733	179454.173		128	512385.642	179418.779	
057	512388.714	179453.735		129	512397.439	179418.162	
058	512388.573	179452.126		130	512400.538	179418.835	
059	512383.592	179452.563		131	512401.129	179418.963	
060	512382.062	179452.688		132	512402.095	179415.645	
061	512378.611	179453.001		133	512398.553	179414.339	
062	512373.63	179453.439		134	512400.188	179410.708	
063	512369.645	179453.789		135	512403.808	179412.544	
064	512364.575	179454.234		136	512405.444	179409.634	
065	512364.408	179452.327		137	512405.138	179409.406	
066	512364.099	179448.81		138	512402.312	179407.339	
067	512388.273	179448.712		139	512404.885	179404.299	
068	512387.614	179443.493		140	512402.583	179405.914	
069	512382.633	179443.93		141	512406.747	179406.112	
070	512377.652	179444.368		142	512407.137	179405.333	
071	512372.671	179444.806		143	512405.521	179403.667	
072	512368.687	179445.156		144	512385.83	179422.963	
				145	512365.923	179433.161	
				146	512381.912	179409.81	

ISSUED FOR CONSTRUCTION

Rev	Date	By	Chk	Comment
C2	24.10.13	MLE	CH	Wall to GC02 moved
C1	17.07.13	PR	AC	DRAWING ISSUED FOR CONSTRUCTION

BRINGING IDEAS TO LIFE

FRANKHAM

Frankham Consultancy Group Limited
21 Perrymount Road
Haywards Heath RH16 3TP
t 01444 444900 f 01444 456642
enquire@frankham.com
www.frankham.com

Client
Ealing
www.ealing.gov.uk

Project Title
Dominion Arts Centre
Southall
London

Drawing Title
Proposed
Ground Floor Coordinates Setting Out Plan
2 of 3


Drawn by:	Scale:	Date:
RKC	1:50@A1	10.05.13
Designed by:	Checked by:	Approved by:
FCG	-	-

File Ref.: P:\2009\224970 - LEALING - DOMINION ARTS CENTRE\ARCH\3D_19\ LOCATION FLANG AND GA\ 224970-A-136.DWG - 2008/11/2023 20:06:11 13:33:23


Drawing No. 224970-A-136
Rev. C2

For continuation, please refer to dwg: 224970-A-137 - 02

For continuation, please refer to dwg: 224970-A-137 - 01

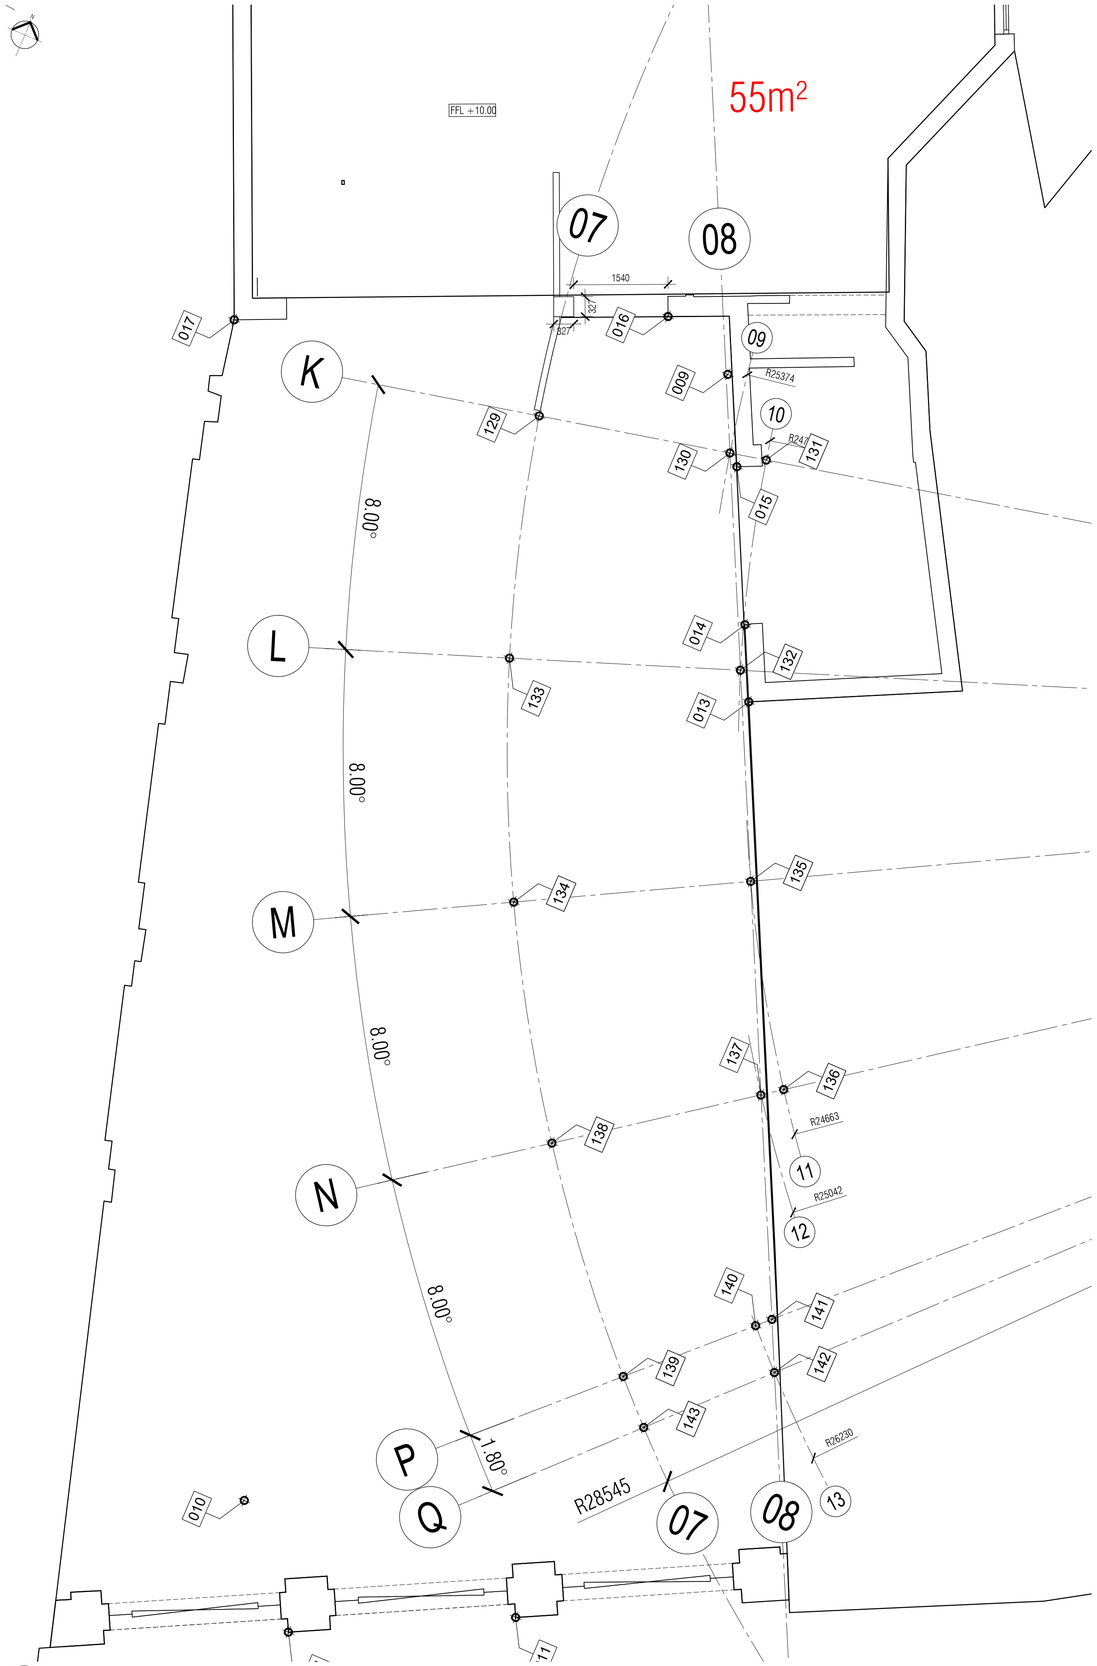


01 Ground Floor Coordinates Plan
Scale: 1:50

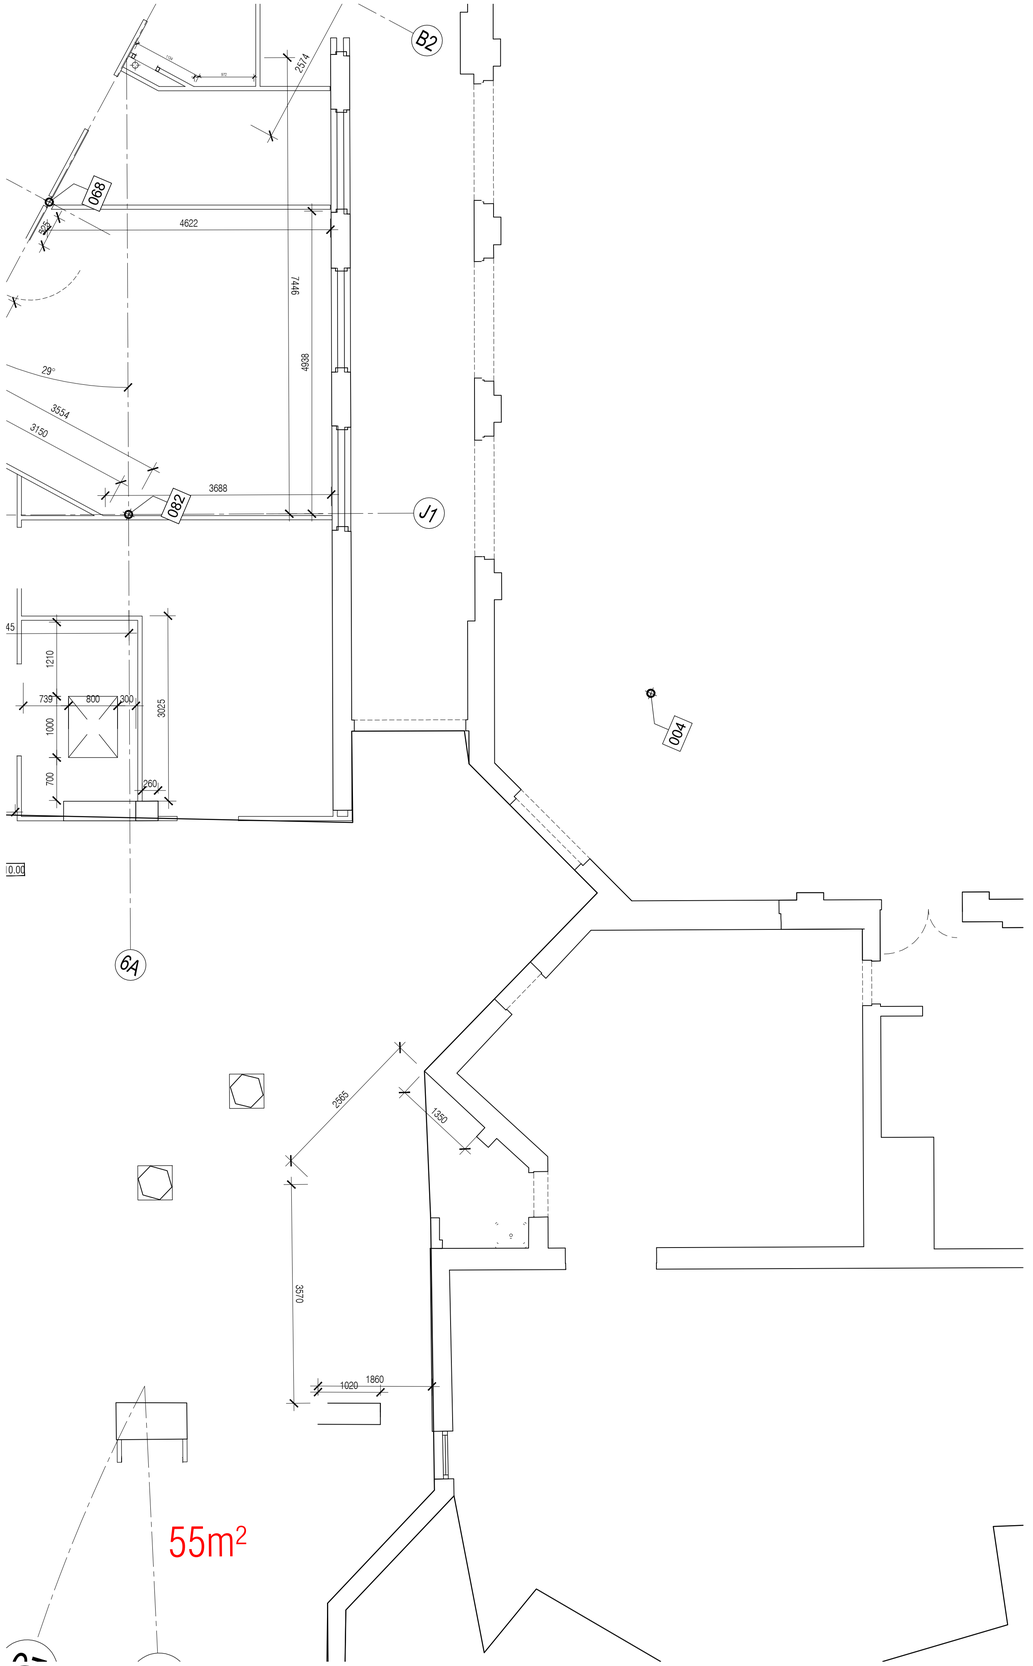

02 Ground Floor Coordinates Plan
Scale: 1:50

NOTES: Do not scale this drawing. All dimensions to be checked on site prior to commencement or manufacture.

Key Plan
(nts)

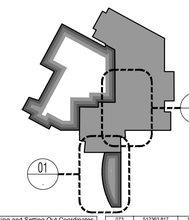

Checking and Setting Out Coordinates									
REF	EASTING	NORTHING		073	512363.817	179445.602		145	512365.923	179433.161
001	512360	179480		074	512363.549	179442.554		146	512361.912	179435.81
002	512360	179460		075	512363.308	179439.815				
003	512400	179480		076	512366.533	179436.531				
004	512400	179440		077	512368.378	179438.369				
005	512380	179440		078	512372.383	179436.019				
006	512360	179440		079	512377.344	179438.581				
007	512360	179420		080	512382.325	179436.144				
008	512380	179420		081	512387.305	179437.706				
009	512400	179420		082	512391.015	179436.318				
010	512400	179400		083	512387.165	179436.112				
011	512404.823	179399.993		084	512382.184	179436.55				
012	512401.508	179398.309		085	512377.204	179436.988				
013	512402.424	179415.224		086	512372.223	179437.425				
014	512401.87	179416.357		087	512368.238	179437.776				
015	512400.731	179418.674		088	512366.393	179437.938				
016	512398.731	179420.483		089	512363.168	179438.221				
017	512392.245	179417.639		090	512366.025	179433.743				
018	512386.304	179421.662		091	512367.87	179433.583				
019	512385.942	179422.497		092	512371.854	179433.233				
020	512382.101	179431.332		093	512376.835	179432.795				
021	512388.262	179434.51		094	512381.816	179432.357				
022	512389.127	179452.031		095	512386.797	179431.919				
023	512387.743	179455.313		096	512386.572	179428.979				
024	512388.586	179455.039		097	512381.451	179428.206				
025	512389.529	179452.987		098	512376.39	179427.733				
026	512387.508	179456.15		099	512371.33	179427.26				
027	512382.389	179455.856		100	512367.776	179432.515				
028	512377.237	179456.309		101	512367.696	179431.607				
029	512376.032	179458.921		102	512367.531	179429.729				
030	512376.618	179465.044		103	512367.451	179428.822				
031	512385.66	179423.119		104	512367.281	179426.881				
032	512378.565	179420.383		105	512364.162	179426.59				
033	512376.054	179419.663		106	512363.965	179424.348				
034	512372.704	179419.563		107	512367.035	179424.079				
035	512366.438	179420.113		108	512363.838	179422.903				
036	512366.644	179427.078		109	512366.908	179422.633				
037	512367.001	179428.861		110	512370.892	179422.283				
038	512374.189	179427.905		111	512375.873	179421.846				
039	512372.899	179432.958		112	512379.532	179421.524				
040	512367.591	179432.89		113	512380.854	179421.408				
041	512367.326	179432.564		114	512380.835	179420.97				
042	512367.463	179434.118		115	512385.765	179420.174				
043	512368.137	179438.937		116	512380.784	179420.611				
044	512362.908	179439.396		117	512379.462	179420.728				
045	512363.458	179445.662		118	512375.803	179421.049				
046	512369.571	179443.78		119	512370.822	179421.487				
047	512379.199	179454.934		120	512368.838	179421.837				
048	512380.217	179454.644		121	512363.768	179422.107				
049	512380.88	179454.787		122	512363.646	179420.712				
050	512382.001	179455.89		123	512366.715	179420.442				
051	512364.717	179455.844		124	512370.7	179420.092				
052	512369.787	179455.398		125	512375.68	179419.654				
053	512373.772	179455.048		126	512379.339	179419.333				
054	512378.752	179454.61		127	512380.561	179419.217				
055	512382.203	179454.307		128	512385.642	179418.779				
056	512383.733	179454.173		129	512397.439	179418.182				
057	512388.714	179453.735		130	512400.538	179418.835				
058	512388.573	179452.126		131	512401.129	179418.963				
059	512383.592	179452.563		132	512402.095	179415.645				
060	512382.062	179452.688		133	512398.553	179414.339				
061	512378.611	179453.001		134	512400.188	179410.708				
062	512373.53	179453.439		135	512403.808	179412.544				
063	512369.645	179453.789		136	512405.444	179409.834				
064	512364.575	179454.234		137	512405.138	179409.406				
065	512364.406	179452.327		138	512402.312	179407.339				
066	512364.099	179448.81		139	512404.885	179404.299				
067	512388.273	179448.712		140	512406.583	179405.914				
068	512387.814	179443.493		141	512406.747	179406.112				
069	512382.633	179443.93		142	512407.127	179405.333				
070	512377.852	179444.368		143	512405.521	179403.667				
071	512372.871	179444.806		144	512365.83	179422.963				
072	512368.887	179445.156		145	512365.923	179433.161				
				146	512361.912	179435.81				

ISSUED FOR CONSTRUCTION

Rev	Date	By	Chk	Comment
C1	17.07.13	PR	AC	DRAWING ISSUED FOR CONSTRUCTION

BRINGING IDEAS TO LIFE

FRANKHAM

Frankham Consultancy Group Limited
21 Perrymount Road
Haywards Heath RH16 3TP
t 01444 444900 f 01444 455642
enquire@frankham.com
www.frankham.com

Client
Ealing
www.ealing.gov.uk

Project Title
Dominion Arts Centre
Southall
London


Drawing Title
Proposed
Ground Floor Coordinates Setting Out Plan
3 of 3

Drawn by:	Scale:	Date:
RKC	1:50@A1	10.05.13
Designed by:	Checked by:	Approved by:
FCG	-	-

File Ref.: K:\2000\2124\01 - LB EALING - DOMINION ARTS CENTRE\ARCH\100_199_LOCATION PLANS AND GA-2124\01-A-137.DWG - 20061113333 20:06:11/13:33:33

Drawing No.	Rev.
224970-A-137	C1


For continuation, please refer to dwg: 224970-A-151

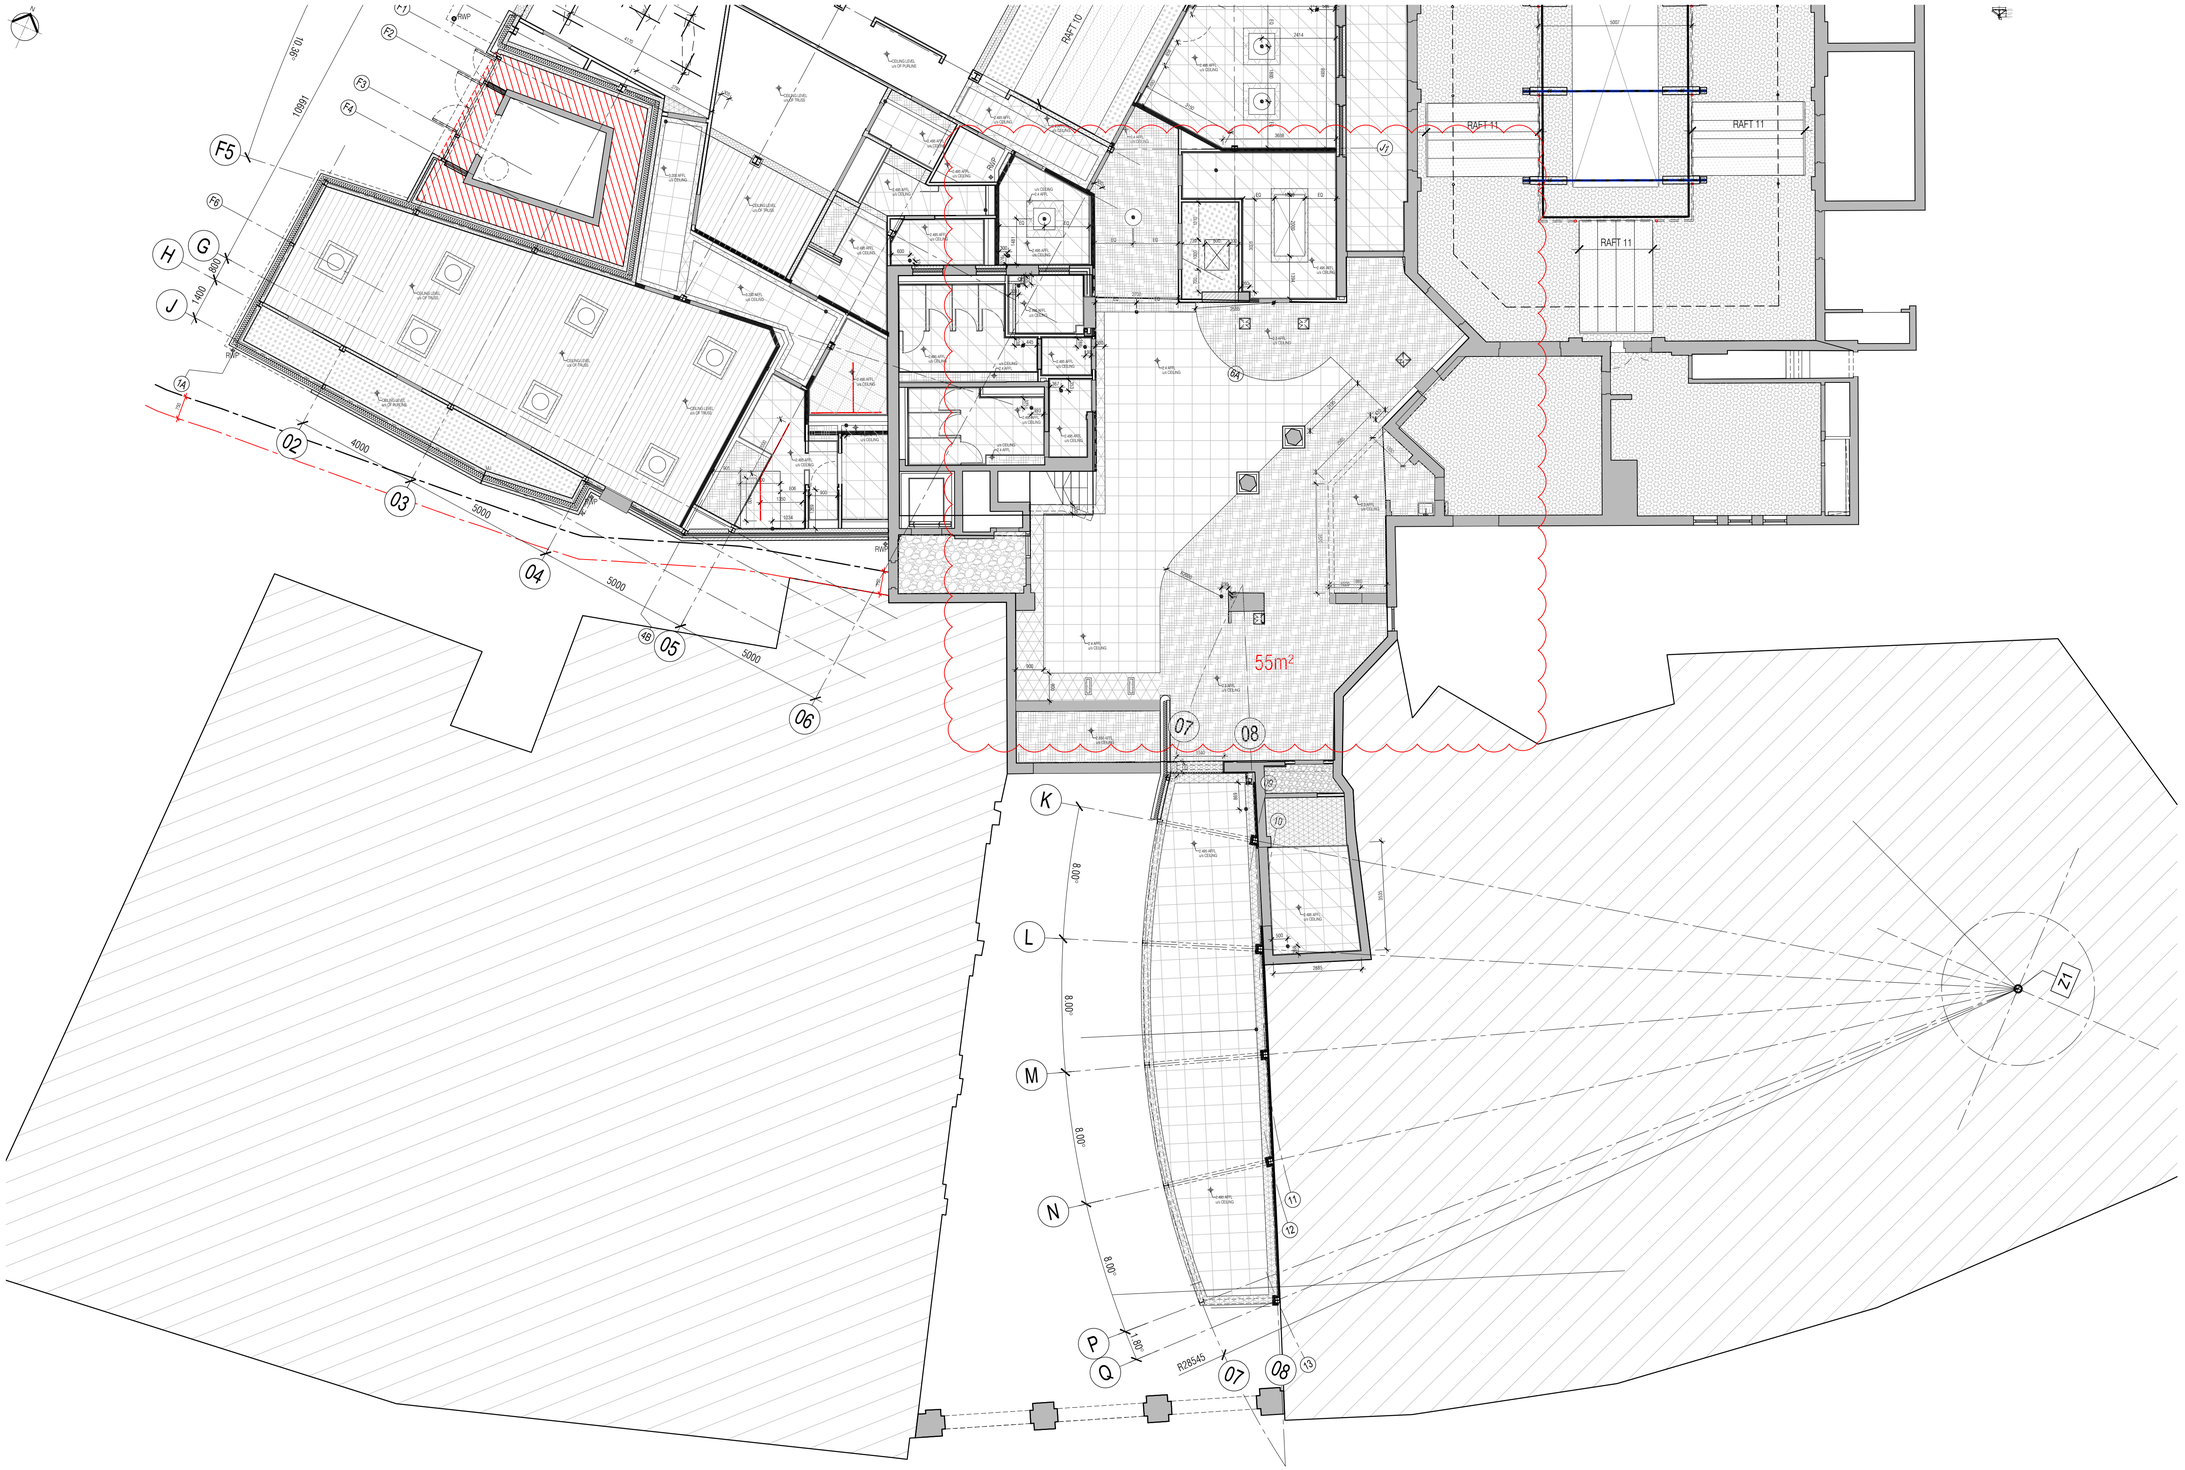

01 / 150 Ground Floor Reflected Ceiling Plan
Scale:1:100

NOTES: Do not scale this drawing. All dimensions to be checked on site prior to commencement or manufacture.

Key Plan
(nts)

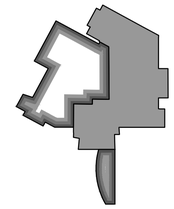

Reflected Ceiling Plan Legend
All colours to be confirmed. Refer to K10 for detail information

- Existing ceiling made good and decorated
- Existing ceiling retained
- Plasterboard ceiling lining to underside of roof structure
- Suspended plasterboard ceiling
- Plasterboard bulkhead
- Armstrong Ultima 9538 M tegular profile 600x600 ceiling tiles on suspended grid
- Armstrong Ultima 3687 M 600x600 ceiling tiles on non corrosive 24mm suspended grid
- Armstrong Ultima 9538 M tegular profile 600x600 tiles on suspended grid with Ex.25x38 black painted s/w perimeter
- Encase fire protection to structural trusses
- Fire rated access hatch. 650x550mm min clear opening
- Perforated Metal panels with acoustic liner material for Acoustic performance
- Monodraught 530 Sunpipe
- Ecophon Lp acoustic ceiling raft

ISSUED FOR CONSTRUCTION

Rev	Date	By	Chk	Comment
C6	10.03.14	CH	AC	Ceiling grid adjusted
C5	04.03.14	CH	AC	Ceilings adjusted
C4	13.02.14	CH	AC	Ceiling adjusted
C3	16.01.14	CH	AC	Dims added to sunpipes
C2	24.10.13	MLE	CH	Wall to GC02 moved
C1	03.07.13	RKC	JAS	Issued for CONSTRUCTION

BRINGING IDEAS TO LIFE

FRANKHAM

Frankham Consultancy Group Limited
21 Perrymount Road
Haywards Heath RH16 3TP
t 01444 444900 f 01444 455642
enquire@frankham.com
www.frankham.com

Client
Ealing
www.ealing.gov.uk


Project Title
Dominion Arts Centre
Southall
London

Drawing Title
Proposed Ground Floor
Reflected Ceiling Plan
1 of 2

Drawn by:	Scale:	Date:
RKC	1:100@A1	18.03.13
Designed by:	Checked by:	Approved by:
FCG	-	-


File Ref.: K:\2000\2224970 - LB EALING - DOMINION ARTS CENTRE\ARCH\DB_RB_LOCATION PLANS AND GA\2224970-A-150.DWG - 2008111042 20.06.11 13:34:22

Drawing No.	Rev.
224970-A-150	C6

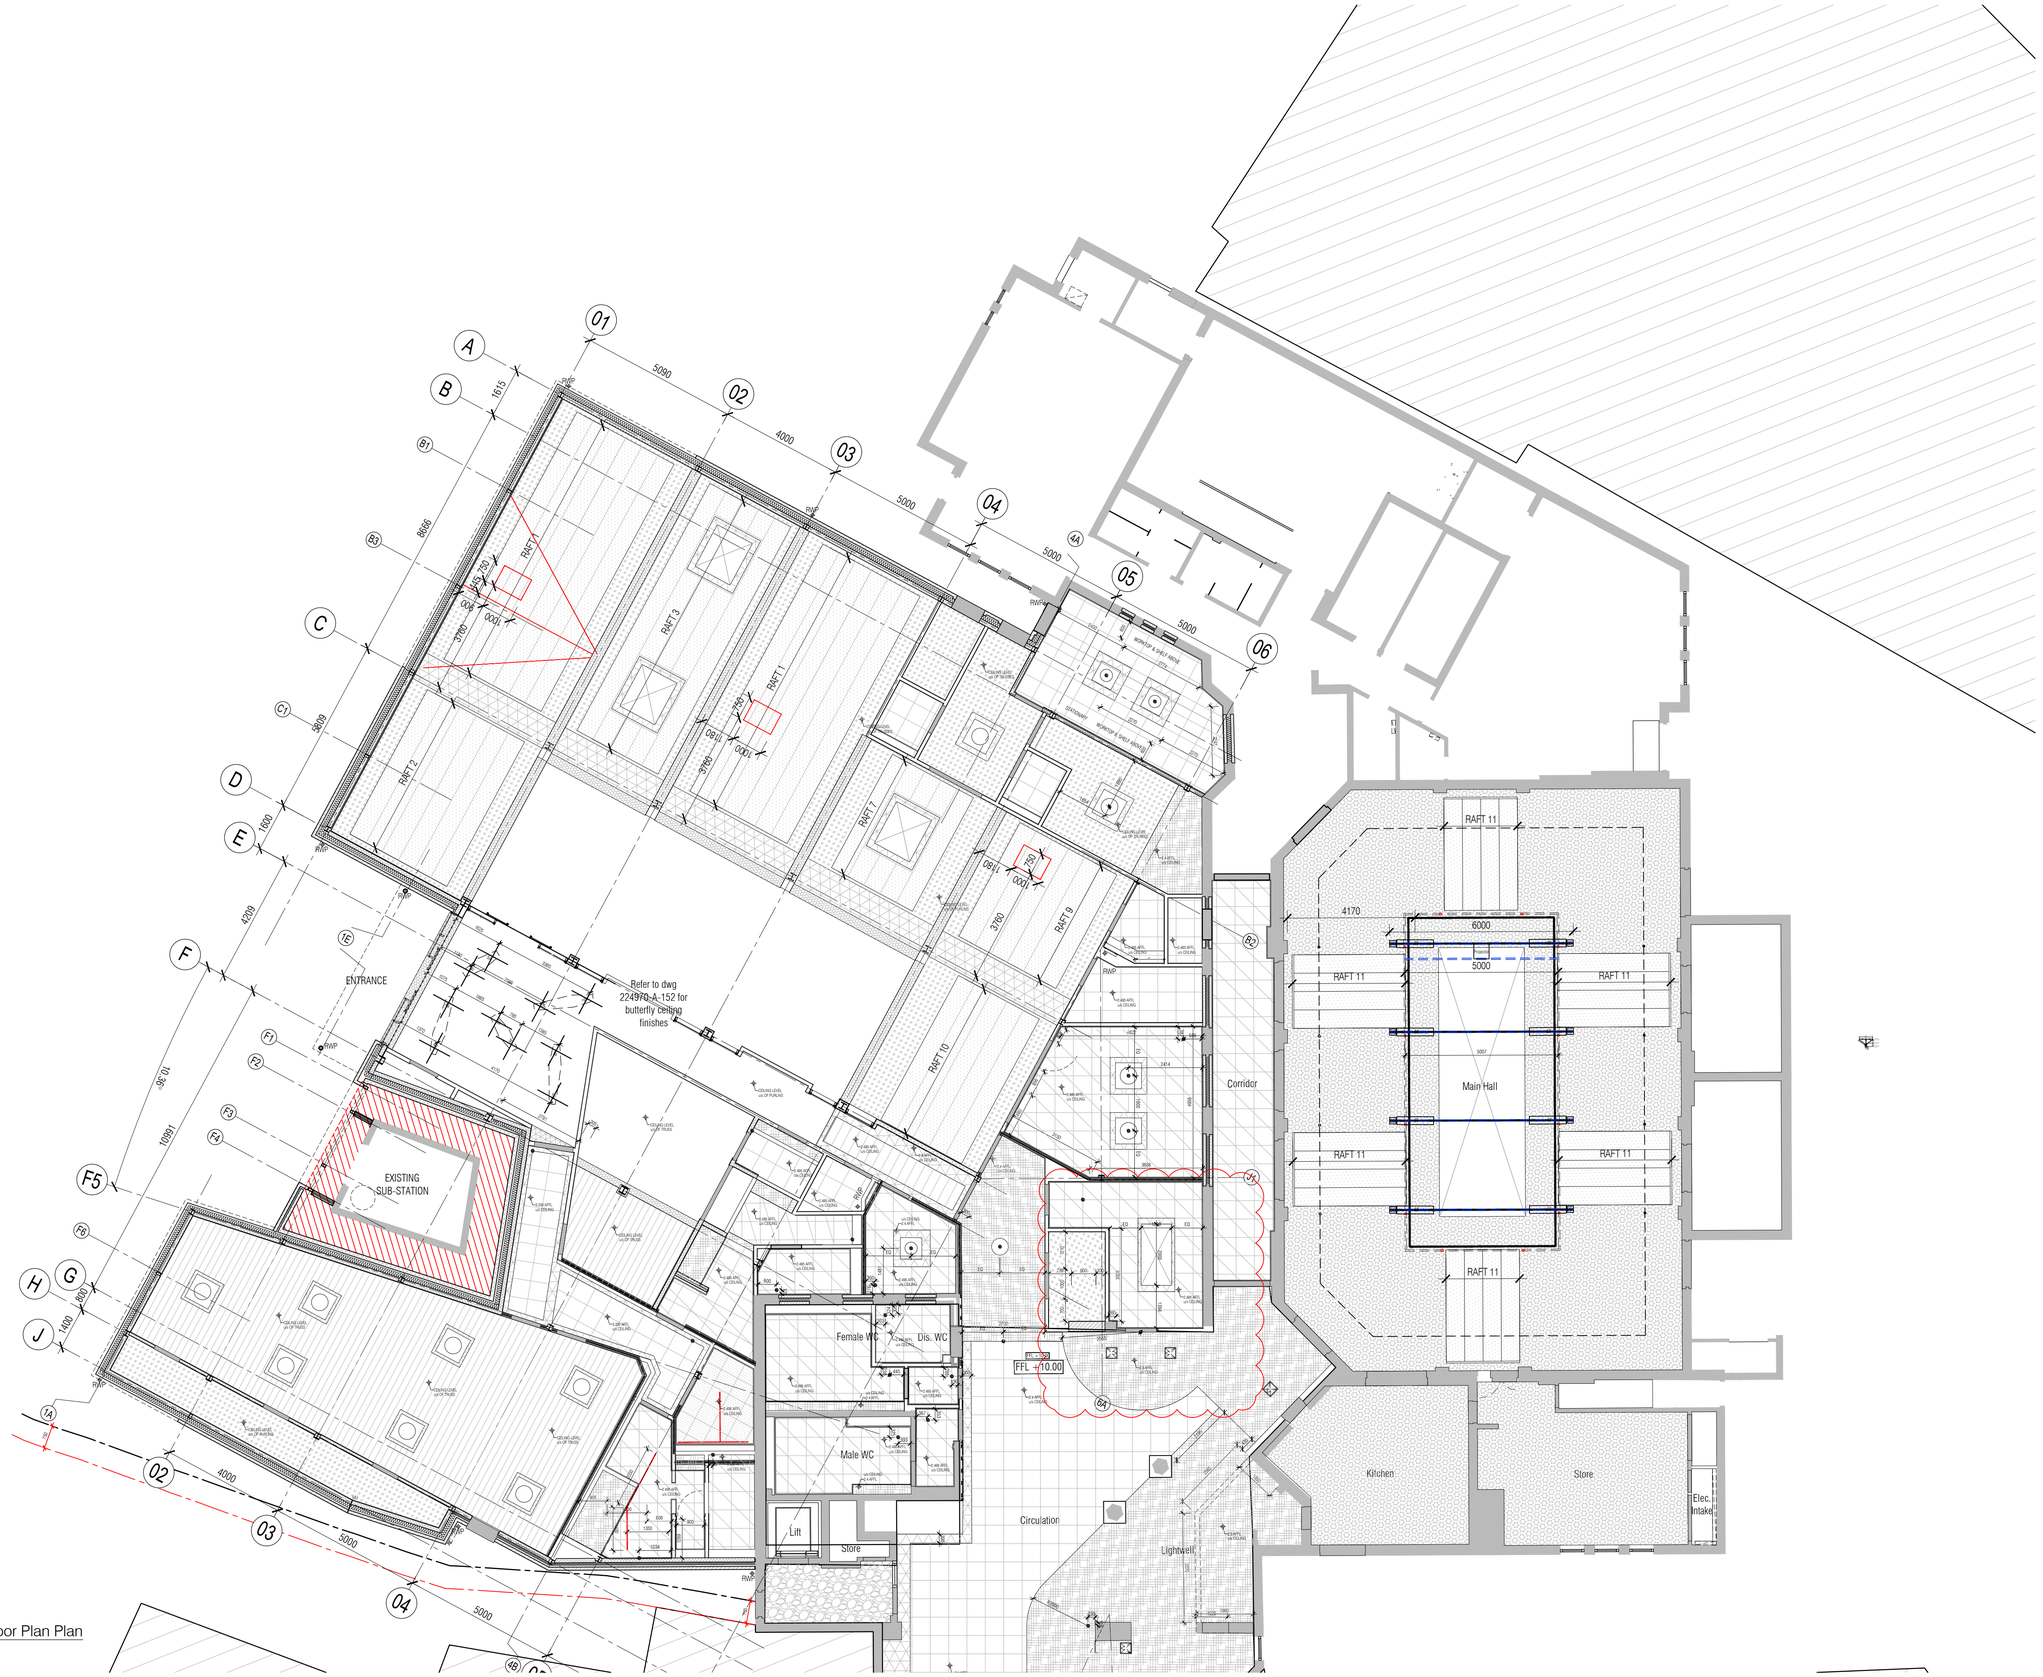

NOTES: Do not scale this drawing. All dimensions to be checked on site prior to commencement or manufacture.

Key Plan
(nts)

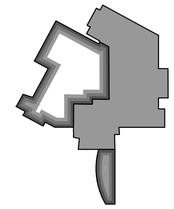

Reflected Ceiling Plan Legend
All colours to be confirmed. Refer to K10 for detail information

- Existing ceiling made good and decorated
- Existing ceiling retained
- Plasterboard ceiling lining to underside of roof structure
- Suspended plasterboard ceiling
- Plasterboard bulkhead
- Armstrong Ultima 9538 M tegular profile 600x600 ceiling tiles on suspended grid
- Armstrong Ultima 3687 M 600x600 ceiling tiles on non corrosive 24mm suspended grid
- Armstrong Ultima 9538 M tegular profile 600x600 tiles on suspended grid with Ex.25x38 black painted s/w perimeter
- Encase fire protection to structural trusses
- Fire rated access hatch. 650x550mm min clear opening
- Perforated Metal panels with acoustic liner material for Acoustic performance
- Monodraught 530 Sunpipe
- Ecophon Lp acoustic ceiling raft

ISSUED FOR CONSTRUCTION

Rev	Date	By	Chk	Comment
C7	13.02.14	CH	AC	Ceiling adjusted
C6	05.02.14	CH	AC	Dims added to VRF units
C5	24.01.14	CH	AC	Ceiling Grid Adjusted
C4	21.01.14	CH	AC	ceiling grid adjusted
C3	16.01.14	CH	AC	Dims added to sunpipes
C2	25.10.13	MLE	CH	Wall to GC02 moved
C1	03.07.13	RKC	JAS	Issued for CONSTRUCTION

BRINGING IDEAS TO LIFE

FRANKHAM

Frankham Consultancy Group Limited
21 Perrymount Road
Haywards Heath RH16 3TP
t 01444 444900 f 01444 455642
enquire@frankham.com
www.frankham.com

Client
Ealing
www.ealing.gov.uk

Project Title
Dominion Arts Centre
Southall
London

Drawing Title
Proposed Ground Floor
Reflected Ceiling Plan
2 of 2

Drawn by:	Scale:	Date:
RKC	1:100@A1	19.03.13
Designed by:	Checked by:	Approved by:
FCG	-	-

File Ref.: X:\2008\DOM\10 - LB EALING - DOMINION ARTS CENTRE\ARCH\10_15B_LOCATION PLANS AND GA - 224970-A-151.DWG - 20081112401 20.06.11 13:34:32


Drawing No. 224970-A-151
Rev. C7



01 First Floor Reflected Ceiling Plan
Scale:1:100

NOTES: Do not scale this drawing. All dimensions to be checked on site prior to commencement or manufacture.

Key Plan
(nts)

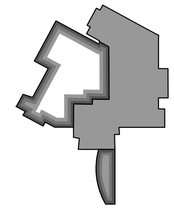

Reflected Ceiling Plan Legend
All colours to be confirmed. Refer to K10 for detail information

- Existing ceiling made good and decorated
- Existing ceiling retained
- Plasterboard ceiling lining to underside of roof structure
- Suspended plasterboard ceiling
- Plasterboard bulkhead
- Armstrong Ultima 9538 M tegular profile 600x600 ceiling tiles on suspended grid
- Armstrong Ultima 3687 M 600x600 ceiling tiles on non corrosive 24mm suspended grid
- Armstrong Ultima 9538 M tegular profile 600x600 tiles on suspended grid with Ex.25x38 black painted s/w perimeter
- Encase fire protection to structural trusses
- Fire rated access hatch. 650x550mm min clear opening
- Perforated Metal panels with acoustic liner material for Acoustic performance
- Monodraught 530 Sunpipe
- Ecophon Lp acoustic ceiling raft

ISSUED FOR CONSTRUCTION

Rev	Date	By	Chk	Comment
C5	02.05.14	CH	AC	Dims added to VRF units
C4	24.01.14	CH	AC	Ceiling Grid Adjusted
C3	21.01.14	CH	AC	ceiling grid adjusted
C2	13.09.13	CH	AC	Layout adjusted. Setting out added
C1	03.07.13	RKC	JAS	Issued for CONSTRUCTION

BRINGING IDEAS TO LIFE

FRANKHAM

Frankham Consultancy Group Limited
21 Perrymount Road
Haywards Heath RH16 3TP
t 01444 444900 f 01444 455642
enquire@frankham.com
www.frankham.com

Client
Ealing
www.ealing.gov.uk

Project Title
Dominion Arts Centre
Southall
London


Drawing Title
Proposed First Floor
Reflected Ceiling Plan

Drawn by:	Scale:	Date:
RKC	1:100@A1	19.03.13
Designed by:	Checked by:	Approved by:
FCG	-	-

File Ref.: X:\2009\0224970 - EALING - DOMINION ARTS CENTRE\ARCH\3D_19B_LOCATION PLANS AND QA-224970-A-152.DWG - 2009111-DAN9 20:06:11/13/05/03

Drawing No. 224970-A-152
Rev. C5


For continuation, please refer to dwg: 224970-A-161

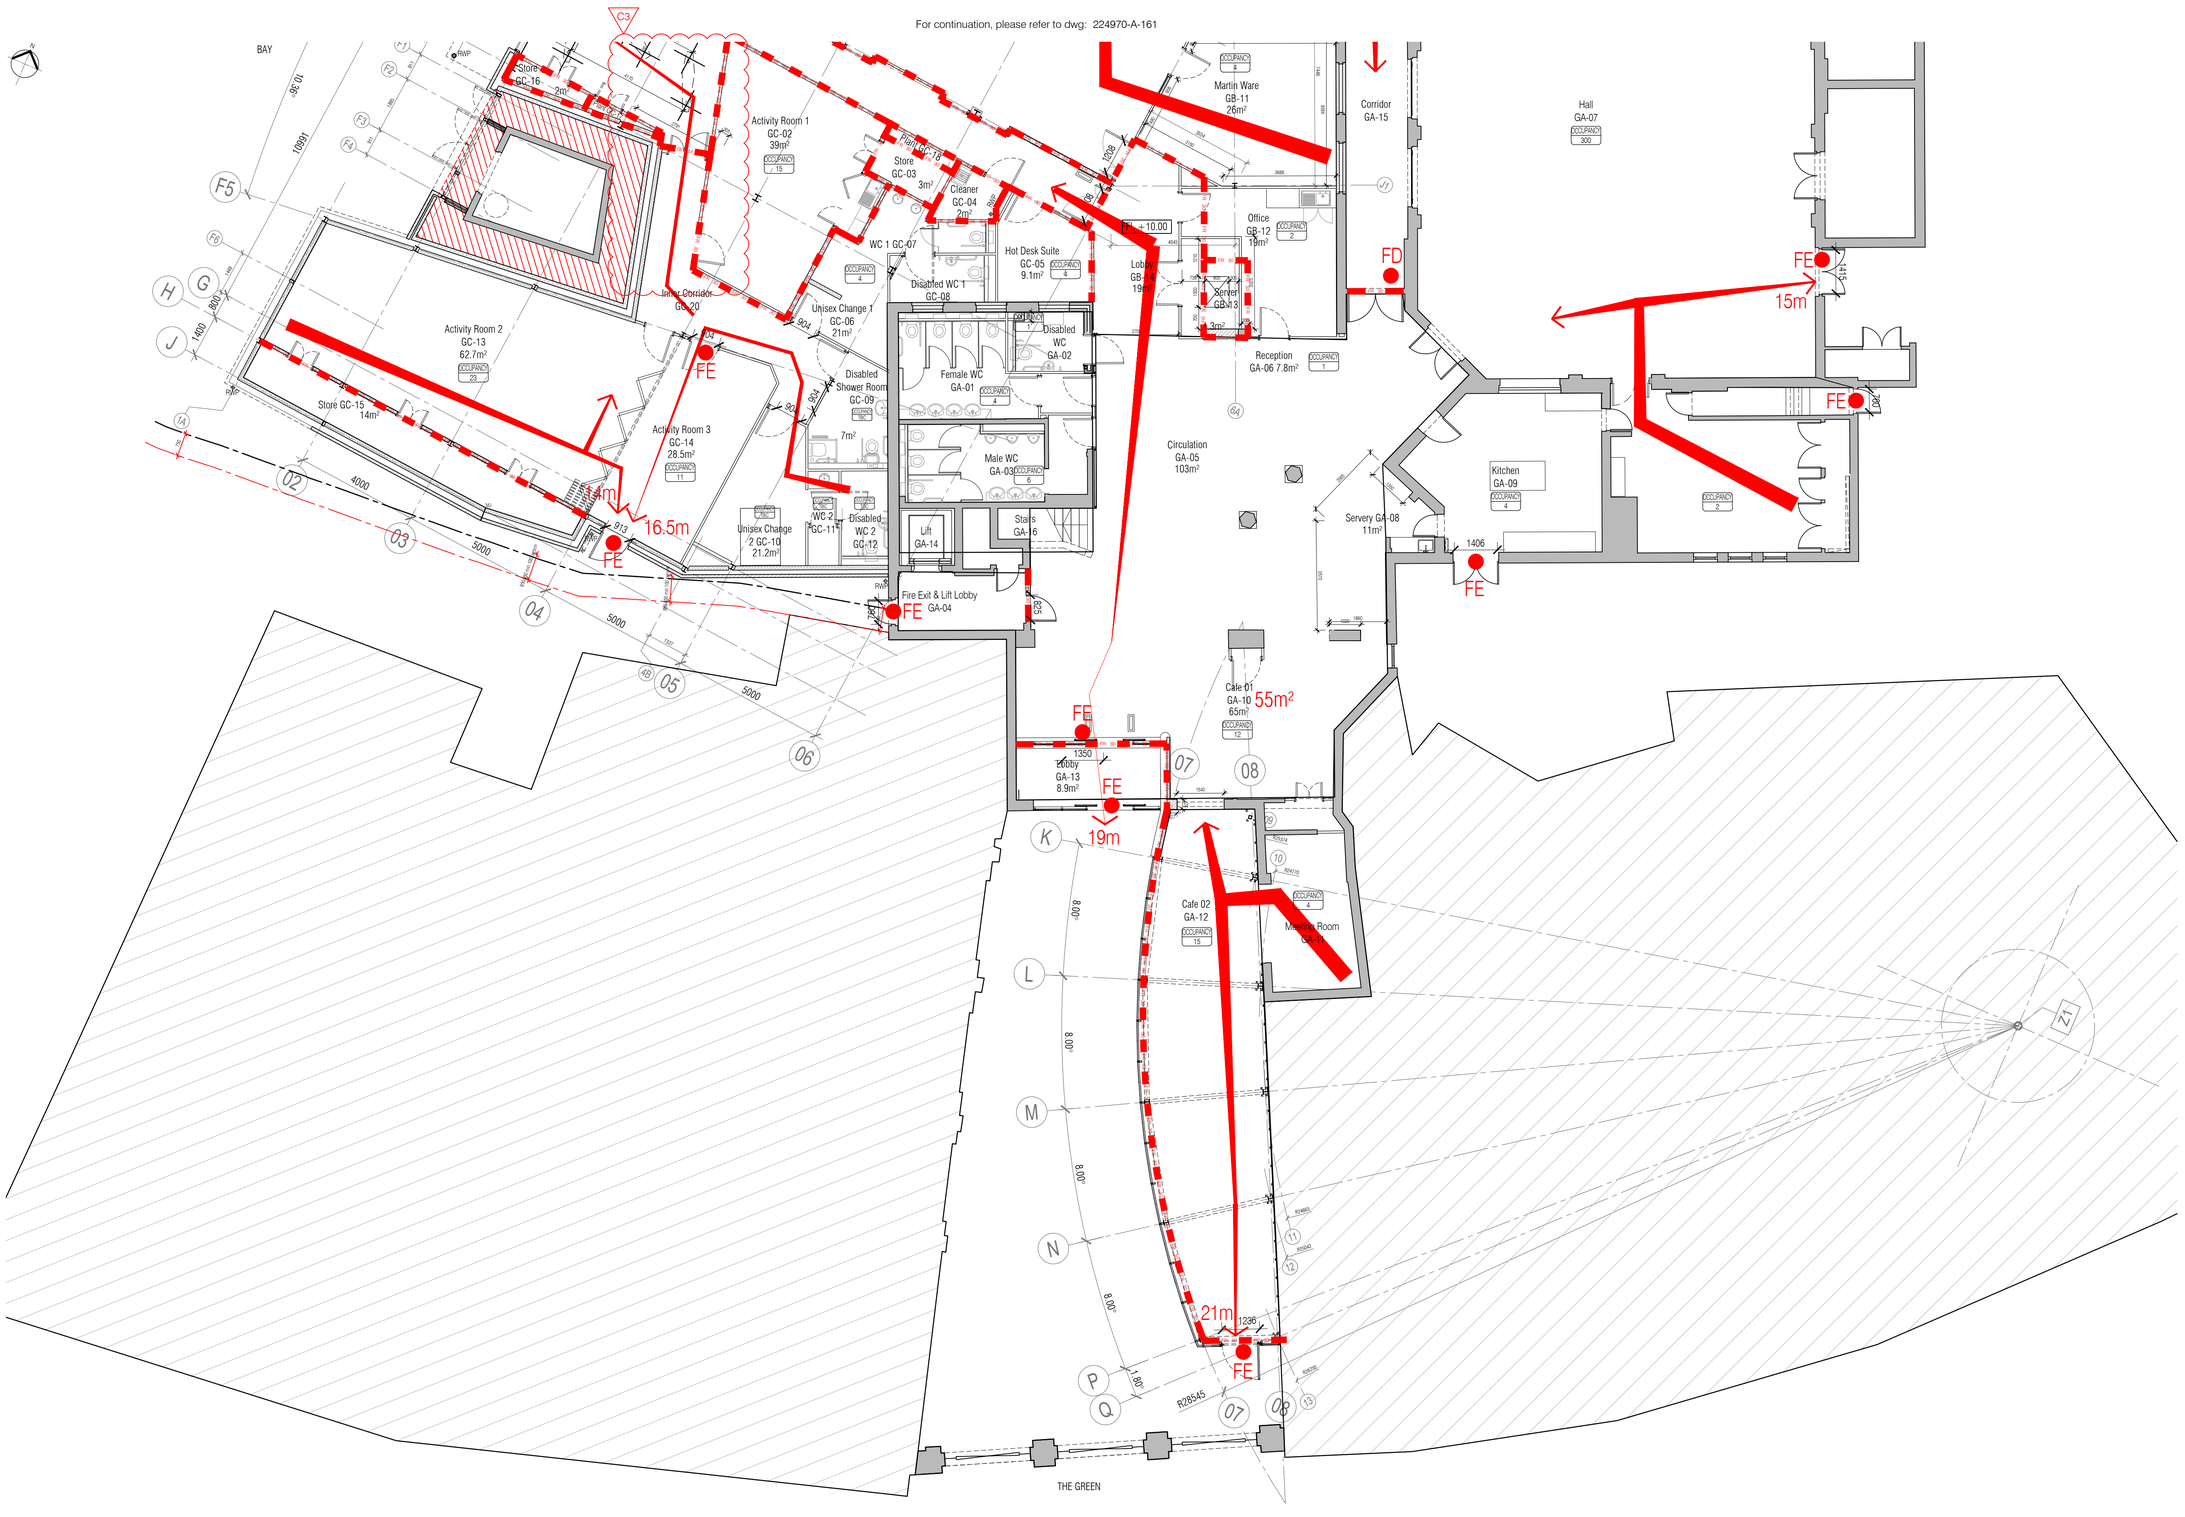

01 / 120 Ground Floor Plan
Scale:1:100

NOTES: Do not scale this drawing. All dimensions to be checked on site prior to commencement or manufacture.

Key Plan
(nts)

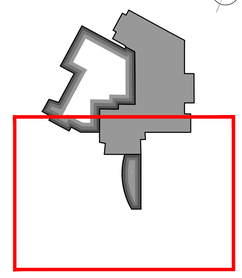

Fire Strategy Key

- FR 30 FR 30 — Denotes 30 minute fire rating partition
- Denotes cavity barriers to extg floor voids
- FE — Denotes Fire Exit. Refer to door schedule for fire rating of doors
- OCCUPANCY TBC — Denotes occupancy number for the room

Refer also to the following FCG drawings:
For 'GA Plans', refer to drawings 'A-100-Series'.
For 'GA Sections', refer to drawings 'A-200-Series'.
For 'GA Elevations', refer to drawings 'A-300-Series'.
For 'Acoustic Strategy', refer to drawings 'A-150-Series'.
For 'Internal Partition Strategy', refer to drawings 'A-170-Series'.
For 'Builder's Work', refer to drawings 'A-180-Series'.
Refer also to detailed drawings generally - 'A-400-Series + NBS.

ISSUED FOR CONSTRUCTION

Rev	Date	By	Chk	Comment
C3	24.10.13	MLE	CH	Wall to GC02 moved
C2	12.07.13	PR	AC	Fire routes added
C1	03.07.13	RKC	JAS	Issued for CONSTRUCTION

BRINGING IDEAS TO LIFE

FRANKHAM

Frankham Consultancy Group Limited
21 Perrymount Road
Haywards Heath RH16 3TP
t 01444 444900 f 01444 455642
enquire@frankham.com
www.frankham.com

Client: Ealing
www.ealing.gov.uk

Project Title
Dominion Arts Centre
Southall
London

Drawing Title
Proposed Ground Floor Plan
1 of 2
Fire Strategy Plan


Drawn by:	Scale:	Date:
RKC	1:100@A1	21.03.13
Designed by:	Checked by:	Approved by:
FCG	-	-

File Ref.: R:\2000\2124\01 - LEVEL\06 - DOMINION ARTS CENTRE\ARCH\3D_15B_LOCATION PLANS AND GA\ 224970-A-160.DWG - 20/06/2013 11:13:35:09

Drawing No. 224970-A-160
Rev. C3

NOTES: Do not scale this drawing. All dimensions to be checked on site prior to commencement or manufacture.

Key Plan
(nts)

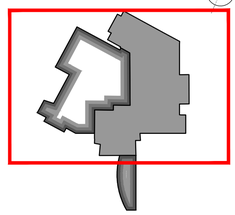

Fire Strategy Key

FR 30 FR 30 — Denotes 30 minute fire rating partition
Denotes cavity barriers to extg floor voids

FE — Denotes Fire Exit. Refer to door schedule for fire rating of doors

OCCUPANCY TBC — Denotes occupancy number for the room

Refer also to the following FCG drawings:
For 'GA Plans', refer to drawings 'A-100-Series'.
For 'GA Sections', refer to drawings 'A-200-Series'.
For 'GA Elevations', refer to drawings 'A-300-Series'.
For 'Acoustic Strategy', refer to drawings 'A-150-Series'.
For 'Internal Partition Strategy', refer to drawings 'A-170-Series'.
For 'Builder's Work', refer to drawings 'A-180-Series'.
Refer also to detailed drawings generally - 'A-400-Series + NBS.

ISSUED FOR AS-BUILT

Rev	Date	By	Chk	Comment
AB	30.09.14	CH	AC	Issued for AS-BUILT

BRINGING IDEAS TO LIFE

FRANKHAM

Frankham Consultancy Group Limited
21 Perrymount Road
Haywards Heath RH16 3TP
t 01444 444900 f 01444 456542
enquire@frankham.com
www.frankham.com

Client
Ealing
www.ealing.gov.uk

Project Title
Dominion Arts Centre
Southall
London

Drawing Title
Proposed Ground Floor Plan
2 of 2
Fire Strategy Plan


Drawn by:	Scale:	Date:
RKC	1:100@A1	21.03.13
Designed by:	Checked by:	Approved by:
FCG	-	-

File Ref.: P:\2009\224970 - LEALING - DOMINION ARTS CENTRE\ARCH\3D_19_LOCATION PLANS AND GA\224970-A-161.DWG - 2008/11/03/19 20:06:11 13:35:19

Drawing No. 224970-A-161 Rev. AB

01/101 Ground Floor Plan
Scale:1:100


For continuation, please refer to dwg: 224970-A-160

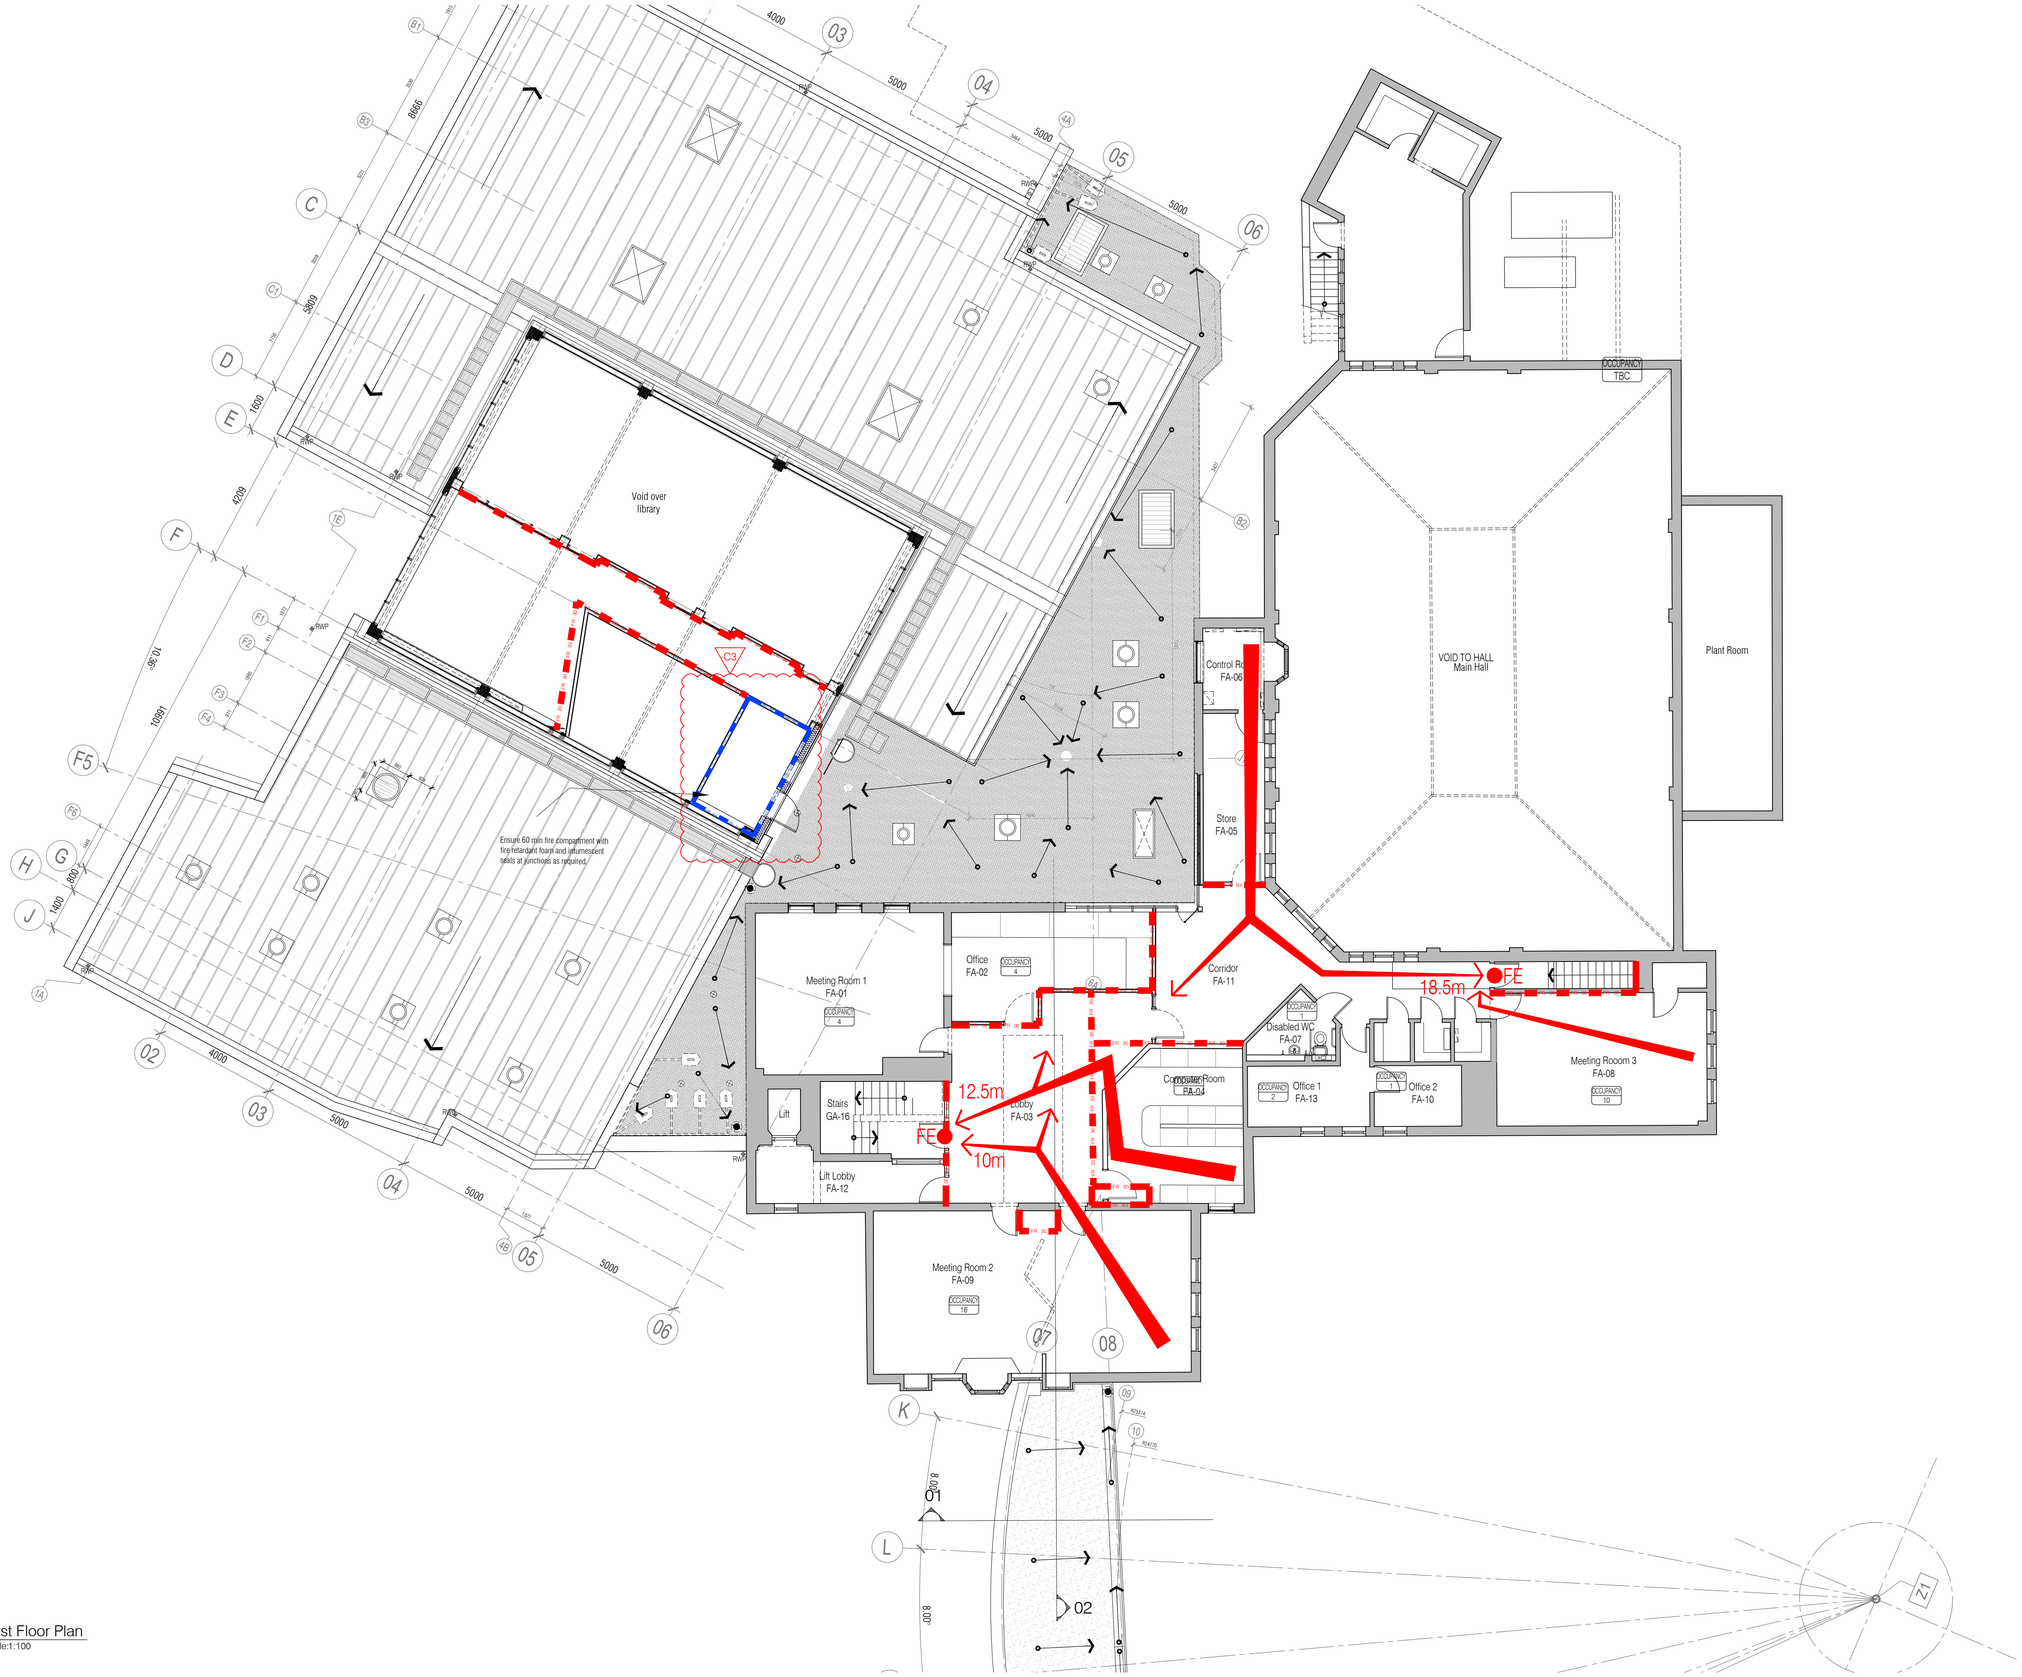

01 First Floor Plan
120 Scale:1:100

NOTES: Do not scale this drawing. All dimensions to be checked on site prior to commencement or manufacture.

Key Plan
(nts)

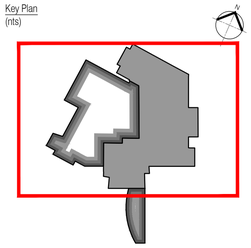

Fire Strategy Key

FR 30 FR 30 Denotes 30 minute fire rating partition
Denotes cavity barriers to extg floor voids

FE Denotes Fire Exit. Refer to door schedule for fire rating of doors

OCCUPANCY TBC Denotes occupancy number for the room

Refer also to the following FCG drawings:
For 'GA Plans', refer to drawings 'A-100-Series'.
For 'GA Sections', refer to drawings 'A-200-Series'.
For 'GA Elevations', refer to drawings 'A-300-Series'.
For 'Acoustic Strategy', refer to drawings 'A-150-Series'.
For 'Internal Partition Strategy', refer to drawings 'A-170-Series'.
For 'Builder's Work', refer to drawings 'A-180-Series'.
Refer also to detailed drawings generally - 'A-400-Series + NBS.

Scale Bar

0 1 2 3 1:50
0 2 4 6 1:100

ISSUED FOR CONSTRUCTION

Rev	Date	By	Chk	Comment
C3	08.11.13	MLE	CH	FR updated from 30 to 60
C2	09.07.13	PR	AC	Fire exit routes updated
C1	03.07.13	RKC	JAS	Issued for CONSTRUCTION

BRINGING IDEAS TO LIFE

FRANKHAM

Frankham Consultancy Group Limited
21 Perrymount Road
Haywards Heath RH16 3TP
t 01444 444900 f 01444 455642
enquire@frankham.com
www.frankham.com

Client
Ealing
www.ealing.gov.uk

Project Title
Dominion Arts Centre
Southall
London

Drawing Title
Proposed First Floor Plan
Fire Strategy Plan

Drawn by:	Scale:	Date:
RKC	1:100@A1	21.03.13
Designed by:	Checked by:	Approved by:
FCG	-	-

File Ref.: X:\2000\021401 - LB EALING - DOMINION ARTS CENTRE\ARCH\10_19B_LOCATION PLANS AND GA\21401-A-162.DWG - 2008/11/20/28 20.08.11 13:35:30

Drawing No. 224970-A-162
Rev. C3

For continuation, please refer to dwg: 224970-A-171

EXISTING SUB-STATION

Deep Flange Floor & Ceiling Channel

Bulkhead above folding partition

Existing gate access for utility supply

Female WC

Dis. WC

Male WC

Lift

Store

Circulation

Corridor

Main Hall

Kitchen

Store

Elec. Intake

Lightwell

Office 55m²

FFL +10.00

Plaster

140mm blockwork wall

12.5mm soundbloc

92mm I90 Stud.

25mm Ply

2x 10mm Glasroc F boards


200mm Stud joints; suspended on hangers fixed to Wall type E

01 170 Kitchenette Section
Scale:1:50

02 170 Plant & Store Section
Scale:1:50

NOTES: Do not scale this drawing. All dimensions to be checked on site prior to commencement or manufacture.

Key Plan
(nts)

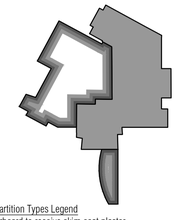

Internal Partition Types Legend
All plasterboard to receive skim coat plaster

- A - 2 layers 15mm soundbloc each side of 70mm C studs @ 600mm centres. 50mm Isover APR 1200 in cavity
- B - 2 layers 15mm Wallboard each side of 70mm C studs @ 600mm centres.
- C - 2 layers 15mm soundbloc each side of 70mm I 50 studs @ 400mm centres. 50mm Isover APR 1200 in cavity
- D - 2 layers12.5mm soundbloc each side of 92mm I 90 studs @ 300mm centres. 25mm Isover APR 1200 in cavity
- E - 140mm blockwork w/skim coat
- 2 layers 12.5mm fireline column encasing
- Z - 2 layers 15mm soundbloc each side of 146mm Gyproframe studs @ 600mm centres.

External Wall Types Legend

- F - Ibstock facing brick - 50mm clear cavity -150mm insulation - 140mm blockwork - plaster finish
- G - Ibstock facing brick - 50mm clear cavity -90mm insulation - 140mm blockwork - plaster finish
- H - Ibstock facing brick - 50mm clear cavity -150mm insulation - 140mm blockwork - dry lining - skim finish
- J - 140mm blockwork -150mm insulation - 140mm blockwork - plaster finish
- K - Laminate cladding - 50mm clear cavity -150mm insulation - 140mm blockwork - plaster finish
- L - Laminate cladding - 50mm clear cavity -150mm insulation - 140mm blockwork - dry lining - skim finish
- M - Ibstock facing brick - 50mm clear cavity 100mm blockwork N - PPC Metal Louvres
- P - Dry lined with 2 layers 12.5mm soundbloc and 50mm Isover APR 1200 in cavity
- Q - Brick to match extg - 25mm cavity -90mm insulation - 100mm blockwork - plaster finish
- R - Plaster - 100mm blockwork - 100mm clear cavity - 100mm blockwork - Plaster

NB: All steelwork to be erected in accordance with Structural Engineer's design and specification. For all steelwork information inc. bracing, refer to Structural Engineers drawings

ISSUED FOR CONSTRUCTION

Rev	Date	By	Chk	Comment
C2	24.10.13	MLE	CH	Wall to GC02 moved
C1	29.08.13	CH	AC	DRAWING ISSUED FOR CONSTRUCTION

BRINGING IDEAS TO LIFE

FRANKHAM

Frankham Consultancy Group Limited
21 Perrymount Road
Haywards Heath RH16 3TP
t 01444 444900 f 01444 455642
enquire@frankham.com
www.frankham.com

Client
Ealing
www.ealing.gov.uk

Project Title
Dominion Arts Centre
Southall
London

Drawing Title
Proposed Ground Floor Plan
1 of 2
Partition Strategy Plan

Drawn by:	Scale:	Date:
RKC	1:100@A1	20.03.13
Designed by:	Checked by:	Approved by:
FCG	-	-


File Ref.: P:\2009\224970 - LEALING - DOMINION ARTS CENTRE\ARCH\02. RB. LOCATION PLANS AND GA\224970-A-170.DWG - 2008111054 20-06-11 13:35:43

Drawing No. 224970-A-170 Rev. C2



NOTES: Do not scale this drawing. All dimensions to be checked on site prior to commencement or manufacture.

Key Plan
(nts)

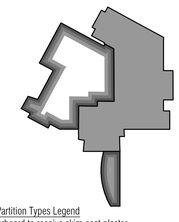

Internal Partition Types Legend
All plasterboard to receive skim coat plaster

- A - 2 layers 15mm soundbloc each side of 70mm C studs @ 600mm centres. 50mm Isover APR 1200 in cavity
- B - 2 layers 15mm Wallboard each side of 70mm C studs @ 600mm centres.
- C - 2 layers 15mm soundbloc each side of 70mm I 50 studs @ 400mm centres. 50mm Isover APR 1200 in cavity
- D - 2 layers12.5mm soundbloc each side of 92mm I 90 studs @ 300mm centres. 25mm Isover APR 1200 in cavity
- E - 140mm blockwork w/skim coat
- 2 layers 12.5mm fireline column encasing
- Z - 2 layers 15mm soundbloc each side of 146mm Gyproframe studs @ 600mm centres.

External Wall Types Legend

- F - Ibstock facing brick - 50mm clear cavity -150mm insulation - 140mm blockwork - plaster finish
- G - Ibstock facing brick - 50mm clear cavity -90mm insulation - 140mm blockwork - plaster finish
- H - Ibstock facing brick - 50mm clear cavity -150mm insulation - 140mm blockwork - dry lining - skim finish
- J - 140mm blockwork -150mm insulation - 140mm blockwork - plaster finish
- K - Laminate cladding - 50mm clear cavity -150mm insulation - 140mm blockwork - plaster finish
- L - Laminate cladding - 50mm clear cavity -150mm insulation - 140mm blockwork - dry lining - skim finish
- M - Ibstock facing brick - 50mm clear cavity 100mm blockwork N - PPC Metal Louvres
- P - Dry lined with 2 layers 12.5mm soundbloc and 50mm Isover APR 1200 in cavity
- Q - Brick to match exig - 25mm cavity -90mm insulation - 100mm blockwork - plaster finish
- R - Plaster - 100mm blockwork - 100mm clear cavity - 100mm blockwork - Plaster

NB: All steelwork to be erected in accordance with Structural Engineer's design and specification. For all steelwork information inc. bracing, refer to Structural Engineers drawings

ISSUED FOR CONSTRUCTION

Rev	Date	By	Chk	Comment
C2	24.10.13	MLE	CH	Wall to GC02 moved
C1	29.08.13	CH	AC	DRAWING ISSUED FOR CONSTRUCTION

BRINGING IDEAS TO LIFE

FRANKHAM

Frankham Consultancy Group Limited
21 Perrymount Road
Haywards Heath RH16 3TP
t 01444 444900 f 01444 456642
enquire@frankham.com
www.frankham.com

Client
Ealing
www.ealing.gov.uk


Project Title
Dominion Arts Centre
Southall
London

Drawing Title
Proposed Ground Floor Plan
2 of 2
Partition Strategy Plan

Drawn by:	Scale:	Date:
RKC	1:100@A1	21.03.13
Designed by:	Checked by:	Approved by:
FCG	-	-


File Ref.: X:\2009\02\224970 - LB EALING - DOMINION ARTS CENTRE\ARCH\02_19B_LOCATION PLANS AND GA\...\224970-A-171.DWG - 20061133553
20/06/11 13:35:53

Drawing No. 224970-A-171
Rev. C2

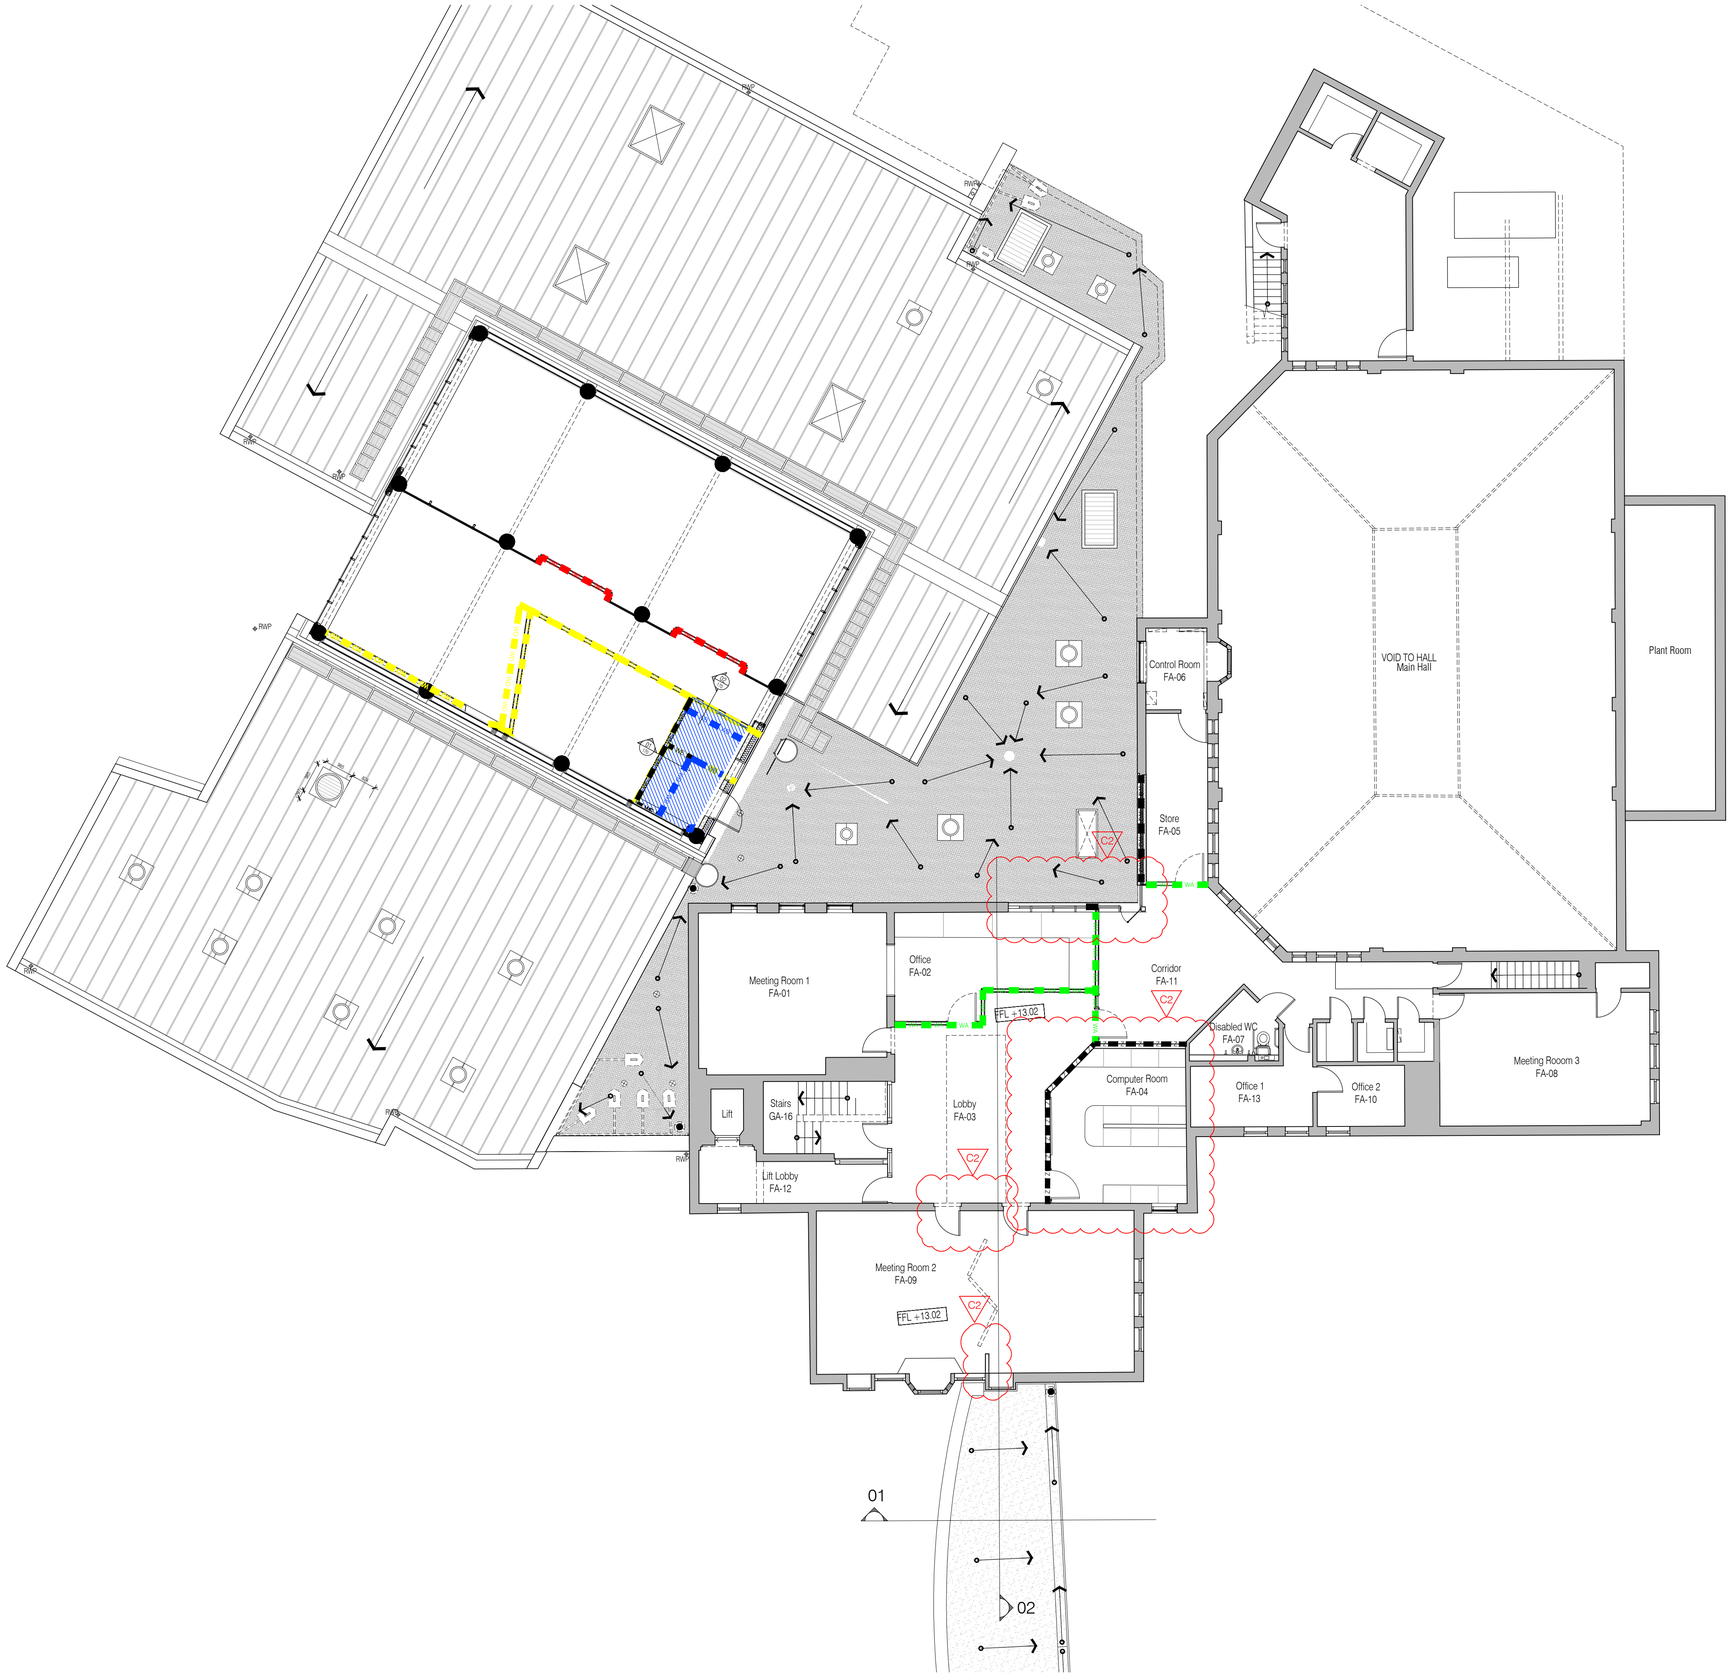

NOTES: Do not scale this drawing. All dimensions to be checked on site prior to commencement or manufacture.

Key Plan
(nts)

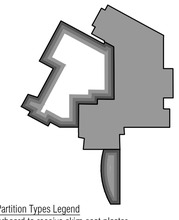

Internal Partition Types Legend
All plasterboard to receive skim coat plaster

- WA — A - 2 layers 15mm soundbloc each side of 70mm C studs @ 600mm centres. 50mm Isover APR 1200 in cavity
- WB — B - 2 layers 15mm Wallboard each side of 70mm C studs @ 600mm centres.
- WC — C - 2 layers 15mm soundbloc each side of 70mm I 50 studs @ 400mm centres. 50mm Isover APR 1200 in cavity
- WD — D - 2 layers12.5mm soundbloc each side of 92mm I 90 studs @ 300mm centres. 25mm Isover APR 1200 in cavity
- WE — E - 140mm blockwork w/skim coat
- 2 layers 12.5mm Irrefloc column encasing
- Z — Z - 2 layers 15mm soundbloc each side of 146mm Gyproc frame studs @ 600mm centres.

External Wall Types Legend

- F — F - Ibstock facing brick - 50mm clear cavity -150mm insulation - 140mm blockwork - plaster finish
- G — G - Ibstock facing brick - 50mm clear cavity -90mm insulation - 140mm blockwork - plaster finish
- H — H - Ibstock facing brick - 50mm clear cavity -150mm insulation - 140mm blockwork - dry lining - skim finish
- J — J - 140mm blockwork -150mm insulation - 140mm blockwork - plaster finish
- K — K - Laminate cladding - 50mm clear cavity -150mm insulation - 140mm blockwork - plaster finish
- L — L - Laminate cladding - 50mm clear cavity -150mm insulation - 140mm blockwork - dry lining - skim finish
- M — M - Ibstock facing brick - 50mm clear cavity 100mm blockwork N - PPC Metal Louvres
- N — P - Dry lined with 2 layers 12.5mm soundbloc and 50mm
- P — Isover APR 1200 in cavity
- WO — O - Brick to match exig - 25mm cavity -90mm insulation - 100mm blockwork - plaster finish
- WR — R - Plaster - 100mm blockwork - 100mm clear cavity - 100mm blockwork - Plaster

NB: All steelwork to be erected in accordance with Structural Engineer's design and specification. For all steelwork information inc. bracing, refer to Structural Engineers drawings

ISSUED FOR TENDER

Rev	Date	By	Chk	Comment
C2	30.08.13	CH	AC	ISSUED FOR CONSTRUCTION
C1	29.08.13	CH	AC	DRAWING ISSUED FOR CONSTRUCTION

BRINGING IDEAS TO LIFE

FRANKHAM

Frankham Consultancy Group Limited
21 Perrymount Road
Haywards Heath RH16 3TP
t 01444 444900 f 01444 455642
enquire@frankham.com
www.frankham.com

Client
Ealing
www.ealing.gov.uk


Project Title
Dominion Arts Centre
Southall
London

Drawing Title
Proposed First Floor Plan
Partition Strategy Plan


Drawn by:	Scale:	Date:
RKC	1:100@A1	21.03.13
Designed by:	Checked by:	Approved by:
FCG	-	-

File Ref.: X:\2009\0224970 - LB EALING - DOMINION ARTS CENTRE\ARCH\102_10B_LOCATION PLANS AND GA - 224970-A-172.DWG - 2009112802 20:06:11 13:36:05

Drawing No. 224970-A-172 | Rev. C2

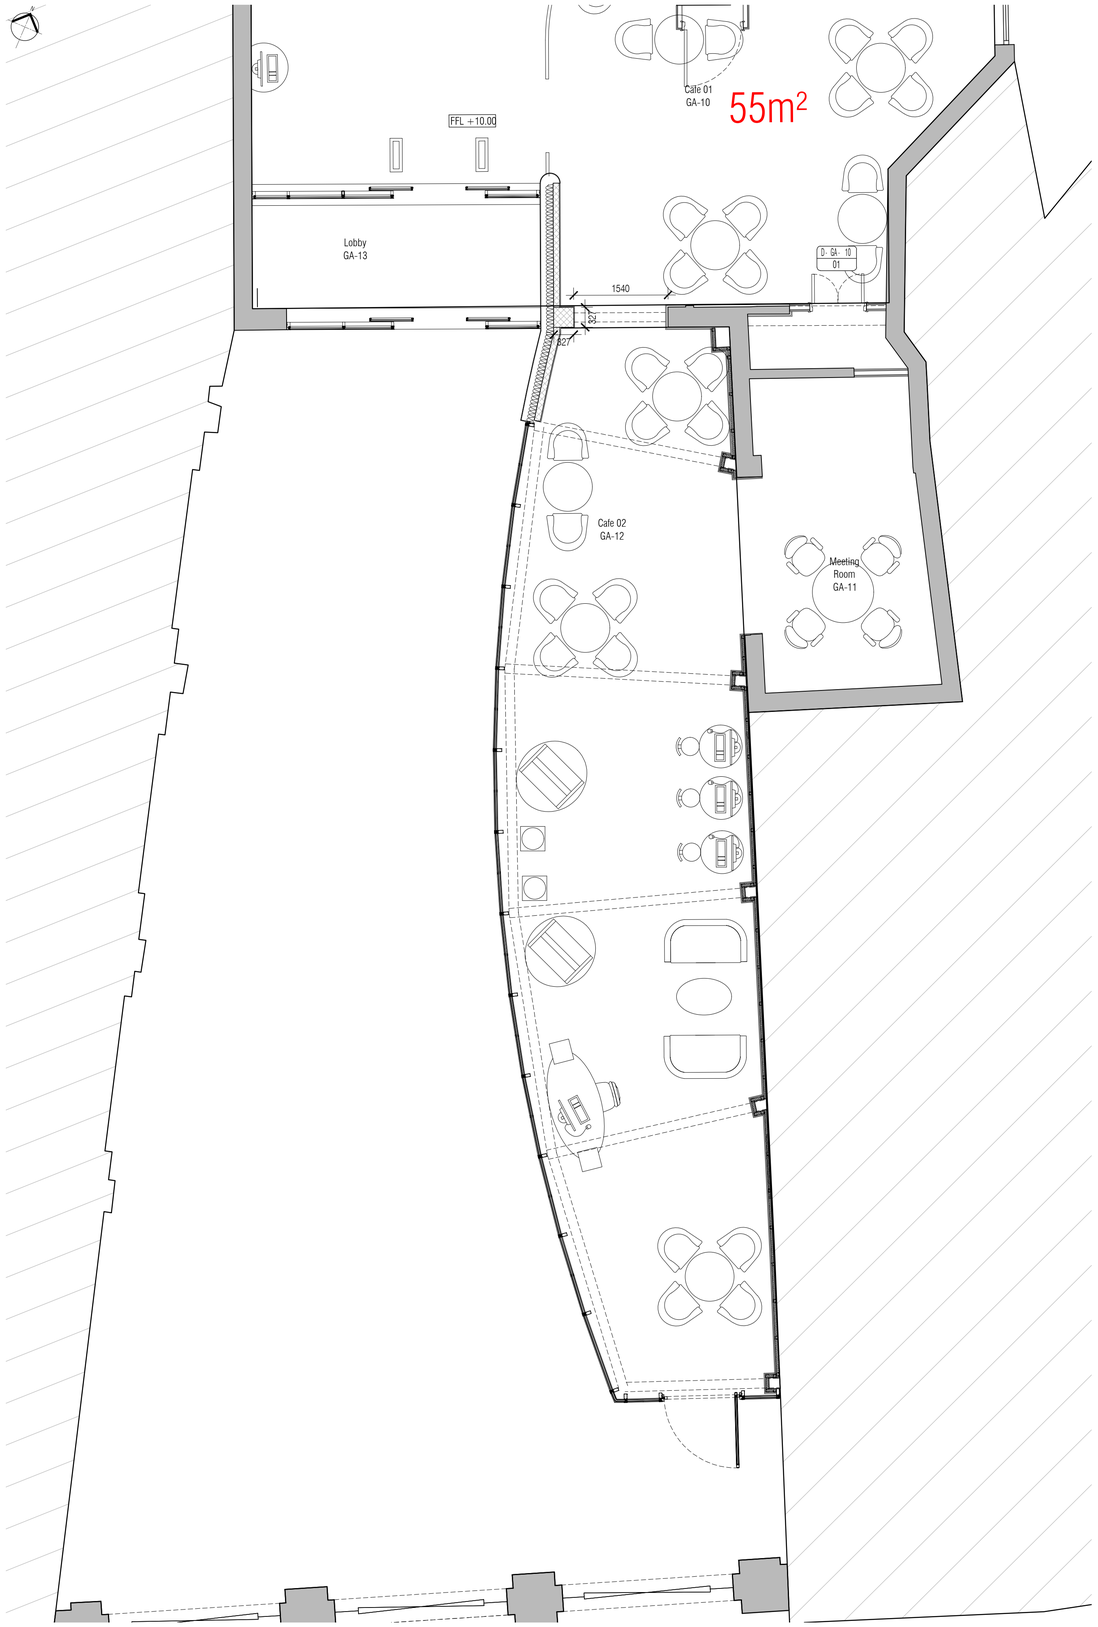


01 Ground Floor Fixed Furniture and Equipment Plan
Scale: 1:50

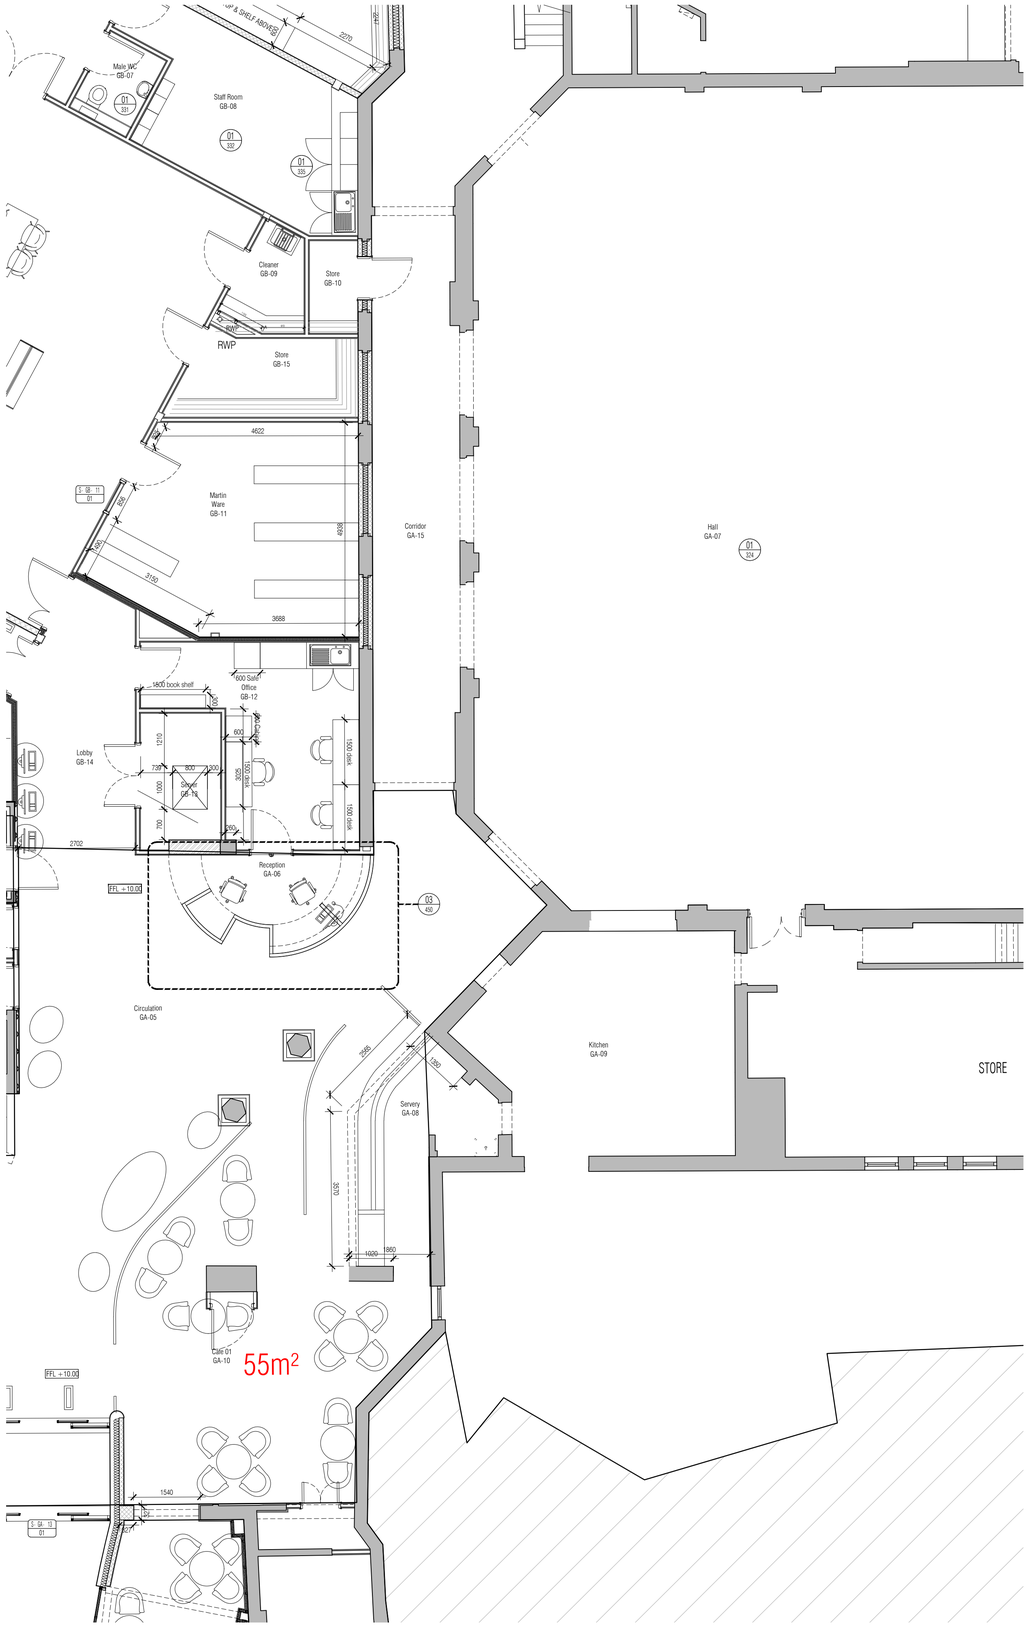

02 Ground Floor Fixed Furniture and Equipment Plan
Scale: 1:50

NOTES: Do not scale this drawing. All dimensions to be checked on site prior to commencement or manufacture.

Key Plan
(nts)

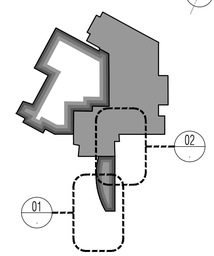

Scale Bar

0 1 2 3 1:50
0 2 4 6 1:100

ISSUED FOR TENDER

Rev	Date	By	Chk	Comment
T1	26.04.13	RKC	JAS	DRAWING ISSUED FOR TENDER

BRINGING IDEAS TO LIFE

FRANKHAM

Frankham Consultancy Group Limited
21 Perrymount Road
Haywards Heath RH16 3TP
t 01444 444900 f 01444 455642
enquire@frankham.com
www.frankham.com

Client
Ealing
www.ealing.gov.uk


Project Title
Dominion Arts Centre
Southall
London

Drawing Title
Proposed
Ground Floor
Fixed Furniture and Equipment Plan
3 of 3


Drawn by:	Scale:	Date:
RKC	1:50@A1	21.02.13
Designed by:	Checked by:	Approved by:
FCG	-	-

File Ref.: X:\2008\0224970 - LB EALING - DOMINION ARTS CENTRE\ARCH\1SS_10B_LOCATION PLANS AND GA\224970-A-182.DWG - 2008/11/2803 20:06:11 13:36:30

Drawing No. 224970-A-182
Rev. T1

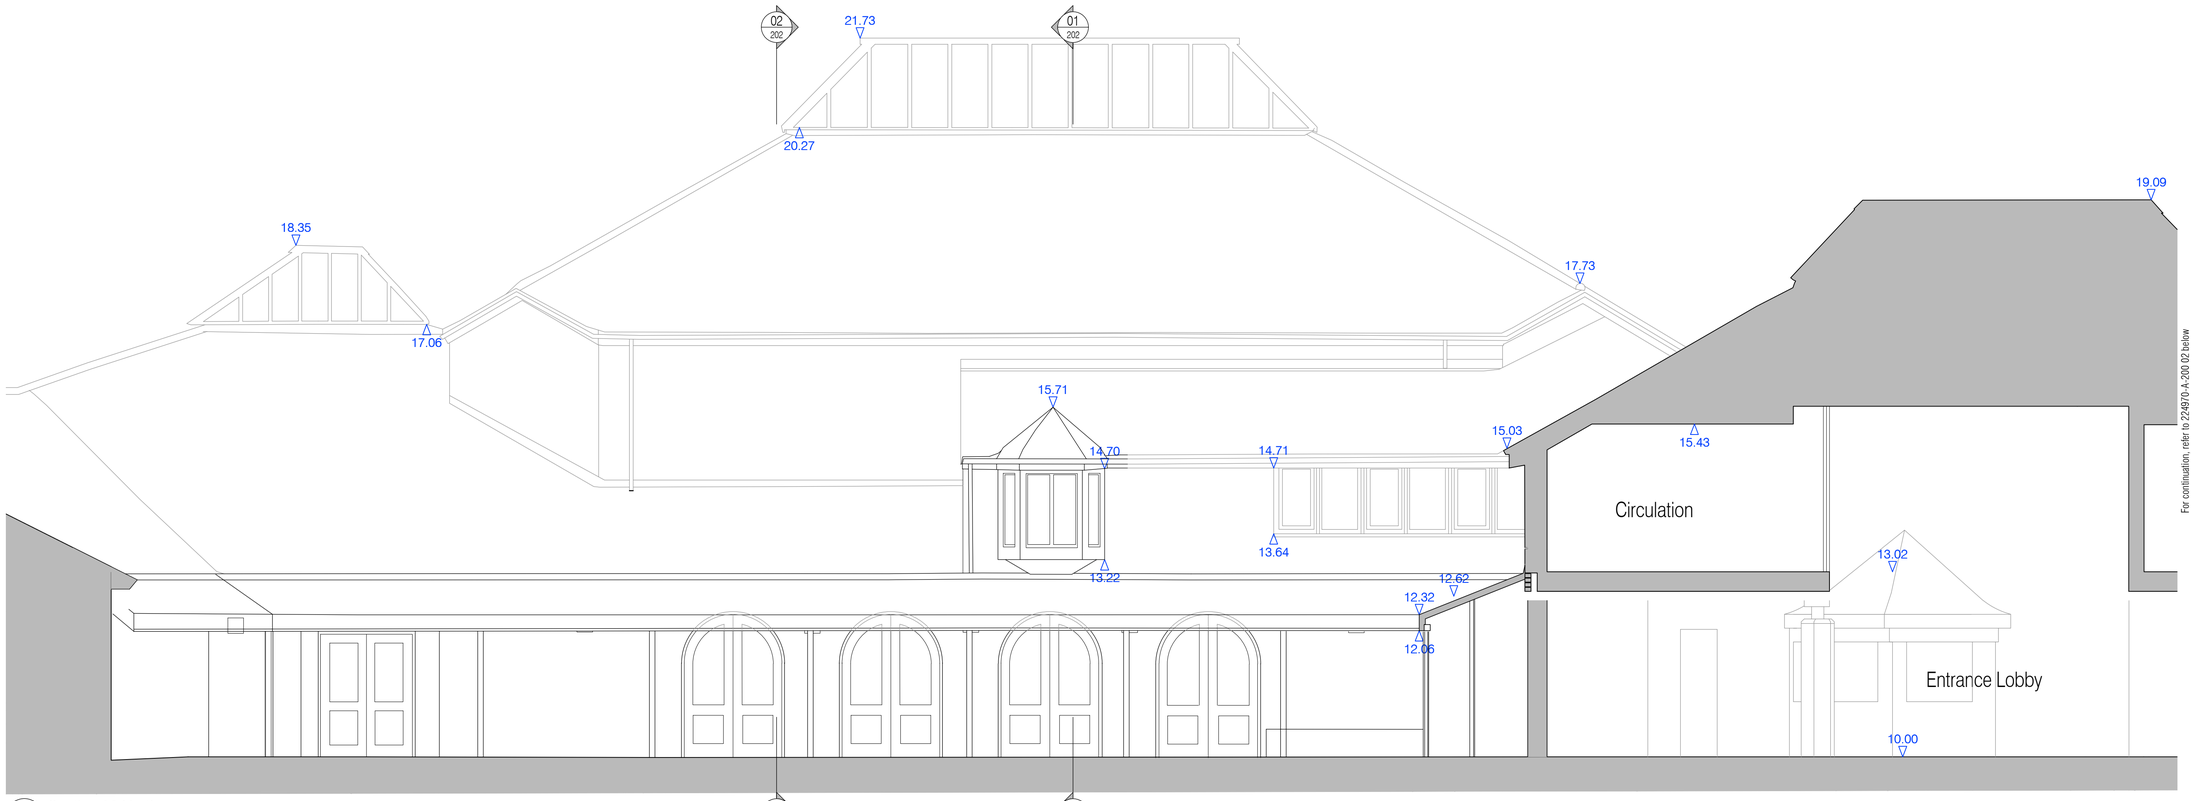


01 Section 02 North
Scale:1:50

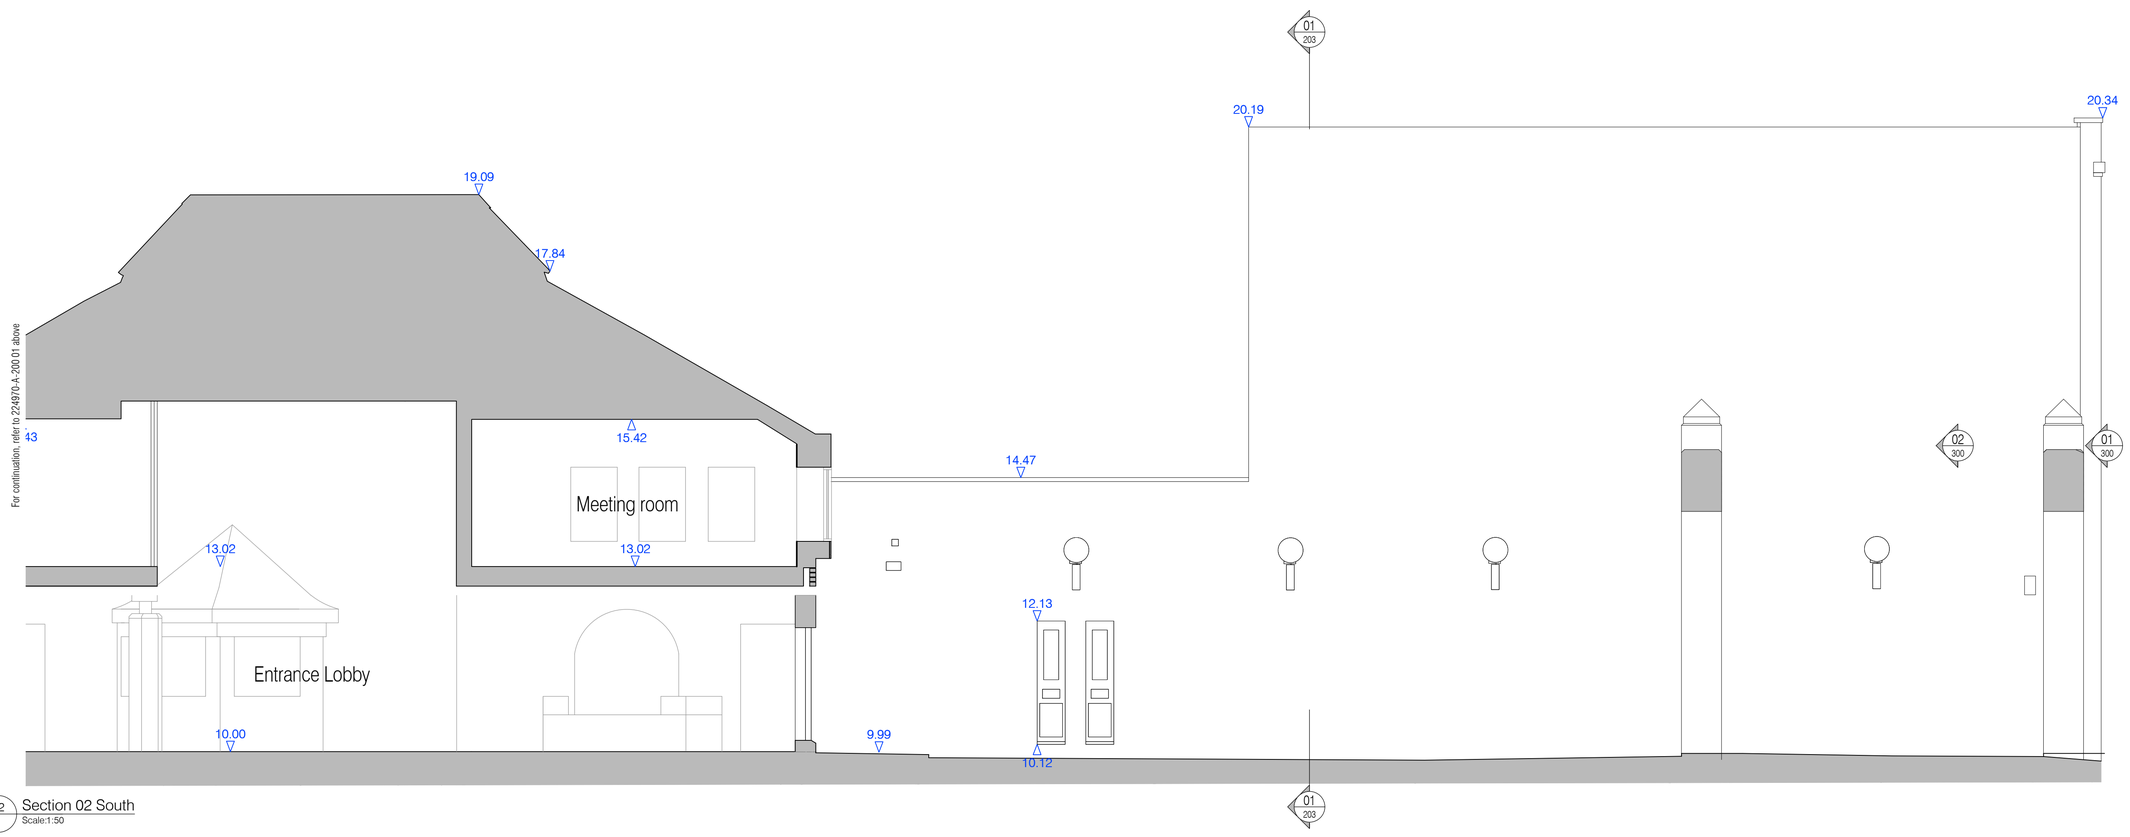

02 Section 02 South
Scale:1:50

NOTES: Do not scale this drawing. All dimensions to be checked on site prior to commencement or manufacture.

Key Plan
(nts)

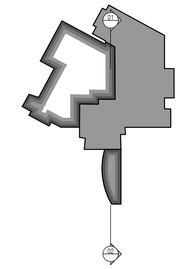

Scale Bar

0 2 4 6 1:100
0 2 4 6 8 10 12 1:200

ISSUED FOR CONSTRUCTION

Rev	Date	By	Chk	Comment
C1	03.07.13	RKC	JAS	Issued for CONSTRUCTION

BRINGING IDEAS TO LIFE

FRANKHAM

Frankham Consultancy Group Limited
21 Perrymount Road
Haywards Heath RH16 3TP
t 01444 449000 f 01444 455642
enquire@frankham.com
www.frankham.com

Client
Ealing
www.ealing.gov.uk

Project Title
Dominion Arts Centre
Southall
London

Drawing Title
Existing
Section 02

Drawn by:	Scale:	Date:
RKC	1:50@A1	07.12.12
Designed by:	Checked by:	Approved by:
FCG	-	-

File Ref.: K:\2009\09224970 - LB EALING - DOMINION ARTS CENTRE\ARCH\200_799_SECTIONS\224970-A-200.DWG - 2009/11/28/47 20.06.11 13:36:47

Drawing No.	Rev.
224970-A-200	C1



01 201

01 Section 05
Scale:1:50


01 201

02 Section 06
Scale:1:50

01 201

NOTES: Do not scale this drawing. All dimensions to be checked on site prior to commencement or manufacture.

Key Plan
(nts)

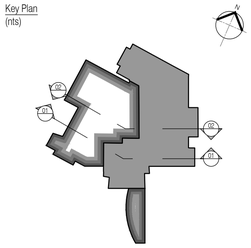

Scale Bar

0 2 4 6 1:100
0 2 4 6 8 10 12 1:200

ISSUED FOR CONSTRUCTION

Rev	Date	By	Chk	Comment
C1	03.07.13	RKC	JAS	Issued for CONSTRUCTION

BRINGING IDEAS TO LIFE

FRANKHAM

Frankham Consultancy Group Limited
21 Perrymount Road
Haywards Heath RH16 3TP
t 01444 444900 f 01444 455642
enquire@frankham.com
www.frankham.com

Client
Ealing
www.ealing.gov.uk


Project Title
Dominion Arts Centre
Southall
London

Drawing Title
Existing
Sections 05 & 06


Drawn by:	Scale:	Date:
RKC	1:50@A1	19.12.12
Designed by:	Checked by:	Approved by:
FCG	-	-

File Ref.: K:\2000\224970 - LB EALING - DOMINION ARTS CENTRE\ARCH\202_3W_SECTIONS 224970-A-202.DWG - 2008/113804
20:06:11 13:36:57

Drawing No. 224970-A-202
Rev. C1

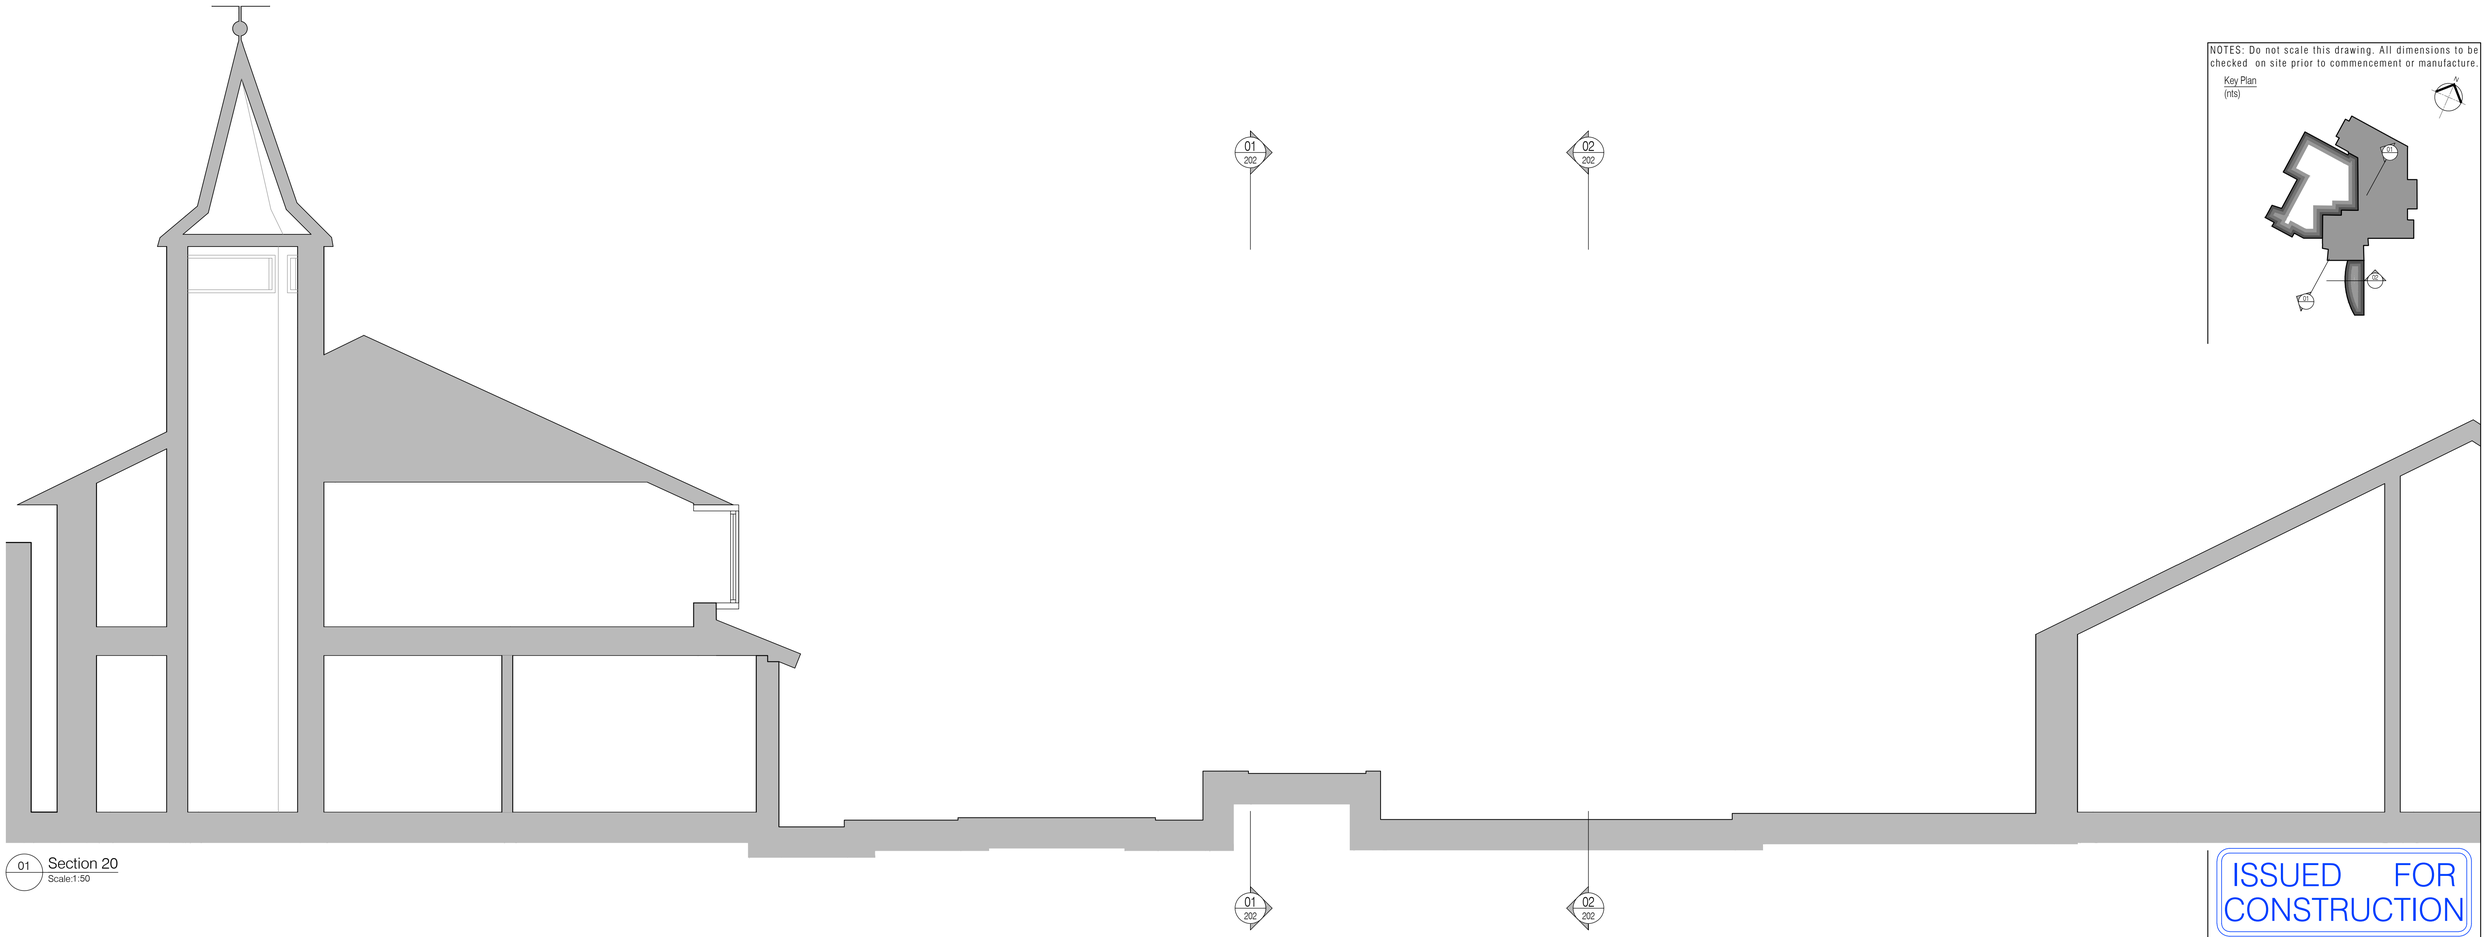

01 Section 20
Scale:1:50

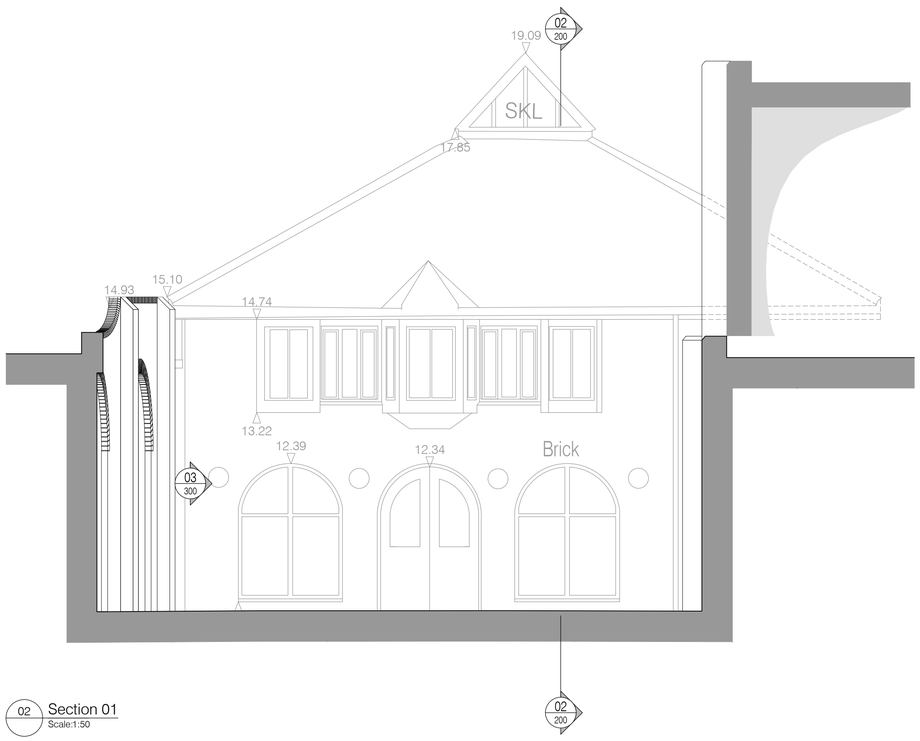

02 Section 01
Scale:1:50

NOTES: Do not scale this drawing. All dimensions to be checked on site prior to commencement or manufacture.

Key Plan
(nts)

ISSUED FOR CONSTRUCTION

Rev	Date	By	Chk	Comment
C1	03.07.13	RKC	JAS	Issued for CONSTRUCTION

BRINGING IDEAS TO LIFE

FRANKHAM

Frankham Consultancy Group Limited
21 Perrymount Road
Haywards Heath RH16 3TP
t 01444 449000 f 01444 455642
enquire@frankham.com
www.frankham.com

Client
Ealing
www.ealing.gov.uk


Project Title
Dominion Arts Centre
Southall
London

Drawing Title
Existing
Sections 20 & 01


Drawn by:	Scale:	Date:
RKC	1:50@A1	28.03.13
Designed by:	Checked by:	Approved by:
FCG	-	-

File Ref.: K:\2009\0224970 - LB EALING - DOMINION ARTS CENTRE\ARCH\200_799_SECTIONS\224970-A-200.DWG - 20061113 07:02

Drawing No.	Rev.
224970-A-203	C1

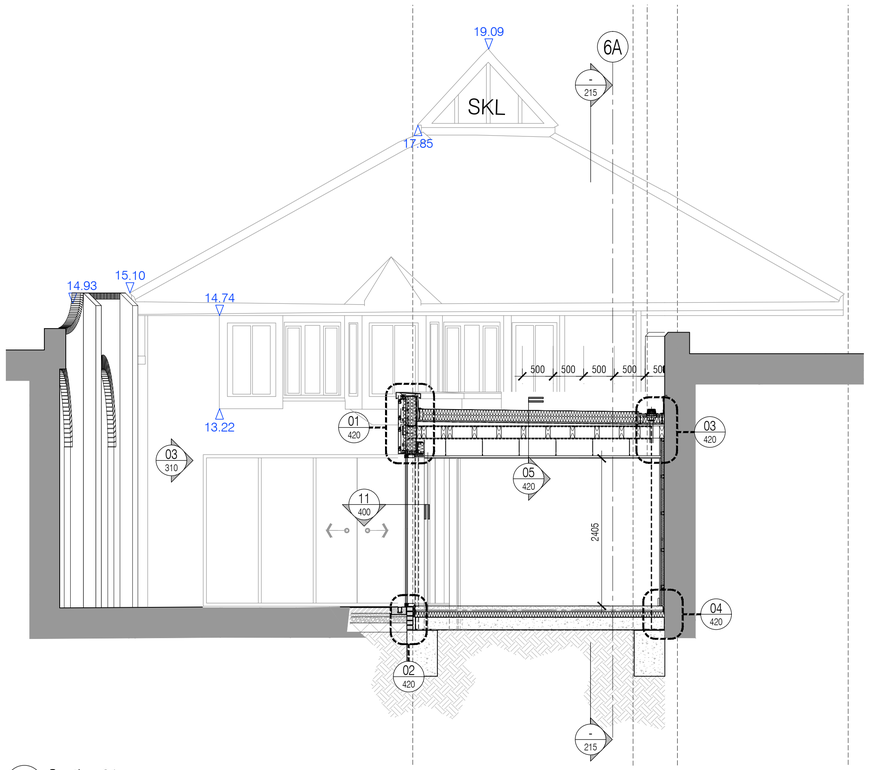


01 Section 01
Scale:1:50

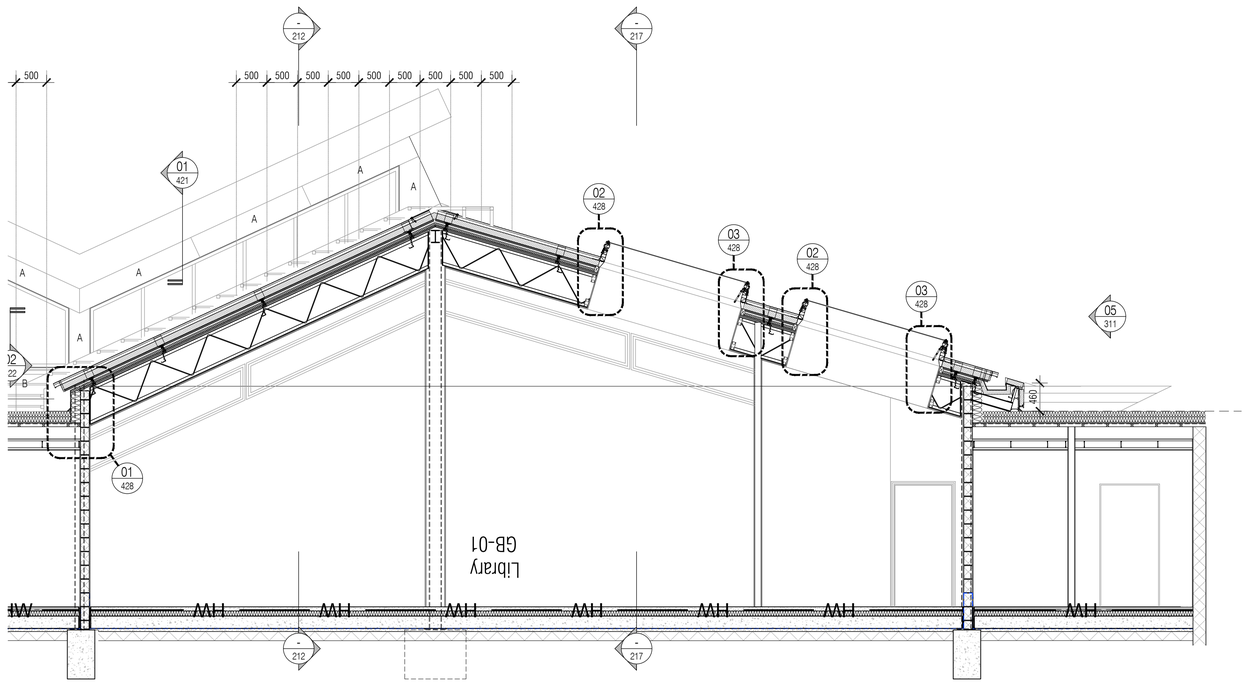

03 Section 19
Scale:1:50

NOTES: Do not scale this drawing. All dimensions to be checked on site prior to commencement or manufacture.

Key Plan
(nts)

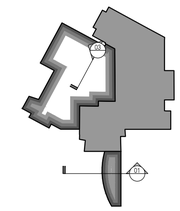

Scale Bar

0 2 4 6 1:100
0 2 4 6 8 10 12 1:200

ISSUED FOR CONSTRUCTION

Rev	Date	By	Chk	Comment
C2	01.11.13	CH	AC	Gutter detail adjusted
C1	03.07.13	RKC	JAS	Issued for CONSTRUCTION

BRINGING IDEAS TO LIFE

FRANKHAM

Frankham Consultancy Group Limited
21 Perrymount Road
Haywards Heath RH16 3TP
t 01444 444900 f 01444 455642
enquire@frankham.com
www.frankham.com

Client
Ealing
www.ealing.gov.uk


Project Title
Dominion Arts Centre
Southall
London

Drawing Title
Proposed
Sections 01 & 19

Drawn by:	Scale:	Date:
RKC	1:50@A1	19.03.13
Designed by:	Checked by:	Approved by:
FCG	-	-

File Ref.: K:\2000\[224970 - 224974] - EALING - DOMINION ARTS CENTRE\ARCH\CAD_DWG_SECTIONS\224970-A-210.DWG - 20061111\3737.16

Drawing No.	Rev.
224970-A-210	C2

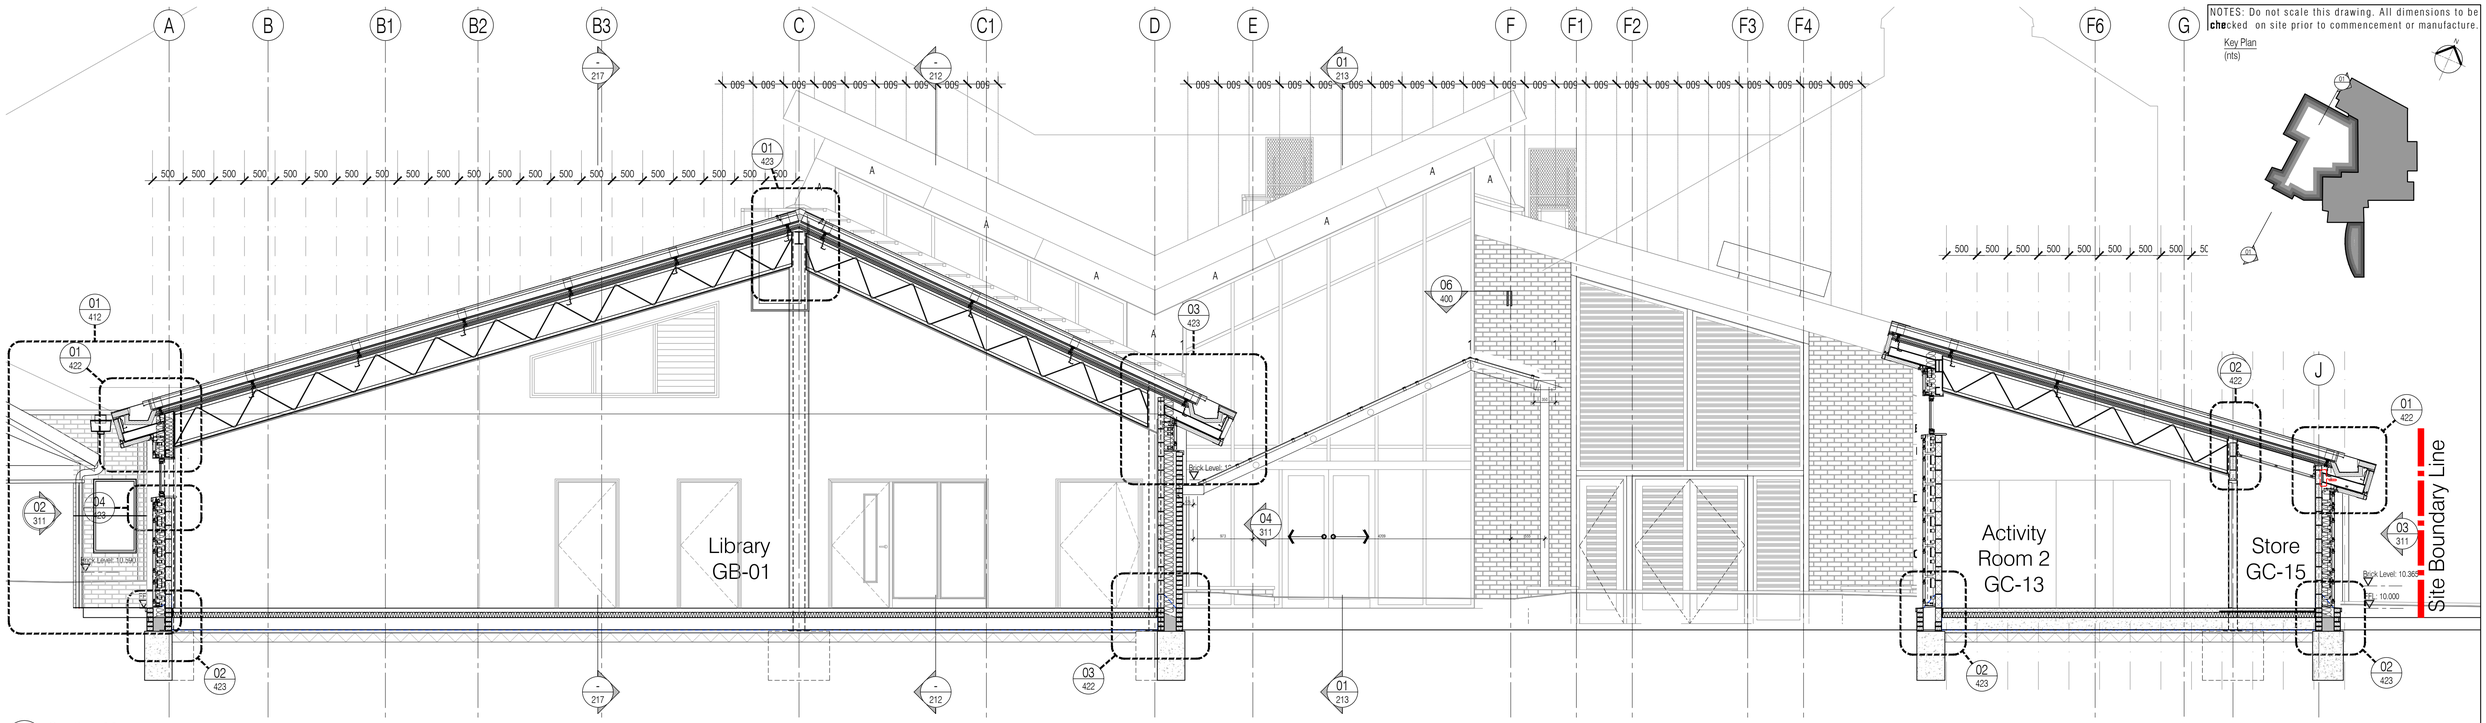

01 Section 03
Scale:1:50

NOTES: Do not scale this drawing. All dimensions to be checked on site prior to commencement or manufacture.

Key Plan
(nts)

Scale Bar

0 2 4 6 1:100
0 2 4 6 8 10 12 1:200

ISSUED FOR CONSTRUCTION

Rev	Date	By	Chk	Comment
C1	03.07.13	RKC	JAS	Issued for CONSTRUCTION

BRINGING IDEAS TO LIFE

FRANKHAM

Frankham Consultancy Group Limited
21 Perrymount Road
Haywards Heath RH16 3TP
t 01444 444900 f 01444 455642
enquire@frankham.com
www.frankham.com

Client
Ealing
www.ealing.gov.uk


Project Title
Dominion Arts Centre
Southall
London

Drawing Title
Proposed
Sections 03


Drawn by:	Scale:	Date:
RKC	1:50@A1	07.12.12
Designed by:	Checked by:	Approved by:
FCG	CDH	AGC

File Ref.: K:\2000\[224970 - EALING - DOMINION ARTS CENTRE\ARCH\2D_DR_0227CAD\] 224970-A-211.DWG - 2008/11/03/12 20:06:11 13:37:35

Drawing No.	Rev.
224970-A-211	C1

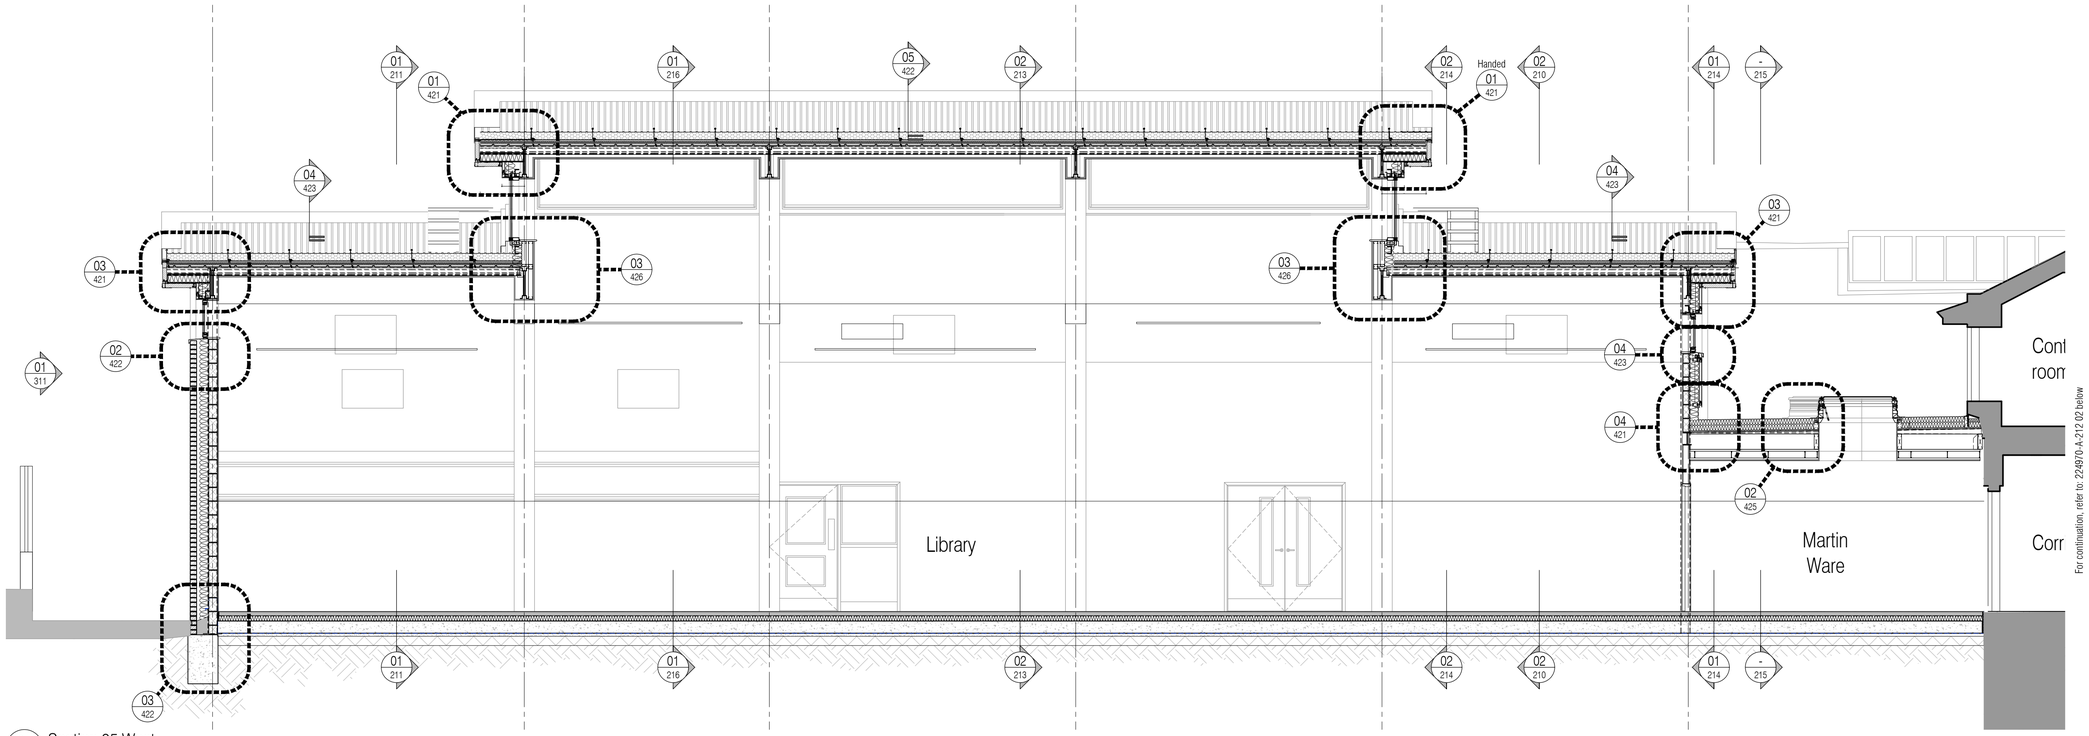


01 Section 05 West
Scale:1:50

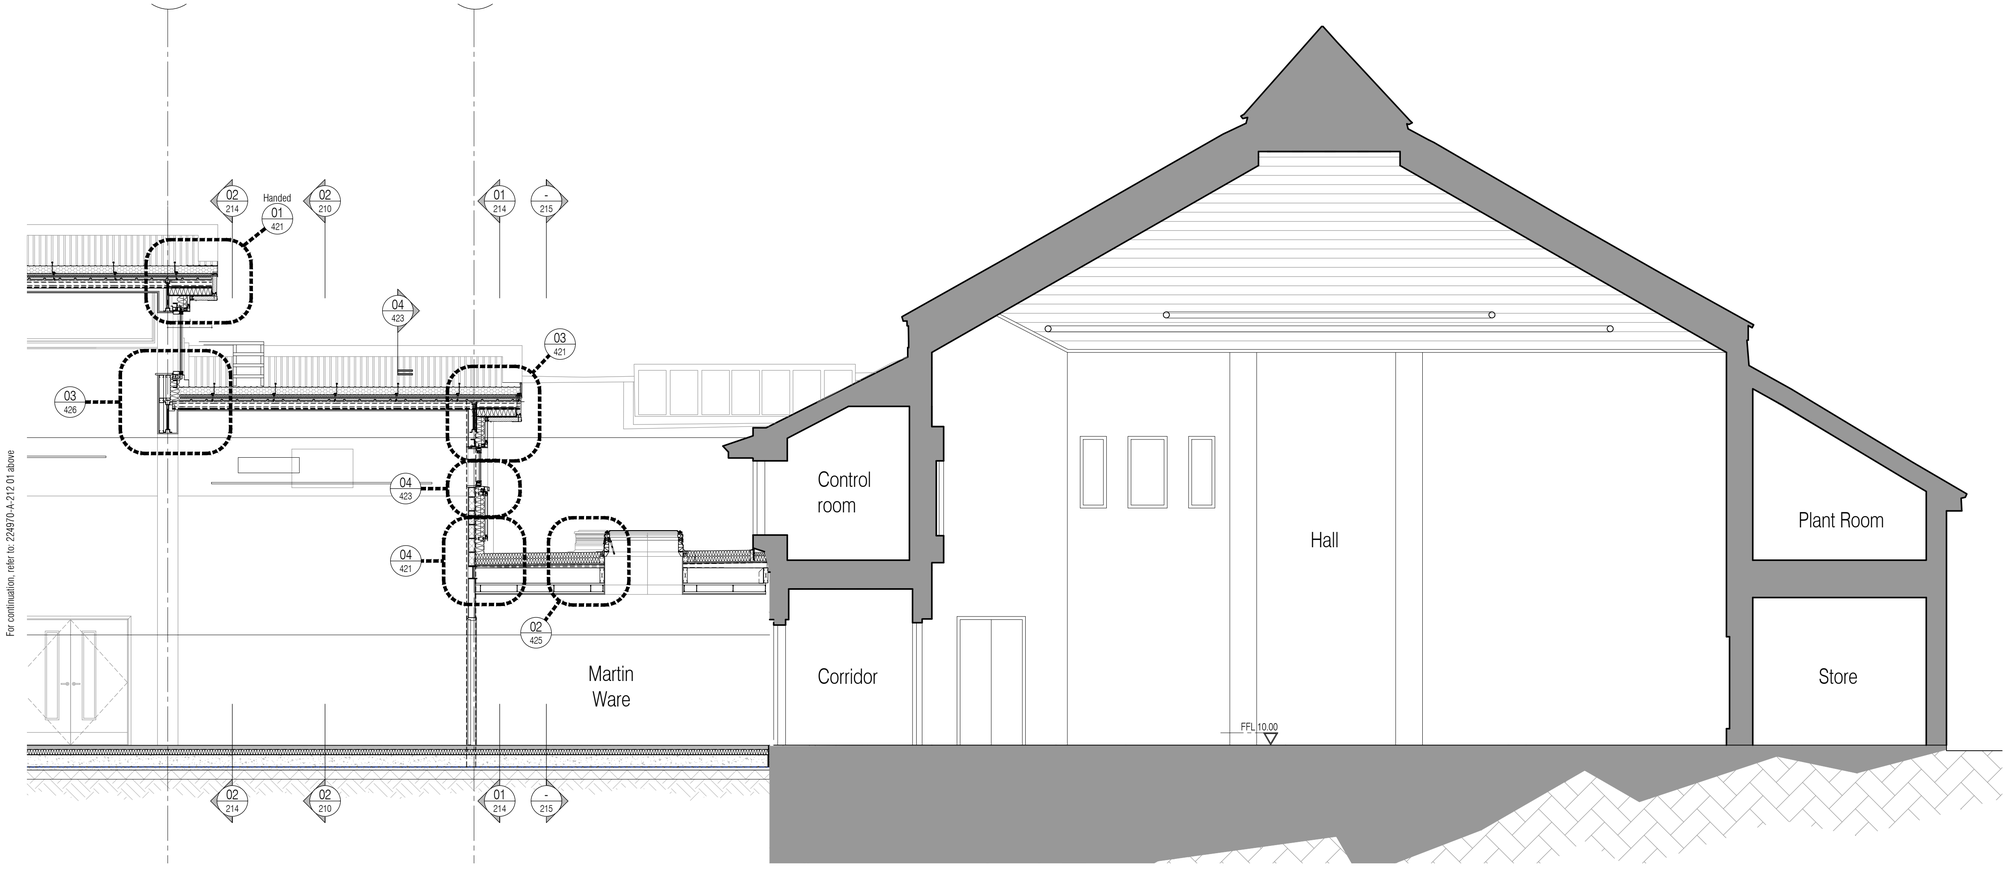

02 Section 05 East
Scale:1:50

NOTES: Do not scale this drawing. All dimensions to be checked on site prior to commencement or manufacture.

Key Plan
(nts)

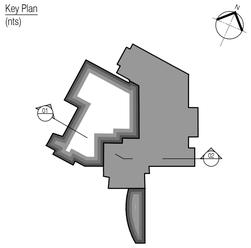

ISSUED FOR CONSTRUCTION

Rev	Date	By	Chk	Comment
C1	03.07.13	RKC	JAS	Issued for CONSTRUCTION

BRINGING IDEAS TO LIFE

FRANKHAM

Frankham Consultancy Group Limited
21 Perrymount Road
Haywards Heath RH16 3TP
t 01444 444900 f 01444 455642
enquire@frankham.com
www.frankham.com

Client
Ealing
www.ealing.gov.uk


Project Title
Dominion Arts Centre
Southall
London

Drawing Title
Proposed
Sections 05 & 06


Drawn by:	Scale:	Date:
RKC	1:100@A1	19.12.12
Designed by:	Checked by:	Approved by:
FCG	-	-

File Ref.: K:\2000\[224970 - LB EALING - DOMINION ARTS CENTRE\ARCH\2D_DR_ISSTCNS\] 224970-A-212.DWG - 2008/11/03/10:42
20:06:11 13:37:45

Drawing No. 224970-A-212
Rev. C1

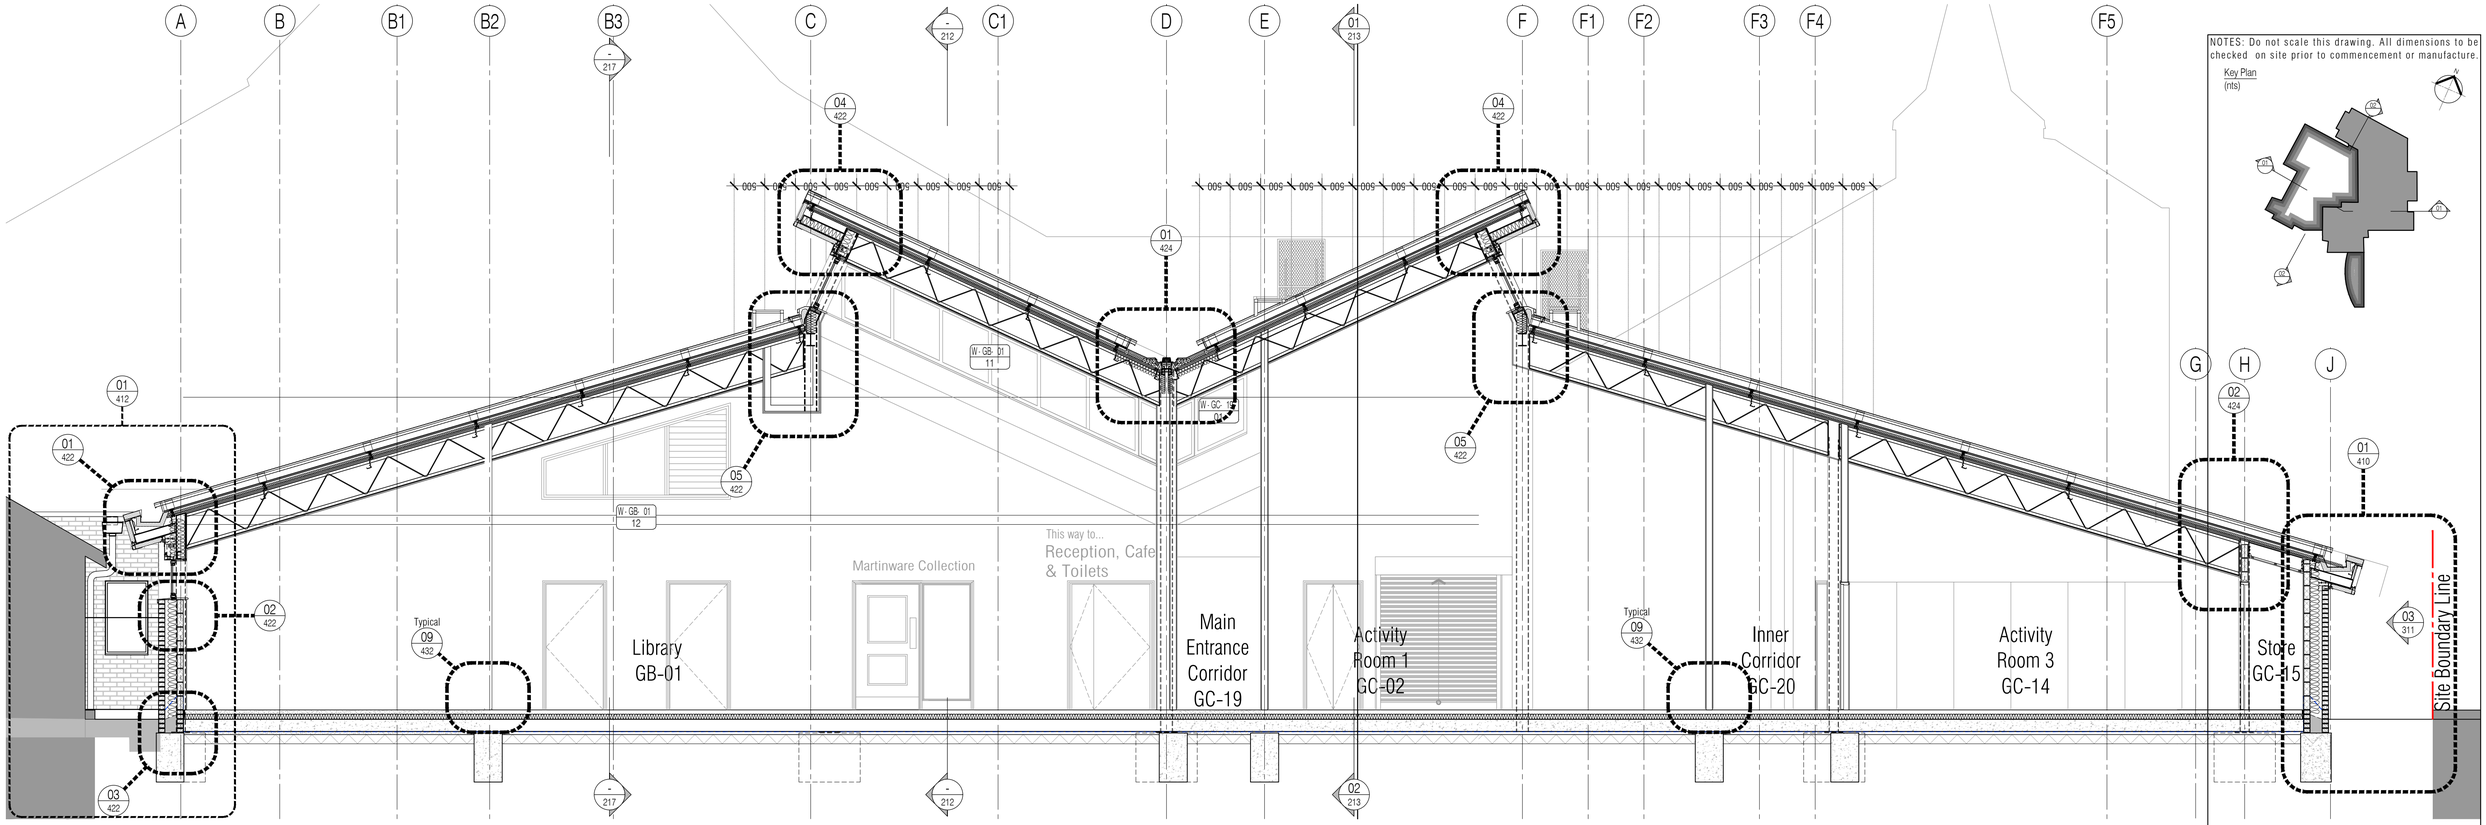

02 Section 08
Scale:1:50

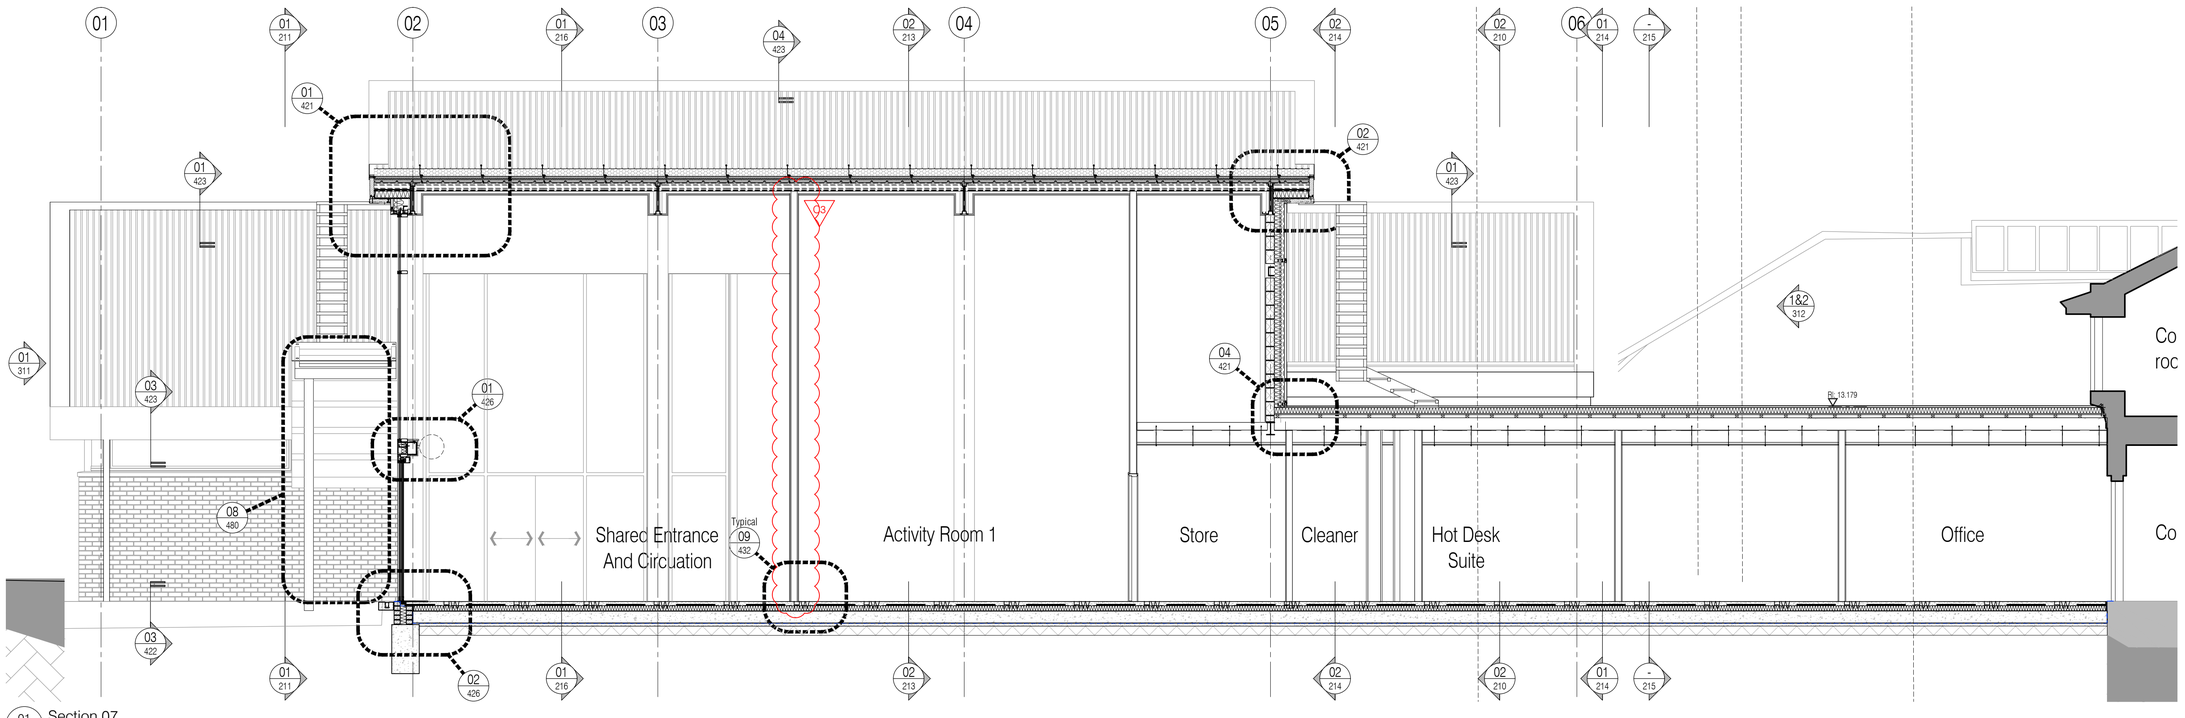

01 Section 07
Scale:1:50

NOTES: Do not scale this drawing. All dimensions to be checked on site prior to commencement or manufacture.

Key Plan
(nts)

ISSUED FOR CONSTRUCTION

Rev	Date	By	Chk	Comment
C3	24.10.13	MLE	CH	Wall to GC02 moved
C2	02.10.13	CH	AC	Bulkhead Added, windows adjusted
C1	03.07.13	RKC	JAS	Issued for CONSTRUCTION

BRINGING IDEAS TO LIFE

FRANKHAM

Frankham Consultancy Group Limited
21 Perrymount Road
Haywards Heath RH16 3TP
t 01444 444900 f 01444 455642
enquire@frankham.com
www.frankham.com

Client
Ealing
www.ealing.gov.uk


Project Title
Dominion Arts Centre
Southall
London

Drawing Title
Proposed
Sections 08 & 07


Drawn by:	Scale:	Date:
RKC	1:50@A1	19.12.12
Designed by:	Checked by:	Approved by:
FCG	-	-

File Ref.: K:\2000\224970 - EALING - DOMINION ARTS CENTRE\ARCH\2D_DR_SECTIONS 224970-A-213.DWG - 2008111004
20:06:11 13:38:07

Drawing No.	Rev.
224970-A-213	C3

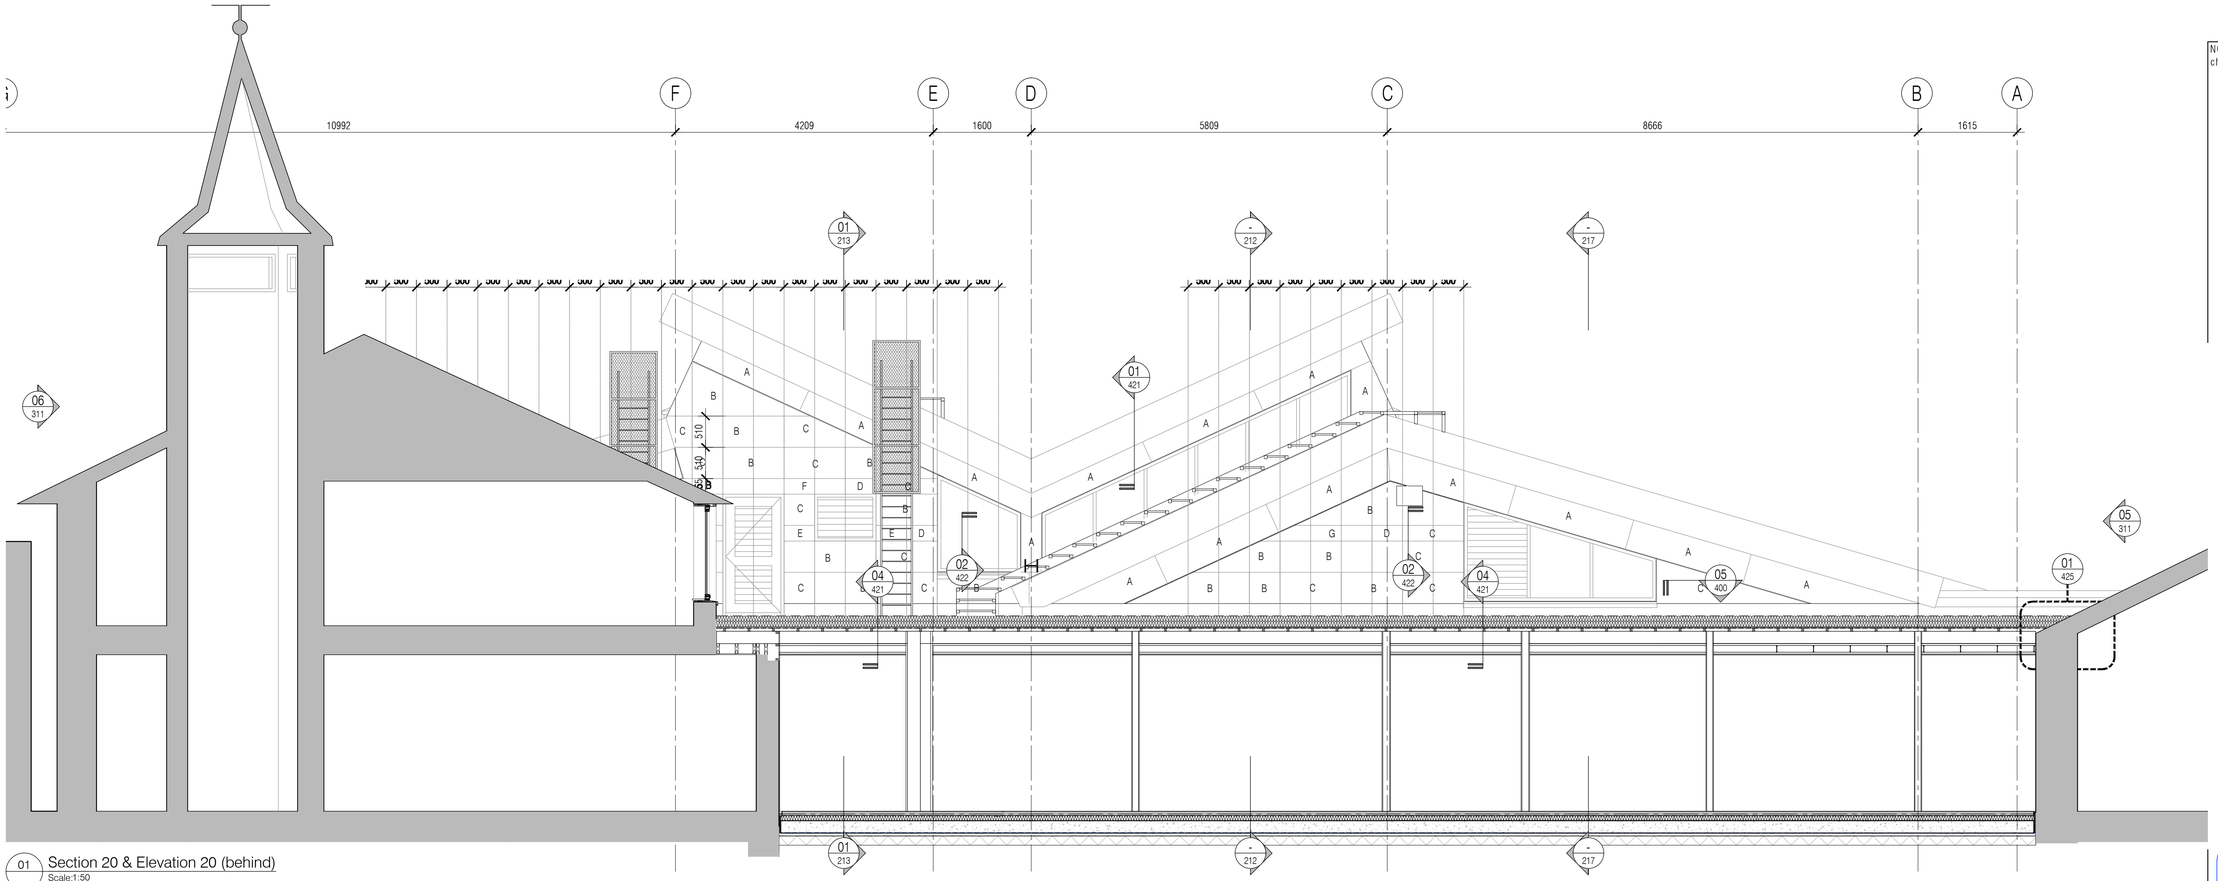


01 Section 20 & Elevation 20 (behind)
Scale:1:50

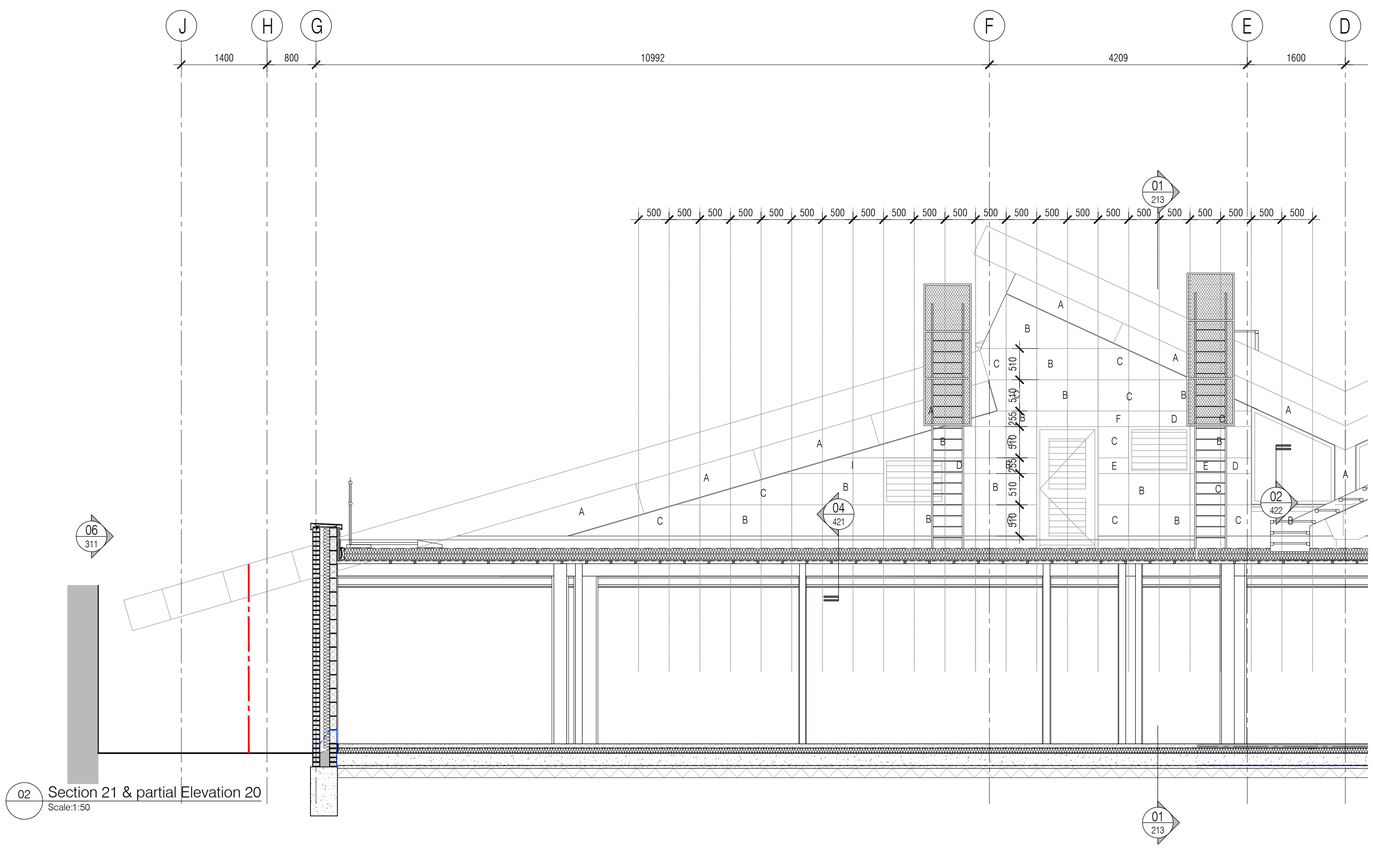

02 Section 21 & partial Elevation 20
Scale:1:50

NOTES: Do not scale this drawing. All dimensions to be checked on site prior to commencement or manufacture.

Key Plan
(nts)

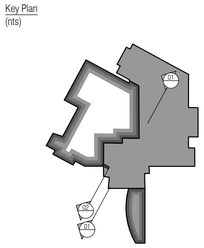

ISSUED FOR CONSTRUCTION

Rev	Date	By	Chk	Comment
C1	03.07.13	RKC	JAS	Issued for CONSTRUCTION

BRINGING IDEAS TO LIFE

FRANKHAM

Frankham Consultancy Group Limited
21 Perrymount Road
Haywards Heath RH16 3TP
t 01444 444900 f 01444 455642
enquire@frankham.com
www.frankham.com

Client
Ealing
www.ealing.gov.uk


Project Title
Dominion Arts Centre
Southall
London

Drawing Title
Proposed
Sections 20 & 21
with Elevation 20 behind

Drawn by:	Scale:	Date:
RKC	1:50@A1	19.12.12
Designed by:	Checked by:	Approved by:
FCG	-	-

File Ref.: K:\2000\02\24970 - LEALNL - DOMINION ARTS CENTRE\ARCH\2D_3M_SECTIONS\224970-A-214.DWG - 20080113819 20:06:11 13:38:20

Drawing No.	Rev.
224970-A-214	C1

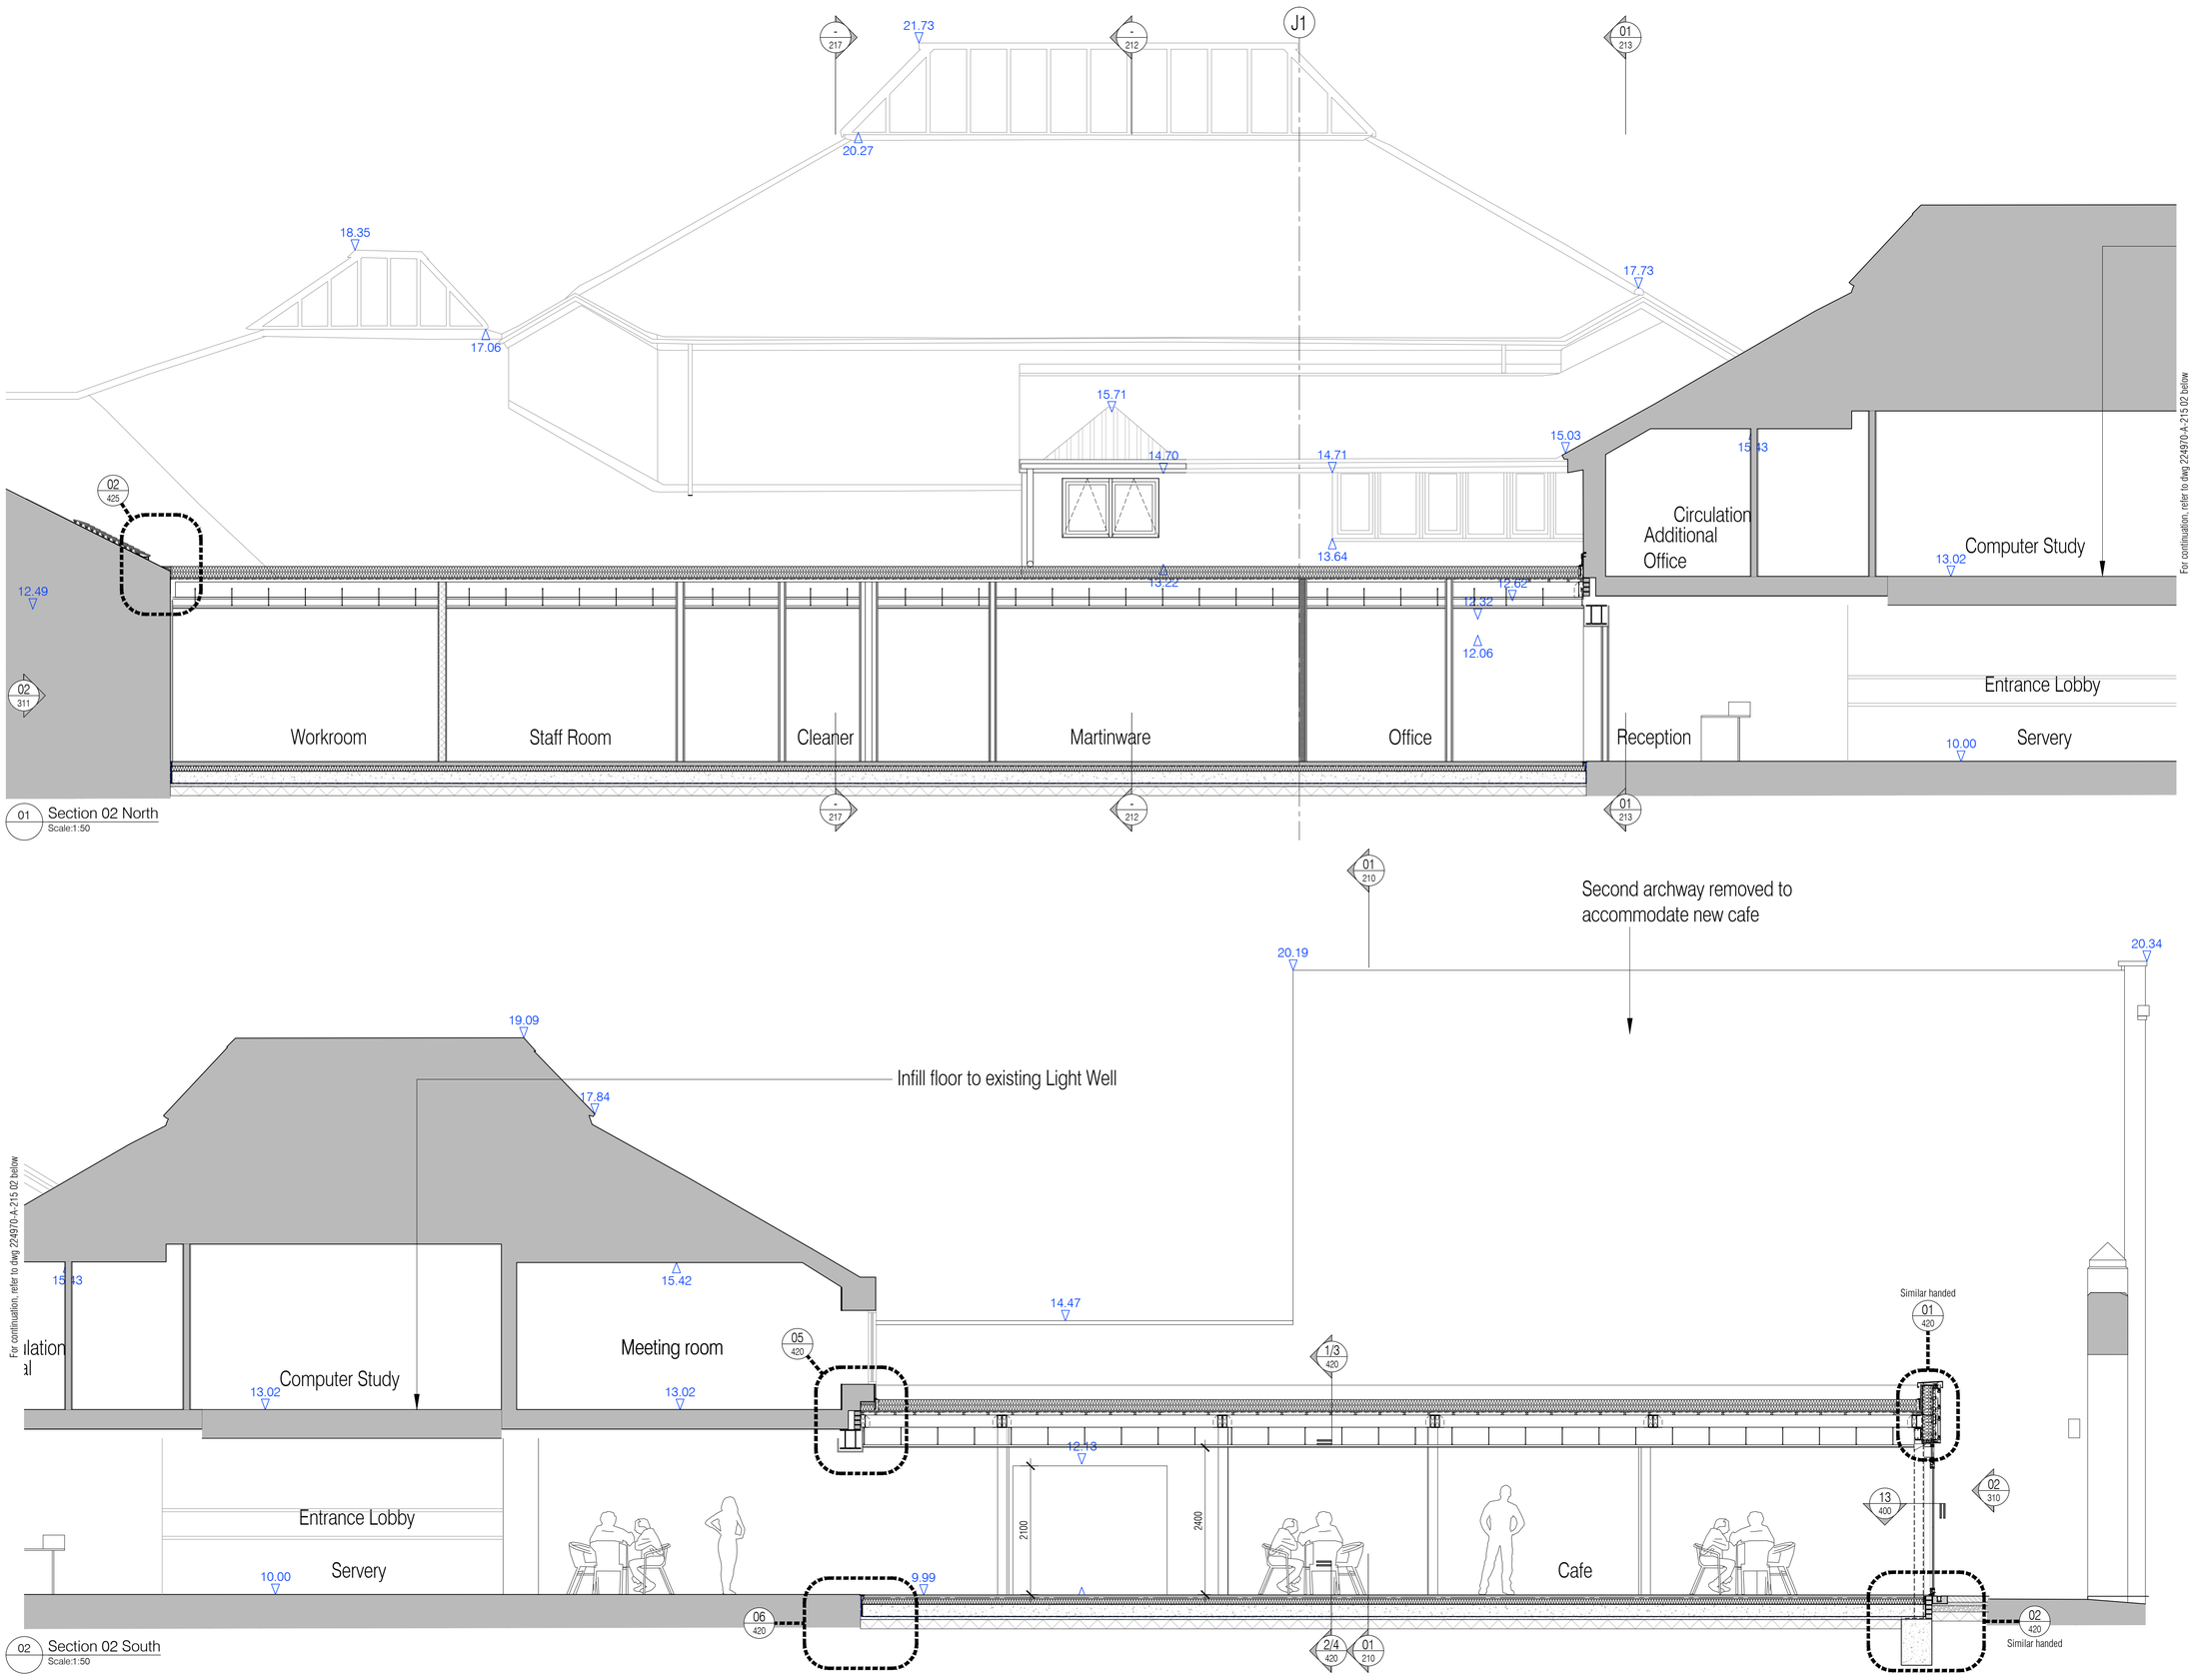


01 Section 02 North
Scale:1:50

02 Section 02 South
Scale:1:50

NOTES: Do not scale this drawing. All dimensions to be checked on site prior to commencement or manufacture.

Key Plan
(nts)

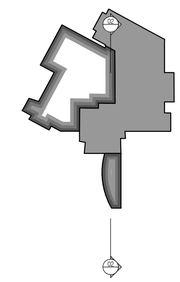

Scale Bar

0 2 4 6 1:100
0 2 4 6 8 10 12 1:200

ISSUED FOR CONSTRUCTION

Rev	Date	By	Chk	Comment
C1	03.07.13	RKC	JAS	Issued for CONSTRUCTION

BRINGING IDEAS TO LIFE

FRANKHAM

Frankham Consultancy Group Limited
21 Perrymount Road
Haywards Heath RH16 3TP
t 01444 444900 f 01444 455642
enquire@frankham.com
www.frankham.com

Client
Ealing
www.ealing.gov.uk


Project Title
Dominion Arts Centre
Southall
London

Drawing Title
Proposed
Section 02

Drawn by:	Scale:	Date:
RKC	1:50@A1	19.03.13
Designed by:	Checked by:	Approved by:
FCG	-	-

File Ref.: X:\2008\0224970 - LB EALING - DOMINION ARTS CENTRE\ARCH\2D_RM_SECTIONS\224970-A-215.DWG - 2008111\2870 20.06.11 13:38:30

Drawing No. 224970-A-215
Rev. C1

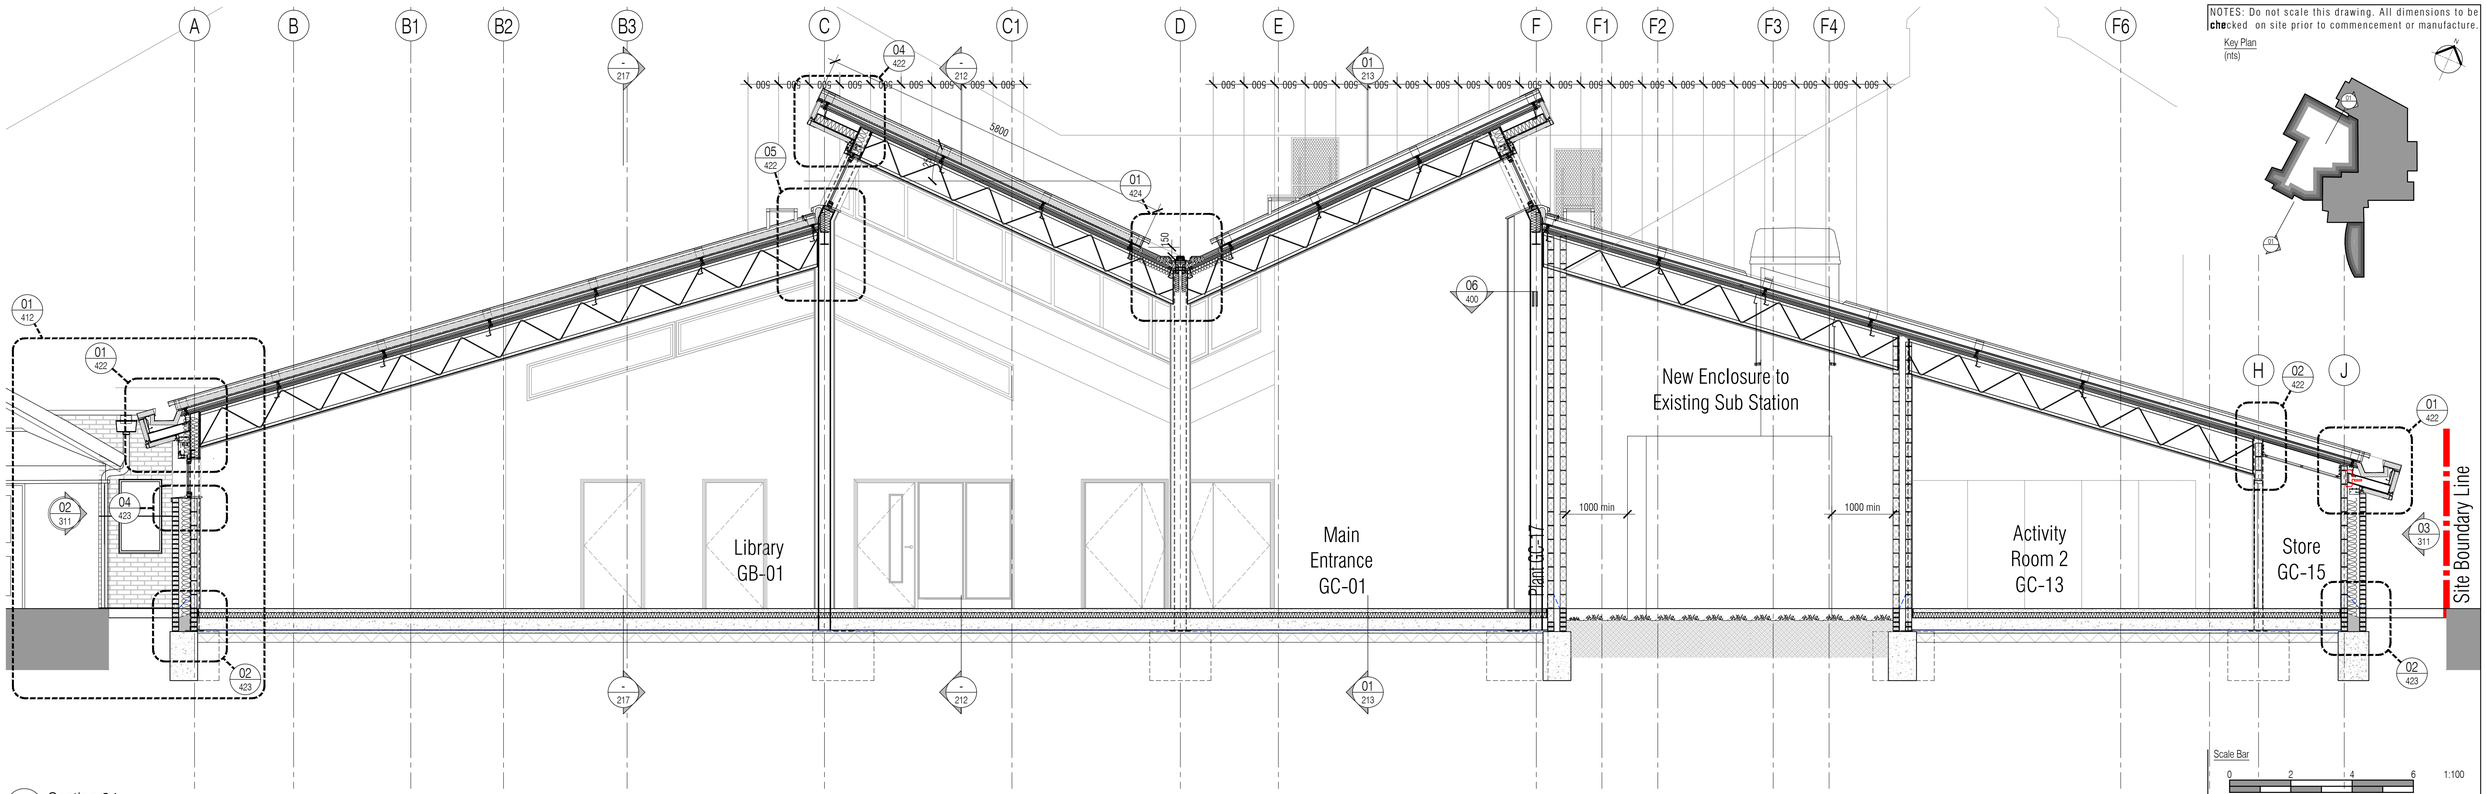

01 Section 04
Scale:1:50

NOTES: Do not scale this drawing. All dimensions to be checked on site prior to commencement or manufacture.

Key Plan
(nts)

Scale Bar

0 2 4 6 1:100
0 2 4 6 8 10 12 1:200

ISSUED FOR CONSTRUCTION

Rev	Date	By	Chk	Comment
C1	03.07.13	RKC	JAS	Issued for CONSTRUCTION

BRINGING IDEAS TO LIFE

FRANKHAM

Frankham Consultancy Group Limited
21 Perrymount Road
Haywards Heath RH16 3TP
t 01444 449000 f 01444 455642
enquire@frankham.com
www.frankham.com

Client
Ealing
www.ealing.gov.uk


Project Title
Dominion Arts Centre
Southall
London

Drawing Title
Proposed
Sections 04

Drawn by:	Scale:	Date:
RKC	1:50@A1	07.12.12
Designed by:	Checked by:	Approved by:
FCG	CDH	AGC


File Ref.: K:\2009\09224970 - LB EALING - DOMINION ARTS CENTRE\ARCH\2D_799_SECTIONS 224970-A-216.DWG — 20061113:38:40

Drawing No.	Rev.
224970-A-216	C1

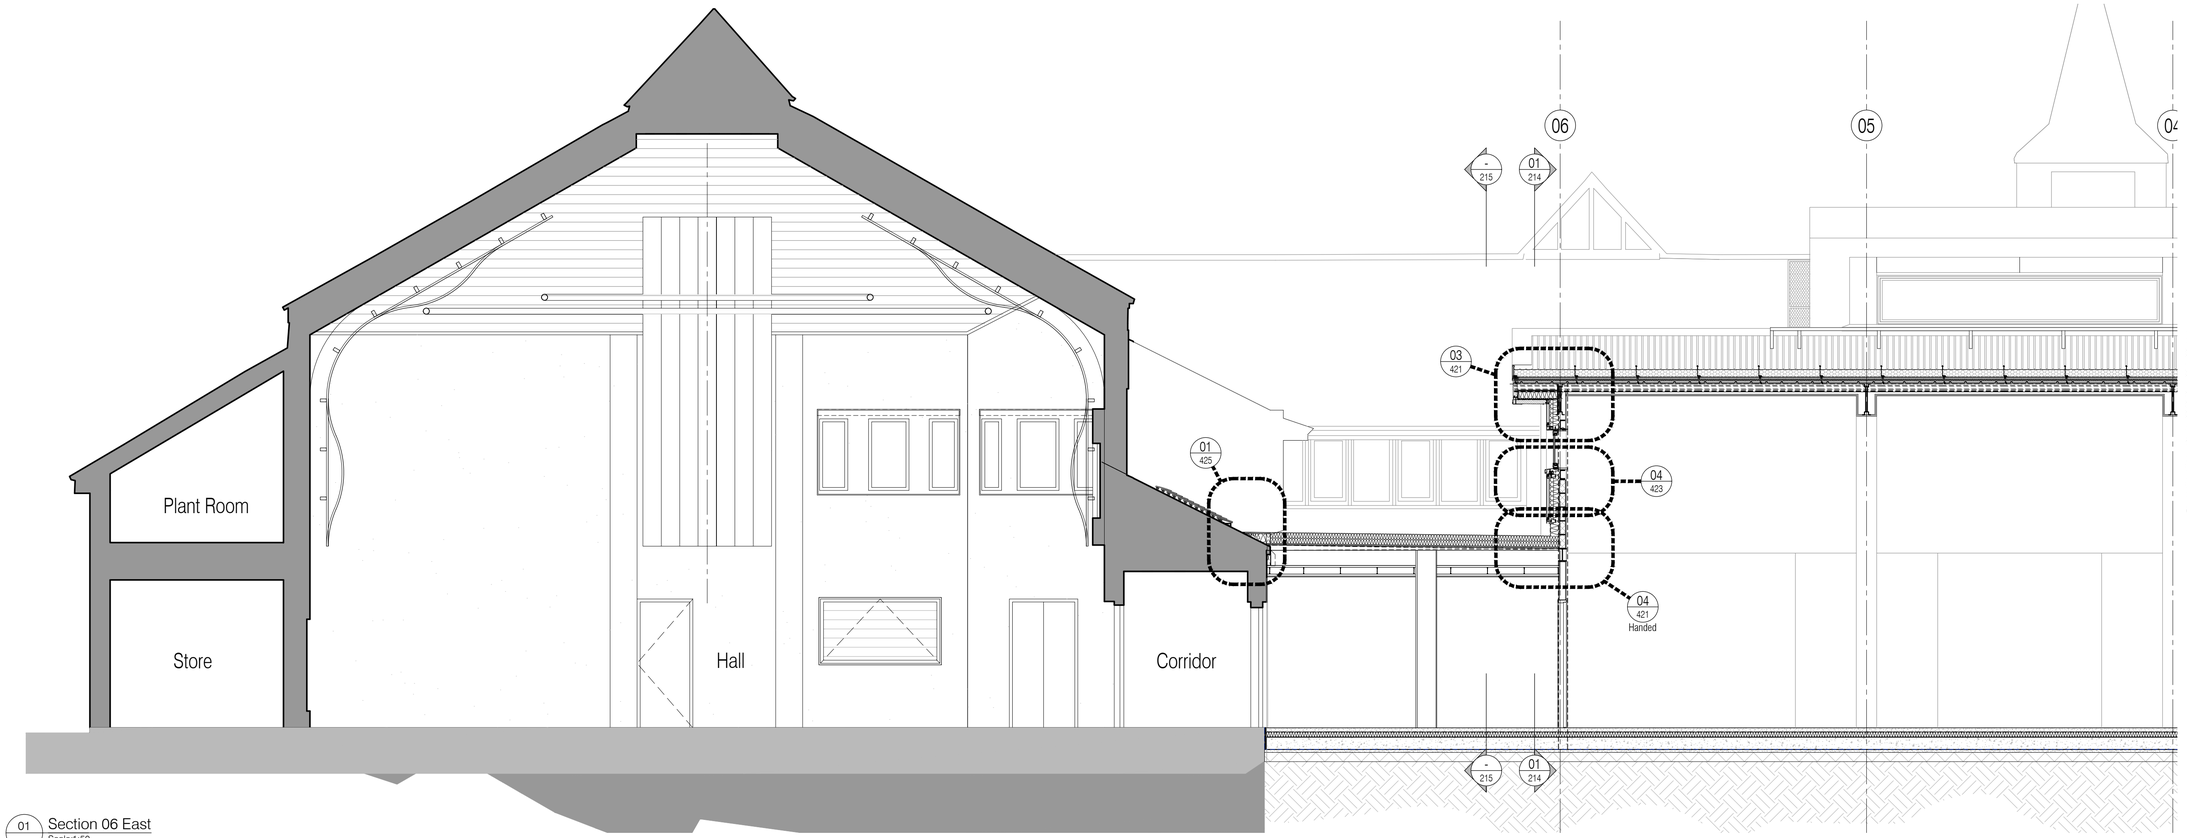

01 Section 06 East
Scale:1:50

For continuation, refer to: 224970-A-217- 02 below

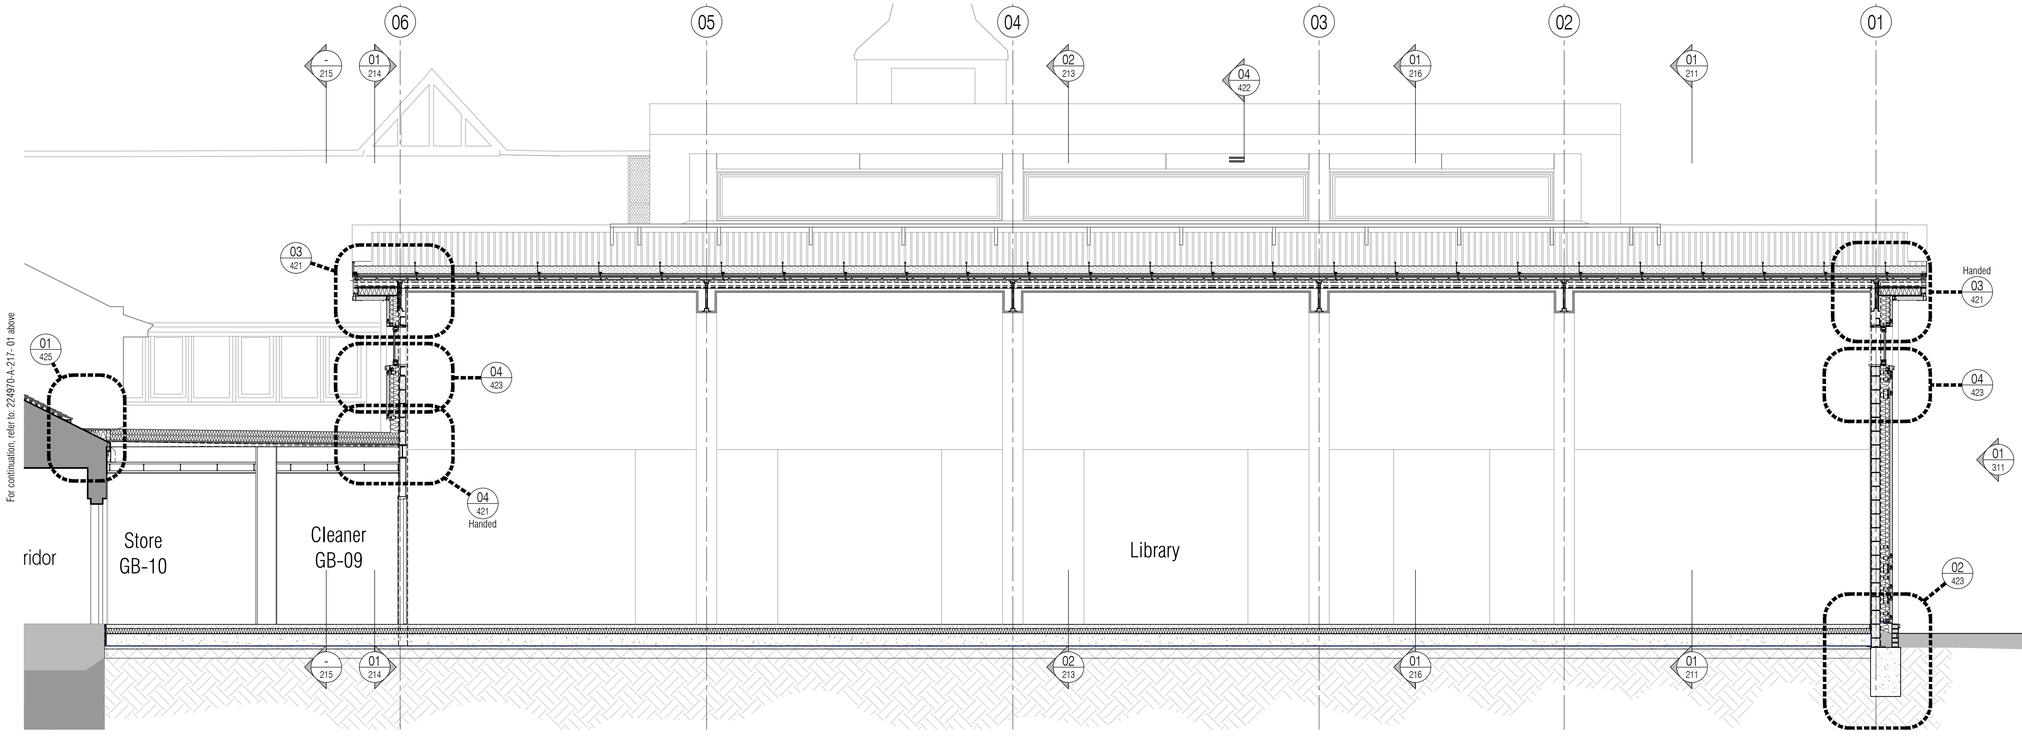


For continuation, refer to: 224970-A-217- 01 above

02 Section 06 West
Scale:1:50

NOTES: Do not scale this drawing. All dimensions to be checked on site prior to commencement or manufacture.

Key Plan
(nts)

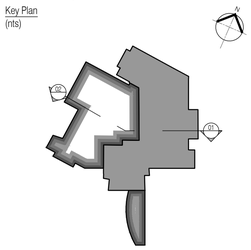

ISSUED FOR CONSTRUCTION

Rev	Date	By	Chk	Comment
C1	03.07.13	RKC	JAS	Issued for CONSTRUCTION

BRINGING IDEAS TO LIFE

FRANKHAM

Frankham Consultancy Group Limited
21 Perrymount Road
Haywards Heath RH16 3TP
t 01444 449000 f 01444 455642
enquire@frankham.com
www.frankham.com

Client
Ealing
www.ealing.gov.uk


Project Title
Dominion Arts Centre
Southall
London

Drawing Title
Proposed
Sections 06


Drawn by:	Scale:	Date:
RKC	1:50@A1	19.12.12
Designed by:	Checked by:	Approved by:
FCG	-	-

File Ref.: K:\2009\09224970 - LB EALING - DOMINION ARTS CENTRE\ARCH\2D_799_SECTIONS\224970-A-217.DWG - 20/06/2013 08:38:50


Drawing No.	Rev.
224970-A-217	C1

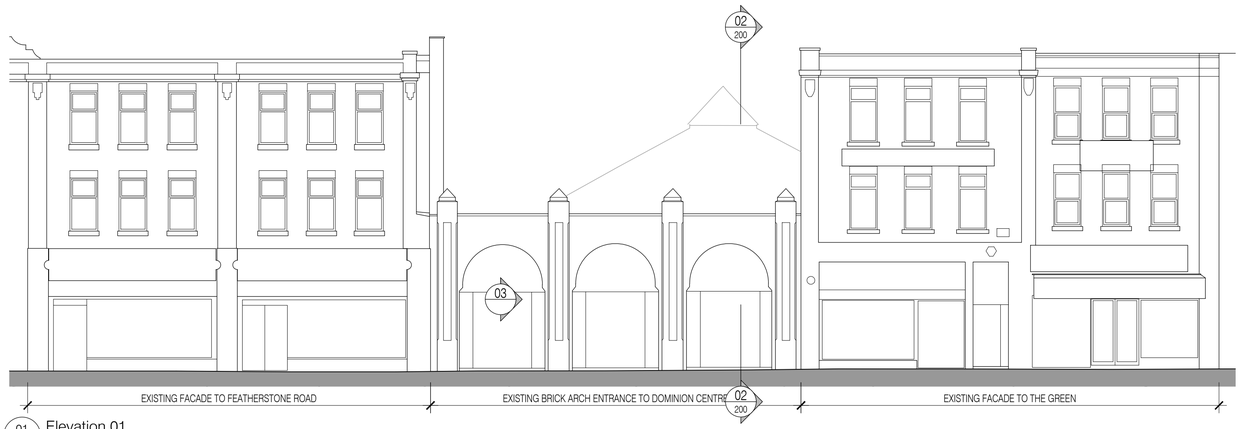

01 Elevation 01
Scale:1:100

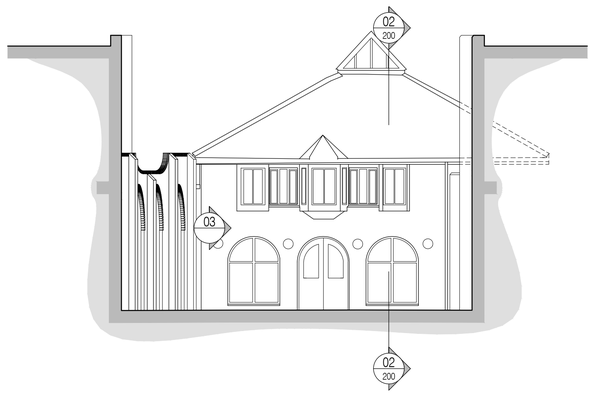


02 Elevation 02
Scale:1:100

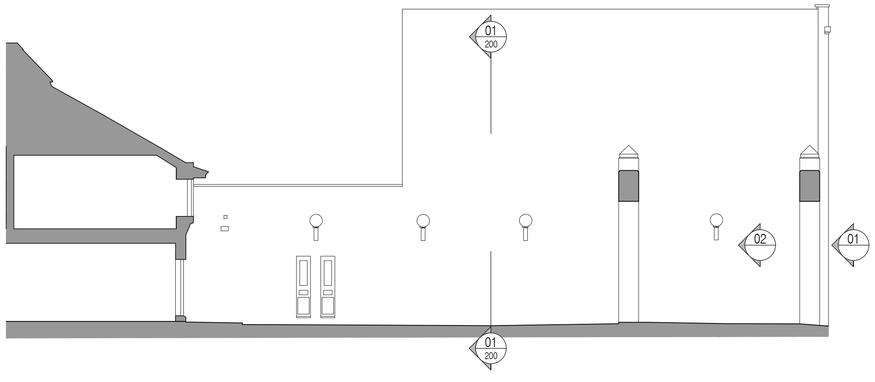


03 Section 03
Scale:1:100

NOTES: Do not scale this drawing. All dimensions to be checked on site prior to commencement or manufacture.

Key Plan
(nts)

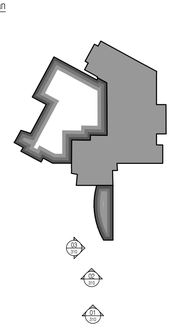

Scale Bar

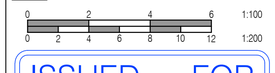

ISSUED FOR CONSTRUCTION

Rev	Date	By	Chk	Comment
C1	03.07.13	RKC	JAS	Issued for CONSTRUCTION

BRINGING IDEAS TO LIFE

FRANKHAM

Frankham Consultancy Group Limited
21 Perrymount Road
Haywards Heath RH16 3TP
t 01444 444900 f 01444 455642
enquire@frankham.com
www.frankham.com

Client
Ealing
www.ealing.gov.uk


Project Title
Dominion Arts Centre
Southall
London

Drawing Title
Existing
Elevations 01, 02 & 03

Drawn by:	Scale:	Date:
RKC	1:100@A1	19.12.12
Designed by:	Checked by:	Approved by:
FCG	-	-

File Ref.: X:\2000\224970 - EALING - DOMINION ARTS CENTRE\ARCH\2D_300_ELEVATIONS\ 224970-A-300.DWG - 2000:11:13:08:55


Drawing No.	Rev.
224970-A-300	C1

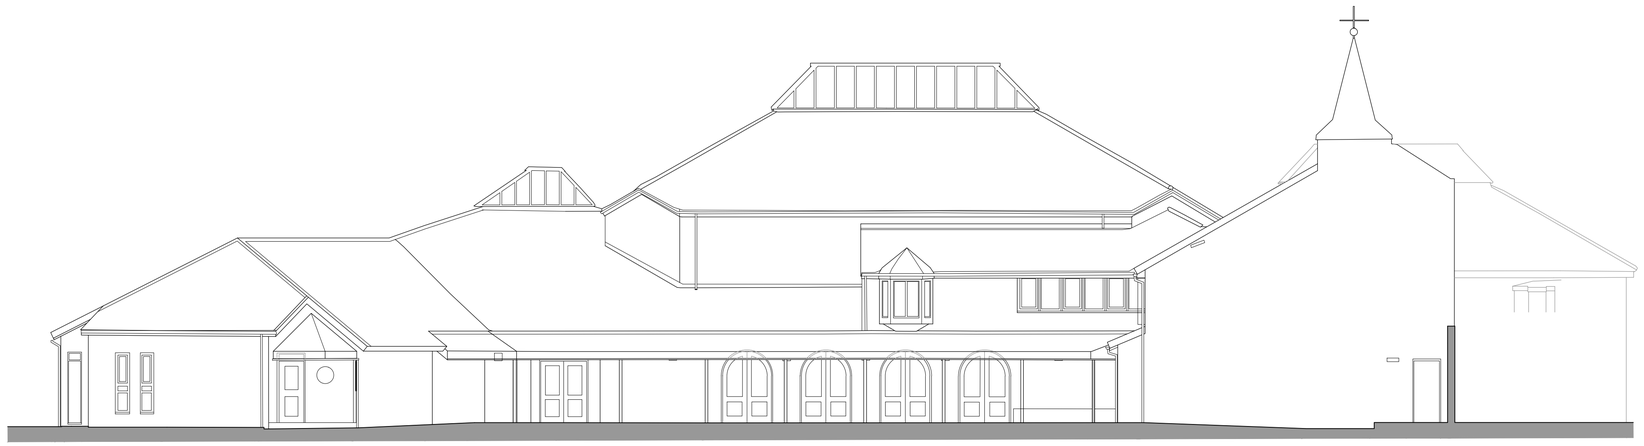

01 Elevation 04
Scale:1:100

NOTES: Do not scale this drawing. All dimensions to be checked on site prior to commencement or manufacture.

Key Plan
(nts)

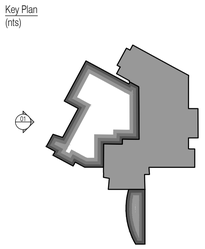

Scale Bar

0 2 4 6 1:100
0 2 4 6 8 10 12 1:200

ISSUED FOR CONSTRUCTION

Rev	Date	By	Chk	Comment
C1	03.07.13	RKC	JAS	Issued for CONSTRUCTION

BRINGING IDEAS TO LIFE

FRANKHAM

Frankham Consultancy Group Limited
21 Perrymount Road
Haywards Heath RH16 3TP
t 01444 444900 f 01444 455542
enquire@frankham.com
www.frankham.com

Client
Ealing
www.ealing.gov.uk

Project Title
Dominion Arts Centre
Southall
London

Drawing Title
Existing
Elevation 04


Drawn by:	Scale:	Date:
RKC	1:100@A1	19.04.13
Designed by:	Checked by:	Approved by:
FCG	-	-

File Ref.: X:\2008\224970 - EALING, DOMINION ARTS CENTRE\ARCH\DOC_DWG_ELEVATIONS-224970-A-301.DWG - 20/06/11 13:39:01


Drawing No. 224970-A-301
Rev. C1




01 Elevation 01
Scale:1:100

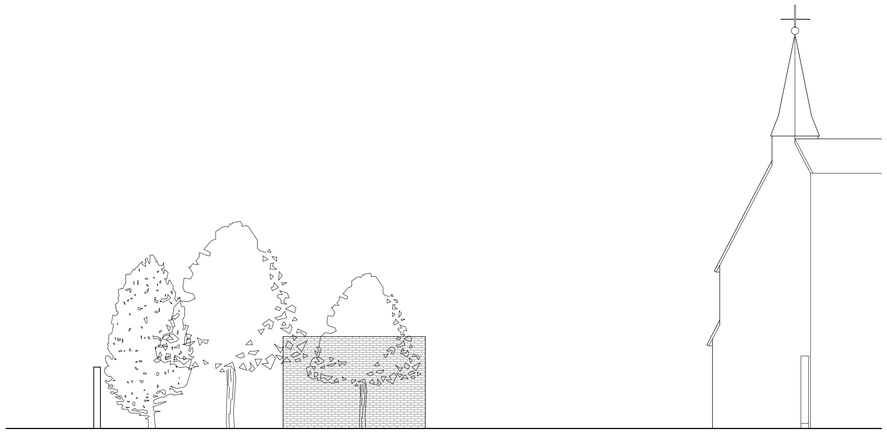

02 Elevation 02
Scale:1:100

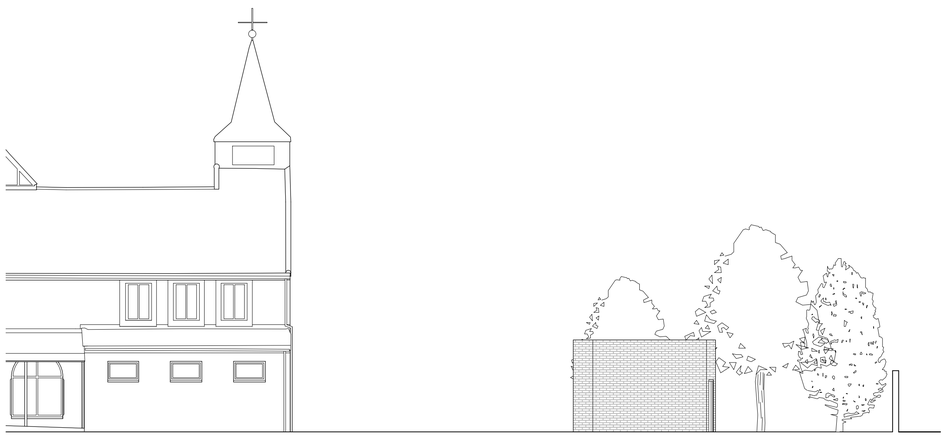


03 Elevation 03
Scale:1:100

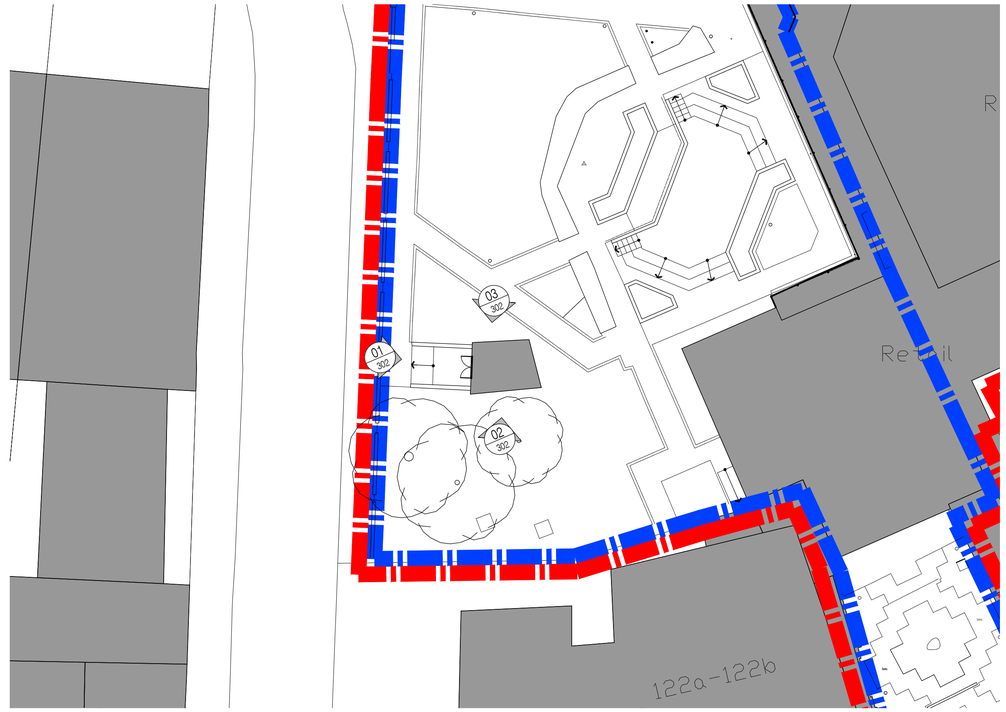

04 Key Plan
Scale:1:200

NOTES: Do not scale this drawing. All dimensions to be checked on site prior to commencement or manufacture.

Key Plan
(nts)

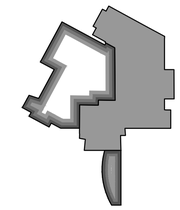

Scale Bar



ISSUED FOR TENDER

Rev	Date	By	Chk	Comment
T1	21.05.13	CH	AC	DRAWING ISSUED FOR TENDER

BRINGING IDEAS TO LIFE

FRANKHAM

Frankham Consultancy Group Limited
21 Perrymount Road
Haywards Heath RH16 3TP
t 01444 444900 f 01444 455542
enquire@frankham.com
www.frankham.com

Client
Ealing
www.ealing.gov.uk


Project Title
Dominion Arts Centre
Southall
London

Drawing Title
Existing
Substation Elevation

Drawn by:	Scale:	Date:
RKC	1:100@A1	21.05.13
Designed by:	Checked by:	Approved by:
FCG	-	-

File Ref.: X:\2008\224970 - EALING_DOMINION ARTS CENTRE\ARCH\302_099_ELEVATIONS-21405-A-302.DWG - 20081110906
20:06:11 13:39:07


Drawing No.	Rev.
224970-A-302	T1

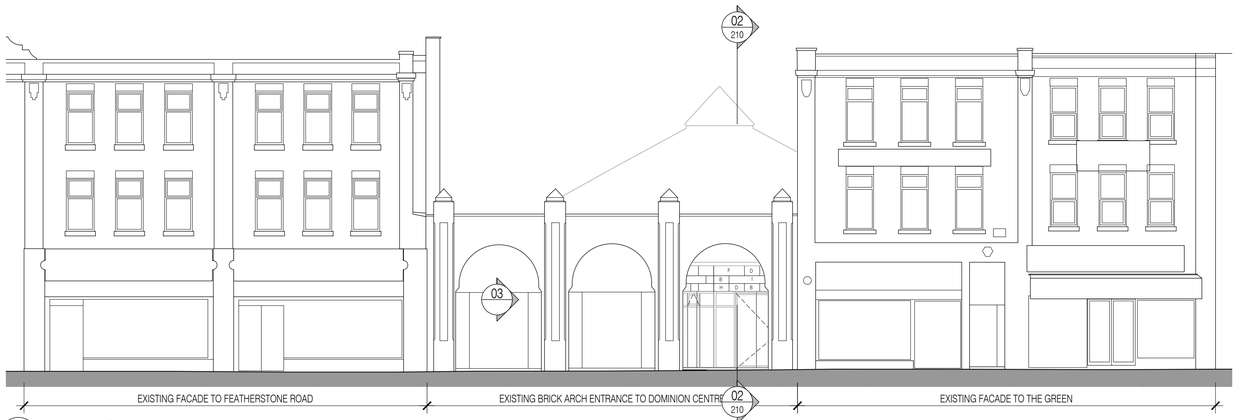

01 310 Elevation 01
Scale:1:100




02 310 Elevation 02
Scale:1:50

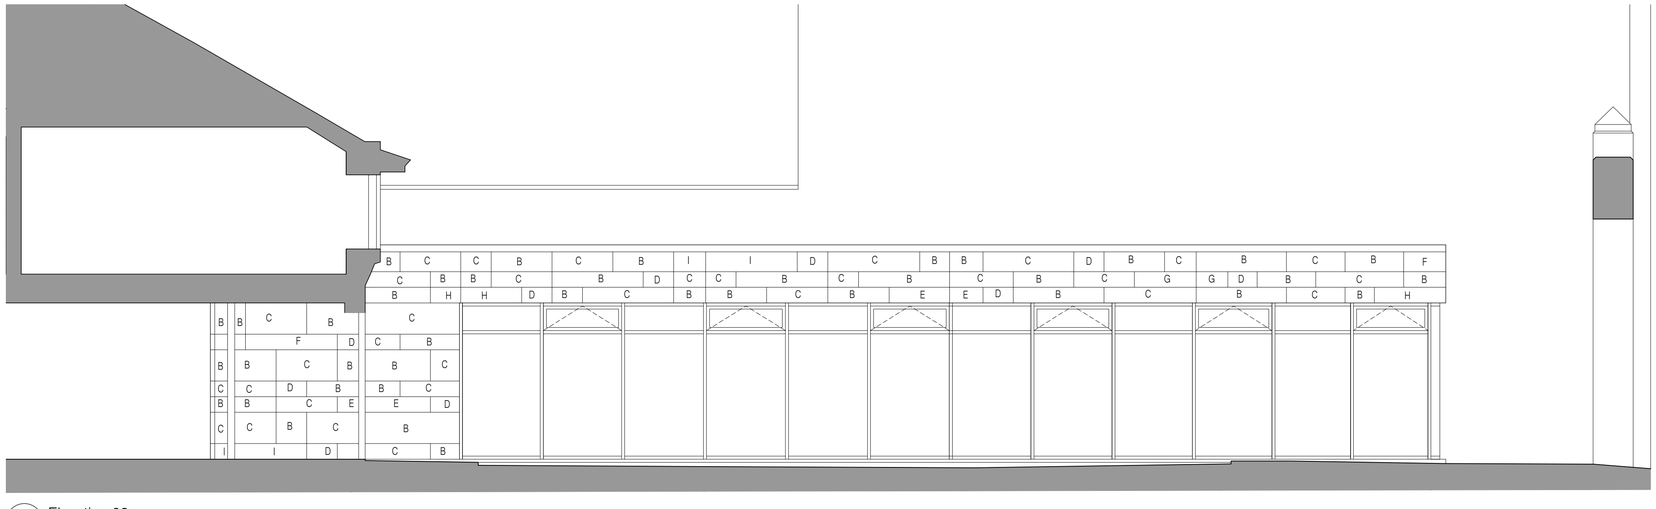

03 310 Elevation 03
Scale:1:50

NOTES: Do not scale this drawing. All dimensions to be checked on site prior to commencement or manufacture.


Key Plan
(nts)

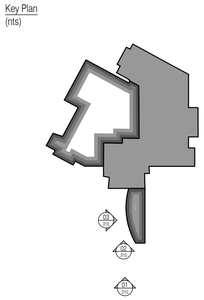

Cladding Legend

A	Denotes Anthracite Grey - Trespa_A25_8_1
B	Denotes Steel Grey - Trespa_A21_7_0
C	Denotes Mid Grey - Trespa_A21_5_1
D	Denotes Winter Grey - Trespa_A21_1_0
E	Denotes Lime Green - Trespa_A37_0_8
F	Denotes Royal Blue – Trespa A22_1_6
G	Cyclam – Trespa A17_3_5
H	Denotes Gold Yellow – Trespa A04_1_7
I	Denotes Red Orange – Trespa A10_1_8

Scale Bar

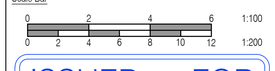

ISSUED FOR CONSTRUCTION

Rev	Date	By	Chk	Comment
C5	16.01.14	CH	AC	Window ref added
C4	27.11.13	CH	AC	Cladding setting out added
C3	25.11.13	CH	AC	Dims added
C2	24.10.13	CH	AC	Elevations updated
C1	03.07.13	RKC	JAS	Issued for CONSTRUCTION

BRINGING IDEAS TO LIFE

FRANKHAM

Frankham Consultancy Group Limited
21 Perrymount Road
Haywards Heath RH16 3TP
t 01444 444900 f 01444 455642
enquire@frankham.com
www.frankham.com

Client
Ealing
www.ealing.gov.uk


Project Title
Dominion Arts Centre
Southall
London

Drawing Title
Proposed
Elevations 01, 02 & 03


Drawn by:	Scale:	Date:
RKC	1:50 & 100@A1	19.12.12
Designed by:	Checked by:	Approved by:
FCG	-	-

File Ref.: I:\2008\02\24970 - LEALING - DOMINION ARTS CENTRE\ARCH\DWG_SRB_ELEVATIONS\224970-A-310.DWG - 20/06/2011 13:39:12


Drawing No. 224970-A-310
Rev. C5

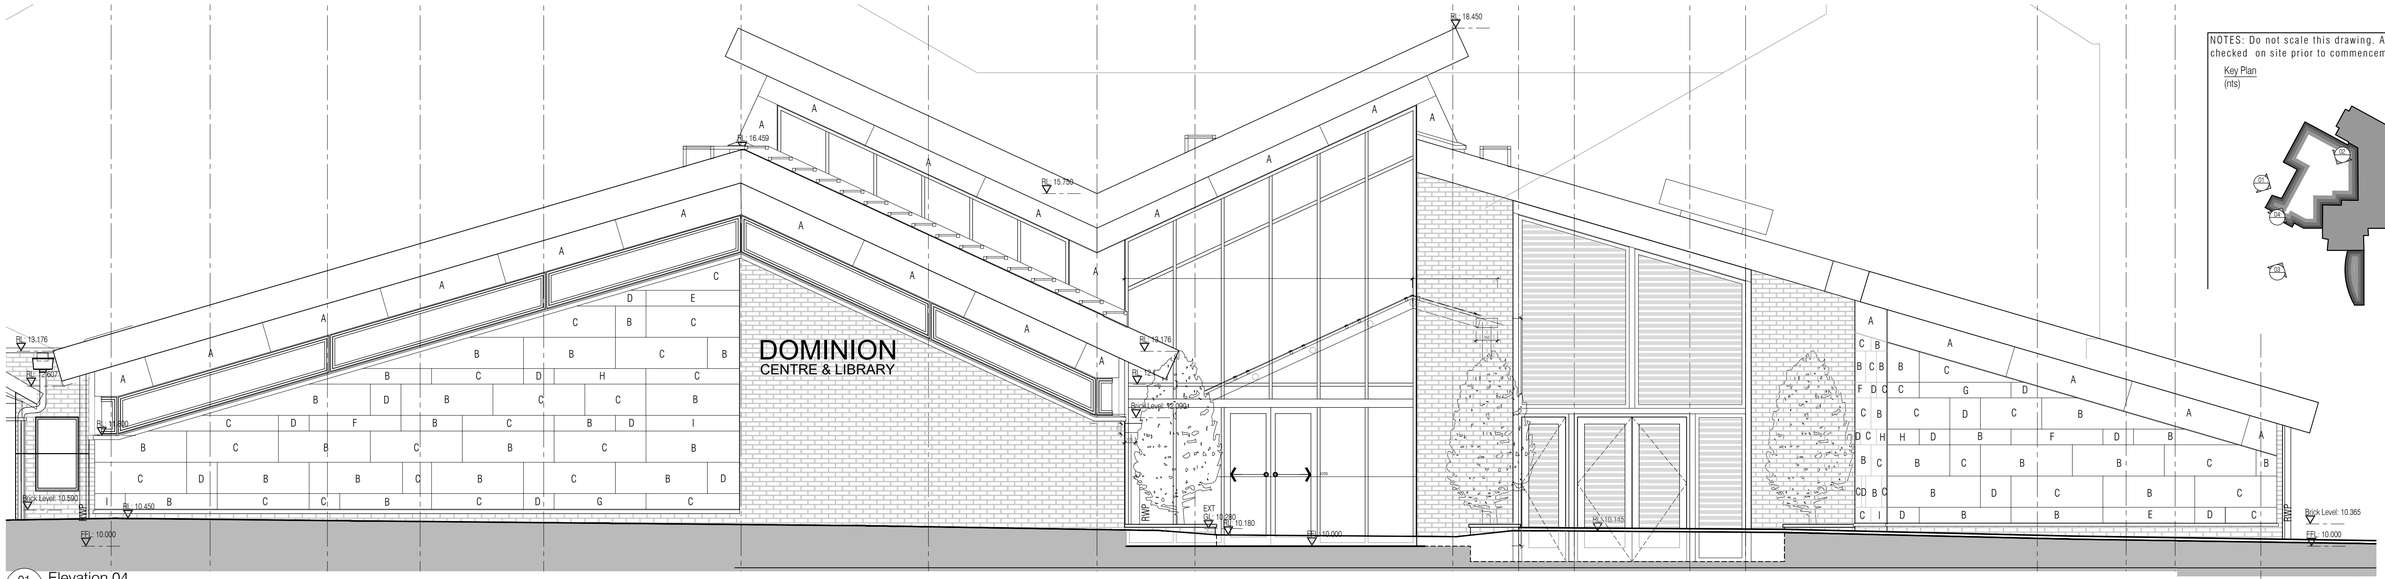


01 Elevation 04
Scale:1:50

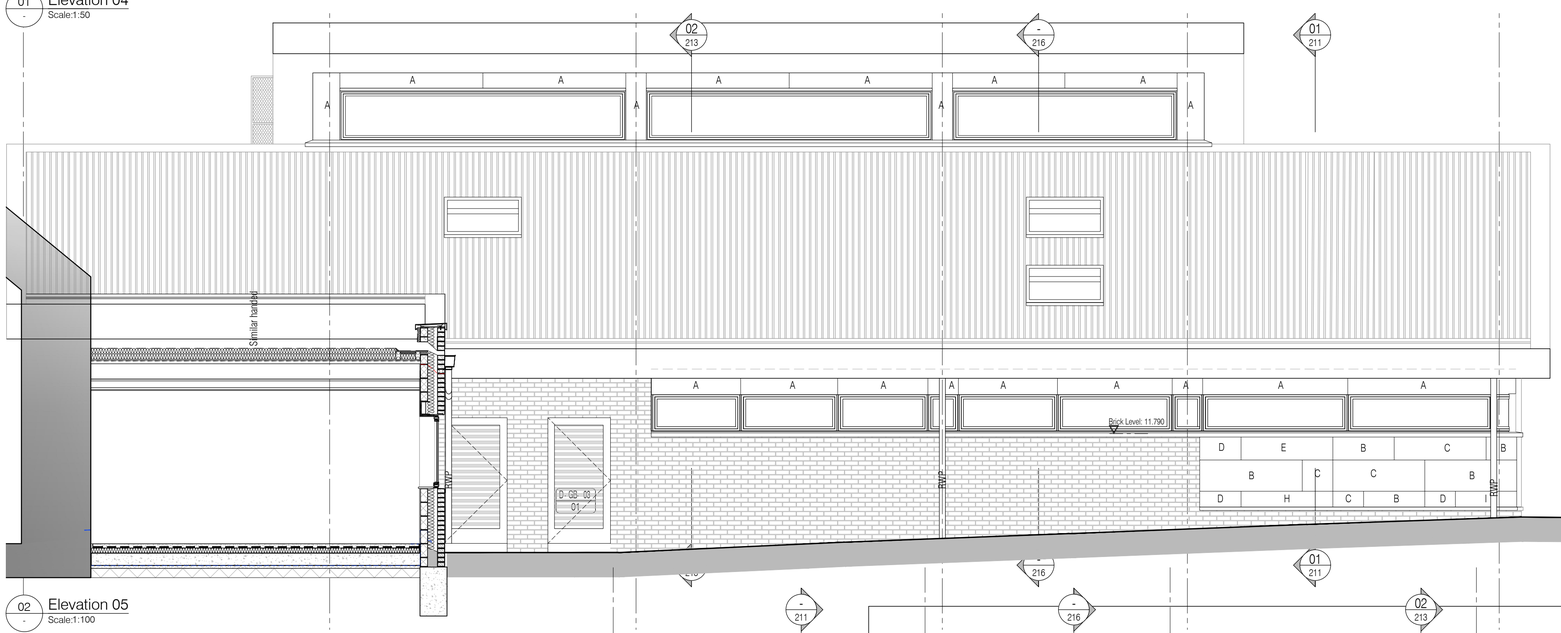

02 Elevation 05
Scale:1:100

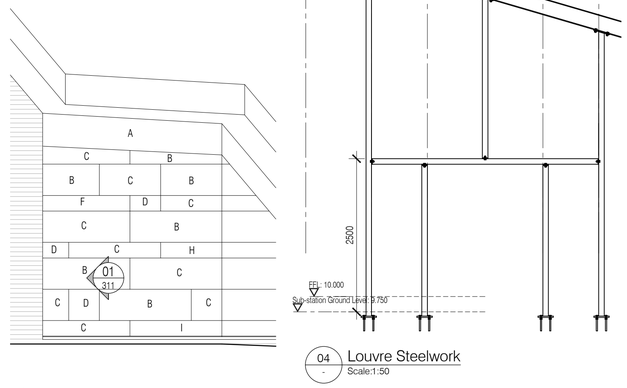

04 Louvre Steelwork
Scale:1:50

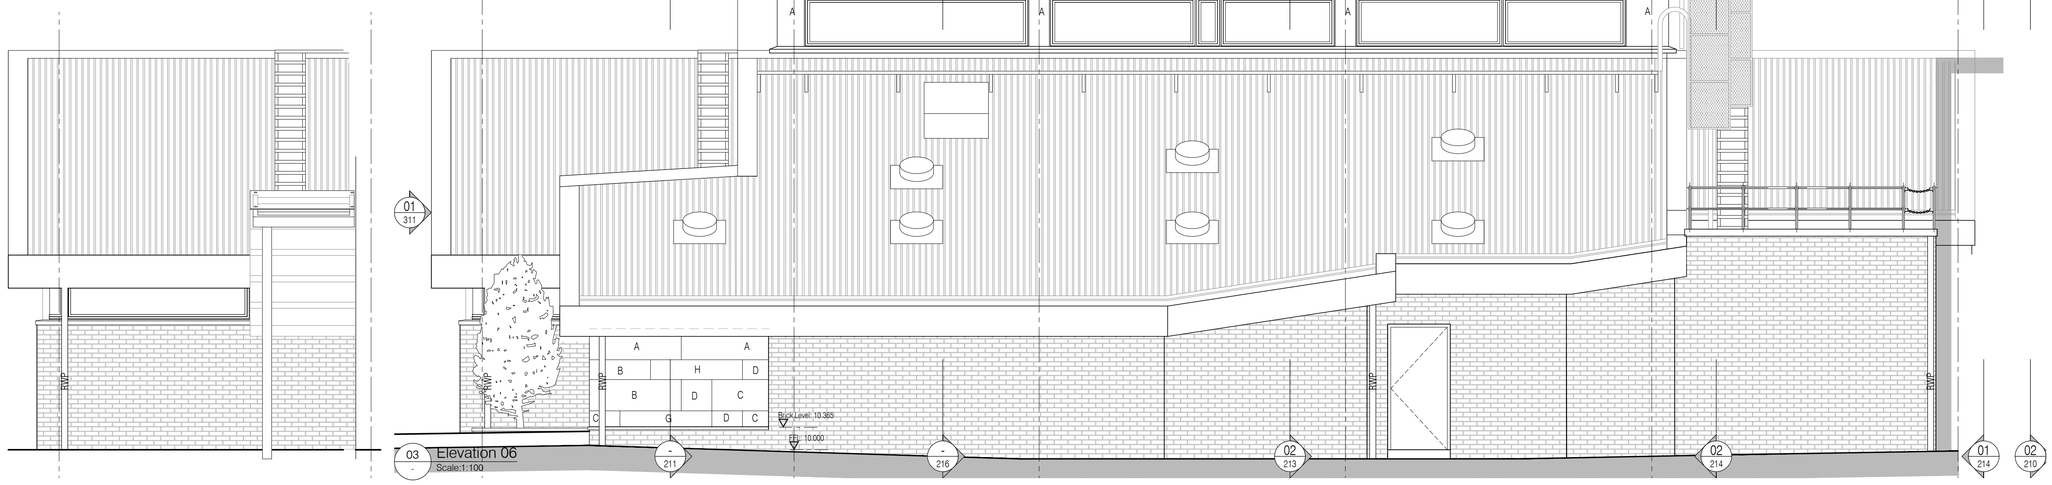


04 Elevation 07
Scale:1:50

03 Elevation 06
Scale:1:100

NOTES: Do not scale this drawing. All dimensions to be checked on site prior to commencement or manufacture.

Key Plan
(nts)

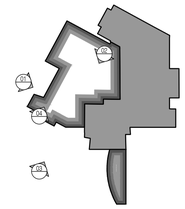

Cladding Legend

A	Denotes Anthracite Grey - Trespa_A25_8_1
B	Denotes Steel Grey - Trespa_A21_7_0
C	Denotes Mid Grey - Trespa_A21_5_1
D	Denotes Winter Grey - Trespa_A21_1_0
E	Denotes Lime Green - Trespa_A37_0_8
F	Denotes Royal Blue – Trespa A22_1_6
G	Cyclam – Trespa A17_3_5
H	Denotes Gold Yellow – Trespa A04_1_7
I	Denotes Red Orange – Trespa A10_1_8

ISSUED FOR CONSTRUCTION

Rev	Date	By	Chk	Comment
C8	24.04.14	CH	AC	Roof cowl added
C7	16.01.14	CH	AC	Window ref added
C6	19.12.13	CH	AC	Louvres adjusted
C5	28.11.13	CH	AC	Levels added
C4	27.11.13	CH	AC	Cladding setting out added
C3	25.11.13	CH	AC	Dims added
C2	24.10.13	CH	AC	Elevations updated
C1	03.07.13	RKC	JAS	Issued for CONSTRUCTION

BRINGING IDEAS TO LIFE

FRANKHAM

Frankham Consultancy Group Limited
21 Perrymount Road
Haywards Heath RH16 3TP
t 01444 444900 f 01444 455642
enquire@frankham.com
www.frankham.com

Client
Ealing
www.ealing.gov.uk

Project Title
Dominion Arts Centre
Southall
London


Drawing Title
Proposed
Elevations 04, 05, 06 & 07

Drawn by:	Scale:	Date:
RKC	1:100@A1	19.12.12
Designed by:	Checked by:	Approved by:
FCG	-	-


File Ref.: X:\2008\224970 - LEALNL - DOMINION ARTS CENTRE\ARCH\DB_BIM_ELEVATIONS-2V2015-A-311.DWG - 20061113

20:06:11 13:39:28

Drawing No.	Rev.
224970-A-311	C8

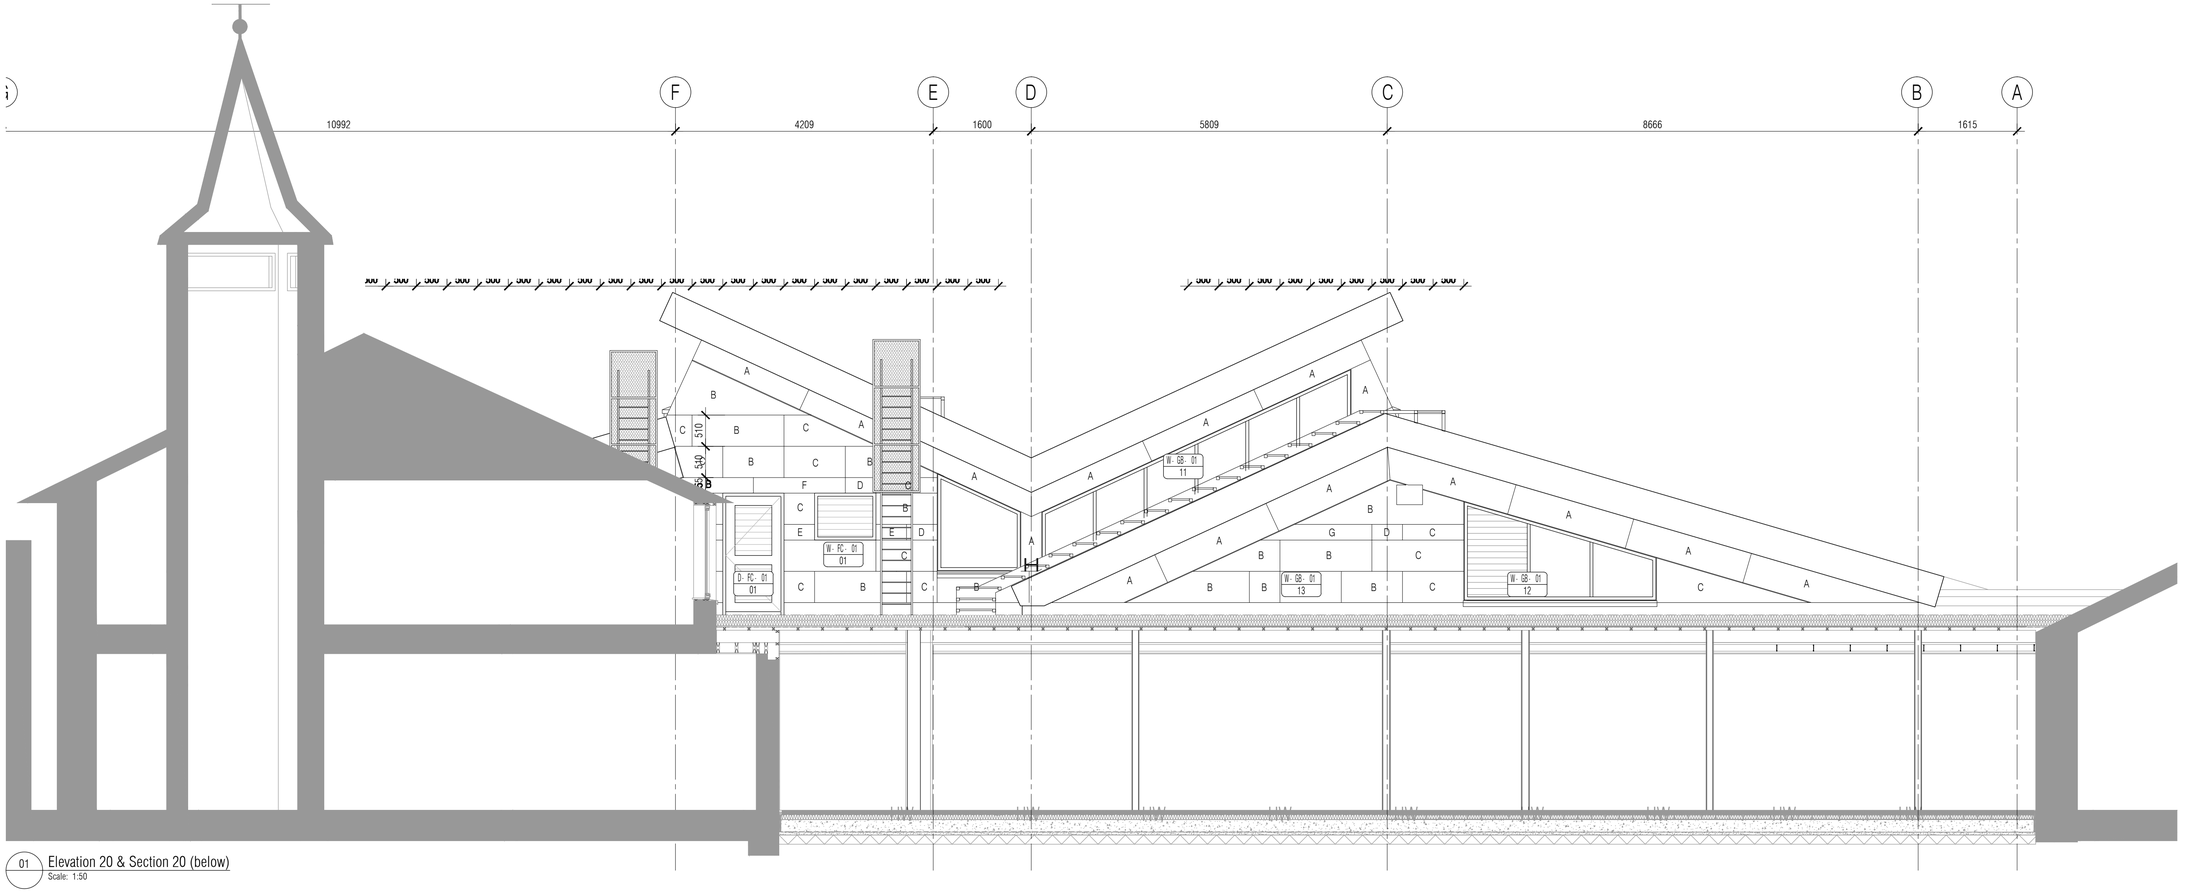


01 Elevation 20 & Section 20 (below)
Scale: 1:50

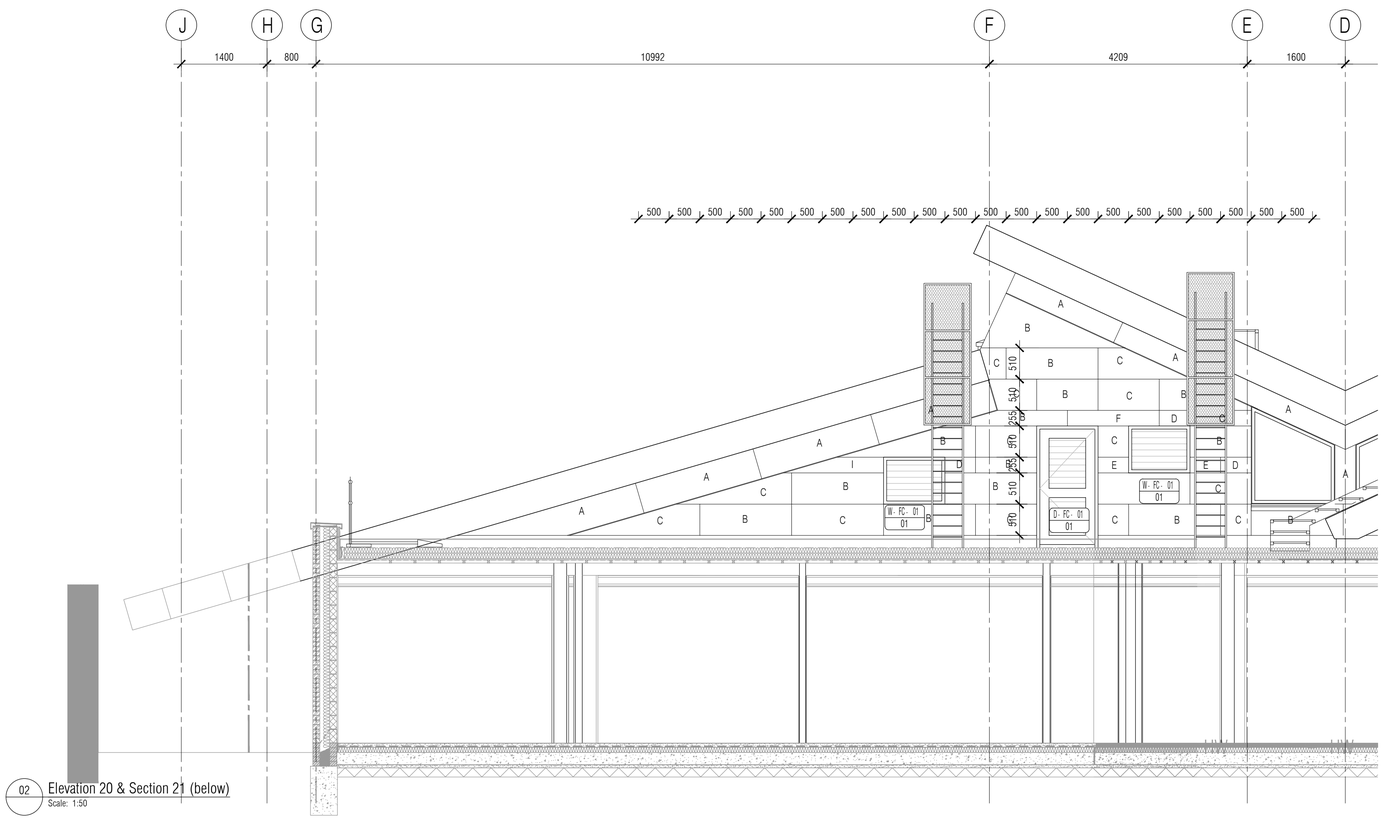

02 Elevation 20 & Section 21 (below)
Scale: 1:50

NOTES: Do not scale this drawing. All dimensions to be checked on site prior to commencement or manufacture.

Key Plan
(nts)

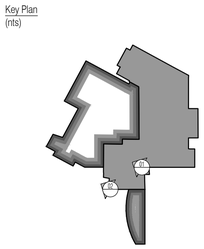

Cladding Legend

A	Denotes Anthracite Grey - Trespa_A25_8_1
B	Denotes Steel Grey - Trespa_A21_7_0
C	Denotes Mid Grey - Trespa_A21_5_1
D	Denotes Winter Grey - Trespa_A21_1_0
E	Denotes Lime Green - Trespa_A37_0_8
F	Denotes Royal Blue – Trespa A22_1_6
G	Cyclam – Trespa A17_3_5
H	Denotes Gold Yellow – Trespa A04_1_7
I	Denotes Red Orange – Trespa A10_1_8

ISSUED FOR CONSTRUCTION

Rev	Date	By	Chk	Comment
C6	16.01.14	CH	AC	Window ref added
C5	27.11.13	CH	AC	Cladding setting out added
C4	25.11.13	CH	AC	Dims added
C3	24.10.13	CH	AC	Elevations updated
C2	21.10.13	CH	AC	Issued for CONSTRUCTION
C1	03.07.13	RKC	JAS	Issued for CONSTRUCTION

BRINGING IDEAS TO LIFE

FRANKHAM

Frankham Consultancy Group Limited
21 Perrymount Road
Haywards Heath RH16 3TP
t 01444 444900 f 01444 455642
enquire@frankham.com
www.frankham.com

Client
Ealing
www.ealing.gov.uk


Project Title
Dominion Arts Centre
Southall
London

Drawing Title
Proposed
Elevation 20
with Sections 20 & 21 below


Drawn by:	Scale:	Date:
RKC	1:50@A1	19.12.12
Designed by:	Checked by:	Approved by:
FCG	-	-

File Ref.: K:\2000\224970 - LEALNL - DOMINION ARTS CENTRE\ARCH\200_999_DJ\ARTDW\224970-A-312.DWG - 20081113559 20:06:11 13:39:41


Drawing No. 224970-A-312
Rev. C6

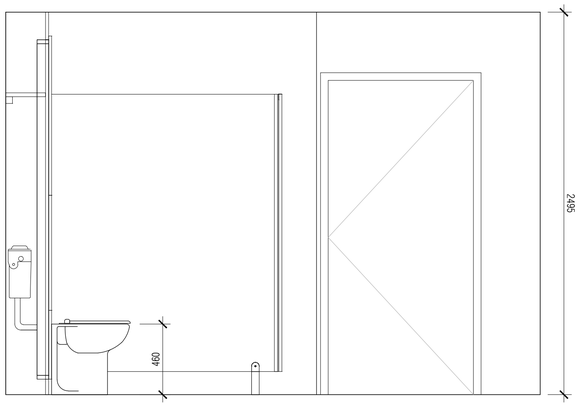


01 Elevation 01
Scale: 1:20@A1

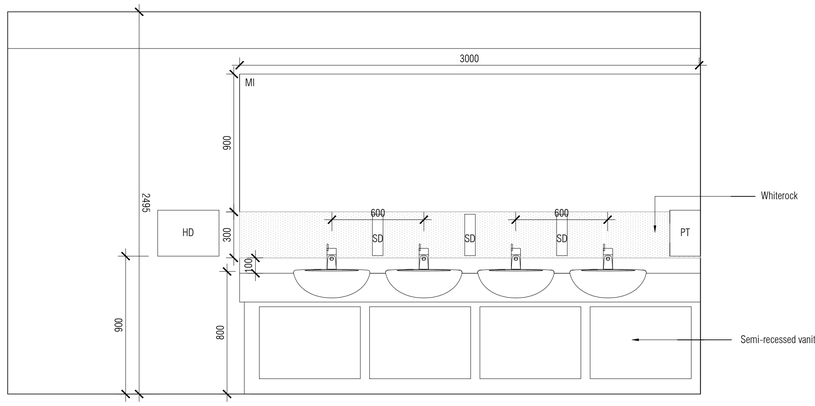


01 Elevation 02
Scale: 1:20@A1

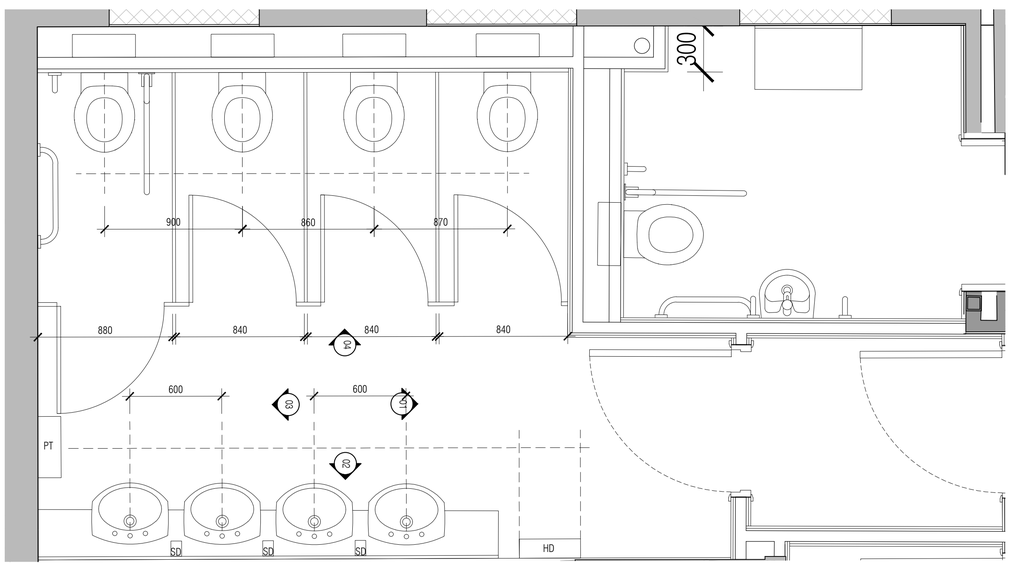

01 Floor Plan
Scale: 1:20@A1

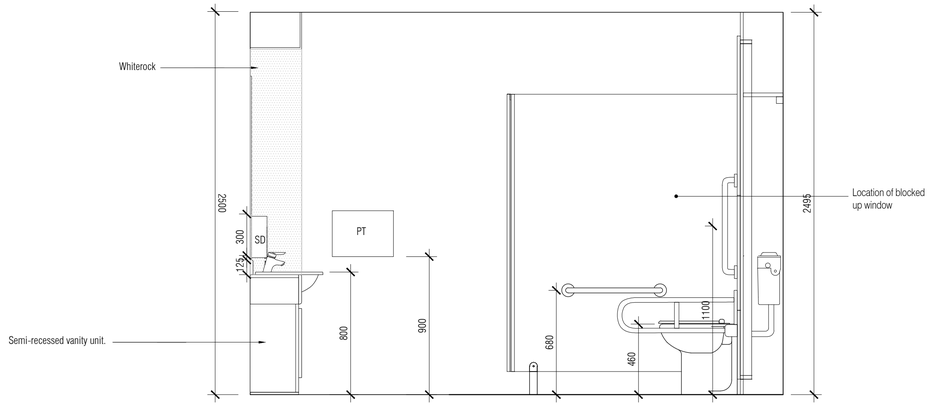


01 Elevation 03
Scale: 1:20@A1

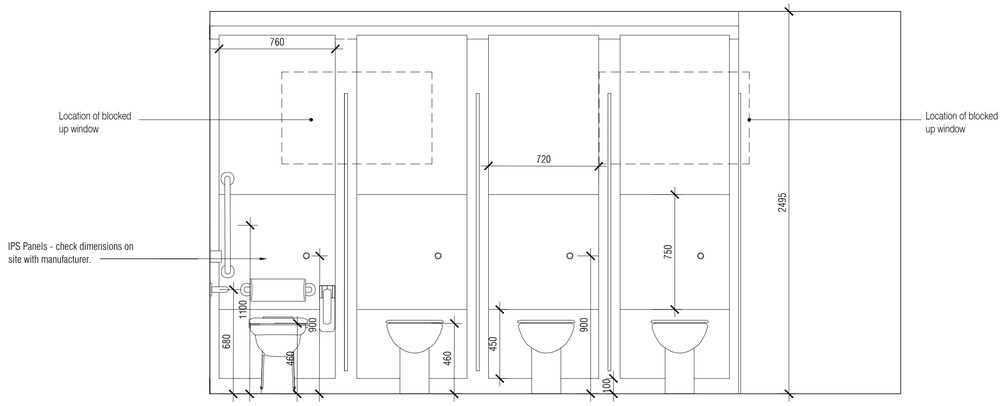

01 Elevation 04
Scale: 1:20@A1

NOTES: Do not scale this drawing. All dimensions to be checked on site prior to commencement or manufacture.

Key Plan
(nts)

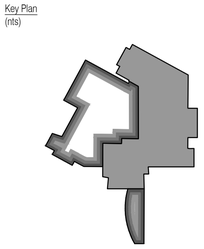

Key

HD - Hand drier. Refer to the specification section N13 clause 472A

SD - Soap dispenser. Refer to the specification section N13 clause 458

PT - Paper towel dispenser. Refer to the specification section N13 clause 442

TP - Toilet paper holder. Refer to the specification section N13 clause 462

MR - For mirror refer to spec. section N13 clause 188A

AR - Alarm reset button

CH - Coat hook

TF - Toilet Flush

For WC Pan and cistern make and model refer to spec. section N13 clause 300A

For unisex corner WC equipment package refer to spec. section N13 clause 311A

For unisex ambulent package refer to spec. section N13 clause 312A

For urinal type refer to spec. section N13 clause 315A

For wash basin refer to spec. section N13 clause 335A

For Doc. M shower room pack refer to spec.

ISSUED FOR CONSTRUCTION

Rev	Date	By	Chk	Comment
C1	30.10.13	MLE	CH	Construction Issue

BRINGING IDEAS TO LIFE

FRANKHAM

Frankham Consultancy Group Limited
21 Perrymount Road
Haywards Heath RH16 3TP
t 01444 444900 f 01444 455642
enquire@frankham.com
www.frankham.com

Client
Ealing
www.ealing.gov.uk


Project Title
Dominion Arts Centre
Southall
London

Drawing Title
Proposed Room Elevation
Female WC GA-01


Drawn by:	Scale:	Date:
RKC	1:20@A1	05/02/13
Designed by:	Checked by:	Approved by:
FCG	-	-

File Ref.: X:\2008\224970 - LB EALING - DOMINION ARTS CENTRE\ARCH\DOC_MM_ELEVATIONS_224970-A-320.DWG - 20061132848 20.06.11 13:39:50


Drawing No.	Rev.
224970-A-320	C1

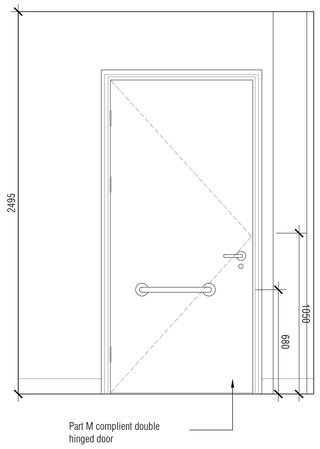


01 Elevation 01
Scale: 1:20@A1

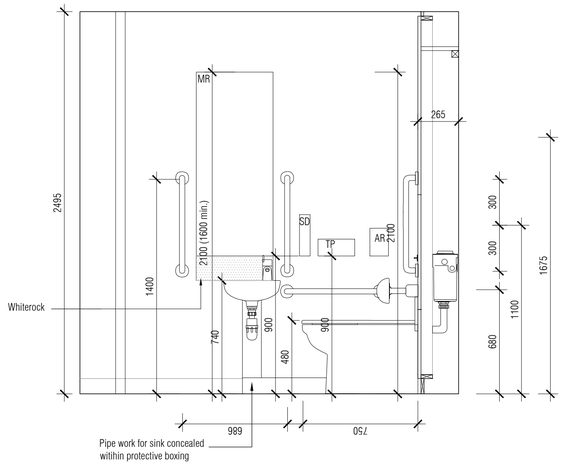


02 Elevation 02
Scale: 1:20@A1

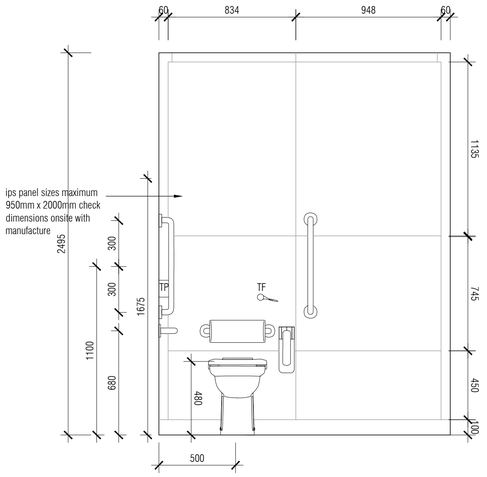

03 Elevation 03
Scale: 1:20@A1

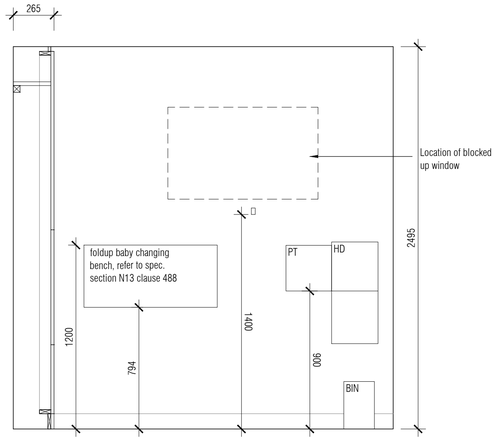


04 Elevation 04
Scale: 1:20@A1

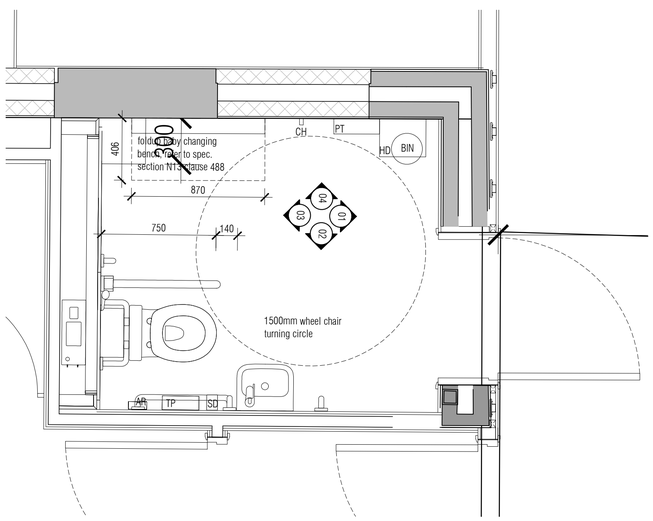

05 Floor Plan
Scale: 1:20@A1

NOTES: Do not scale this drawing. All dimensions to be checked on site prior to commencement or manufacture.

Key Plan
(nts)

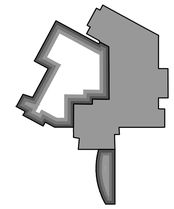

Key

HD - Hand drier. Refer to the specification section N13 clause 472A

SD - Soap dispenser. Refer to the specification section N13 clause 456

PT - Paper towel dispenser. Refer to the specification section N13 clause 442

TP - Toilet paper holder. Refer to the specification section N13 clause 462

MR - For mirror refer to spec. section N13 clause 188A

AR - Alarm reset button

CH - Coat hook

TF - Toilet Flush

For unisex corner WC equipment package refer to spec. section N13 clause 311A

For Doc. M shower room pack refer to spec.

Disabled toilet complient with Part M Doc.

ISSUED FOR CONSTRUCTION

Rev	Date	By	Chk	Comment
C2	15.07.13	PR	AC	CONSTRUCTION ISSUE

BRINGING IDEAS TO LIFE

FRANKHAM

Frankham Consultancy Group Limited
21 Perrymount Road
Haywards Heath RH16 3TP
t 01444 444900 f 01444 455642
enquire@frankham.com
www.frankham.com

Client
Ealing
www.ealing.gov.uk


Project Title
Dominion Arts Centre
Southall
London

Drawing Title
Proposed Room Elevation
Disabled WC
Room GA-02


Drawn by:	Scale:	Date:
RKC	1:20@A1	15.07.13
Designed by:	Checked by:	Approved by:
FCG	AC	AC

File Ref.: X:\2008\224970 - LB EALING - DOMINION ARTS CENTRE\ARCH\DOC_SRV_ELEVATIONS\224970-A-321.DWG - 20081104 20.08.11 13:40:01


Drawing No. 224970-A-321
Rev. C2

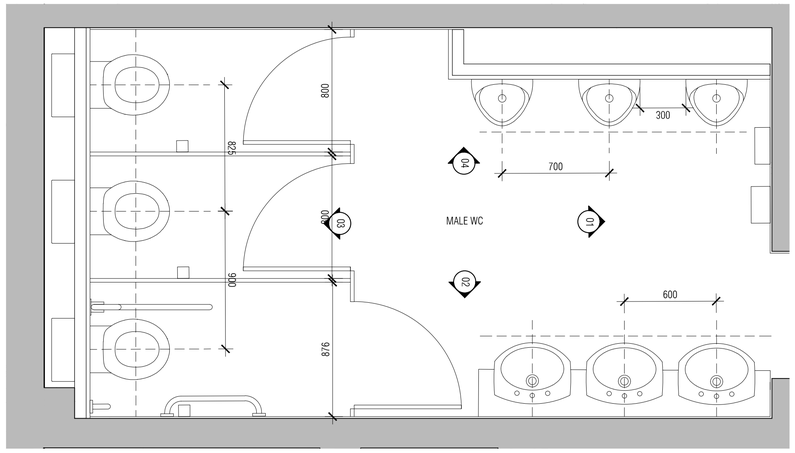


01 Floor Plan
Scale: 1:20@A1

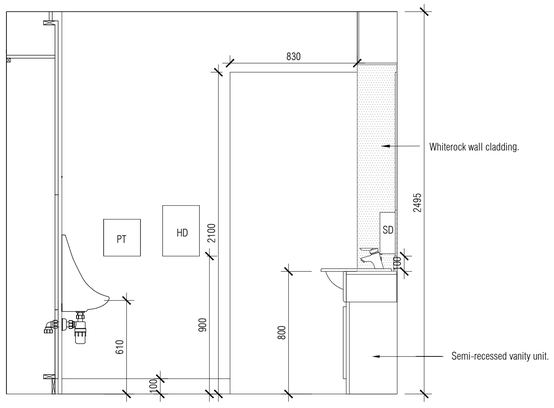


02 Elevation 01
Scale: 1:20@A1

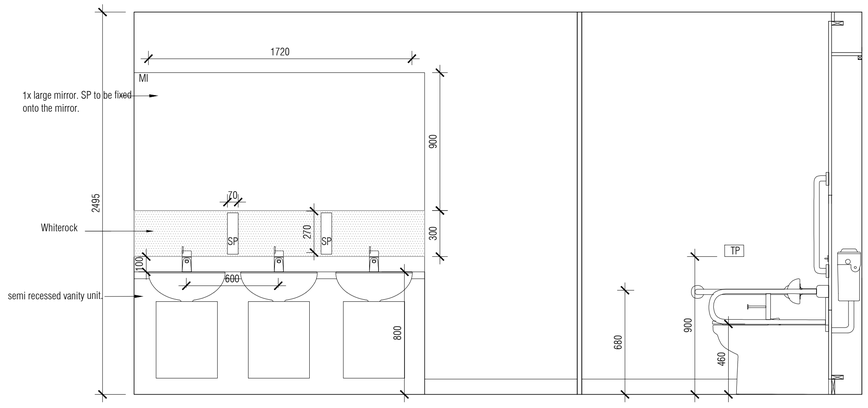

03 Elevation 02
Scale: 1:20@A1

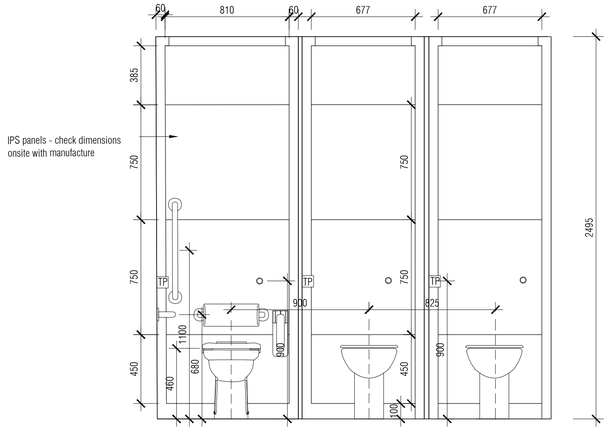


04 Elevation 03
Scale: 1:20@A1

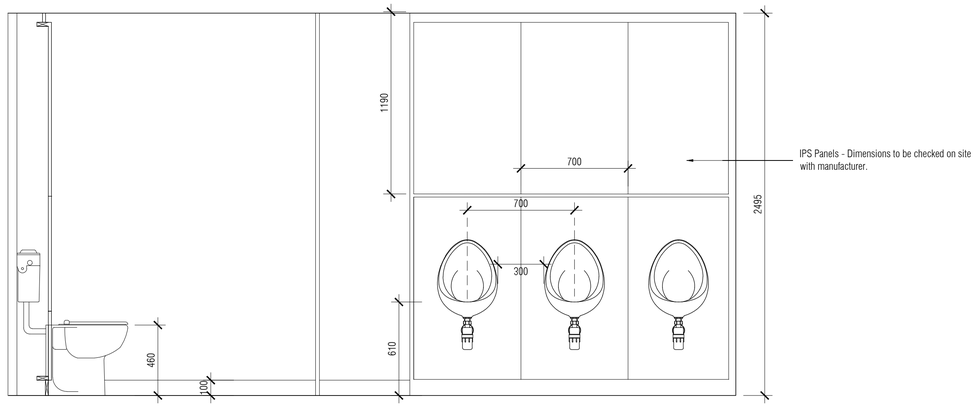

05 Elevation 04
Scale: 1:20@A1

NOTES: Do not scale this drawing. All dimensions to be checked on site prior to commencement or manufacture.

Key Plan
(nts)

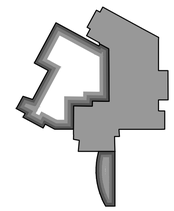

Key

HD - Hand drier. Refer to the specification section N13 clause 472A

SD - Soap dispenser. Refer to the specification section N13 clause 458

PT - Paper towel dispenser. Refer to the specification section N13 clause 442

TP - Toilet paper holder. Refer to the specification section N13 clause 462

MR - For mirror refer to spec. section N13 clause 188A

AR - Alarm reset button

CH - Coat hook

TF - Toilet Flush

For WC Pan and cistern make and model refer to spec. section N13 clause 300A

For unisex corner WC equipment package refer to spec. section N13 clause 311A

For unisex ambulent package refer to spec. section N13 clause 312A

For urinal type refer to spec. section N13 clause 315A

For wash basin refer to spec. section N13 clause 335A

For Doc. M shower room pack refer to spec.

ISSUED FOR CONSTRUCTION

Rev	Date	By	Chk	Comment
C2	30.10.13	MLE	CH	Construction Issue

BRINGING IDEAS TO LIFE

FRANKHAM

Frankham Consultancy Group Limited
21 Perrymount Road
Haywards Heath RH16 3TP
t 01444 444900 f 01444 455642
enquire@frankham.com
www.frankham.com

Client
Ealing
www.ealing.gov.uk


Project Title
Dominion Arts Centre
Southall
London

Drawing Title
Proposed Room Elevation
Male WC GA03


Drawn by:	Scale:	Date:
RKC	1:20@A1	05/02/13
Designed by:	Checked by:	Approved by:
FCG	-	-

File Ref.: K:\2000\224970 - EALING - DOMINION ARTS CENTRE\ARCH\DWG_SRF_ELEVATIONS\224970-A-322.DWG - 30/09/13 08:07 20:06:11:13:40:08


Drawing No. 224970-A-322 Rev. C2

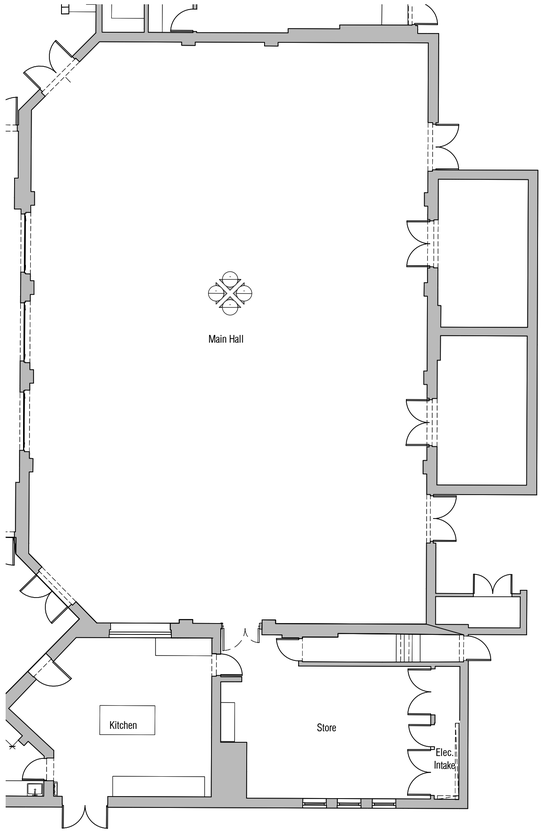


01 Floor Plan
Scale: 1:100@A1

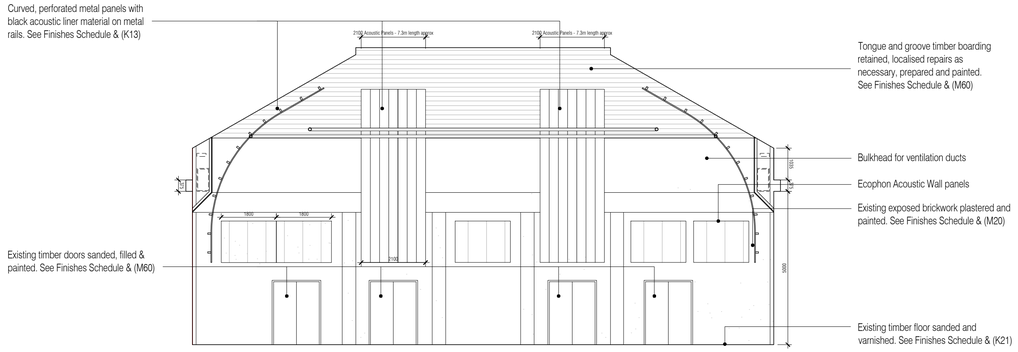


02 Elevation 01
Scale: 1:100@A1

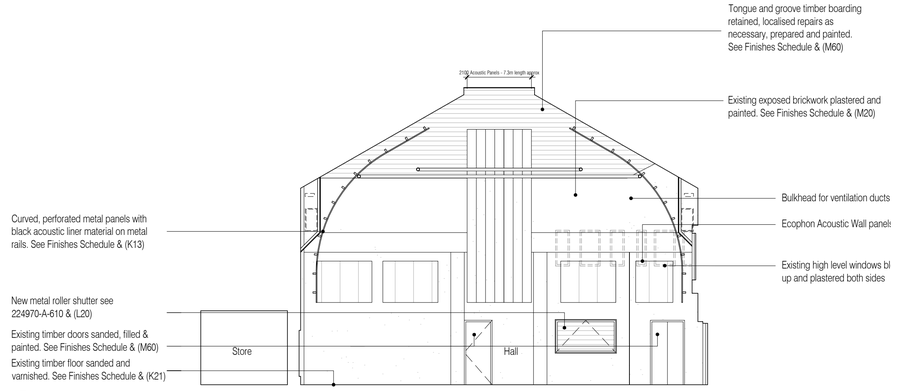

03 Elevation 02
Scale: 1:100@A1

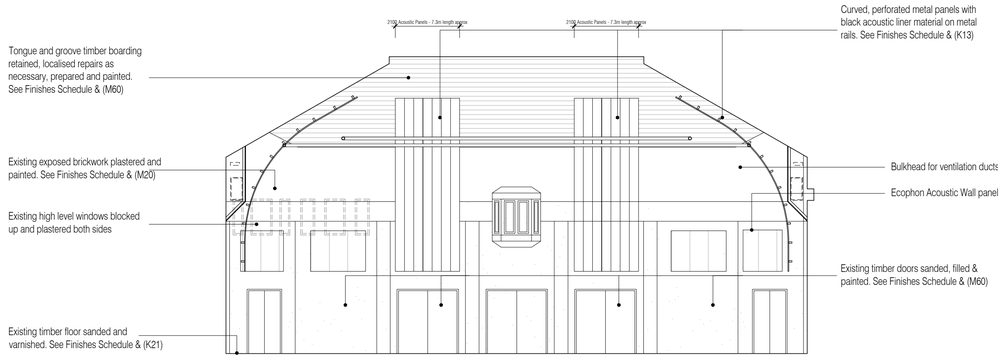


04 Elevation 03
Scale: 1:100@A1

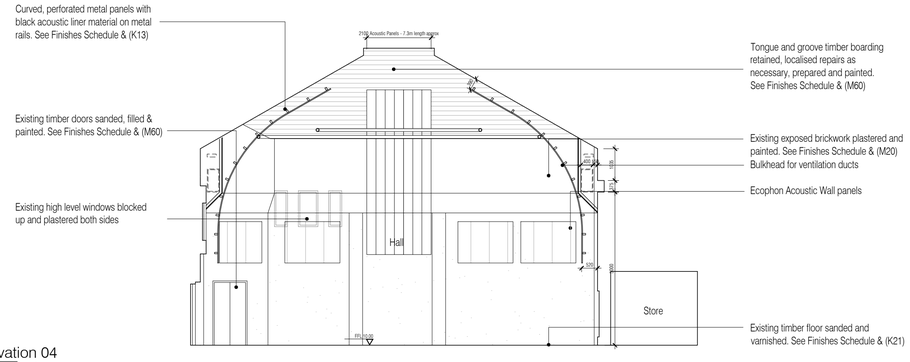

05 Elevation 04
Scale: 1:100@A1

NOTES: Do not scale this drawing. All dimensions to be checked on site prior to commencement or manufacture.

Key Plan
(nts)

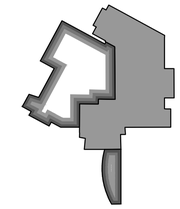

ISSUED FOR CONSTRUCTION

Rev	Date	By	Chk	Comment
C2	11.04.14	CH	AC	Ductwork adjusted
C1	03.07.13	RKC	JAS	Issued for CONSTRUCTION

BRINGING IDEAS TO LIFE

FRANKHAM

Frankham Consultancy Group Limited
21 Perrymount Road
Haywards Heath RH16 3TP
t 01444 444900 f 01444 455642
enquire@frankham.com
www.frankham.com

Client
Ealing
www.ealing.gov.uk


Project Title
Dominion Arts Centre
Southall
London

Drawing Title
Proposed Room Elevation
Main Hall - GA-07


Drawn by:	Scale:	Date:
RKC	1:100@A1	28.02.13
Designed by:	Checked by:	Approved by:
FCG	-	-

File Ref.: X:\2000\2134\01 - LEVEL 04\ - DOMINION ARTS CENTRE\ARCH\2ND_3RD_ELEVATIONS 2134\01-A-224.DWG - 20/06/2013 11:40:33


Drawing No. 224970-A-324
Rev. C2

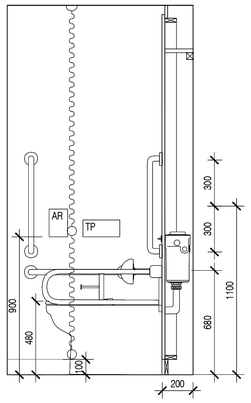


01 Elevation 01
Scale: 1:20@A1

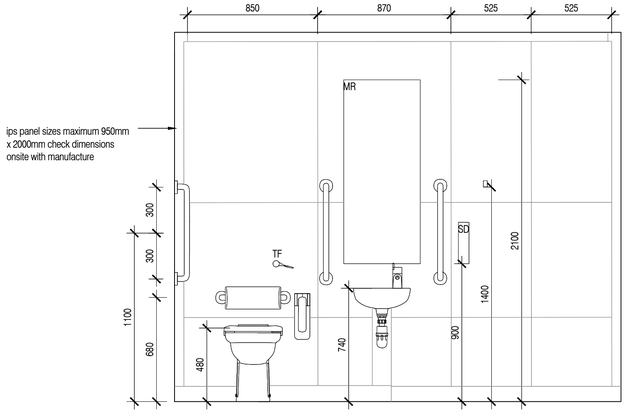


02 Elevation 02
Scale: 1:20@A1

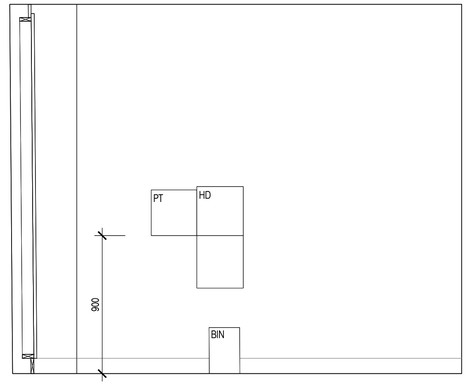

03 Elevation 03
Scale: 1:20@A1

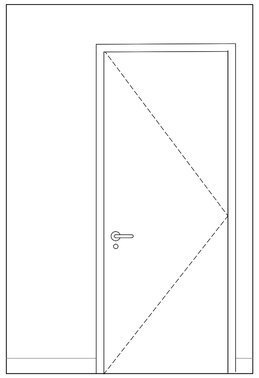


04 Elevation 04
Scale: 1:20@A1

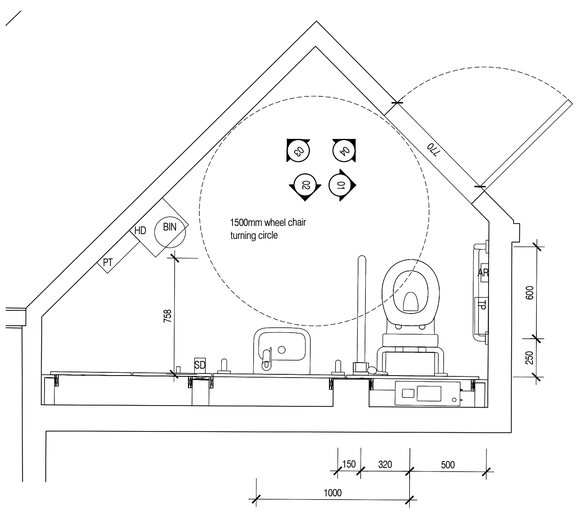

05 Floor Plan
Scale: 1:20@A1

NOTES: Do not scale this drawing. All dimensions to be checked on site prior to commencement or manufacture.

Key Plan
(nts)

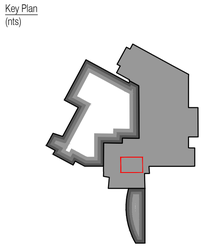

Key

HD - Hand drier. Refer to the specification section N13 clause 472A

SD - Soap dispenser. Refer to the specification section N13 clause 456

PT - Paper towel dispenser. Refer to the specification section N13 clause 442

TP - Toilet paper holder. Refer to the specification section N13 clause 462

MR - For mirror refer to spec. section N13 clause 188A

AR - Alarm reset button

CH - Coat hook

TF - Toilet Flush

For unisex corner WC equipment package refer to spec. section N13 clause 311A

Disabled toilet complient with Part M Doc.

ISSUED FOR CONSTRUCTION

Rev	Date	By	Chk	Comment
C2	15.07.13	PR	AC	CONSTRUCTION ISSUE

BRINGING IDEAS TO LIFE

FRANKHAM

Frankham Consultancy Group Limited
21 Perrymount Road
Haywards Heath RH16 3TP
t 01444 444900 f 01444 455642
enquire@frankham.com
www.frankham.com

Client
Ealing
www.ealing.gov.uk


Project Title
Dominion Arts Centre
Southall
London

Drawing Title
Proposed Room Elevation
Disabled WC
Room FA-07

Drawn by:	Scale:	Date:
RKC	1:20@A1	15.07.13
Designed by:	Checked by:	Approved by:
FCG	AC	AC

File Ref.: X:\2008\224970 - EALING - DOMINION ARTS CENTRE\ARCH\DB_BIM_ELEVATIONS_224970-A-326.DWG - 20081134045 20.06.11 13:40:45

Drawing No.	Rev.
224970-A-326	C2

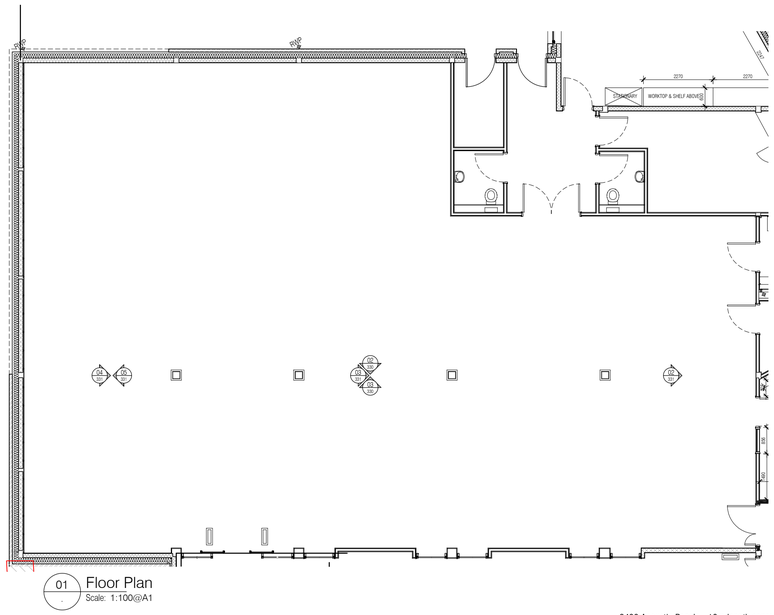

01 Floor Plan
Scale: 1:100@A1




02 Elevation 02
Scale: 1:50@A1



03 Elevation 03
Scale: 1:50@A1

NOTES: Do not scale this drawing. All dimensions to be checked on site prior to commencement or manufacture.

Key Plan
(nts)

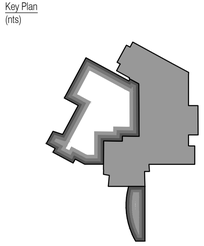

ISSUED FOR CONSTRUCTION

Rev	Date	By	Chk	Comment
C1	03.07.13	RKC	JAS	Issued for CONSTRUCTION

BRINGING IDEAS TO LIFE

FRANKHAM

Frankham Consultancy Group Limited
21 Perrymount Road
Haywards Heath RH16 3TP
t 01444 444900 f 01444 455642
enquire@frankham.com
www.frankham.com

Client
Ealing
www.ealing.gov.uk


Project Title
Dominion Arts Centre
Southall
London

Drawing Title
Proposed Room Elevation
Library GB01


Drawn by:	Scale:	Date:
RKC	1:20@A1	05/02/13
Designed by:	Checked by:	Approved by:
FCG	-	-

File Ref.: R:\2008\224970 - LEALNG - DOMINION ARTS CENTRE\ARCH\DGE_DRI_ELEVATIONS-224970-A-330.DWG - 20080119404
20:06:11/13:40:55


Drawing No. 224970-A-330
Rev. C1

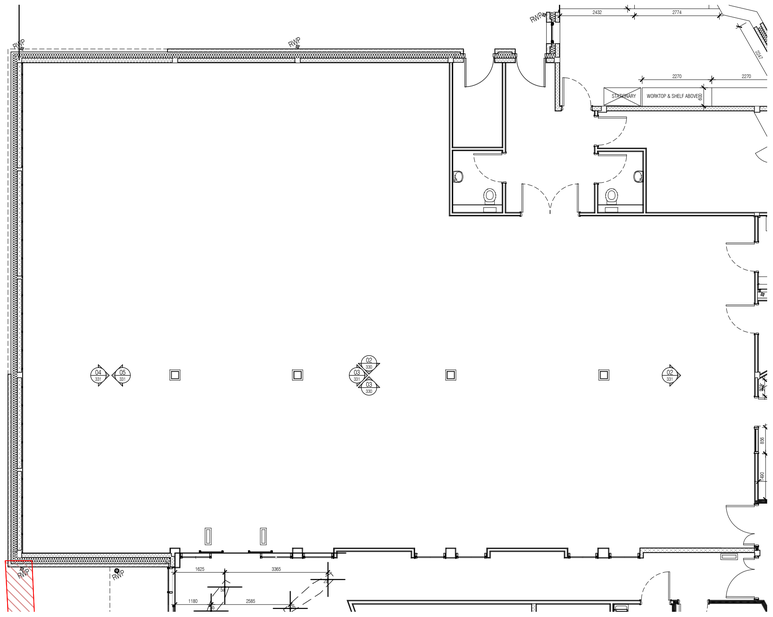


01 Floor Plan
Scale: 1:100@A1

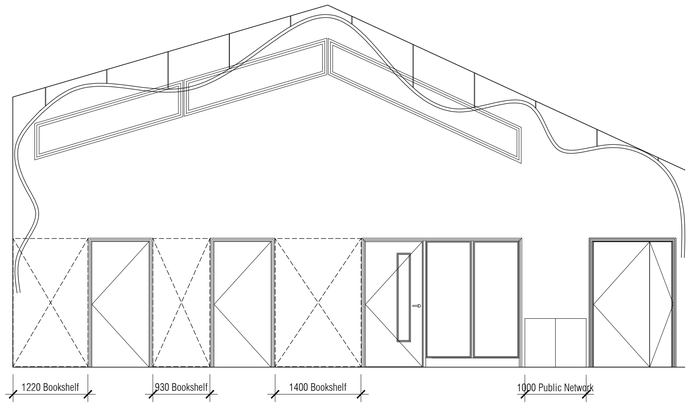


02 Elevation 02
Scale: 1:50@A1

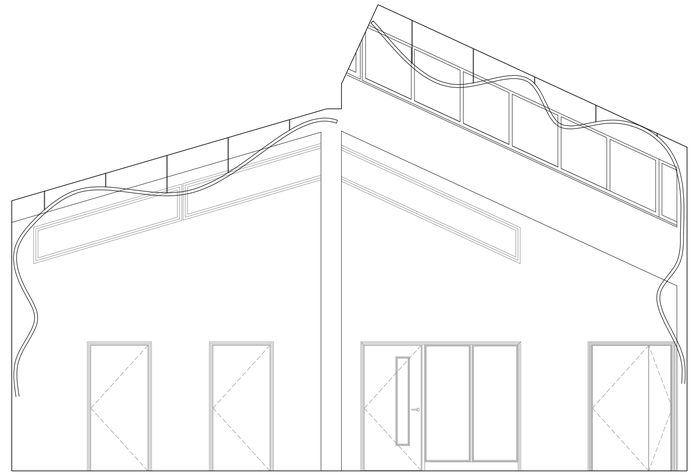

03 Elevation 03
Scale: 1:50@A1

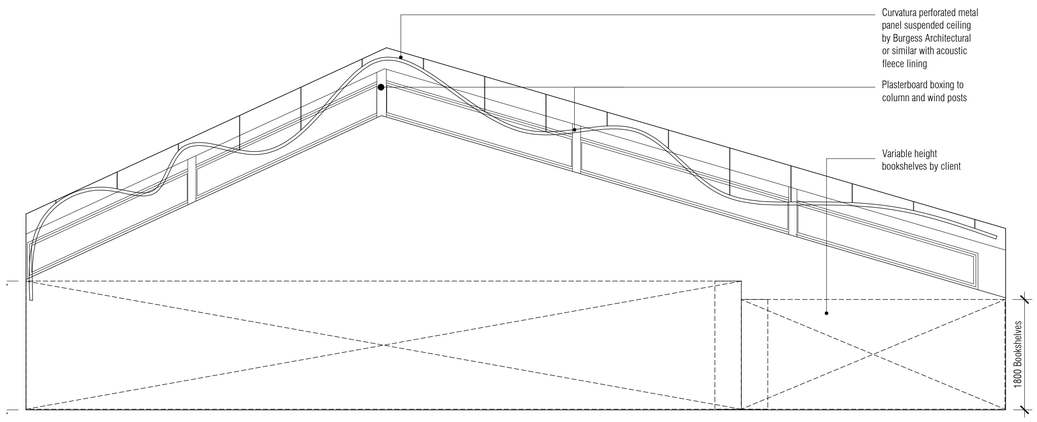

05 Elevation 05
Scale: 1:50@A1

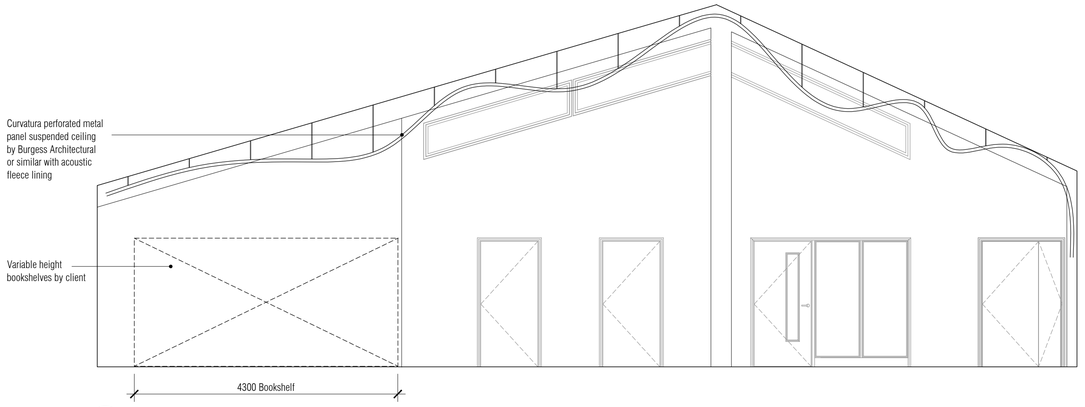

04 Elevation 04
Scale: 1:50@A1

NOTES: Do not scale this drawing. All dimensions to be checked on site prior to commencement or manufacture.

ISSUED FOR CONSTRUCTION

Rev	Date	By	Chk	Comment
C1	03.07.13	RKC	JAS	Issued for CONSTRUCTION

BRINGING IDEAS TO LIFE

FRANKHAM

Frankham Consultancy Group Limited
21 Perrymount Road
Haywards Heath RH16 3TP
t 01444 444900 f 01444 455642
enquire@frankham.com
www.frankham.com

Client
Ealing
www.ealing.gov.uk


Project Title
Dominion Arts Centre
Southall
London

Drawing Title
Proposed Room Elevation
Library GB01


Drawn by:	Scale:	Date:
RKC	1:20@A1	05/02/13
Designed by:	Checked by:	Approved by:
FCG	-	-

File Ref.: X:\2008\224970 - LB EALING - DOMINION ARTS CENTRE\ARCH\DB_3M_ELEVATIONS-224970-A-331.DWG - 20/06/2013 20:06:11:13:41:05


Drawing No.	Rev.
224970-A-331	C1

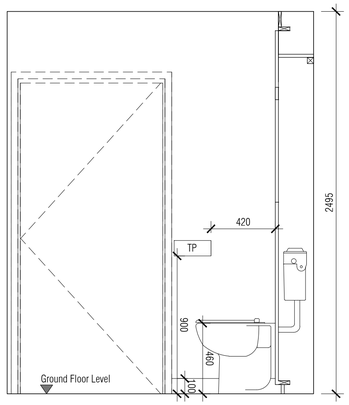


01 Elevation 01
Scale: 1:20@A1

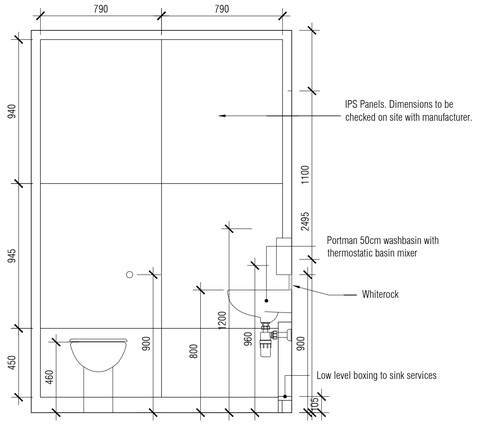


02 Elevation 02
Scale: 1:20@A1

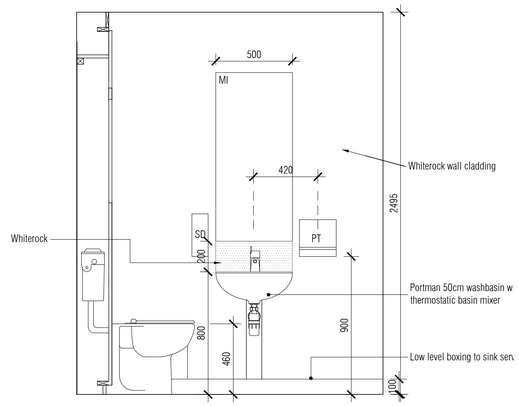

03 Elevation 03
Scale: 1:20@A1

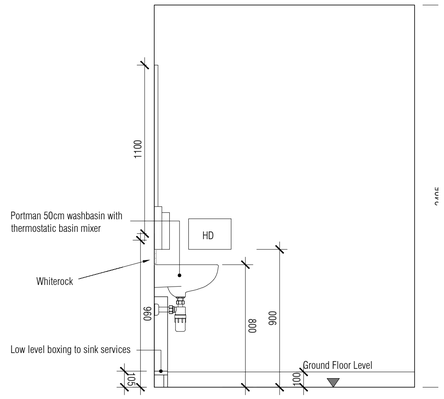


04 Elevation 04
Scale: 1:20@A1

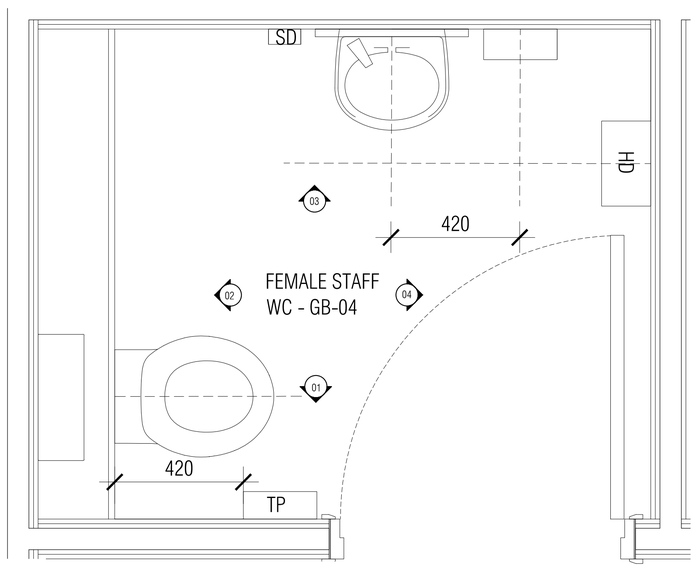

05 Floor Plan
Scale: 1:10@A1

NOTES: Do not scale this drawing. All dimensions to be checked on site prior to commencement or manufacture.

Key Plan
(nts)

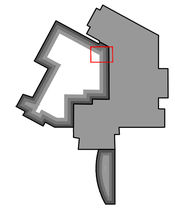

Key

HD - Hand drier. Refer to the specification section N13 clause 472A

SD - Soap dispenser. Refer to the specification section N13 clause 458

PT - Paper towel dispenser. Refer to the specification section N13 clause 442

TP - Toilet paper holder. Refer to the specification section N13 clause 462

MR - For mirror refer to spec. section N13 clause 188A

AR - Alarm reset button

CH - Coat hook

TF - Toilet Flush

For WC Pan and cistern make and model refer to spec. section N13 clause 300A

For unisex corner WC equipment package refer to spec. section N13 clause 311A

For unisex ambulent package refer to spec. section N13 clause 312A

For urinal type refer to spec. section N13 clause 315A

For wash basin refer to spec. section N13 clause 335A

For Doc. M shower room pack refer to spec.

ISSUED FOR CONSTRUCTION

Rev	Date	By	Chk	Comment

BRINGING IDEAS TO LIFE

FRANKHAM

Frankham Consultancy Group Limited
21 Perrymount Road
Haywards Heath RH16 3TP
t 01444 449000 f 01444 455642
enquire@frankham.com
www.frankham.com

Client
Ealing
www.ealing.gov.uk


Project Title
Dominion Arts Centre
Southall
London

Drawing Title
Proposed Room Elevation
Female Staff WC
Room GB-04


Drawn by:	Scale:	Date:
RKC	1:20@A1	28.10.13
Designed by:	Checked by:	Approved by:
FCG		

File Ref.: X:\2009\2224970 - LB EALING - DOMINION ARTS CENTRE\ARCH\2D_300_ELEVATIONS\ 224970-A-2322MS - 20061134119 20.06.11 13:41:19


Drawing No.	Rev.
224970-A-333	C2

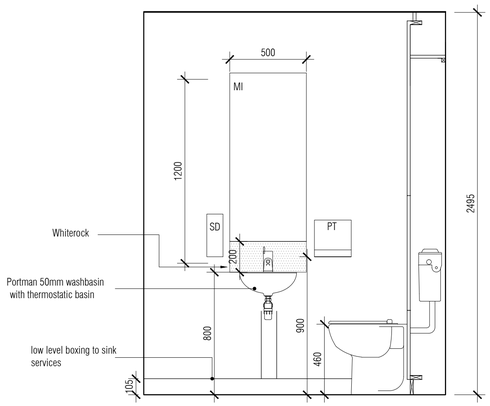


01 Elevation 01
Scale: 1:20@A1

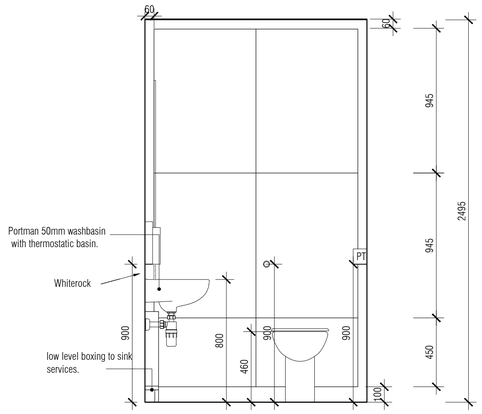


02 Elevation 02
Scale: 1:20@A1

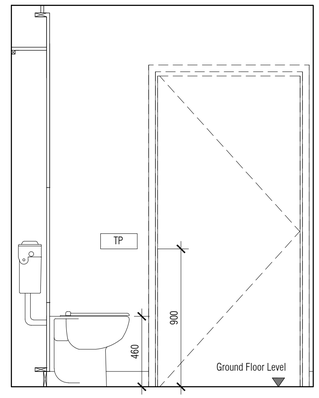

03 Elevation 03
Scale: 1:20@A1

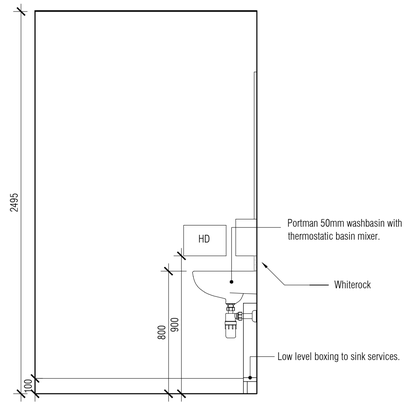


04 Elevation 04
Scale: 1:20@A1

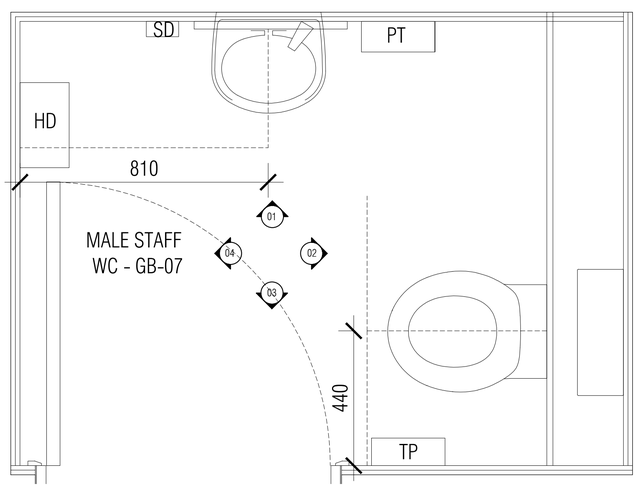

05 Floor Plan
Scale: 1:20@A1

NOTES: Do not scale this drawing. All dimensions to be checked on site prior to commencement or manufacture.

Key Plan
(nts)

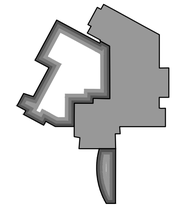

Key

HD - Hand drier, Refer to the specification section N13 clause 472A

SD - Soap dispenser, Refer to the specification section N13 clause 458

PT - Paper towel dispenser, Refer to the specification section N13 clause 442

TP - Toilet paper holder. Refer to the specification section N13 clause 462

MR - For mirror refer to spec, section N13 clause 188A

AR - Alarm reset button

CH - Coat hook

TF - Toilet Flush

For WC Pan and cistern make and model refer to spec, section N13 clause 300A

For unisex corner WC equipment package refer to spec. section N13 clause 311A

For unisex ambulent package refer to spec, section N13 clause 312A

For urinal type refer to spec, section N13 clause 315A

For wash basin refer to spec. section N13 clause 335A

For Doc, M shower room pack refer to spec.

ISSUED FOR CONSTRUCTION

Rev	Date	By	Chk	Comment
C2	30.10.13	MLE	CH	Construction Issue

BRINGING IDEAS TO LIFE

FRANKHAM

Frankham Consultancy Group Limited
21 Perrymount Road
Haywards Heath RH16 3TP
t 01444 444900 f 01444 455642
enquire@frankham.com
www.frankham.com

Client
Ealing
www.ealing.gov.uk


Project Title
Dominion Arts Centre
Southall
London

Drawing Title
Proposed Room Elevation
Male Staff WC
Room GB-07


Drawn by:	Scale:	Date:
RKC	1:20@A1	28.10.13
Designed by: FCG	Checked by:	Approved by:

File Ref.: X:\2008\2224970 - LB EALING - DOMINION ARTS CENTRE\ARCH\LBE_DM_ELEVATIONS_224970-A-334.DWG - 2008\11\28\13:41:24 20.06.11:13:41:24


Drawing No. 224970-A-334
Rev. C2

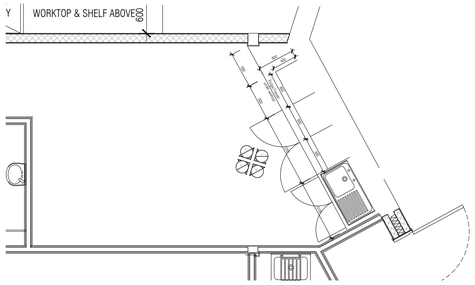


01 Floor Plan
Scale: 1:20@A1

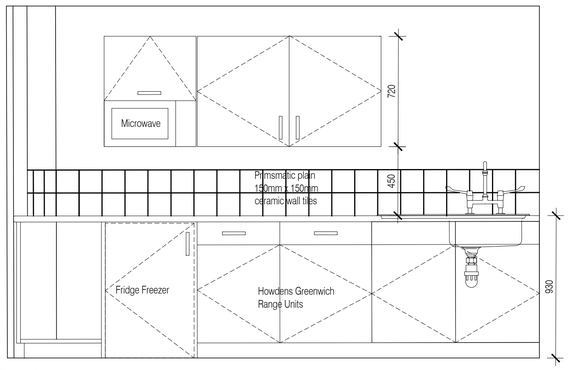


02 Elevation 01
Scale: 1:20@A1

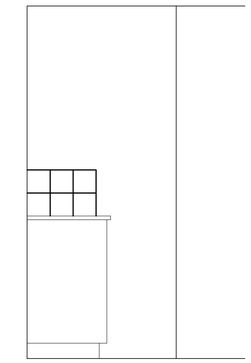


04 Elevation 03
Scale: 1:20@A1

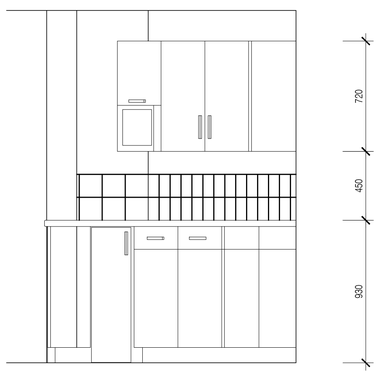

03 Elevation 02
Scale: 1:20@A1

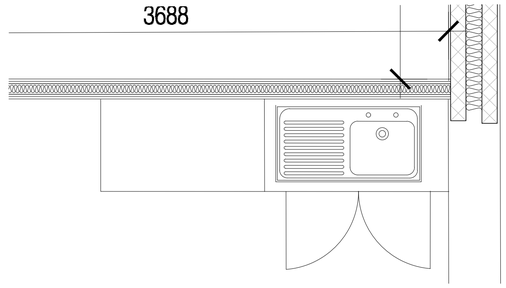


05 Office kitchenette plan
Scale: 1:20@A1

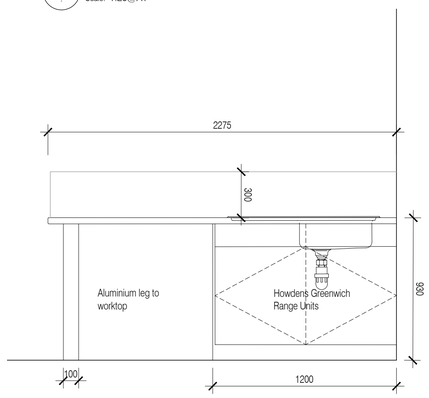

06 Elevation 01
Scale: 1:20@A1

NOTES: Do not scale this drawing. All dimensions to be checked on site prior to commencement or manufacture.

Key Plan
(nts)

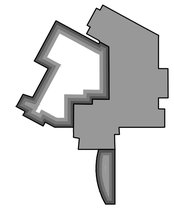

ISSUED FOR CONSTRUCTION

Rev	Date	By	Chk	Comment
C2	27.01.14	CH	AC	Office kitchenette added
C1	03.07.13	RKC	JAS	Issued for CONSTRUCTION

BRINGING IDEAS TO LIFE

FRANKHAM

Frankham Consultancy Group Limited
21 Perrymount Road
Haywards Heath RH16 3TP
t 01444 444900 f 01444 455642
enquire@frankham.com
www.frankham.com

Client
Ealing
www.ealing.gov.uk


Project Title
Dominion Arts Centre
Southall
London

Drawing Title
Proposed Room Elevation
Staff Kitchen GB08


Drawn by:	Scale:	Date:
RKC	1:20@A1	09.04.13
Designed by:	Checked by:	Approved by:
FCG	CH	AC

File Ref.: X:\2008\2124\01 - LB EALING - DOMINION ARTS CENTRE\ARCH\DB_BIM_ELEVATIONS\2124DV-A-335.DWG - 20/06/13 14:03 — 20.06.11:13:41:32


Drawing No. 224970-A-335 | Rev. C2

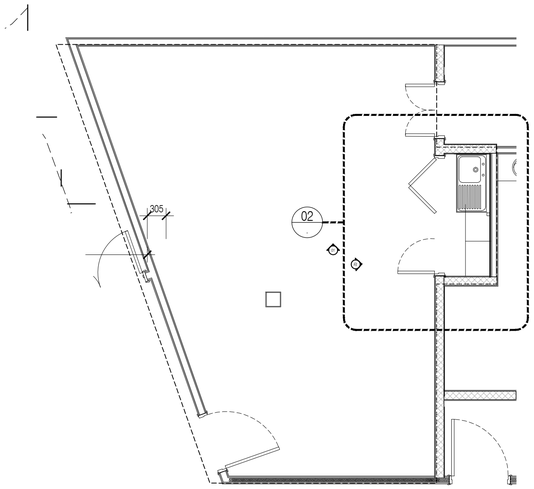


01 Floor Plan
Scale: 1:50@A1

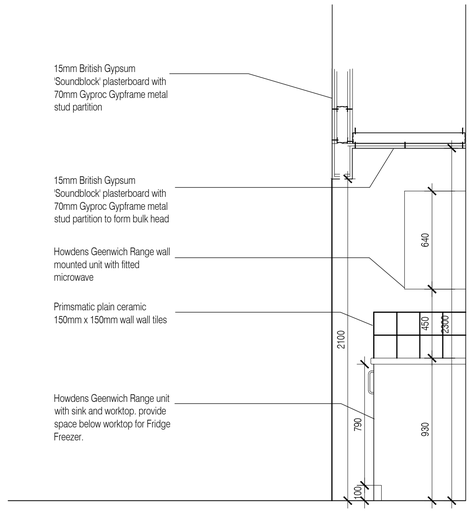

03 Elevation 03
Scale: 1:20@A1

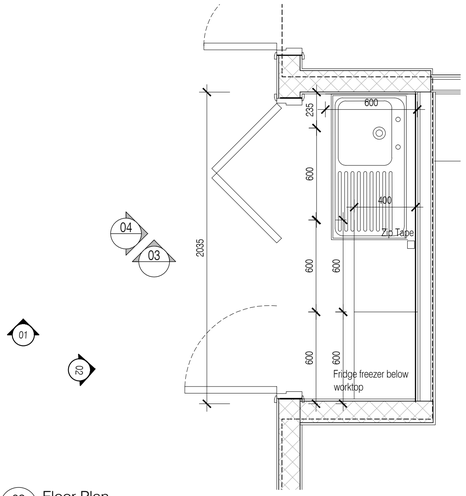


02 Floor Plan
Scale: 1:20@A1

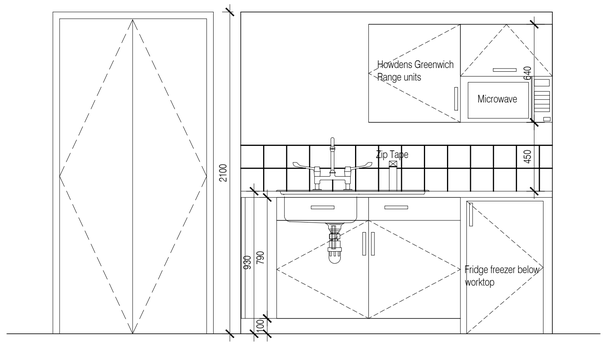

04 Elevation 04
Scale: 1:20@A1

NOTES: Do not scale this drawing. All dimensions to be checked on site prior to commencement or manufacture.

Key Plan
(nts)

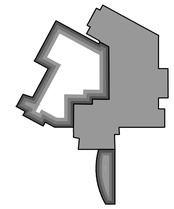

Rev	Date	By	Chk	Comment
C1	03.07.13	RKC	JAS	Issued for CONSTRUCTION

BRINGING IDEAS TO LIFE

FRANKHAM

Frankham Consultancy Group Limited
21 Perrymount Road
Haywards Heath RH16 3TP
t 01444 444900 f 01444 455642
enquire@frankham.com
www.frankham.com

Client
Ealing
www.ealing.gov.uk


Project Title
Dominion Arts Centre
Southall
London

Drawing Title
Proposed Room Elevation
Kitchenette To Activity Room 1


Drawn by:	Scale:	Date:
RKC	1:20@A1	09.04.13
Designed by:	Checked by:	Approved by:
FCG	CH	AC

File Ref.: K:\2000\0224970 - LB EALING - DOMINION ARTS CENTRE\ARCH\2D_SW_D\224970A01-224970-A-340.DWG - 20061113 04139 20:06:11/13:41:39


Drawing No. 224970-A-340 Rev. C1

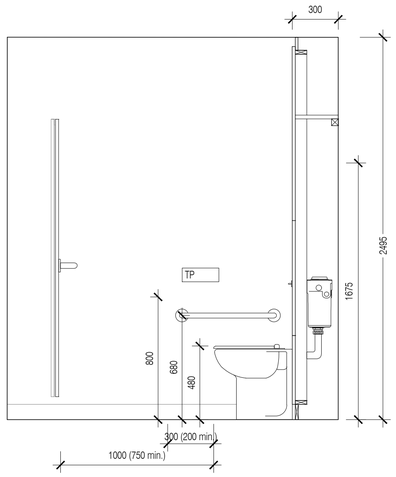


01 Elevation 01
Scale:1:20@A1

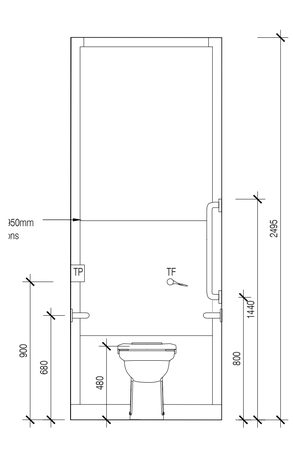


02 Elevation 02
Scale:1:20@A1

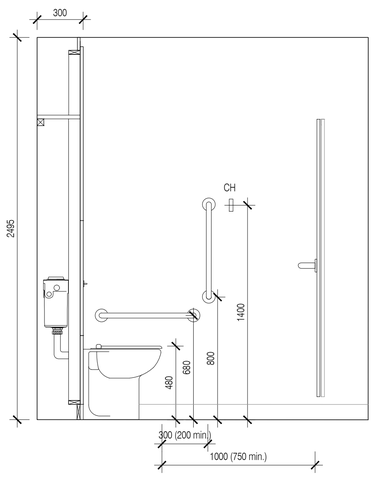


03 Elevation 03
Scale:1:20@A1

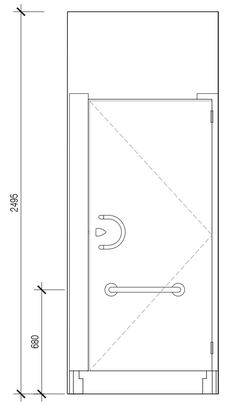

04 Elevation 04
Scale: 1:20@A1

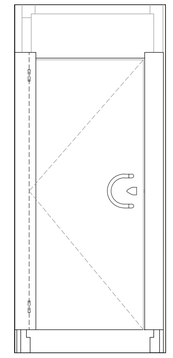


05 Elevation 05
Scale:1:20@A1

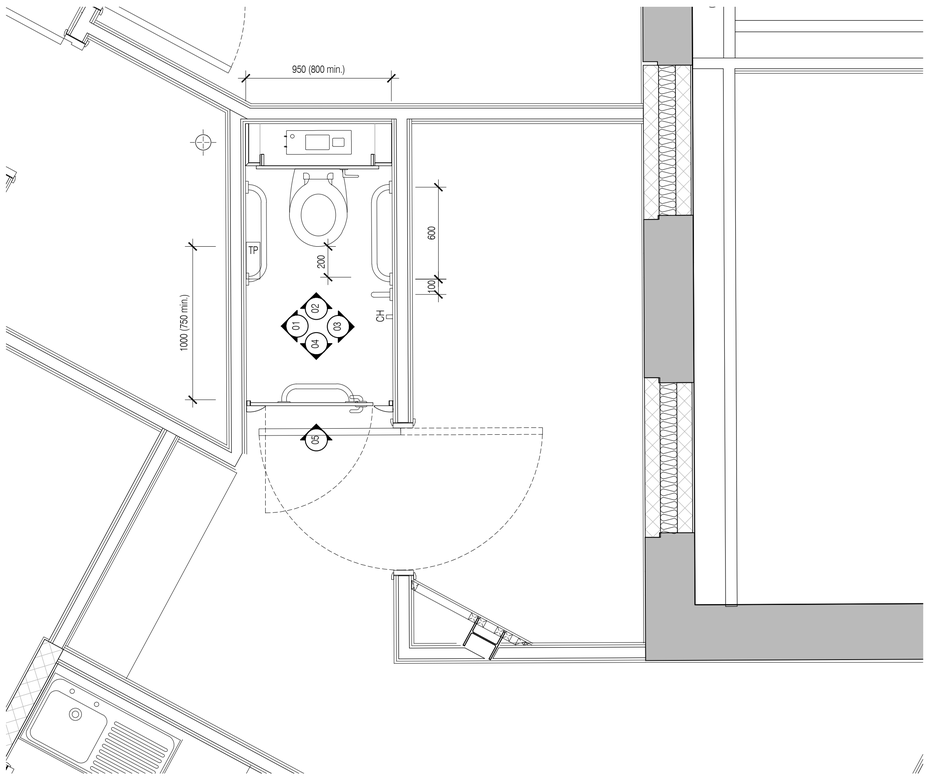

07 Plan
Scale:1:20@A1

NOTES: Do not scale this drawing. All dimensions to be checked on site prior to commencement or manufacture.

Key Plan
(nts)

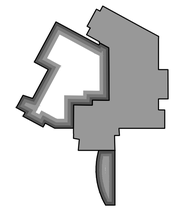

Key

HD - Hand drier. Refer to the specification section N13 clause 472A

SD - Soap dispenser. Refer to the specification section N13 clause 458

PT - Paper towel dispenser. Refer to the specification section N13 clause 442

TP - Toilet paper holder. Refer to the specification section N13 clause 462

MR - For mirror refer to spec. section N13 clause 188A

AR - Alarm reset button

CH - Coat hook

TF - Toilet Flush

For WC Pan and cistern make and model refer to spec. section N13 clause 300A

For unisex ambulent package refer to spec. section N13 clause 312A

Disabled toilet complient with Part M Doc.

ISSUED FOR CONSTRUCTION

Rev	Date	By	Chk	Comment
C3	31.10.13	MLE	AC	Layouts adjusted
C2	15.07.13	PR	AC	CONSTRUCTION ISSUE

BRINGING IDEAS TO LIFE

FRANKHAM

Frankham Consultancy Group Limited
21 Perrymount Road
Haywards Heath RH16 3TP
t 01444 444900 f 01444 455642
enquire@frankham.com
www.frankham.com

Client
Ealing
www.ealing.gov.uk


Project Title
Dominion Arts Centre
Southall
London

Drawing Title
Proposed Room Elevation
WC 1 GC07


Drawn by:	Scale:	Date:
RKC	1:20@A1	15/07/13
Designed by:	Checked by:	Approved by:
FCG	AC	AC

File Ref.: K:\2000\0224970 - LEALNL - DOMINION ARTS CENTRE\ARCH\3D_BIM_D.EVIT(ND).224970-A-342.DWG - 20061113454
20:06:11:13:41:54

Drawing No.	Rev.
224970-A-342	C3

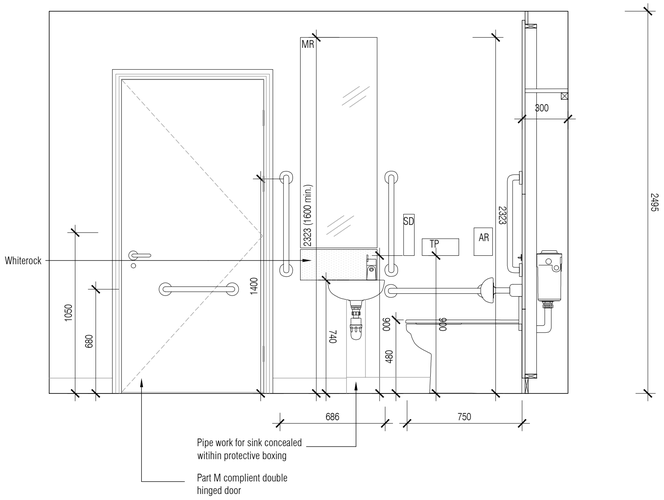


01 . Elevation 01
Scale:1:20@A1

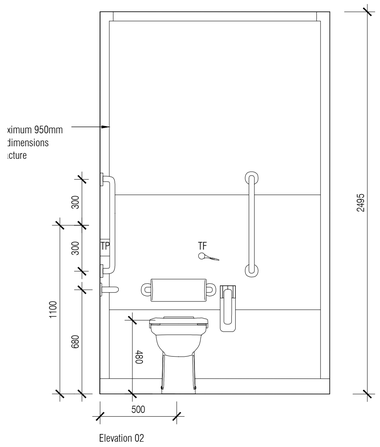


Elevation 02


02 . Elevation 02
Scale:1:20@A1

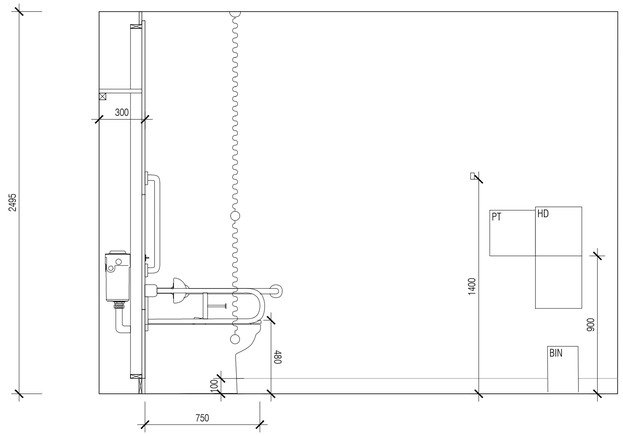

03 . Elevation 03
Scale:1:20@A1

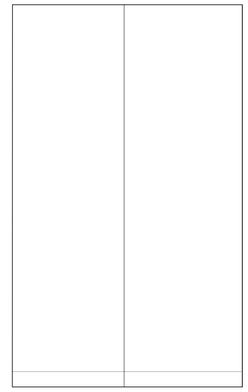


04 . Elevation 04
Scale: 1:20@A1

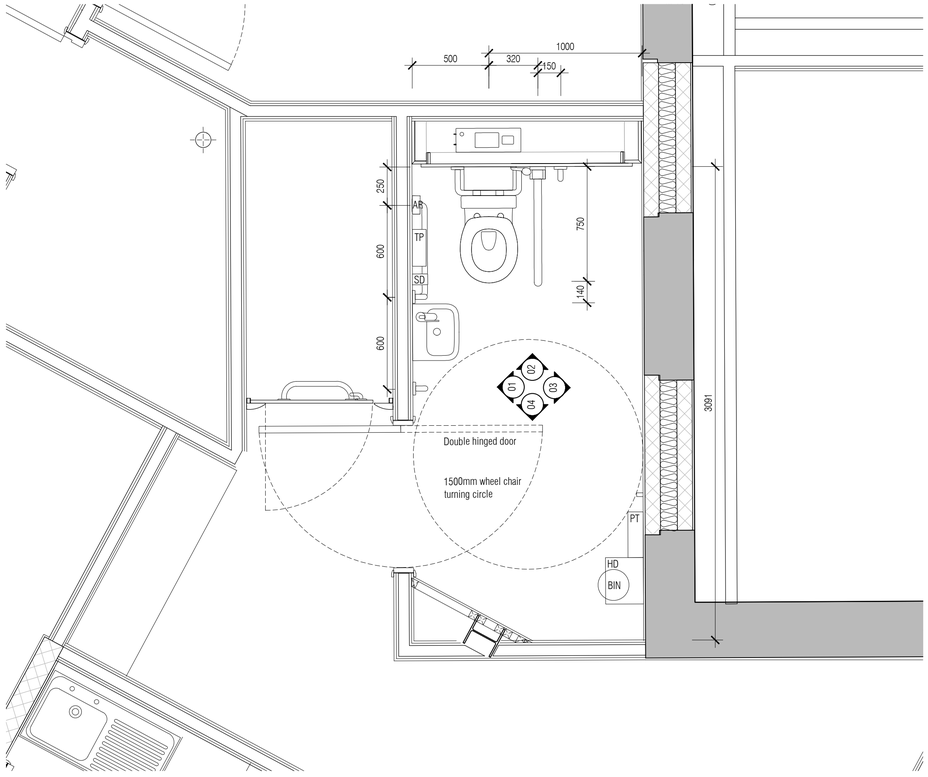

05 . Plan
Scale:1:20@A1

NOTES: Do not scale this drawing. All dimensions to be checked on site prior to commencement or manufacture.

Key Plan
(nts)

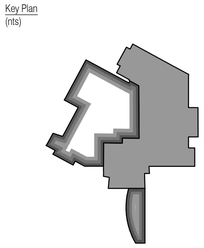

Key

HD - Hand drier. Refer to the specification section N13 clause 472A

SD - Soap dispenser. Refer to the specification section N13 clause 458

PT - Paper towel dispenser. Refer to the specification section N13 clause 442

TP - Toilet paper holder. Refer to the specification section N13 clause 462

MR - For mirror refer to spec. section N13 clause 188A

AR - Alarm reset button

CH - Coat hook

TF - Toilet Flush

For unisex corner WC equipment package refer to spec. section N13 clause 311A

Disabled toilet complient with Part M Doc.

ISSUED FOR CONSTRUCTION

Rev	Date	By	Chk	Comment
C3	31.10.13	MLE	AC	Layout adjusted
C2	15.07.13	PR	AC	CONSTRUCTION ISSUE

BRINGING IDEAS TO LIFE

FRANKHAM

Frankham Consultancy Group Limited
21 Perrymount Road
Haywards Heath RH16 3TP
t 01444 444900 f 01444 455642
enquire@frankham.com
www.frankham.com

Client
Ealing
www.ealing.gov.uk


Project Title
Dominion Arts Centre
Southall
London

Drawing Title
Proposed Room Elevation
WC 1 GC08


Drawn by:	Scale:	Date:
RKC	1:20@A1	15/07/13
Designed by:	Checked by:	Approved by:
FCG	AC	AC

File Ref.: X:\2009\224970 - LB EALING - DOMINION ARTS CENTRE\ARCH\300_399_ELEVATIONS\224970-A-343.DWG — 2009/11/24/23 20.06.11 13:47:03


Drawing No. 224970-A-343
Rev. C3

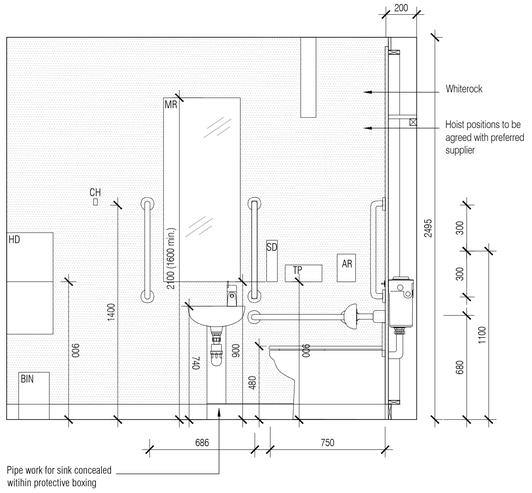


01 Elevation 01
Scale:1:20@A1

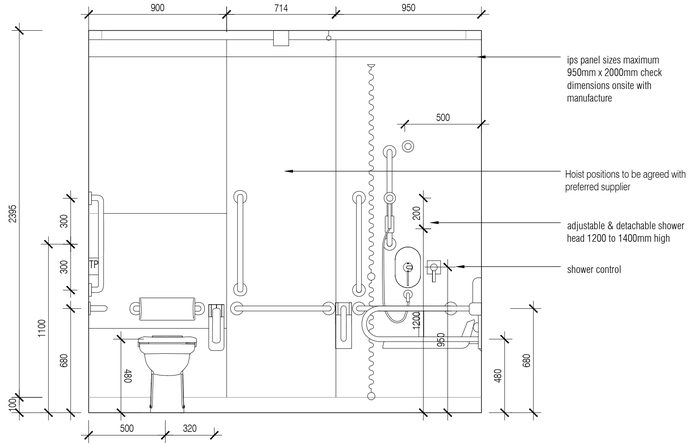


02 Elevation 02
Scale:1:20@A1

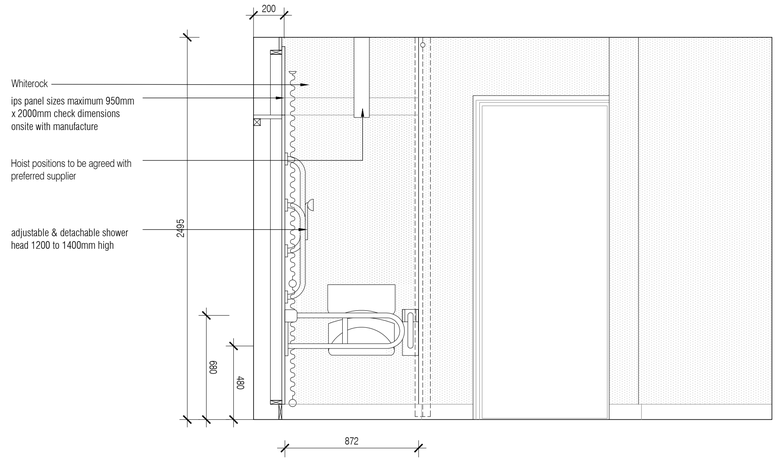


03 Elevation 03
Scale: 1:20@A1

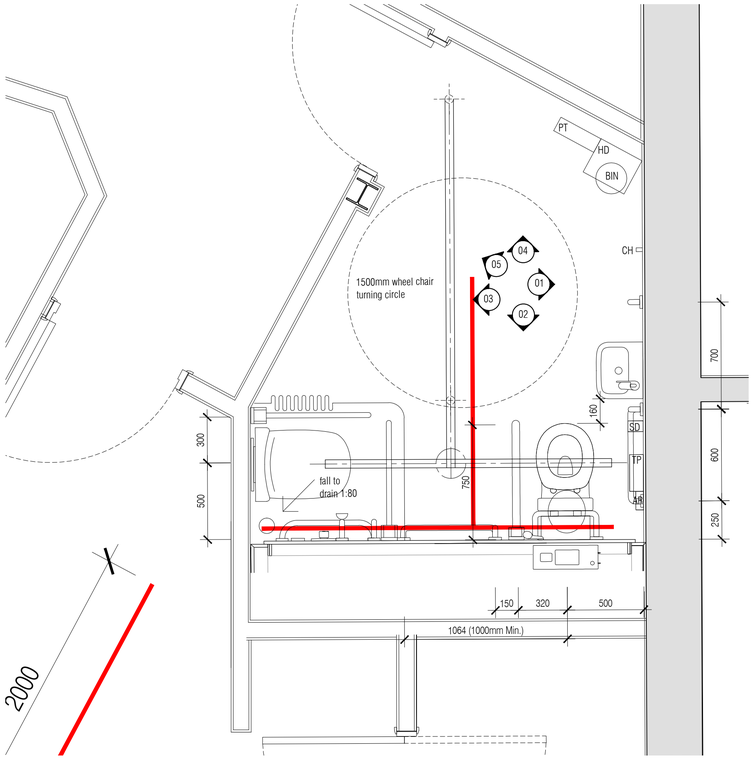

06 Plan
Scale:1:20@A1

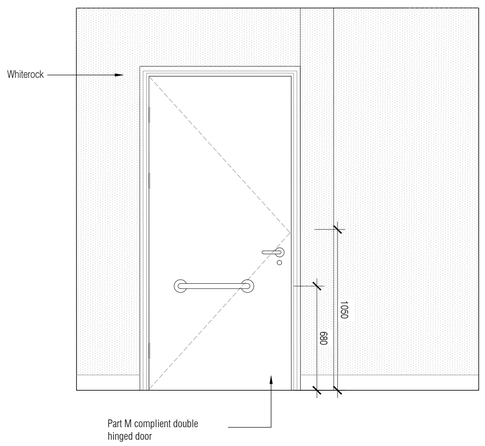


04 Elevation 04
Scale:1:20@A1

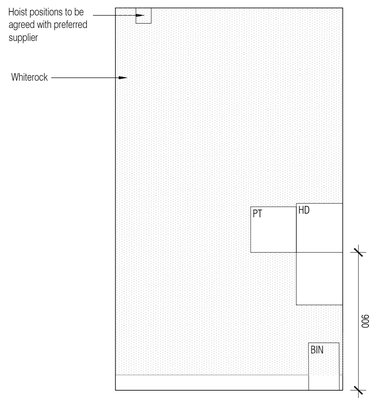

05 Elevation 05
Scale:1:20@A1

NOTES: Do not scale this drawing. All dimensions to be checked on site prior to commencement or manufacture.

Key Plan
(nts)

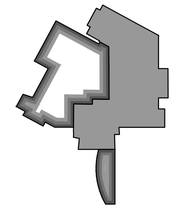

Key

HD - Hand drier. Refer to the specification section N13 clause 472A

SD - Soap dispenser. Refer to the specification section N13 clause 458

PT - Paper towel dispenser. Refer to the specification section N13 clause 442

TP - Toilet paper holder. Refer to the specification section N13 clause 462

MR - For mirror refer to spec. section N13 clause 188A

AR - Alarm reset button

CH - Coat hook

TF - Toilet Flush

For unisex corner WC equipment package refer to spec. section N13 clause 311A

Disabled toilet complient with Part M Doc.

For Doc. M shower room pack refer to spec.

ISSUED FOR CONSTRUCTION

Rev	Date	By	Chk	Comment
C3	31.10.13	MLE	AC	Layout adjusted
C2	15.07.13	PR	AC	CONSTRUCTION ISSUE

BRINGING IDEAS TO LIFE

FRANKHAM

Frankham Consultancy Group Limited
21 Perrymount Road
Haywards Heath RH16 3TP
t 01444 449000 f 01444 455642
enquire@frankham.com
www.frankham.com

Client
Ealing
www.ealing.gov.uk

Project Title
Dominion Arts Centre
Southall
London


Drawing Title
Proposed Room Elevation
WC 1 GC09

Drawn by:	Scale:	Date:
RKC	1:20@A1	15/07/13
Designed by:	Checked by:	Approved by:
FCG	AC	AC


File Ref.: K:\2009\2224970 - LB EALING - DOMINION ARTS CENTRE\ARCH\200_3Bl_ELEVATIONS\ 224970-A-344.DWG - 20061114213

20.06.11 13:42:15


Drawing No. 224970-A-344
Rev. C3

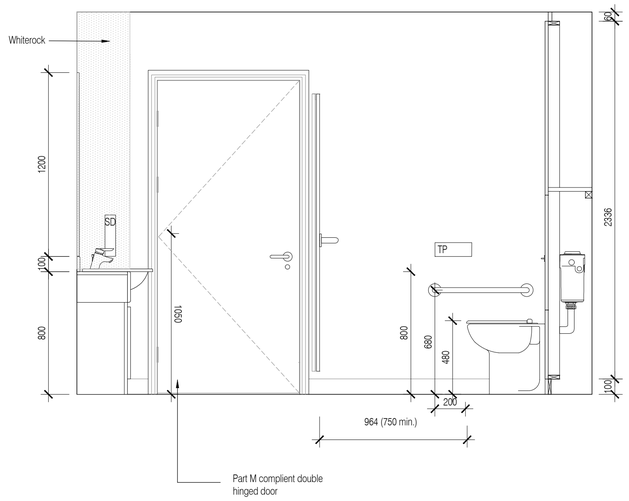


01 Elevation 01
Scale: 1:20@A1

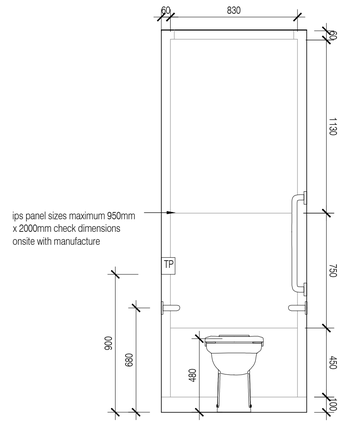


02 Elevation 02
Scale: 1:20@A1

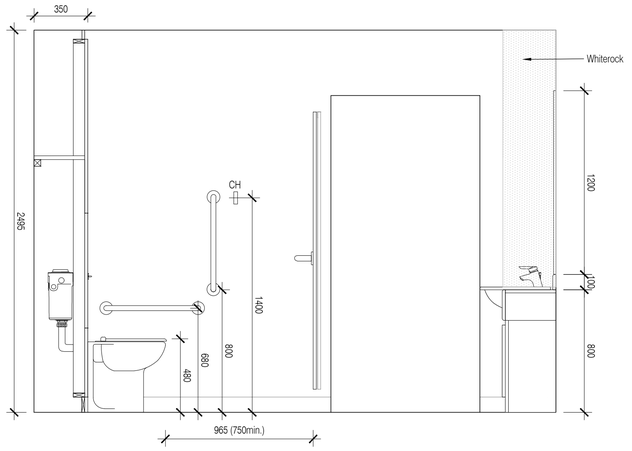


03 Elevation 03
Scale: 1:20@A1

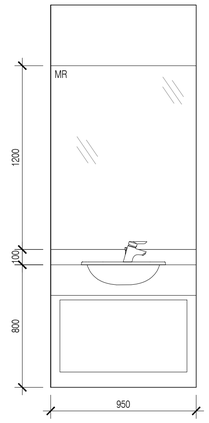


04 Elevation 04
Scale: 1:20@A1

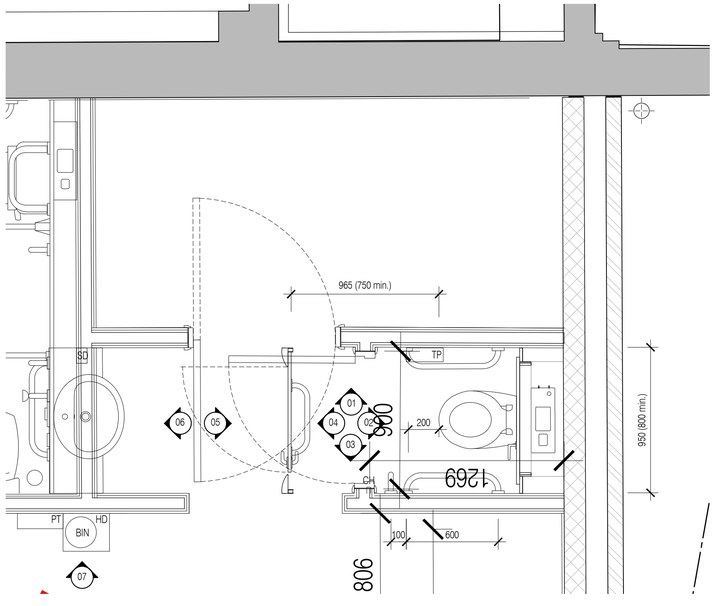


08 Floor Plan
Scale: 1:20@A1

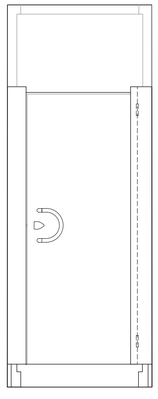

05 Elevation 02
Scale: 1:20@A1

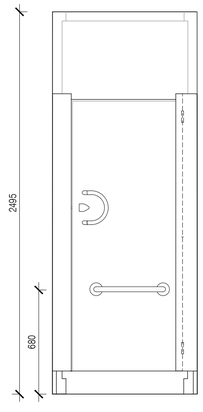


06 Elevation 04
Scale: 1:20@A1

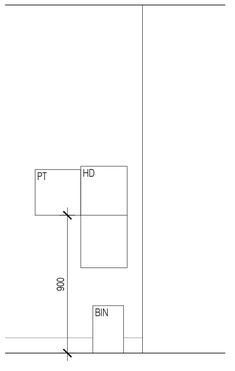

07 Elevation 03
Scale: 1:20@A1

NOTES: Do not scale this drawing. All dimensions to be checked on site prior to commencement or manufacture.

Key Plan
(nts)

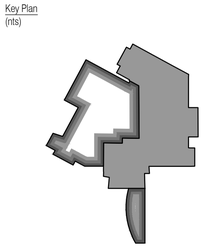

Key

HD - Hand drier. Refer to the specification section N13 clause 472A

SD - Soap dispenser. Refer to the specification section N13 clause 458

PT - Paper towel dispenser. Refer to the specification section N13 clause 442

TP - Toilet paper holder. Refer to the specification section N13 clause 462

MR - For mirror refer to spec. section N13 clause 188A

AR - Alarm reset button

CH - Coat hook

TF - Toilet Flush

For unisex ambulent package refer to spec. section N13 clause 312A

For Doc. M shower room pack refer to spec.

Disabled toilet complient with Part M Doc.

ISSUED FOR CONSTRUCTION

Rev	Date	By	Chk	Comment
C3	31.10.13	MLE	AC	Layout Adjusted
C2	15.07.13	PR	AC	Issued for construction

BRINGING IDEAS TO LIFE

FRANKHAM

Frankham Consultancy Group Limited
21 Perrymount Road
Haywards Heath RH16 3TP
t 01444 444900 f 01444 455642
enquire@frankham.com
www.frankham.com

Client
Ealing
www.ealing.gov.uk


Project Title
Dominion Arts Centre
Southall
London

Drawing Title
Proposed Room Elevation
WC 2 GC11


Drawn by:	Scale:	Date:
RKC	1:20@A1	15.07.13
Designed by:	Checked by:	Approved by:
FCG	AC	AC

File Ref.: K:\2000\2224\01 - EALING - DOMINION ARTS CENTRE\ARCH\DWG_WIP_ELEVATIONS\224970-A-346.DWG - 2008111\3231 20:06:11 13:42:33


Drawing No. 224970-A-346
Rev. C3

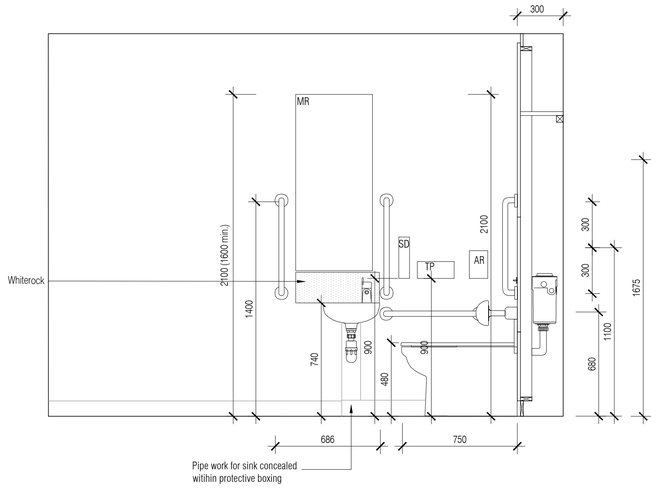


01 Elevation 01
Scale:1:20@A1

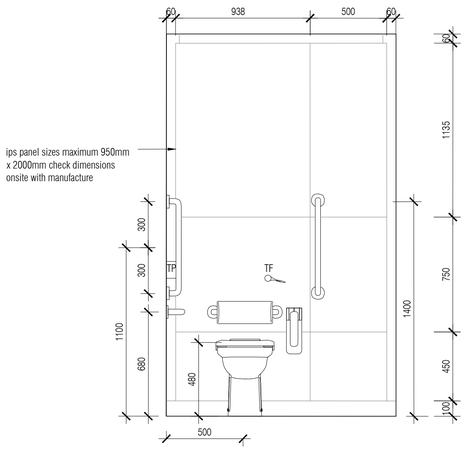


02 Elevation 02
Scale:1:20@A1

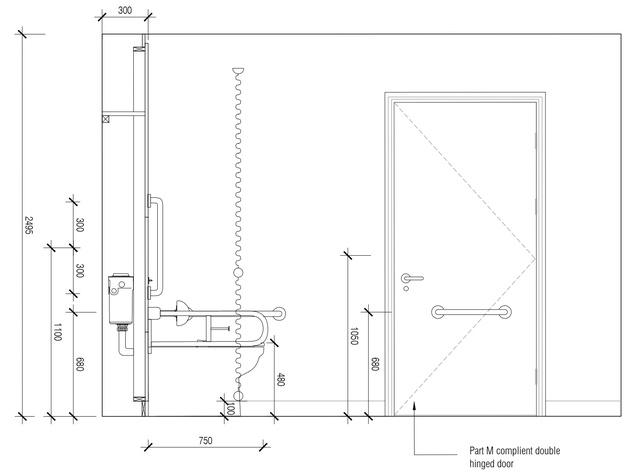

03 Elevation 03
Scale:1:20@A1

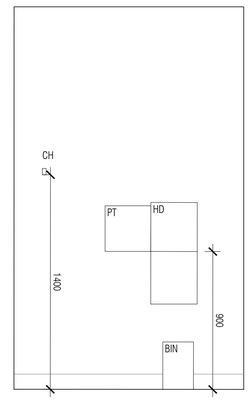


04 Elevation 04
Scale: 1:20@A1

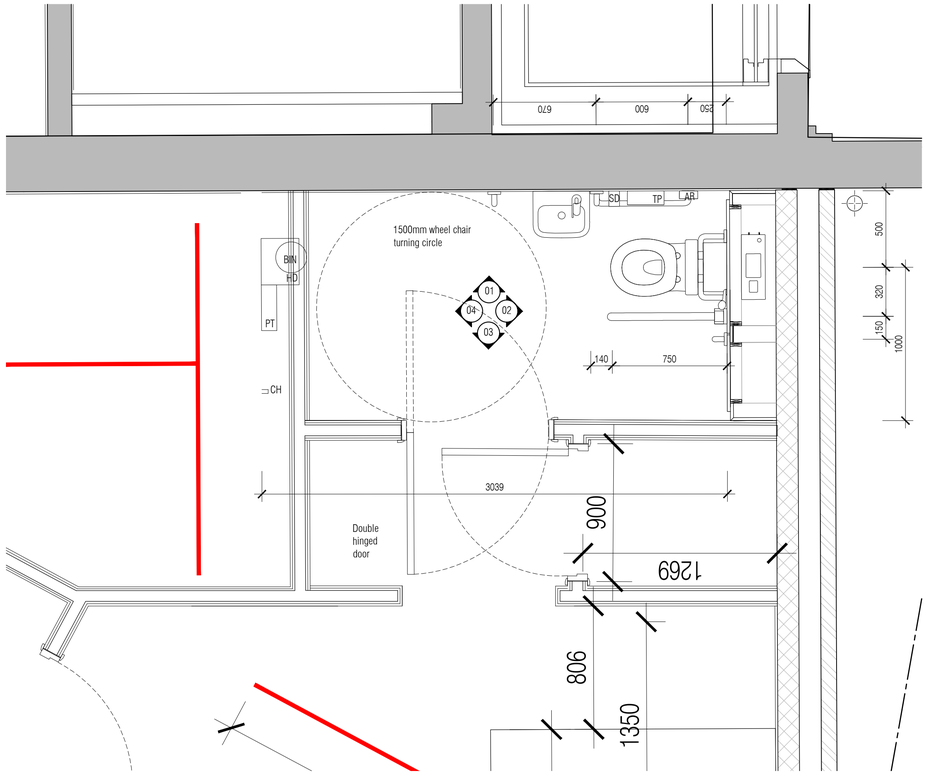

05 Plan
Scale:1:20@A1

NOTES: Do not scale this drawing. All dimensions to be checked on site prior to commencement or manufacture.

Key Plan
(nts)

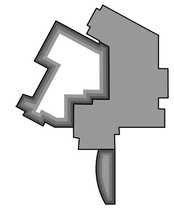

Key

HD - Hand drier. Refer to the specification section N13 clause 472A

SD - Soap dispenser. Refer to the specification section N13 clause 458

PT - Paper towel dispenser. Refer to the specification section N13 clause 442

TP - Toilet paper holder. Refer to the specification section N13 clause 462

MR - For mirror refer to spec. section N13 clause 188A

AR - Alarm reset button

CH - Coat hook

TF - Toilet Flush

For unisex corner WC equipment package refer to spec. section N13 clause 311A

ISSUED FOR CONSTRUCTION

Rev	Date	By	Chk	Comment
C3	31.10.13	MLE	AC	Layout Adjusted
C2	15.07.13	PR	AC	CONSTRUCTION ISSUE

BRINGING IDEAS TO LIFE

FRANKHAM

Frankham Consultancy Group Limited
21 Perrymount Road
Haywards Heath RH16 3TP
t 01444 444900 f 01444 455642
enquire@frankham.com
www.frankham.com

Client
Ealing
www.ealing.gov.uk


Project Title
Dominion Arts Centre
Southall
London

Drawing Title
Proposed Room Elevation
WC 1 GC12

Drawn by:	Scale:	Date:
RKC	1:20@A1	15/07/13
Designed by:	Checked by:	Approved by:
FCG	AC	AC


File Ref.: X:\2009\2224970 - LB EALING - DOMINION ARTS CENTRE\ARCH\2D_SW_ELEVATIONS\224970-A-347.DWG - 20/06/11:42:40

Drawing No. 224970-A-347
Rev. C3

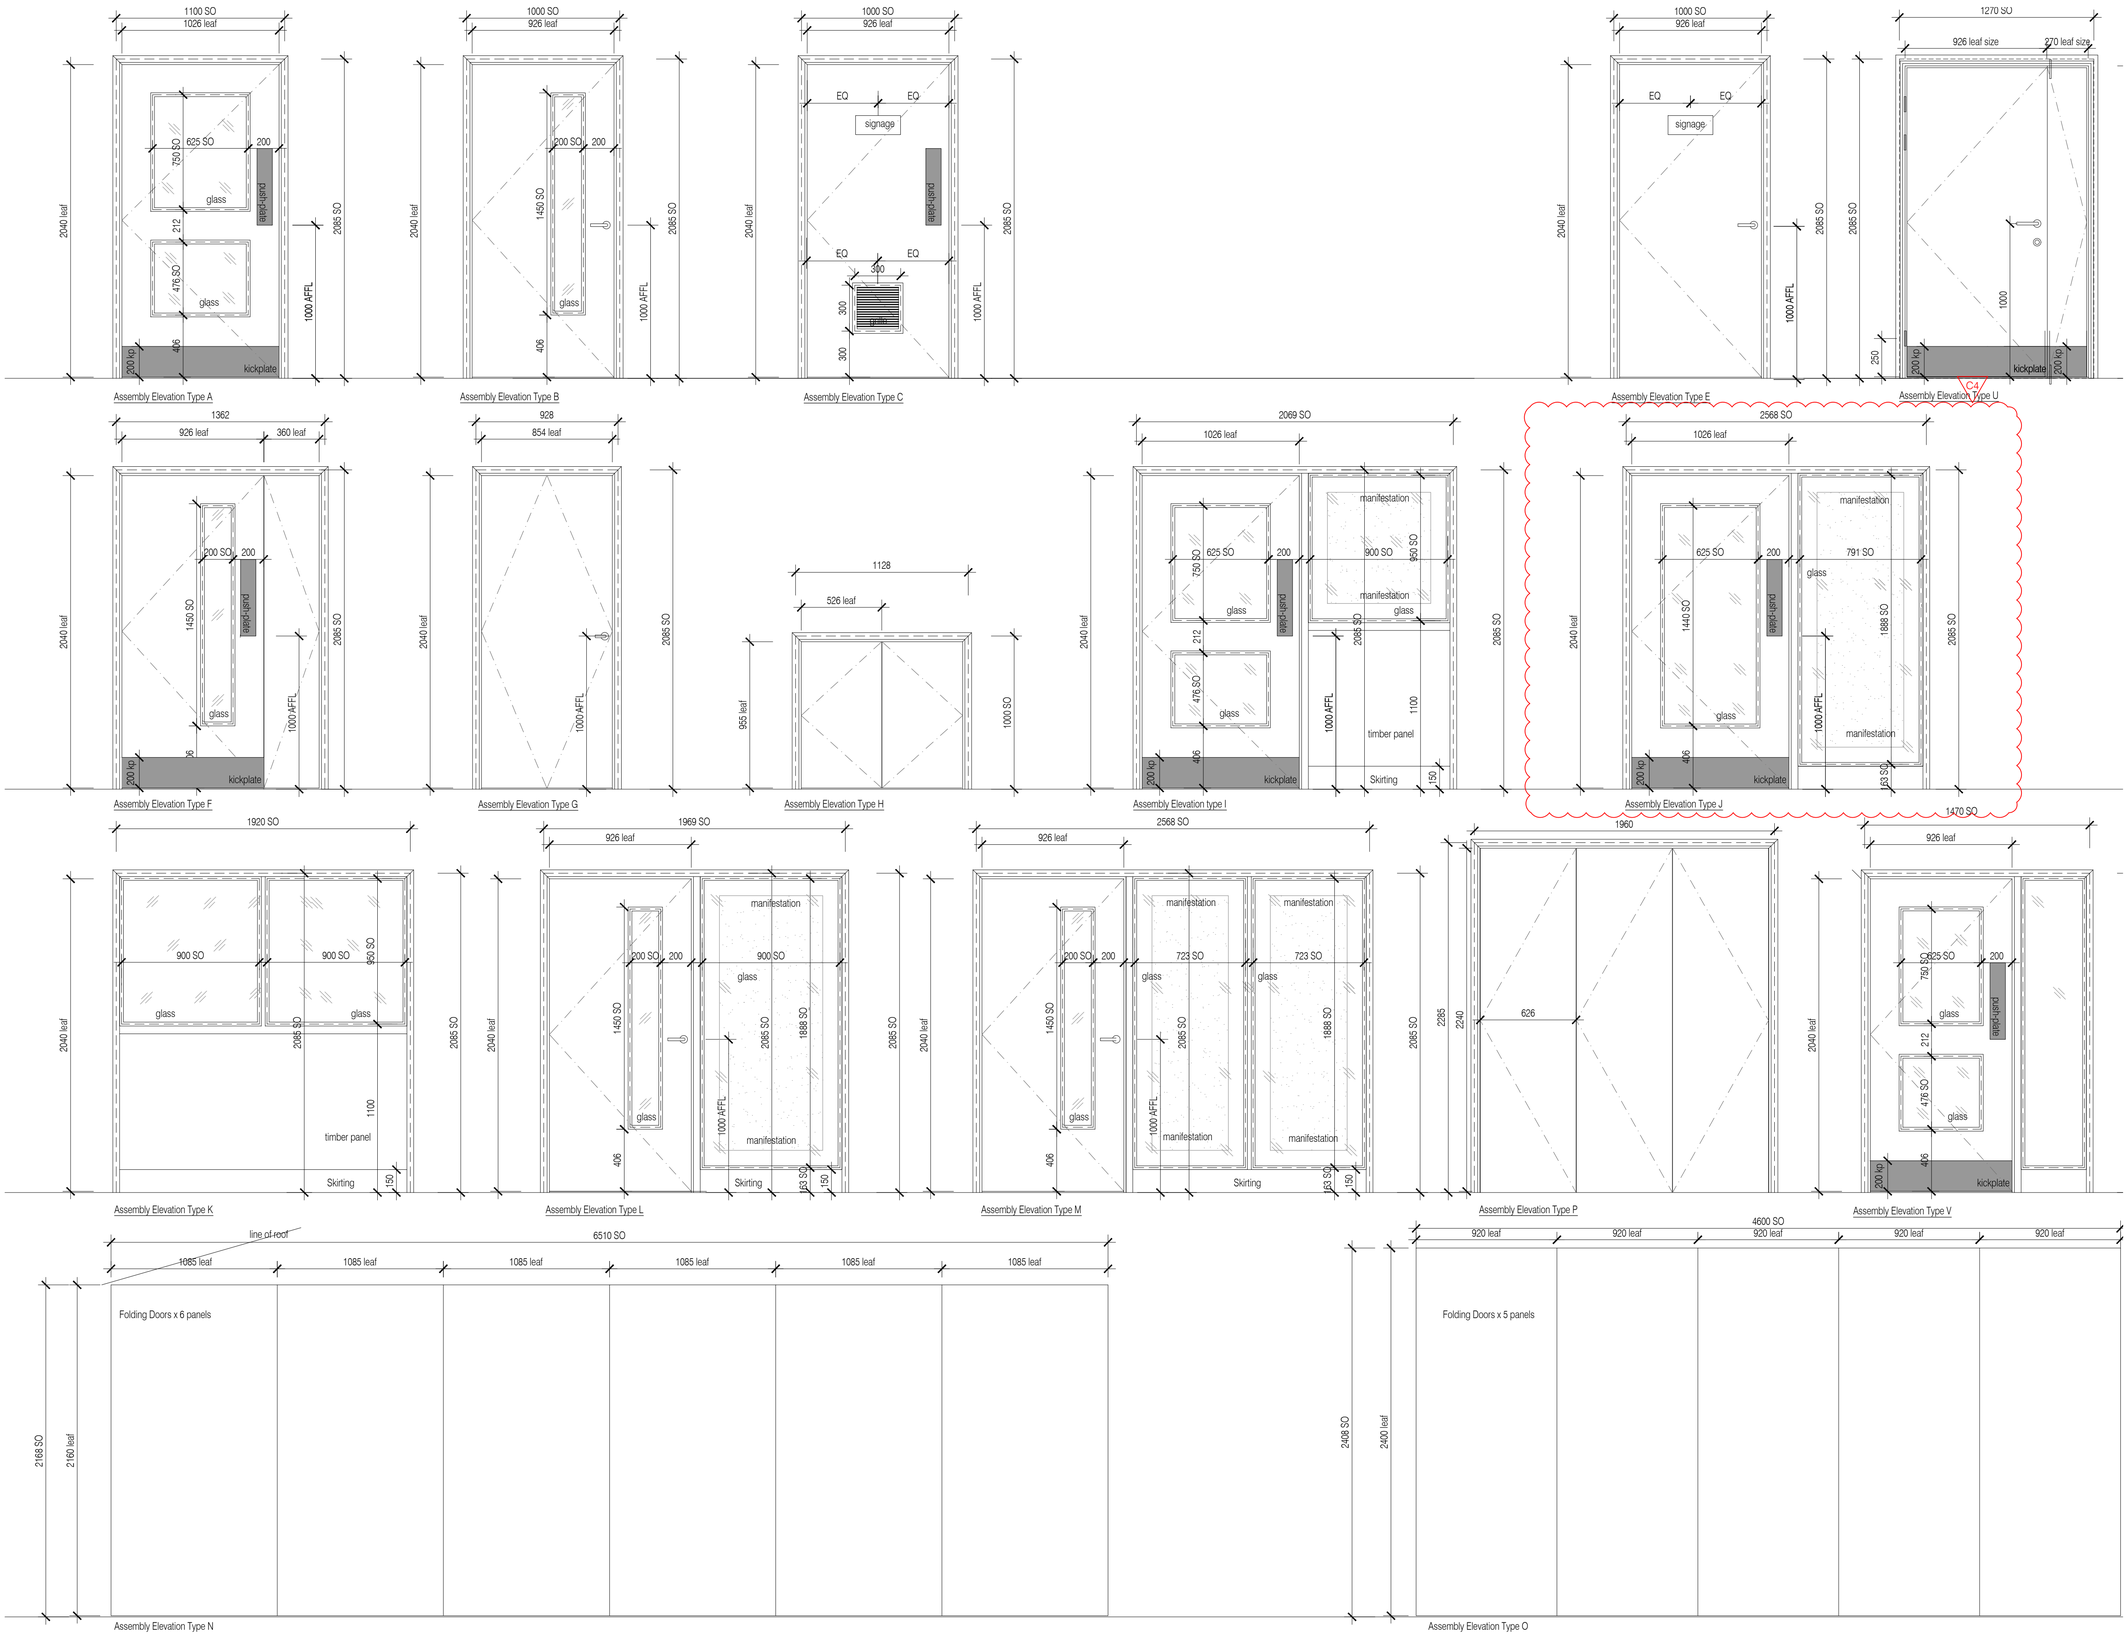

NOTES: Do not scale this drawing. All dimensions to be checked on site prior to commencement or manufacture.

Key Plan
(nts)

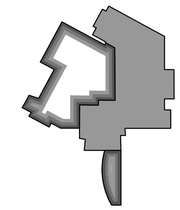

ISSUED FOR CONSTRUCTION

Rev	Date	By	Chk	Comment
C4	14.04.14	CH	AC	Type J adjusted
C3	06.12.2013	CH	AC	Type G revised
C2	28.08.13	CH	AC	Door Added
C1	03.07.13	RKC	JAS	Issued for CONSTRUCTION

BRINGING IDEAS TO LIFE

FRANKHAM

Frankham Consultancy Group Limited
21 Perrymount Road
Haywards Heath RH16 3TP
t 01444 444900 f 01444 456642
enquire@frankham.com
www.frankham.com

Client
Ealing
www.ealing.gov.uk


Project Title
Dominion Arts Centre
Southall
London

Drawing Title
Door & Screen Elevations


Drawn by:	Scale:	Date:
RKC	1:20@A1	15.03.13
Designed by:	Checked by:	Approved by:
FCG	CH	AC

File Ref.: X:\2009\224970 - EALING - DOMINION ARTS CENTRE\ARCH\2D_356_ELEVATIONS\224970-A-350.DWG - 2009/11/4/248 20:06:11/13:47:48


Drawing No. 224970-A-350
Rev. C4

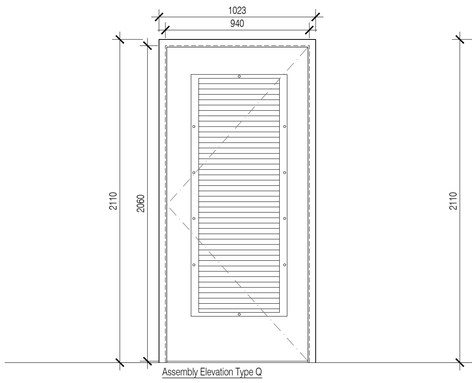


Assembly Elevation Type Q

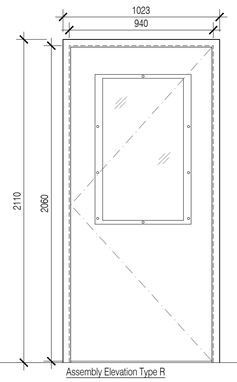


Assembly Elevation Type R

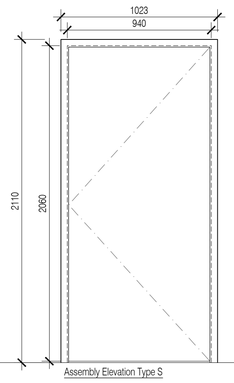

Assembly Elevation Type S

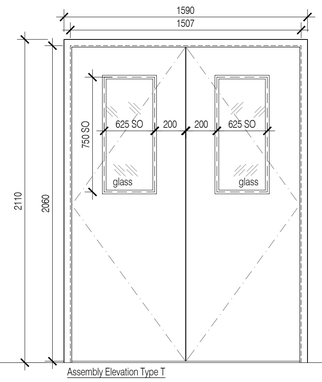


Assembly Elevation Type T

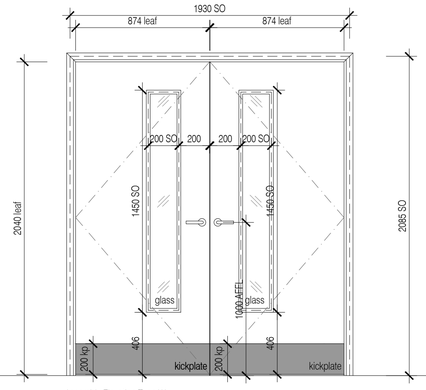

Assembly Elevation Type W

NOTES: Do not scale this drawing. All dimensions to be checked on site prior to commencement or manufacture.

Key Plan
(nts)

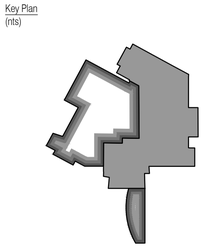

ISSUED FOR CONSTRUCTION

Rev	Date	By	Chk	Comment
C1	03.07.13	RKC	JAS	Issued for CONSTRUCTION

BRINGING IDEAS TO LIFE

FRANKHAM

Frankham Consultancy Group Limited
21 Perrymount Road
Haywards Heath RH16 3TP
t 01444 444900 f 01444 455642
enquire@frankham.com
www.frankham.com

Client

Ealing
www.ealing.gov.uk

Project Title

Dominion Arts Centre
Southall
London

Drawing Title


External
Door Elevations

Drawn by:	Scale:	Date:
RKC	1:20@A1	08.05.13
Designed by:	**Checked by:**	**Approved by:**
FCG	CH	AC


File Ref.: K:\2000\[224970 - LB EALING - DOMINION ARTS CENTRE\ARCH\DB_SW_ELEVATIONS_224970-A-351.DWG - 2008111425M

20.06.11 13:43:57


Drawing No. 224970-A-351 Rev. C1

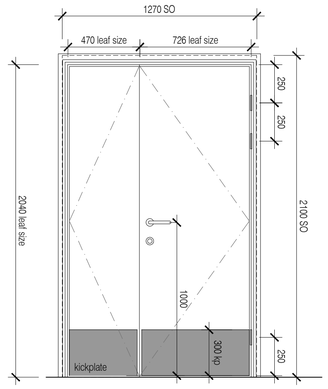


01 New Door To Store Cupboard In Hall - GA-07 Hall Elevation
Scale:1:20@A1

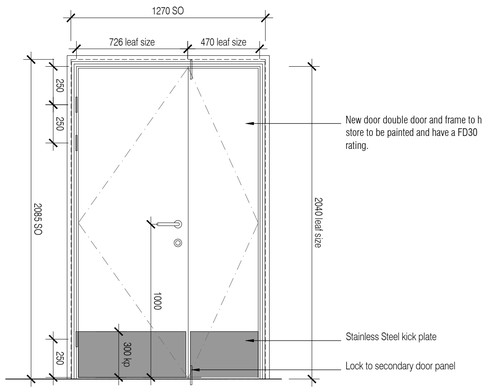


02 New Door To Store Cupboard In Hall - Store Room Elevation
Scale:1:20@A1

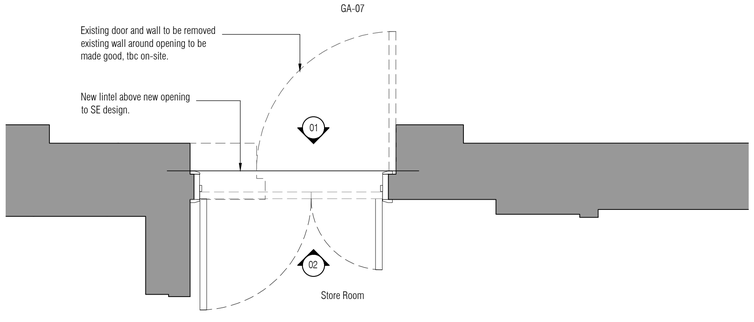


03 New Door To Store Cupboard In Hall - Plan
Scale:1:20@A1

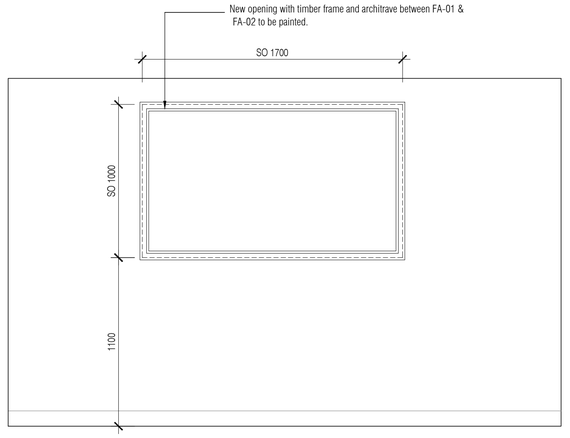

C2
04 New Opening - FA-02 Elevation
Scale:1:20@A1

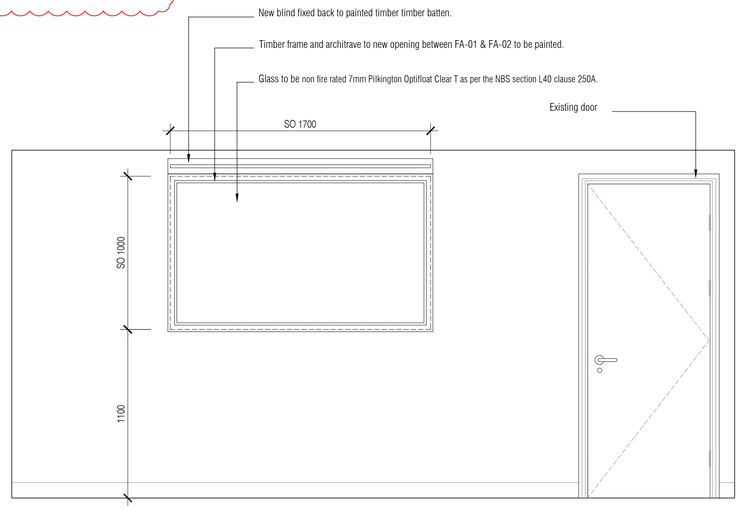

C2
05 New Opening - FA-01 Elevation
Scale:1:20@A1

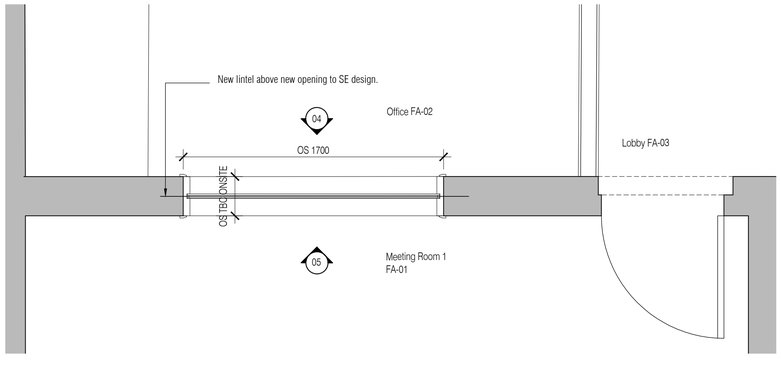

06 New Opening - Plan
Scale:1:20@A1

NOTES

1. All structural opening sizes are to be checked on site prior to manufacture of door linings/frames and leafs. Specialist door supplier is responsible for all handing of door leafs as shown on the General Arrangement Floor Plans.

2. Pack size stated to jamb is based on a nominal 32 mm frame/lining thickness, and should be adjusted to suit specialist door suppliers standard dimensions. Refer to detail drawings for more information.

3. Door leaf thicknesses to be determined by the specialist door supplier, based on the fire and acoustic requirements provided.

4. Door stop sizes to be determined by the specialist door supplier, in accordance with the fire requirements provided.

5. Acoustic and fire seals specification to be determined by the specialist door supplier, in accordance with the fire and acoustic requirements provided.


6. Final lining details to be determined by the specialist door supplier.

7. Refer also to FCG NBS work-sections L20 + L40 generally.

8. Doors with masonry construction generally have an S.O. height of 2085mm, and doors with drywall constructio generally have an S.O. height of 2085mm; unless otherwise noted.

NOTES: Do not scale this drawing. All dimensions to be checked on site prior to commencement or manufacture.

Key Plan
(nts)

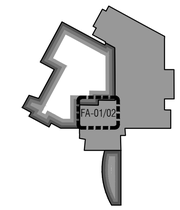

CONSTRUCTION ISSUE

Rev	Date	By	Chk	Comment
C2	05.08.13	CH	AC	Room ref adjusted
C1	30.07.13	PR	AC	CONSTRUCTION ISSUE

BRINGING IDEAS TO LIFE

FRANKHAM

Frankham Consultancy Group Limited
21 Perrymount Road
Haywards Heath RH16 3TP
t 01444 444900 f 01444 455642
enquire@frankham.com
www.frankham.com

Client
Ealing
www.ealing.gov.uk


Project Title
Dominion Arts Centre
Southall
London

Drawing Title
Proposed Room Elevations
FA-02 New Opening &
FA-07 New Door To Store


Drawn by:	Scale:	Date:
RKC	1:20@A1	19/07/13
Designed by:	Checked by:	Approved by:
FCG	AC	AC

File Ref.: X:\2000\2224970 - LB EALING - DOMINION ARTS CENTRE\ARCH\2DWG_DWL\224970-A-352.DWG - 2008111A3D3 20.08.11 13:43:04


Drawing No. 224970-A-352 Rev. C2

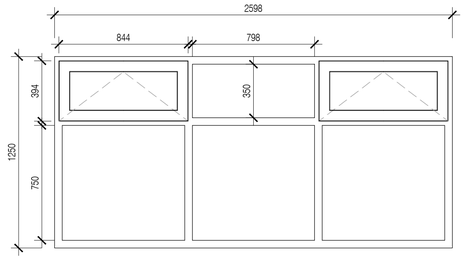


Assembly Type 1

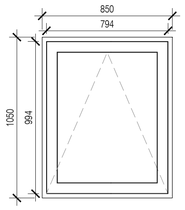


Assembly Type 2

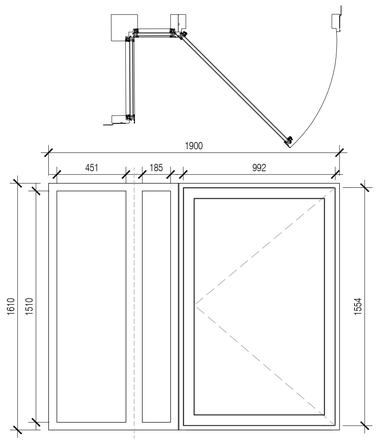


Assembly Type 3

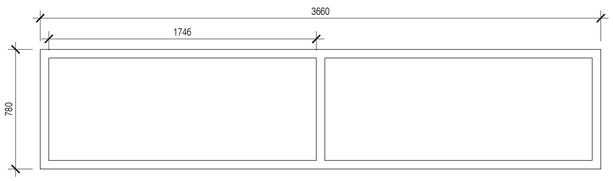


Assembly Type 4

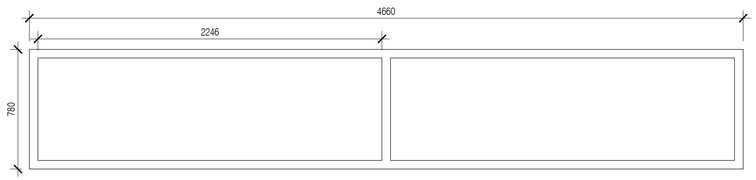


Assembly Type 5

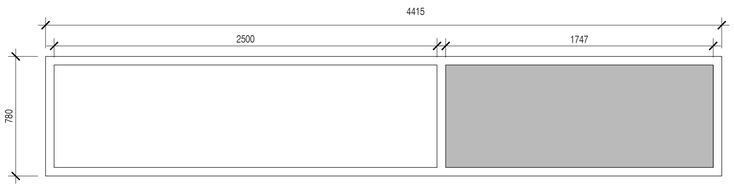


Assembly Type 6

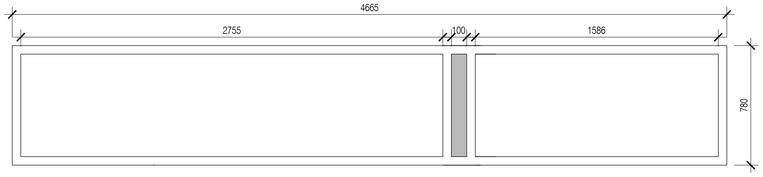

Assembly Type 7

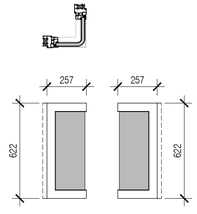


Assembly Type 8

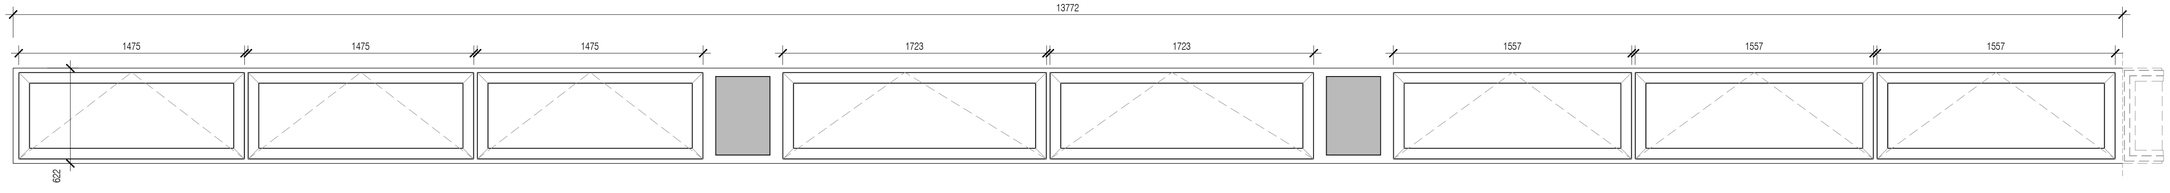

Assembly Type 9

NOTES: Do not scale this drawing. All dimensions to be checked on site prior to commencement or manufacture.

Key Plan
(nts)

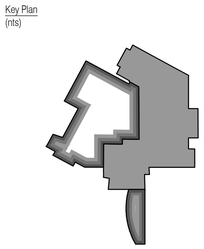

ISSUED FOR CONSTRUCTION

Rev	Date	By	Chk	Comment
C3	08.11.13	CH	AC	Win types 4/5/6/7 adjusted
C2	05.11.13	CH	AC	Win types 4/5/6/7 adjusted
C1	03.07.13	RKC	JAS	Issued for CONSTRUCTION

BRINGING IDEAS TO LIFE

FRANKHAM

Frankham Consultancy Group Limited
21 Perrymount Road
Haywards Heath RH16 3TP
t 01444 444900 f 01444 455642
enquire@frankham.com
www.frankham.com

Client

Ealing
www.ealing.gov.uk

Project Title

Dominion Arts Centre
Southall
London

Drawing Title


Window Elevations
1 of 4

Drawn by:	Scale:	Date:
RKC	1:20@A1	24.03.13
Designed by:	Checked by:	Approved by:
FCG	-	-


File Ref.: K:\2000\2224970 - LEALING - DOMINION ARTS CENTRE\ARCH\DWG_SRC_ELEVATIONS\224970-A-360.DWG - 2008113431

20:06:11 13:43:12


Drawing No.	Rev.
224970-A-360	C3

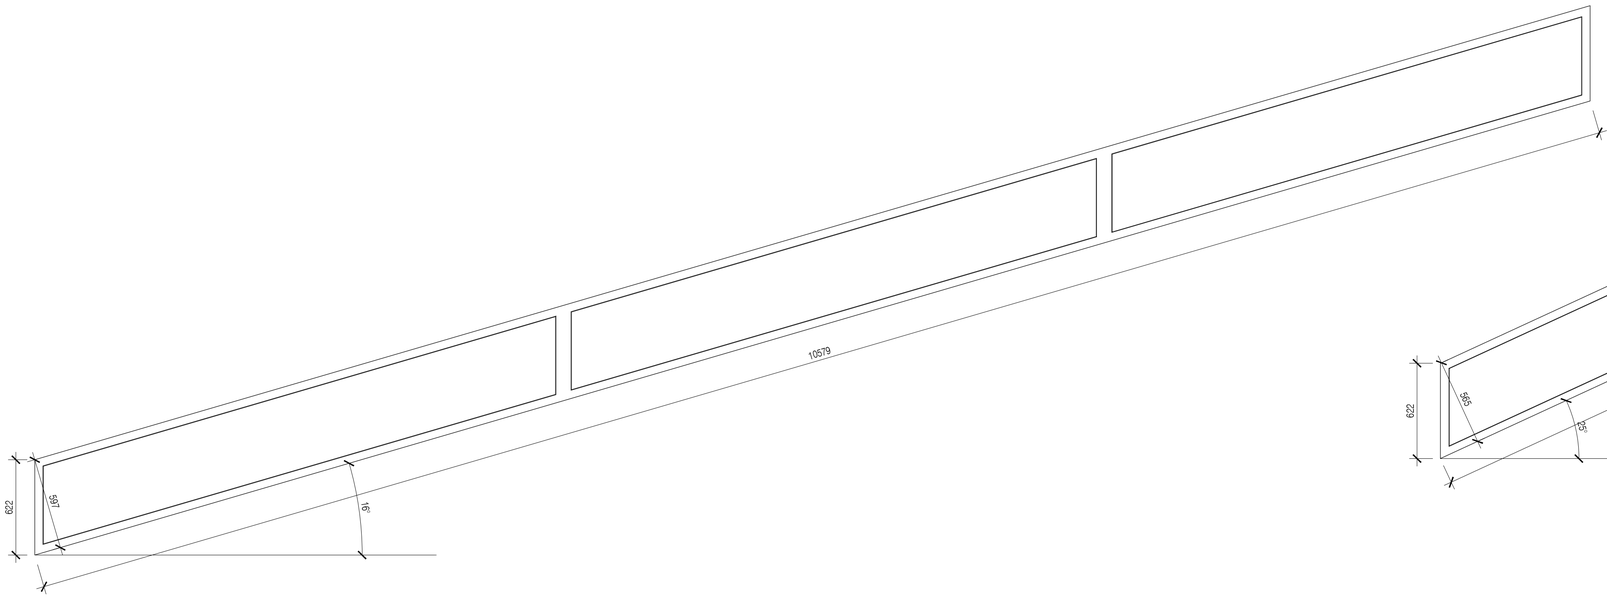


Assembly Type 10

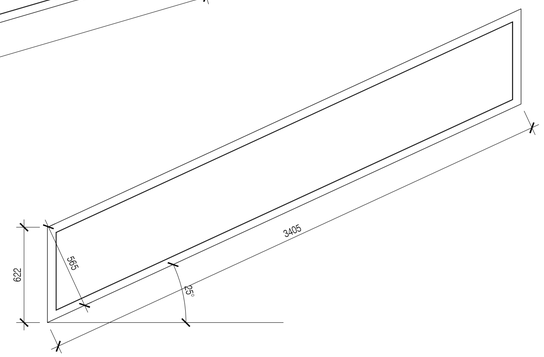


Assembly Type 11

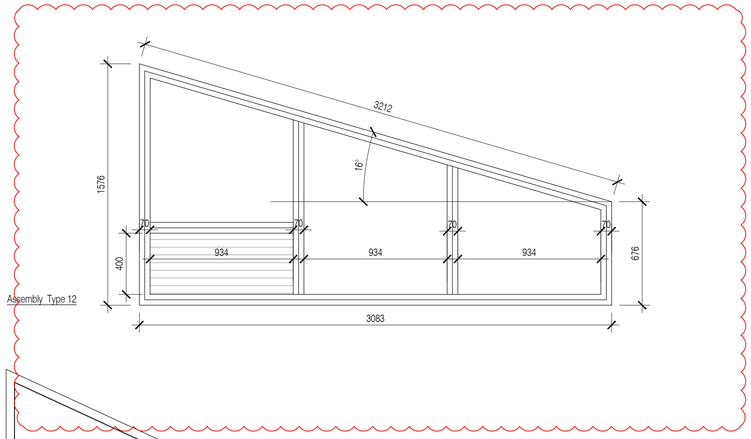

Assembly Type 12

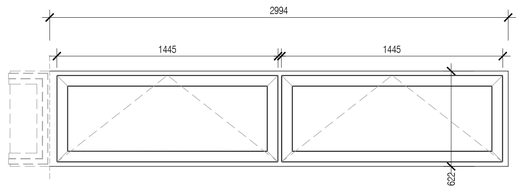


Assembly Type 13

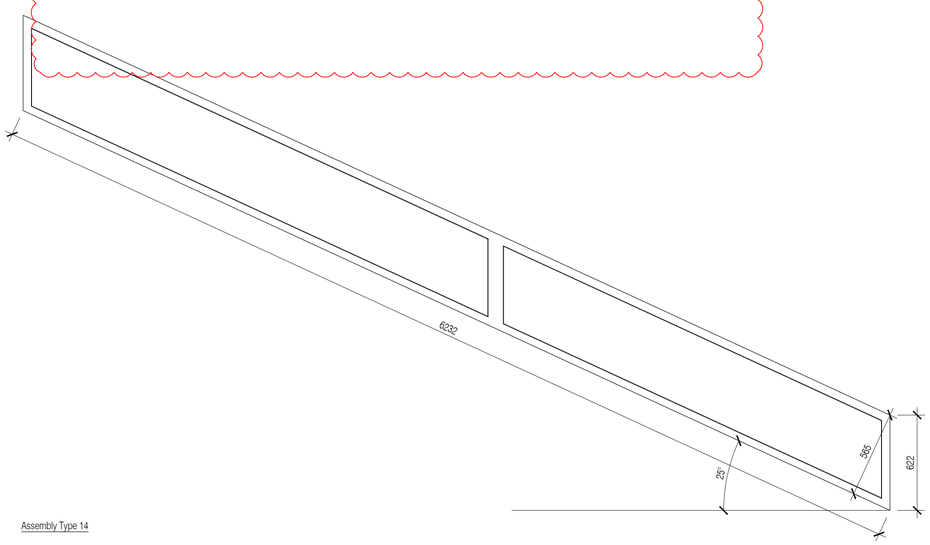

Assembly Type 14

NOTES: Do not scale this drawing. All dimensions to be checked on site prior to commencement or manufacture.

Key Plan
(nts)

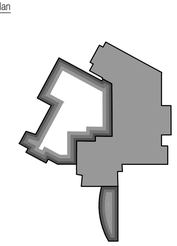

ISSUED FOR CONSTRUCTION

Rev	Date	By	Chk	Comment
C3	08.11.13	CH	AC	Window adjustment
C2	17.10.13	CH	AC	Window adjustments
C1	03.07.13	RKC	JAS	Issued for CONSTRUCTION

BRINGING IDEAS TO LIFE

FRANKHAM

Frankham Consultancy Group Limited
21 Perrymount Road
Haywards Heath RH16 3TP
t 01444 444900 f 01444 455642
enquire@frankham.com
www.frankham.com

Client
Ealing
www.ealing.gov.uk


Project Title
Dominion Arts Centre
Southall
London

Drawing Title
Window Elevations
2 of 4


Drawn by:	Scale:	Date:
RKC	1:20@A1	24.03.13
Designed by:	Checked by:	Approved by:
FCG	-	-

File Ref.: X:\2009\0224970 - LB EALING - DOMINION ARTS CENTRE\ARCH\LBE_DM_ELEVATIONS.21MTA-A-361.DWG - 2009/11/0218 20.06.11 13:43:19


Drawing No.	Rev.
224970-A-361	C3

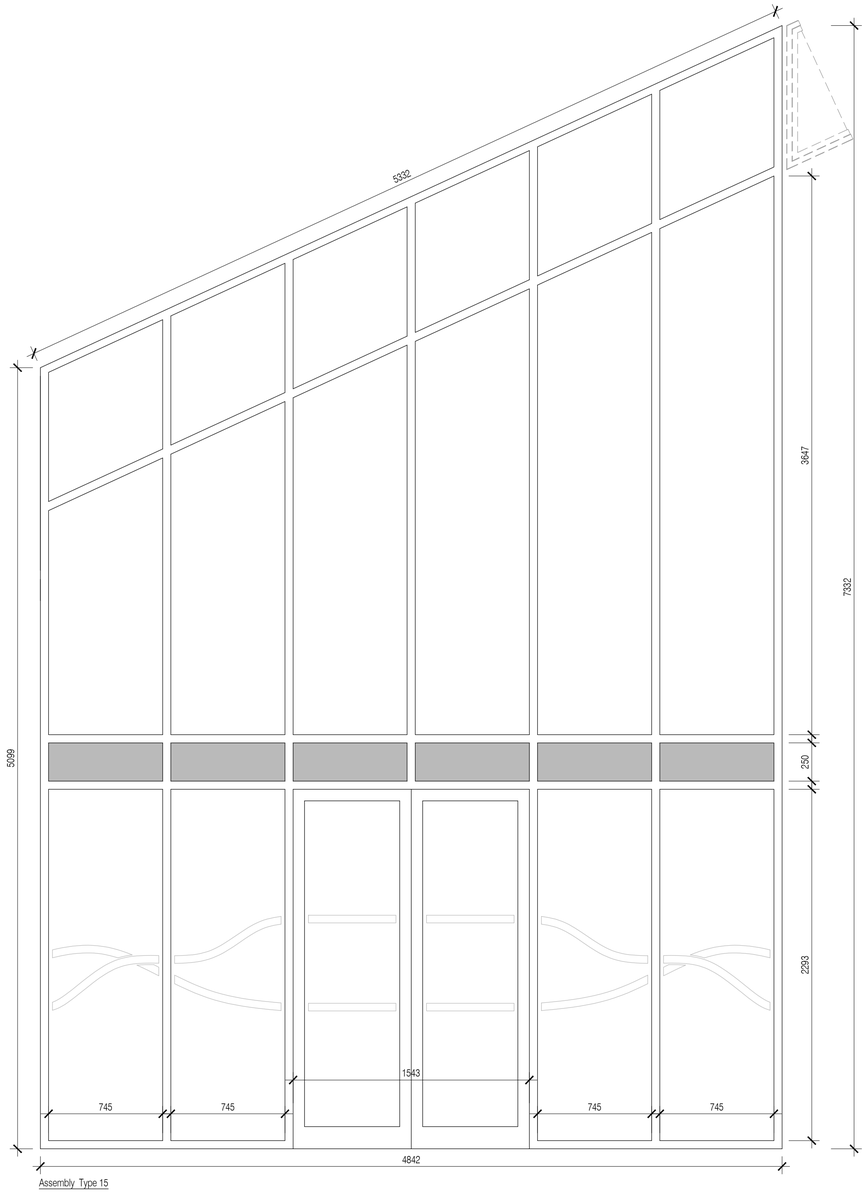

Assembly Type 15

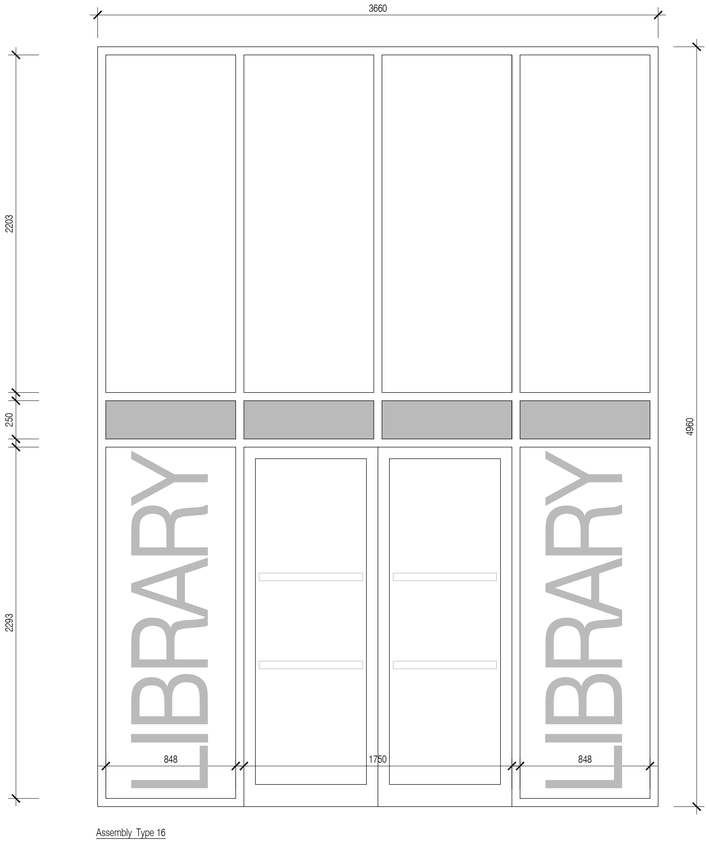


Assembly Type 16

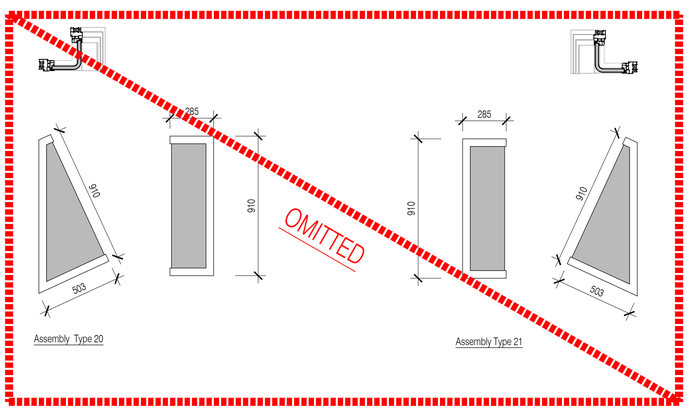


Assembly Type 20


Assembly Type 21

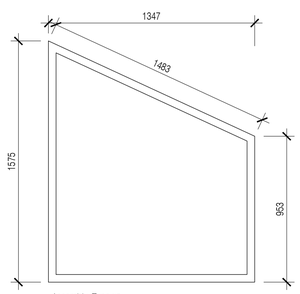

Assembly Type 17

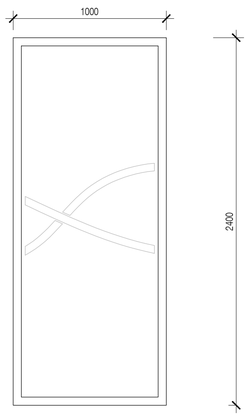


Assembly Type 18

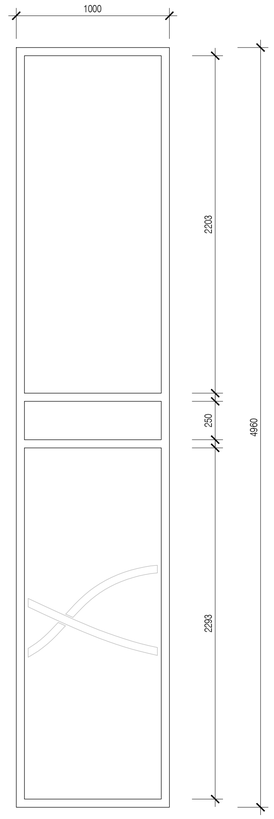

Assembly Type 19

NOTES: Do not scale this drawing. All dimensions to be checked on site prior to commencement or manufacture.

Key Plan
(nts)

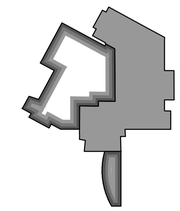

ISSUED FOR CONSTRUCTION

Rev	Date	By	Chk	Comment
C3	28.01.14	CH	AC	Manifestation adjusted
C2	27.01.13	CH	AC	Manifestation adjusted
C1	03.07.13	RKC	JAS	Issued for CONSTRUCTION

BRINGING IDEAS TO LIFE

FRANKHAM

Frankham Consultancy Group Limited
21 Perrymount Road
Haywards Heath RH16 3TP
t 01444 444900 f 01444 455642
enquire@frankham.com
www.frankham.com

Client
Ealing
www.ealing.gov.uk


Project Title
Dominion Arts Centre
Southall
London

Drawing Title
Window Elevations
3 of 4


Drawn by:	Scale:	Date:
RKC	1:20@A1	24.03.13
Designed by:	Checked by:	Approved by:
FCG	-	-

File Ref.: X:\2008\2124\01 - LB EALING - DOMINION ARTS CENTRE\ARCH\DB_3M_ELEVATIONS-21457-A-362.DWG - 2008/11/24/26 20.06.11 13:43:27


Drawing No. 224970-A-362
Rev. C3

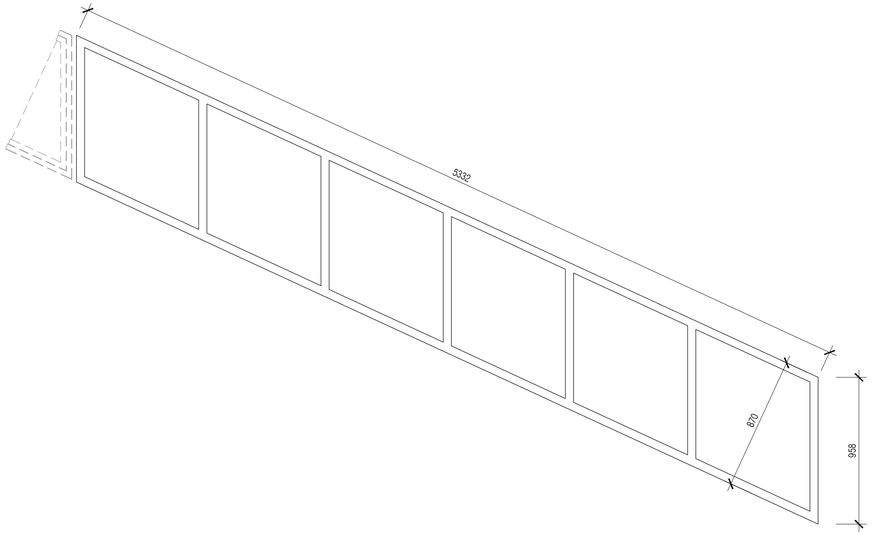


Assembly Type 22

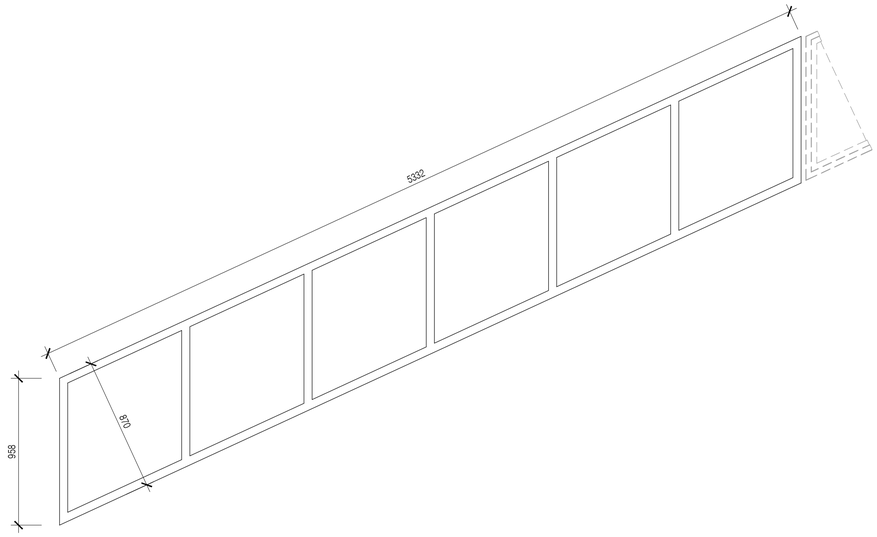


Assembly Type 23

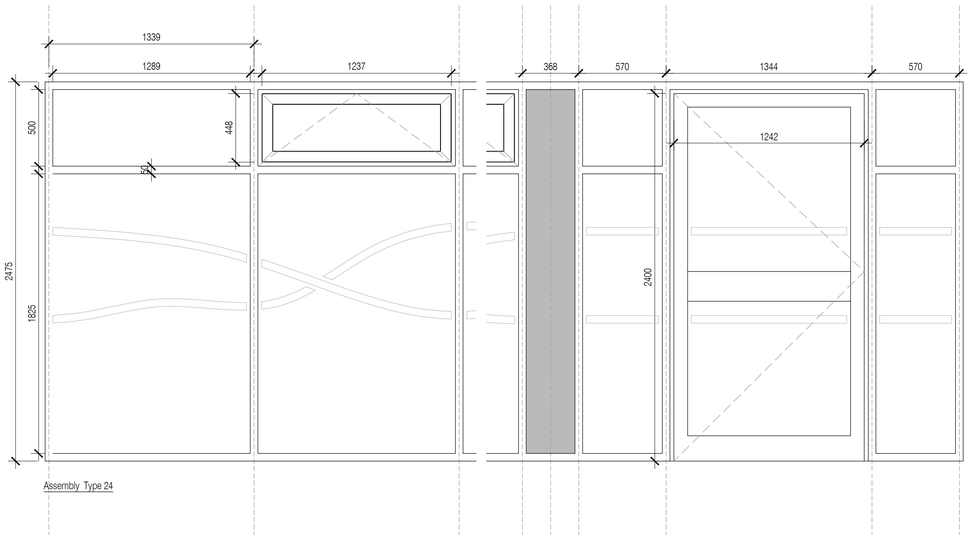


Assembly Type 24

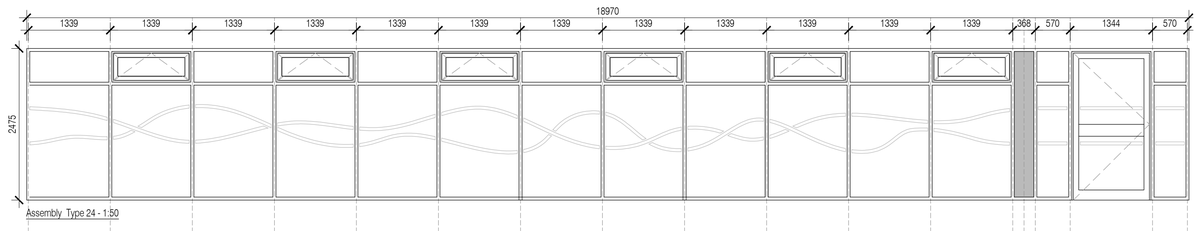


Assembly Type 24 - 1:50

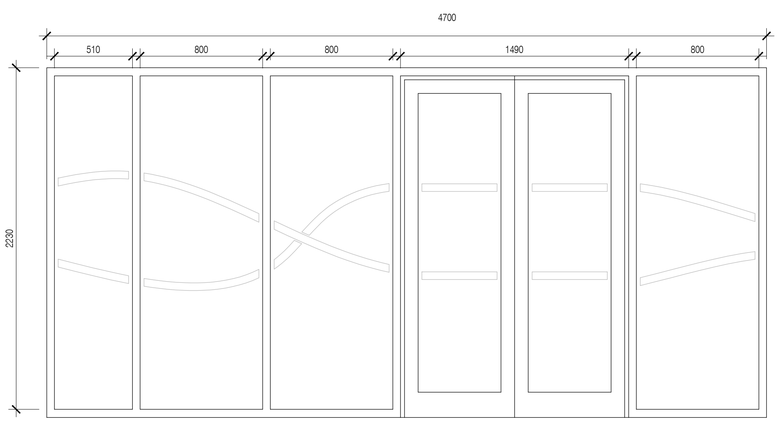

Assembly Type 25

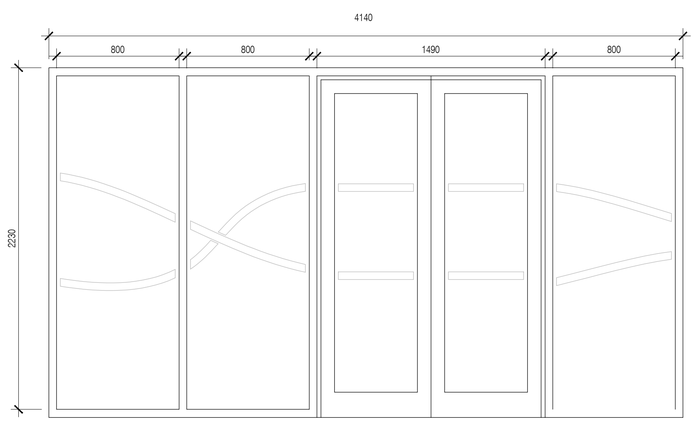


Assembly Type 26

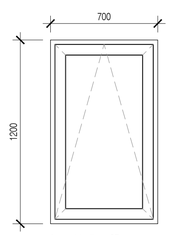

Assembly Type 27

NOTES: Do not scale this drawing. All dimensions to be checked on site prior to commencement or manufacture.

Key Plan
(nts)

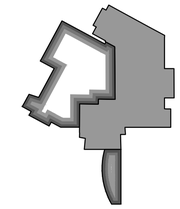

ISSUED FOR CONSTRUCTION

Rev	Date	By	Chk	Comment
C3	28.01.14	CH	AC	Manifestations adjusted
C2	27.01.14	CH	AC	Manifestations adjusted
C1	03.07.13	RKC	JAS	Issued for CONSTRUCTION

BRINGING IDEAS TO LIFE

FRANKHAM

Frankham Consultancy Group Limited
21 Perrymount Road
Haywards Heath RH16 3TP
t 01444 449000 f 01444 455642
enquire@frankham.com
www.frankham.com

Client

Ealing
www.ealing.gov.uk

Project Title

Dominion Arts Centre
Southall
London

Drawing Title


Window Elevations
4 of 4

Drawn by:	Scale:	Date:
RKC	1:20@A1	24.03.13
Designed by:	Checked by:	Approved by:
FCG	-	-

File Ref.: I:\2009\02\224970 - LB EALING - DOMINION ARTS CENTRE\ARCH\200_399_ELEVATIONS\224970-A-363.DWG - 20/06/11 13:43:37

Drawing No.	Rev.
224970-A-363	C3

This is a rough note example of text for sizing and shaping purposes

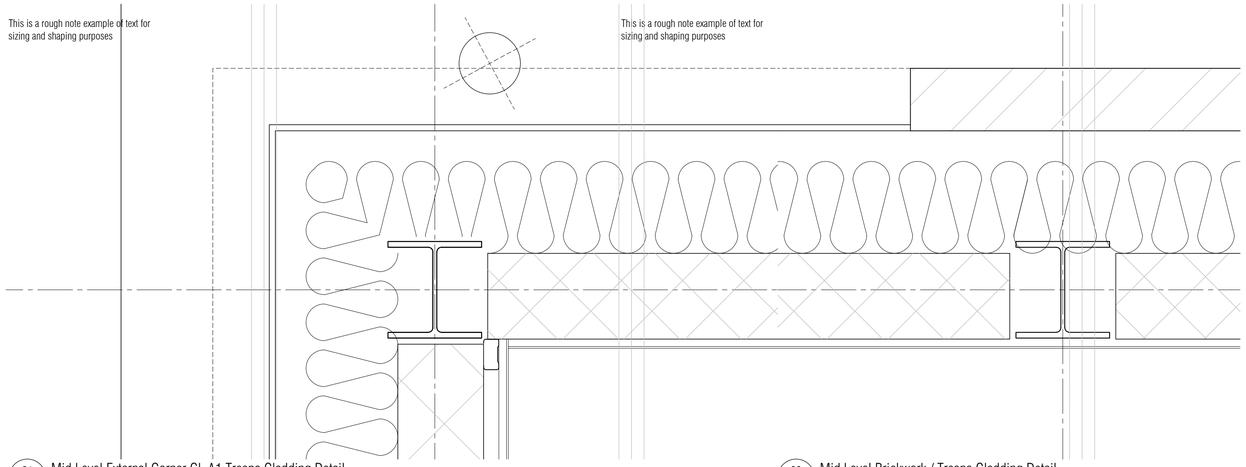


01 Mid Level External Corner GL A1 Trespa Cladding Detail
Scale: 1:5

This is a rough note example of text for sizing and shaping purposes

03 Mid Level Brickwork / Trespa Cladding Detail
Scale: 1:5

This is a rough note example of text for sizing and shaping purposes

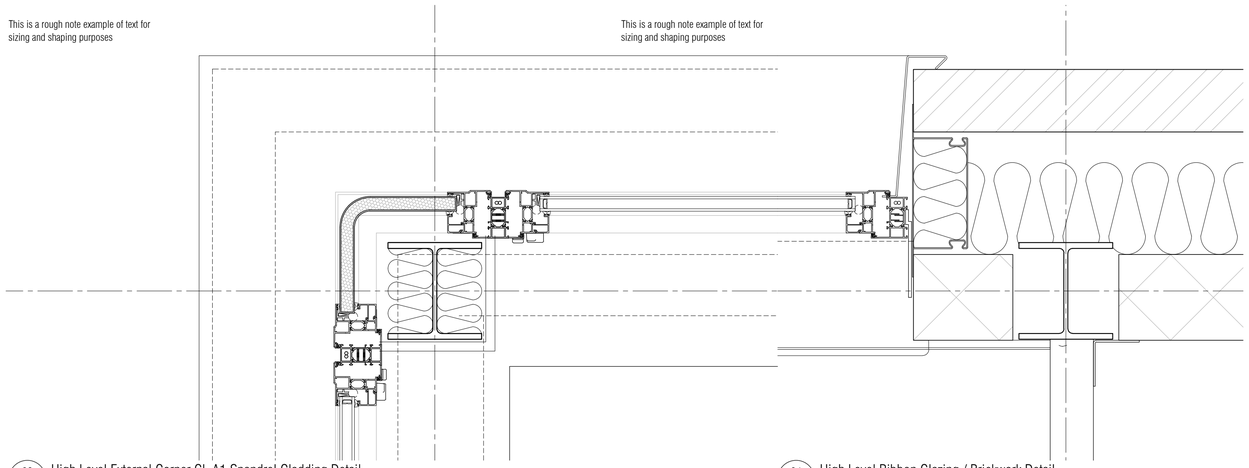


02 High Level External Corner GL A1 Spandrel Cladding Detail
Scale: 1:5

This is a rough note example of text for sizing and shaping purposes

04 High Level Ribbon Glazing / Brickwork Detail
Scale: 1:5


This is a rough note example of text for sizing and shaping purposes

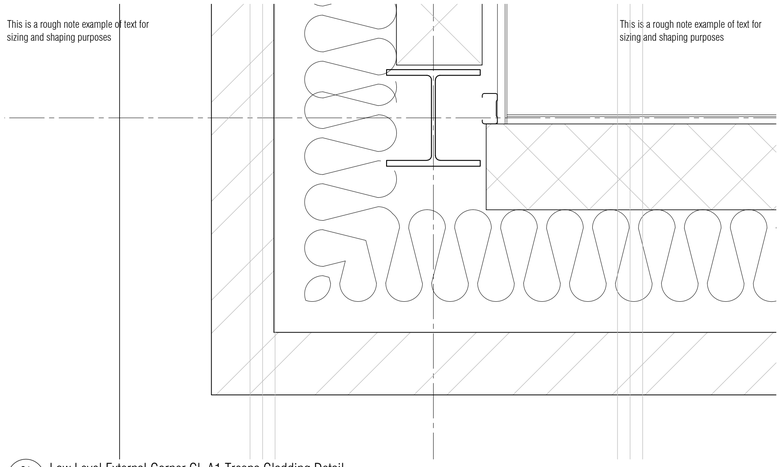

01 Low Level External Corner GL A1 Trespa Cladding Detail
Scale: 1:5


This is a rough note example of text for sizing and shaping purposes

C2

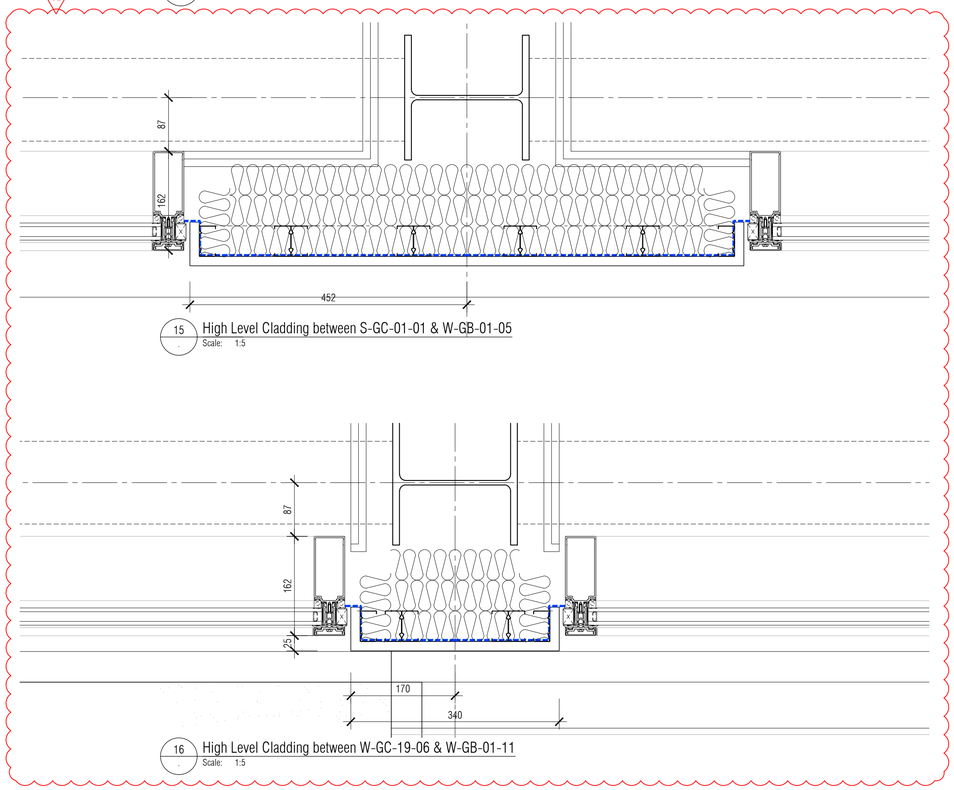


15 High Level Cladding between S-GC-01-01 & W-GB-01-05
Scale: 1:5


16 High Level Cladding between W-GC-19-06 & W-GB-01-11
Scale: 1:5

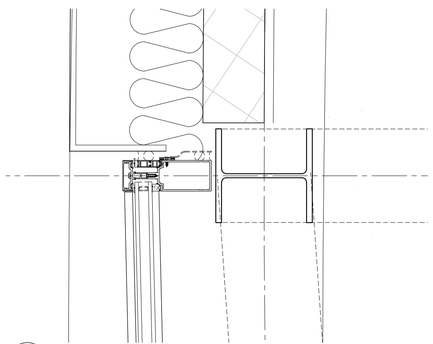


10 / 120 Trespa Interface with Kawneer Cafe Curtain Walling
Scale: 1:5

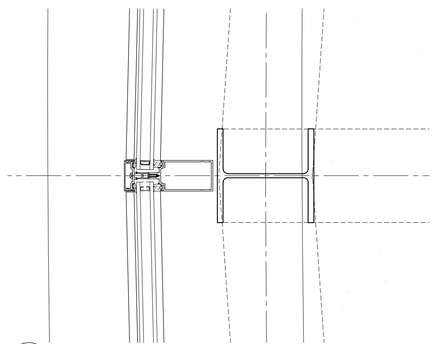

11 / 120 Mullion of Facetted Kawneer Cafe Curtain Walling
Scale: 1:5

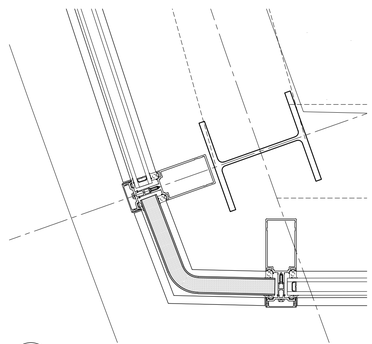

12 / 120 Spandrel Return of Kawneer Cafe Curtain Walling
Scale: 1:5

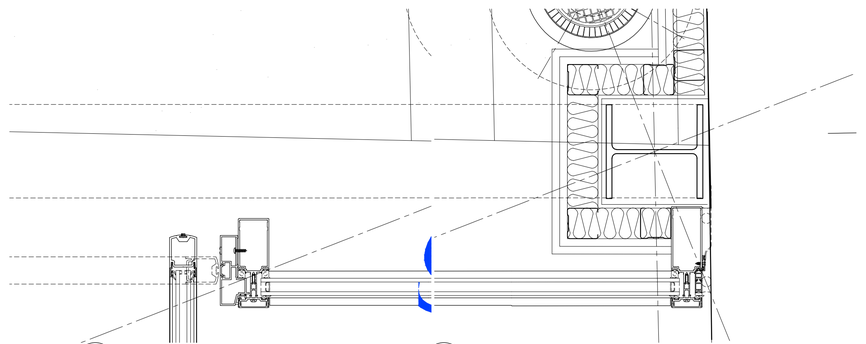


13 / 120 Door Jamb of Kawneer Cafe Curtain Walling
Scale: 1:5

14 / 120 End of Kawneer Cafe Curtain Walling to Existing Adjacent Wall
Scale: 1:5

NOTES: Do not scale this drawing. All dimensions to be checked on site prior to commencement or manufacture.

Key Plan
(nts)

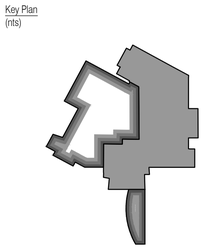

ISSUED FOR CONSTRUCTION

Rev	Date	By	Chk	Comment
C2	08.01.14	CH	AC	ISSUED FOR CONSTRUCTION
C1	03.07.13	RKC	JAS	Issued for CONSTRUCTION

BRINGING IDEAS TO LIFE

FRANKHAM

Frankham Consultancy Group Limited
21 Perrymount Road
Haywards Heath RH16 3TP
t 01444 444900 f 01444 455642
enquire@frankham.com
www.frankham.com

Client
Ealing
www.ealing.gov.uk


Project Title
Dominion Arts Centre
Southall
London

Drawing Title
Plan
Details


Drawn by:	Scale:	Date:
RKC	1:50@A1	13.03.13
Designed by:	Checked by:	Approved by:
FCG	JAS	AGC

File Ref.: K:\2009\2224970 - LB EALING - DOMINION ARTS CENTRE\ARCHIVE_4B_DETAIL_SCHEMATICS\224970-A-400.DWG - 2009111.0427
20.06.11:13:44:43

Drawing No. 224970-A-400
Rev. C2

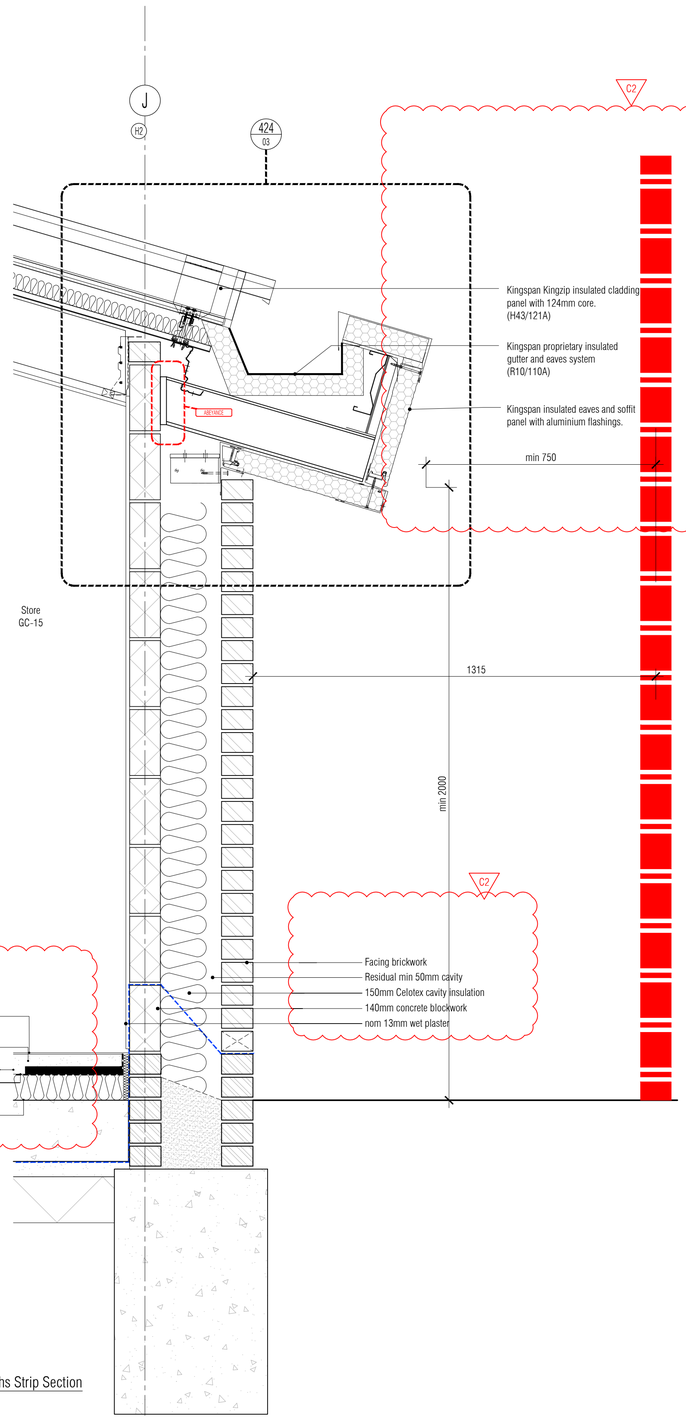


01 Minimum Escape Route Widths Strip Section
Scale: 1:10

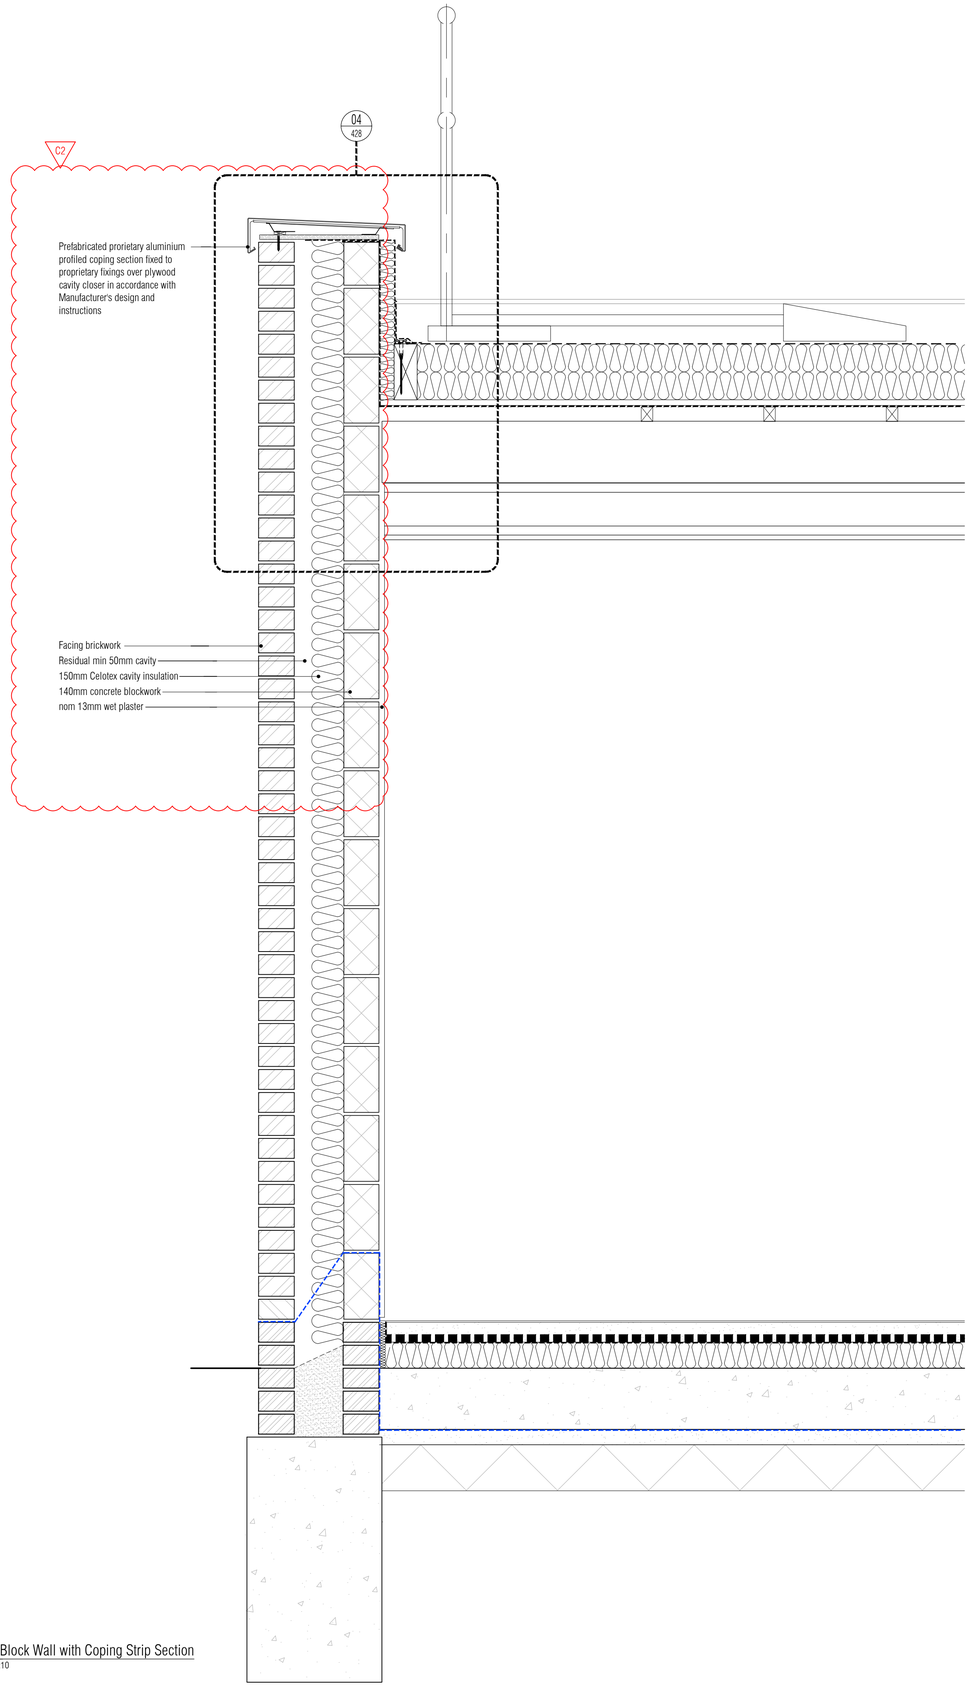

02 Brick / Block Wall with Coping Strip Section
Scale: 1:10

NOTES: Do not scale this drawing. All dimensions to be checked on site prior to commencement or manufacture.

Key Plan
(nts)

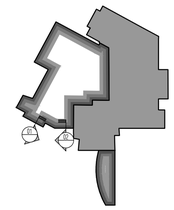

ISSUED FOR CONSTRUCTION

Rev	Date	By	Chk	Comment
C2	07.10.13	CH	AC	Annotation added
C1	03.07.13	RKC	JAS	Issued for CONSTRUCTION

BRINGING IDEAS TO LIFE

FRANKHAM

Frankham Consultancy Group Limited
21 Perrymount Road
Haywards Heath RH16 3TP
t 01444 449000 f 01444 455642
enquire@frankham.com
www.frankham.com

Client
Ealing
www.ealing.gov.uk


Project Title
Dominion Arts Centre
Southall
London

Drawing Title
Strip Sections
Details

Drawn by:	Scale:	Date:
RKC	1:50@A1	06.02.13
Designed by:	Checked by:	Approved by:
FCG	JAS	AGC

File Ref.: K:\2009\09224970 - LB EALING - DOMINION ARTS CENTRE\ARCH\400_499_DETAIL_SCHEMATICS\224970-A-410.DWG 20:06:11 13/44/57


Drawing No.	Rev.
224970-A-410	C2

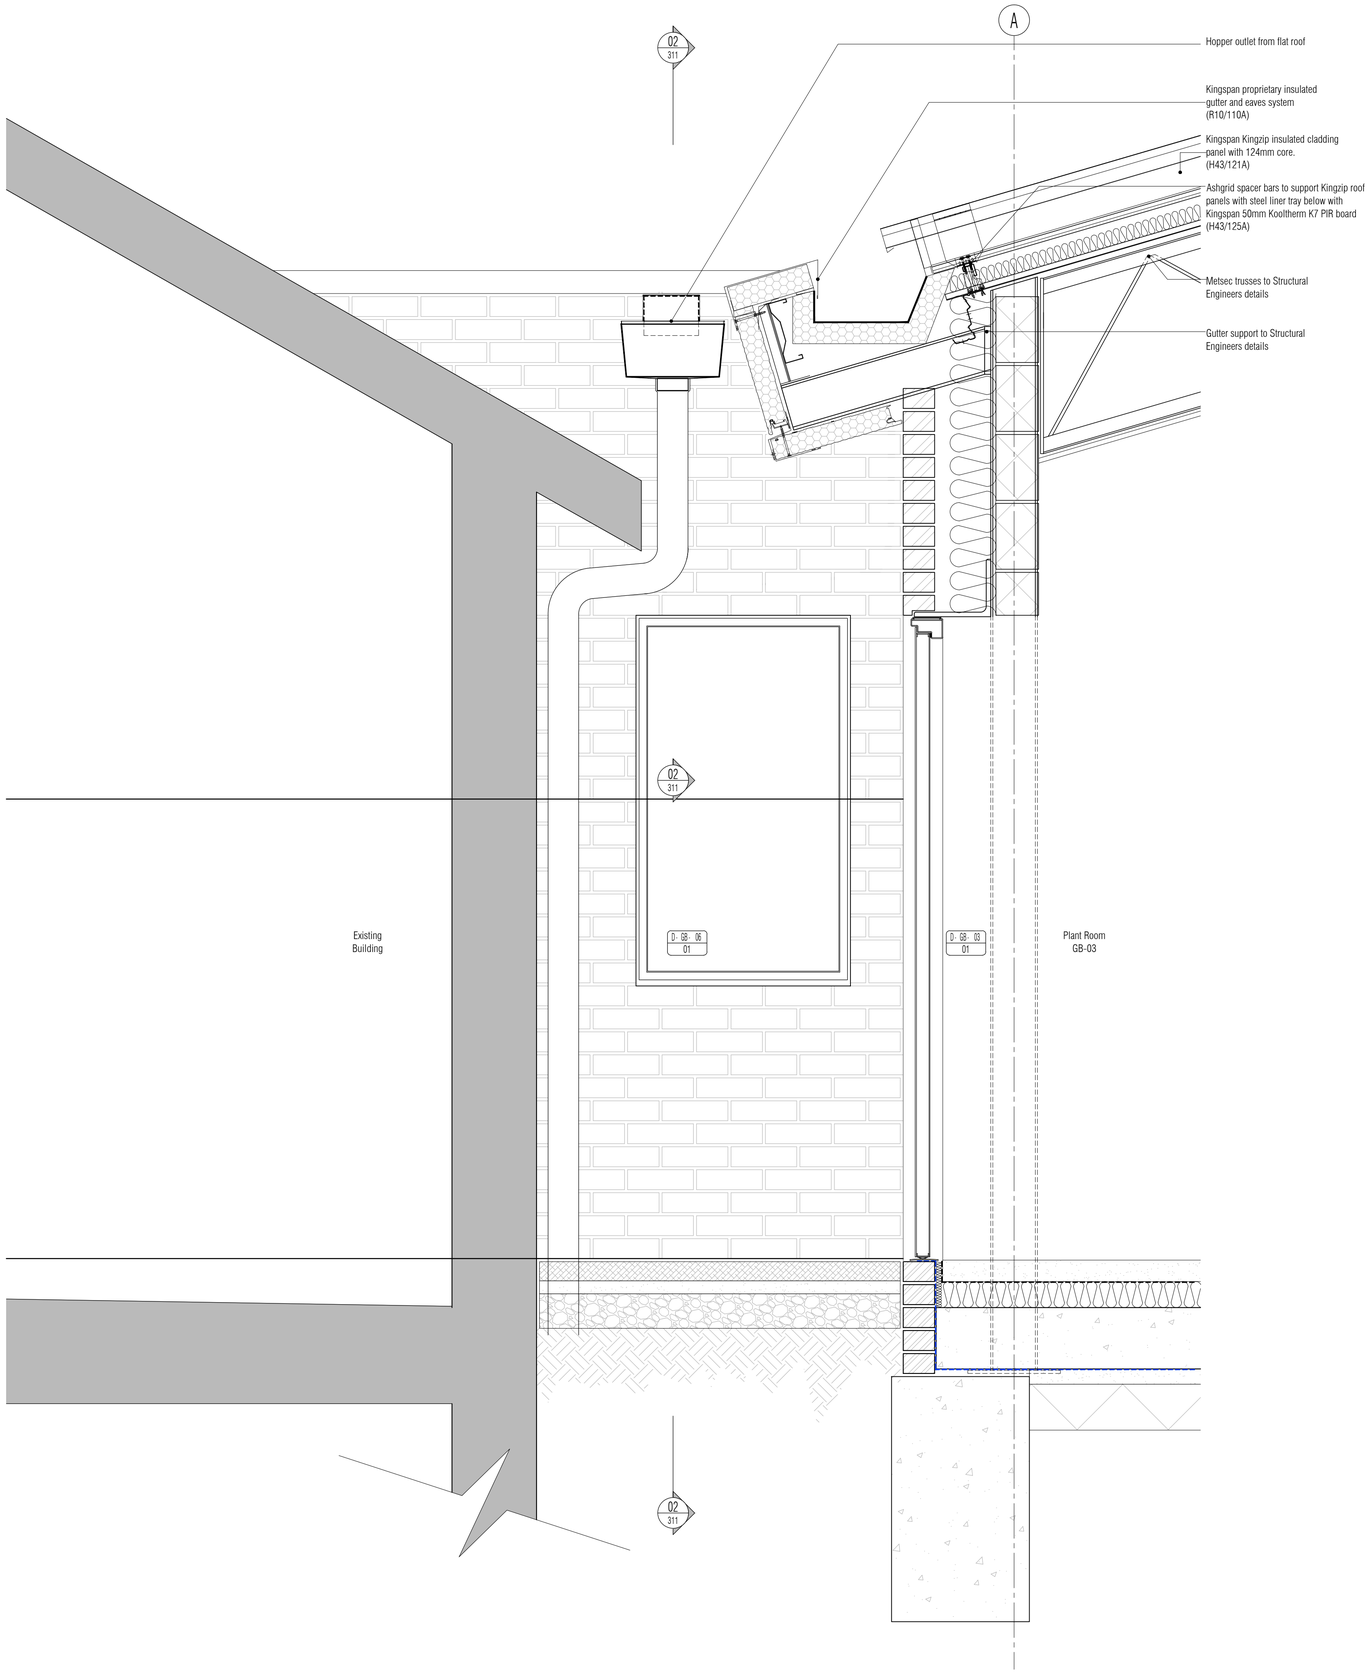

01 Section 17
Scale: 1:10

NOTES: Do not scale this drawing. All dimensions to be checked on site prior to commencement or manufacture.

Key Plan
(nts)

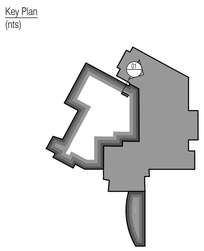

ISSUED FOR CONSTRUCTION

Rev	Date	By	Chk	Comment
C3	04.11.13	CH	AC	Parapet lowered
C2	07.10.13	CH	AC	Annotation added
C1	03.07.13	RKC	JAS	Issued for CONSTRUCTION

BRINGING IDEAS TO LIFE

FRANKHAM

Frankham Consultancy Group Limited
21 Perrymount Road
Haywards Heath RH16 3TP
t 01444 449000 f 01444 455642
enquire@frankham.com
www.frankham.com

Client
Ealing
www.ealing.gov.uk


Project Title
Dominion Arts Centre
Southall
London

Drawing Title
Strip Section between Existing Building and New Library thro' Entry Door DGB03-01 to Plant Room GB-03 and Elevation of Door DGB06-01 to Workroom GB-06 showing Parapet and RWP Hopper


Drawn by:	Scale:	Date:
RKC	1:10@A1	24.04.13
Designed by:	Checked by:	Approved by:
FCG	JAS	AGC

File Ref.: X:\2009\2224970 - LB EALING - DOMINION ARTS CENTRE\ARCH\ARD_4[8]_DETAIL_SCHEMATICS\224970-A-412.DWG - 20061114609 20.06.11:13:45:09


Drawing No.	Rev.
224970-A-412	C3

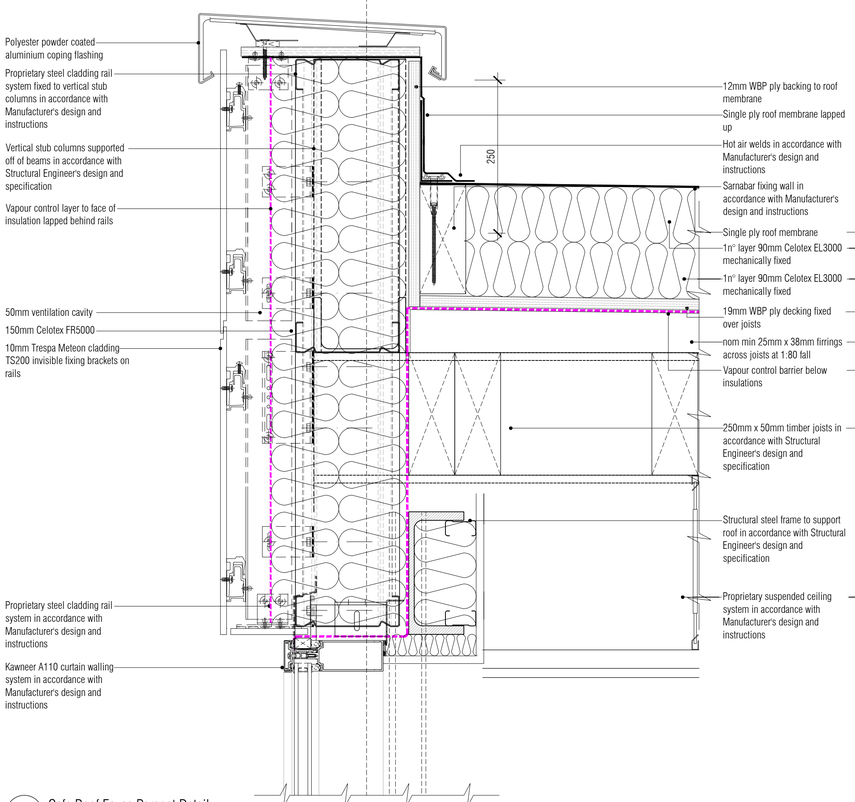


01 210 Cafe Roof Eaves Parapet Detail
Scale: 1:5

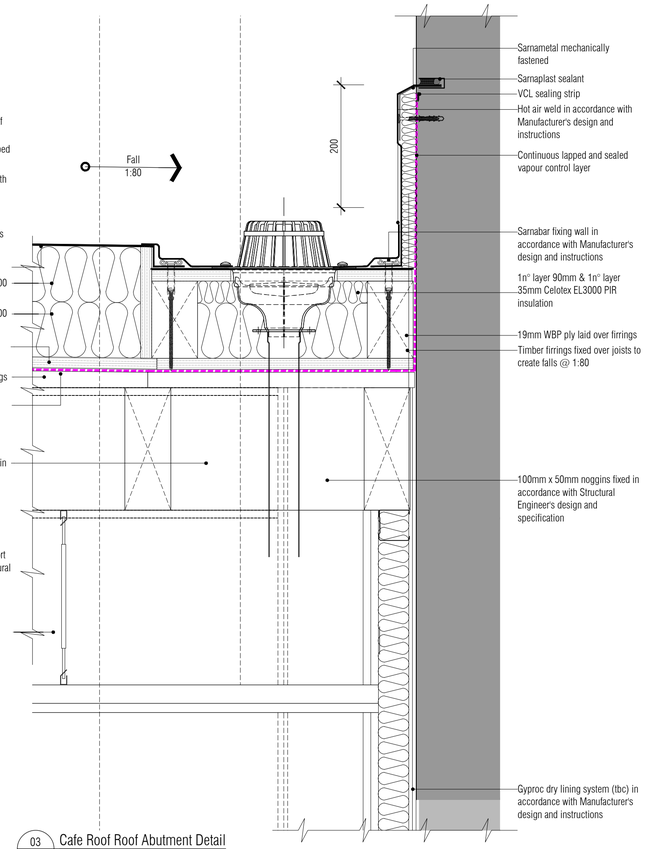


03 210 Cafe Roof Roof Abutment Detail
Scale: 1:5

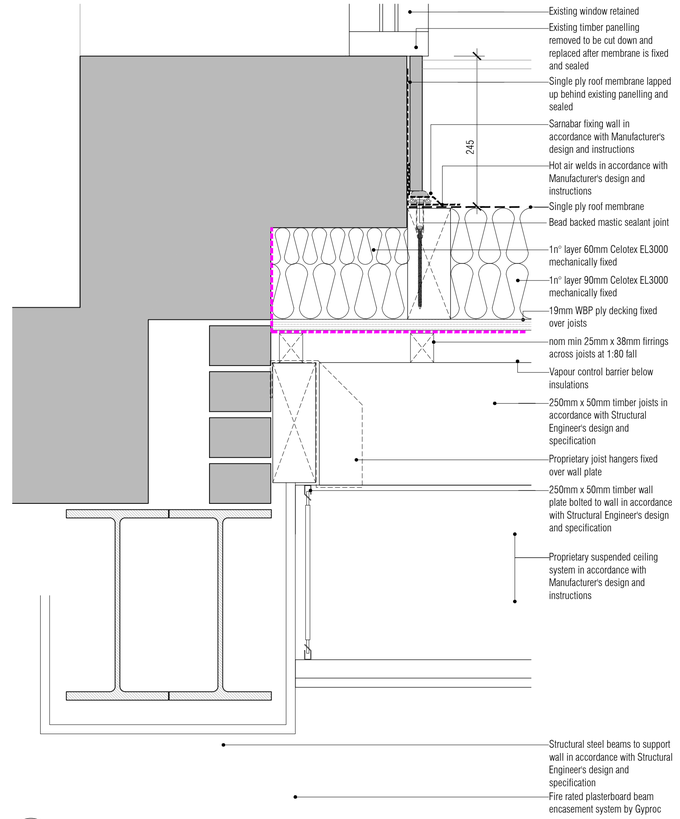


05 210 Cafe Roof Existing Bay Abutment Detail
Scale: 1:5

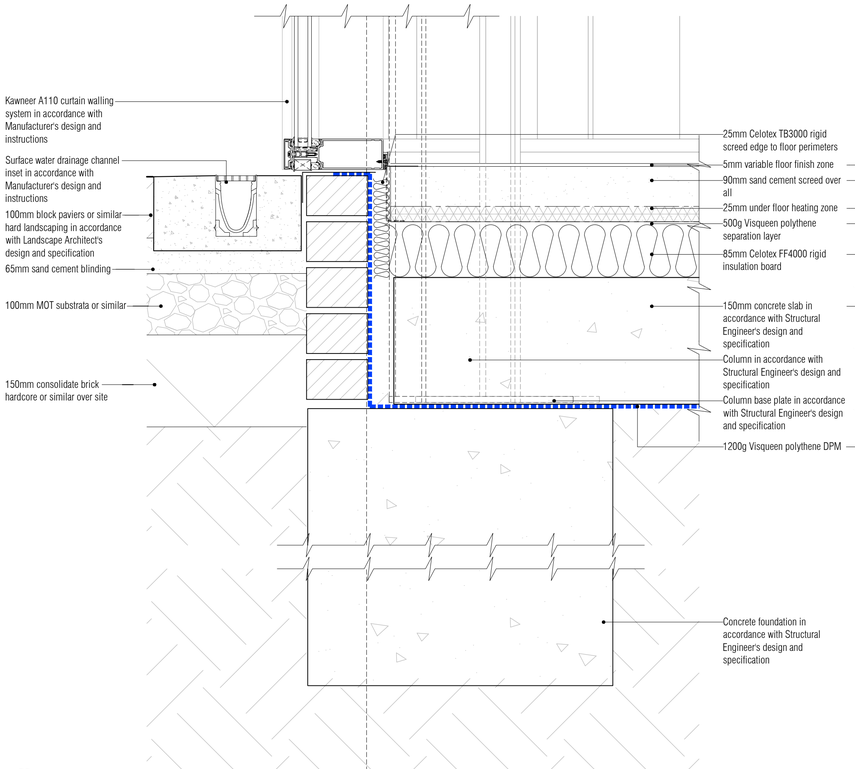

02 210 Cafe Threshold Detail
Scale: 1:5

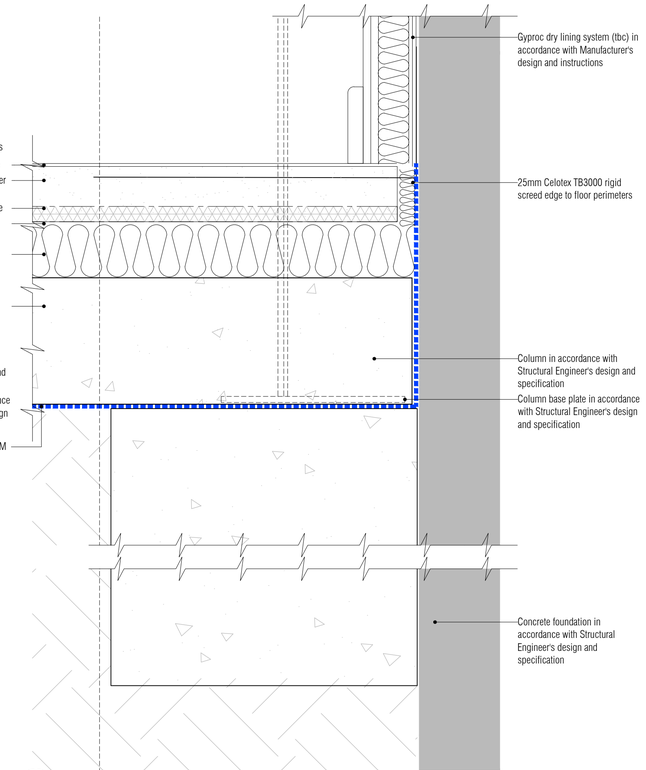


04 210 Cafe Floor Abutment Detail
Scale: 1:5

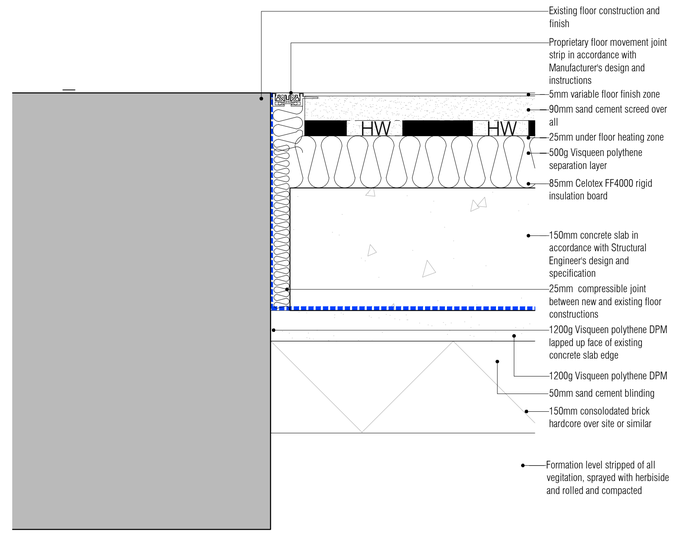

06 210 Cafe Floor Existing / New Abutment Detail
Scale: 1:5

NOTES: Do not scale this drawing. All dimensions to be checked on site prior to commencement or manufacture.

Key Plan
(nts)

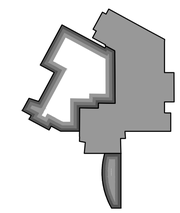

ISSUED FOR CONSTRUCTION

Rev	Date	By	Chk	Comment
C1	03.07.13	RKC	JAS	Issued for CONSTRUCTION

BRINGING IDEAS TO LIFE

FRANKHAM

Frankham Consultancy Group Limited
21 Perrymount Road
Haywards Heath RH16 3TP
t 01444 444900 f 01444 455642
enquire@frankham.com
www.frankham.com

Client
Ealing
www.ealing.gov.uk


Project Title
Dominion Arts Centre
Southall
London

Drawing Title
Cafe Sectional
Details


Drawn by:	Scale:	Date:
RKC	1:50@A1	06.02.13
Designed by:	Checked by:	Approved by:
FCG	JAS	AGC

File Ref.: K:\2000\2224\01 - LB EALING - DOMINION ARTS CENTRE\ARCH\ARD_4R_DETAIL_SCHEMATICS\224970-A-420.DWG - 3588113422
20:06:11/13:45:24


Drawing No. 224970-A-420
Rev. C1

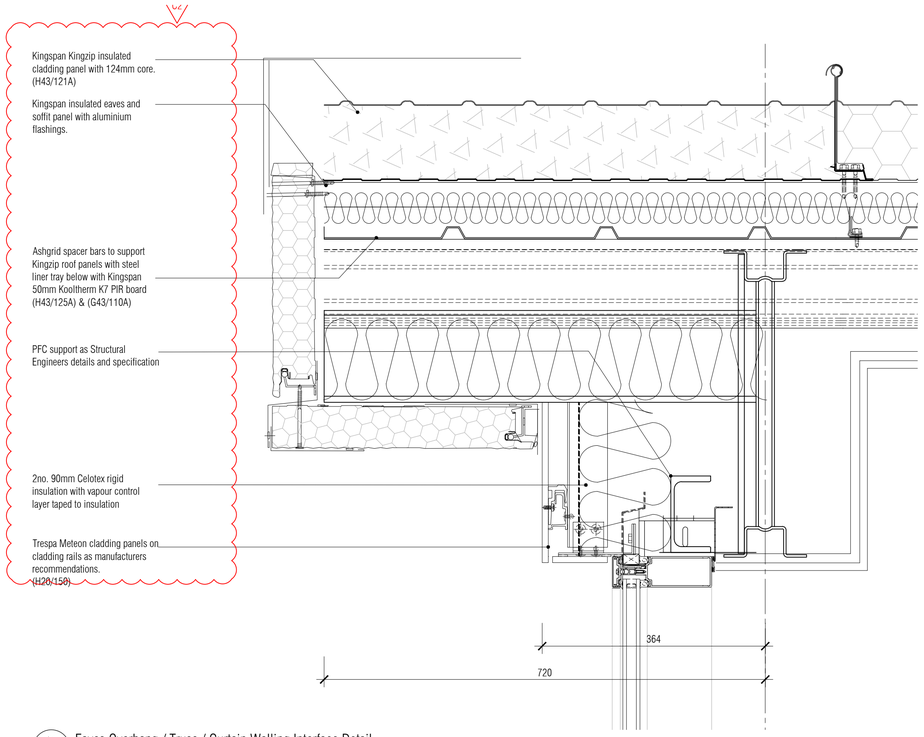


01 Eaves Overhang / Truss / Curtain Walling Interface Detail
Scale: 1:5

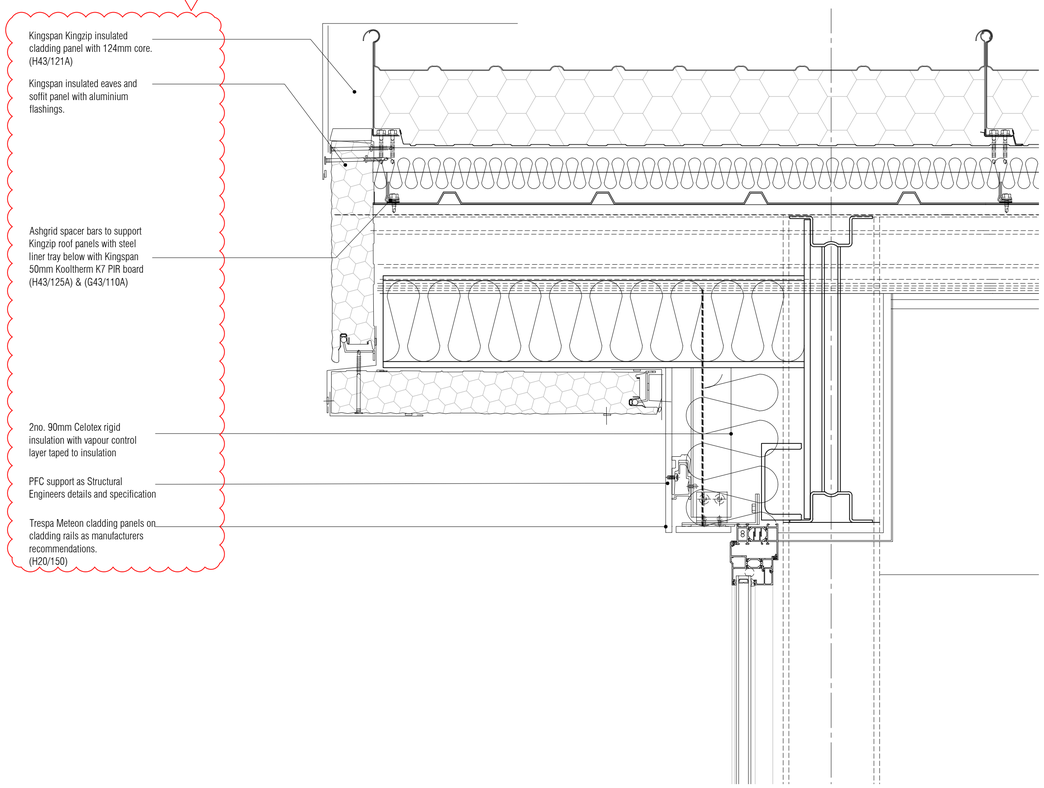

03 Eaves Overhang / Brick Block Wall Along GL1 Interface Detail
Scale: 1:5

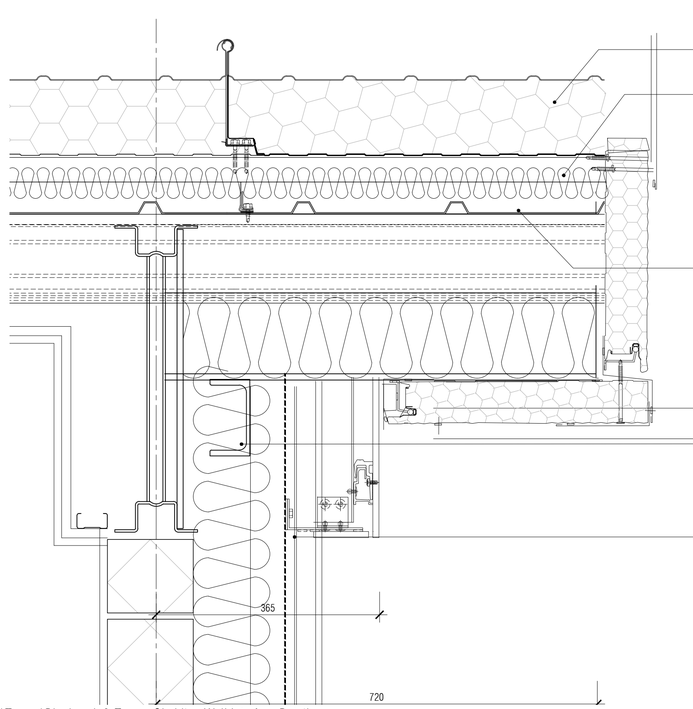


02 Eaves Overhang / Truss / Blockwork & Trespa Cladding Wall Interface Detail
Scale: 1:5

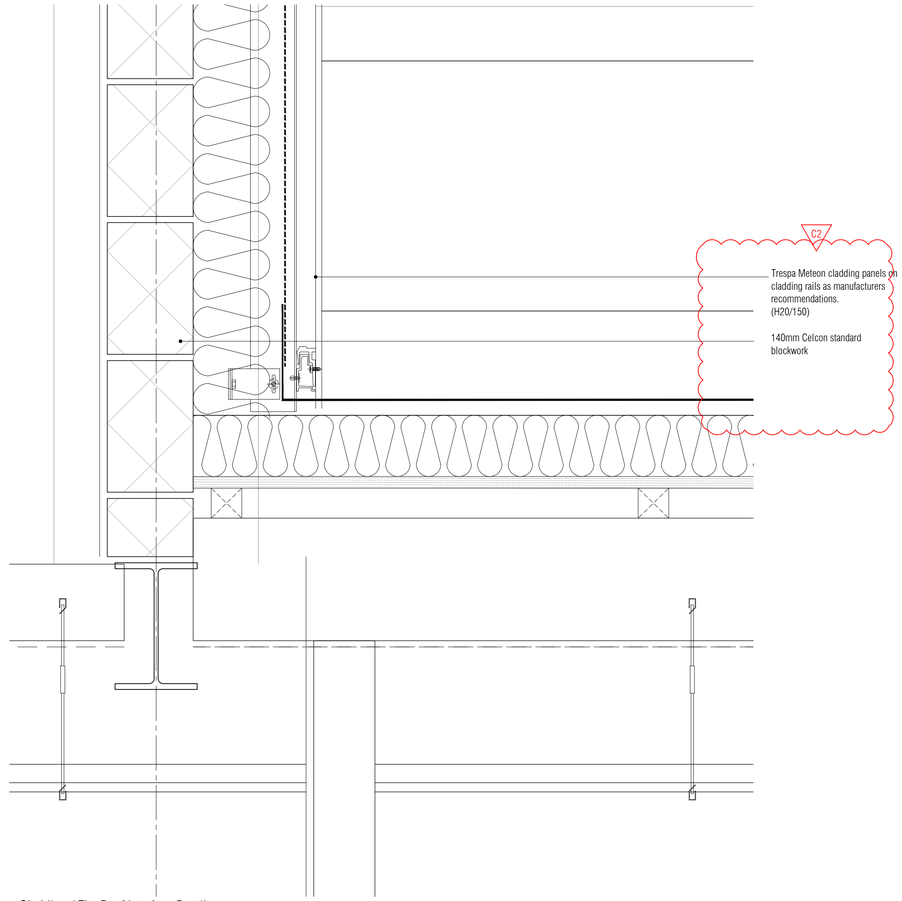

04 Blockwork & Trespa Cladding / Flat Roof Interface Detail
Scale: 1:5

NOTES: Do not scale this drawing. All dimensions to be checked on site prior to commencement or manufacture.

Key Plan
(nts)

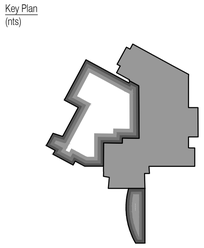

ISSUED FOR CONSTRUCTION

Rev	Date	By	Chk	Comment
C2	07.10.13	CH	AC	Annotation added
C1	03.07.13	RKC	JAS	Issued for CONSTRUCTION

BRINGING IDEAS TO LIFE

FRANKHAM

Frankham Consultancy Group Limited
21 Perrymount Road
Haywards Heath RH16 3TP
t 01444 444900 f 01444 455642
enquire@frankham.com
www.frankham.com

Client
Ealing
www.ealing.gov.uk


Project Title
Dominion Arts Centre
Southall
London

Drawing Title
General
Roof Interface
Arrangement
Details


Drawn by:	Scale:	Date:
RKC	1:5@A1	06.02.13
Designed by:	Checked by:	Approved by:
FCG	JAS	AGC

File Ref.: I:\2008\2124\01 - EFALNS - DOMINION ARTS CENTRE\ARCH\ADE_499_DETAIL_SCHEMATICS\224970-A-421.DWG - 20/06/2013 11:13:46:01


Drawing No. 224970-A-421
Rev. C2

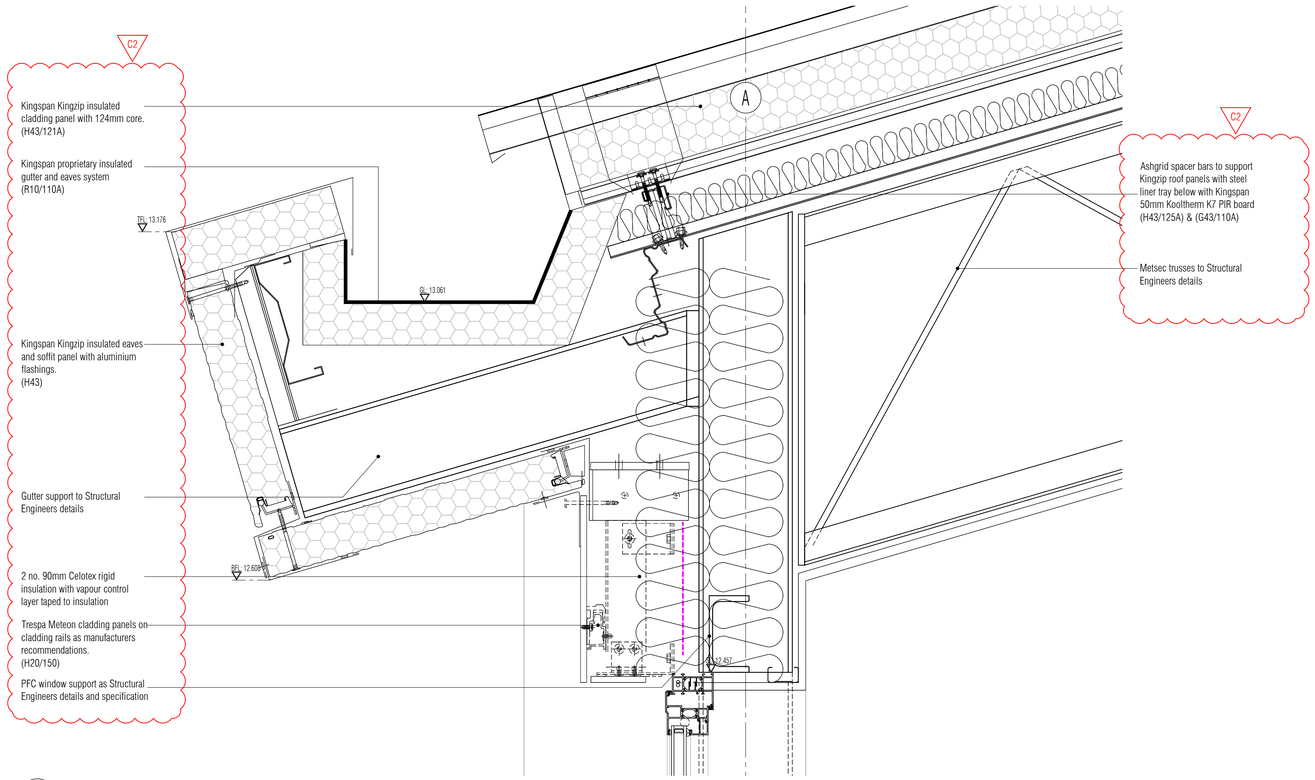


01 Truss Roof / Clad Masonry Interface Detail
Scale: 1:5

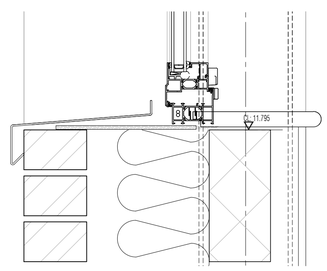


02 Truss Roof / Clad Masonry Interface Detail
Scale: 1:5

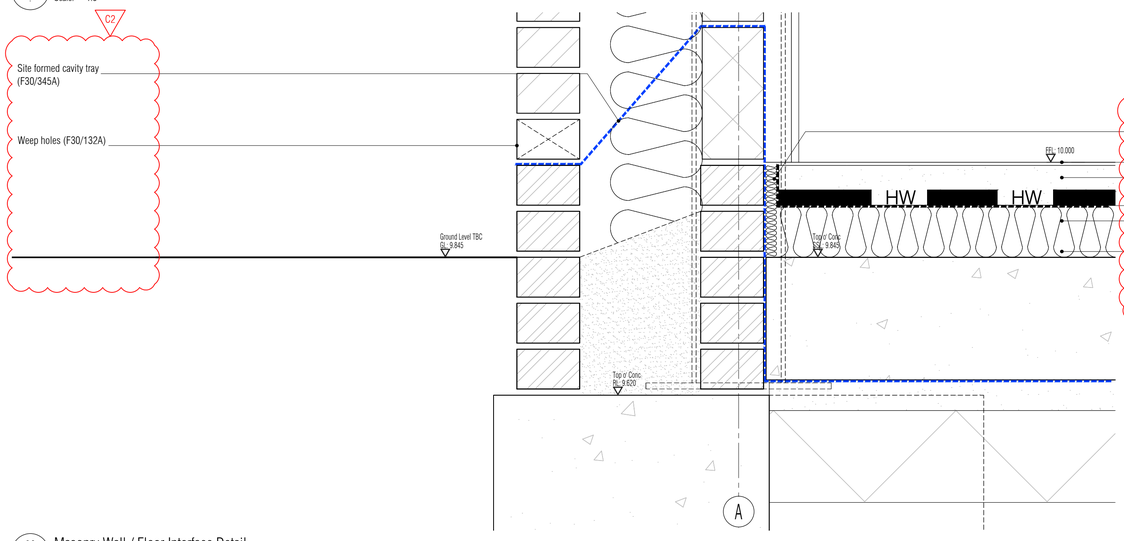

03 Masonry Wall / Floor Interface Detail
Scale: 1:5

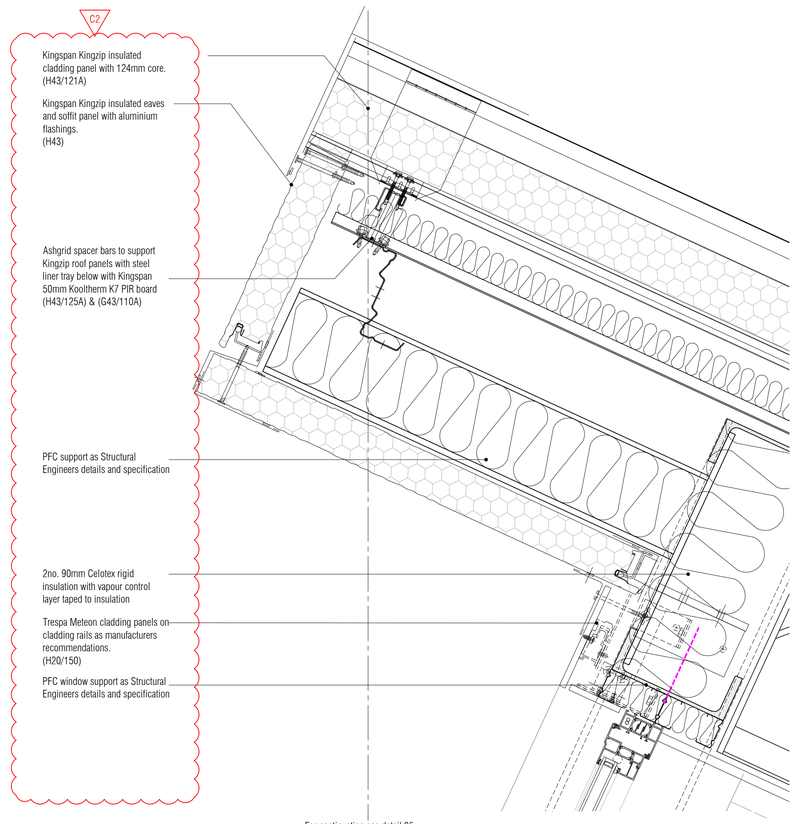


04 Butterfly Truss Roof / Robbin Window Interface Detail
Scale: 1:5

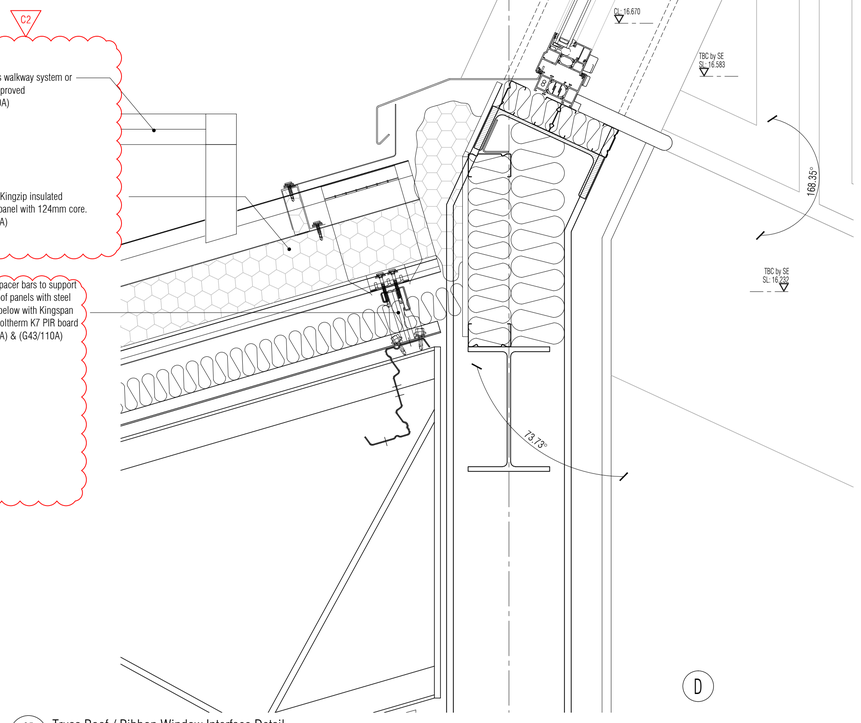

05 Truss Roof / Ribbon Window Interface Detail
Scale: 1:5

NOTES: Do not scale this drawing. All dimensions to be checked on site prior to commencement or manufacture.

Key Plan
(nts)

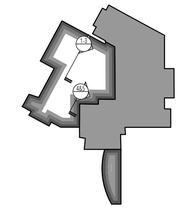

ISSUED FOR CONSTRUCTION

Rev	Date	By	Chk	Comment
C2	07.10.13	CH	AC	Annotation added
C1	03.07.13	RKC	JAS	Issued for CONSTRUCTION

BRINGING IDEAS TO LIFE

FRANKHAM
Frankham Consultancy Group Limited
21 Perrymount Road
Haywards Heath RH16 3TP
t 01444 444900 f 01444 455642
enquire@frankham.com
www.frankham.com

Client
Ealing
www.ealing.gov.uk


Project Title
Dominion Arts Centre
Southall
London

Drawing Title
Truss Roof Eaves,
High Level Ribbon Window and
Masonry and Floor
Details


Drawn by:	Scale:	Date:
RKC	1:5@A1	04.03.13
Designed by:	Checked by:	Approved by:
FCG	JAS	AGC

File Ref.: X:\2009\0224970 - LB EALING - DOMINION ARTS CENTRE\ARCH\ARC 4\06_DETAIL_SCHEMATICS\224970-A-422.DWG - 20/06/13 13:46:34


Drawing No.	Rev.
224970-A-422	C2

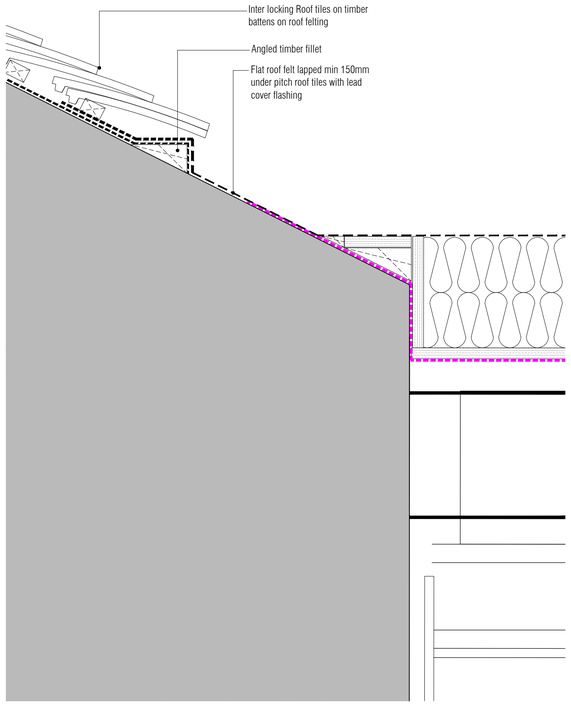


01 New Flat Roof / Existing Pitched Roof Abutment Detail
Scale: 1:5

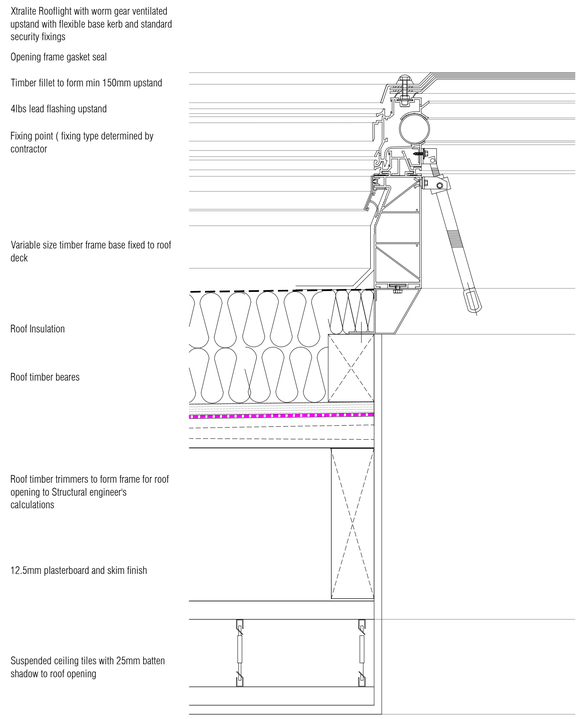


02 New Flat Roof / Roof Light Kerb Detail
Scale: 1:5

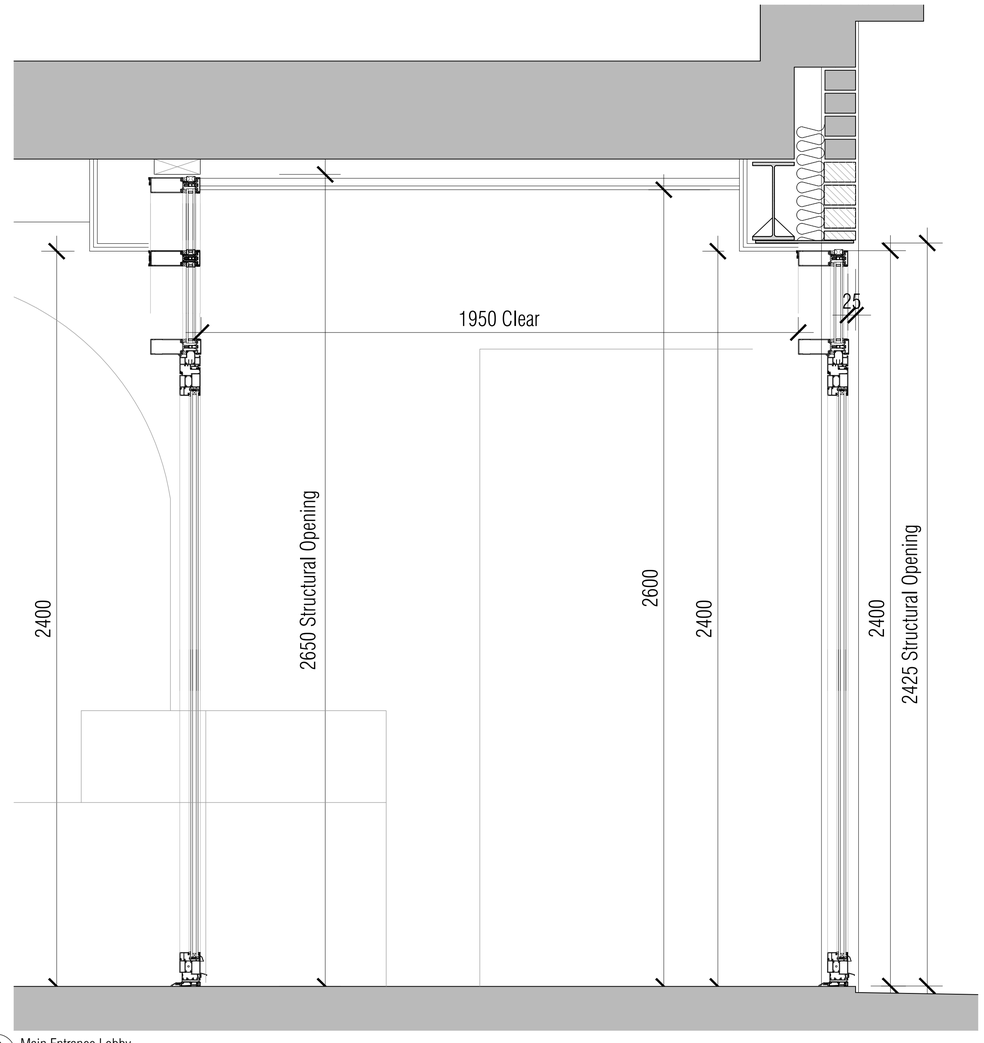

03 425 Main Entrance Lobby
Scale: 1:10

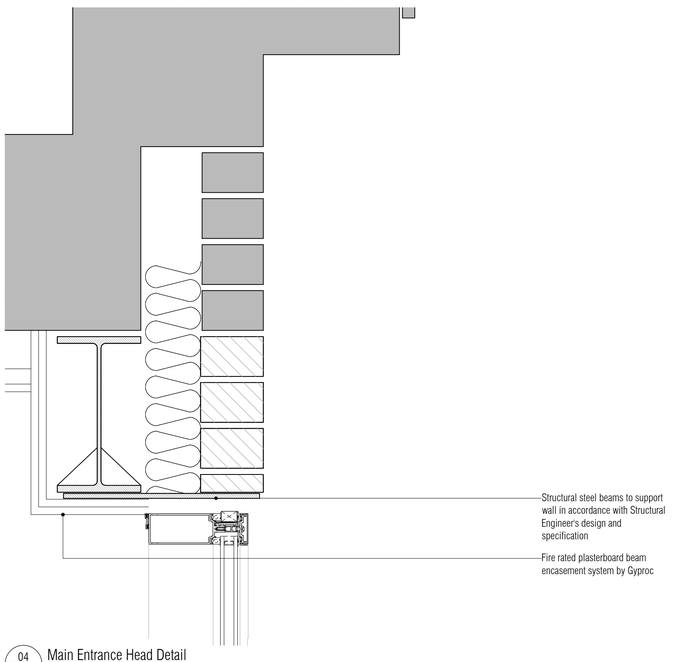


04 425 Main Entrance Head Detail
Scale: 1:5

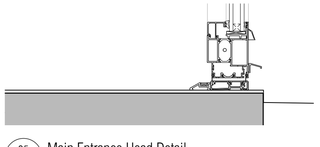

05 425 Main Entrance Head Detail
Scale: 1:5

NOTES: Do not scale this drawing. All dimensions to be checked on site prior to commencement or manufacture.

Key Plan
(nts)

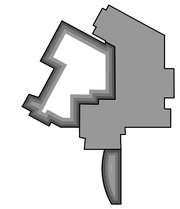

ISSUED FOR CONSTRUCTION

Rev	Date	By	Chk	Comment
C2	08.11.13	CH	AC	Cafe details added
C1	03.07.13	RKC	JAS	Issued for CONSTRUCTION

BRINGING IDEAS TO LIFE

FRANKHAM

Frankham Consultancy Group Limited
21 Perrymount Road
Haywards Heath RH16 3TP
t 01444 444900 f 01444 455642
enquire@frankham.com
www.frankham.com

Client
Ealing
www.ealing.gov.uk


Project Title
Dominion Arts Centre
Southall
London

Drawing Title
Main Entrance
Details


Drawn by:	Scale:	Date:
RKC	Varies@A1	08.11.13
Designed by:	Checked by:	Approved by:
FCG	JAS	AGC

File Ref.: K:\2008\2224970 - LB EALING - DOMINION ARTS CENTRE\ARCHI\DWG\PLANS\224970-A-425.DWG - 20081113A731
20.06.11:13:47:33


Drawing No. 224970-A-425
Rev. C2

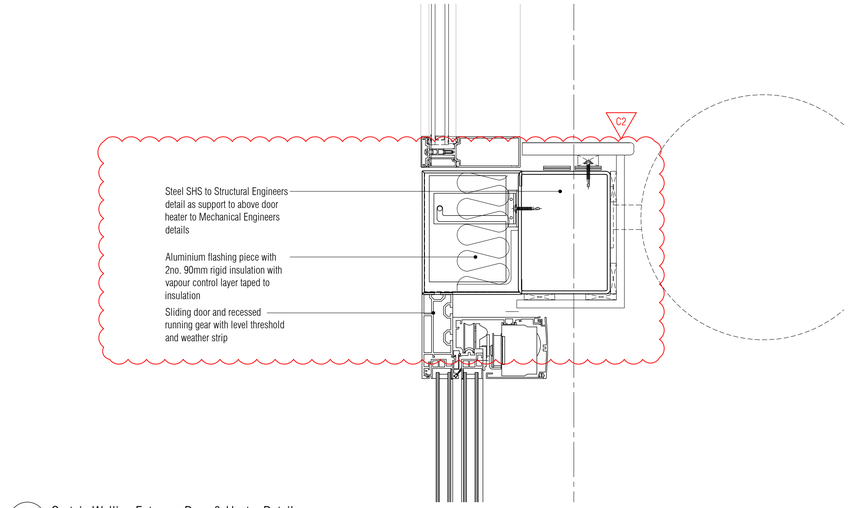


01 Curtain Walling Entrance Door & Heater Detail
Scale: 1:5

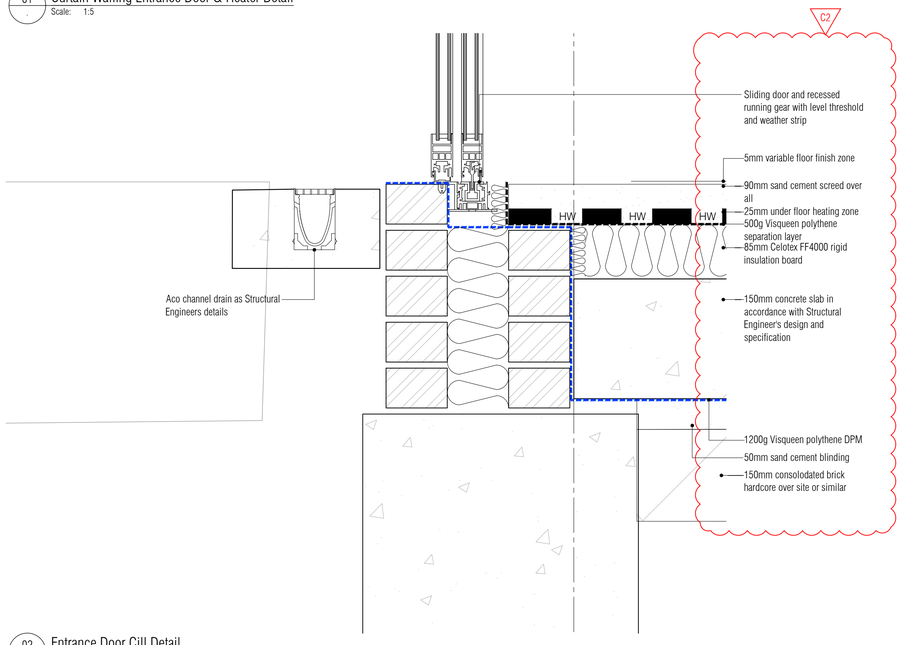

02 Entrance Door Cill Detail
Scale: 1:5

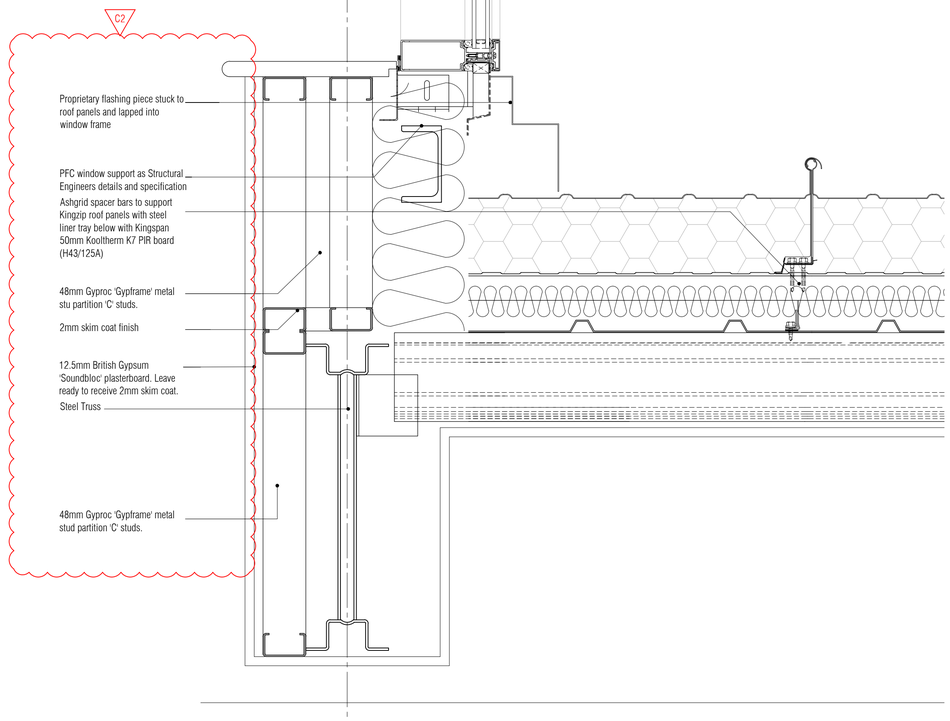


03 High Level Curtain Walling Cill / Pitched RoofDetail
Scale: 1:5

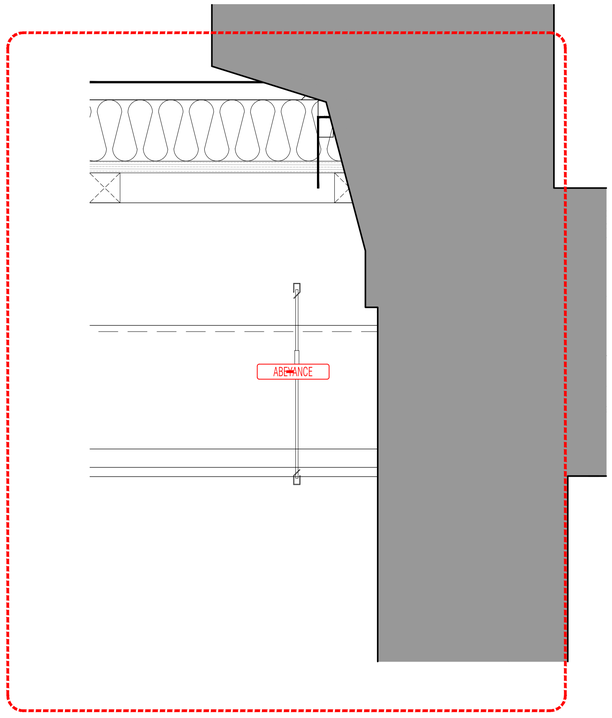

04 Flat Roof / Existing Bay Window Detail
Scale: 1:5

NOTES: Do not scale this drawing. All dimensions to be checked on site prior to commencement or manufacture.

Key Plan
(nts)

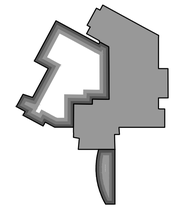

ISSUED FOR CONSTRUCTION

Rev	Date	By	Chk	Comment
C2	07.10.13	CH	AC	Annotation added
C1	03.07.13	RKC	JAS	Issued for CONSTRUCTION

BRINGING IDEAS TO LIFE

FRANKHAM

Frankham Consultancy Group Limited
21 Perrymount Road
Haywards Heath RH16 3TP
t 01444 444900 f 01444 455642
enquire@frankham.com
www.frankham.com

Client
Ealing
www.ealing.gov.uk


Project Title
Dominion Arts Centre
Southall
London

Drawing Title
General
Roof Interface
Arrangement
Details


Drawn by:	Scale:	Date:
RKC	1:5@A1	06.02.13
Designed by:	Checked by:	Approved by:
FCG	JAS	AGC

File Ref.: H:\2000\0224970 - LEALNL - DOMINION ARTS CENTRE\ARCH\ADD_499_DETAIL_SCHEMATICS\224970-A-426.DWG - 20061113\MDS 20:06:11:13:48:09


Drawing No. 224970-A-426
Rev. C2

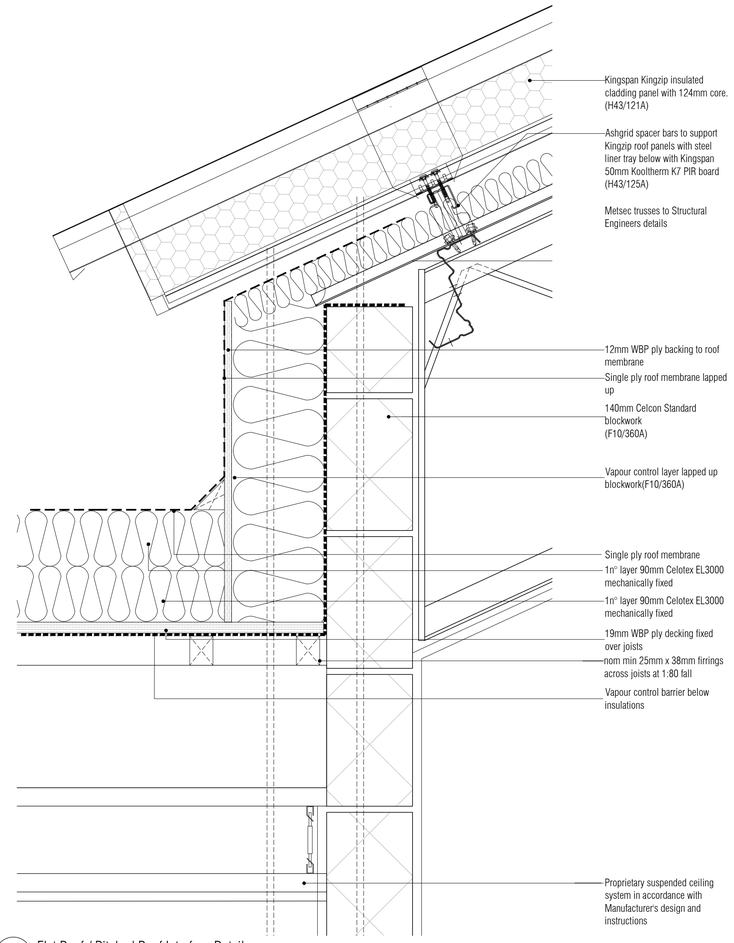


01 Flat Roof / Pitched Roof Interface Detail
Scale: 1:5

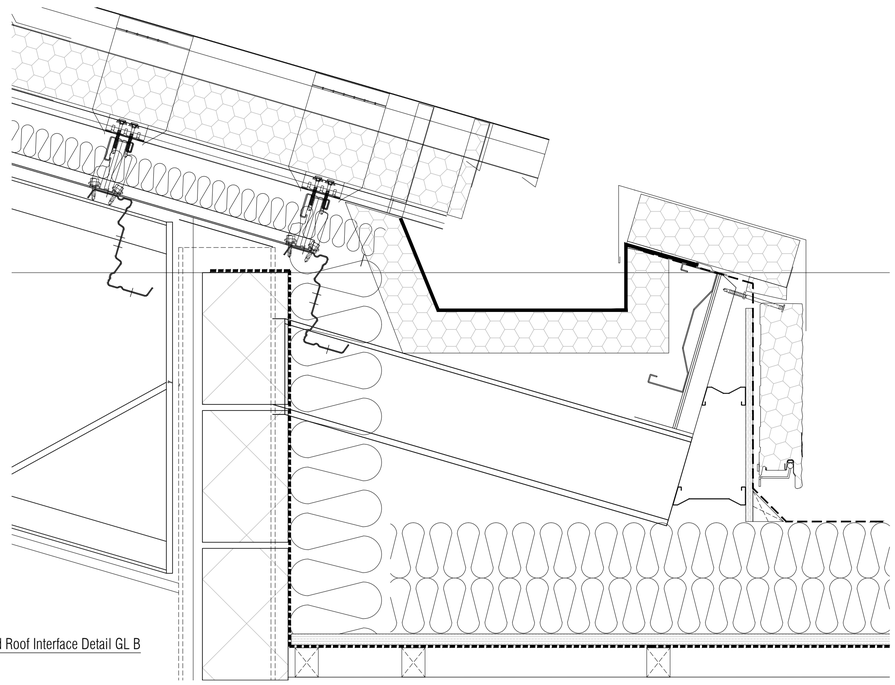


05 Flat Roof / Pitched Roof Interface Detail GL B
Scale: 1:5

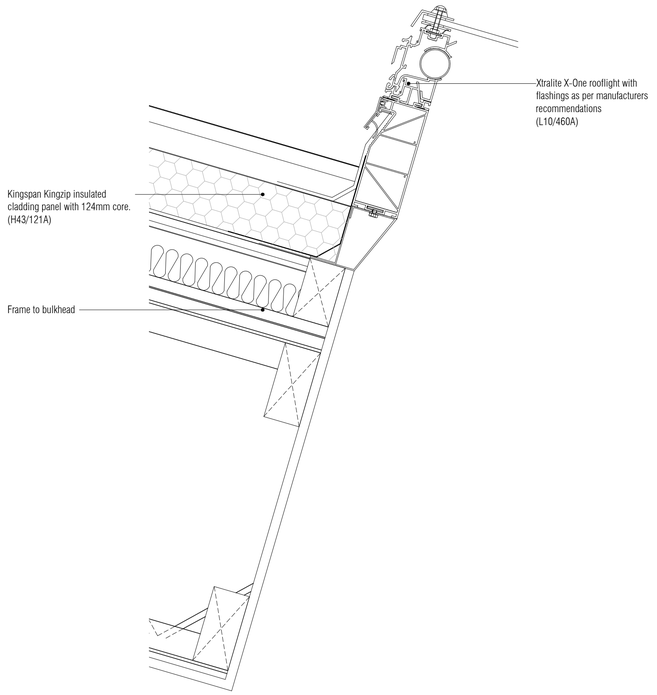

02 Roof Light Head Detail
Scale: 1:5

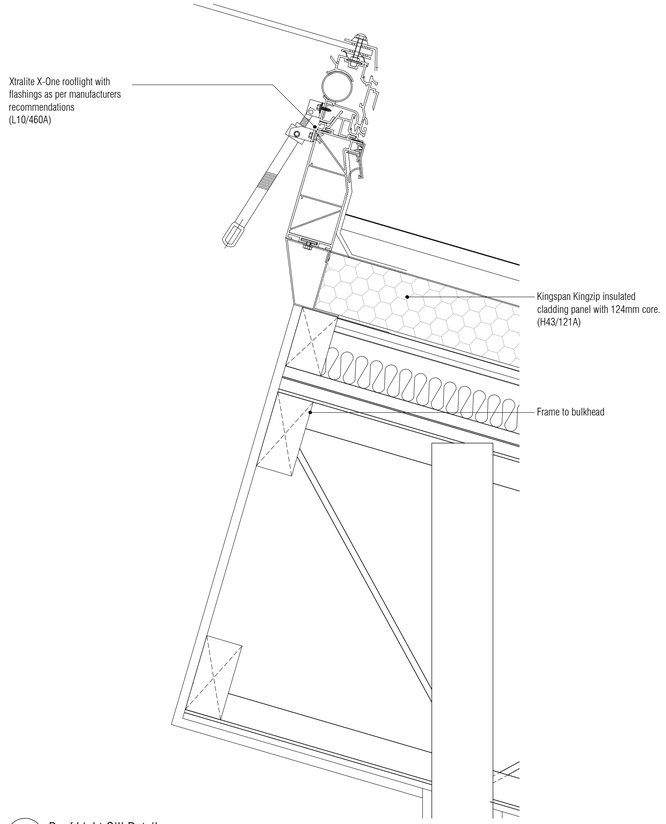


03 Roof Light Cill Detail
Scale: 1:5

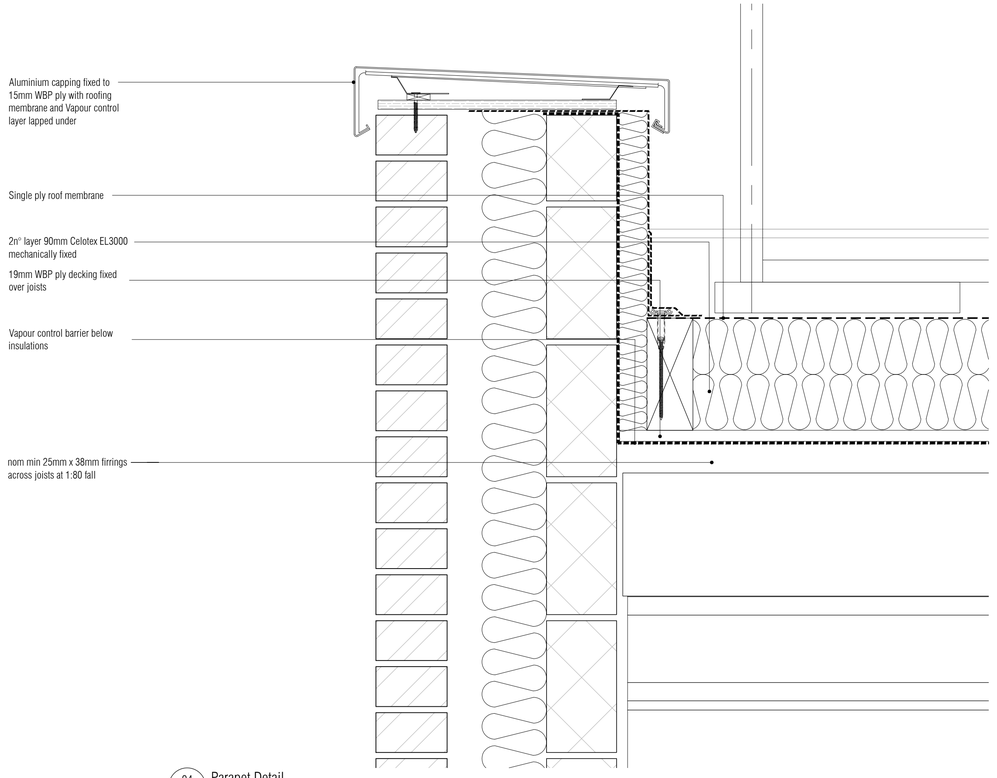

04 Parapet Detail
Scale: 1:5

NOTES: Do not scale this drawing. All dimensions to be checked on site prior to commencement or manufacture.

Key Plan
(nts)

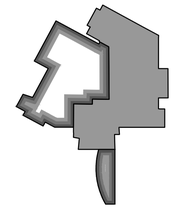

ISSUED FOR CONSTRUCTION

Rev	Date	By	Chk	Comment
C3	01.11.13	CH	AC	Gutter detail added
C2	07.10.13	CH	AC	Annotation added
C1	03.07.13	RKC	JAS	Issued for CONSTRUCTION

BRINGING IDEAS TO LIFE

FRANKHAM

Frankham Consultancy Group Limited
21 Perrymount Road
Haywards Heath RH16 3TP
t 01444 444900 f 01444 455642
enquire@frankham.com
www.frankham.com

Client
Ealing
www.ealing.gov.uk


Project Title
Dominion Arts Centre
Southall
London

Drawing Title
General
Roof Interface
Arrangement
Details


Drawn by:	Scale:	Date:
RKC	1:5@A1	06.02.13
Designed by:	Checked by:	Approved by:
FCG	JAS	AGC

File Ref.: X:\2008\0224970 - LB EALING - DOMINION ARTS CENTRE\ARCH\ADD_499_DETAIL_SCHEMATICS\224970-A-428.DWG - 20/06/2013 11:48:24


Drawing No.	Rev.
224970-A-428	C3

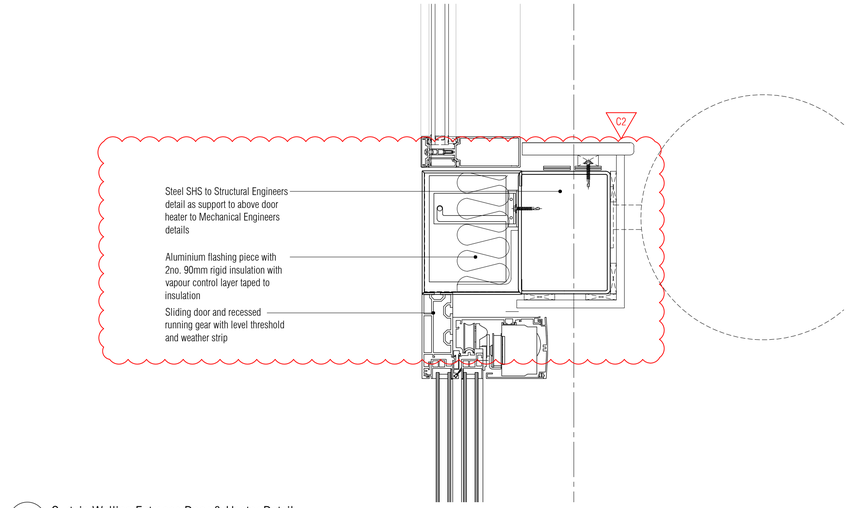


01 Curtain Walling Entrance Door & Heater Detail
Scale: 1:5

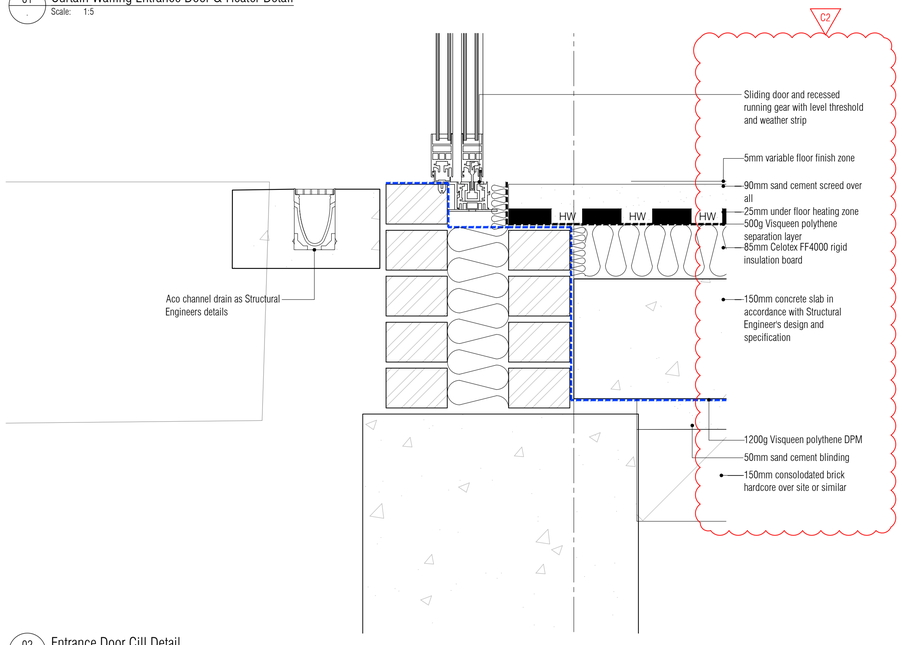

02 Entrance Door Cill Detail
Scale: 1:5

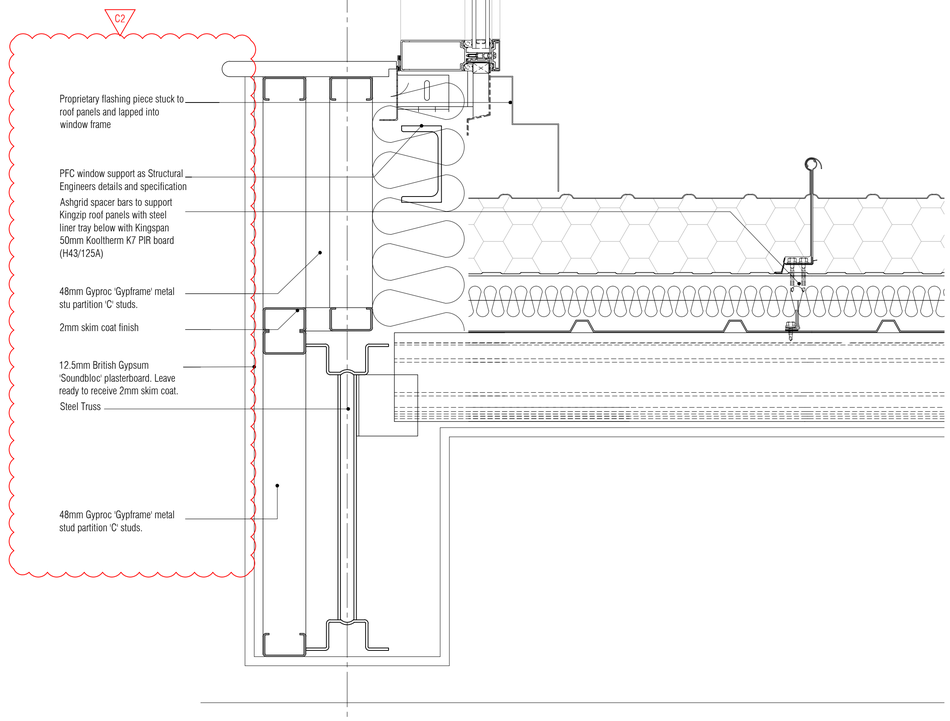


03 High Level Curtain Walling Cill / Pitched RoofDetail
Scale: 1:5

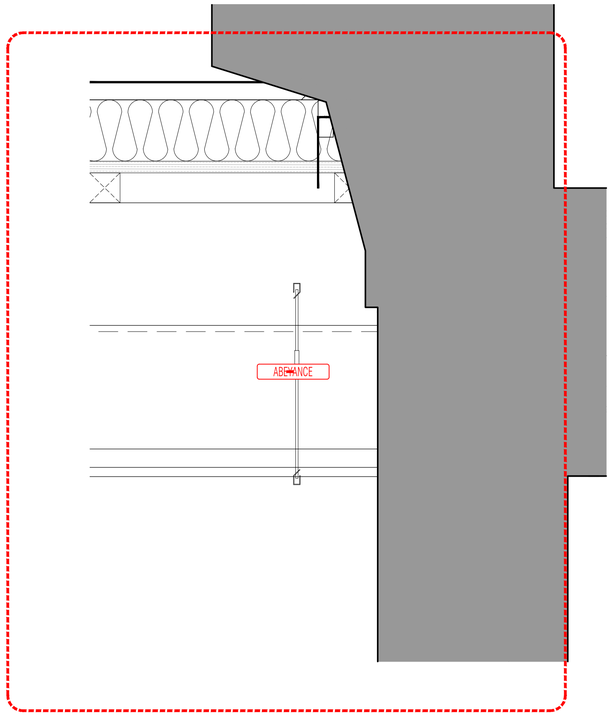

04 Flat Roof / Existing Bay Window Detail
Scale: 1:5

NOTES: Do not scale this drawing. All dimensions to be checked on site prior to commencement or manufacture.

Key Plan
(nts)

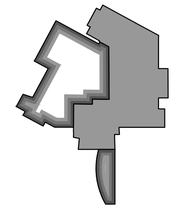

ISSUED FOR CONSTRUCTION

Rev	Date	By	Chk	Comment
C2	07.10.13	CH	AC	Annotation added
C1	03.07.13	RKC	JAS	Issued for CONSTRUCTION

BRINGING IDEAS TO LIFE

FRANKHAM

Frankham Consultancy Group Limited
21 Perrymount Road
Haywards Heath RH16 3TP
t 01444 444900 f 01444 455642
enquire@frankham.com
www.frankham.com

Client
Ealing
www.ealing.gov.uk


Project Title
Dominion Arts Centre
Southall
London

Drawing Title
General
Roof Interface
Arrangement
Details


Drawn by:	Scale:	Date:
RKC	1:5@A1	06.02.13
Designed by:	Checked by:	Approved by:
FCG	JAS	AGC

File Ref.: H:\2000\224970 - LEALNL - DOMINION ARTS CENTRE\ARCH\ADD_499_DETAIL_SCHEMATICS\224970-A-429.DWG - 20061113494 20:06:11 13:49:01


Drawing No. 224970-A-429
Rev. C2

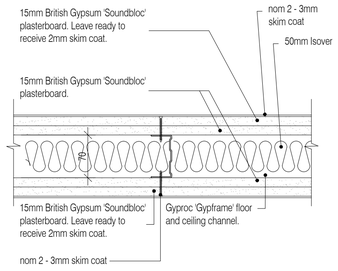


01 Typical locations - corridors/stores (Wall Type A)
Scale: 1:5

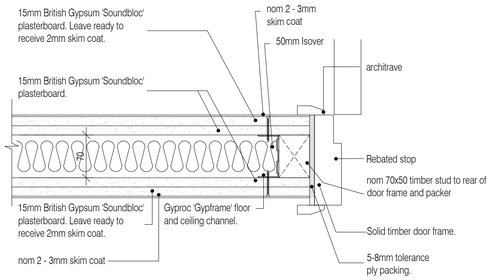


02 Typical locations - corridors/stores (Wall Type A Door frame detail)
Scale: 1:5

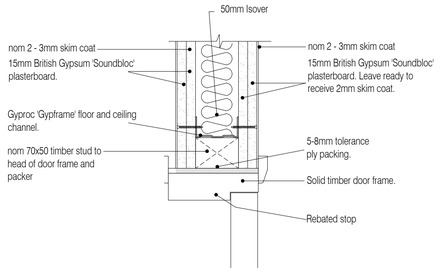


03 Typical door head detail Wall Type A
Scale: 1:5

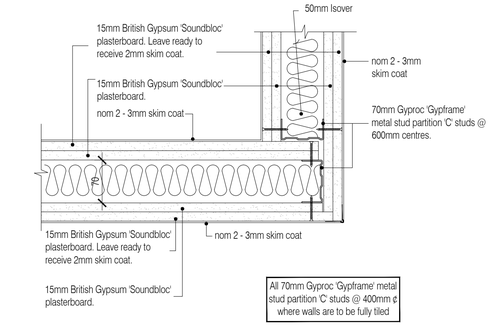


04 Typical corner detail Wall Type A
Scale: 1:5

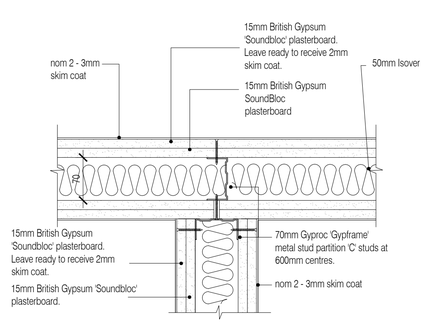


05 Typical junction detail Wall Type A
Scale: 1:5

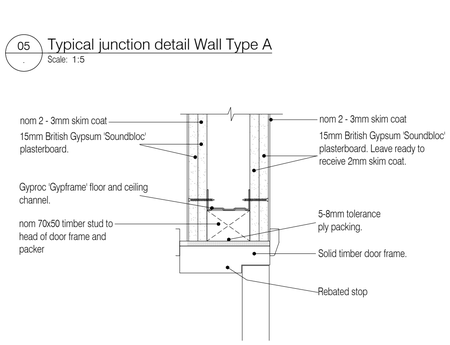


06 Typical splayed angled corner detail. (Wall Type A)
Scale: 1:5

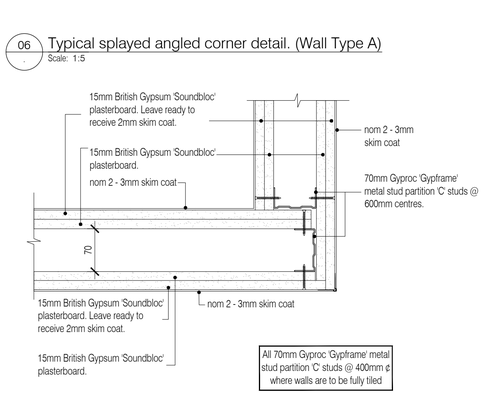


07 Typical locations - corridors/stores (Wall Type B)
Scale: 1:5

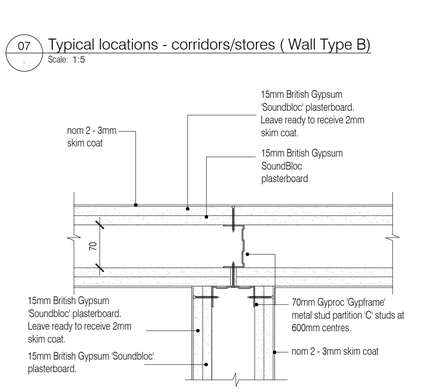


08 Typical locations - corridors/stores (Wall Type B Door frame detail)
Scale: 1:5

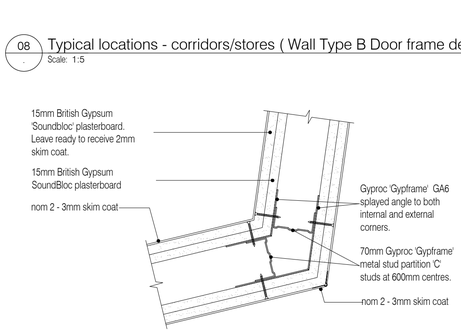


09 Typical door head detail Wall Type B
Scale: 1:5

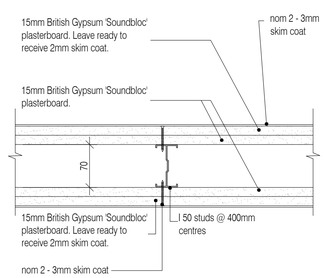


10 Typical corner detail Wall Type B
Scale: 1:5

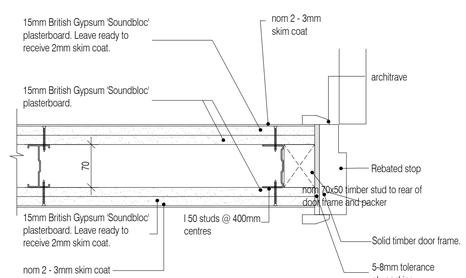

11 Typical junction detail Wall Type B
Scale: 1:5

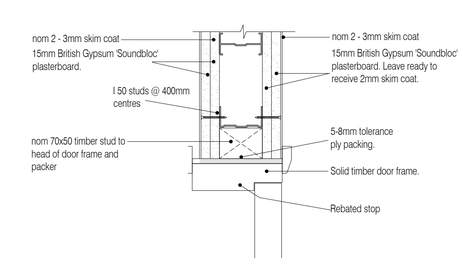

12 Typical splayed angled corner detail. (Wall Type B)
Scale: 1:5

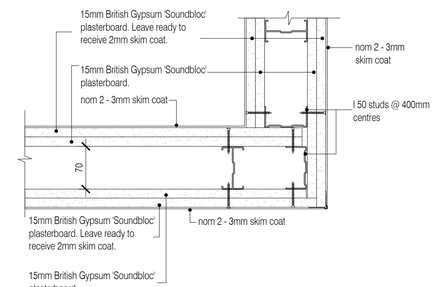

13 Typical locations - corridors/stores (Wall Type C)
Scale: 1:5


14 Typical locations - corridors/stores (Wall Type C Door frame detail)
Scale: 1:5

15 Typical door head detail Wall Type C
Scale: 1:5

16 Typical corner detail Wall Type C
Scale: 1:5

NOTES: Do not scale this drawing. All dimensions to be checked on site prior to commencement or manufacture.

Key Plan
(nts)

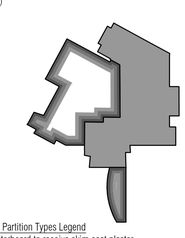

Internal Partition Types Legend
All plasterboard to receive skim coat plaster

- A - 2 layers 15mm soundbloc each side of 70mm C studs @ 600mm centres. 50mm Isover APR 1200 in cavity
- B - 2 layers 15mm Wallboard each side of 70mm C studs @ 600mm centres.
- C - 2 layers 15mm soundbloc each side of 70mm I 50 studs @ 400mm centres. 50mm Isover APR 1200 in cavity
- D - 2 layers12.5mm soundbloc each side of 92mm I 90 studs @ 300mm centres. 25mm Isover APR 1200 in cavity
- E - 140mm blockwork w/skim coat
- 2 layers 12.5mm fireline column encasing
- Z - 2 layers 15mm soundbloc each side of 146mm Gypframe studs @ 600mm centres.

External Wall Types Legend

- F - Ibstock facing brick - 50mm clear cavity -150mm insulation - 140mm blockwork - plaster finish
- G - Ibstock facing brick - 50mm clear cavity -90mm insulation - 140mm blockwork - plaster finish
- H - Ibstock facing brick - 50mm clear cavity -150mm insulation - 140mm blockwork - dry lining - skim finish
- J - 140mm blockwork -150mm insulation - 140mm blockwork - plaster finish
- K - Laminate cladding - 50mm clear cavity -150mm insulation - 140mm blockwork - plaster finish
- L - Laminate cladding - 50mm clear cavity -150mm insulation - 140mm blockwork - dry lining - skim finish
- M - Ibstock facing brick - 50mm clear cavity 100mm blockwork N - PPC Metal Louvres
- P - Dry lined with 2 layers 12.5mm soundbloc and 50mm Isover APR 1200 in cavity
- Q - Brick to match exig - 25mm cavity -90mm insulation - 100mm blockwork - plaster finish
- R - Plaster - 100mm blockwork - 100mm clear cavity - 100mm blockwork - Plaster

NB: All steelwork to be erected in accordance with Structural Engineer's design and specification. For all steelwork information inc. bracing, refer to Structural Engineers drawings

ISSUED FOR CONSTRUCTION

Rev	Date	By	Chk	Comment
C1	03.07.13	RKC	JAS	Issued for CONSTRUCTION

BRINGING IDEAS TO LIFE

FRANKHAM

Frankham Consultancy Group Limited
21 Perrymount Road
Haywards Heath RH16 3TP
t 01444 444900 f 01444 455642
enquire@frankham.com
www.frankham.com

Client
Ealing
www.ealing.gov.uk


Project Title
Dominion Arts Centre
Southall
London

Drawing Title
Internal Wall Partition
Details
Sheet 1 of 2


Drawn by:	Scale:	Date:
RKC	1:5 @A1	03.04.13
Designed by:	Checked by:	Approved by:
FCG	CH	AGC

File Ref.: K:\2000\02\24970 - EALING - DOMINION ARTS CENTRE\ARCH\ARC 4\R_DETAIL_SCHEMATICS\224970-A-430.DWG 20/06/11 13:49:08


Drawing No. 224970-A-430
Rev. C1

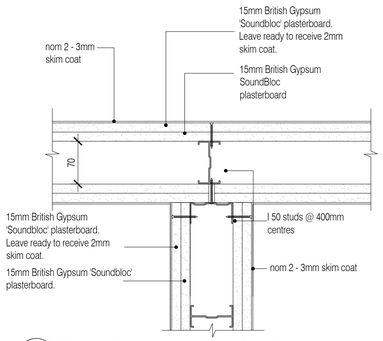


01 Typical junction detail Wall Type C
Scale: 1:5

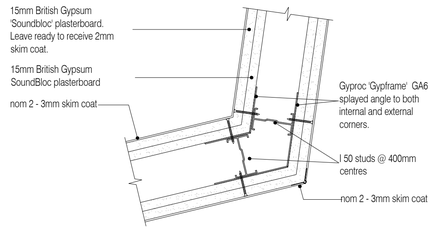


02 Typical splayed angled corner detail. (Wall Type C)
Scale: 1:5

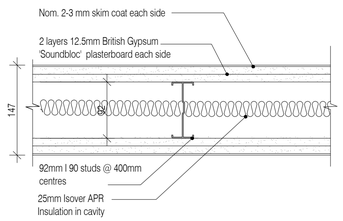


03 Typical locations - corridors/stores (Wall Type D)
Scale: 1:5

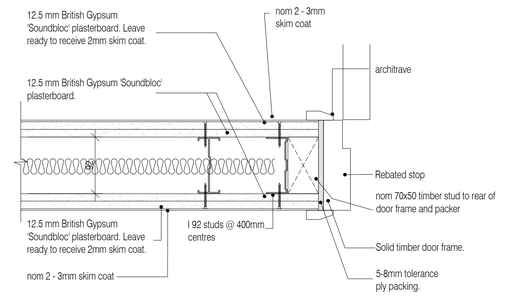


04 Typical locations - corridors/stores (Wall Type D Door frame detail)
Scale: 1:5

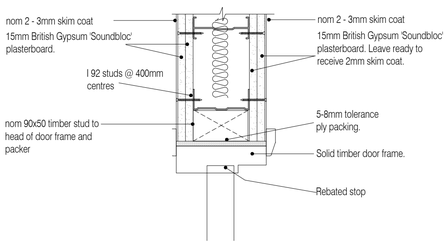


05 Typical door head detail Wall Type D
Scale: 1:5

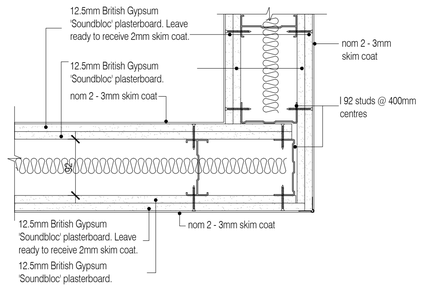


06 Typical corner detail Wall Type D
Scale: 1:5

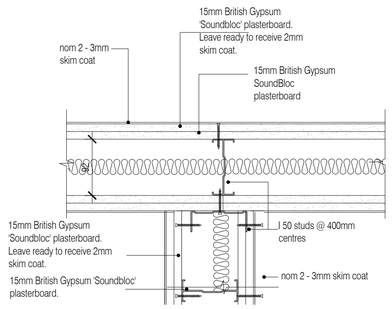


07 Typical junction detail Wall Type D
Scale: 1:5

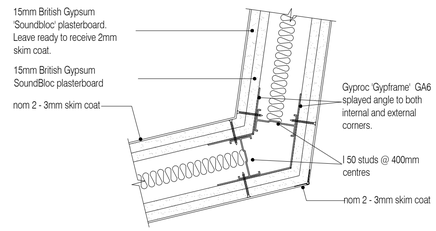


08 Typical splayed angled corner detail. (Wall Type D)
Scale: 1:5

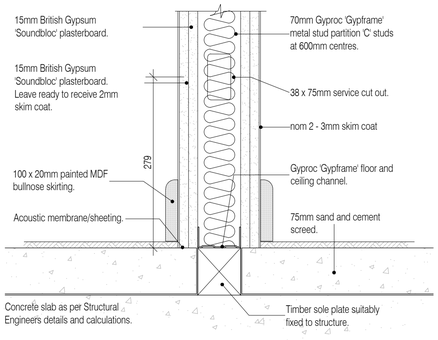


09 Typical Partition Base with Insulation Detail
Scale: 1:5

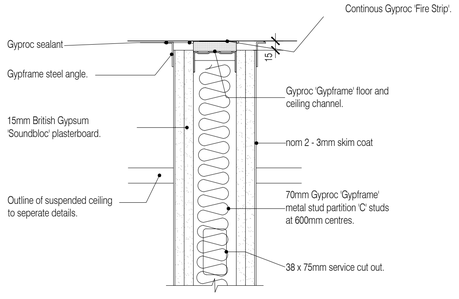


10 Typical Partition Head with Insullation To New Roof Detail
Scale: 1:5

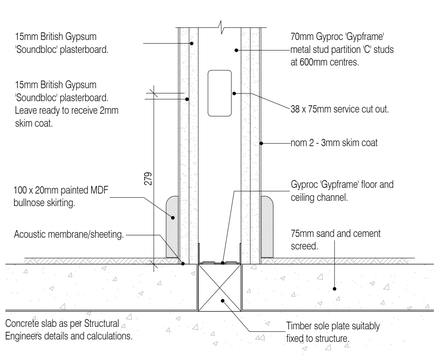

11 Typical Partition Base without Insulation Detail
Scale: 1:5

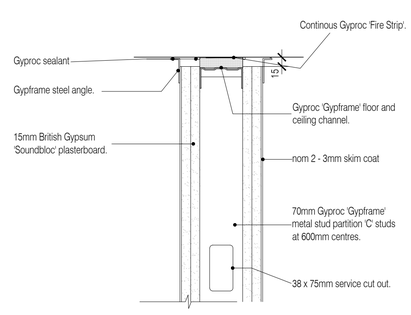


12 Typical Partition Head without Insulation To New Roof Detail
Scale: 1:5

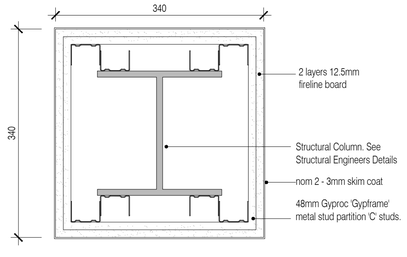

13 Typical Gyplyner Encasement To Steel In library Detail
Scale: 1:5

NOTES: Do not scale this drawing. All dimensions to be checked on site prior to commencement or manufacture.

Key Plan
(nts)

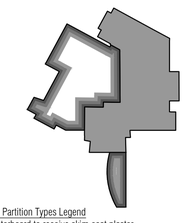

Internal Partition Types Legend
All plasterboard to receive skim coat plaster

- A - 2 layers 15mm soundbloc each side of 70mm C studs @ 600mm centres. 50mm Isover APR 1200 in cavity
- B - 2 layers 15mm Wallboard each side of 70mm C studs @ 600mm centres.
- C - 2 layers 15mm soundbloc each side of 70mm l 50 studs @ 400mm centres. 50mm Isover APR 1200 in cavity
- D - 2 layers12.5mm soundbloc each side of 92mm l 90 studs @ 300mm centres. 25mm Isover APR 1200 in cavity
- E - 140mm blockwork w/skim coat
- 2 layers 12.5mm fireline column encasing
- Z - 2 layers 15mm soundbloc each side of 146mm Gypframe studs @ 600mm centres.

External Wall Types Legend

- F - Ibstock facing brick - 50mm clear cavity -150mm insulation - 140mm blockwork - plaster finish
- G - Ibstock facing brick - 50mm clear cavity -90mm insulation - 140mm blockwork - plaster finish
- H - Ibstock facing brick - 50mm clear cavity -150mm insulation - 140mm blockwork - dry lining - skim finish
- J - 140mm blockwork -150mm insulation - 140mm blockwork - plaster finish
- K - Laminate cladding - 50mm clear cavity -150mm insulation - 140mm blockwork - plaster finish
- L - Laminate cladding - 50mm clear cavity -150mm insulation - 140mm blockwork - dry lining - skim finish
- M - Ibstock facing brick - 50mm clear cavity 100mm blockwork N - PPC Metal Louvres
- P - Dry lined with 2 layers 12.5mm soundbloc and 50mm Isover APR 1200 in cavity
- Q - Brick to match exig - 25mm cavity -90mm insulation - 100mm blockwork - plaster finish
- R - Plaster - 100mm blockwork - 100mm clear cavity - 100mm blockwork - Plaster

NB: All steelwork to be erected in accordance with Structural Engineer's design and specification. For all steelwork information inc. bracing, refer to Structural Engineers drawings

ISSUED FOR CONSTRUCTION

Rev	Date	By	Chk	Comment
C1	03.07.13	RKC	JAS	Issued for CONSTRUCTION

BRINGING IDEAS TO LIFE

FRANKHAM

Frankham Consultancy Group Limited
21 Perrymount Road
Haywards Heath RH16 3TP
t 01444 444900 f 01444 455642
enquire@frankham.com
www.frankham.com

Client
Ealing
www.ealing.gov.uk


Project Title
Dominion Arts Centre
Southall
London

Drawing Title
Internal Wall Partition
Details
Sheet 2 of 2


Drawn by:	Scale:	Date:
RKC	1:5 @A1	03.04.13
Designed by:	Checked by:	Approved by:
FCG	CH	AGC

File Ref.: X:\2000\0224970 - LEALING - DOMINION ARTS CENTRE\ARCHI\DE_4IR_DETAIL_SCHEMATICS\224970-A-431.DWG - 2000/11/3493
20:06:11/13:49:16


Drawing No. 224970-A-431
Rev. C1

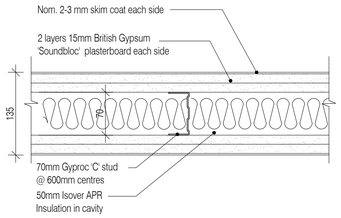


01 Wall Type A - 56dB - 90mins - 4.9m max.
Scale: 1:5

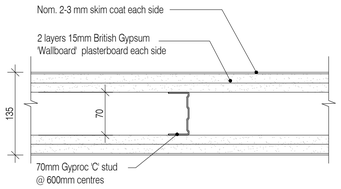


02 Wall Type B - 46dB - 60mins - 4.9m max.
Scale: 1:5

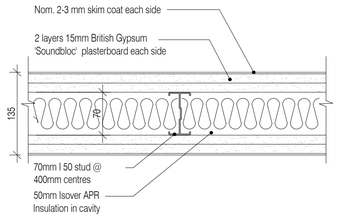


03 Wall Type C - 56dB - 90mins - 5.5m max.
Scale: 1:5

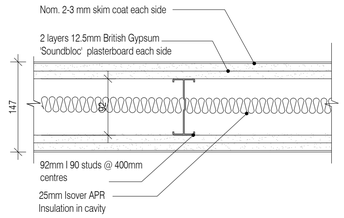


04 Wall Type D - 53dB - 60mins - 7.9m max.
Scale: 1:5

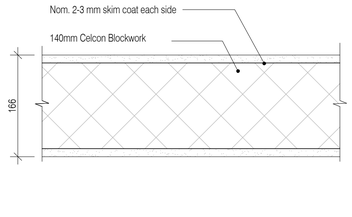

05 Wall Type E
Scale: 1:5

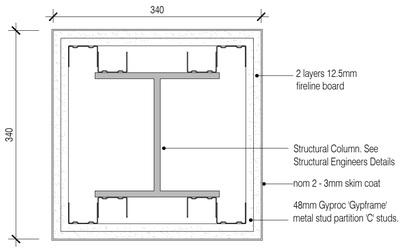


06 Typical Gyplyner Encasement To Steel Column
Scale: 1:5

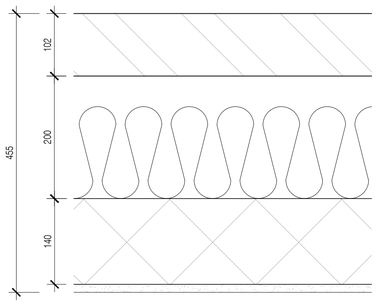


07 Wall Type F
Scale: 1:5

Ibstock facing brick - 50mm clear cavity -150mm insulation - 140mm blockwork - plaster finish

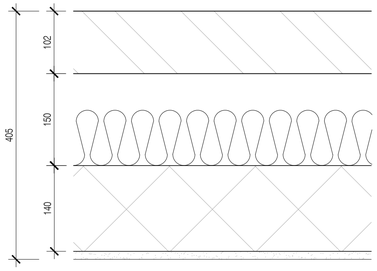


08 Wall Type G
Scale: 1:5

Ibstock facing brick - 50mm clear cavity -90mm insulation - 140mm blockwork - plaster finish

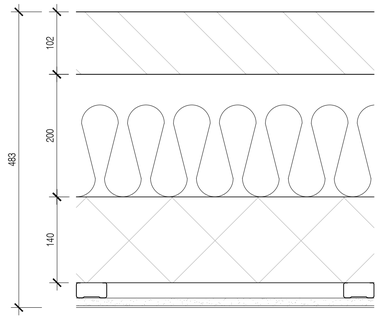


09 Wall Type H
Scale: 1:5

Ibstock facing brick - 50mm clear cavity -150mm insulation - 140mm blockwork - dry lining - skim finish

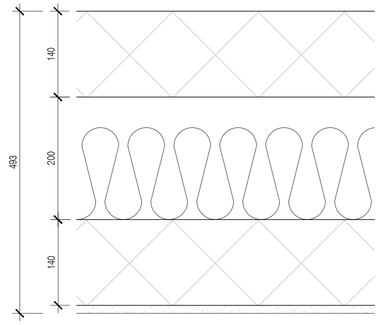


10 Wall Type J
Scale: 1:5

140mm blockwork -150mm insulation - 140mm blockwork - plaster finish

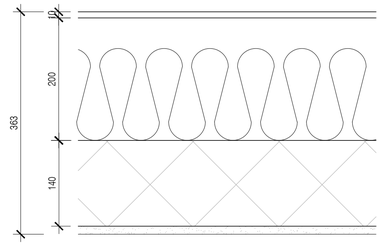


11 Wall Type K
Scale: 1:5

Laminate cladding - 50mm clear cavity -150mm insulation - 140mm blockwork - plaster finish

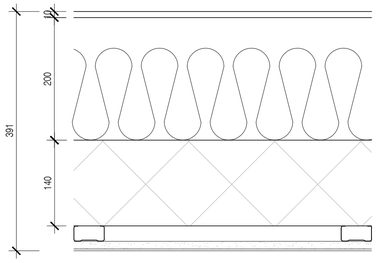


12 Wall Type L
Scale: 1:5

Laminate cladding - 50mm clear cavity -150mm insulation - 140mm blockwork - dry lining - skim finish

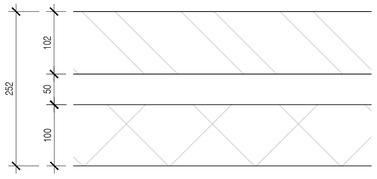


13 Wall Type M
Scale: 1:5

Ibstock facing brick - 50mm clear cavity 100mm blockwork

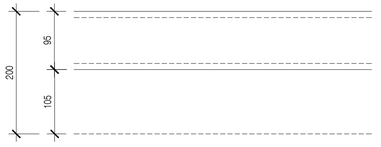


14 Wall Type N
Scale: 1:5

PPC Metal Louvres

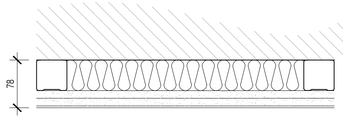


15 Wall Type P
Scale: 1:5

Dry lined with 2 layers 12.5mm soundbloc and 50mm Isover APR 1200 in cavity

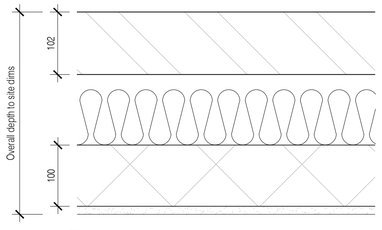

16 Wall Type Q
Scale: 1:5

Brick to match extg - 25mm clear cavity -90mm insulation - 100mm blockwork - plaster finish

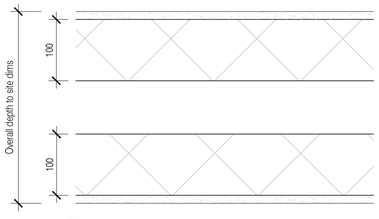


17 Wall Type R
Scale: 1:5

Plaster Finish - 100mm blockwork - 100mm clear cavity - 100mm blockwork - skim finish

NOTES: Do not scale this drawing. All dimensions to be checked on site prior to commencement or manufacture.

Key Plan
(nts)

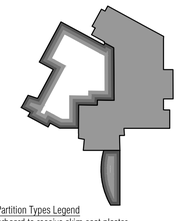

Internal Partition Types Legend
All plasterboard to receive skim coat plaster

- A - 2 layers 15mm soundbloc each side of 70mm C studs @ 600mm centres. 50mm Isover APR 1200 in cavity
- B - 2 layers 15mm Wallboard each side of 70mm C studs @ 600mm centres.
- C - 2 layers 15mm soundbloc each side of 70mm I 50 studs @ 400mm centres. 50mm Isover APR 1200 in cavity
- D - 2 layers12.5mm soundbloc each side of 92mm I 90 studs @ 300mm centres. 25mm Isover APR 1200 in cavity
- E - 140mm blockwork w/skim coat
- 2 layers 12.5mm fireline column encasing
- Z - 2 layers 15mm soundbloc each side of 146mm Gypframe studs @ 600mm centres.

External Wall Types Legend

- F - Ibstock facing brick - 50mm clear cavity -150mm insulation - 140mm blockwork - plaster finish
- G - Ibstock facing brick - 50mm clear cavity -90mm insulation - 140mm blockwork - plaster finish
- H - Ibstock facing brick - 50mm clear cavity -150mm insulation - 140mm blockwork - dry lining - skim finish
- J - 140mm blockwork -150mm insulation - 140mm blockwork - plaster finish
- K - Laminate cladding - 50mm clear cavity -150mm insulation - 140mm blockwork - plaster finish
- L - Laminate cladding - 50mm clear cavity -150mm insulation - 140mm blockwork - dry lining - skim finish
- M - Ibstock facing brick - 50mm clear cavity 100mm blockwork N - PPC Metal Louvres
- P - Dry lined with 2 layers 12.5mm soundbloc and 50mm Isover APR 1200 in cavity
- Q - Brick to match extg - 25mm cavity -90mm insulation - 100mm blockwork - plaster finish
- R - Plaster - 100mm blockwork - 100mm clear cavity - 100mm blockwork - Plaster

NB: All steelwork to be erected in accordance with Structural Engineer's design and specification. For all steelwork information inc. bracing, refer to Structural Engineers drawings

ISSUED FOR CONSTRUCTION

Rev	Date	By	Chk	Comment
C1	03.07.13	RKC	JAS	Issued for CONSTRUCTION

BRINGING IDEAS TO LIFE

FRANKHAM

Frankham Consultancy Group Limited
21 Perrymount Road
Haywards Heath RH16 3TP
t 01444 444900 f 01444 455642
enquire@frankham.com
www.frankham.com

Client
Ealing
www.ealing.gov.uk

Project Title
Dominion Arts Centre
Southall
London


Drawing Title
Internal & External
Wall Details

Drawn by:	Scale:	Date:
RKC	1:5 @A1	18.04.13
Designed by:	Checked by:	Approved by:
FCG	AC	AC


File Ref.: X:\2009\224970 - LB EALING - DOMINION ARTS CENTRE\ARCH\A3D_4BI_DETAIL_SCHEMATICS 224970-A-432.DWG - 20/06/13 11:13:49:23

Drawing No.	Rev.
224970-A-432	C1


C2

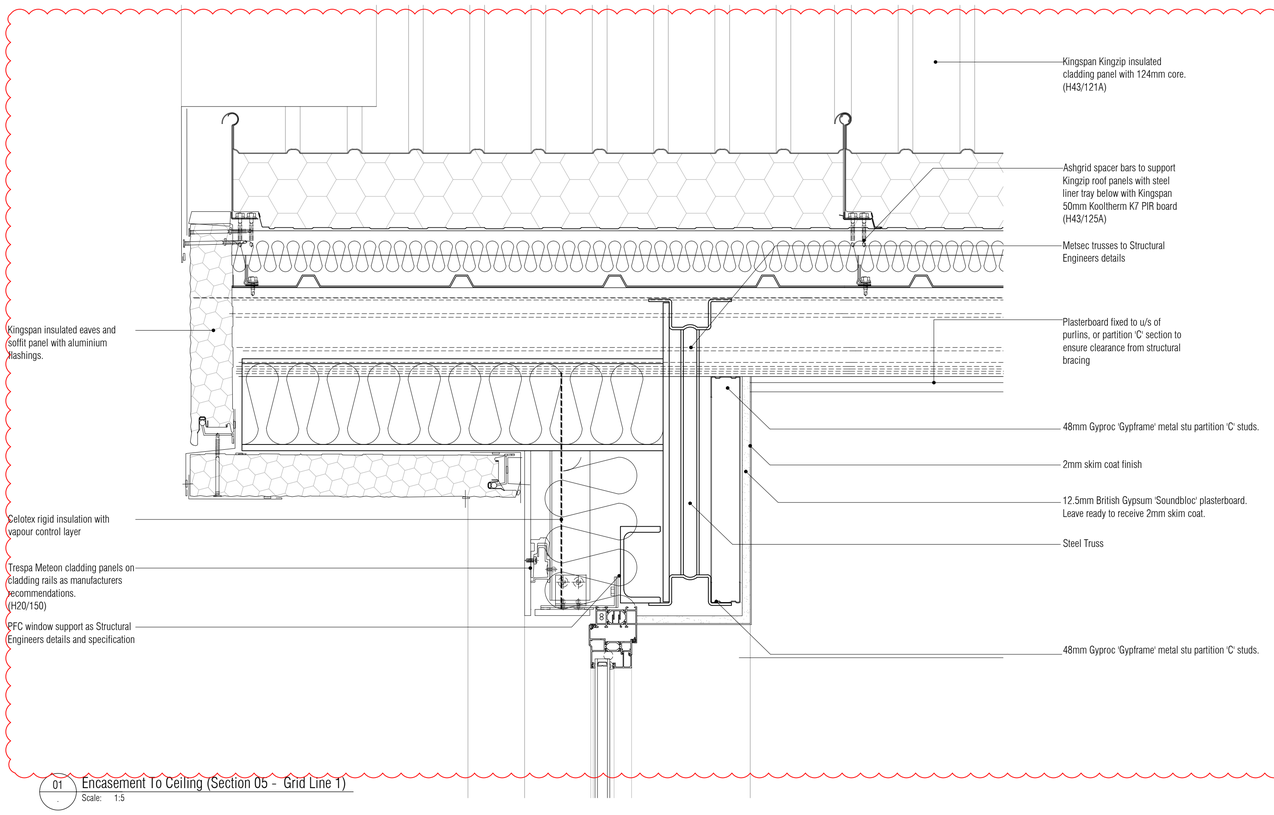


01 Encasement To Ceiling (Section 05 - Grid Line 1)
Scale: 1:5

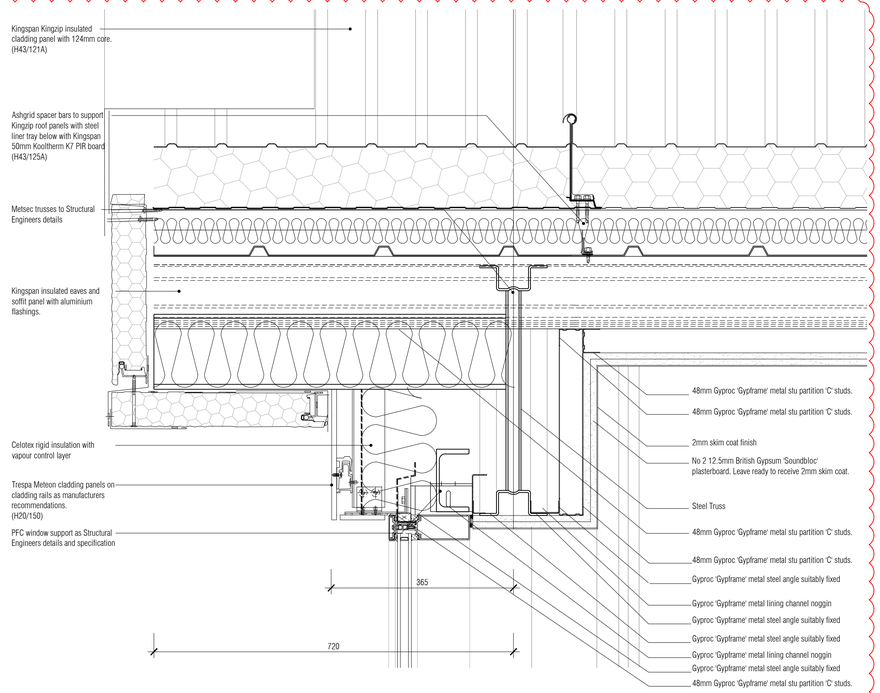

02 Encasement To Ceiling (Section 05 - Grid Line 2)
Scale: 1:5

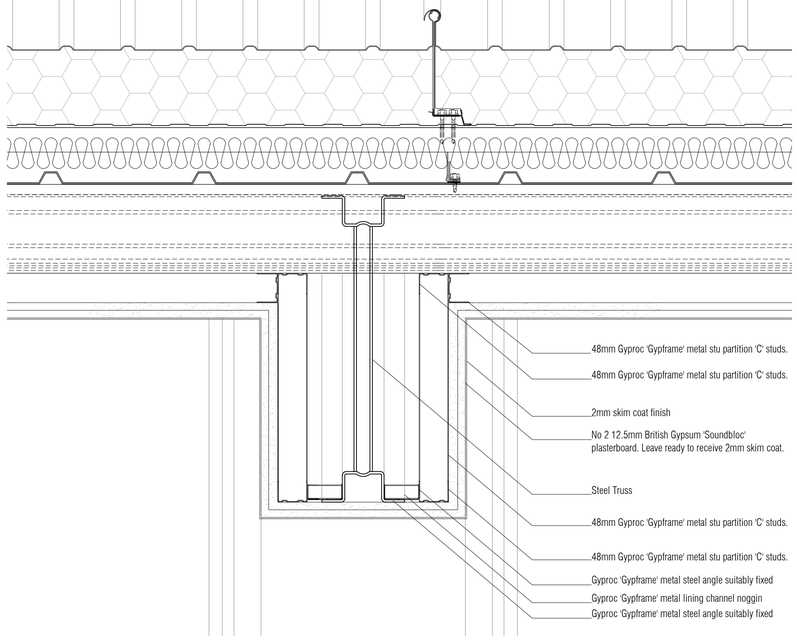


03 Encasement To Ceiling (Section 05 - Grid Line 4)
Scale: 1:5

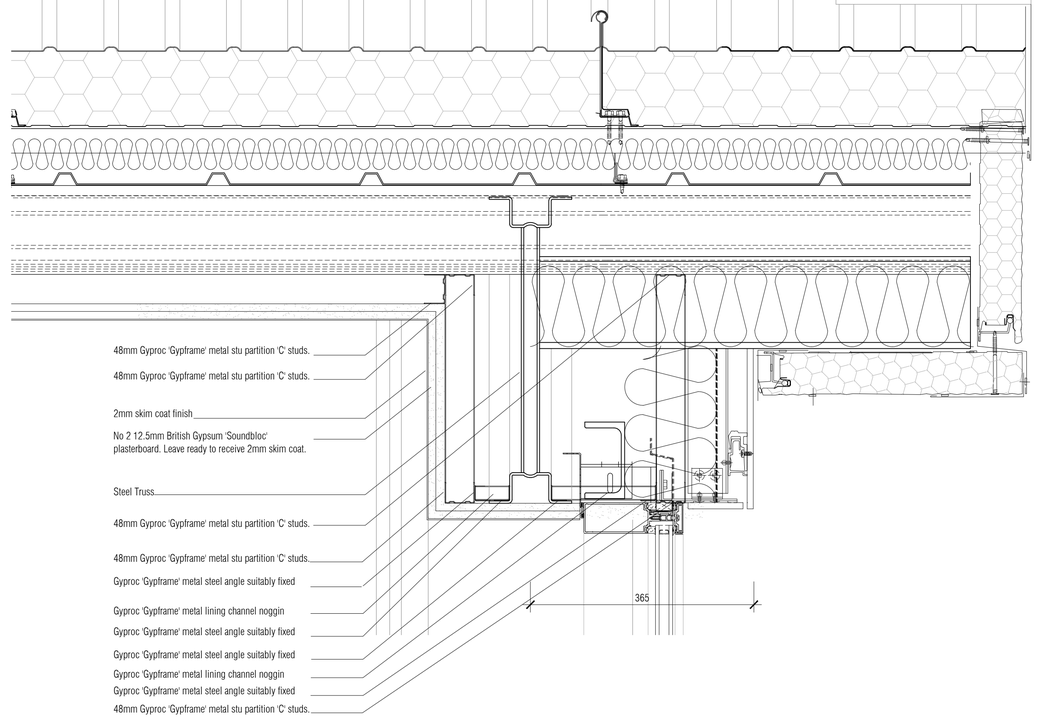

04 Encasement To Ceiling (Section 05 - Grid Line 5)
Scale: 1:5

NOTES: Do not scale this drawing. All dimensions to be checked on site prior to commencement or manufacture.

Key Plan
(nts)

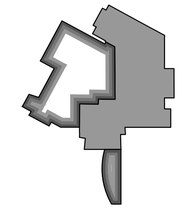

ISSUED FOR CONSTRUCTION

Rev	Date	By	Chk	Comment
C2	07.10.13	CH	AC	Notes added to roofing
C1	03.07.13	RKC	JAS	Issued for CONSTRUCTION

BRINGING IDEAS TO LIFE

FRANKHAM

Frankham Consultancy Group Limited
21 Perrymount Road
Haywards Heath RH16 3TP
t 01444 449000 f 01444 455642
enquire@frankham.com
www.frankham.com

Client
Ealing
www.ealing.gov.uk

Project Title
Dominion Arts Centre
Southall
London


Drawing Title
Ceiling Details
Details
Sheet 1 of 2

Drawn by:	Scale:	Date:
RKC	1:5 @A1	18.04.13
Designed by:	Checked by:	Approved by:
FCG	CH	AGC

File Ref.: K:\2008\0224970 - DEALING - DOMINION ARTS CENTRE\ARCH\400_499_DETAIL_SCHEMATICS\224970-A-440.DWG - 20061113493 20:06:11 13:49:50

Drawing No. 224970-A-440
Rev. C2


C2

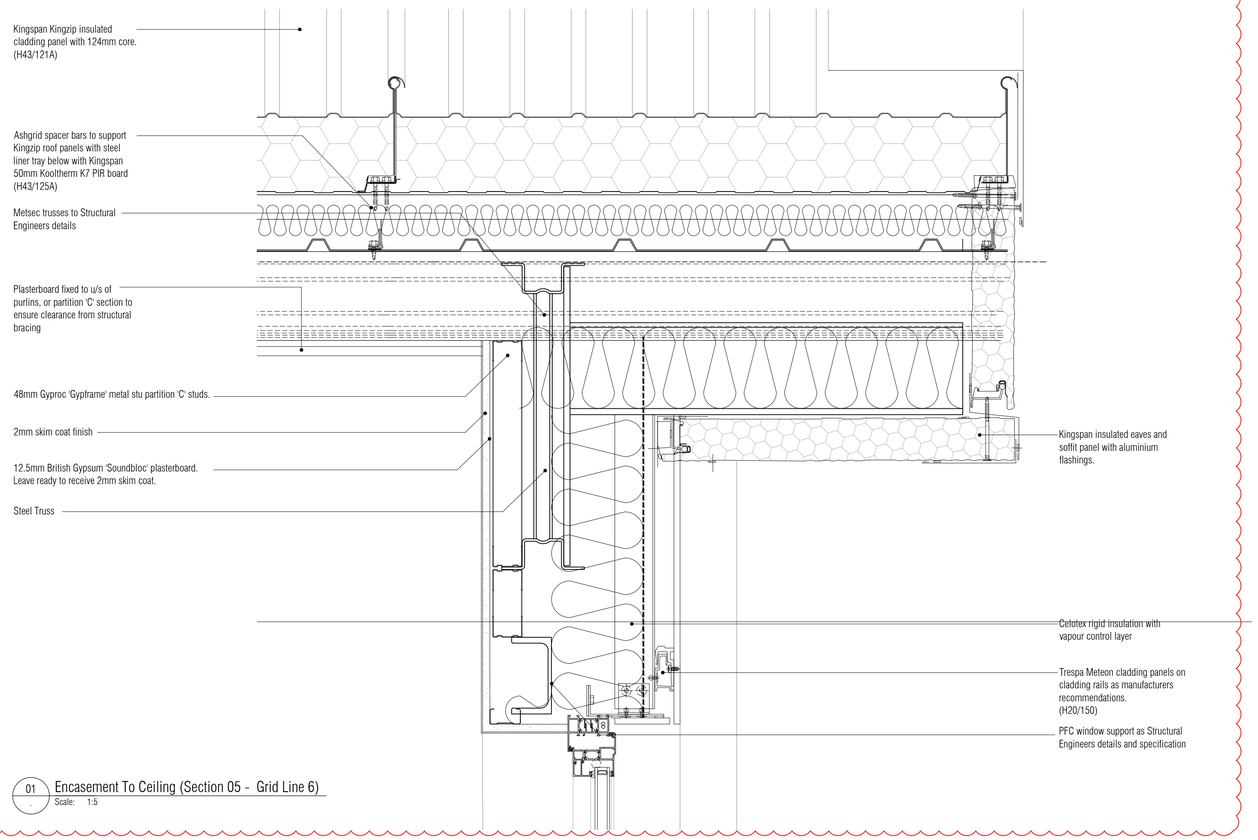

01 Encasement To Ceiling (Section 05 - Grid Line 6)
Scale: 1:5

NOTES: Do not scale this drawing. All dimensions to be checked on site prior to commencement or manufacture.

Key Plan
(nts)

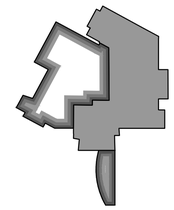

ISSUED FOR CONSTRUCTION

Rev	Date	By	Chk	Comment
C2	07.10.13	CH	AC	Annotation added
C1	03.07.13	RKC	JAS	Issued for CONSTRUCTION

BRINGING IDEAS TO LIFE

FRANKHAM

Frankham Consultancy Group Limited
21 Perrymount Road
Haywards Heath RH16 3TP
t 01444 449000 f 01444 455642
enquire@frankham.com
www.frankham.com

Client
Ealing
www.ealing.gov.uk


Project Title
Dominion Arts Centre
Southall
London

Drawing Title
Ceiling Details
Details
Sheet 2 of 2


Drawn by:	Scale:	Date:
RKC	1:5 @A1	18.04.13
Designed by:	Checked by:	Approved by:
FCG	CH	AGC

File Ref.: I:\2008\05\224970 - LB EALING - DOMINION ARTS CENTRE\ARCH\400_499_DETAIL_SCHEMATICS\224970-A-441.DWG — 20061113:50:05


Drawing No. 224970-A-441
Rev. C2

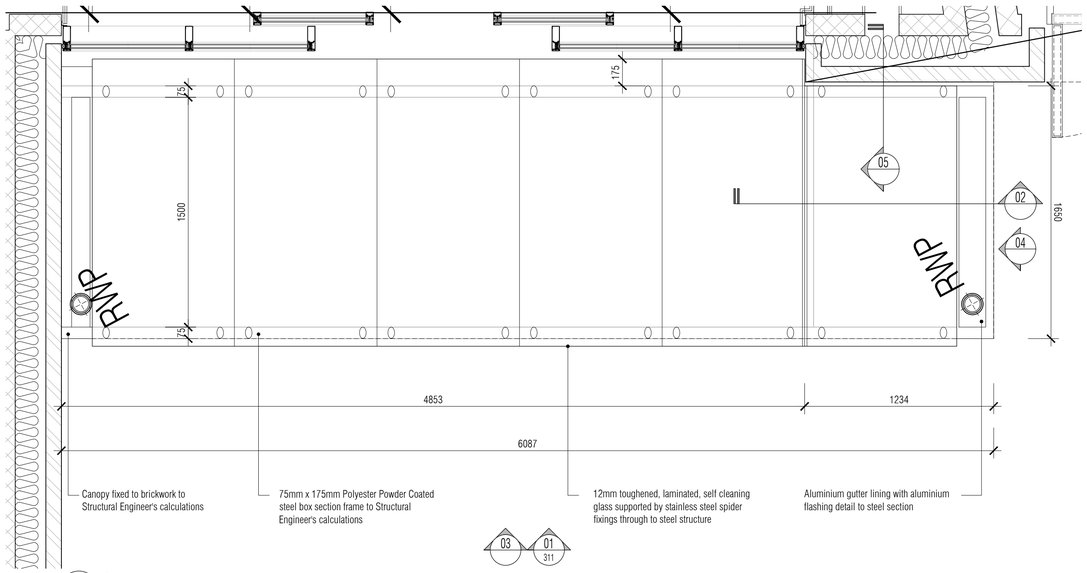


01 Canopy plan
Scale: 1:20

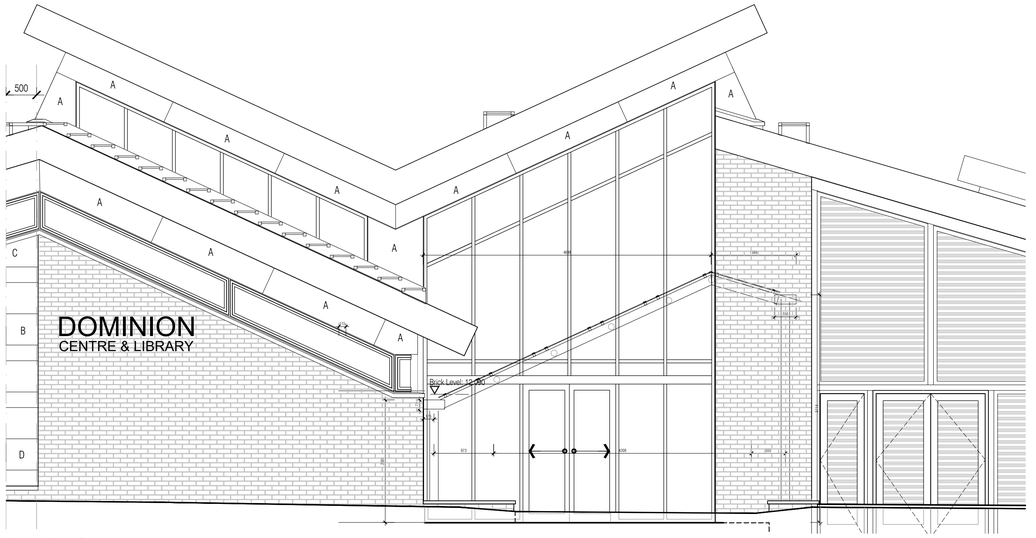


03 Partial West Elevation
Scale: 1:50

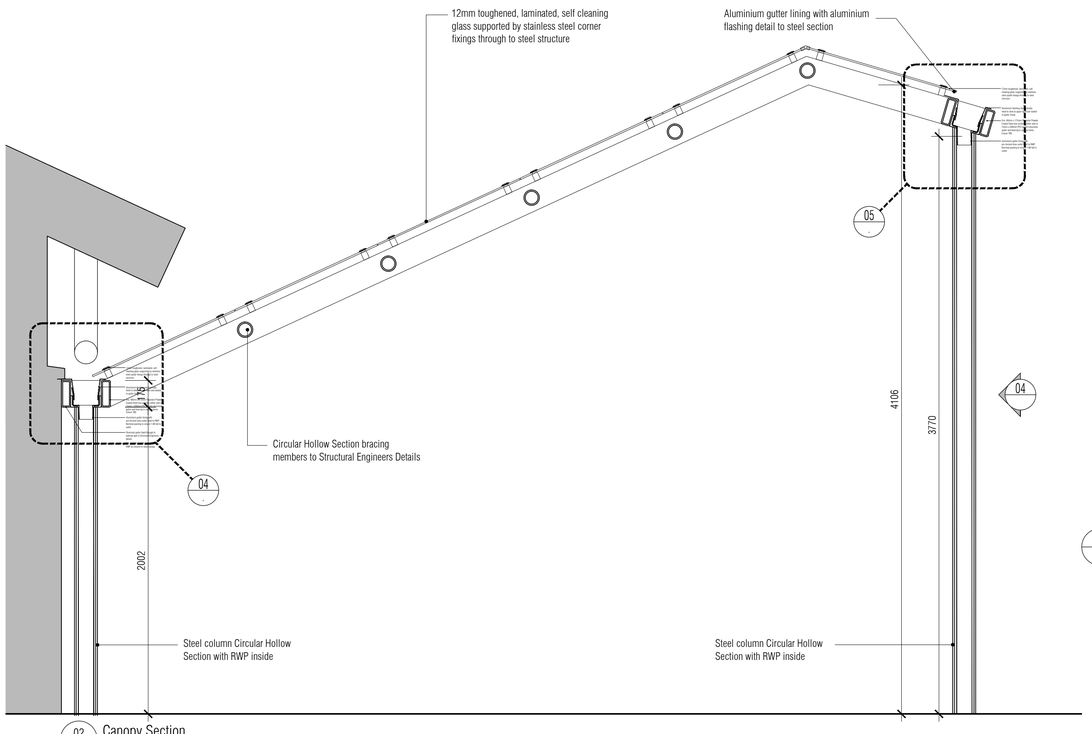

02 Canopy Section
Scale: 1:20

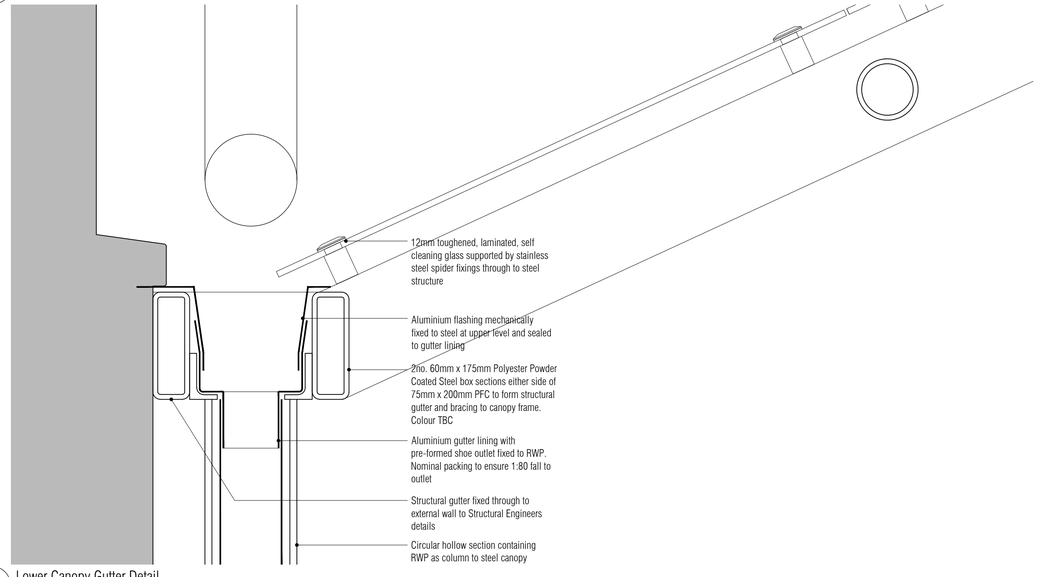


04 Lower Canopy Gutter Detail
Scale: 1:5

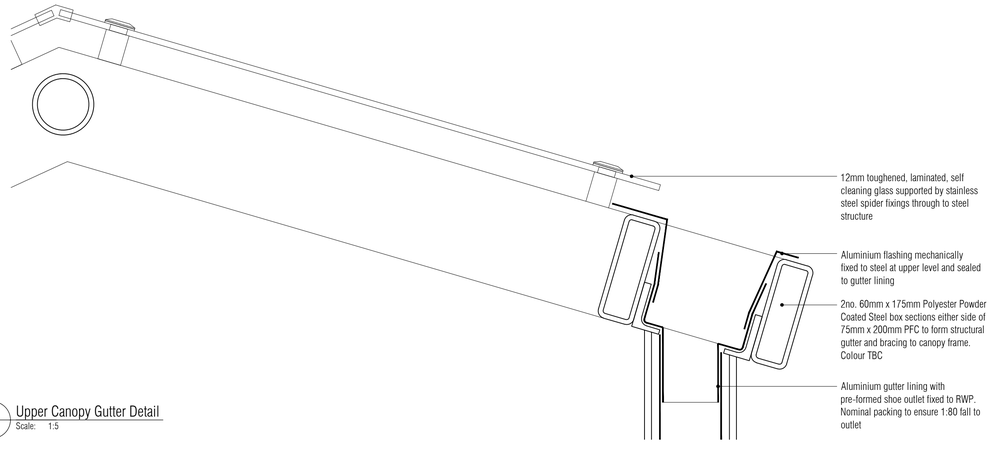

05 Upper Canopy Gutter Detail
Scale: 1:5

NOTES: Do not scale this drawing. All dimensions to be checked on site prior to commencement or manufacture.

Key Plan
(nts)

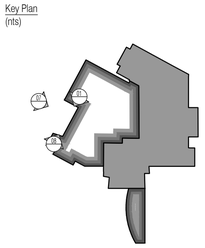

ISSUED FOR CONSTRUCTION

Rev	Date	By	Chk	Comment
C1	03.07.13	RKC	JAS	Issued for CONSTRUCTION

BRINGING IDEAS TO LIFE

FRANKHAM

Frankham Consultancy Group Limited
21 Perrymount Road
Haywards Heath RH16 3TP
t 01444 444900 f 01444 455642
enquire@frankham.com
www.frankham.com

Client
Ealing
www.ealing.gov.uk

Project Title
Dominion Arts Centre
Southall
London

Drawing Title
Entrance Canopy
Details

Drawn by:	Scale:	Date:
RKC	1:10 & 1:50 @A1	03.04.13
Designed by:	**Checked by:**	**Approved by:**
FCG	CH	AGC

File Ref.: H:\2009\224970 - LEALNG - DOMINION ARTS CENTRE\ARCHIVE\ 499_DETAIL SCHEMATICS\ 224970-A-480.DWG - 2009/11/30/09 20:06:11 13:53:57

Drawing No.	Rev.
224970-A-480	C1